# CITY OF ALBUQUERQUE

July 24, 2015



Mark Goodwin, P.E. Mark Goodwin and Associates P.O. Box 90606 Albuquerque, NM 87199

Re: A.I.S. Retail

Grading and Drainage Plan (H13D106) Engineer's Stamp Date, 7-18-15 (Sheets C1, C2, C3 & C4)

Dear Mr. Goodwin,

Based upon the information provided in your submittal received 7-20-15, the above referenced plan is approved for grading and building permit with following recommendation:

• Please consider changing the grades in the parking lot to lessen the 22" of water depth at the bottom/center of the pond. This might be achieved by raising the bottom of the pond and provide a flatter slopes in the parking lot to increase top of water surface elevation to the south, to the north and to the east.

PO Box 1293

Albuquerque

Please attach a copy of this approved plan to the construction sets prior to sign-off by Hydrology. Prior to Certificate of Occupancy release the following items will be required: a) Engineer Certification per the DPM checklist & b) An executed License Agreement or recorded public easement for the construction of the improvements along 12<sup>th</sup> Street N.W.

New Mexico 87103 If you have any questions, you can contact me at 924-3999.

www.cabq.gov

Sincerely,

Shahab Biazar, P.E.

City Engineer, Planning

Development and Building Services

C: email



Project Title: DRB#:

# City of Albuquerque

#### Planning Department

# Development & Building Services Division

#### DRAINAGE AND TRANSPORTATION INFORMATION SHEET

(REV 02/2013)

Building Permit #: City Drainage #:


DRB#: EPC#:		Work Order#:				
Legal Description:						
City Address:						
Engineering Firm:		Contact:				
Address:						
Phone#: Fax#:		E-mail:				
Owner:		Contact:				
Address:						
Phone#: Fax#:		E-mail:				
Architect:		Contact:				
Address:						
Phone#: Fax#:		E-mail:				
Surveyor:		Contact:				
Address:						
Phone#: Fax#:		E-mail:				
Contractor:		Contact:				
Address:						
Phone#: Fax#:		E-mail:				
TYPE OF SUBMITTAL:	CHECK TYPE OF APPROV	AL/ACCEPTANCE SOUGHT:				
DRAINAGE REPORT	SIA/FINANCIAL GUARAN	TEE RELEASE				
DRAINAGE PLAN 1st SUBMITTAL	PRELIMINARY PLAT APP	ROVAL				
DRAINAGE PLAN RESUBMITTAL	S. DEV. PLAN FOR SUB'D	SUB'D APPROVAL				
CONCEPTUAL G & D PLAN	S. DEV. FOR BLDG. PERM	IT APPROVAL				
GRADING PLAN	SECTOR PLAN APPROVAL	_				
EROSION & SEDIMENT CONTROL PLAN (ES	C)FINAL PLAT APPROVAL					
ENGINEER'S CERT (HYDROLOGY)	CERTIFICATE OF OCCUPA	ANCY (PERM)				
CLOMR/LOMR	CERTIFICATE OF OCCUPA	CERTIFICATE OF OCCUPANCY (TCL TEMP)				
TRAFFIC CIRCULATION LAYOUT (TCL)	FOUNDATION PERMIT AF	PPROVAL				
ENGINEER'S CERT (TCL)	BUILDING PERMIT APPRO	OVAL				
ENGINEER'S CERT (DRB SITE PLAN)	GRADING PERMIT APPRO	VAL SO-19 APPROVAL				
ENGINEER'S CERT (ESC)	PAVING PERMIT APPROV	AL ESC PERMIT APPROVAL				
SO-19	WORK ORDER APPROVAL	<del></del>				
OTHER (SPECIFY)	GRADING CERTIFICATIO	OTHER (SPECIFY)				
WAS A PRE-DESIGN CONFERENCE ATTENDED:	Yes No Co	ppy Provided				
DATE SUBMITTED:	By:					

Requests for approvals of Site Development Plans and/or Subdivision Plats shall be accompanied by a drainage submittal. The particular nature, location, and scope to the proposed development defines the degree of drainage detail. One or more of the following levels of submittal may be required based on the followin

- 1. Conceptual Grading and Drainage Plan: Required for approval of Site Development Plans greater than five (5) acres and Sector Plans
- Drainage Plans: Required for building permits, grading permits, paving permits and site plans less than five (5) acres
- Drainage Report: Required for subdivision containing more than ten (10) lots or constituting five (5) acres or more
- Erosion and Sediment Control Plan: Required for any new development and redevelopment site with 1-acre or more of land disturbing area, including project less than 1-acre than are part of a larger common plan of development

# CITY OF ALBUQUERQUE

July 14, 2015

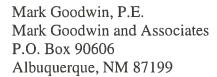

Re: A.I.S. Retail

Grading and Drainage Plan (H13D106) Engineer's Stamp Date, 7-9-15, 7-7-15 & 6-25-15 (Sheet C1, C2 & C3)

Dear Mr. Goodwin,

Based upon the information provided in your submittal received 6-26-15 and 7-9-15 the above referenced plan is approved for Site Plan For Building Permit. The following comments must be addressed prior to grading and building permit approval:

- Show roof flow directions. Runoff west of the building along 12<sup>th</sup> street cannot drain over the sidewalk to the west.
- There appear to be some ponding between the two buildings along 12<sup>th</sup> street.
- Provide additional spot elevation to assure that the runoff will be able to get around the back of the building and into the parking lot.
- Provide elevations for the trash enclosure floor drains.
- Show the 100-year water surface elevation on the plans. The water depth appears to be more than 24" in the parking lot. Provide your routing calculations for the parking ponding. Where is the emergency overflow?
- Please provide the bottom of the pond elevations where first flush ponding is proposed. Some areas along the parking lots may have more than 18" of vertical drop. Therefore, handrail will be required. A retaining wall should be used for these areas.
- Is the grate elevation for the double "D" inlet at the bottom of the pond? How does the sidewalk culvert tie into the double "D" inlet?
- There is a proposed sidewalk culvert north side of the southerly building along 12<sup>th</sup> Street. The culvert encroaches into the handicap ramp. Is the runoff draining to the depressed landscaping area to the southwest corner of the building? Can the runoff be routed to the parking lot? How much runoff is being routed to this area?
- Please correct the force main line size on sheet C3 of 3.
- Show existing contours. Provide contour elevations on sheet C2 of 3.
- Who will be maintaining the storm drain system?

If you have any questions, you can contact me at 924-3999.

Sincerely,

Shahab Biazar, P.E.

City Engineer, Planning

Development and Building Services

C: email

PO Box 1293

Albuquerque

New Mexico 87103

www.cabq.gov

~ 2012 ACEC/NM Award Winner for Engineering Excellence, Small Firm ~ ~ 2008 ACEC/NM Award Winner for Engineering Excellence, Small Firm ~

July 20, 2015

Mr. Shahab Biazar, P.E. City Engineer, Planning City of Albuquerque PO Box 1293 Albuquerque, NM 87103

Re: AIS Retail; 12 St & Indian School/Menaul; Grading and Drainage Plan (H13D106)

Dear Mr. Biazar:

Attached, please find a revised Grading & Drainage Plan as required by your letter dated 7/14/2015. Our response and/or changes are as follows:

- "Show roof flow directions..." The roof flow directions have been added to Sheet C1. The roof runoff does NOT drain to the west of the building. The roof runoff drains towards the east of the building into the parking lot.
- "There appears to be ponding between the two buildings along 12th Street." Please see changes on Sheet C1. Grade point elevations were changed and flow arrows were added to ensure the runoff drains towards the parking lot.
- "Provide additional spot elevations to assure that the runoff will be able to get around the back of the building and into the parking lot." Please see changes on Sheet C1.
- "Provide elevations for the trash enclosure floor drains." Please see changes on Sheet C1.
- "Show the 100 year water surface elevation on the plans...water depth appears to be more than 24"...where is the emergency overflow?" The MWSEL has been added to Sheet C1. The MWSEL is 4964.11. Since the majority of the spaces in the parking lot are at elevations greater than 4963.00, the water depth is 13". Six parking spaces near the center of the pond will have a maximum depth of 22". The emergency overflow is located in the southwestern corner of the parking lot as shown on note 8 on Sheet C1.
- "Please provide the bottom of the pond elevations where the first flush ponding is proposed..." Please see pond elevations on Sheet C1.
- "Is the grate elevation for the double "D" inlet at the bottom of the pond? How does the sidewalk culvert tie into the inlet?" Please see changes on Sheet C1. The inlet has been relocated to the middle of the first flush pond A2 and will be in a sump condition. The

top of the grate is at elevation 62.00'. The sidewalk culvert will discharge into pond A2 (outfall invert of the sidewalk culvert is 62.20'). The gravel lined bed shown on the "Typical Cross Section for First Flush Ponding in Parking Lot Medians" will help prevent erosion.

- "There is a proposed sidewalk culvert north side of the southerly building along 12<sup>th</sup> Street. The culvert encroaches into the handicapped ramp." The culvert has been relocated. The area in question will serve as a loading ramp for truck deliveries and not designed as an ADA ramp. Is the runoff draining to the depressed landscaping area to the southwest corner of the building? This drainage path is intended as the emergency spillway. The only runoff draining toward the depressed landscaping area is what falls on this area during the storm.
- "Please correct the force main line size on Sheet C3" Please see changes on Sheet C3.
- "Show existing contours. Provides contour elevations on sheet C2" Please see changes on Sheet C2. Please note that the site has been regraded since the topography of these existing contours was complete. The existing spot elevations show the grades after the site was regraded.
- "Who will be maintaining the storm drain system?" IPMI 6 L.L.C will be maintaining the system. Their address is 2401 12<sup>th</sup> Street NW.

Sincerely,

Kelly Klein, EIT

MARK GOODWIN & ASSOCIATES, PA

		17 2015
	. 7	Same as Jan 16 but Includes Temp Pond)
	( <	same as Jank but includes temptorer)
START	AIS_ AHYMO_2 pump out at 2.0cfs and 0.0 HRS PUNCH CODE=0 PRINT LINES	Temp Pond FINAL_ INPUT
*S********	**********	*********
_	ABQ INDIAN SCHOOL 100-YR, 24-HR D	**************************************
LOCATION RAINFALL	ALBUQUERQUE TYPE=2 RAIN QUARTER=0.0 RAIN ONE RAIN SIX=2.23 RAIN DAY=2.60	=1.78 DT=.05 ************************************
*S	ONSITE-ENTIRE BASIN A - DEVELOPED	
*S ********	**********	
COMPUTE NM HYD	TER A-0 B-0 C-12 B-00	Q= 14,23CFS
PRINT HYD .	ID=1 CODE=1	Vol = 0.6322 AC-FT
******	****	****
*S *S	ONSITE-SUBBASINS IN BASIN A	
****************	***********	***********
*s	BASIN 100.1	
COMPUTE NM HYD	ID=2 HYD=100.1 DA=0.000191 SQ MI PER_A=0_B=0 C=0 D=100	Q=0,53cF5
PRINT HYD	TP=0.133333 HRS RAIN=-1 ID=2 CODE=1	Ø-01236[-2
* *s	BASIN 100.2	
COMPUTE NM HYD	ID=3 HYD=100.2 DA=0.000395 SQ MI	
	PER A=0 B=0 C=14 D=86 TP=0.133333 HRS RAIN=-1	Q = 1.0Scps
PRINT HYD *	ID=3 CODE=1	
*S COMPUTE NM HYD	BASIN 100.3 ID=4 HYD=100.3 DA=0.00033 SQ MI	
COMPOTE NM HTD	PER A=0 B=0 C=12 D=88	
PRINT HYD	TP=0.133333 HRS RAIN=-1 ID=4 CODE=1	Q=0,89cfs
* *s	BASIN 100.4	
COMPUTE NM HYD	ID=5 HYD=100.4 DA=0.00045 SQ MI PER A=0 B=0 C=12 D=88	
	TP=0.133333 HRS RAIN=-1	Q=1,20 cfs
PRINT HYD *	ID=5 CODE=1	
*S COMPUTE NM HYD	BASIN 100.5 ID=6 HYD=100.5 DA=0.00404 SQ MI	
	PER A=0 B=0 C=10 D=90 TP=0.133333 HRS RAIN=-1	Q=10.69 crs
PRINT HYD *S	ID=6 CODE=1	Vol= 0.478AL-11
*****	****	
*S *S	OFFSITE-ENTIRE BASIN B - DEVELOPED	
COMPUTE NM HYD	1D=8 HYD=200 DA=0.011 SO MI	Q = 28.91 CFS
	PER A=0 B=0 C=12 D=88 TP=0.133333 HRS RAIN=-1	1109A7
PRINT HYD	ID=8 CODE=1	Vol: 1,28516-FT
	*******	
*S *S	FULLY DEVELOPED CONDITIONS ADD BAS	
**************************************	ID=9 HYD=300 ID=6 AND 8	59.61 CFS VOI = 1.763 ALFT
* ROUTE RESERVOIR	ID=10 HYD=300.1 INFLOW ID=9 CODE=	
	OUTFLOW (CFS) STORAGE (AC 0 0.00	
	0.01 0.001803	4951
	0.02 0.003606 0.03 0.005409	4952 4953
	0.04 0.007212 0.991 0.009015	4954 Op = 1.998 CFS
	0.992 0.010818 0.993 0.012621	4956 4957 & 2,35 hours
	0.994 0.014424	4958
	1.993 0.016227 1.994 0.019042	4959 MWSEL= 4964, 11
	1.995 0.021859 1.996 0.030000	4961 Max Storage = 1.16 Az-FT 4962
	1.997 0.021200 1.998 0.982000	4963 4964
	1.999 2.590000	4965
	Page 1	

```
AIS_ AHYMO_2 pump out at 2.0cfs and Temp Pond FINAL_ INPUT
PRINT HYD
                   ID=10 CODE=1
*S
                   OFFSITE-ENTIRE BASIN B - UNDEVELOPED CONDITIONS
*****************
                   ID=13 HYD=200 DA=0.011 SQ MI
COMPUTE NM HYD
                                                 Q = 21.88 CFS
                   PER A=0 B=0 C=90 D=10
TP=0.133333 HRS RAIN=-1
                                                 VOL = 0.6785 AR-FT
                   ID=13 CODE=1
PRINT HYD
*****************
                   PARTIALLY DEVELOPED CONDITIONS ADD BASINS TO GO TO PUMP
ID=14 HYD=301 ID=6 AND 13 Q = 32,57 CFS VOLE 1, 156 AZ-FT
ADD HYD
                   ID=14 CODE=1
PRINT HYD
ROUTE RESERVOIR
                   ID=15 HYD=30.1 INFLOW ID=14 CODE=10
                                       STORAGE (AC FT)
                   OUTFLOW (CFS)
                                                        ELEV
                                        0.00
                                                         4950
                   0.01
                                       0.001803
0.003606
                                                        4951
                                                        4952
                                       0.005409
0.007212
                   0.03
                                                        4953
                                                        4954
4955
                   0.04
                                                               Op=1,998 crs
e2.15 hrs
                   0.991
                                       0.009015
0.010818
                                                        4956
4957
4958
                   0.992
                                       0.012621
0.014424
                   0.993
                   0.994
                                       0.016227
0.019042
                   1.993
                                                        4959
                   1.994
                                                        4960
                   1.995
                                       0.021859
                                                        4961
4962
                                                              MWSEL = 4963.83
                   1.996
                                       0.021200
                   1.997
                                                        4963
                                                              Max Storage = 0.8146 AZ-FT
                   1.998
                                                        4964
                   1.999
                                        2.590000
                                                        4965
PRINT HYD
                   ID=15 CODE=1
********************************
           ONSITE-ENTIRE BASIN A - DEVELOPED CONDITIONS SIZING OUTLET PIPE TO PUMP Outflow using 8" pipe (Size of pipe determined by maintaing elevation of pumped conditions)
*S
*S
*S
                   ID=20 HYD=408 INFLOW ID=6 CODE=10

JTFLOW (CFS) STORAGE (AC FT)

0 0.00

1.370 0.00034
ROUTE RESERVOIR
                 OUTFLOW (CFS)
                                                        ELEV
4959
                                                        4960
                                                                 Ap= 1,57cFs
MWSFL = 4964.10'
9" Pipe flowing full at S=1.0%
                   1.566
                                        0.00135
                                                        4961
                   1.567
1.568
1.569
1.570
                                        0.00236
                                                        4962
                                        0.01965
                                                        4963
                                       0.18197
0.73497*
                                                        4964
                                                        4965 \star
PRINT HYD
                   ID=20 CODE=1
           ONSITE-ENTIRE BASIN A - DEVELOPED CONDITIONS SIZING OUTLET PIPE TO PUMP Outflow using 12" pipe (Size of pipe determined by maintaing elevation of pumped conditions)
*S
*S
     *********************
                   ID=21 HYD=412 INFLOW ID=6 CODE=10
JTFLOW (CFS) STORAGE (AC FT)
0 0.00
ROUTE RESERVOIR
                 OUTFLOW (CFS)
                                                        ELEV
                                                         4959
                   2.670
                                        0.00034
                                                        4960
                   4.626
                                        0.00135
                                                        4961
                                        0.00236
                   4.627
                                                        4962
                   4.628
                                        0.01965
0.18197
                                                        4963
                                                        4964
4965 * 12" pipe flowing fulle
5 = 1.0%
                   4.629
                   4.630*
                                        0.73497 +
PRINT HYD
                   ID=21 CODE=1
```

```
AIS_ AHYMO_2 pump out at 2.0cfs and Temp Pond FINAL_ INPUT
*S
***********************
*S
                      FULLY DEVELOPED CONDITIONS ADD BASINS PUMP NOT WORKING
*$
ROUTE RESERVOIR
                      ID=22 HYD=500 INFLOW ID=9 CODE=10
                                             STORAGE (AC FT)
                      OUTFLOW (CFS)
                                                                      (This is a chede)
                                                               4950
                      0.010
                                             0.001803
                                                                4951
                      0.015
                                             0.003606
                                                                4952
                                                                          Design will allow for runoff to flow
                      0.020
                                             0.005409
                                                                4953
                      0.025
                                                                4954
                                             0.007212
                      0.030
                                             0.009015
                                                                4955
                      0.035
                                             0.010818
                                                                4956
                      0.040
                                             0.012621
                                                                4957
                                                                          into struts so as
                      0.045
                                             0.014424
                                                                4958
                                                                4959
                      0.050
                                             0.016227
                                                                          not to flood the
                                             0.019042
                                                                4960
                      0.055
                      0.060
                                             0.021859
                                                                4961
                                                                           parking lot.
                      0.065
                                             0.030000
                                                                4962
                      0.070
                                             0.021200
                                                                4963
                      0.075
                                             0.982000
                                                                4964
                                                                           MWSEL = 4964.4
                      0.100
                                             2.590000
                                                                4965
PRINT HYD
                      ID=22 CODE=1
                                                                          Max Storage = 1.611ac-ft
      *******************
              FULLY DEVELOPED CONDITIONS TO GO TO PUMP (Adding AREAS of each basin going into pump instead of adding the individual BASIN'S HYDROGRAPHS)
*s
*5
*S
*S
**********************
                     ID=25 HYD=600 DA=0.01504 SQ MI
PER A=0 B=0 C=10 D=90
TP=0.1333333 HRS RAIN=-1
COMPUTE NM HYD
                      ID=25 CODE=1
PRINT HYD
                      ID=26 HYD=600.1 INFLOW ID=25 CODE=10 OUTFLOW (CFS) STORAGE (AC FT)
ROUTE RESERVOIR
                                                                FLFV
                                             0.00
0.001803
0.003606
                       0
                                                                 4950
                      0.01
                                                                4951
                                                                           Q= 1,998 CFS
@ 2,35 hours
                                                                4952
                                             0.005409
                                                                4953
                      0.03
                                             0.007212
0.009015
                     0.04
0.991
0.992
0.993
                                                                4954
                                                                4955
                                                                4956
4957
                                             0.010818
                                             0.012621
                                                                        MWSEL = 4964,12
                                             0.014424
0.016227
                      0.994
                                                                4958
4959
                      1.993
                                                                        Max Storage = 1.17 AC-FT
                      1.994
                                             0.019042
0.021859
                                                                4960
                      1.995
                                                                4961
                      1.996
1.997
                                             0.030000
                                                                4962
                                             0.021200
                                                                4963
                      1.998
1.999
                                             0.982000
                                                                4964
                                                                4965
PRINT HYD
                      ID=26 CODE=1
*******
                      DESIGNING TEMPORARY POND IN BASIN B
PARTIALLY DEVELOPED CONDITIONS ADD BASINS TO GO TO PUMP
*S
*S
*S
                      (BASIN A: FULLY DEVELOPED... BASIN B: UNDEVELOPED)
                      ID=14 HYD=301 ID=6 AND 13 ID=14 CODE=1 ID=40 HYD=301 ID=20 AND 13
*ADD HYD
*PRINT HYD
ADD HYD
PRINT HYD
                      ID=40 CODE=1
                                                                              *NO FLOW OUT

Qp = 0.012 cfs *

MWSEL = 4956.47
                      ID=50 HYD=50.1 INFLOW ID=40 CODE=10
ROUTE RESERVOIR
                                             STORAGE (AC FT)
0.00
0.70
                      OUTFLOW (CFS)
                                                                   ELEV
                      0.00
                                                                   4955
                                                                   4956
                                                                   4957
                                             1.62
2.81
                      0.015
                      0.025
                                                                   4958
                                             4.29
6.07
                                                                   4959
                                                                   4960
                                                                              Max Strage: 1.135 ALFT
                      0.035
                      0.040
                                                                   4961
                                             8.20
                      0.045
                                             10.69
                                                                   4962
```


Page 3

AIS\_ AHYMO\_2 pump out at 2.0cfs and Temp Pond FINAL\_ INPUT  $0.050 \\ 13.59 \\ 4963$ 

PRINT HYD FINISH

ID=50

CODE=1

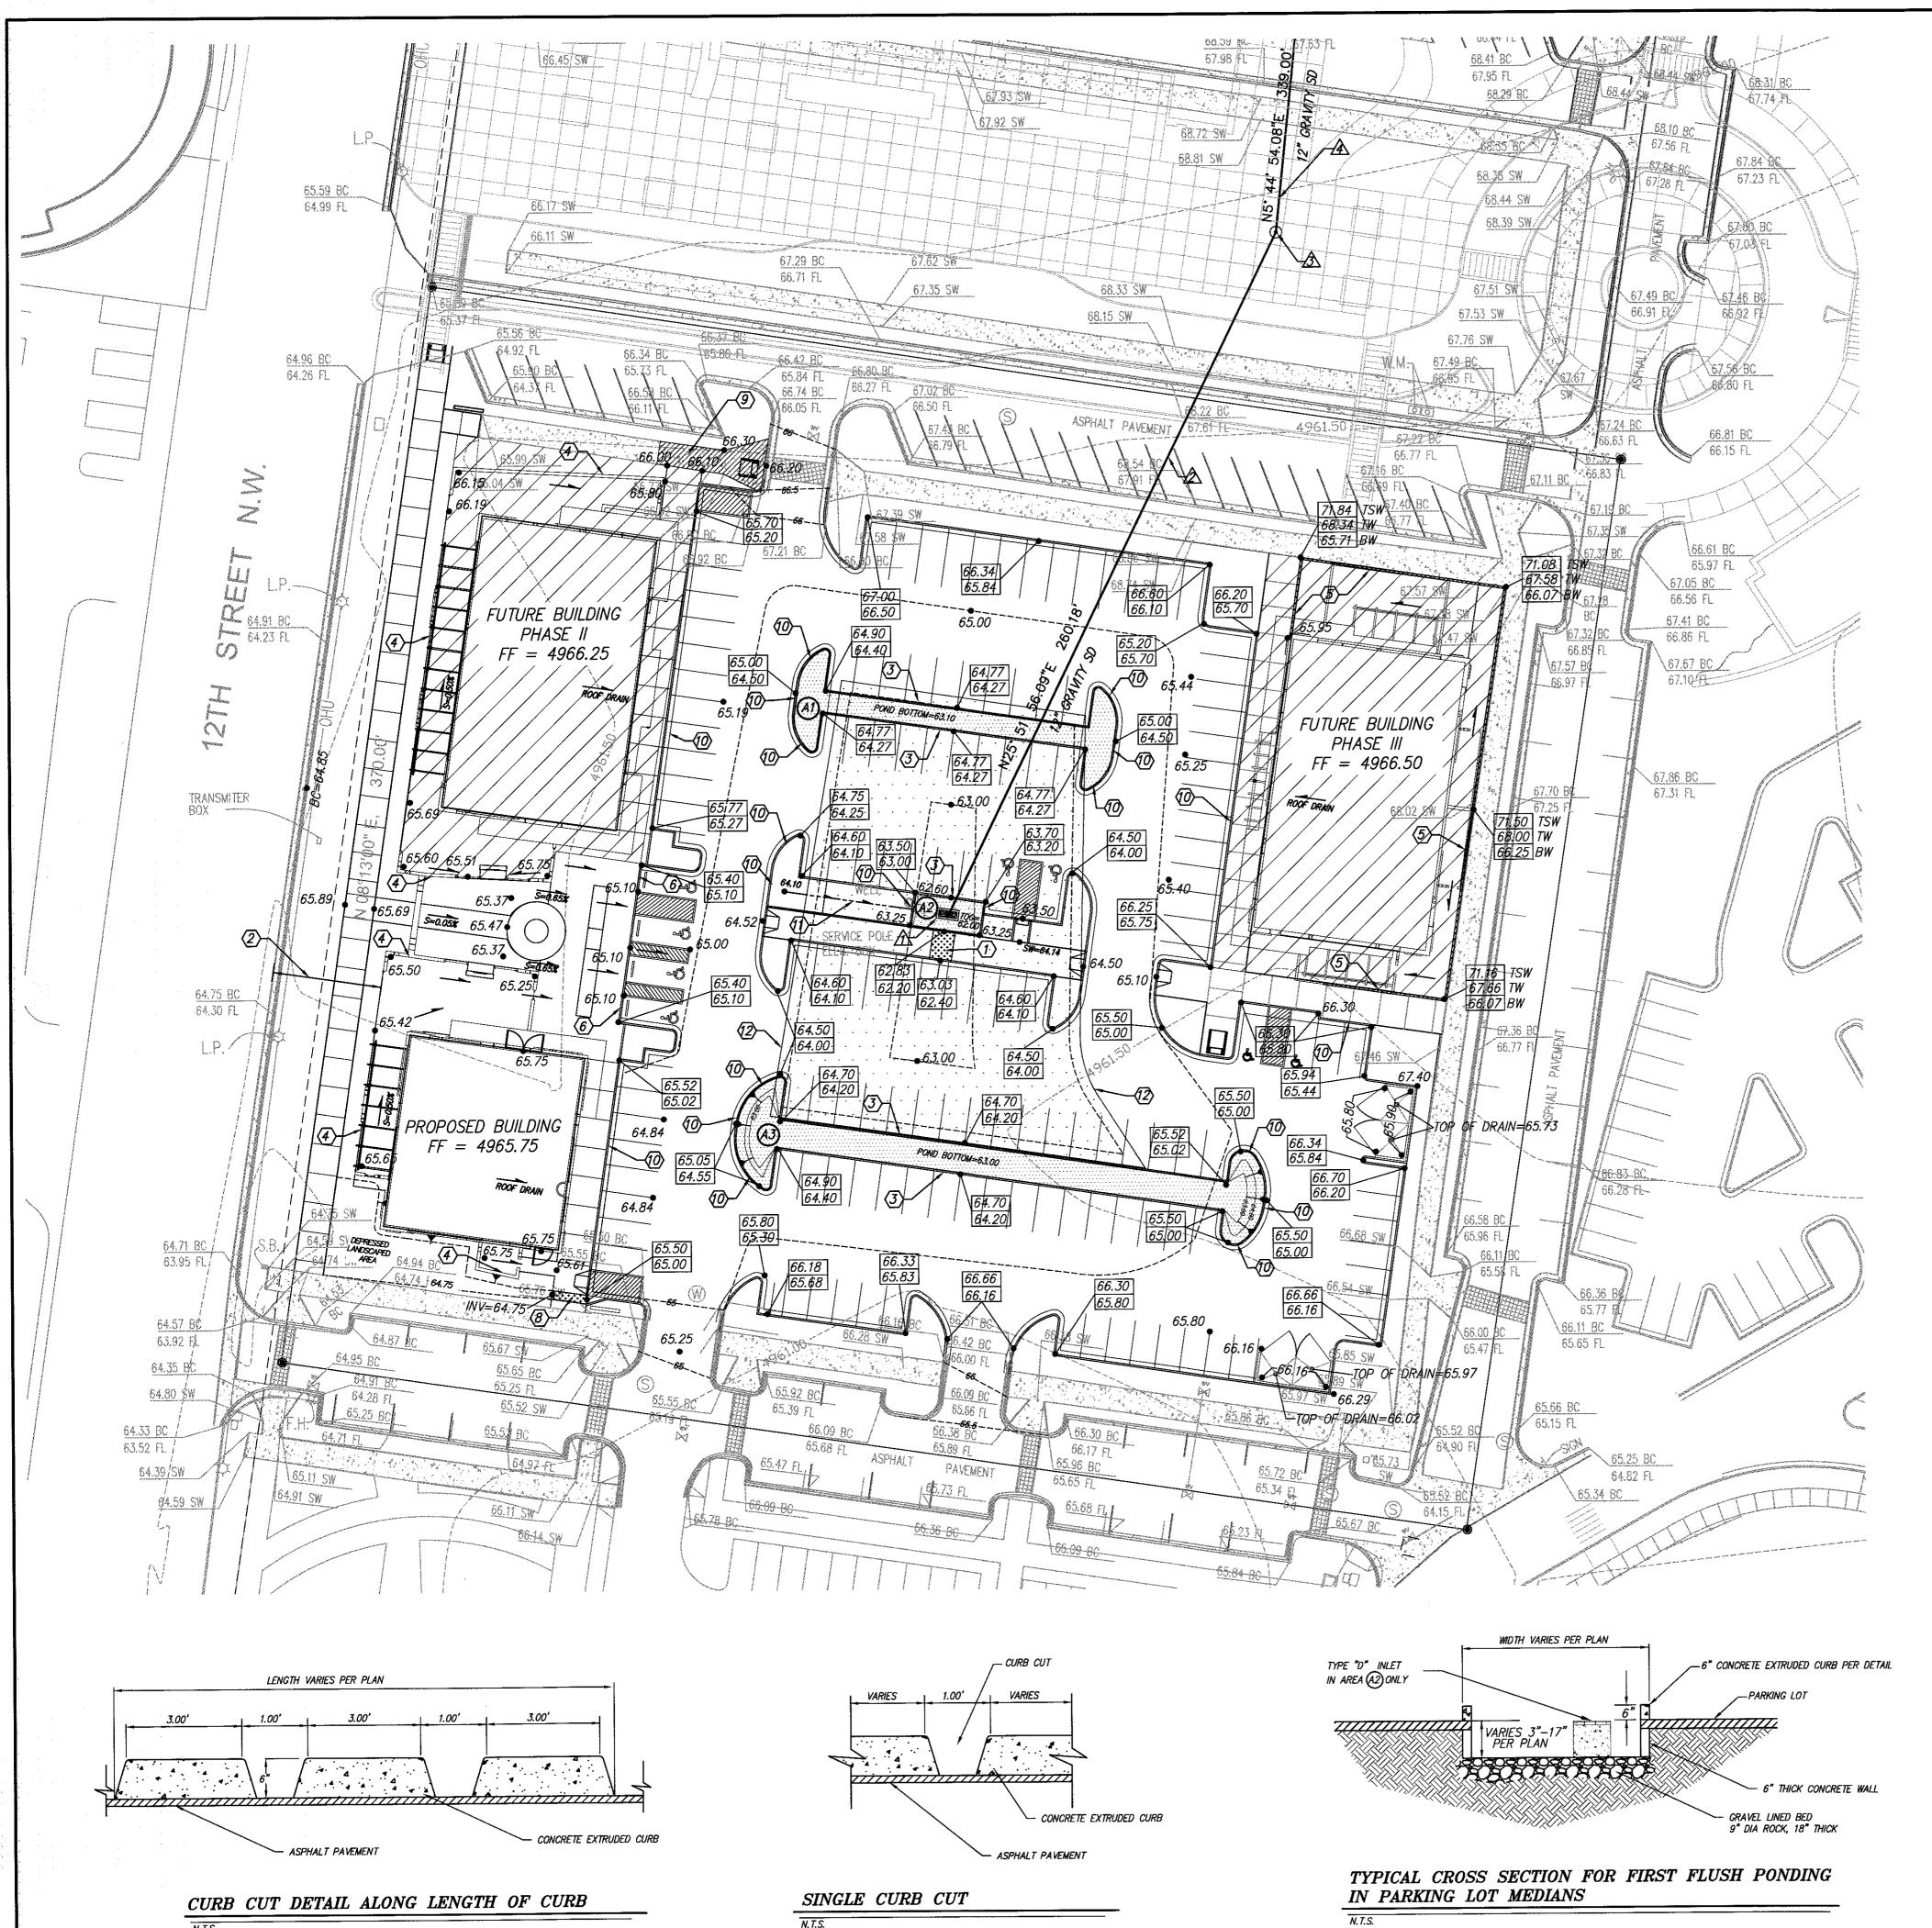

### GENERAL NOTES

- 1. SEE ARCHITECTURAL SITE PLAN FOR TRUE DIMENSIONS. 2. CITY OF ALBUQUERQUE STANDARD DETAILS SHALL BE USED WHEN APPLICABLE.
- 3. USE EXTRUDED CURB PER DETAIL EXCEPT WHERE NOTED
  4. EXISTING <u>CONTOURS</u> ARE PROVIDED FOR REFERENCE ONLY. SITE
  HAS BEEN REGRADED SINCE TOPOGRAPHY WAS COMPLETE.

### $\bigcirc$ KEYED NOTES

- 6' SIDEWALK CULVERT PER COA STANDARD DRAWING 2236
   FUTURE SIDEWALK IMPROVEMENTS BY CITY OF ALBUQUERQUE PROJECT. SEE ARCHITECTURAL SITE PLAN.
- 3. CURB CUTS PER DETAIL ALONG LENGTH OF CURB
  4. GARDEN / RETAINING WALL. DESIGN BY OTHERS.
- 5. GARDEN / RETAINING WALL. DESIGN BY OTHERS. IF WALL IS NOT TO BE CONSTRUCTED UNTIL FUTURE BUILDING IS BUILT, GRADE SLOPES AT 3:1 MAX FROM EXISTING SIDEWALK TO FUTURE PAD ELEVATION.
- 6. TRANSITION CURB FROM 6" TO NO CURB. INSTALL CURB STOPS IN PARKING SPACES.
- 7. TURNED DOWN SIDEWALK PER DETAIL THIS SHEET.
- 8. 3' WIDE SIDEWALK CULVERT PER COA STANDARD DRAWING 2236.
- USED AS EMERGENCY SPILLWAY.
  9. REMOVE AND REPLACE SIDEWALK TO MATCH NEW GRADES
- 10. SINGLE CURB CUT PER DETAIL
- 11. CREATE DRAINAGE SWALE
  12. MWSEL = 4964.11

### FIRST FLUSH

THE "FIRST FLUSH" IS BEING ACCOMPLISHED THROUGH DEPRESSED AREAS WITHIN THE MEDIANS IN THE PARKING LOT.

REQUIRED VOLUME = 0.34" X IMPERVIOUS AREA = 0.34"/12 X (132,631 SF) = 3,757 CF

VOLUME PROVIDED = 3,920 CF

- DEPTH = 14" (SEE DETAIL) POND BOTTOM = 63.00 63.10
  AREA = 1161 SF
  VOLUME = 1355 CF
- DEPTH = 3" (SEE DETAIL) POND BOTTOM = 61.75

  AREA = 258 SF

  VOLUME = 65 CF
- DEPTH = 14.4" (SEE DETAIL) POND BOTTOM = 63.00

  AREA = 2228 SF

  VOLUME = 2500 CF

### $\triangle$ S T O R M D R A I N N O T E S

- NEW TYPE DOUBLE "D" SD INLET PER COA DETAIL 2206 IN SUMP CONDITION


  GRATE = 4962.00'
  INVERT = 4959.00'
- NEW 12" GRAVITY MAIN SDR PVC 35

  LENGTH = 259'
  SLOPE = 1.00%
- NEW 4' DIA SD MH RIM = 4968.50 INV(S) = 4956.40
- INV(N) = 4956.30

  A NEW 12" GRAVITY MAIN SDR PVC 35


  LENGTH = 339.00'

  SLOPE = 0.9%
- LENGTH = 339.00' SLOPE = 0.9% END INVERT = 4953.30'

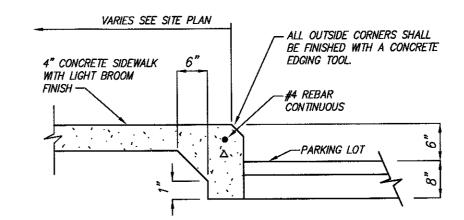

# TURNED DOWN SIDEWALK DETAIL

N.T.S

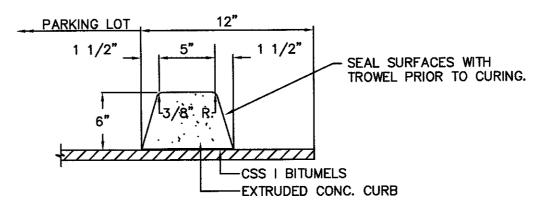

- 4000 PSI COMP. STRENGTH AT 28 DAYS
- 1.5 #/CY OF POLYPROPYLENE COLLATED FIBRILLATED FIBERS(FIBERMESH OR
- APPROVED EQUAL)

   NON-CHLORIDE RETARDER PER MANUF. RECOMM.

EXTRUDED CURB

ACTION OF THE PROPERTY OF THE

VICINITY MAP

TRACT A
RETAIL SITE
PROJECTED SECTIONS 7 & 8, T.10 N., R. 3 E., N.M.P.M
TOWN ON ALBUQUERQUE GRANT
CITY OF ALBUQUERQUE

BERNALILLO COUNTY, NEW MEXICO

ZONE ATLAS H-13-Z

### BENCHMARK

SEE PLAT FOR BASIS OF BEARINGS AND SITE BENCHMARKS

### LEGAL DESCRIPTION

TRACT "A'" OF THE PLAT FOR THE UNITED STATES BUREAU OF LAND MANAGEMENT SURVEY OF TOWN OF ALBUQUERQUE GRANT, PROJECTED SECTIONS 7 AND 8 TOWNSHIP 10 NORTH, RANGE 3 EAST NEW MEXICO PRINCIPAL MERIDAN, DATED AUGUST 12, 2011,

### SHEET INDEX

- C1 SITE GRADING AND DRAINAGE PLAN SITE SPECIFIC FOR PHASE 4
- OVERALL HYDROLOGY AND STORM DRAIN DESIGN
- C3 SITE UTILITY PLAN
  C4 OVERALL UTLITY EASEMENTS

# LEGEND

PROPERTY LINE

EXISTING CONTOUR

EXISTING SPOT ELEVATION

+ 2050 EXISTING SPOT ELEVATION

00.00 BC EXISTING SPOT ELEVATION

 00.00
 PROPOSED TOP OF CURB ELEVATION

 00.00
 PROPOSED FLOW LINE ELEVATION


00.00TSWPROPOSED TOP OF SCREEN WALL00.00TWPROPOSED TOP OF WALL00.00BWPROPOSED BOTTOM OF WALL

• 00.00 PROPOSED SPOT ELEVATION

DIRECTION OF FLOW

PROPOSED SWALE

PROPOSED 3:1 SLOPE

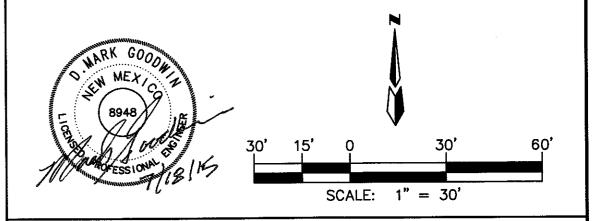

GARDEN/RETAINING WALL

A.I.S. RETAIL

SITE GRADING & DRAINAGE

MARK GOODWIN & ASSOCIATES, P.A. CONSULTING ENGINEERS

P.O. BOX 90606
ALBUQUERQUE, NEW MEXICO 87199
(505)828-2200, FAX (505)797-9539

Designed: KMK Drawn: KMK Checked: DMG
Scale: SEE SCALE Date: 11/30/14 Job: A12041 Sheet 7 of 4

### HYDROLOGY NOTES

THE TOTAL SITE IS BOUNDED BY 12TH STREET, INDIAN SCHOOL, MENAUL AND 9TH STREET AND CONSISTS OF 47.4 ACRES. THE PROJECT SITE IS PHASE 4 OF THE PROJECT SITE. THE FIRST 3 BEING THE BIA BUILDINGS PHASES 1 AND 2 AND IPFDC HOTEL (ALL PREPARED BY MARK GOODWIN & ASSOCIATES ON 6-11-03 AND 11-5-14 AND 10-5-06 RESPECTIVELY) THE DRAINAGE MANAGEMENT PLAN FOR ALL PHASES INCLUDES SOME DRAINAGE TO ADJACENT STREETS AND 2 LIFT STATIONS THAT PUMP THE RUNOFF TO THE EXISTING STORM DRAIN IN 9TH ST. LIFT STATION #1 WAS CONSTRUCED DURING PHASE 1. LIFT STATION #2 WILL BE CONSTRUCTED DURING THIS PHASE. THIS PLAN IS PHASE 4.


THE PROJECT SITE (PHASE 4) CONSISTS OF 3.46 ACRES. NO OFFISTE FLOWS ENTER THIS SITE. THE SITE IS NOT IN A 100YR FLOOD ZONE PER MAP 35001C00331D.

THE DEVELOPED FLOW FOR THIS ENTIRE SITE IS 14.23cfs. THE HYDROLOGY WAS CALCULATED PER COA DPM USING AHYMO. P≥=2.60" FROM NOAA 14. THE RESULTS ARE SUMMARIZED IN THE HYDROLOGY TABLE ON THIS SHEET.

PARTS OF THE PROJECT SITE ARE ALREADY DEVELOPED. THE DRAINAGE BASINS FROM THESE DEVELOPED SECTIONS WILL NOT BE CHANGED (BASINS 100.1-100.4). THE REMAINING RUNOFF (BASIN 100.5) WILL BE CAPTURED BY A TYPE "D" INLET IN SUMP CONDITION AND THEN CONVEYED BY A 12" GRAVITY LINE TO BASIN B. BASIN B WILL BE GRADED TO APPROXIMATE DEVELOPED GRADES.

THE PARKING LOT OF THE PROJECT SITE WILL ACT AS A DETENTION POND WITH WATER BEING RELEASED AT A RATE OF 1.60cfs TO THE LIFT STATION IN BASIN B.

LIFT STATION IS 10' DIAMETER INLETS ARE TYPE "D" LEAD PUMP TURNS ON AT 4955.00' LAG PUMP TURNS ON AT 4959.00' QMAX = 1.998cfs AT 2.35 hours MWSEL (BASIN A&B FULLY DEVELOPED)=4964.11'. TOTAL STORAGE = 1.16 ac-ft TIME TO DRAIN ENTIRE SITE AND LIFT STATION = 29 hours TIME TO REACH THE GRATES = 10.25 hours

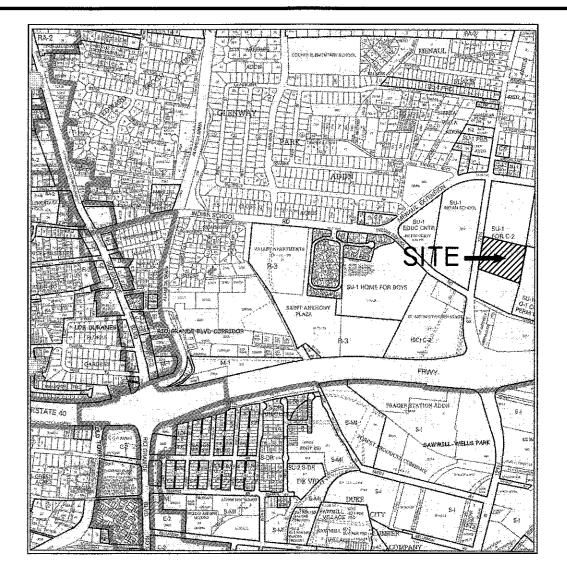

VICINITY MAP

ZONE ATLAS H-13-Z



#### BASIN DATA

BASIN	SUBBASIN	BASIN OUTLET	AREA (acres)	% LAND TREATMENT TYPES					
				Å	В	Ċ	D	Q (cfs)	Vol (ac-ft)
Onsite Basin A			3.46	0	0	12	88	14.23	0.63
	100.1	12th St.	0.12	0	0	0	100	0.53	0.02
	100.2	Existing Lift Station #1	0.25	0	0	14	86	1.05	0.05
	100.3	NE Corner	0.21	0	0	12	88	0.88	0.04
	100.4	12th St.	0.29	0	0	12	88	1.2	0.05
	100.5	New Sump Inlet	2.58	0	0	10	90	10.69	0.48
Basin B (Uneveloped)	existing	NEW Lift Station #2	9.63	0	0	90	10	21.88	0.68
Basin B (Developed)	future	NEW Lift Station #2	9.63	0	0	12	88	28.91	1.29
Basin A + Basin B (Undev)		NEW Lift Station #2	13.09	_	-	-	-	32.57	1.16

DUPLEX PUMP CONTROL PANEL NEMA I INDOOR RATED ENCLOSURE (TO BE RELOCATED BUILDING)

...... NEW 12" STORMDRAIN

36"x48" SINGLE ACCESS DOOR FROM FLYGT,
ALUMINUM WITH STAINLESS HARDWARE

ELEV. = 62.00

-8" CONCRETE TOP SLAB

W/ #5 AT 12" E.W. (TYP.)

2" DIA. VENT

-NEW 12" STORMDRAIN

-36"X48" ACCESS

DOOR FROM FLYGT

HEAVY DUTY WATERTIGHT

- NEW 10' DIA. TYPE "E" MH PER COA STANDARD DETAILS (EPOXY COAT).

PRECAST REINFORCED CONC. WALLS

-12" SD FROM BASIN B INV=57.89

-12" SD FROM BASIN A INV=53.30

SUBMERSIBLE DUPLEX PUMP

---ALARM = DISABLED

,LAG PUMP START 59.00

LEAD PUMP ON 55.00

PUMP OFF = 51.50

-BASE= 50.00

NP3153 15 HP 435 IMPELLER

# BASIN A POND VOLUMES

2-8" FLYGT FLEX CHECK VALVES MODEL 584

36"x36" SINGLE DOOR -VALVE VAULT ACCESS COVER ALUMINUM WITH

STAINLESS HARDWARE

FLANGED ENDS

304 STAINLESS GUIDE RAILS— TO BE SUPPLIED BY CONTRACTOR

BY PUMP MNFCR.

8"x8" DISCHARGE ELBOW -

ANCHOR BOLTS-----

STORM SEWER LIFT STATION #2

BY PUMP MNFCR.

SCALE: NONE

(BY OTHERS)

4'x4' CONCRETE VAULT

2-8" ISOLATION VALVES -

8" THICK W/ #5 EACH WAY (TYP.)

NON - METALIC GROUT (TYP.)

8" C-900 PVC

2-8" ADJUSTABLE SUPPORT (EACH SIDE)

SCALE: 1" = 100'

2-8" ISOLATION-

NEW 10' DIA. TYPE "E" MH PER CITY—OF ALBUQUERQUE DETAILS (EPOXY COAT).
PRECAST REINFORCED CONC. WALLS

			Surface	lner,	Total	Total
	Elev.	Area	Area	Volume	Volume	Volume
	(feet)	(SF)	(acres)	(acre ft.)	(acre ft.)	(cubic ft.)
	65	37,420.00	0.86	0.57	0.75	32,63
	64	14,082.00	0.32	0.16	0.18	7,82
	63	1,924.00	0.04	0.02	0.02	75
Pond Bottom = >	62	441.00	0.00			

### BASIN B POND VOLUMES

yanina ka ya ku ku karansana yi ku ku ka ka ka ka kanansan wan aman an ana a ka ka k	Elev.	Surface Area	Surface Area	Incr. Volume	Total Volume	Total Volume
Marie Marie Marie and a marie and a destruction of the Section of	(feet)	(sf)	(acres)	(acre ft.)	(acre ft.)	(cubic ft.)
	65	70,293.00	1.61	1.23	2.00	86,975
- 18 1 - 18 1 milh - 1 de 1 milh de maldre devidemen en minge en mercenne, que um use yan e	64	38,709.00	0.89	0.60	0.76	33,239
	63	15,517.00	0.36	0.16	0.16	6,988
Pond Bottom = >	62	1,211.00	0.03			

# $\triangle S T O R M D R A I N N O T E S$

A NEW TYPE DOUBLE "D" SD INLET PER COA DETAIL 2206 IN SUMF GRATE = 4962.00'INVERT = 4959.00'

A NEW 12" GRAVITY MAIN SDR PVC 35 LENGTH = 259' SLOPE = 1.00%

A NEW 4' DIA SD MH RIM = 4968.50INV(S) = 4956.40INV(N) = 4956.30

A NEW 12" GRAVITY MAIN SDR PVC 35 LENGTH = 339.00'SLOPE = 0.9%END INVERT = 4953.30'

⚠ NEW TYPE DOUBLE "D" SD INLET SUMP CONDITION GRATE = 4962.00'INVERT = 4958.00'

6 NEW 12" GRAVITY MAIN SDR PVC 35 LENGTH = 11.50SLOPE = 1.00%


# A.I.S. RETAIL

# OVERALL STORM DRAIN DESIGN

MARK GOODWIN & ASSOCIATES, P.A. CONSULTING ENGINEERS

P.O. BOX 90606 ALBUQUERQUE, NEW MEXICO 87199 (505)828-2200, FAX (505)797-9539

Designed: KMK Drawn: KMK Checked: DMG Scale: SEE SCALE Date: 11/30/14 Job: A12041

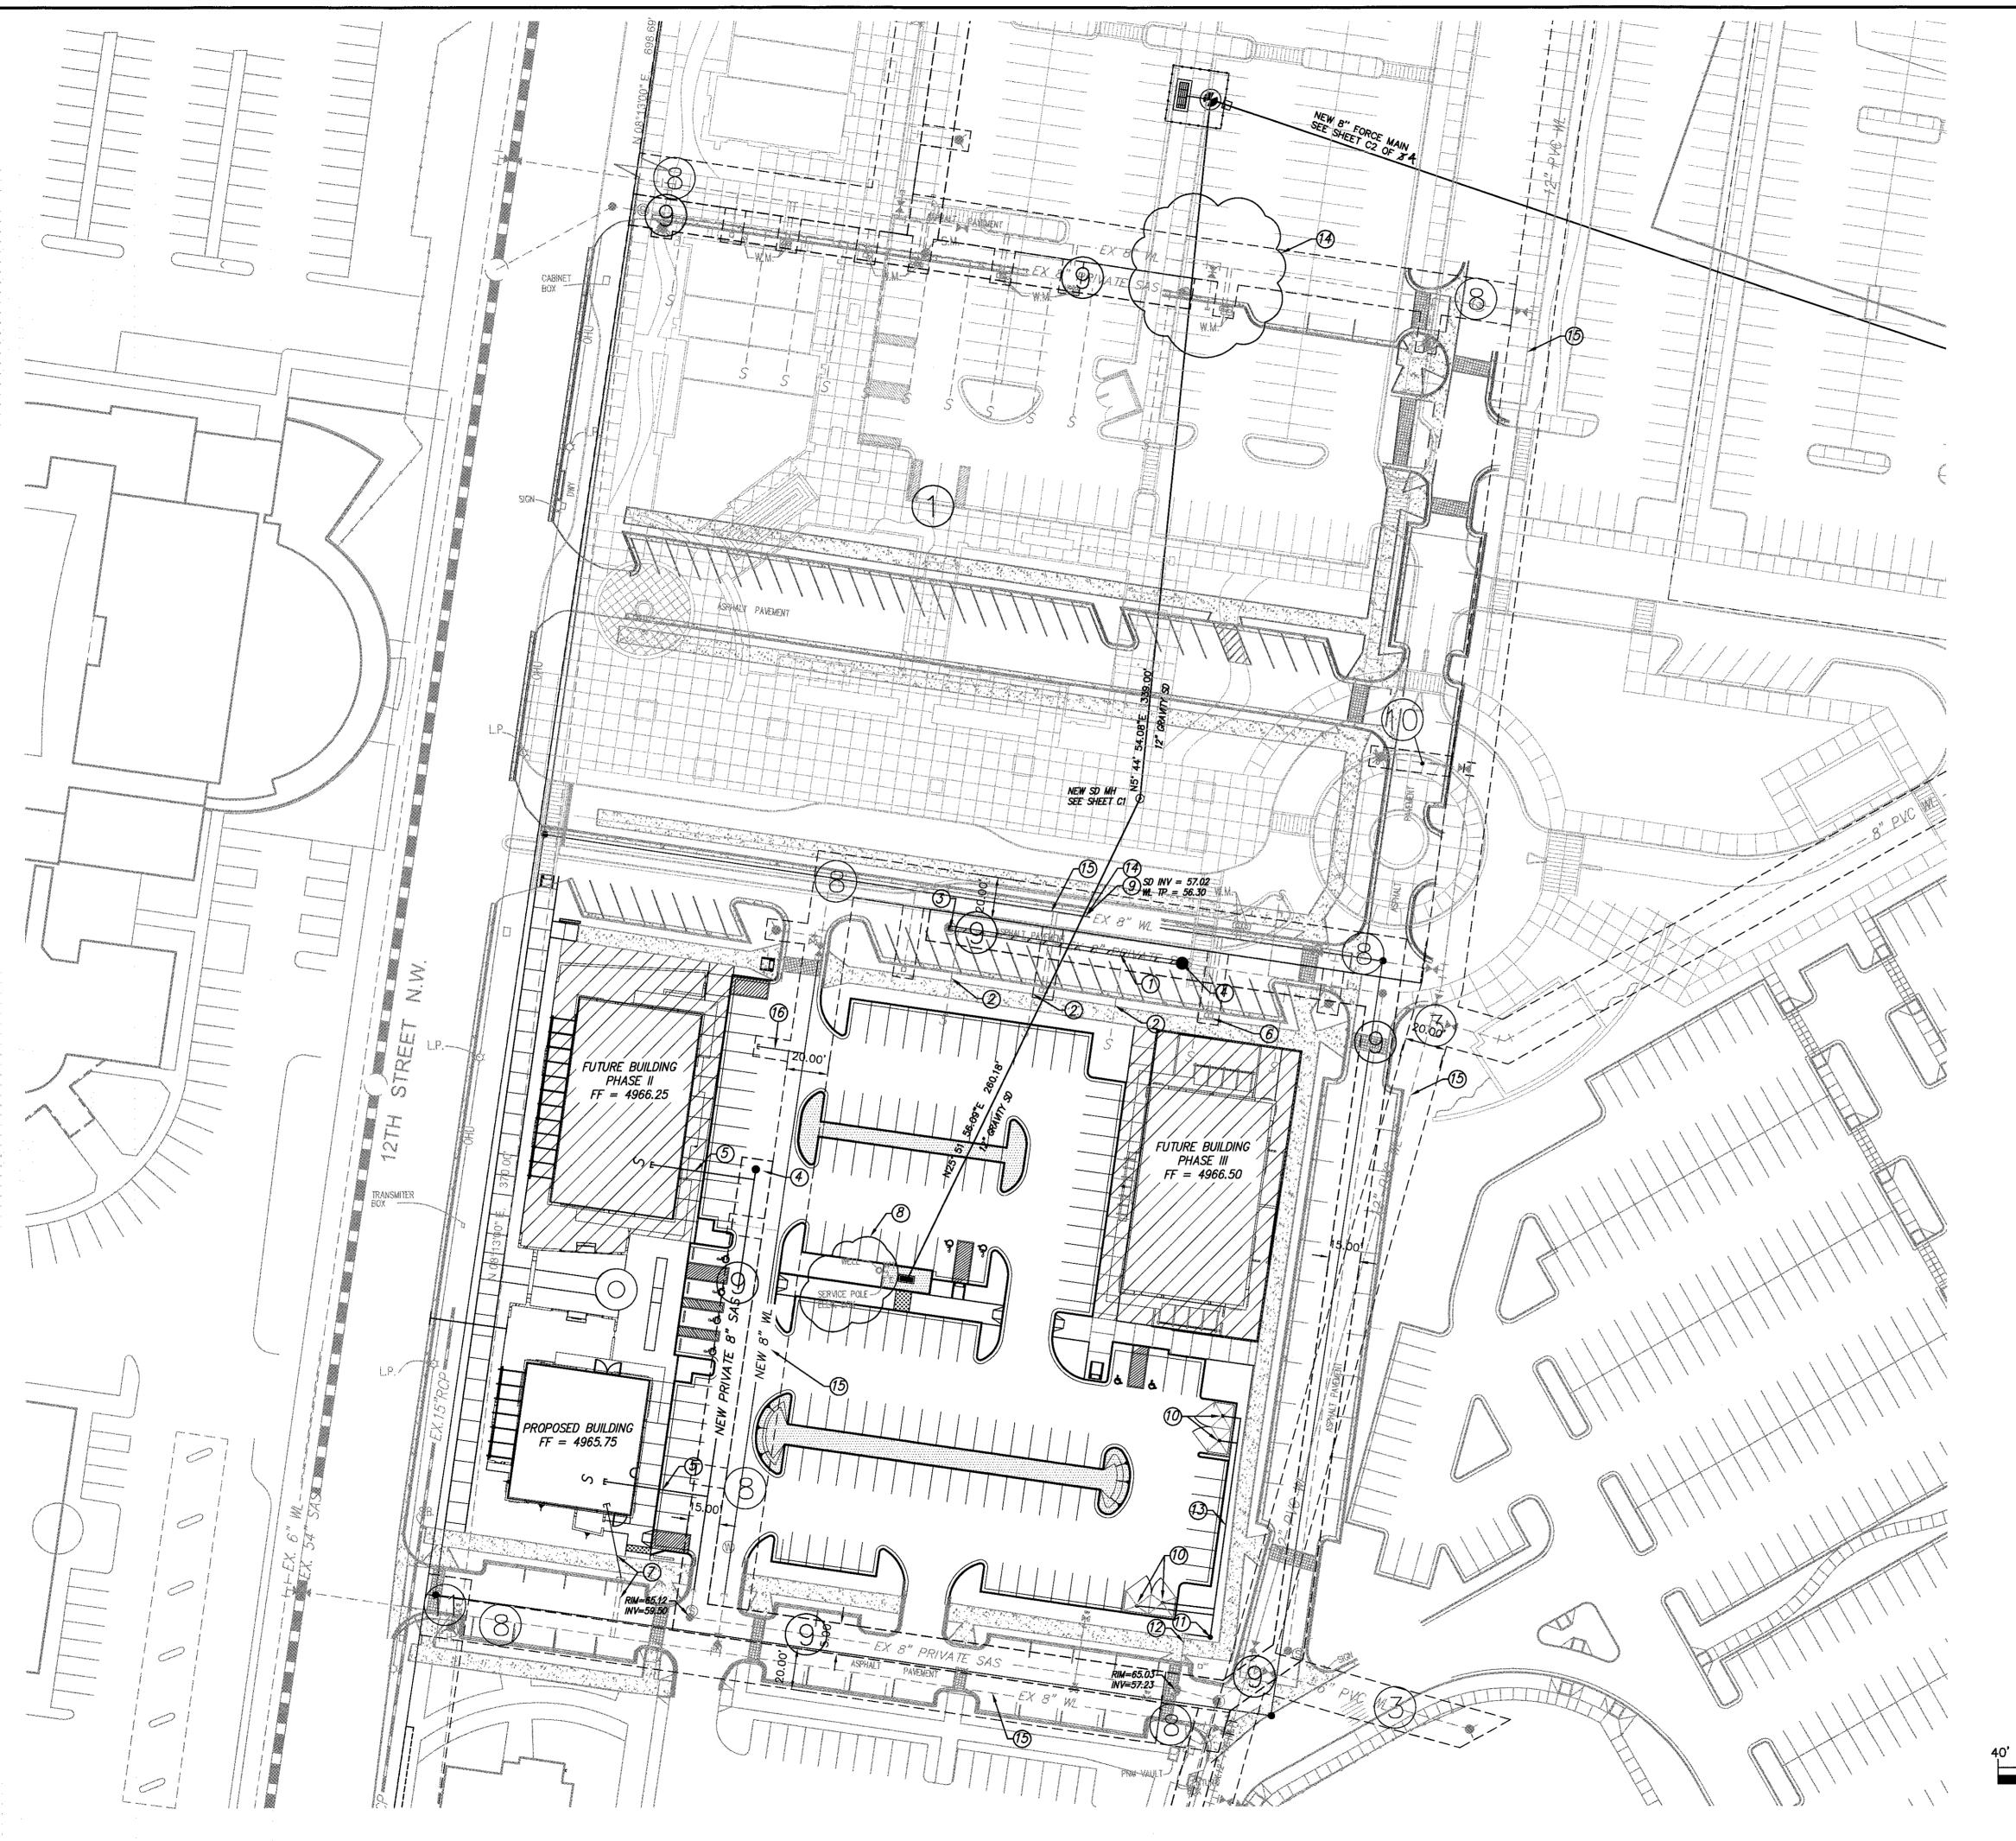

### GENERAL NOTES

- 1. FIELD VERIFY ALL EXISTING UTILITY ELEVATIONS PRIOR TO CONSTRUCTION.
- 2. CITY OF ALBUQUERQUE STANDARD DETAILS SHALL BE USED WHEN APPLICABLE.

## $\bigcirc \ \textit{KEYED} \quad \textit{UTILITY} \quad \textit{NOTES}$

- 1. FIELD VERIFY EXISTING 8"SAS LINE AND WL PRIOR TO CONSTRUCTION. REMOVE
- 2. FIELD VERIFY EXISTING SAS SERVICE LINE PRIOR TO CONSTRUCTION. REMOVE PER
- 3. REMOVE EXISTING SAS MANHOLE 4. INSTALL NEW SAS MANHOLE 5. INSTALL NEW SAS SERVICE.


- INSTALL NEW SAS SERVICE.
   EXISTING WATER SERVICE LINE TO REMAIN FOR FUTURE BUILDING.
   FIELD VERIFY EXISTING WATER SERVICE LINE AND METER PRIOR TO CONSTRUCTION.
   EXTEND NEW WATER SERVICE LINE TO BUILDING.
   RELOCATE/ABANDON EXISTING UTILITIES AS NEEDED.
   NEW STORM DRAIN AND EXISTING WATER LINE INTERSECTION. FIELD VERIFY WATER LINE TOP OF PIPE PRIOR TO CONSTRUCTION. ADJUST WL IF REQUIRED.
   INSTALL SAS SEWER DRAINS FOR REFUSE ENCLOSURE PER DETAIL

- 11. INSTALL GREASE TRAP
  12. FIELD VERIFY EXISTING SAS SERVICE CONNECTION PRIOR TO CONSTRUCTION.
- 13. NEW 4" SAS SERVICE LINE
- 14. CAUTION: FIELD VERIFY EXISTING UTILITES. CONTACT ENGINEER IF CONFLICT
- 15. PUBLIC ACCEPTANCE OF WL PENDING
- 16. NEW WATER SERVICE TO BE INSTALLED THIS PHASE FOR FUTURE BUILDING

### 


### (LARGE CIRCLES) SEE ALSO SHEET C4 OF 4

- 1 BLANKET COMCAST EASEMENT (09-08-2008, 2008099413)
- ② 10' PNM EASEMENT (05-08-2007, 2007068048)
- (3) 20' C.O.A. WATERLINE EASEMENT (07-01-2005, 2005095321)
- 4 20' C.O.A. WATERLINE EASEMENT (05–25–2004, 2004071228)
- (5) C.O.A. WATERLINE, SANITARY SEWER AND DRAINAGE EASEMENT (05-25-2004, 2004071228)
- 6 15' X 20' QWEST EASEMENT (05-25-2004, 2004071227)
- 7 C.O.A. ROADWAY EASEMENT (05-25-2004, 2004071226)
- 8 20' C.O.A. WATERLINE EASEMENT
- 9 15' PRIVATE SANITARY SEWER EASEMENT
- 10 10' C.O.A. WATERLINE EASEMENT 11 - C.O.A. SIDEWALK EASEMENT
- (2) C.O.A. WATERLINE EASEMENT

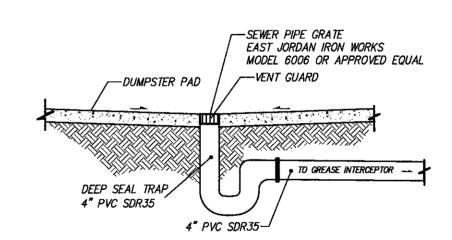



SANITARY SEWER DRAIN FOR REFUSE ENCLOSURE

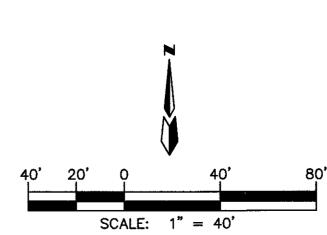

A.I.S. RETAIL

SITE UTILITY PLAN

MARK GOODWIN & ASSOCIATES, P.A. CONSULTING ENGINEERS

P.O. BOX 90606 ALBUQUERQUE, NEW MEXICO 87199 (505)828-2200, FAX (505)797-9539

Designed: KMK Drawn: KMK Checked: DMG Scale: SEE SCALE Date: 11/30/14 Job: A12041



1)- BLANKET COMCAST EASEMENT (09-08-2008, 2008099413)

(05-08-2007, 2007068048)

3 - 20' C.O.A. WATERLINE EASEMENT (07-01-2005, 2005095321)

4 - 20' C.O.A. WATERLINE EASEMENT (05-25-2004, 2004071228)

(5) - C.O.A. WATERLINE, SANITARY SEWER AND DRAINAGE I (05-25-2004, 2004071228)

6 - 15' X 20' QWEST EASEMENT (05-25-2004, 2004071227)

7 - C.O.A. ROADWAY EASEMENT (05-25-2004, 2004071226)


8 - 20' C.O.A. WATERLINE EASEMENT

9 - 15' PRIVATE SANITARY SEWER EASEMENT

10 - 10' C.O.A. WATERLINE EASEMENT

11 - C.O.A. SIDEWALK EASEMENT

2 - C.O.A. WATERLINE EASEMENT

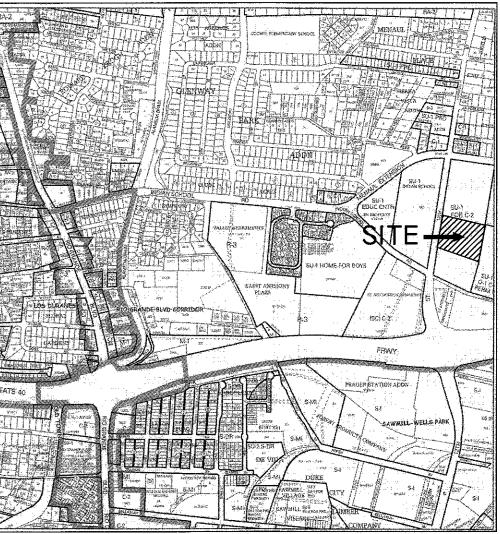

VICINITY MAP

TRACT A
RETAIL SITE
PROJECTED SECTIONS 7 & 8, T.10 N., R. 3 E., N.M.P.M
TOWN ON ALBUQUERQUE GRANT
CITY OF ALBUQUERQUE
BERNALILLO COUNTY, NEW MEXICO

ZONE ATLAS H-13-Z

BENCHMARK

SEE PLAT FOR BASIS OF BEARINGS AND SITE BENCHMARKS

LEGAL DESCRIPTION

TRACT "A'" OF THE PLAT FOR THE UNITED STATES BUREAU OF LAD MANAGEMENT SURVEY OF TOWN OF ALBUQUERQUE GRANT, PROJECTED SECTIONS 7 AND 8 TOWNSHIP 10 NORTH, RANGE 3 EAST NEW MEXICO PRINCIPAL MERIDAN, DATED AUGUST 12, 2011,



A.I.S. RETAIL

OVERALL UTILITY EASEMENTS

MARK GOOD P.O. BOX

MARK GOODWIN & ASSOCIATES, P.A. CONSULTING ENGINEERS

P.O. BOX 90606 ALBUQUERQUE, NEW MEXICO 87199 (505)828-2200, FAX (505)797-9539

Designed: KMK Drawn: KMK Checked: DMG
Scale: SEE SCALE Date: 11/30/14 Job: A12041