

CITY OF ALBUQUERQUE

Planning Department
Brennon Williams, Director



Mayor Timothy M. Keller

November 3, 2020

Reza Afaghpor, P.E.
SBS Construction and Engineering, LLC
10209 Snowflake Ct. NW
Albuquerque, NM 87114

RE: 2633 Floral Rd. NW
Revised Grading & Drainage Plan
Engineer's Certification Date: 11/03/20
Engineer's Stamp Date: 10/12/20
Hydrology File: H13D115

Dear Mr. Afaghpor:

PO Box 1293

Based upon the information provided in your submittal received 10/15/2020, the Revised Grading and Drainage Plan are approved for Building Permit and Building Pad Certification for 2633 Floral Rd. NW. Please attach a copy of this approved plan in the construction sets for Building Permit processing along with a copy of this letter.

Albuquerque

Prior to approval in support of Permanent Release of Occupancy by Hydrology, Engineer Certification per the DPM checklist will be required.

NM 87103

If you have any questions, please contact me at 924-3995 or rbrissette@cabq.gov.

www.cabq.gov

Sincerely,

Renée C. Brissette, P.E. CFM
Senior Engineer, Hydrology
Planning Department



City of Albuquerque

Planning Department
Development & Building Services Division

DRAINAGE AND TRANSPORTATION INFORMATION SHEET (REV 6/2018)

Project Title: 2633 FLORAL ROAD., NW Building Permit #: _____ Hydrology File #: H13D115
DRB#: _____ **EPC#:** _____ **Work Order#:** _____
Legal Description: TRACT 250A1A, MRGCD MAP 35
City Address: 2633 FLORAL ROAD., NW, ALBUQUERQUE, NM 87104

Applicant: SBS CONSTRUCTION AND ENGINEERING, LLC **Contact:** SHAWN BIAZAR
Address: 10209 SNOWFLAKE CT., NW, ALBUQUERQUE, NM 87114
Phone#: (505) 804-5013 **Fax#:** (505) 897-4996 **E-mail:** AECLLC@AOL.COM

Other Contact: _____ **Contact:** _____
Address: _____
Phone#: _____ **Fax#:** _____ **E-mail:** _____

TYPE OF DEVELOPMENT: _____ PLAT (# of lots) ☒ RESIDENCE _____ DRB SITE _____ ADMIN SITE

IS THIS A RESUBMITTAL? _____ Yes ☒ No

DEPARTMENT _____ TRANSPORTATION ☒ HYDROLOGY/DRAINAGE

Check all that Apply:

TYPE OF SUBMITTAL:

- ☐ ENGINEER/ARCHITECT CERTIFICATION
☒ PAD CERTIFICATION
☐ CONCEPTUAL G & D PLAN
☐ GRADING PLAN
☐ DRAINAGE REPORT
☐ DRAINAGE MASTER PLAN
☐ FLOODPLAIN DEVELOPMENT PERMIT APPLIC
☐ ELEVATION CERTIFICATE
☐ CLOMR/LOMR
☐ TRAFFIC CIRCULATION LAYOUT (TCL)
☐ TRAFFIC IMPACT STUDY (TIS)
☐ STREET LIGHT LAYOUT
☐ OTHER (SPECIFY) _____
☐ PRE-DESIGN MEETING?

TYPE OF APPROVAL/ACCEPTANCE SOUGHT:

- ☒ BUILDING PERMIT APPROVAL
☐ CERTIFICATE OF OCCUPANCY
☐ PRELIMINARY PLAT APPROVAL
☐ SITE PLAN FOR SUB'D APPROVAL
☐ SITE PLAN FOR BLDG. PERMIT APPROVAL
☐ FINAL PLAT APPROVAL
☐ SIA/ RELEASE OF FINANCIAL GUARANTEE
☐ FOUNDATION PERMIT APPROVAL
☐ GRADING PERMIT APPROVAL
☐ SO-19 APPROVAL
☐ PAVING PERMIT APPROVAL
☐ GRADING/ PAD CERTIFICATION
☐ WORK ORDER APPROVAL
☐ CLOMR/LOMR
☐ FLOODPLAIN DEVELOPMENT PERMIT
☐ OTHER (SPECIFY) _____

DATE SUBMITTED: 11-3-2020 **By:** SHAWN BIAZAR

COA STAFF:

ELECTRONIC SUBMITTAL RECEIVED: _____

FEE PAID: _____

Location
Tract 250A1A, MRGCD #35, is located at 2633 FLORAL, NW containing 0.4284 acre. See attached portion of Vicinity Map H-12-Z for exact location.

Purpose
The purpose of this drainage report is to present a grading and drainage solution for new buildings and improvement for Tract 250A1A, MRGCD #35.

Existing Drainage Conditions
This lot is very flat and drains south into Floral Road, Ave., NW and no other offsite flows enters this site. There are existing block walls all the way around this tract.

Proposed Conditions and On-Site Drainage Management Plan

There are existing block walls all three sides of this lot. We are proposing to retain all the developed flow minus the historical flow. The total volume requirement under this condition is 2,312.54 CF. We are proposing three ponds with total volume provided of 2,340.55 CF which includes the first final volume requirement of 260.84 CF.

VOLUME CALCULATIONS FOR 10 DAY STORM
(UNDER EXISTING CONDITIONS)

BASIN	AREA (SF)	AREA (AC)	AREA (MT ²)
ON-SITE	18,663.32	0.285	0.000689

$E = E(AA) + EB(AB) + EC(AC) + ED(AD)$
 $AA = AB + AC + AD$

$V-360 = E(AA + AB + AC + AD)$

EA = 0.35
EB = 0.78
EC = 1.13
ED = 2.12

AA = 100.00%
AB = 0.00%
AC = 0.00%
AD = 0.00%

P-60 = 2.01
P-360 = 2.35
P-1440 = 2.75
P-10 Day = 3.95

E = 0.5300 IN
V-360 = 0.0189 AC-FT
AD = 0.0000 AC
V-10 DAY = 0.0189 AC-FT
V-10 DAY = 824.30 CF

V (REQUIRED) = 3,136.84 - 824.30 = 2,312.54 CF

VOLUME CALCULATIONS FOR 10 DAY STORM
(UNDER PROPOSED CONDITIONS)

BASIN	AREA (SF)	AREA (AC)	AREA (MT ²)
ON-SITE	18,663.32	0.285	0.000689

$E = E(AA) + EB(AB) + EC(AC) + ED(AD)$
 $AA = AB + AC + AD$

$V-360 = E(AA + AB + AC + AD)$

EA = 0.35
EB = 0.78
EC = 1.13
ED = 2.12

AA = 0.00%
AB = 50.00%
AC = 9.00%
AD = 41.00%

P-60 = 2.01
P-360 = 2.35
P-1440 = 2.75
P-10 Day = 3.95

E = 1.3609 IN
V-360 = 0.0486 AC-FT
AD = 0.1757 AC
V-10 DAY = 0.0720 AC-FT
V-10 DAY = 3,136.84 CF

PONDING VOLUME REQUIREMENTS (90TH PERCENTILE/FIRST FLUSH)

VOLUME REQUIRED = 0.34 INCHES x IMPERVIOUS AREA =
(0.34/12 x 9,206.00) = 260.84 CF

PONDING VOLUME CALCULATION

TOTAL POND AREA PROVIDED =

PONDING CALCULATIONS:

POND A:
AREA @ ELEV. 60.10 = 2038.45 SF
AREA @ ELEV. 59.25 = 945.05 SF
POND VOLUME=(2038.45+945.05)/2*0.85=1267.99 CF

POND B:
AREA @ ELEV. 60.00 = 806.95 SF
AREA @ ELEV. 59.15 = 483.66 SF
POND VOLUME=(806.95+483.66)/2*0.85=640.43 CF


POND C:
AREA @ ELEV. 60.00 = 564.84 SF
AREA @ ELEV. 59.15 = 922.55 SF
POND VOLUME=(564.84+922.55)/2*0.85=632.15 CF

TOTAL PONDING VOLUME PROVIDED =
1267.99 + 640.43 + 632.15 = 2,440.56 CF

DRAINAGE CERTIFICATION

I, REZA AFAGHPOUR, LICENSED PROFESSIONAL ENGINEER, HEREBY CERTIFY THAT THIS PROJECT HAS BEEN GRADDED AND WILL DRAIN IN SUBSTANTIAL COMPLIANCE WITH AND IN ACCORDANCE WITH THE DESIGN INTENT OF THE APPROVED PLAN DATED 02-20-2020. I HAVE REVIEWED THE RECORD INFORMATION ENTERED ONTO THE ORIGINAL DESIGN DOCUMENT HAS BEEN OBTAINED BY ME OR MY DELEGATED ASSISTANT, OF SBS CONSTRUCTION AND ENGINEERING, L.L.C. I HAVE CONDUCTED A VISUAL INSPECTION OF THE SURVEY DATA PROVIDED IS REPRESENTATIVE OF ACTUAL SITE CONDITIONS AND IS TRUE AND CORRECT TO THE BEST OF MY KNOWLEDGE AND BELIEF. THIS CERTIFICATION IS SUBMITTED IN SUPPORT OF A REQUEST FOR P.D. CERTIFICATION.


THE RECORD INFORMATION PRESENTED HEREON IS NOT NECESSARILY COMPLETE AND INTENDED ONLY TO VERIFY SUBSTANTIAL COMPLIANCE OF THE GRADING AND DRAINAGE ASPECTS OF THIS PROJECT. THOSE RELYING ON THIS RECORD DOCUMENT ARE ADVISED TO OBTAIN INDEPENDENT VERIFICATION OF ITS ACCURACY BEFORE USING IT FOR ANY OTHER PURPOSE.

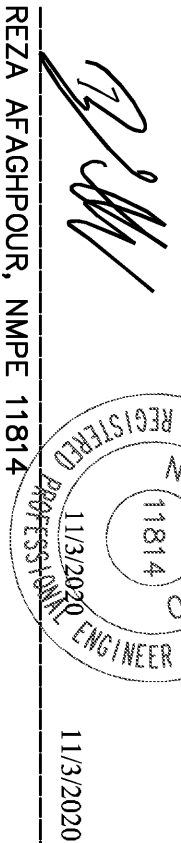



REZA AFAGHPOUR, NMPE 11814

11/3/2020

DATE

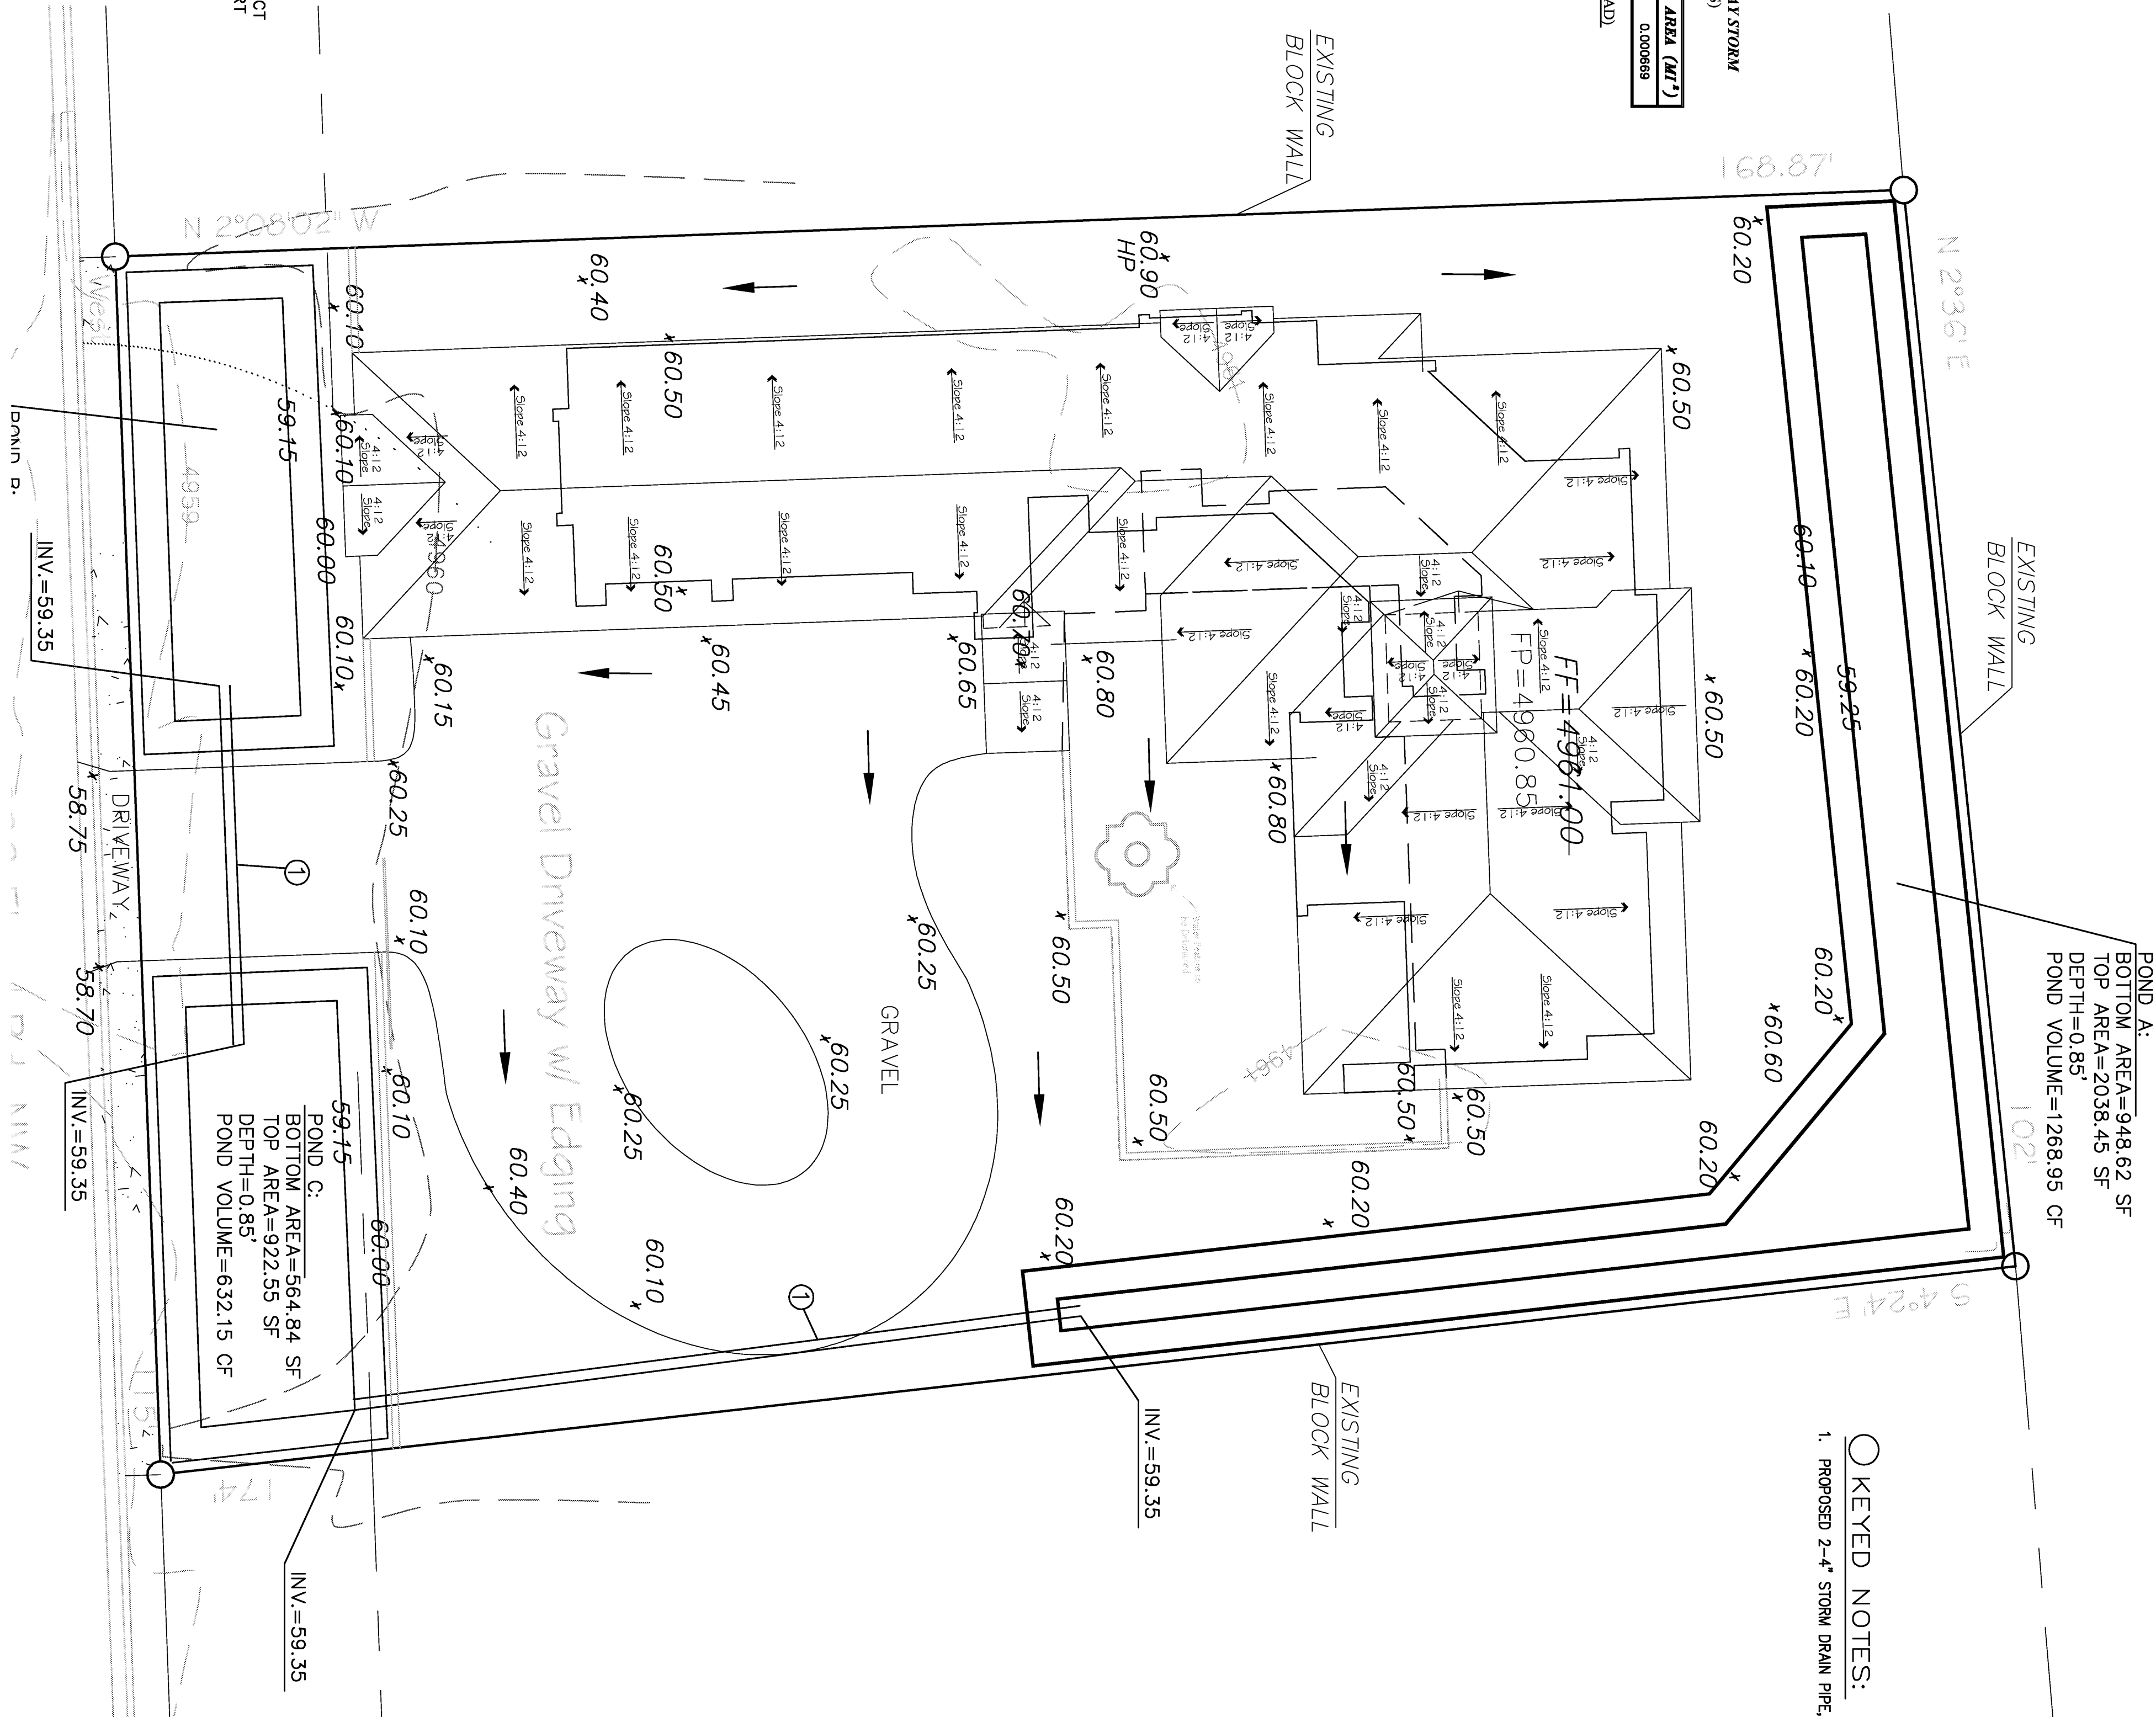

- KEYED NOTES:**
- PROPOSED 2-4" STORM DRAIN PIPE, SCHEDULE 40.

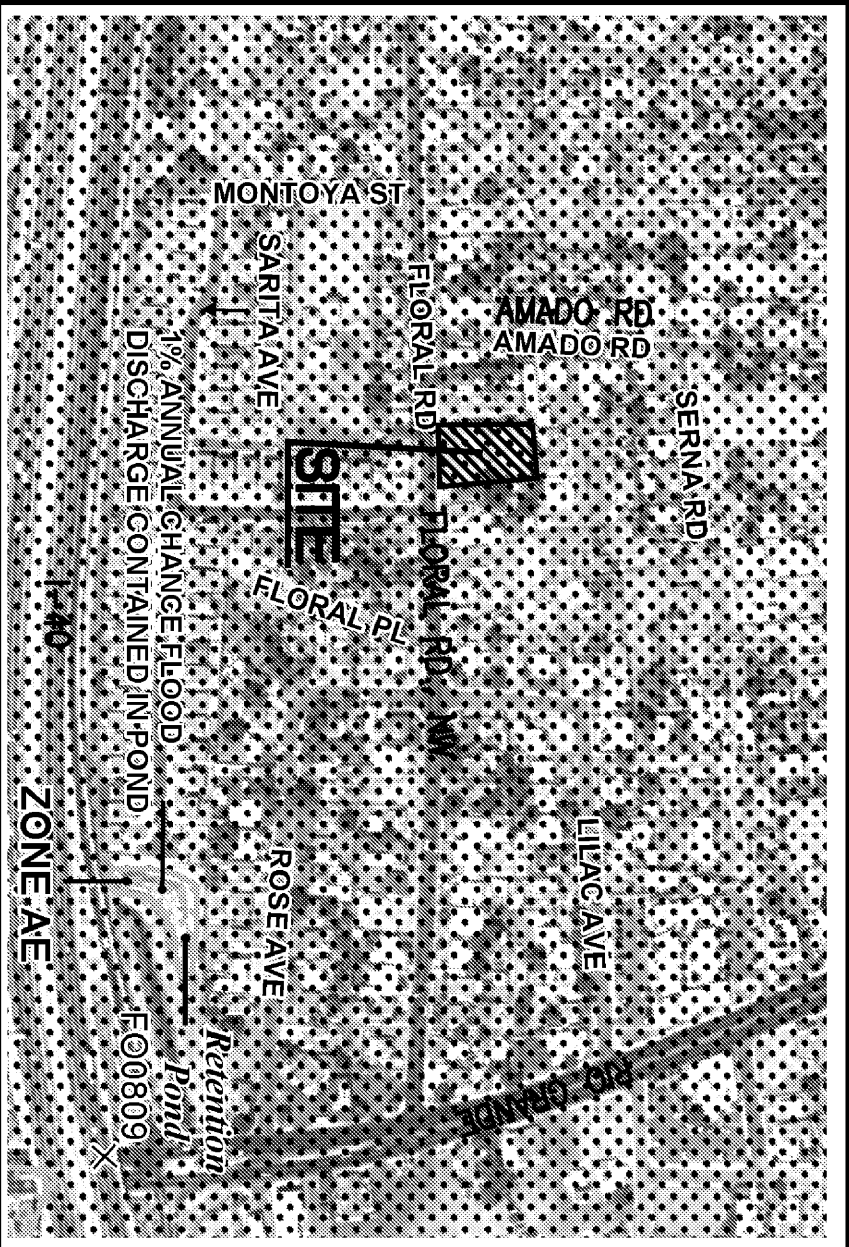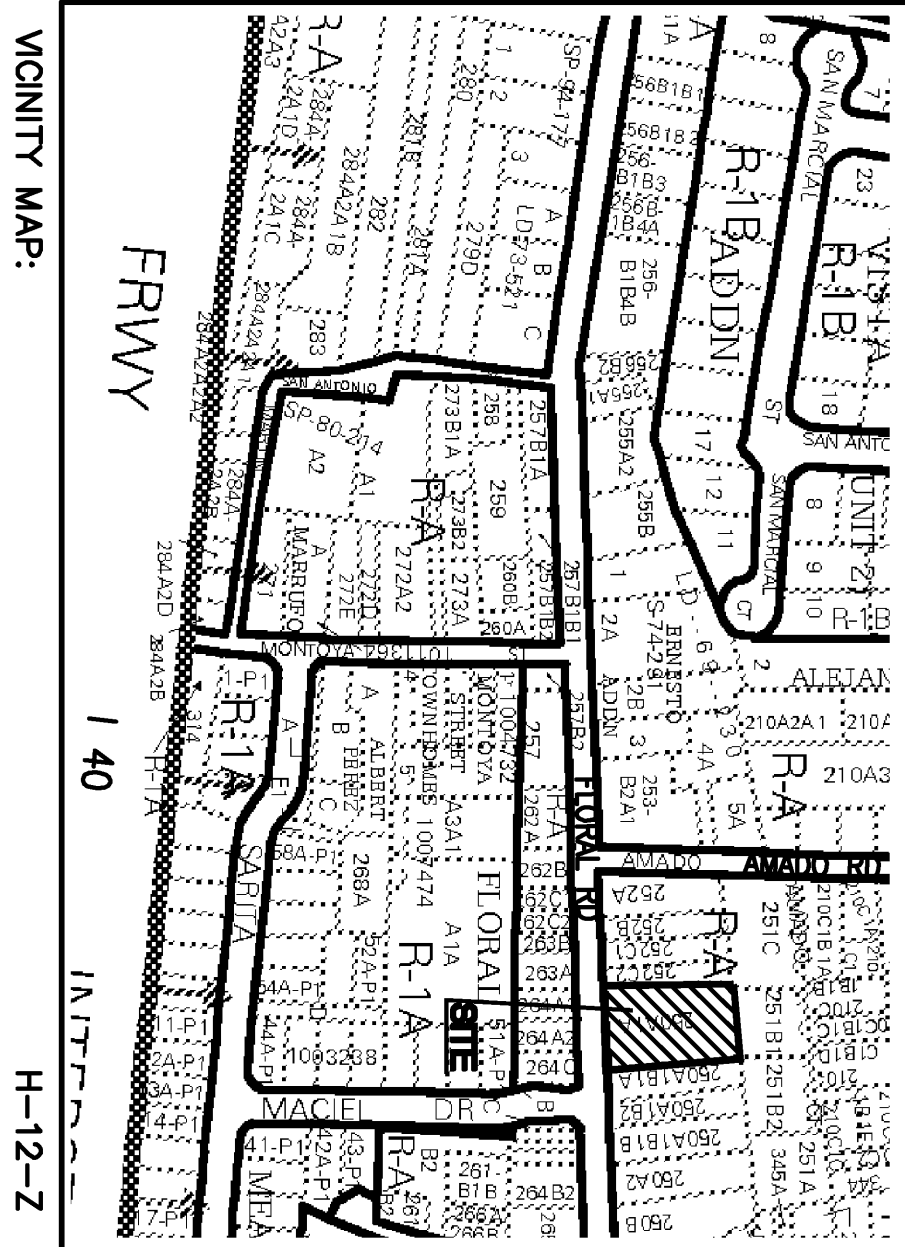


LEGAL DESCRIPTION:
Tract 250A1A, MRGCD #35
ADDRESS: 2633 FLORAL, NW

LEGEND

- 5030 --- EXISTING CONTOUR (MAJOR)
- 5029 --- EXISTING CONTOUR (MINOR)
- BOUNDARY LINE
- X 42.70 PROPOSED SPOT ELEVATION
- X 5029.16 EXISTING GRADE
- X 5075.65 EXISTING FLOWLINE ELEVATION
- FL
- ■ ■ ■ ■ PROPOSED RETAINING WALL
- BC=41.30 BOTTOM OF CHANEL
- TF=42.00 TOP OF FOOTING
- TRW=45.12 TOP OF RETAINING WALL
- HP HIGH POINT
- 42.40 AS-BUILT GRADES
- 69.77 AS-BUILT SPOT ELEVATIONS
- FF=5142.25

**SBS CONSTRUCTION
AND ENGINEERING, LLC**

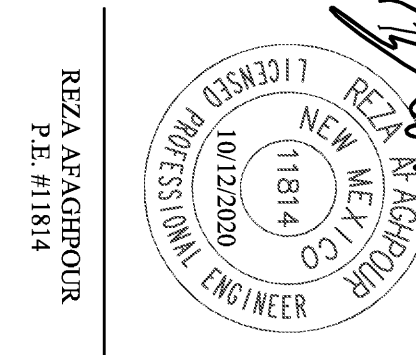

REZA AFAGHPOUR
P.E. #11814

1020 SNOOK LAKE CT, NW
ALBUQUERQUE, NEW MEXICO 87114
(505)995-5570

GRAPHIC SCALE
10 5 0 10
SCALE: 1"=10'

**2633 FLORAL ROAD, NW
GRADING PLAN**

DRAWING:	DRAWN BY:	DATE:	SHEET #
201803-GDWG	SH-B	3-6-2018	1