CITY OF ALBUQUERQUE



September 30, 2019

Jeremy Shelton, PE, RA Dekker/Perich/Sabatini 7601 Jefferson NE, Suite 100 Albuquerque, NM 87109

ABC Vocational Training Facility Addn. Re:

2821 Broadway Blvd NE

Request for Certificate of Occupancy

Transportation Development Final Inspection

Engineer's/Architect's Stamp dated 10-24-18(DRB) (H14D001B)

Certification dated 9-12-19

Dear Mr. Shelton,

Based upon the information provided in your pictures received 9-26-19, Transportation Development has no objection to the issuance of a Permanent Certificate of

Occupancy. This letter serves as a "green tag" from Transportation Development for a Permanent Certificate of Occupancy to be issued by the Building and Safety Division.

If you have any questions, please contact Ernie Gomez at (505) 924-3981.

Albuquerque

PO Box 1293

Sincerely,

NM 87103

Ernest Armijo, P.E.

Senior Engineer, Planning Dept. **Development Review Services**

www.cabq.gov

Ernie Gomez


Plan Checker, Planning Dept. **Development Review Services**

EG

via: email

C:

CO Clerk, File

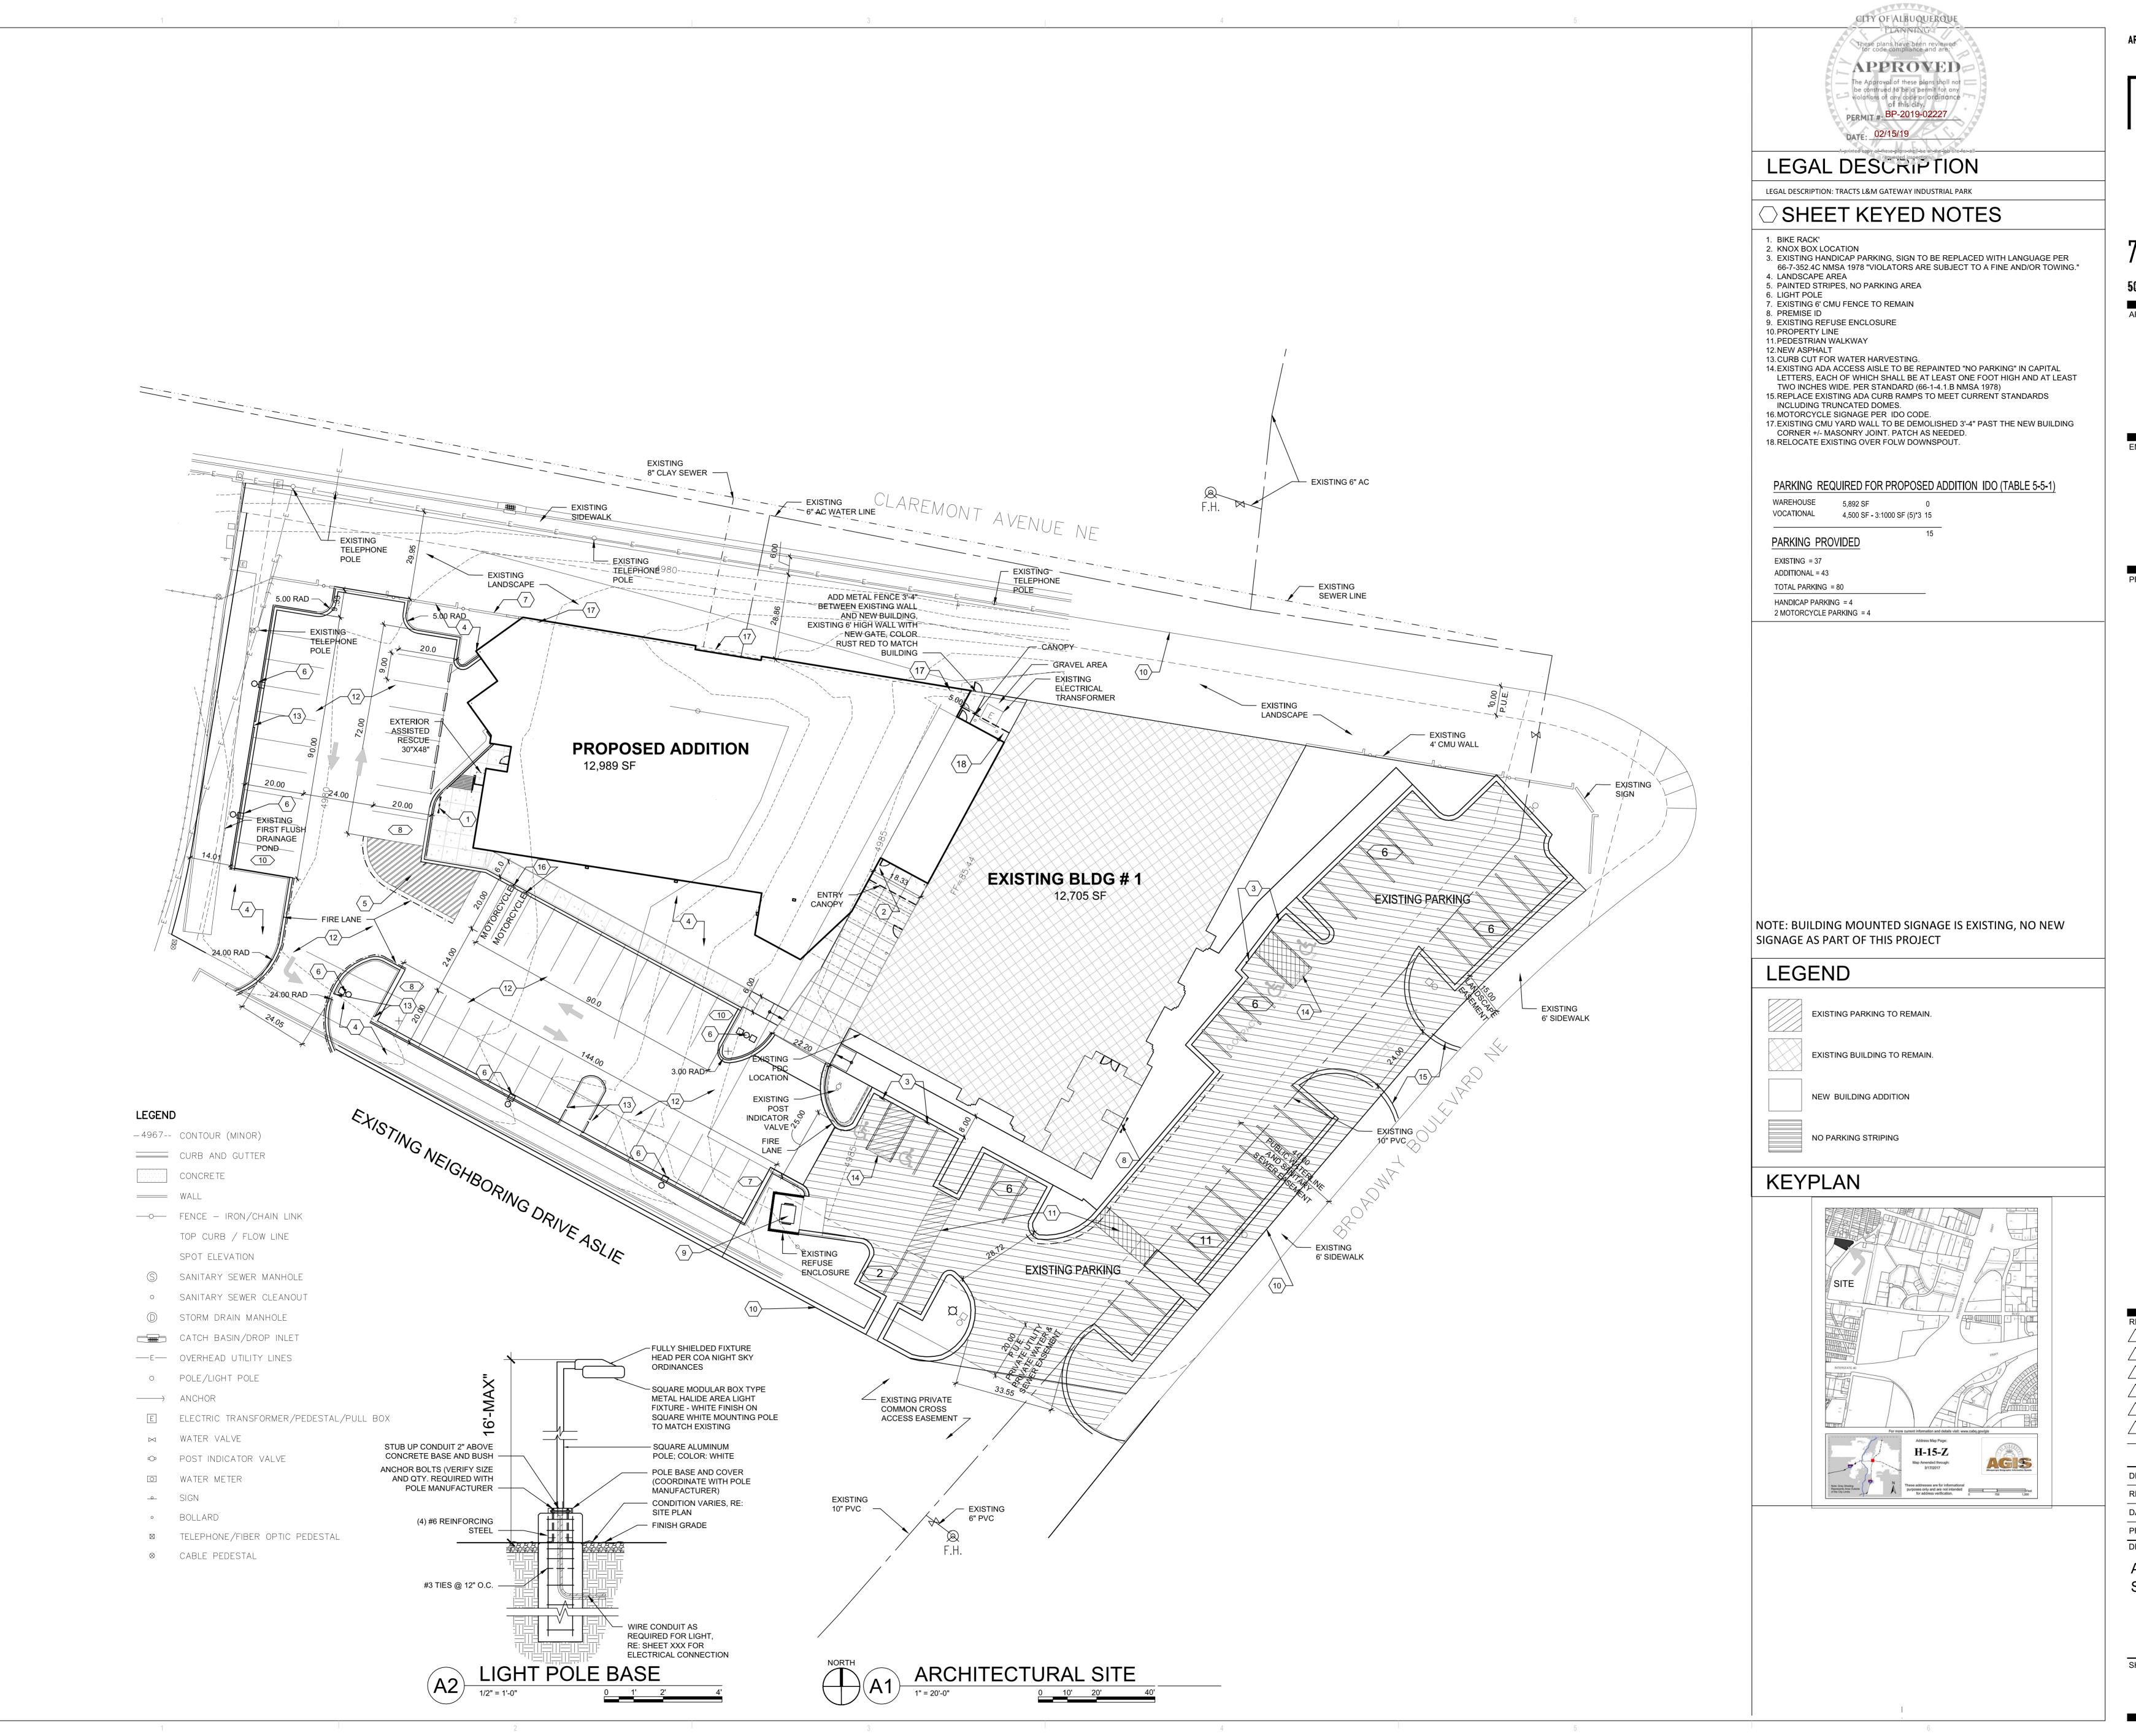


ARCHITECTURE / DESIGN / INSPIRATION

DEKKER PERICH SABATINI

7601 JEFFERSON NE, SUITE 100 ALBUQUERQUE, NM 87109

505.761.9700 / DPSDESIGN.ORG

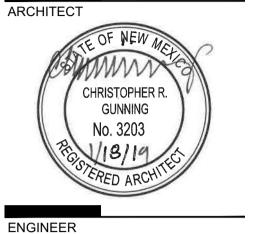

ROJECT

ABC VOCATIONAL
TRAINING FACILITY ADDITION
2821 BROADWAY BLVD NE
ALBUQUERQUE NM

DRAWN BY

REVIEWED BY


DATE 01 17/2019

PROJECT NO. 18-0057.001
DRAWING NAME

ARCHITECTURAL SITE PLAN

SHEET NO.

AS101

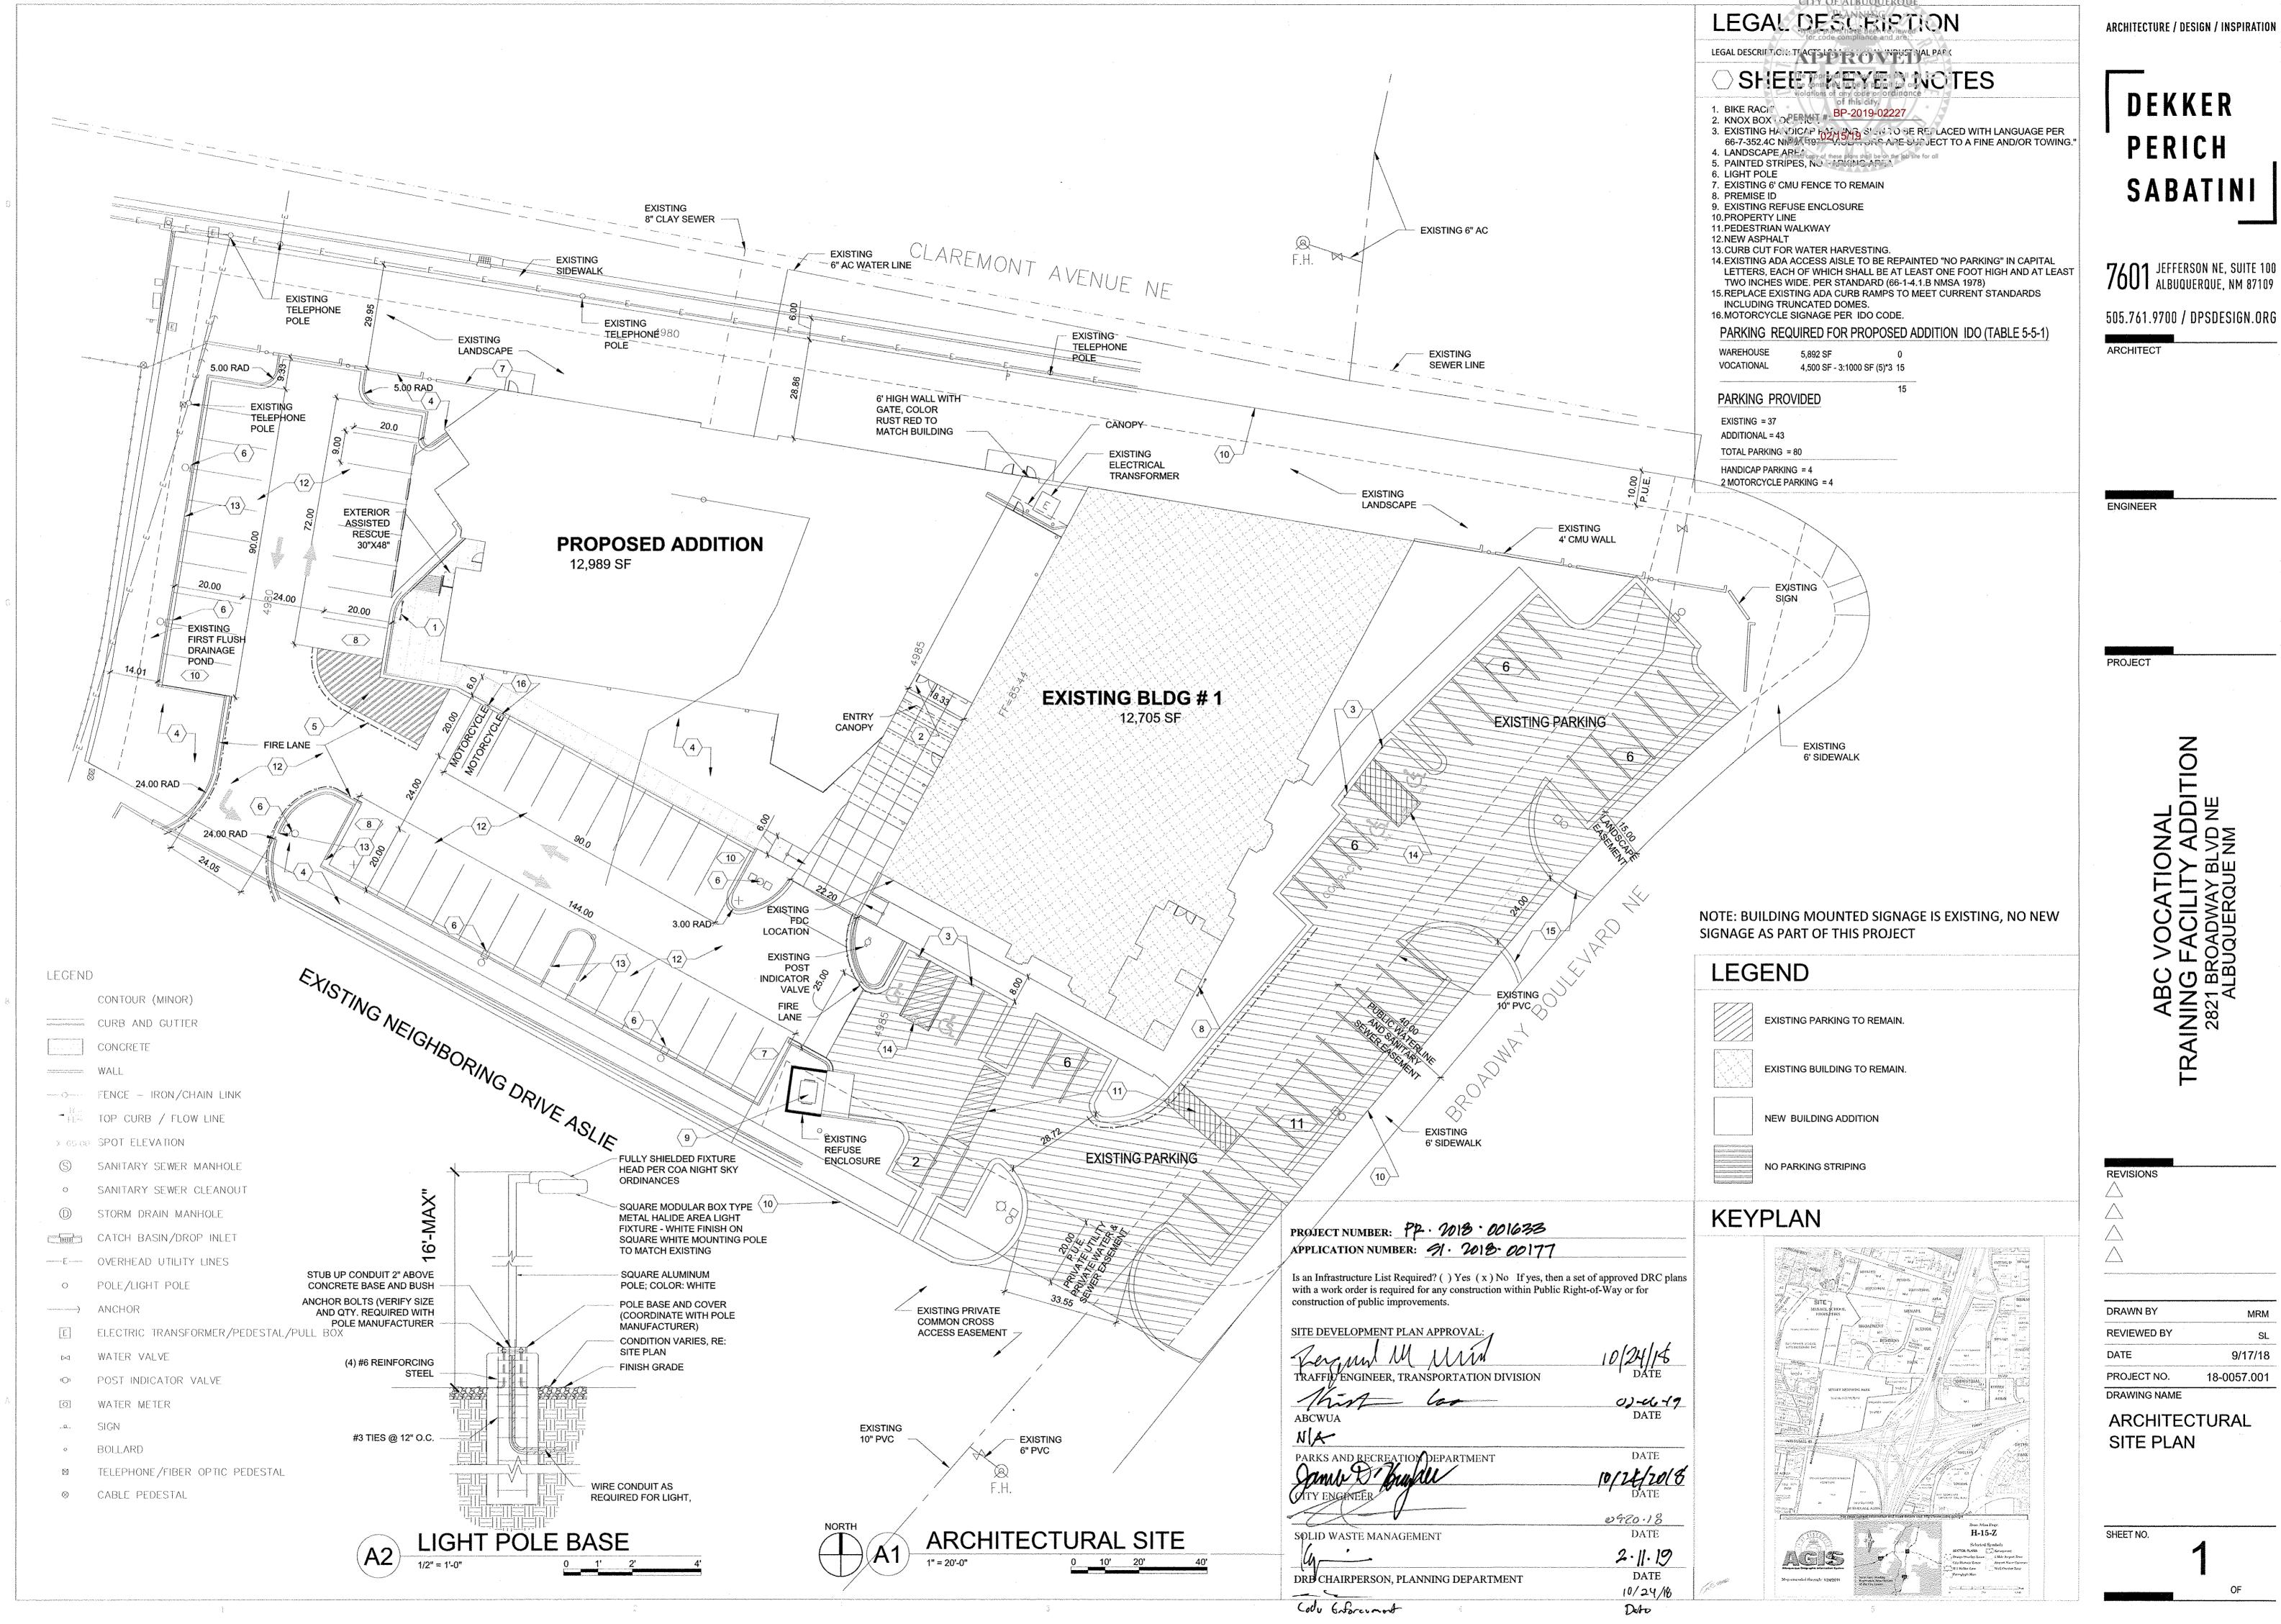

9/17/18

September 12, 2019

DEKKER PERICH SABATINI

Traffic Engineer
City of Albuquerque
Transportation Development Coordination
600 2nd Street NW
Albuquerque, New Mexico 87102

RE: ABC Vocational Training Facility Addition
2821 Broadway Blvd. NE, Albuquerque, NM 87107
Total Acreage – 2.5
Zone – CABQ INTEGRATED DEVELOPMENT ORDINANCE (IDO):
VOCATIONAL SCHOOL
Submittal - TCL for Certificate of Occupancy

To Whom It May Concern:

I, Jeremy Shelton, NMRA no. 4187 of the firm Dekker/Perich/Sabatini, respectfully request approval of the attached Traffic Circulation Plan dated 9-12-19 for Certificate of Occupancy. Attached is a copy of the site plan that was inserted into the Building Permit sets for review by the City of Albuquerque.

The information presented hereon is not necessarily complete and intended only to verify substantial compliance of the traffic aspects of this project. Those relying on record document are advised to obtain independent verification of its accuracy before using it for any other purpose.

If you have any questions, please feel free to contact myself or Scott Leonard at 761-9700, thank you.

Very truly yours,

Jeremy Shelton, AIA, CSI, LEED AP Principal / Architect

