CITY OF ALBUQUERQUE

Planning Department Alan Varela, Director



Mayor Timothy M. Keller

January 30, 2024

Rafael Rodriguez Rodriguez Design 2408 Venetian Way SW Albuquerque, NM 87105

Re: Storage Building 1905 8th St NW

Traffic Circulation Layout

Architect's Stamp 03-29-23 (H14-D078)

Dear Mr. Rodriguez,

Based upon the information provided in your submittal received 01-22-24, the above referenced plan cannot be approved for Building Permit until the following comments are addressed:

1. List the number of parking spaces required by the IDO as well as the proposed number of parking spaces including bicycle and motorcycle parking.

PO Box 1293

- Identify all existing access easements and rights of way width dimensions.
- 3. Identify the right of way width, medians, curb cuts, and street widths on 8TH St.


Albuquerque

- 4. 5 ft. wide sidewalk must be developed from property line to property line off 8TH St. for sidewalk waiver, please contact Ernest Armijo at earmijo@cabg.gov (505)924-3991.
- 5. Sidewalk along streets should be placed at the property line.

NM 87103

6. When sidewalk constructed, please ensure to provide 4 ft. wide pathway around the existing power pole. See attached city requirements.

www.cabq.gov

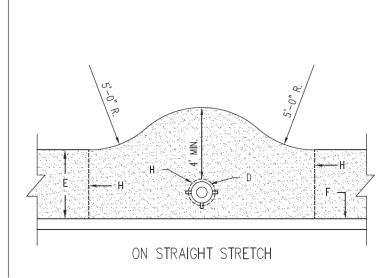


CITY OF ALBUQUERO

Planning Department Alan Varela, Director



Mayor Timothy M. Keller

- 7. Due to proposing a gate, please show on the site plan 20 ft. distance from the face of the curb to the proposing gate.
- 8. Please show on the site plan the building main entrance.
- 9. The ADA accessible spaces must include an access aisle. Van accessible aisles should be 8ft wide: all others should be 5ft wide.
- The ADA access aisles shall have the words "NO PARKING" in capital letters, each of which shall be at least one foot high and at least two inches wide, placed at the rear of the parking space so as to be close to where an adjacent vehicle's rear tire would be placed. (66-1-4.1. B NMSA 1978)
- Please place the ADA parking aisle adjacent to the 7 ft. wide pathway to provide efficient and safe ADA pathway.

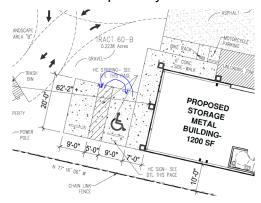

PO Box 1293

Albuquerque

NM 87103

- motorcycles entering the parking space.
- 13. Provide a copy of Fire Marshal and Solid Waste approval.
- 14. Show the clear sight triangle on the site plan.
- 15. Please specify the City Standard Drawing Number when applicable.
- Provide notes showing what work is included and on the work order and the private work 16. on site.

12. The pavement marking "MC" should be shown in the opposite direction for

- Traffic Studies: See the Traffic Impact Study (TIS) thresholds. In general, a minimum combination of 100 vehicles entering and exiting in the peak hour warrants a Traffic Impact Study. Visit with Traffic Engineer for determination, and fill out a TIS Form that states whether one is warranted. In some cases, a trip generation may be requested for determination (Contact Matt Grush: mgrush@cabq.gov).
 - 18. Please provide a letter of response for all comments given.

Once corrections are complete resubmit

- 1. The Traffic Circulation Layout
- 2. A Drainage Transportation Information Sheet (DTIS)
- 3. Send an electronic copy of your submittal to PLNDRS@cabq.gov.

www.cabq.gov

CITY OF ALBUQUERQUE

Planning Department Alan Varela, Director



Mayor Timothy M. Keller

4. The \$75 re-submittal fee.

for log in and evaluation by Transportation.

If you have any questions, please contact me at (505) 924-3675.

Sincerely,

Marwa Al-najjar

Marwa Al-najjar Associate Engineer, Planning Dept. Development Review Services

PO Box 1293 \ma via: email

C: CO Clerk, File

Albuquerque

NM 87103

www.cabq.gov



City of Albuquerque

Planning Department

Development & Building Services Division

DRAINAGE AND TRANSPORTATION INFORMATION SHEET

BP-2023-Project Title: 8th St NW Storage Building Permit # 17440 Hydrology File #_____ EPC# Legal Description: Tr 60-B, MRGCD MAP 36 City Address OR Parcel 1905 8TH ST NW Applicant/Agent: RAFAEL RODRIGUEZ Contact: RAFAEL Address: 2408 YENETIAN WAY SW Phone: (505) 203-8456 Email: Phomedesignse apl. Applicant/Owner: Luis A. PANDO Contact: Luis Address: 2520 Evita way sw 87121 Phone: (505) 322-5226
Email: Abg. automaticgates egmail.com TYPE OF DEVELOPMENT: __PLAT (#of lots) RESIDENCE DRB SITE ADMIN SITE: RE-SUBMITTAL: ____YES ____NO **DEPARTMENT:** __X_TRANSPORTATION _____ HYDROLOGY/DRAINAGE Check all that apply: TYPE OF SUBMITTAL: TYPE OF APPROVAL/ACCEPTANCE SOUGHT: ENGINEER/ARCHITECT CERTIFICATION **BUILDING PERMIT APPROVAL** PAD CERTIFICATION CERTIFICATE OF OCCUPANCY CONCEPTUAL TCL DRB APPROVAL CONCEPTUAL G&D PLAN **GRADING PLAN** PRELIMINARY PLAT APPROVAL SITE PLAN FOR SUB'D APPROVAL DRAINAGE REPORT SITE PLAN FOR BLDG PERMIT APPROVAL DRAINAGE MASTER PLAN FLOOD PLAN DEVELOPMENT PERMIT APP. FINAL PLAT APPROVAL SIA/RELEASE OF FINANCIAL GUARANTEE **ELEVATION CERTIFICATE** CLOMR/LOMR FOUNDATION PERMIT APPROVAL X TRAFFIC CIRCULATION LAYOUT (TCL) GRADING PERMIT APPROVAL SO-19 APPROVAL **ADMINISTRATIVE**

PAVING PERMIT APPROVAL
GRADING PAD CERTIFICATION

WORK ORDER APPROVAL

OTHER (SPECIFY)

FLOOD PLAN DEVELOPMENT PERMIT

CLOMR/LOMR

DATE SUBMITTED: 1-19-2024


* TRAFFIC CIRCULATION LAYOUT FOR DRB


TRAFFIC IMPACT STUDY (TIS)


STREET LIGHT LAYOUT


OTHER (SPECIFY)
PRE-DESIGN MEETING?

APPROVAL

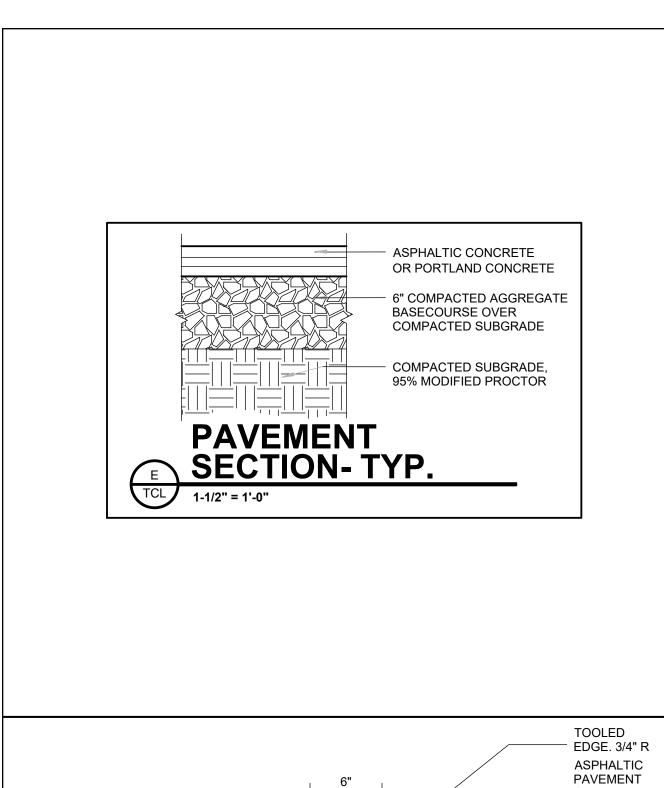

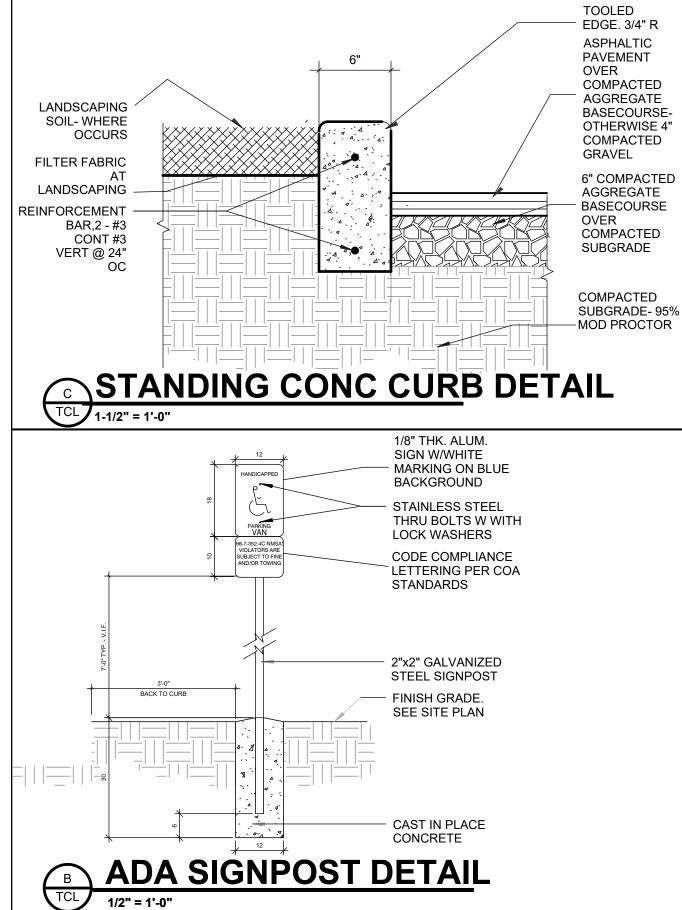

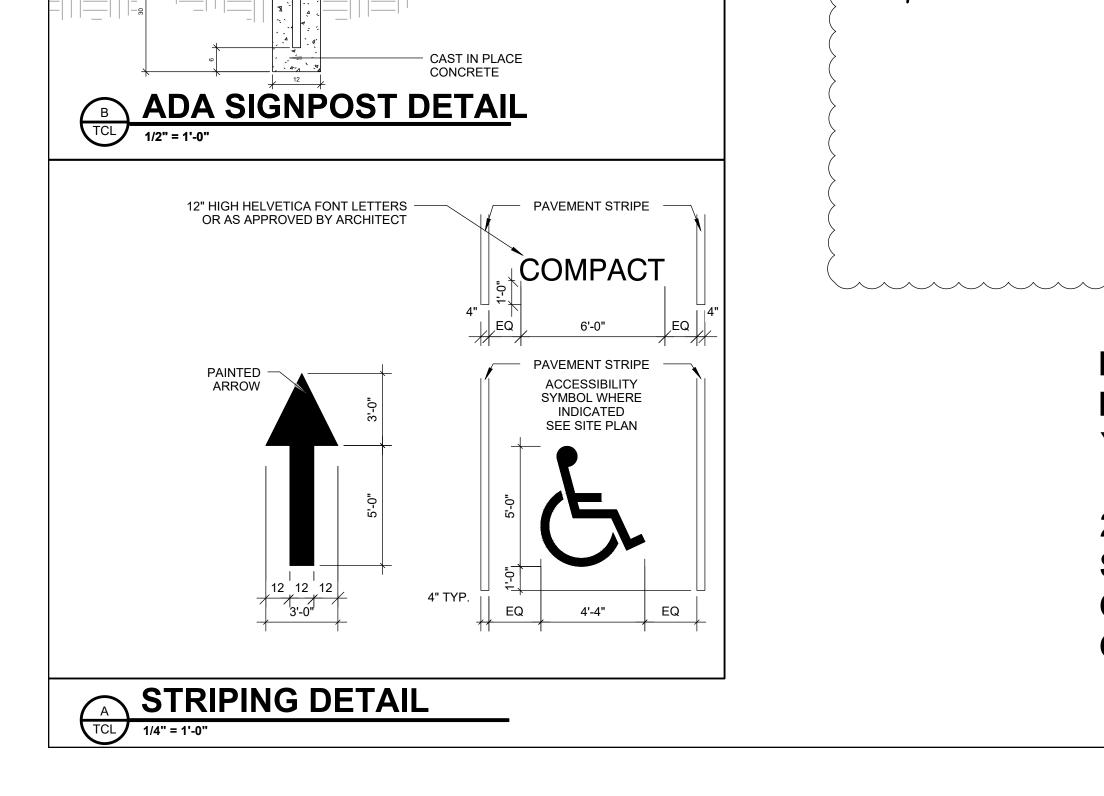

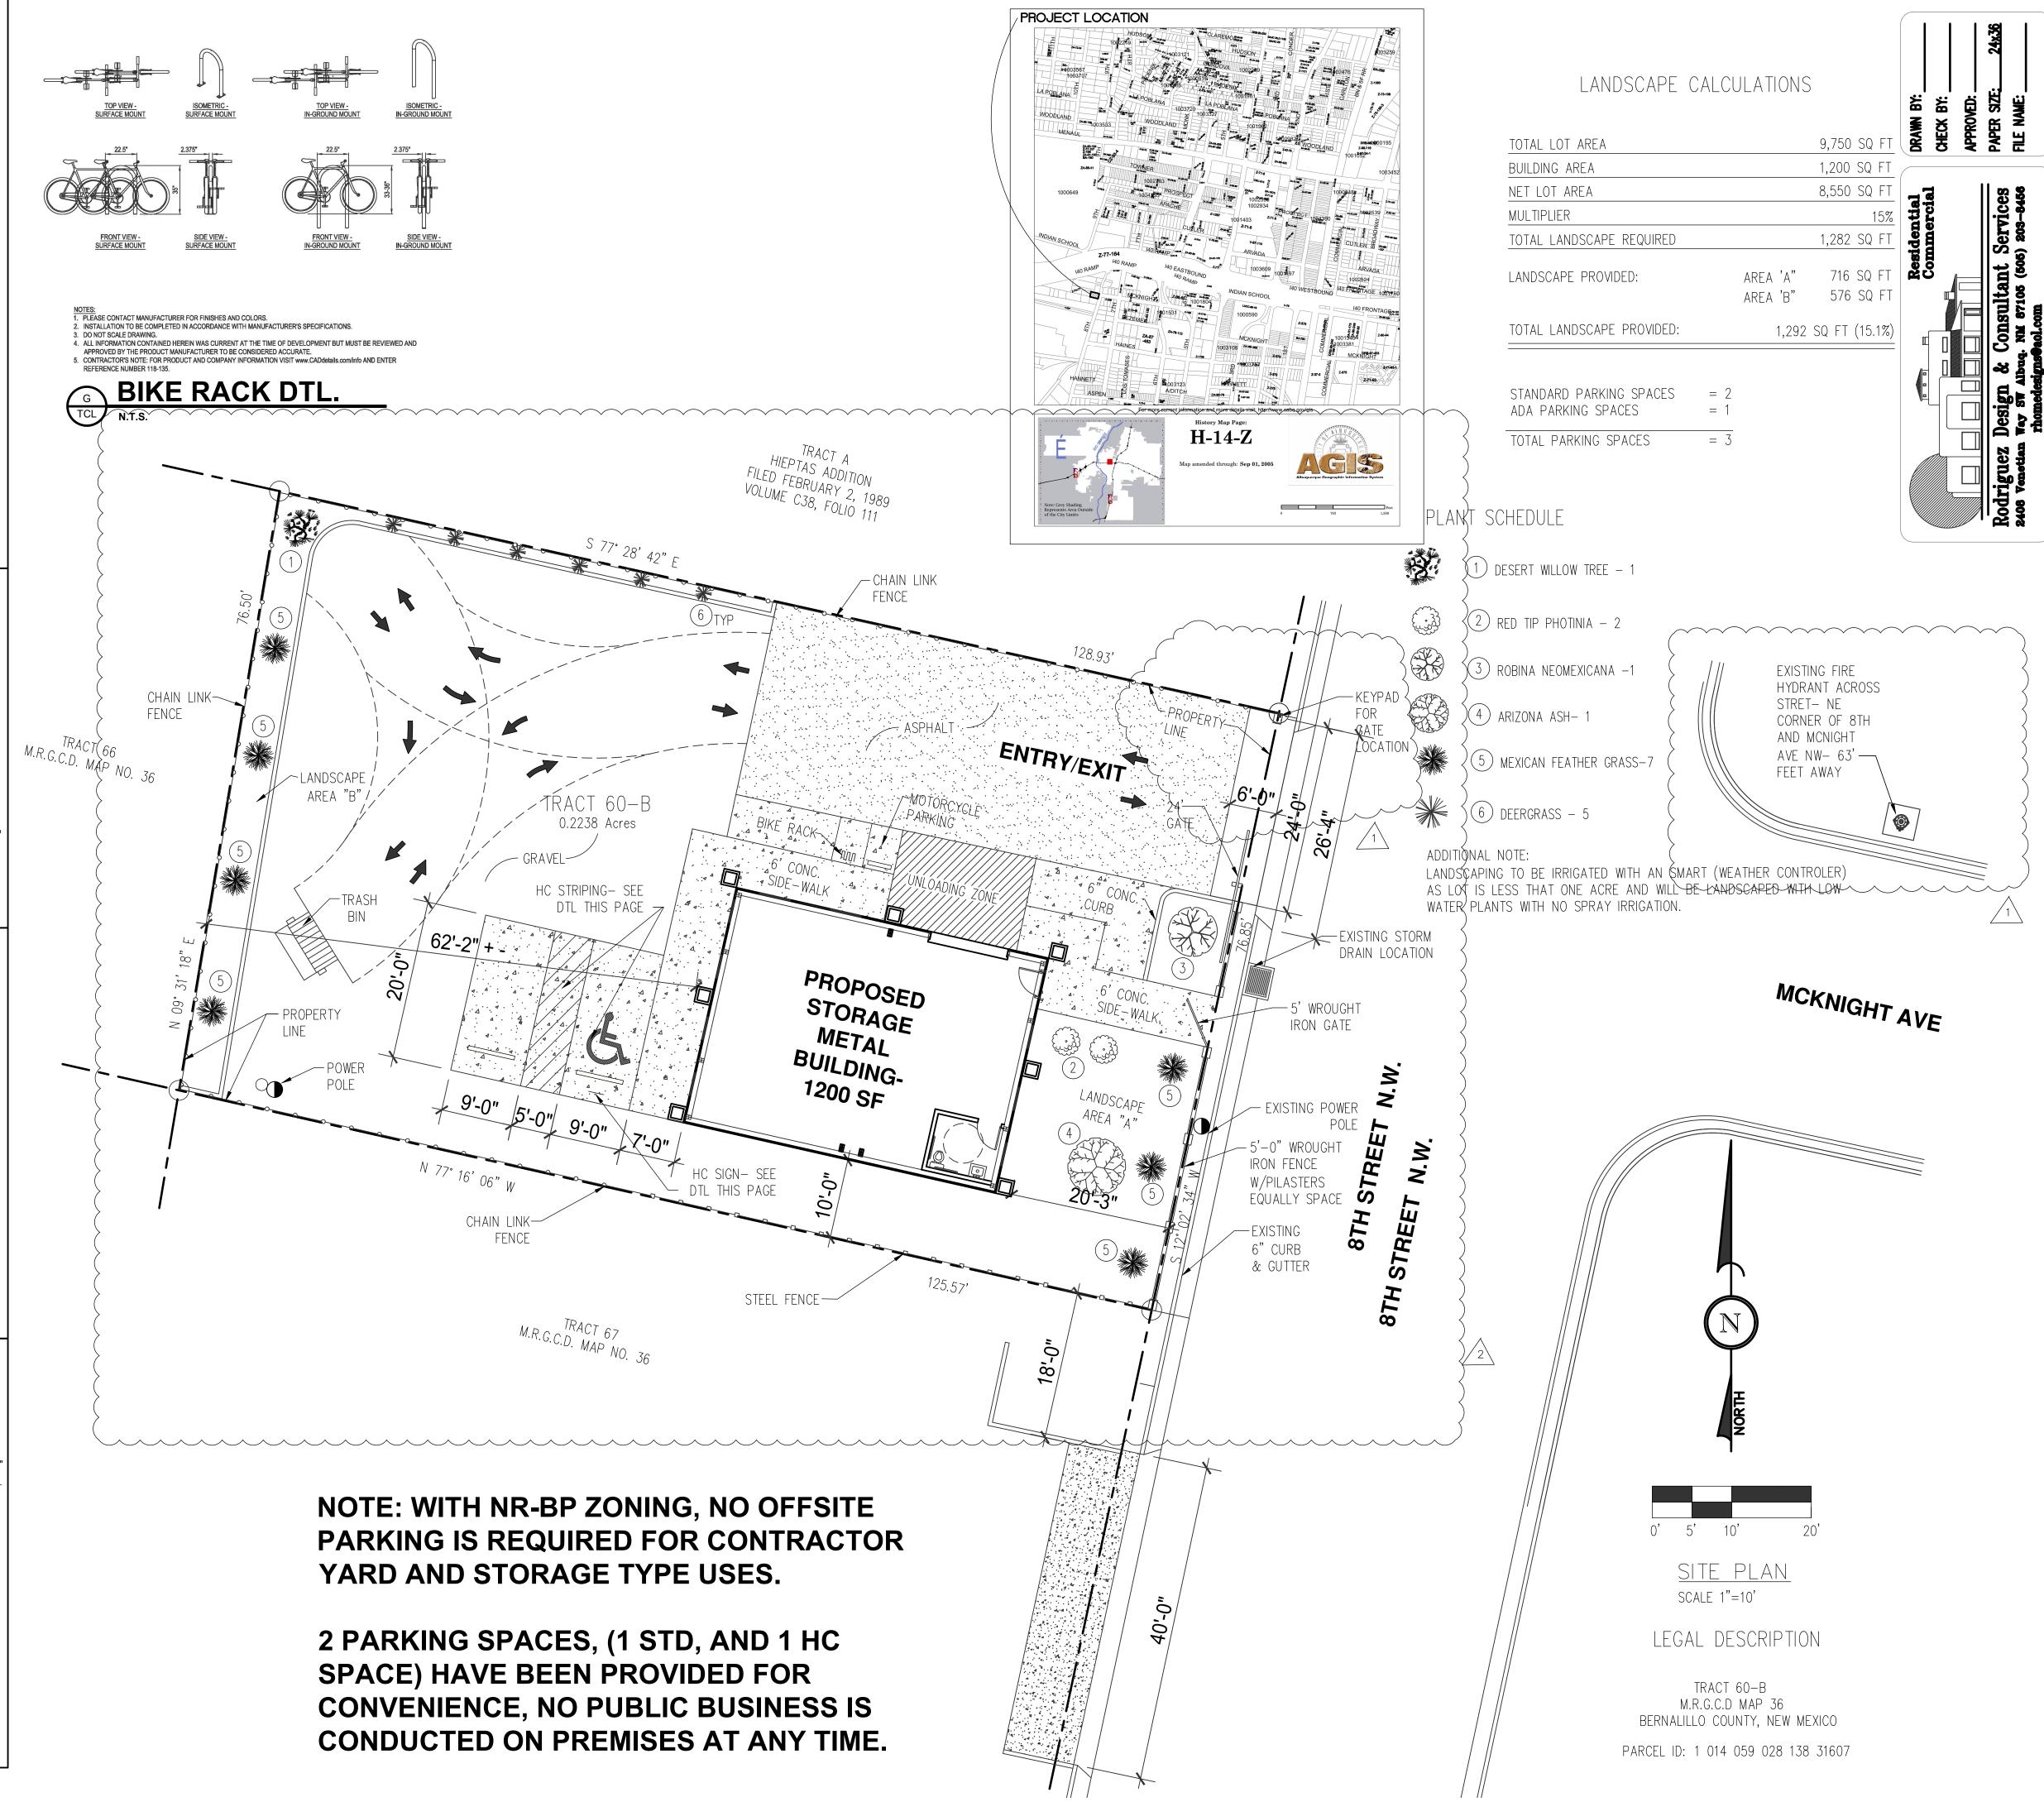

EVISION DATE:

N

PROJE

08-23-2023

12-12-2023

LDING ST PAU LAN

JRAGI DS BU

 $\mathbb{Q} - A \mathbb{Q}$

3/28/2023

DRAWING NUMBER