

# CITY OF ALBUQUERQUE

*Planning Department*  
Brennon Williams, Director



*Mayor Timothy M. Keller*

February 13, 2020

Shawn Biazar  
SBS Construction and Engineering, LLC  
10209 Snowflake Ct. NW  
Albuquerque, NM 87114

**RE: 3308 4th Street Apartment Building**  
**Permanent C.O. – Accepted**  
**Engineer's Certification Date: 01/30/20**  
**Engineer's Stamp Date: 10/22/18**  
**Hydrology File: H14D109**

Dear Mr. Biazar:

PO Box 1293

Based on the Certification received 02/12/20 and site visit on 02/13/20, this certification is approved in support of Permanent Release of Occupancy by Hydrology.

Albuquerque

If you have any questions, please contact me at 924-3995 or [rbrissette@cabq.gov](mailto:rbrissette@cabq.gov).

Sincerely,

NM 87103

*Renée C. Brissette*

[www.cabq.gov](http://www.cabq.gov)

Renée C. Brissette, P.E. CFM  
Senior Engineer, Hydrology  
Planning Department



# City of Albuquerque

Planning Department  
Development & Building Services Division

## DRAINAGE AND TRANSPORTATION INFORMATION SHEET (REV 6/2018)

**Project Title:** 3308 4th Street Apartments Building **Building Permit #:** \_\_\_\_\_ **Hydrology File #:** H14D109  
**DRB#:** \_\_\_\_\_ **EPC#:** \_\_\_\_\_ **Work Order#:** \_\_\_\_\_  
**Legal Description:** LOT 1, BLOCK 2, CENTURY ADDITION  
**City Address:** 3308 4th Street, NW

**Applicant:** SBS CONSTRUCTION AND ENGINEERING, LLC **Contact:** SHAWN BIAZAR  
**Address:** 10209 SNOWFLAKE CT., NW, ALBUQUERQUE, NM 87114  
**Phone#:** (505) 804-5013 **Fax#:** (505) 897-4996 **E-mail:** AECLLC@AOL.COM

**Other Contact:** \_\_\_\_\_ **Contact:** \_\_\_\_\_  
**Address:** \_\_\_\_\_  
**Phone#:** \_\_\_\_\_ **Fax#:** \_\_\_\_\_ **E-mail:** \_\_\_\_\_

**TYPE OF DEVELOPMENT:** \_\_\_\_\_ PLAT (# of lots) \_\_\_\_\_ RESIDENCE \_\_\_\_\_ DRB SITE ☒ ADMIN SITE

IS THIS A RESUBMITTAL? ☒ Yes \_\_\_\_\_ No

**DEPARTMENT** \_\_\_\_\_ TRANSPORTATION ☒ HYDROLOGY/DRAINAGE

Check all that Apply:

### TYPE OF SUBMITTAL:

- ☒ ENGINEER/ARCHITECT CERTIFICATION  
☐ PAD CERTIFICATION  
☐ CONCEPTUAL G & D PLAN  
☐ GRADING PLAN  
☐ DRAINAGE REPORT  
☐ DRAINAGE MASTER PLAN  
☐ FLOODPLAIN DEVELOPMENT PERMIT APPLIC  
☐ ELEVATION CERTIFICATE  
☐ CLOMR/LOMR  
☐ TRAFFIC CIRCULATION LAYOUT (TCL)  
☐ TRAFFIC IMPACT STUDY (TIS)  
☐ STREET LIGHT LAYOUT  
☐ OTHER (SPECIFY) \_\_\_\_\_  
☐ PRE-DESIGN MEETING?

### TYPE OF APPROVAL/ACCEPTANCE SOUGHT:

- ☐ BUILDING PERMIT APPROVAL  
☐ CERTIFICATE OF OCCUPANCY  
☐ PRELIMINARY PLAT APPROVAL  
☐ SITE PLAN FOR SUB'D APPROVAL  
☐ SITE PLAN FOR BLDG. PERMIT APPROVAL  
☐ FINAL PLAT APPROVAL  
☐ SIA/ RELEASE OF FINANCIAL GUARANTEE  
☐ FOUNDATION PERMIT APPROVAL  
☐ GRADING PERMIT APPROVAL  
☐ SO-19 APPROVAL  
☐ PAVING PERMIT APPROVAL  
☒ GRADING/ PAD CERTIFICATION  
☐ WORK ORDER APPROVAL  
☐ CLOMR/LOMR  
☐ FLOODPLAIN DEVELOPMENT PERMIT  
☐ OTHER (SPECIFY) \_\_\_\_\_

**DATE SUBMITTED:** 1-30-2020 **By:** SHAWN BIAZAR

COA STAFF:

ELECTRONIC SUBMITTAL RECEIVED: \_\_\_\_\_

FEE PAID: \_\_\_\_\_

DRAINAGE MANAGEMENT PLAN

**Location**  
LOT 1, BLOCK 2, CENTURY ADDITION is located at 3308 4th Street, NW, just south of Alameda drain. This site contains 0.7090 acre. See attached portion of Vicinity Map G-14-Z for exact location.

**Purpose**  
The purpose of this drainage report is to present a conceptual grading and drainage solution for the proposed commercial buildings. We are requesting site plan for building permit approval.

**Existing Site/Drainage Conditions**  
This site contained of existing buildings, concrete pads, asphalt and some gravel. All the existing structures and asphalt and concrete pads have been removed. This site is fairly flat. Most of the site was draining into 4th., NW. No offsite runoff impacts this site.

**Proposed Conditions and On-Site Drainage Management Plan**  
This site is located within zone 2 and in the north valley. We are proposing a building with ground level and underground parking structure. This site will pond most of water and discharge at a control rate. According to grading plan file #G14-D086, the north valley rate of discharge is 2.75 CFS per acre. This site contains 0.7090 acre (30,886 sf). Therefore our rate of discharge will be at 1.95 CFS (0.7090 \* 2.75). This site will generate 3.22 CFS and the difference between the developed flow (3.22 CFS) and allowable discharge (1.95 CFS) will be 1.27 CFS (3.22-1.95). therefore the amonth of the ponding required will be 2,095.51 CF.

There are four proposed pond for this site. One is at the east side of the property and three smaller ponds along south property line, see grading plan for location. All the water except the some of the proposed driveway which will be draining directly into 4th street, will drain into the ponds in the east and south. These ponds will be connected via 2.4" storm drain pipe. the water eventually will drain into 4th Street via concrete channel. The total volume ponding provided is 3,396.14 CF which is greater than required 2,095.51 CF.

PONDING VOLUME REQUIRED

TOTAL AREA = 30,688 SF = 0.7090 ACRE

ZONE 2 LAND TREATMENT TABLE A-8: B=0.78 AND D=2.12  
B=2,000 SF/0.0459 AC D=28,388 SF/0.6631 AC

VOL (100-yr/6hr ) = (2000\*0.78)/12 + 28388\*2.12/12 = 5,233.19 CF

Q (100-yr/6 hr) (USING TABLE A-9, ZONE 2)=(2.28\*0.0459)+(4.7\*0.6631)=3.22 CFS

ALLOWABLE RUNOFF = 2.75/AC \* 0.7090 AC = 1.95 CFS

ADDITIONAL RUNOFF = 3.22-1.95 =1.27 CFS

PONDING VOLUME REQUIRED = 5,233.19/3.22 \* 1.27 = 2,095.51 CF

POND VOLUME REQUIRED FOR FIRST FLUSH

0.34 INCHES x IMPERVIOUS AREA = (0.34/12 x 30,688) = 869.49 CF  
THIS VOLUME IS PART OF THE PONDING PROVIDED.

PONDING AREA PROVIDED

TOTAL POND AREA PROVIDED = PONDING CALCULATIONS:

POND A: AREA @ TOP = 327.27, WITH 3.00' DEPTH  
POND VOLUME = (327.27\*3.00') = 711.50 CF

POND B: AREA @ TOP = 323.95, WITH 1.75' DEPTH  
POND VOLUME = (323.95\*1.75') = 566.91 CF

POND C: AREA @ TOP = 323.95, WITH 1.75' DEPTH  
POND VOLUME = (323.95\*1.75') = 566.91 CF

POND D: AREA @ TOP = 866.00, WITH 1.75' DEPTH  
POND VOLUME = (866.00\*1.75') = 1,550.50 CF

TOTAL POND VOLUME PROVIDED = (711.50+566.91+566.91+1550.50)= 3,396.14 CF

SIDEWALK CULVERT/CONCRETE CHANNEL AND POND OPENING CALCULATIONS

24" Sidewalk Culvert 8" High Calculation Using Weir Equation

$Q = CLH^{1.5}$   
 $H = 0.67$ ,  $C = 2.95$ ,  $L = 24"$  (2.00)

$2.95 * 24 * (67)^{1.5} = 2.958 * 2 * 0.548418636$   
 $Q = 3.236$  cfs

18" Wide With 8" High Concrete Channel Using Weir Equation

$Q = CLH^{1.5}$   
 $H = 0.67$ ,  $C = 2.95$ ,  $L = 18"$  (1.50)

$2.95 * 18 * (67)^{1.5} = 2.958 * 1.50 * 0.548418636$   
 $Q = 2.427$  cfs

DRAINAGE CERTIFICATION

I, REZA AFAGHPOUR, NMPE 11814, OF SBS CONSTRUCTION AND ENGINEERING, LLC, HEREBY CERTIFY THAT THIS PROJECT HAS BEEN GRADED AND WILL DRAIN IN SUBSTANTIAL COMPLIANCE WITH AND IN ACCORDANCE WITH THE DESIGN INTENT OF THE APPROVED PLAN DATED 10-22-2018. THE RECORD INFORMATION EDITED ONTO THE ORIGINAL DESIGN DOCUMENT HAS BEEN OBTAINED BY NMPS 9801 LEONARD MARTINEZ, OF SBS CONSTRUCTION AND ENGINEERING. I FURTHER CERTIFY THAT I HAVE PERSONALLY VISITED THE PROJECT SITE ON AND HAVE DETERMINED BY VISUAL INSPECTION THAT THE SURVEY DATA PROVIDED IS REPRESENTATIVE OF ACTUAL SITE CONDITIONS AND IS TRUE AND CORRECT TO THE BEST OF MY KNOWLEDGE AND BELIEF. THIS CERTIFICATION IS SUBMITTED IN SUPPORT OF A REQUEST FOR FINAL CERTIFICATE OF OCCUPANCY.

THE RECORD INFORMATION PRESENTED HEREON IS NOT NECESSARILY COMPLETE AND INTENDED ONLY TO VERIFY SUBSTANTIAL COMPLIANCE OF THE GRADING AND DRAINAGE ASPECTS OF THIS PROJECT. THOSE RELYING ON THIS RECORD DOCUMENT ARE ADVISED TO OBTAIN INDEPENDENT VERIFICATION OF ITS ACCURACY BEFORE USING IT FOR ANY OTHER PURPOSE.

REZA AFAGHPOUR, NMPE 11814  
1/30/2020  
DATE



NOTES:

- 24" SIDEWALK CULRVET PER CITY STD DWG 2236 (TACK WELD PLATE AT THE BOLT).
- INSTALL 2-4" STORM DRAIN PIPE, SDR 35.
- 18" WIDE CONC. CHANNEL WITH 8" WALL.
- BUILDING ENVELOPE.
- INSTALL MEDIAN CURB & GUTTER.
- ASPHALT PAVING AREA.
- PROVIDE 18" OPENNING.
- PROVIDE 12" CURB OPENNING.
- NEW DRIVE WAY.
- LANDSCAPING AREA.
- TO LOWER PARKING LEVEL.
- LANDSCAPING AREA.
- TO LOWER PARKING LEVEL.
- REMOVE AND REPLACE EXISTING SIDEWALK.

NOTICE TO CONTRACTORS

- AN EXCAVATION/CONSTRUCTION PERMIT WILL BE REQUIRED BEFORE BEGINNING ANY WORK WITHIN CITY RIGHT-OF-WAY.
- ALL WORK DETAILED ON THESE PLANS TO BE PERFORMED, EXCEPT AS OTHERWISE STATED OR PROVIDED HEREON, SHALL BE CONSTRUCTED IN ACCORDANCE WITH CITY OF ALBUQUERQUE INTERIM STANDARD SPECIFICATIONS FOR PUBLIC WORKS CONSTRUCTION, 1985.
- TWO WORKING DAYS PRIOR TO ANY EXCAVATION, CONTRACTOR MUST CONTACT NEW MEXICO ONE CALL FOR LOCATING SERVICE, 260-1990 OR "811", FOR LOCATION OF EXISTING UTILITIES.
- PRIOR TO CONSTRUCTION, THE CONTRACTOR SHALL EXCAVATE AND VERIFY THE HORIZONTAL AND VERTICAL LOCATIONS OF ALL CONSTRUCTIONS. SHOULD A CONFLICT EXIST, THE CONTRACTOR SHALL NOTIFY THE ENGINEER SO THAT THE CONFLICT CAN BE RESOLVED WITH A MINIMUM AMOUNT OF DELAY.
- BACKFILL COMPACTION SHALL BE ACCORDING TO TRAFFIC/STREET USE.
- MAINTENANCE OF THESE FACILITIES SHALL BE THE RESPONSIBILITY OF THE OWNER OF THE PROPERTY SERVED.
- WORK ON ARTERIAL STREETS SHALL BE PERFORMED ON A 24-HOUR BASIS.

APPROVALS	NAME	DATE
INSPECTOR		

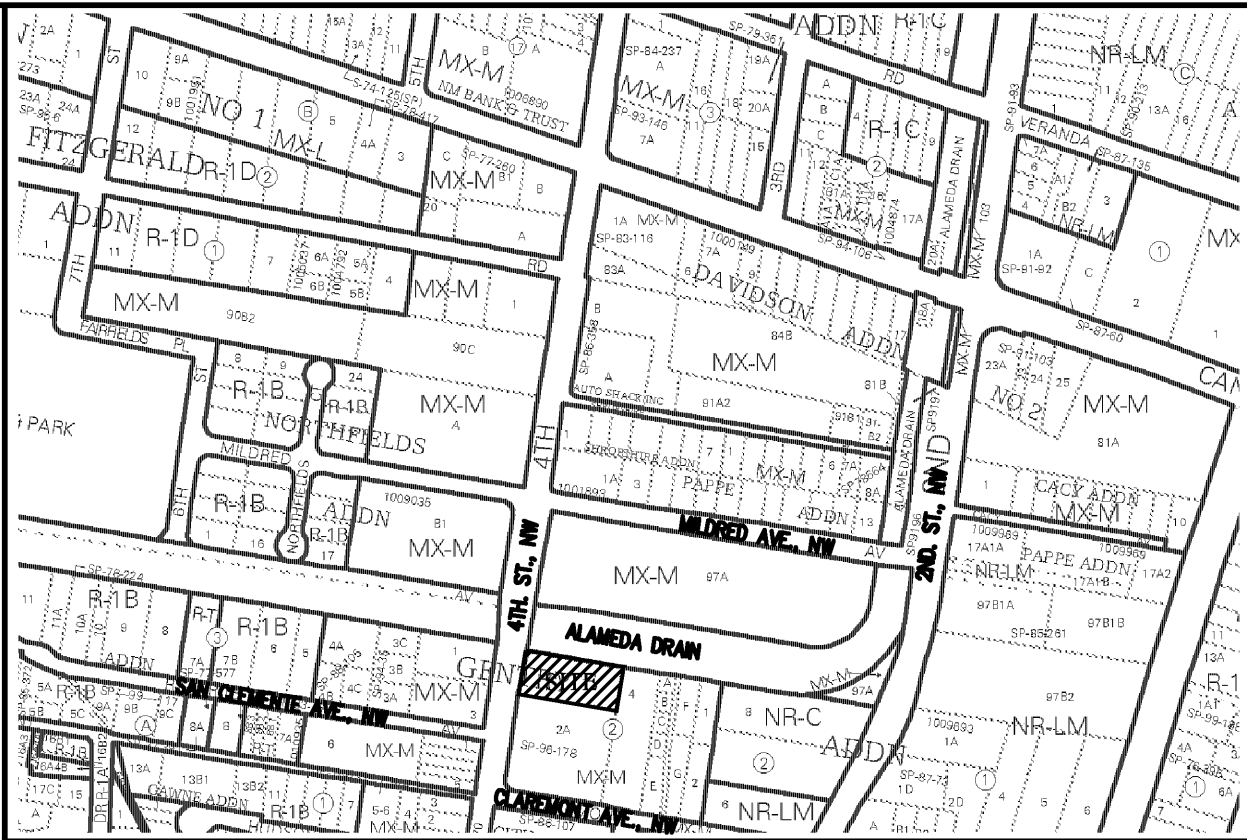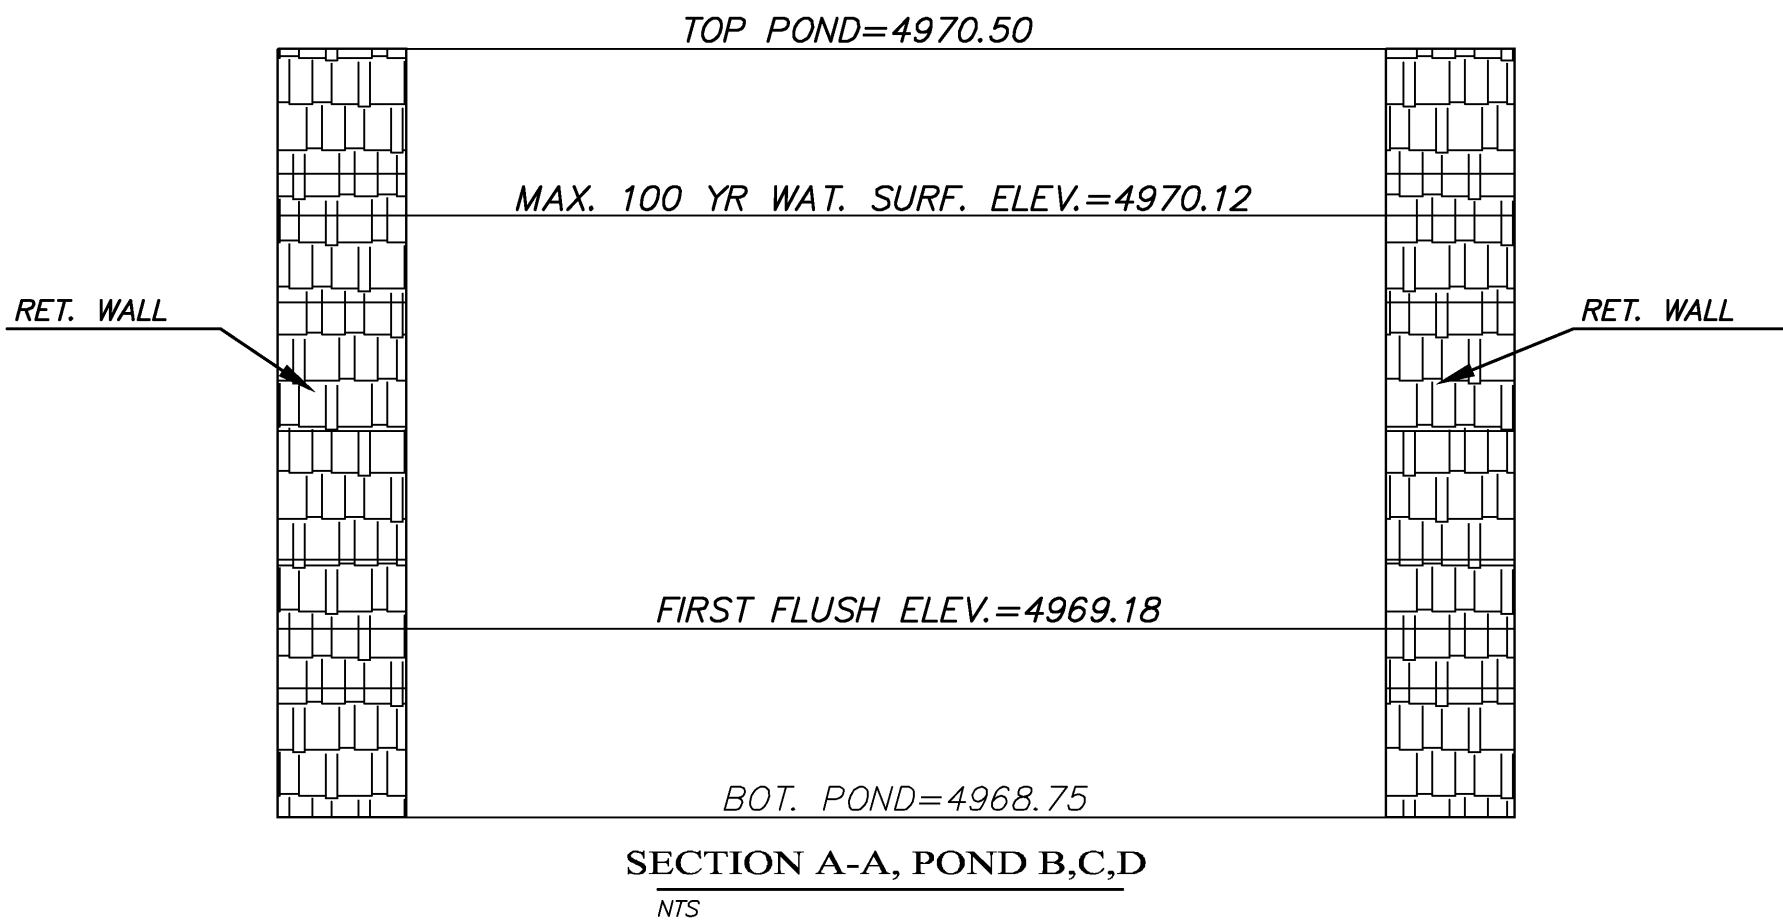

VICINITY MAP:

G-14-Z

LEGAL DESCRIPTION:

LOT 1, BLOCK 2, CENTURY ADDITION  
CONTAINING: 30,883.00 SF ( 0.7090 ACRE )  
ZONING: SU-2 NFMX

GENERAL NOTES:

- CONTOUR INTERVAL IS HALF (1.00) FOOT.
- ELEVATIONS ARE BASED ON CITY OF ALBUQUERQUE CONTROL STATION SMW-, HAVING AN ELEVATION OF 4969.728 FEET ABOVE SEA LEVEL.
- UTILITIES SHOWN HEREON ARE IN THEIR APPROXIMATE LOCATION BASED ONLY ON ABOVE GROUND EVIDENCE FOUND IN THE FIELD AND AS-BUILT INFORMATION PROVIDED BY THE CLIENT. UTILITIES SHOWN HEREON, WHETHER INDICATED AS ABANDONED OR NOT, SHALL BE VERIFIED BY OTHERS FOR EXACT LOCATION AND/ OR DEPTH PRIOR TO EXCAVATION OR DESIGN CONSIDERATIONS.
- THIS IS NOT A BOUNDARY SURVEY, BEARINGS ARE ASSUMED, DISTANCES AND FOUND PROPERTY CORNERS ARE FOR INFORMATIONAL PURPOSES ONLY.
- SLOPES ARE AT 3:1 MAXIMUM.

LEGEND

- 5030 EXISTING CONTOUR (MAJOR)
- EXISTING CONTOUR (MINOR)
- BOUNDARY LINE
- X 28.50 PROPOSED SPOT ELEVATION
- X 5029.16 EXISTING GRADE
- X 5028.65 EXISTING FLOWLINE ELEVATION
- PROPOSED RETAINING WALL
- BC=89.08 BOTTOM OF CHANEL
- TC=28.50 TOP OF CURB
- TA=28.00 TOP OF ASPHALT
- HP HIGH POINT
- 86.65 AS-BUILT GRADES
- X 86.65 AS-BUILT SPOT ELEVATIONS



REZA AFAGHPOUR  
P.E. #11814

SBS CONSTRUCTION AND ENGINEERING, LLC

10209 SNOWFLAKE CT., NW  
ALBUQUERQUE, NEW MEXICO 87114  
(505)899-5570

3308 4th SREET NW  
GRADING AND DRAINAGE PLAN

DRAWING:	DRAWN BY:	DATE:	SHEET #
201618-GR.DWG	SH-B	09-14-207	C 101

GRAPHIC SCALE



LAST REVISION: 09-14-2017