

CITY OF ALBUQUERQUE

Planning Department
Brennon Williams, Director



Mayor Timothy M. Keller

April 1, 2020

Ronald Bohannon, P.E.
Tierra West, LLC
5571 Midway Park Place NE
Albuquerque, NM, 87109

**RE: U-Haul
2217 4TH St. NW
Grading & Drainage Plan
Engineer's Stamp Date: 01/28/20
Hydrology File: H14D110**

Dear Mr. Bohannon:

Based upon the information provided in your submittal received 03/31/2020, the Grading & Drainage Plan **is not** approved for Building Permit and SO-19 Permit. The following comments need to be addressed for approval of the above referenced project:

1. Please use the latest SO-19 Notes. See attachment.
2. Please update your use of "First Flush". This is an old 1990s term and please update it with "Stormwater Quality" instead.
3. Please provide an emergency spillway for both retention ponds by way of sidewalk culverts.
4. Please provide a cross section of both retention ponds showing the 100 yr – 10 day volume, top of pond, bottom of pond, and the elevation of the emergency spillway (sidewalk culvert).
5. Please add the broad crest weir equation (equation 6.60 in the DPM) for the 2 ft curb cuts and the sidewalk culverts.. A coefficient of 2.7 is typically used for the equation $Q = CLH^{2/3}$.
6. Please reference City of Albuquerque standard detail No. 2236 – Sidewalk Culvert with Steel Plate Top at the sidewalk culvert.
7. Please update the SO-19 Permit Notes. See Attachment.
8. Please show and label the slump pump along with the force main. Also provide the cut sheet for the pump along with the performance curve.

PO Box 1293

Albuquerque

NM 87103

www.cabq.gov

CITY OF ALBUQUERQUE

Planning Department
Brennon Williams, Director



Mayor Timothy M. Keller

9. As a reminder, if the project total area of disturbance (including the staging area and any work within the adjacent Right-of-Way) is 1 acre or more, then an Erosion and Sediment Control (ESC) Plan and Owner's certified Notice of Intent (NOI) is required to be submitted to the Stormwater Quality Engineer (Doug Hughes, PE, jhughes@cabq.gov, 924-3420) 14 days prior to any earth disturbance.
10. Also as a reminder, please provide a Drainage Covenant for the proposed Stormwater Quality Ponds and retention ponds per Chapter 17 of the DPM prior to Permanent Release of Occupancy. Please submit this on the 4th floor of Plaza de Sol. A \$25 fee will be required.
11. Standard review fee of \$150 will be required at the time of resubmittal.

If you have any questions, please contact me at 924-3995 or rbrissette@cabq.gov.

Sincerely,

PO Box 1293

Albuquerque

Renée C. Brissette, P.E. CFM
Senior Engineer, Hydrology
Planning Department

NM 87103

www.cabq.gov



City of Albuquerque

Planning Department
Development & Building Services Division

DRAINAGE AND TRANSPORTATION INFORMATION SHEET (REV 6/2018)

Project Title: U-Haul 4th St & I40 **Building Permit #:** _____ **Hydrology File #:** H14D110
DRB#: _____ **EPC#:** _____ **Work Order#:** _____
Legal Description: TR C of Alexander Center (EXCL S'LY PORT OUT TO R/W)
City Address: 2217 4th St NW Albuquerque NM

Applicant: Tierra West, LLC **Contact:** Jonathan Niski
Address: 5571 Midway Park PL NE Albuquerque NM 87109
Phone#: 505-858-3100 **Fax#:** 505-858-1118 **E-mail:** jniski@tierrawestll.com

Other Contact: _____ **Contact:** _____
Address: _____
Phone#: _____ **Fax#:** _____ **E-mail:** _____

TYPE OF DEVELOPMENT: _____ PLAT (# of lots) _____ RESIDENCE _____ DRB SITE ☒ ADMIN SITE

IS THIS A RESUBMITTAL? _____ Yes ☒ No

DEPARTMENT _____ TRANSPORTATION ☒ HYDROLOGY/DRAINAGE

Check all that Apply:

TYPE OF SUBMITTAL:

- ☐ ENGINEER/ARCHITECT CERTIFICATION
- ☐ PAD CERTIFICATION
- ☐ CONCEPTUAL G & D PLAN
- ☒ GRADING PLAN
- ☒ DRAINAGE REPORT
- ☐ DRAINAGE MASTER PLAN
- ☐ FLOODPLAIN DEVELOPMENT PERMIT APPLIC
- ☐ ELEVATION CERTIFICATE
- ☐ CLOMR/LOMR
- ☐ TRAFFIC CIRCULATION LAYOUT (TCL)
- ☐ TRAFFIC IMPACT STUDY (TIS)
- ☐ STREET LIGHT LAYOUT
- ☐ OTHER (SPECIFY) _____
- ☐ PRE-DESIGN MEETING?

TYPE OF APPROVAL/ACCEPTANCE SOUGHT:


- ☒ BUILDING PERMIT APPROVAL
- ☐ CERTIFICATE OF OCCUPANCY
- ☐ PRELIMINARY PLAT APPROVAL
- ☐ SITE PLAN FOR SUB'D APPROVAL
- ☐ SITE PLAN FOR BLDG. PERMIT APPROVAL
- ☐ FINAL PLAT APPROVAL
- ☐ SIA/ RELEASE OF FINANCIAL GUARANTEE
- ☐ FOUNDATION PERMIT APPROVAL
- ☐ GRADING PERMIT APPROVAL
- ☐ SO-19 APPROVAL
- ☐ PAVING PERMIT APPROVAL
- ☐ GRADING/ PAD CERTIFICATION
- ☐ WORK ORDER APPROVAL
- ☐ CLOMR/LOMR
- ☐ FLOODPLAIN DEVELOPMENT PERMIT
- ☐ OTHER (SPECIFY) _____

DATE SUBMITTED: 3/31/2020 **By:** Jonathan Niski

COA STAFF:

ELECTRONIC SUBMITTAL RECEIVED: _____

FEE PAID: _____

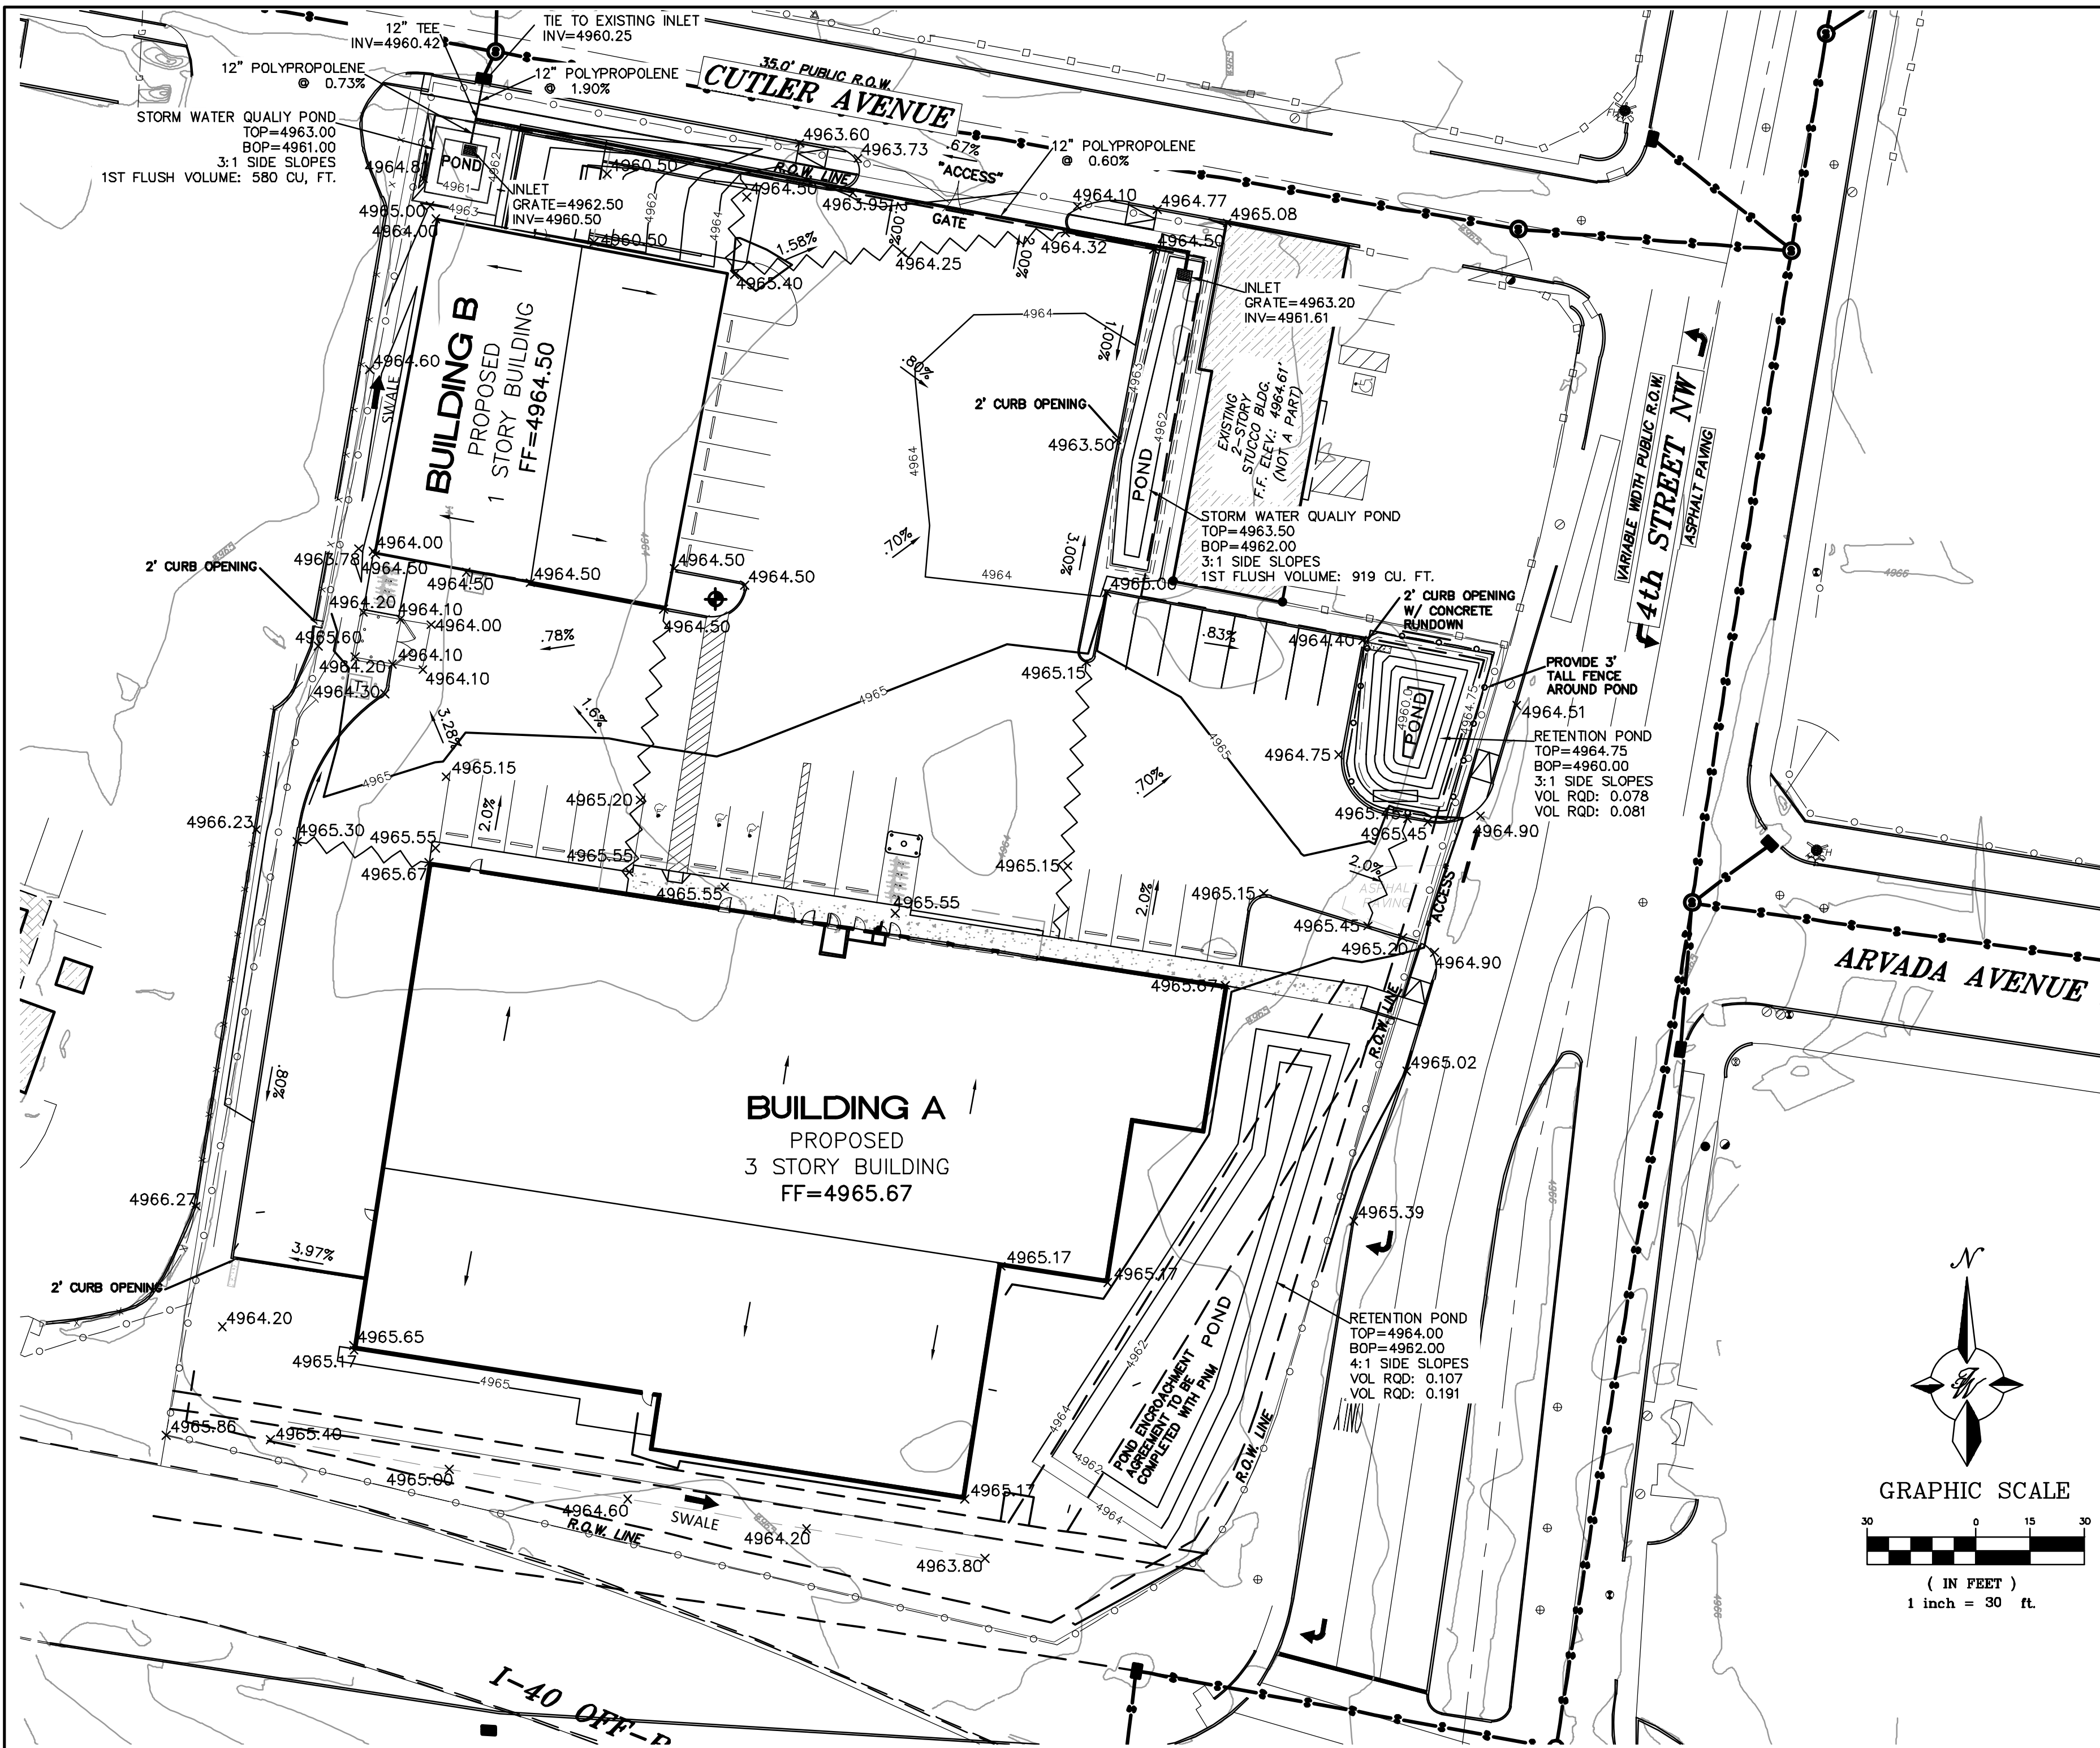

LEGEND

- CURB & GUTTER
- BOUNDARY LINE
- EASEMENT
- CENTERLINE
- RIGHT-OF-WAY
- BUILDING
- SIDEWALK
- RETAINING WALL
- CONTOUR MAJOR
- CONTOUR MINOR
- SPOT ELEVATION (FLOWLINE)
- FLOW ARROW
- EXISTING CURB & GUTTER
- EXISTING BOUNDARY LINE
- EXISTING CONTOUR MAJOR
- EXISTING CONTOUR MINOR
- EXISTING SPOT ELEVATION
- EXISTING LIGHT STANDARD
- PHASE LINE

EXISTING DRAINAGE CONDITION:
THE SITE IS AN EXISTING UNDEVELOPED 2.5 ACRE LOT. THE SITE DRAINS FROM SOUTH TO NORTH AND THE SURFACE RUNOFF IS DISCHARGED INTO CUTLER AVE. WHERE IT IS CAPTURED BY AN EXISTING DROP INLET NEAR THE NORTHWEST CORNER OF THE SITE. THERE IS NO OFFSITE RUNOFF THAT ENTERS THE SITE. THE SITE MAY HAVE BEEN USED AS A GRAVEL PARKING LOT IN THE PAST. AS SUCH THE EXISTING LAND TREATMENT WAS CONSIDERED COMPACT GRAVEL WITH TREATMENT "C" GENERATING A RUNOFF OF 7.93 CFS. A PORTION OF THE SITE IS LOCATED IN SHADED ZONE X WITH THE REST IN ZONE X.

PROPOSED DRAINAGE CONDITION:
THE SITE WAS DIVIDED UP INTO SEVEN BASINS AS SHOWN ON THE BASIN MAP ON THIS SHEET. BASIN ONE CONSISTS OF THE BACK HALF OF THE LARGE BUILDING AND THE REAR LANDSCAPED AREA. THIS BASIN WILL DRAIN FROM WEST TO EAST IN A SWALE TO A RETENTION POND LOCATED BETWEEN THE BUILDING AND 4TH STREET. THE POND IS SIZED FOR THE 100YR, 10 DAY STORM AND IS ONLY 2 FEET DEEP. THAT POND IS LOCATED IN AN EXISTING OVERHEAD POWERLINE EASEMENT FOR WHICH AN ENCROACHMENT AGREEMENT WILL BE EXECUTED WITH PNM.

BASIN 2 CONTAINS THE WESTERN PORTION OF THE SITE AND THE BACK HALF OF THE SMALL BUILDING. THE RUNOFF WILL FLOW IN A SWALE BEHIND THE SMALL BUILDING TO A STORM WATER QUALITY POND LOCATED AT THE NORTHWEST CORNER OF THE SITE. THE POND IS SIZED TO HOLD THE FIRST FLUSH VOLUME BEFORE DISCHARGING 1.86 CFS INTO A DROP INLET.

BASIN 3 CONTAINS THE EASTERN PARKING LOT AND A SMALL PORTION OF THE LARGE BUILDING. THE RUNOFF WILL SURFACE FLOW TO A RETENTION POND SIZED FOR THE 100YR, 10 DAY STORM AND IS 4 FEET DEEP. THIS POND WILL BE SURROUNDED BY A FENCE TO KEEP PEDESTRIANS OUT.




BASIN 4 CONTAINS MOST OF THE PARKING LOT AND THE FRONT PORTION OF BOTH BUILDINGS. THE RUNOFF WILL SURFACE FLOW TO A STORM WATER QUALITY POND LOCATED IN THE NORTHEAST CORNER OF THE SITE. THE POND IS SIZED TO HOLD THE FIRST FLUSH VOLUME PRIOR TO DISCHARGING 3.90 CFS INTO A DROP INLET. THE STORM WATER FROM BASINS 2, 3 AND 4 WILL DISCHARGE 5.76 CFS VIA STORM SEWER TO THE EXISTING DROP INLET IN CUTLER AVE.

BASIN 5 CONSISTS OF A LOADING DOCK THAT WILL DRAIN TO A SUMP PUMP. THE SUMP PUMP WILL DISCHARGE THE STORM WATER INTO THE STORM WATER QUALITY POND BEHIND THE LOADING DOCK.

BASINS 6 AND 7 CONSIST OF THE ENTRANCE WATER BLOCKS AND WILL DISCHARGE A TOTAL OF .25 CFS TO CUTLER AVE AND 4TH STREET. THE TOTAL STORM WATER DISCHARGED FROM THE PROPOSED PROJECT IS 7.42 CFS WHICH IS BELOW THE EXISTING DISCHARGE OF 7.93.

NOTICE TO CONTRACTORS

- AN EXCAVATION/CONSTRUCTION PERMIT WILL BE REQUIRED BEFORE BEGINNING ANY WORK WITHIN CITY RIGHT-OF-WAY.
- ALL WORK DETAILED ON THESE PLANS TO BE PERFORMED, EXCEPT AS OTHERWISE STATED OR PROVIDED HEREON, SHALL BE CONSTRUCTED IN ACCORDANCE WITH CITY OF ALBUQUERQUE INTERIM STANDARD SPECIFICATIONS FOR PUBLIC WORKS CONSTRUCTION, 1985.
- TWO WORKING DAYS PRIOR TO ANY EXCAVATION, CONTRACTOR MUST CONTACT LINE LOCATING SERVICE, 785-1234, FOR LOCATION OF EXISTING UTILITIES.
- PRIOR TO CONSTRUCTION, THE CONTRACTOR SHALL EXCAVATE AND VERIFY THE HORIZONTAL AND VERTICAL LOCATIONS OF ALL CONNECTIONS. SHOULD A CONFLICT EXIST, THE CONTRACTOR SHALL NOTIFY THE ENGINEER SO THAT THE CONFLICT CAN BE RESOLVED WITH A MINIMUM AMOUNT OF DELAY.
- BACKFILL COMPACTION SHALL BE ACCORDING TO TRAFFIC/STREET USE.
- MAINTENANCE OF THESE FACILITIES SHALL BE THE RESPONSIBILITY OF THE OWNER OF THE PROPERTY SERVED.
- WORK ON ARTERIAL STREETS SHALL BE PERFORMED ON A 24-HOUR BASIS.
- PRIOR TO WORK WITHIN THE INTERSTATE 40 RIGHT-OF-WAY, A NMDOT PERMIT WILL BE REQUIRED.

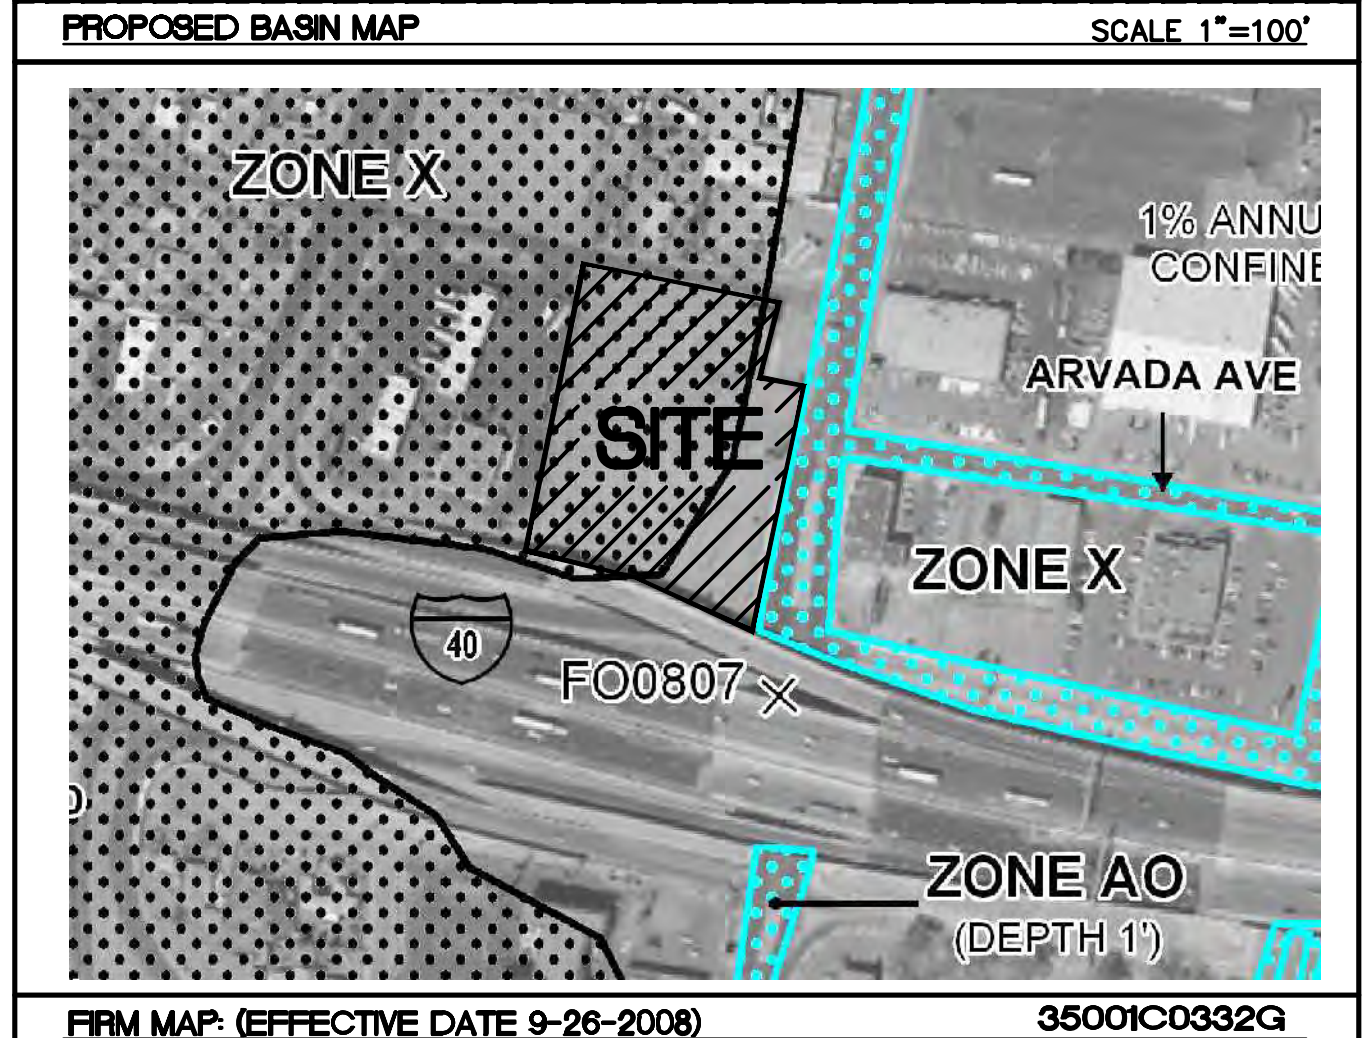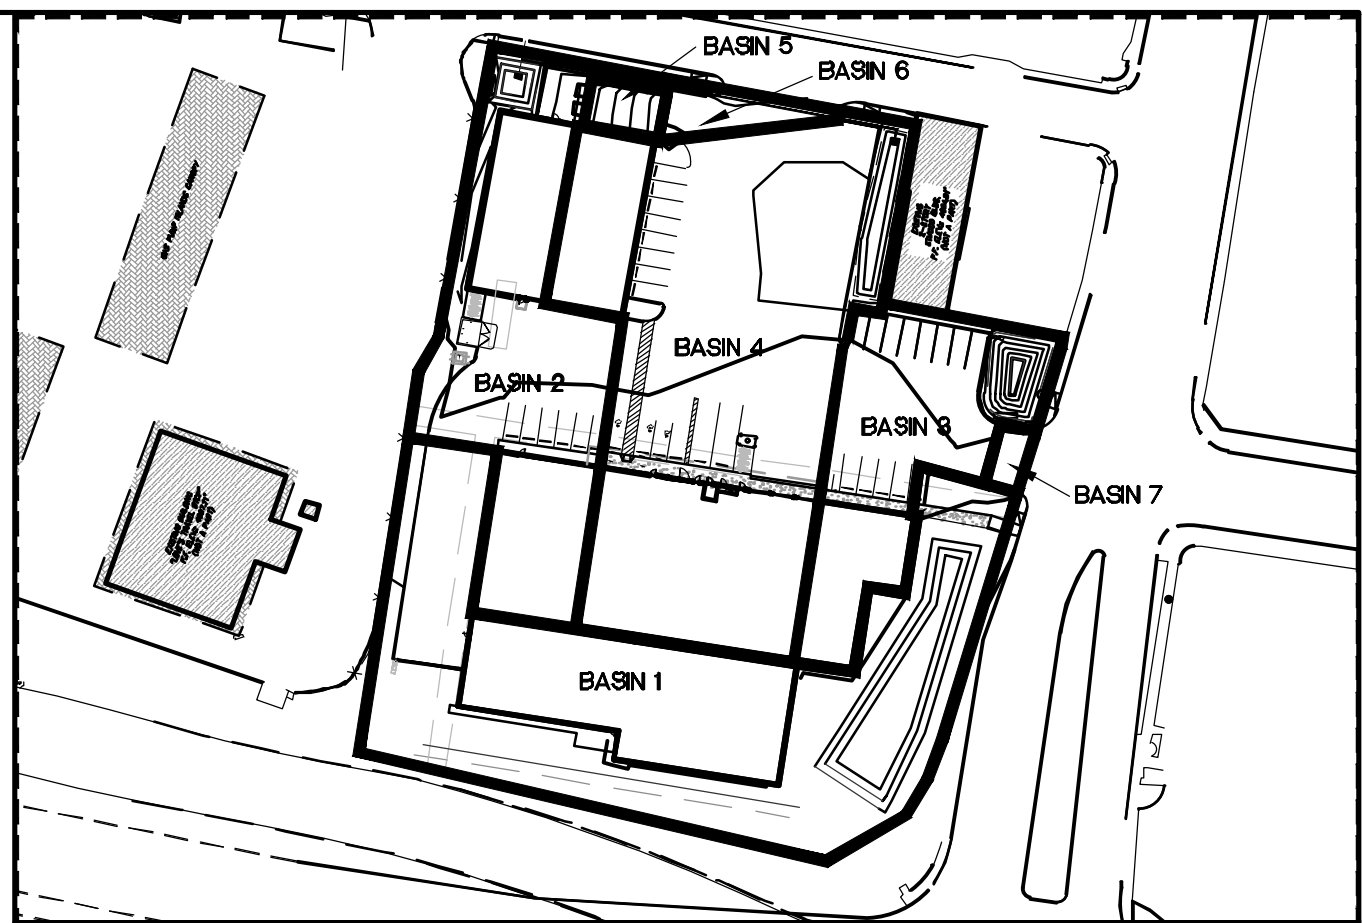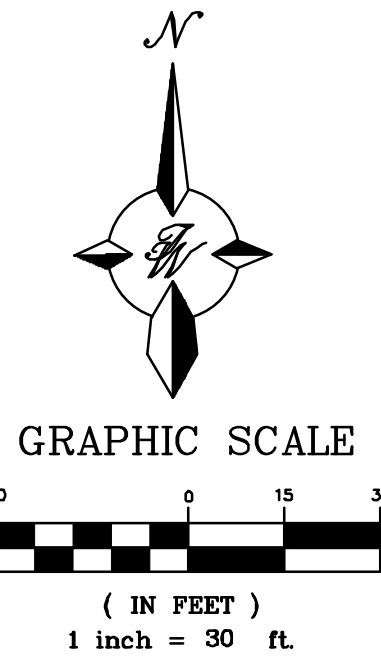

NOTICE TO CONTRACTORS

- AN EXCAVATION/CONSTRUCTION PERMIT WILL BE REQUIRED BEFORE BEGINNING ANY WORK WITHIN CITY RIGHT-OF-WAY.
- ALL WORK DETAILED ON THESE PLANS TO BE PERFORMED, EXCEPT AS OTHERWISE STATED OR PROVIDED HEREON, SHALL BE CONSTRUCTED IN ACCORDANCE WITH CITY OF ALBUQUERQUE INTERIM STANDARD SPECIFICATIONS FOR PUBLIC WORKS CONSTRUCTION, 1985.
- TWO WORKING DAYS PRIOR TO ANY EXCAVATION, CONTRACTOR MUST CONTACT LINE LOCATING SERVICE, 785-1234, FOR LOCATION OF EXISTING UTILITIES.
- PRIOR TO CONSTRUCTION, THE CONTRACTOR SHALL EXCAVATE AND VERIFY THE HORIZONTAL AND VERTICAL LOCATIONS OF ALL CONNECTIONS. SHOULD A CONFLICT EXIST, THE CONTRACTOR SHALL NOTIFY THE ENGINEER SO THAT THE CONFLICT CAN BE RESOLVED WITH A MINIMUM AMOUNT OF DELAY.
- BACKFILL COMPACTION SHALL BE ACCORDING TO TRAFFIC/STREET USE.
- MAINTENANCE OF THESE FACILITIES SHALL BE THE RESPONSIBILITY OF THE OWNER OF THE PROPERTY SERVED.
- WORK ON ARTERIAL STREETS SHALL BE PERFORMED ON A 24-HOUR BASIS.

APPROVAL	NAME	DATE
INSPECTOR		

FIRST FLUSH MANAGEMENT

WATER QUALITY MEASURES WILL CONSIST OF RETENTION PONDS SIZED TO RETAIN THE FIRST FLUSH VOLUME FROM THE DEVELOPED AREAS. FLOWS WILL BE CONVEYED TO THE PONDS PRIMARILY BY SURFACE DRAINAGE AS WELL AS A PRIVATE STORM DRAIN SYSTEM BETWEEN BUILDINGS "A" AND "B". DRAINAGE VOLUMES IN EXCESS OF THE FIRST FLUSH WILL BE DISCHARGED THROUGH A PROPOSED STORM DRAIN SYSTEM AND INTO THE EXISTING PUBLIC STORM DRAIN WITHIN 4TH STREET.

FIRST FLUSH CALCULATIONS

BASIN 1: $9847 \times .32"/12" = 213$ CU.FT.
BASIN 2: $15246 \times .32"/12" = 329$ CU.FT.
BASIN 3: $10890 \times .32"/12" = 237$ CU.FT.
BASIN 4: $34848 \times .32"/12" = 751$ CU.FT.
BASIN 5: $1307 \times .32"/12" = 94$ CU.FT.
BASIN 6: $1742 \times .32"/12" = 38$ CU.FT.
BASIN 7: $436 \times .32"/12" = 15$ CU.FT.
TOTAL FIRST FLUSH VOLUME = 1677 CU.FT.

CAUTION:

ALL EXISTING UTILITIES SHOWN WERE OBTAINED FROM RESEARCH, AS-BUILTS, SURVEYS OR INFORMATION PROVIDED BY OTHERS. IT SHALL BE THE SOLE RESPONSIBILITY OF THE CONTRACTOR TO CONDUCT ALL NECESSARY FIELD INVESTIGATIONS PRIOR TO AND INCLUDING ANY EXCAVATION, TO DETERMINE THE ACTUAL LOCATION OF UTILITIES AND OTHER IMPROVEMENTS, PRIOR TO STARTING THE WORK. ANY CHANGES FROM THIS PLAN SHALL BE COORDINATED WITH AND APPROVED BY THE ENGINEER.

Weighted E Method



Developed On-Site Basins											
Basin	Area (sf)	Area (acres)	Treatment A				Treatment B				1st Flush Volume (ft³)
			%	(acres)	%	(acres)	%	(acres)	%	(acres)	
1	36,471	0.84	0%	0	73%	0.61	0%	0	27%	0.23	213
2	19,484	0.45	0%	0	22%	0.10	0%	0	78%	0.35	329
3	13,027	0.30	0%	0	16%	0.05	0%	0	84%	0.25	237
4	37,672	0.86	0%	0	8%	0.07	0%	0	92%	0.80	751
5	1,106	0.03	0%	0	0%	0.00	0%	0	100%	0.03	24
6	1,739	0.04	0%	0	0%	0.00	0%	0	100%	0.04	38
7	600	0.01	0%	0	0%	0.00	0%	0	100%	0.01	13
Total Discharge										6.13	
Undeveloped On-Site Basins											
Basin	Area (sf)	Area (acres)	Treatment A				Treatment B				1st Flush Volume (ft³)
			%	(acres)	%	(acres)	%	(acres)	%	(acres)	
1	110,000	2.53	0%	0	0%	0.00	100%	2.525	0%	0.00	7.93

Pipe Capacity

Pipe	D (in)	Slope (%)	Area (ft²)	R	Q Provided (cfs)	Q Required (cfs)	Velocity (ft/s)
1	12	0.6	0.79	0.250	3.27	3.90	4.97
2	10	0.73	0.55	0.208	2.22	1.86	3.41
3	12	1.9	0.79	0.250	5.82	5.76	7.33

Manning's Equation:
 $Q = 1.49 \text{ in}^3 \cdot A \cdot R^{2/3} \cdot S^{1/2}$

A = Area
R = D/4
S = Slope
n = 0.011

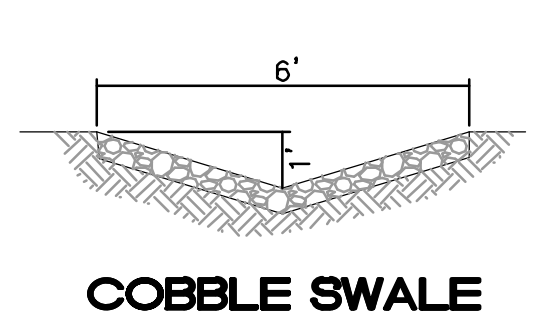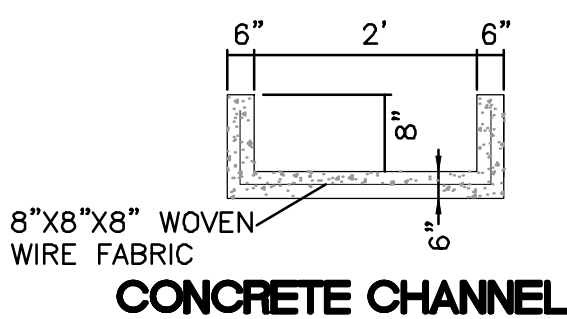

ENGINEER'S SEAL

RONALD R. BOHANNAN
NEW MEXICO
PROFESSIONAL ENGINEER
7868
01/28/2020
RONALD R. BOHANNAN
P.E. #32784

U-HAUL
4TH AND I-40
GRADING AND DRAINAGE
PLAN

TERRA WEST, LLC
5571 MIDWAY PARK PLACE NE
ALBUQUERQUE, NM 87109
(505) 858-3100
www.tierrowestllc.com

DRAWN BY
RMG
DATE
01/21/2020
2019070-GR
SHEET #
MU-3
JOB #
2019070