CITY OF ALBUQUERQUE

Planning Department
Brennon Williams, Director



August 13, 2021

Martin Grummer, RA Martin Grummer Architect 331 Wellesley Pl. NE Albuquerque, NM 87106

Re: Mountaintop Extracts

1912 1st St. NW 87102

30-Day Temporary Certificate of Occupancy Transportation Development Final Inspection Engineer's/Architect's Stamp dated 1-7-21 (H14D113)

Certification dated 8-9-21

Dear Mr. Grummer,

Based upon the information provided in your submittal received 8-9-21, Transportation Development has no objection to a <u>30-day Temporary Certificate of Occupancy</u> based. This letter serves as a "green tag" from Transportation Development for a <u>30-day Temporary</u> Certificate of Occupancy to be issued by the Building and Safety Division.

PO Box 1293

Prior to the issuance of a permanent Certificate of Occupancy, the following items must be addressed:

Albuquerque

Please send pictures of the Bike Rack and ADA Signage.

NM 87103

Once these corrections are complete, email pictures showing the changes to epomez@cabq.gov for release of Final CO.

If you have any questions, please contact me at (505) 924-3981.

www.cabq.gov


Sincerely,

Ernie Gomez, Plan Checker, Planning Dept. Development Review Services

EG via: email C: CO Clerk, File

MOUNTAINTOP EXTRACTS LLC

NEW BUILDING ADDITION 1912 FIRST STREET NW ALBUQUERQUE, NEW MEXICO 87102

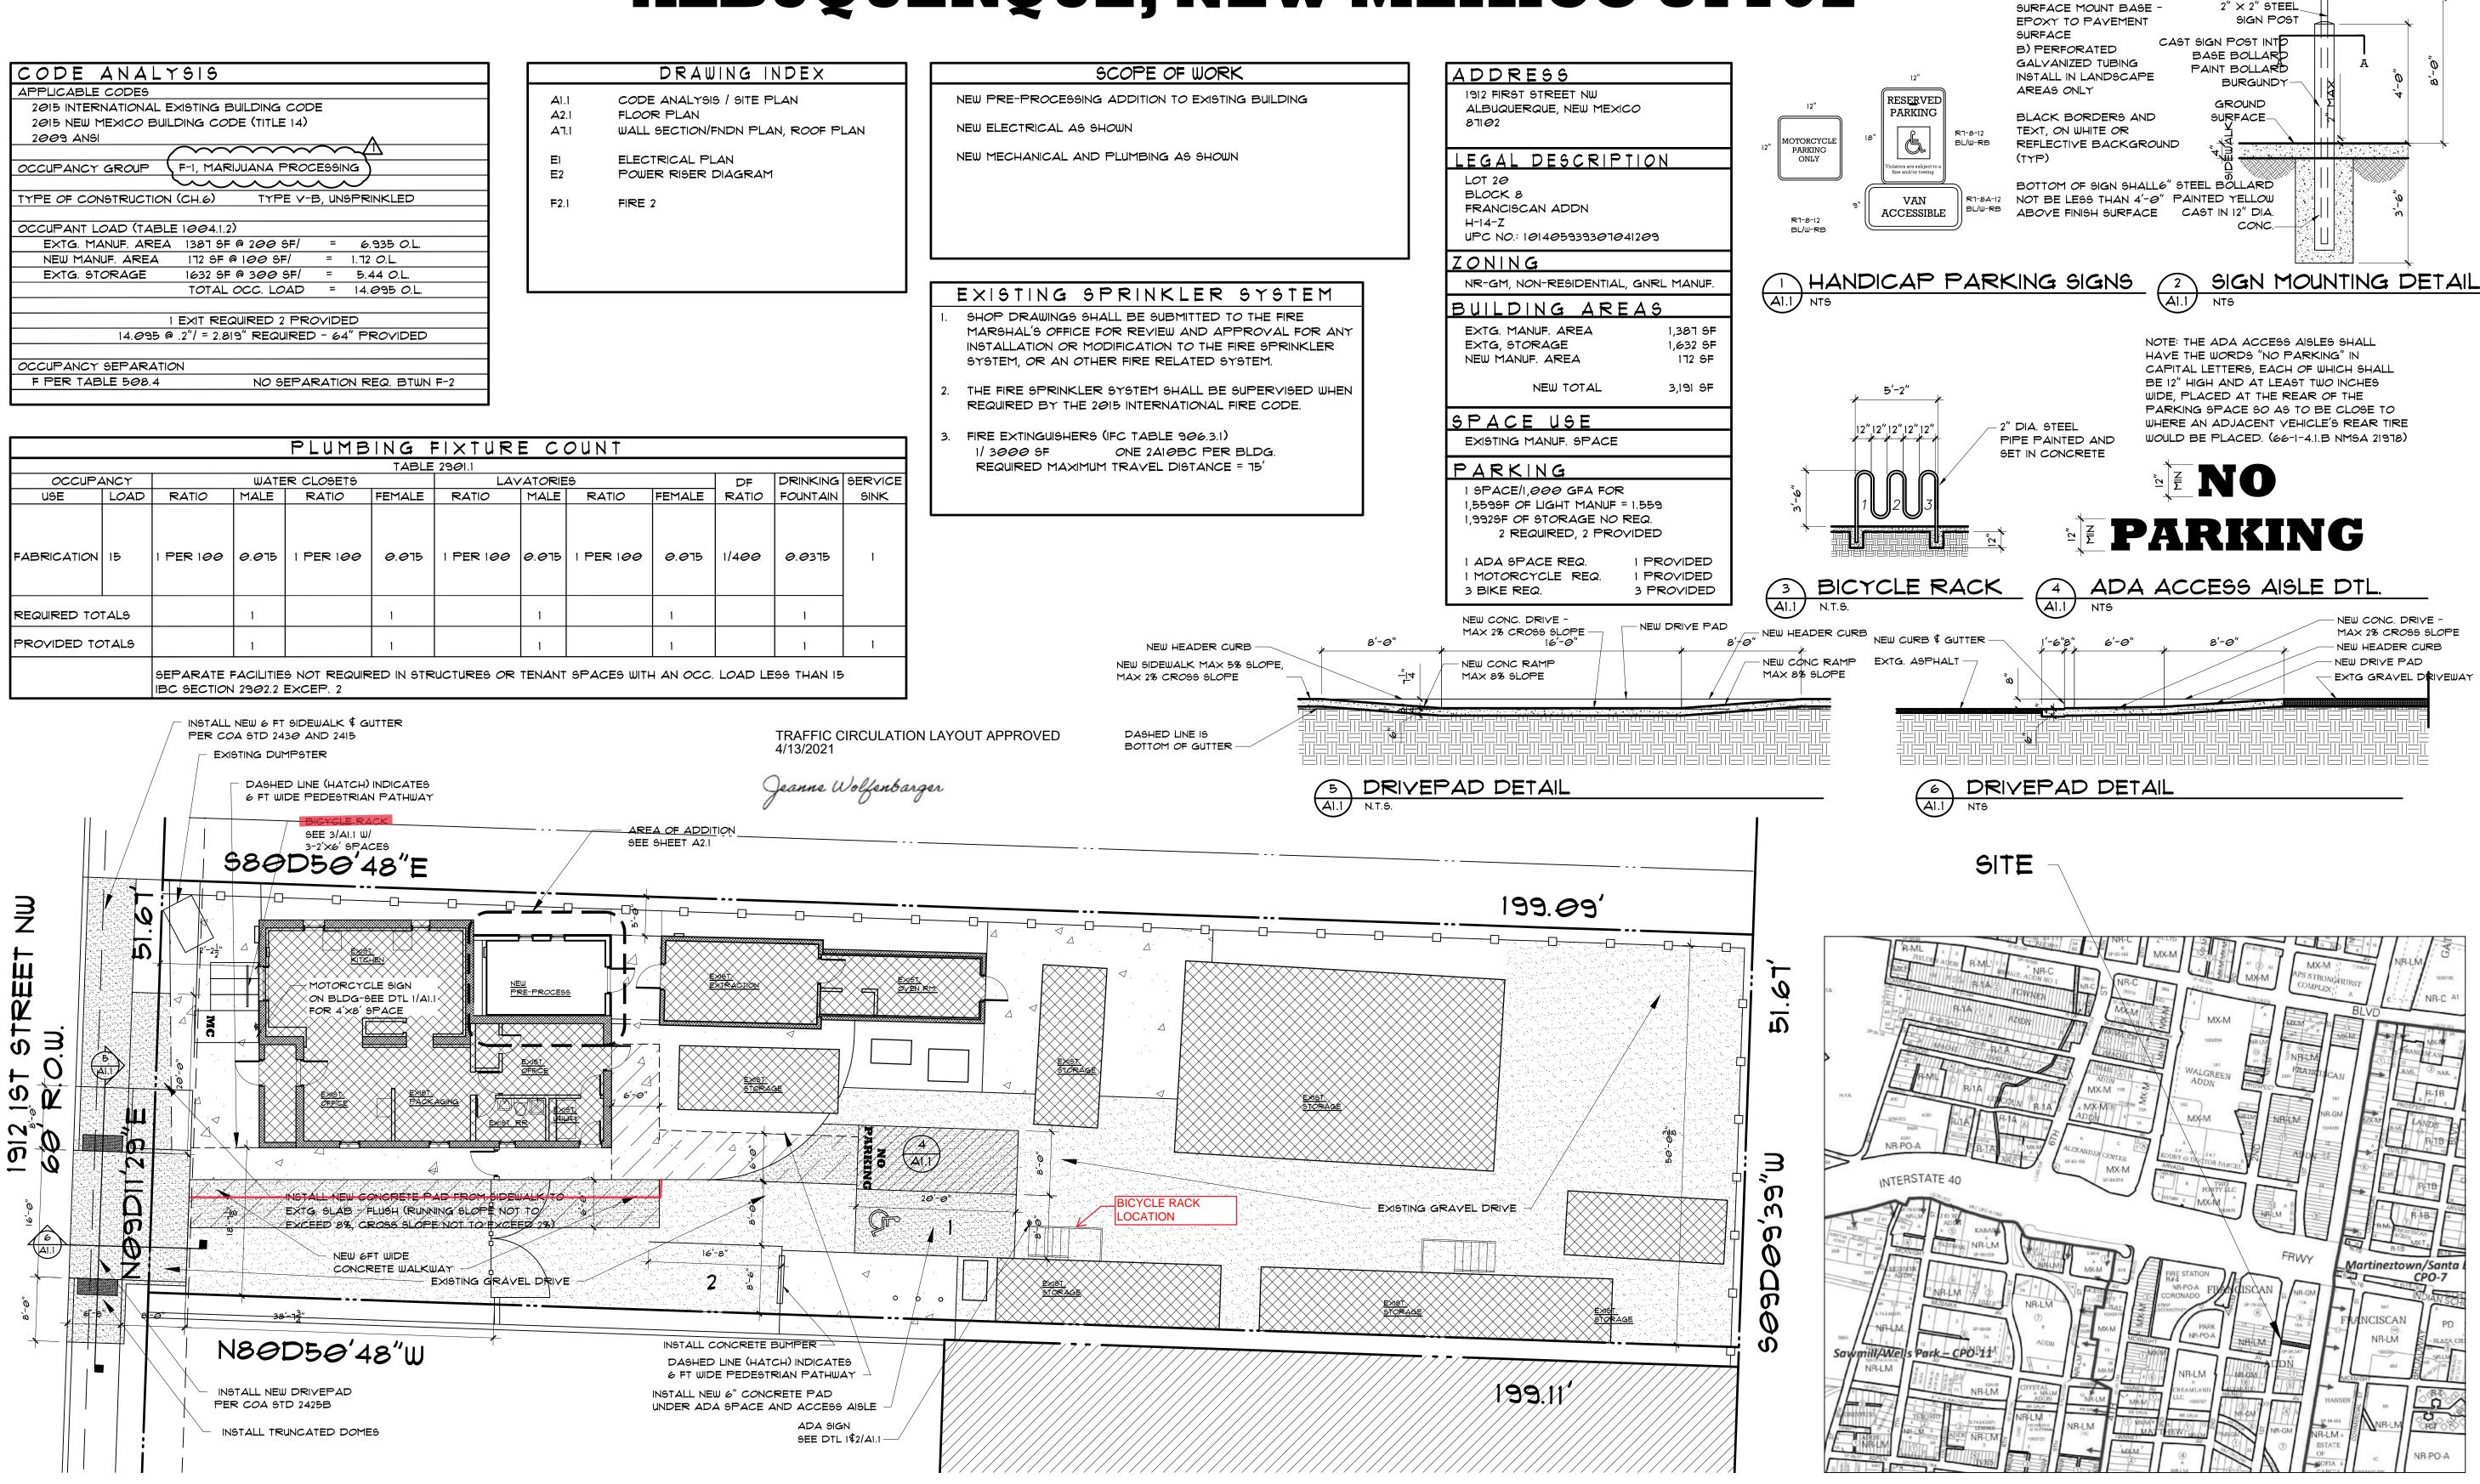

1" = 10'-0'

SITE PLAN



MARTIN FM GRUMMER
ARCHITECT

331 WELLESLEY PLACE NE
ALBUQUERQUE, NEW MEXICO 87106

NOTE: LETTERING SHALL BE

A) FLEXIBLE P.E. POST WITH

FHWA SERIES "B" ALPHABET

MOUNTING OPTIONS

VICINITY MAP

A

NG ADDITION STREET NW NEW MEXICO 87102

TCL

DATE:
12 APR 2021

DRAWN BY:
MFMG

CHECKED BY:


VERIFIED BY:

REVISIONS

14 JAN 2021

SHEET NO:

A1.1

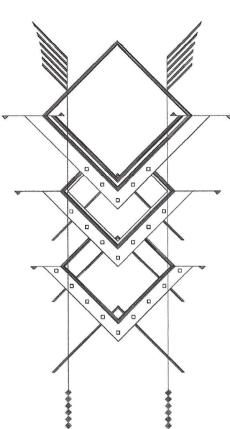

TRAFFIC CERTIFICATION

I, MARTIN GRUMMER, NMRA 2044, OF THE FIRM MARTIN GRUMMER - ARCHITECT, HEREBY CERTIFY THAT THIS PROJECT IS IN SUBSTANTIAL COMPLIANCE WITH AND IN ACCORDANCE WITH THE DESIGN INTENT OF THE APPROVED PLAN DATED 12 Apr 2021. THE RECORD INFORMATION EDITED ONTO THE ORIGINAL DESIGN DOCUMENT HAS BEEN OBTAINED BY MARTIN GRUMMER OF THE FIRM MARTIN GRUMMER - ARCHITECT. I FURTHER CERTIFY THAT I HAVE PERSONALLY VISITED THE PROJECT SITE ON 6 Aug 2021 AND HAVE DETERMINED BY VISUAL INSPECTION THAT THE SURVEY DATA PROVIDED IS REPRESENTATIVE OF ACTUAL SITE CONDITIONS AND IS TRUE AND CORRECT TO THE BEST OF MY KNOWLEDGE AND BELIEF. THIS CERTIFICATION IS SUBMITTED IN SUPPORT OF A REQUEST FOR CERTIFICATE OF OCCUPANCY.

BICYCLE RACK WAS NOT INSTALLED AS DRAWN BUT WAS RELOCATED TO BE JUST EAST OF THE ADA SIGNAGE AND PARKING SPACE. THE OWNER WAS CONCERNED WITH THEFT IN THE NEIGHBORHOOD AND WANTED IT LOCATED BEHIND THE GATE.

THE RECORD INFORMATION PRESENTED HEREON IS NOT NECESSARILY COMPLETE AND INTENDED ONLY TO VERIFY SUBSTANTIAL COMPLIANCE OF THE TRAFFIC ASPECTS OF THIS PROJECT. THOSE RELYING ON THE RECORD DOCUMENT ARE ADVISED TO OBTAIN INDEPENDENT VERIFICATION OF ITS ACCURACY BEFORE USING IT FOR ANY OTHER PURPOSE.

Martin FM Grummer

Date: 9 August 2021

MARTIN FM GRUMMEI
ARCHITECT
331 WELLESLEY PLNE ALBUQUERQUE, NM 8710
505-265-2507 mgrummer@centurylink.ne



City of Albuquerque

Planning Department

Development & Building Services Division

DRAINAGE AND TRANSPORTATION INFORMATION SHEET (REV 6/2018)

		nit #: BP-2021-00986 Hydrology File #:
		Work Order#:
-		ion
City Address: 1912 First St NW, ABQ, N	1101 07 102	
Applicant: Martin Grummer		Contact: Martin
Address: 331 Wellesley PI NE		
Phone#: 505-265-2507	Fax#:	E-mail: mgrummer@centurylink.ne
Other Contact: Eric Merryman		Contact:
4040 = 4 04 1 114		
		E-mail:
		RESIDENCE DRB SITE TCLADMIN SITE
IS THIS A RESUBMITTAL? Yes	No	
DEPARTMENT X TRANSPORTATION		OLOGVIDDANIA GE
DEPARTMENT TRANSPORTATION	HYDR	.OLOGY/DRAINAGE
Check all that Apply: TYPE OF SUBMITTAL: ENGINEER/ARCHITECT CERTIFICATION PAD CERTIFICATION CONCEPTUAL G & D PLAN GRADING PLAN DRAINAGE REPORT DRAINAGE MASTER PLAN FLOODPLAIN DEVELOPMENT PERMIT A ELEVATION CERTIFICATE CLOMR/LOMR X TRAFFIC CIRCULATION LAYOUT (TCL) TRAFFIC IMPACT STUDY (TIS) STREET LIGHT LAYOUT OTHER (SPECIFY) PRE-DESIGN MEETING?	APPLIC	TYPE OF APPROVAL/ACCEPTANCE SOUGHT: BUILDING PERMIT APPROVAL X CERTIFICATE OF OCCUPANCY PRELIMINARY PLAT APPROVAL SITE PLAN FOR SUB'D APPROVAL SITE PLAN FOR BLDG. PERMIT APPROVAL FINAL PLAT APPROVAL SIA/ RELEASE OF FINANCIAL GUARANTEE FOUNDATION PERMIT APPROVAL GRADING PERMIT APPROVAL SO-19 APPROVAL PAVING PERMIT APPROVAL GRADING/ PAD CERTIFICATION WORK ORDER APPROVAL CLOMR/LOMR FLOODPLAIN DEVELOPMENT PERMIT
		OTHER (SPECIFY)
DATE SUBMITTED: 9 Aug 2021	By: Marti	n Grummer
COA STAFF:	ELECTRONIC SI	UBMITTAL RECEIVED:

FEE PAID:_____