## CITY OF ALBUQUERO

Planning Department Alan Varela, Director



Mayor Timothy M. Keller

July 13, 2023

Dan Ponder, P.E. Short Elliott Hendrickson Inc. 934 Main Ave., Unit C Durango, CO 81301

Re: **NUVUE 6th & Cutler** 

2300 6th St NW

**Traffic Circulation Layout** 

Engineer's Stamp 06-26-23 (H14D117)

Dear Mr. Ponder,

The TCL re-submittal received 6-27-2023 is approved for Building Permit by Transportation. A copy of the stamped and signed plan will be needed for each of the building permit plans. Please keep the original to be used for certification of the site for final C.O. for Transportation.

PO Box 1293

Albuquerque

When the site construction is completed and an inspection for Certificate of Occupancy (C.O.) is requested, use the original City stamped approved TCL for certification. Redline any minor changes and adjustments that were made in the field. A NM registered architect or engineer must stamp, sign, and date the certification TCL along with indicating that the development was built in "substantial compliance" with the TCL. Submit this certification, the TCL, and a completed Drainage and Transportation Information Sheet to the PLNDRS@cabq.gov for log in and evaluation by Transportation.

NM 87103

Once verification of certification is completed and approved, notification will be made to Building Safety to issue Final C.O. To confirm that a final C.O. has been issued, call Building Safety at 924-3690.

www.cabq.gov

Sincerely,

Ernest Armijo, P.E.

Principal Engineer, Planning Dept. Development Review Services

C: CO Clerk, File




# **City of Albuquerque**

#### Planning Department

#### Development & Building Services Division


#### DRAINAGE AND TRANSPORTATION INFORMATION SHEET

| Project Title: NuVue - 6th and Cutler                           | Building Permit #_TBDHydrology File #_TBD                     |
|---|---|
| DRB#_TBD  | EPC#TBD   |
| Legal Description: TR A BLK B LINCOLN AD OF LTS 9 10 & POR OF 1 | DDN (REPL City Address OR Parcel 2300 6th Street NW 11 BLK B) |
| Applicant/Agent: SEH, Inc.                                      | Contact: Philip Rennhack                                      |
| Address: 934 Main Avenue, Unit C Durango                        |   |
| Email: prennhack@sehinc.com                                     |   |
| Applicant/Owner: NuVue Pharma                                   | Contact: Paul Julian  |
| Address: 4740 Dillon Drive Pueblo, CO 8130                      | Phone: 919.619.2443   |
| Email: paulj@nuvuepharma.com                                    |   |
| TYPE OF DEVELOPMENT:PLAT (#of 1 RE-SUBMITTAL:YESX_ NO           | ots)RESIDENCEDRB SITE _X_ ADMIN SITE:                         |
| <b>DEPARTMENT:</b> XTRANSPORTATION Check all that apply:        | ON HYDROLOGY/DRAINAGE   |
| TYPE OF SUBMITTAL:  | TYPE OF APPROVAL/ACCEPTANCE SOUGHT:                           |
| ENGINEER/ARCHITECT CERTIFICATION                                | X_BUILDING PERMIT APPROVAL                                    |
| PAD CERTIFICATION   | CERTIFICATE OF OCCUPANCY                                      |
| CONCEPTUAL G&D PLAN   | CONCEPTUAL TCL DRB APPROVAL                                   |
| GRADING PLAN  | PRELIMINARY PLAT APPROVAL                                     |
| DRAINAGE REPORT   | SITE PLAN FOR SUB'D APPROVAL                                  |
| DRAINAGE MASTER PLAN  | SITE PLAN FOR BLDG PERMIT APPROVAL                            |
| FLOOD PLAN DEVELOPMENT PERMIT A                                 | PPFINAL PLAT APPROVAL   |
| ELEVATION CERTIFICATE   | SIA/RELEASE OF FINANCIAL GUARANTEE                            |
| CLOMR/LOMR  | FOUNDATION PERMIT APPROVAL                                    |
| TRAFFIC CIRCULATION LAYOUT (TCL)                                | GRADING PERMIT APPROVAL                                       |
| ADMINISTRATIVE  | SO-19 APPROVAL  |
| X TRAFFIC CIRCULATION LAYOUT FOR D                              | RBPAVING PERMIT APPROVAL                                      |
| APPROVAL  | GRADING PAD CERTIFICATION                                     |
| TRAFFIC IMPACT STUDY (TIS)                                      | WORK ORDER APPROVAL   |
| STREET LIGHT LAYOUT   | CLOMR/LOMR  |
| OTHER (SPECIFY)   | FLOOD PLAN DEVELOPMENT PERMIT                                 |
| PRE-DESIGN MEETING?   | OTHER (SPECIFY)   |
| DATE SUBMITTED: 06.06.2023                                      |   |

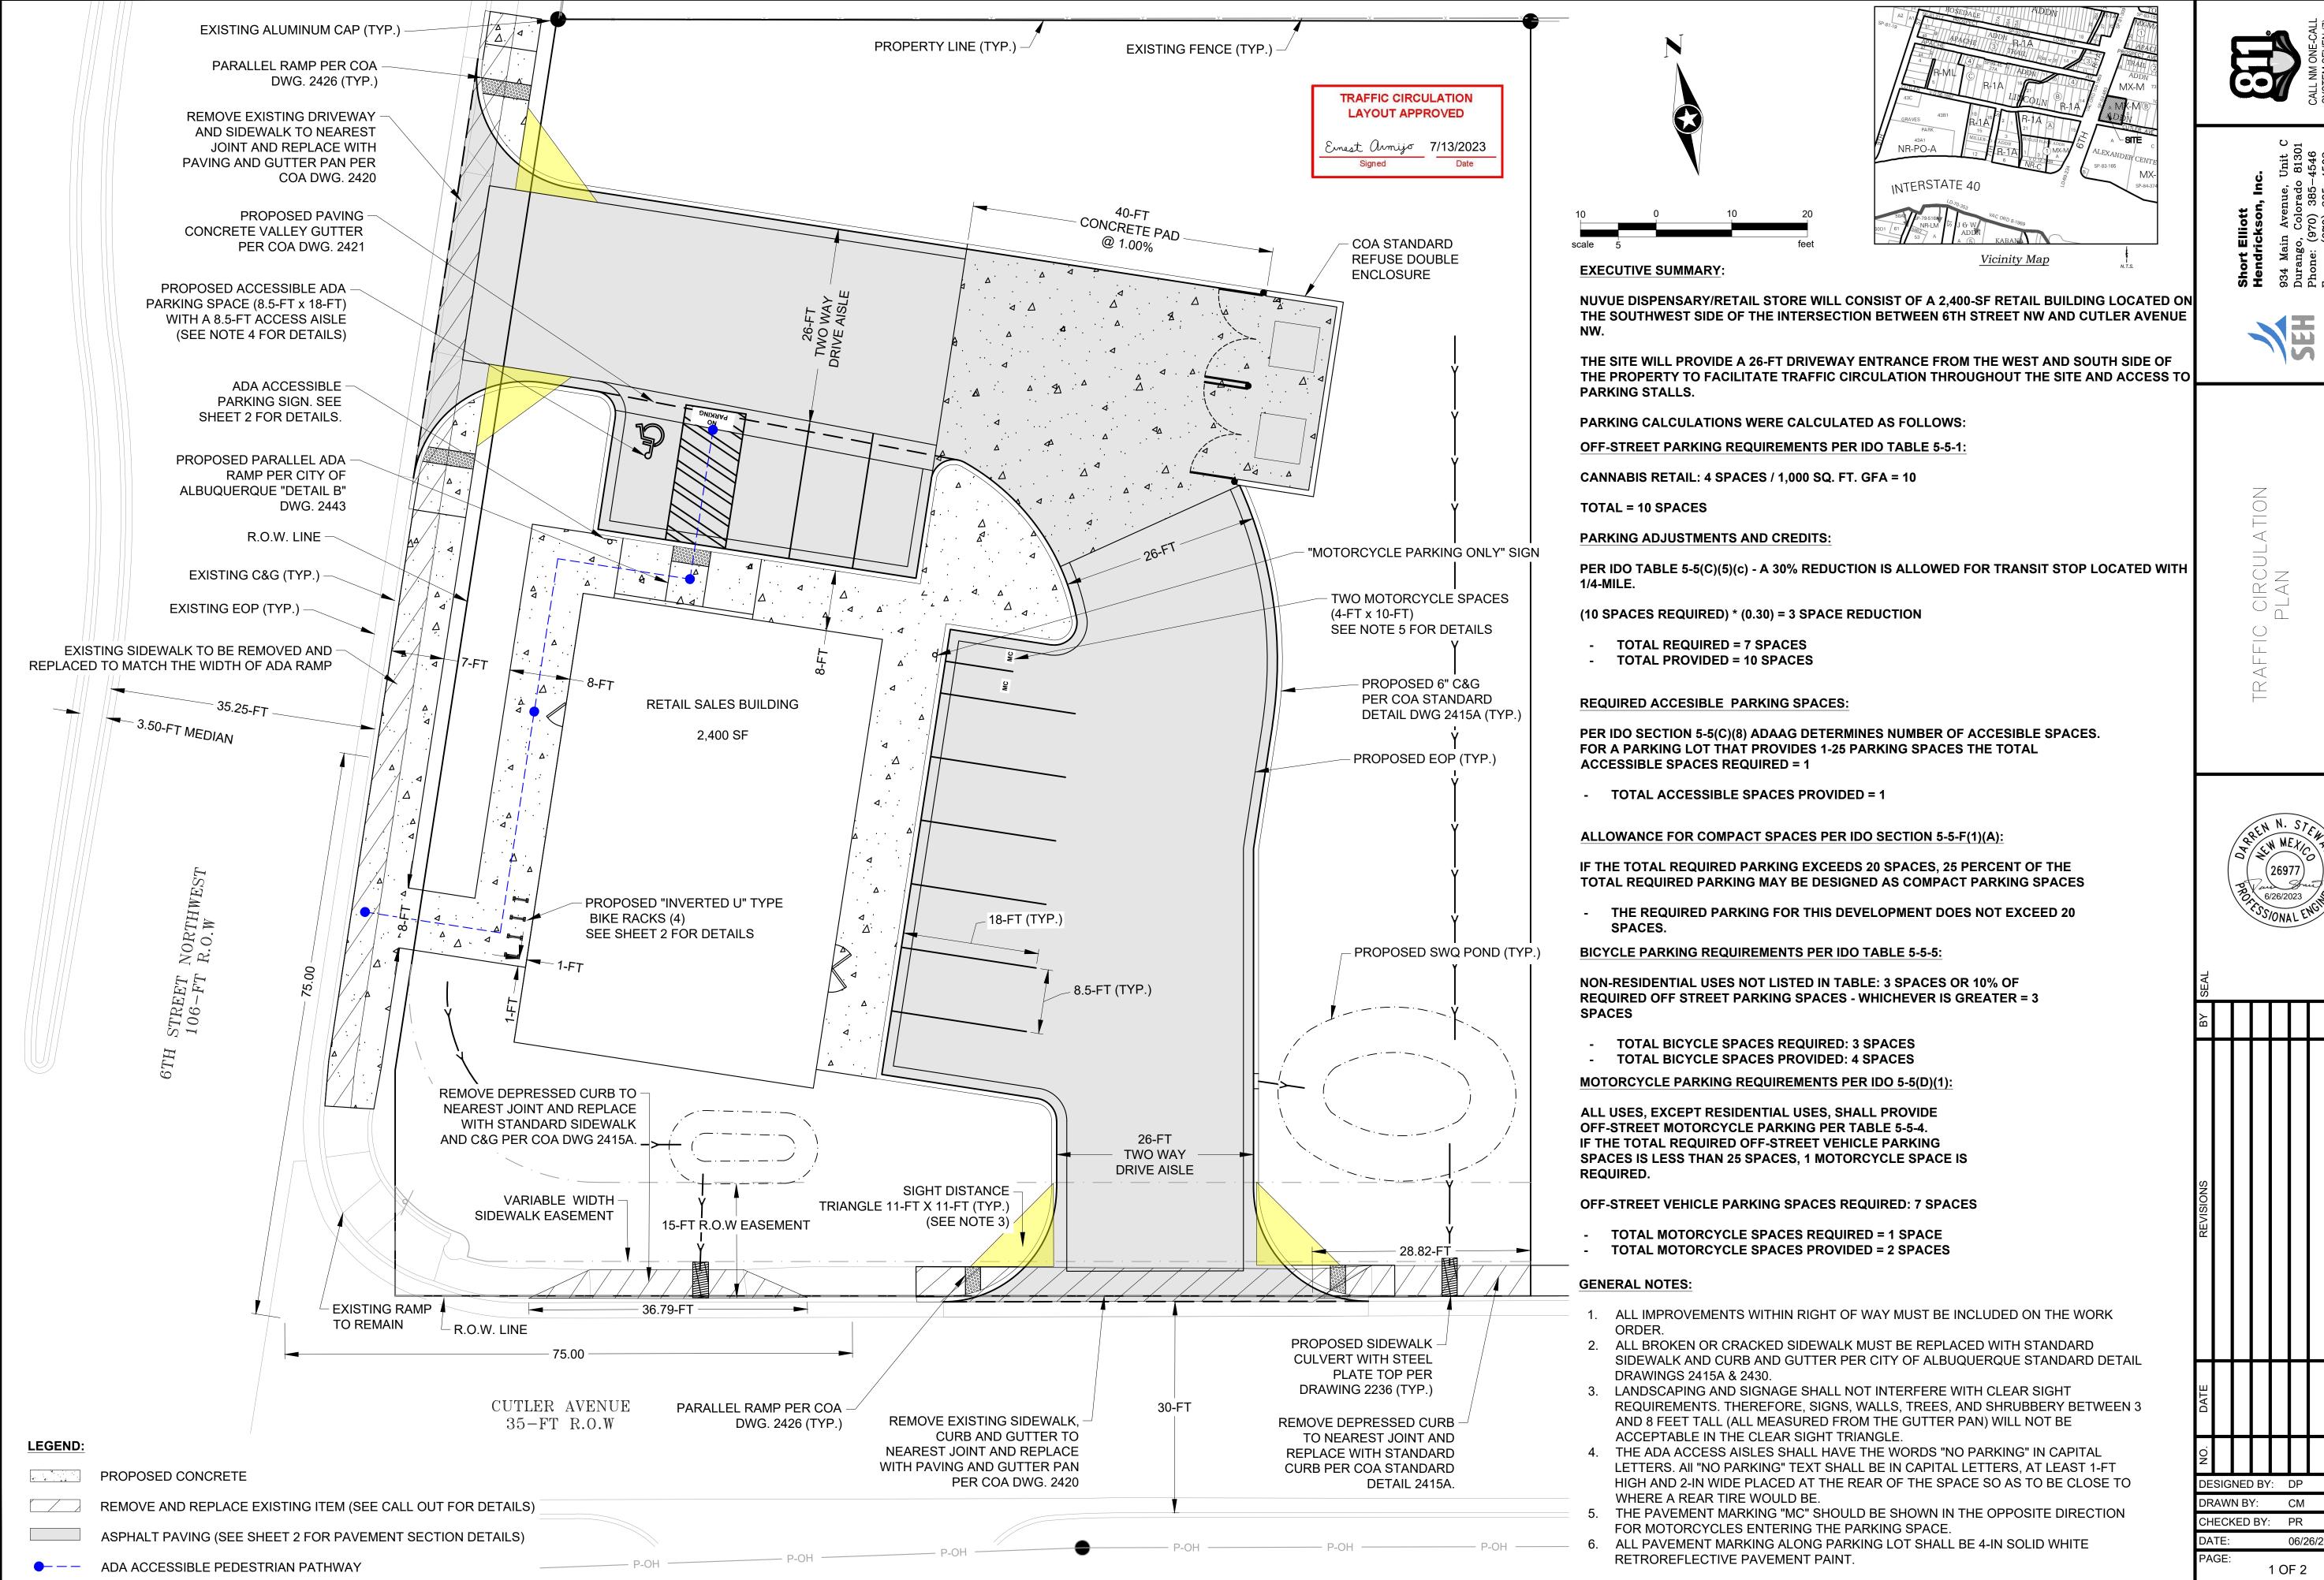


CM 06/26/2023

CHECKED BY: PR 1 OF 2

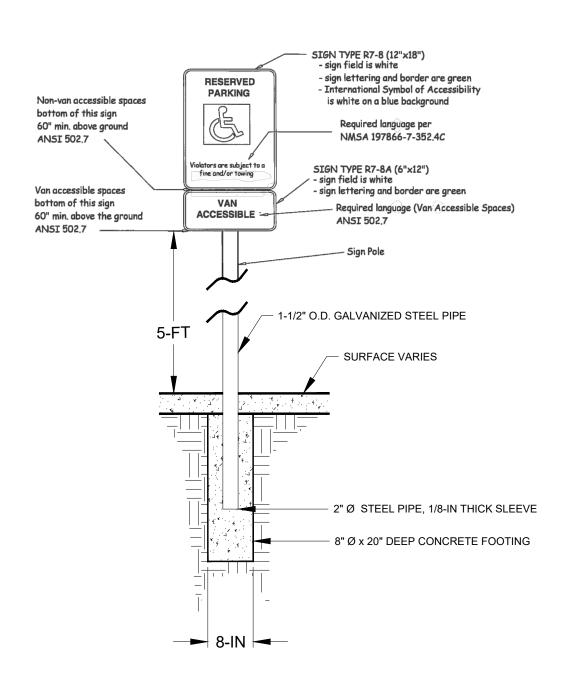



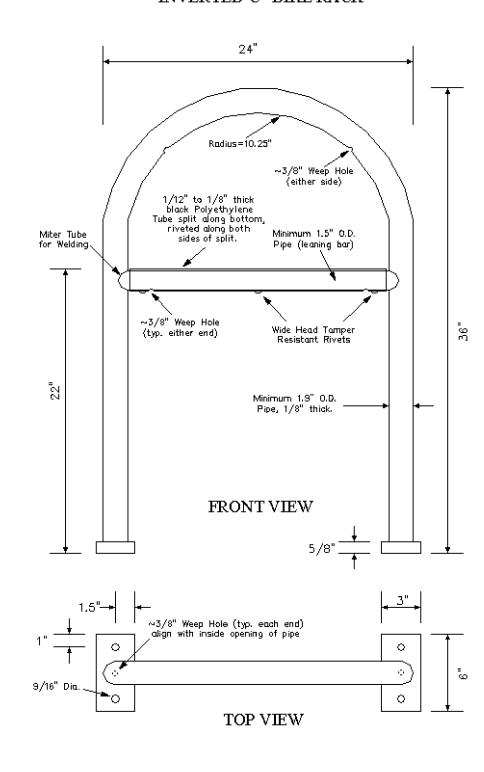




- 1. OFF-STREET BICYCLE RACKS SHALL BE BUILT IN ACCORDANCE TO SECTION 7-5(K)(2) OF THE CITY OF ALBUQUERQUE DEVELOPMENT PROCESS MANUAL.
- 2. BICYCLE RACKS SHALL BE ANCHORED TO A CONCRETE PAD.
- 3. A 1-FT CLEAR ZONE AROUND BICYCLE PARKING STALL SHALL BE
- 4. BICYCLE PARKING SPACES SHALL BE AT LEAST 6-FT LONG AND 2-FT WIDE.

TRAFFIC CIRCULATION LAYOUT APPROVED



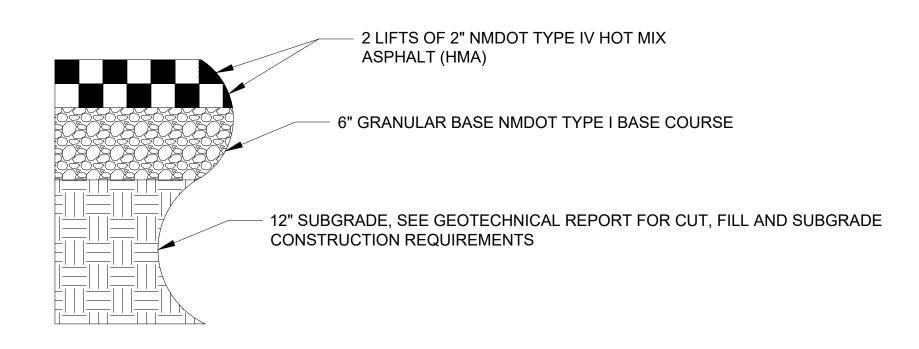








DETAIL TYPICAL


DESIGNED BY: DP DRAWN BY: CM

CHECKED BY: PR

06/26/2023

2 OF 2

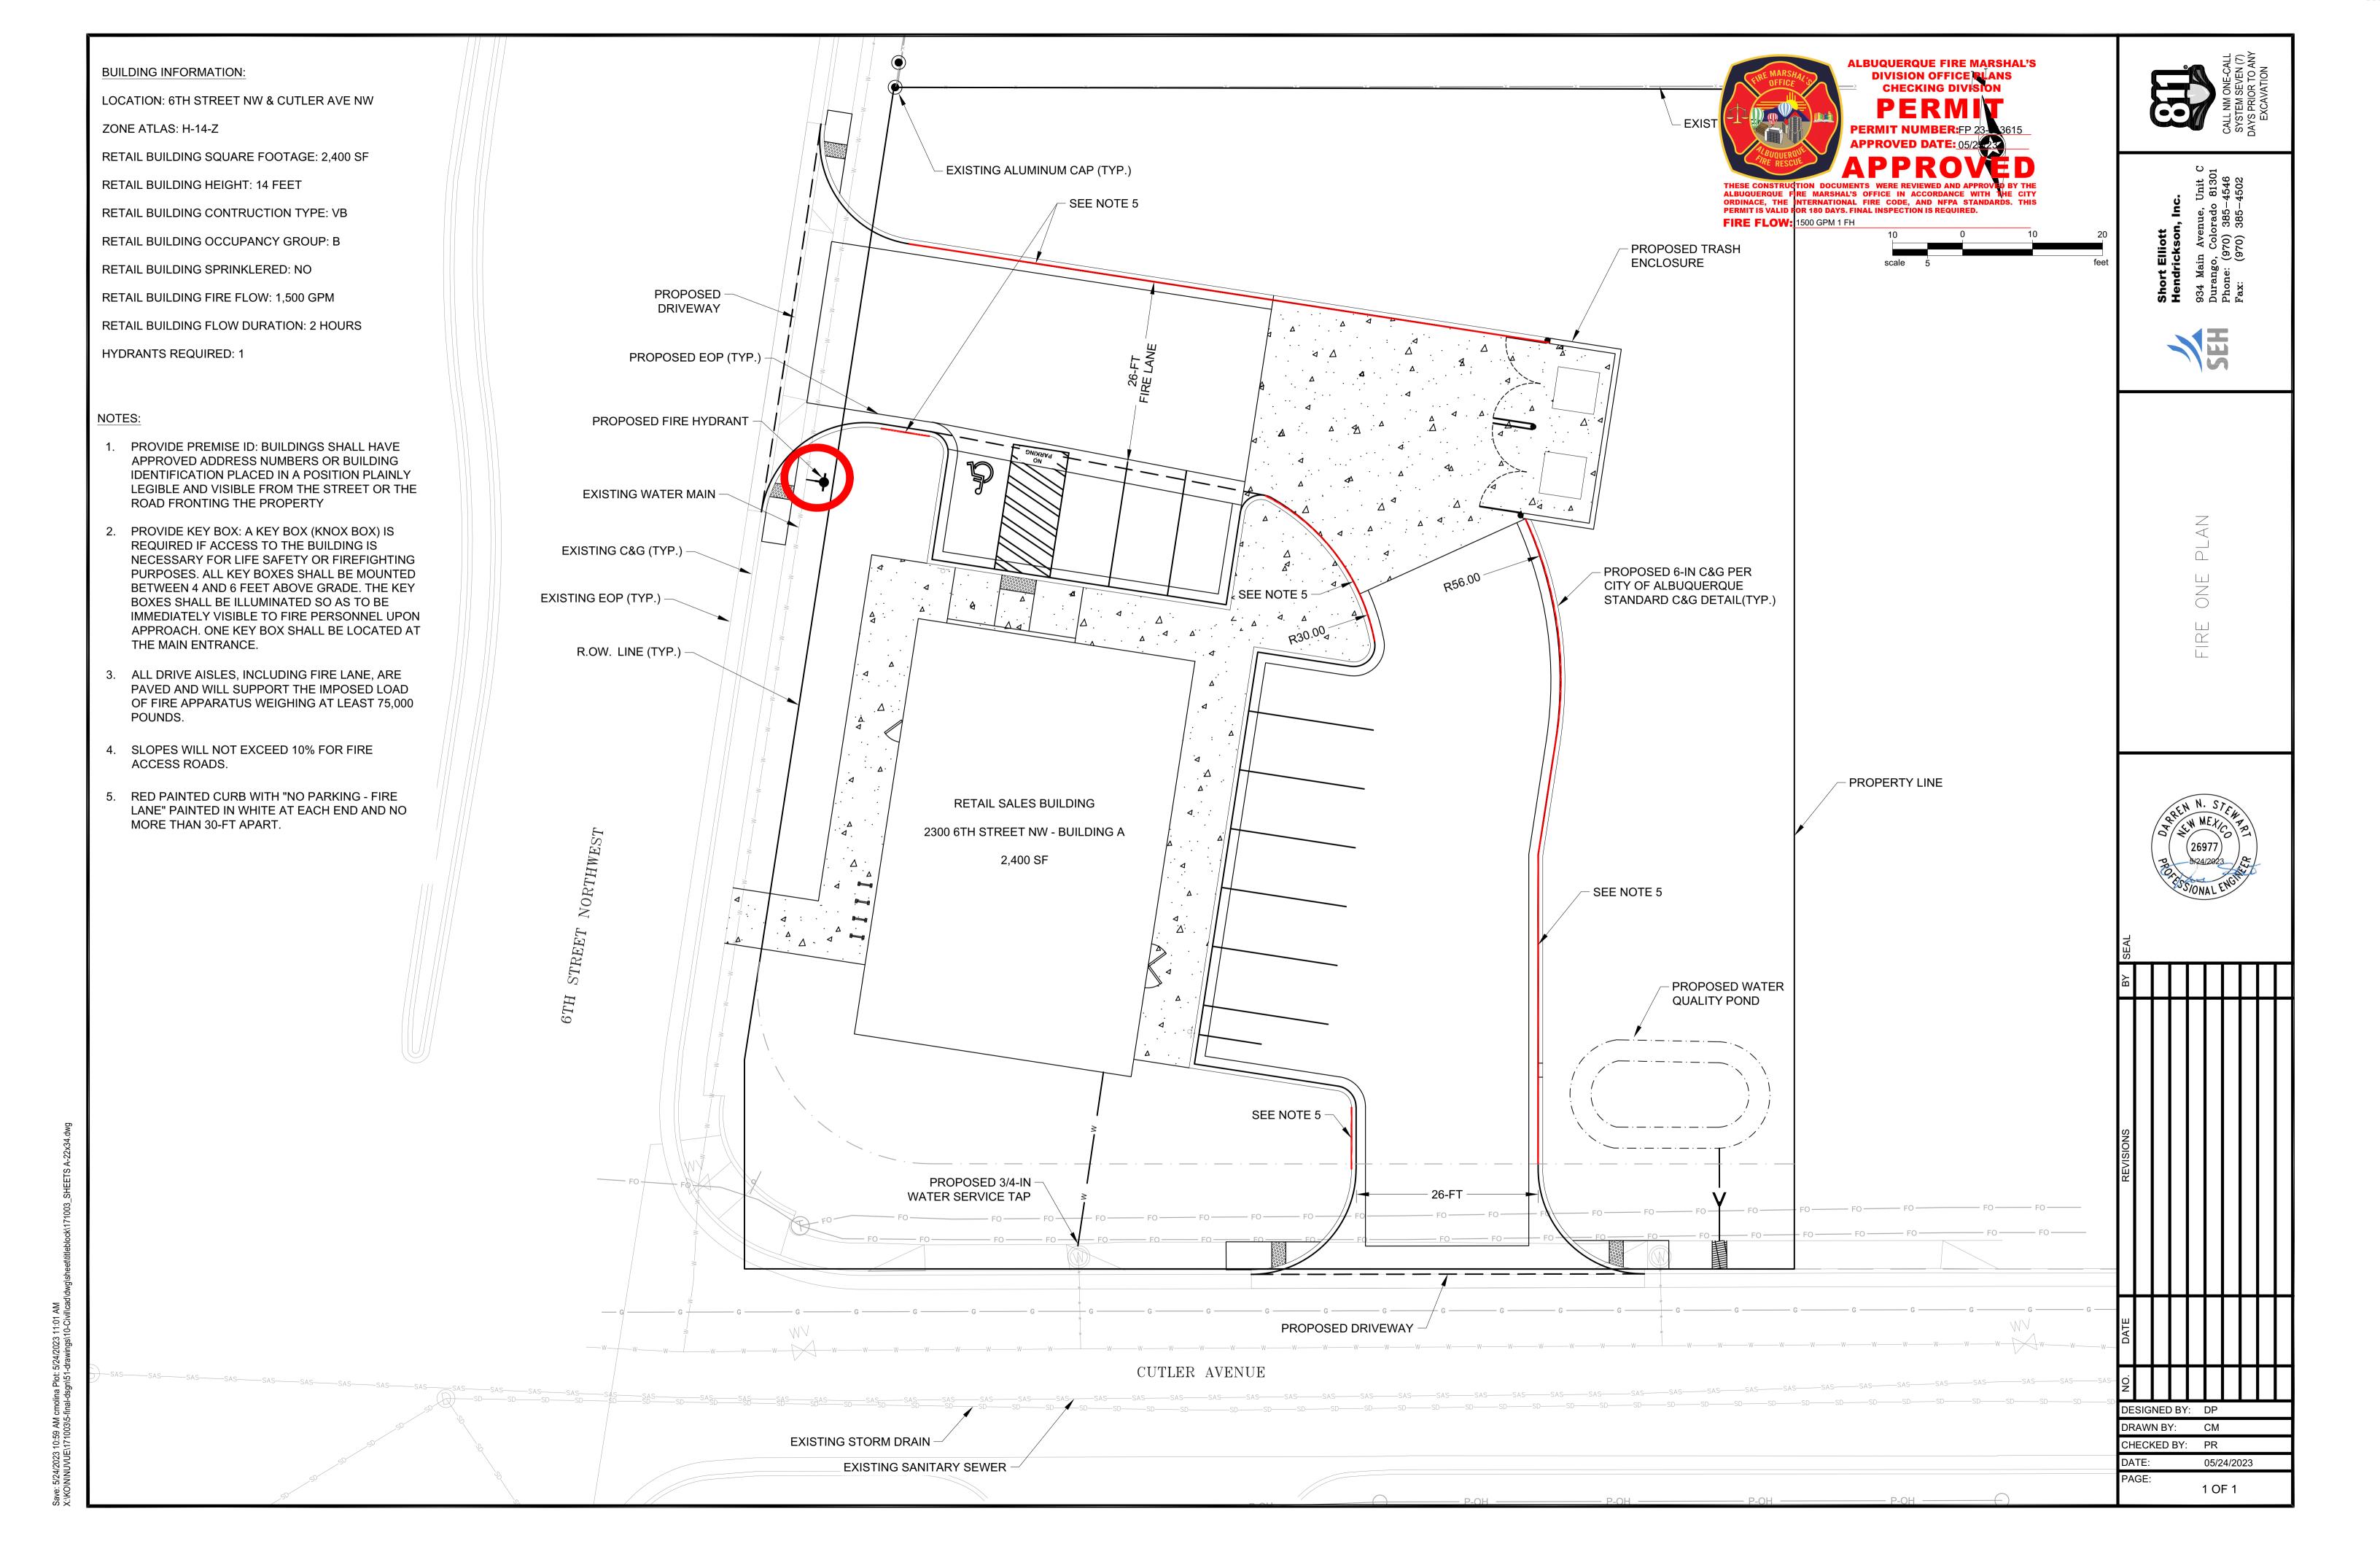

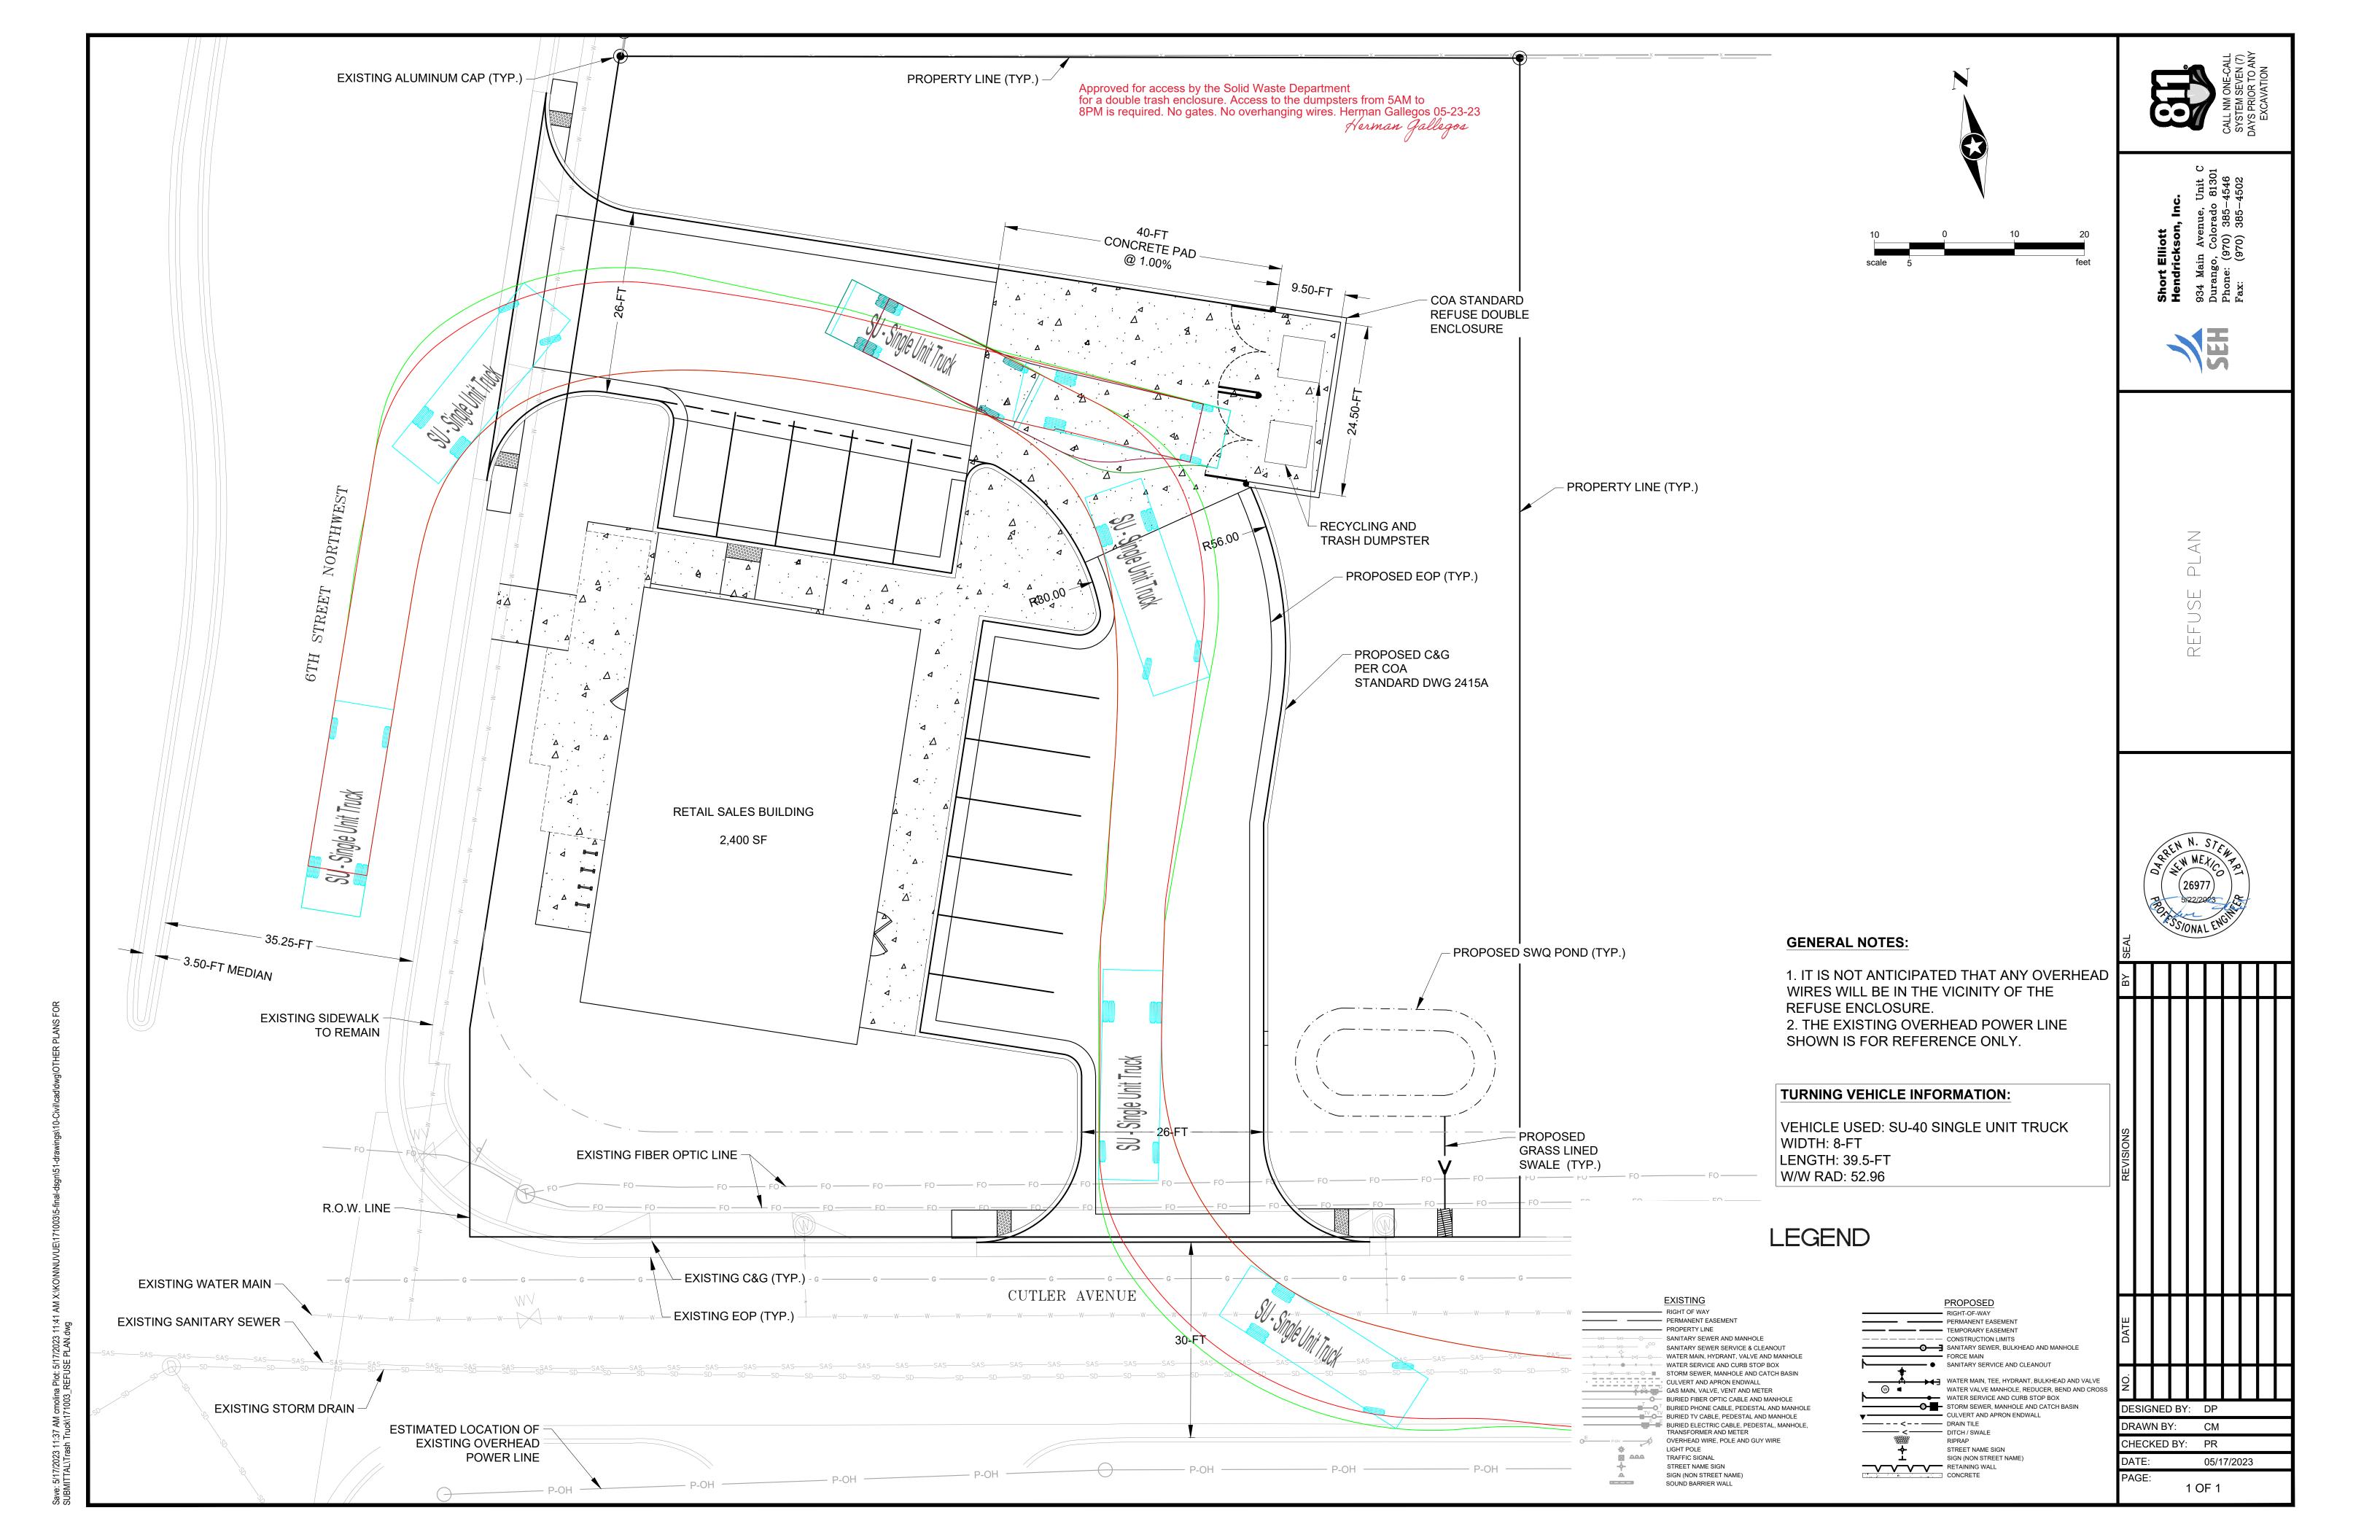

#### Doc# 2023037536

06/16/2023 11:03 AM Page: 1 of 6 EASE R:\$25.00 Linda Stover, Bernalillo County

#### PUBLIC SIDEWALK EASEMENT

Project No: H14D117

Project Name: NuVue - 6th and Cutler 2300 6th St. NW (H14D117)

Grant of Sidewalk Easement, between 4740 Dillon Drive, LLC ("Grantor"), whose address is 4740 Dillon Drive, Pueblo, CO 81008 and whose telephone number is (919) 619-2443 and the City of Albuquerque, a New Mexico municipal corporation ("City"), whose address is P.O. Box 1293, Albuquerque, NM, 87103.

Grantor, for and in certain valuable non-monetary consideration received from the City, the receipt of which is acknowledged by Grantor, does hereby give, bargain, sell, grant and convey unto City an exclusive, perpetual sidewalk easement ("Easement") in, over, upon and across the real property described on **Exhibit** "A" with the Legal Description set forth in Exhibit A and attached hereto ("Property") for the construction, installation, maintenance, repair, modification, replacement and operation of a public sidewalk easement, together with the right to remove trees, bushes, undergrowth and any other obstacles upon the Property if the City determines they interfere with the appropriate use of this Easement.

In the event Grantor constructs any improvements ("Improvements") within the Easement, the City has the right to enter upon Grantor's property at any time and perform whatever inspection, installation, maintenance, repair, modification or removal ("Work") it deems appropriate without liability to the City. If the Work effects any Improvements or encroachments made by the Grantor, the City will not be financially or otherwise responsible for rebuilding or repairing the Improvements or encroachments. If in the opinion of the City, the Work to be performed by the City could endanger the structural integrity or otherwise damage the Improvements or encroachments, the Grantor shall, at its own expense, take whatever protective measures are required to safeguard the Improvements or encroachments.

Grantor covenants and warrants that Grantor is the owner in fee simple of the Property, that Grantor has a good lawful right to convey the Property or any part thereof and that Grantor will forever warrant and defend the title to the Property against all claims from all persons or entities.

The grant and other provisions of this Easement constitute covenants running with the Property for the benefit of the City and its successors and assigns until terminated.

This Easement shall not be effective until approved by the City Engineer and recorded at the Bernalillo County Clerk.

| GRANTOR: 4740 Dillon Drive, LLC  |
|--|
| By [signature]: Van Julin  |
| Name [print]: Paul Julian  |
| Title: Lorporate Counsel   |
| Date: 6/1/23   |
|  |
| GRANTOR'S NOTARY   |
| STATE OF COLORADO ) )ss.   |
| COUNTY OF PUEBLO )   |
| This instrument was acknowledged before me on this day of, 20_23 by Paul   |
| Julian, Corporate Counsel of 4740 Dillon Drive, LLC, the Developer.  |
| STACEY R MANWEILER (SEAL) NOTARY PUBLIC STATE OF COLORADO NOTARY ID# 20054013569 MY COMMISSION EXPIRES APR. 15, 2025  My Commission Expires:  My Commission Expires: |

| CITY OF A          | LBUQUERQUE:  DocuSigned by:           |
|--------------------|---------------------------------------|
| By:<br>Shahab Biaz | Shahab Biayar ar, Prespocity Engineer |
| Date:              | 6/12/2023   8:33 AM MDT               |

#### **CITY'S NOTARY**

STATE OF NEW MEXICO ) )ss.
COUNTY OF BERNALILLO )

This instrument was acknowledged before me on this 124h day of 20 23 by Shahab Biazar, P.E., City Engineer, City of Albuquerque, a municipal corporation, on behalf of said corporation.

(SEAL)

STATE OF NEW MEXICO NOTARY PUBLIC Rachael Miranda Commission No. 1119740 November 09, 2025 Notary Public

My Commission Expires: 11-9-2025

(EXHIBIT "A" ATTACHED)

Exhibit A

# Exhibit for A Portion within Tract "A", Block "B", Lincoln Addition

City of Albuquerque
Bernalillo County, New Mexico
May 2023

Legal Description

A CERTAIN PARCEL, WITHIN TRACT "A", IN BLOCK LETTERED "B", OF LINCOLN ADDITION, AS THE SAME IS SHOWN AND DESIGNATED ON THE PLAT THEREOF, FILED IN THE OFFICE OF THE COUNTY CLERK OF BERNALILLO COUNTY, NEW MEXICO, ON NOVEMBER 2, 1984, IN MAP BOOK C25, FOLIO 103.

BEING MORE PARTICULARLY DESCRIBED BY METES AND BOUNDS AS FOLLOWS;

BEGINNING AT THE SOUTHEAST CORNER OF THE HEREIN DESCRIBED PARCEL, ALSO BEING THE SOUTHEAST CORNER OF SAID TRACT "A" LYING ON THE NORTHERLY RIGHT OF WAY OF CUTLER AVENUE N.W., WHENCE A TIE TO ACS MONUMENT "A-438", BEARS N 66'08'21" E, A DISTANCE OF 2159.13 FEET;

THENCE, FROM SAID POINT OF BEGINNING, COINCIDING SAID CUTLER AVENUE N.W. RIGHT OF WAY, N 79°09'16" W, A DISTANCE OF 150.00 FEET, TO THE SOUTHWEST CORNER OF THE HEREIN DESCRIBED PARCEL, ALSO BEING THE SOUTHWEST CORNER OF SAID TRACT "A", LYING ON THE EASTERLY RIGHT OF WAY OF 6TH STREET NW;

THENCE, LEAVING SAID NORTHERLY CUTLER AVENUE N.W. RIGHT OF WAY, AND COINCIDING SAID EASTERLY 6TH STREET N.W. RIGHT OF WAY, N 10°50'20" E, A DISTANCE OF 14.54 FEET TO AN ANGLE POINT, BEING THE NORTHWEST CORNER OF THE HEREIN DESCRIBED PARCEL;

CONTINUED ON SHEET 2 OF 3

Surveyor's Certificate

I, BRIAN J. MARTINEZ, A REGISTERED PROFESSIONAL LAND SURVEYOR UNDER THE LAWS OF THE STATE OF NEW MEXICO, DO HEREBY CERTIFY THAT THE EXHIBIT SHOWN HEREON IS TRUE AND CORRECT TO THE BEST OF MY KNOWLEDGE AND BELIEF.

BRIAN J. MARTINEZ N.M.R.P.S. NO. 18374 5/30/23 DATE

CSI-CARTESIAN SURVEYS INC.

P.O. BOX 44414 RIO RANCHO, N.M. 87174 Phone (505) 896 - 3050 Fax (505) 891 - 0244 cartesianbrian@gmail.com



Sheet 1 of 3

Exhibit A

# Exhibit for A Portion within Tract "A", Block "B",

Lincoln Addition

City of Albuquerque Bernalillo County, New Mexico May 2023

### Legal Description

CONTINUED FROM SHEET 1 OF 3

THENCE, LEAVING SAID EASTERLY RIGHT OF WAY, 10.68 FEET ALONG A CURVE TO THE LEFT, NON-TANGENT TO THE PREVIOUS COURSE, HAVING A RADIUS OF 18.66 FEET, A DELTA OF 32°47'05", AND A CHORD BEARING S 42°43'11" E, A DISTANCE OF 10.53 FEET TO A POINT OF REVERSE CURVATURE;

THENCE, 2.95 FEET ALONG A CURVE TO THE RIGHT, HAVING A RADIUS OF 2.00 FEET, A DELTA OF 84°26'44", AND A CHORD BEARING S 16°52'23" E, A DISTANCE OF 2.69 FEET TO A POINT OF TANGENCY;

THENCE, S 25°20'59" W, A DISTANCE OF 0.74 FEET TO AN ANGLE POINT, BEING A POINT OF CURVATURE:

THENCE, 2.69 FEET ALONG A CURVE TO THE LEFT, NON-TANGENT TO THE PREVIOUS COURSE, HAVING A RADIUS OF 23.09 FEET, A DELTA OF 06'39'47", AND A CHORD BEARING S 65'24'53" E, A DISTANCE OF 2.68 FEET TO A POINT OF TANGENCY;

THENCE, S 79°09'16" E, A DISTANCE OF 137.86 FEET TO THE NORTHEAST CORNER OF THE HEREIN DESCRIBED PARCEL, POINT LYING ON THE EAST BOUNDARY LINE OF SAID TRACT "A";


THENCE, COINCIDING WITH SAID EAST BOUNDARY LINE, S 10'50'20" W, A DISTANCE OF 4.55 FEET TO THE POINT OF BEGINNING, CONTAINING 0.0170 ACRES (740 SQ. FT.) MORE OR LESS.

#### Notes

- 1. FIELD SURVEY PERFORMED IN DECEMBER 2022 AND JANUARY 2023.
- 2. ALL DISTANCES ARE GROUND DISTANCES: US SURVEY FOOT.
- 3. THE BASIS OF BEARINGS REFERENCES NEW MEXICO STATE PLANE COORDINATES (NAD 83-CENTRAL ZONE).

# CSI-CARTESIAN SURVEYS INC.

P.O. BOX 44414 RIO RANCHO, N.M. 87174 Phone (505) 896 - 3050 Fax (505) 891 - 0244 cartesianbrian@gmail.com

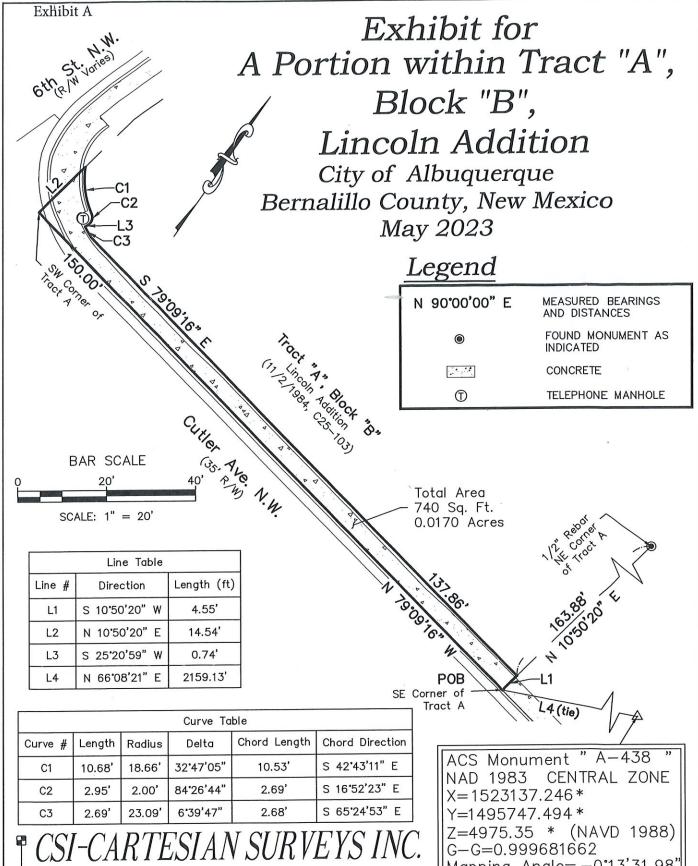

P.O. BOX 44414 RIO RANCHO, N.M. 87174 Phone (505) 896 - 3050 Fax (505) 891 - 0244 cartesianbrian@gmail.com

Mapping Angle= $-0^{\circ}13'31.98'$ 

\*U.S. SURVEY FEET

Sheet 3 of 3

222070