

NEW MEXICO TEXAS COLORADO CORPORATE OFFICE:

MAIL One Park Square 6501 Americas Pkwy NE, Ste. 300 Albuquerque, NM 87110 PH0 505.883.5200

WEB fbtarch.com

REGIONAL OFFICES:

MAIL 500 East 50th Street, Ste. C-2 Lubbock, TX 79404 PH0 806,747.2244

MAIL 415 N. Tejon St. Colorado Springs, CO 80903 PH0 719.309.9440

November 17, 2022

To: Ms. Marwa Al-najjar, Associate Engineer City of Albuquerque, Development Review Services Albuquerque, NM 87102 (505)924-3675 <u>malnajjar@cabq.gov</u>

Project: GAAR 1635 University Blvd. Renovation and Addition-Permit Reference H15-D008

Subject: Reference Letter dated November 7, 2022-Traffic Circulation Layout Review

Ms. Najjar,

We have reviewed the comments regarding the Traffic Circulation Layout (TCL). Below are responses to each item noted:

1. Label the compact parking spaces by placing the words "**COMPACT**" on the pavement of each space.

RESPONSE: Stenciled lettering on the asphalt paving to read "COMPACT" shall be added as part of the project and as shown in the revised TCL Plan.

2. Keynote S01: the aerial shows the parking spaces striping is fading. I'd like to request restripe the parking spaces if applicable.

RESPONSE: ADA spaces will require restriping –Repainting of striping shall be included in the project.

- Key note S69: The minimum width for the pathway should be 4 ft.
 RESPONSE: New pathway shall be adjusted to 4 ft as shown on the revised TCL.
- Key note S81: Call out COA std dwg 2430.
 RESPONSE: Revised keynote to callout per COA std dwg 2430 for required slopes only.
- Key note S82: Please add a note stating that the max. slope for the landing area should be 2% in all direction.
 RESPONSE: Added keynote S82 that add stating that the max. slope for the landing area should be 2% in all direction.
- Key note S90: Please provide face sign details.
 RESPONSE: Added face sign details on sheet TCL2.
- 7. Key note S96: Per the IDO, a 6 ft. wide ADA accessible pedestrian pathway is required from the public sidewalk to the building entrances. Please clearly show this pathway and provide details.

RESPONSE: Hatched pathway added on TRAFFIC PLAN to reflect existing condition.





8. Keynote S97: ADA curb ramps must be updated to current standards and have truncated domes installed.

RESPONSE: Response: Most of the existing ramps have tactile grooves, not truncated domes. Those are to remain. New ramps and existing ramps, without tactile grooves, will include installation of new City standard truncated domes as shown on the attached, detail B4, sheet TCL1 drawing.



Please provide details for all the interior ADA ramps.
 Response: Interior ADA ramps details have been added in sheet TCL2.




- 10. Show all drive aisle widths and radii. Some dimensions are not shown. Response: Dimensions have been added on revised TRAFFIC PLAN, TCL1.
- 11. The pavement marking "MC" should be shown in the opposite direction for Motorcycles entering the parking space. RESPONSE: "MC" to be painted on asphalt paving.



12. Per DPM, a 6 ft. wide ADA accessible pedestrian pathway is required from the ADA parking stall access aisles to the building entrances. Please clearly show this pathway and provide details.

RESPONSE: Hatched pathway has been added on TRAFFIC PLAN. Also illustrated below.



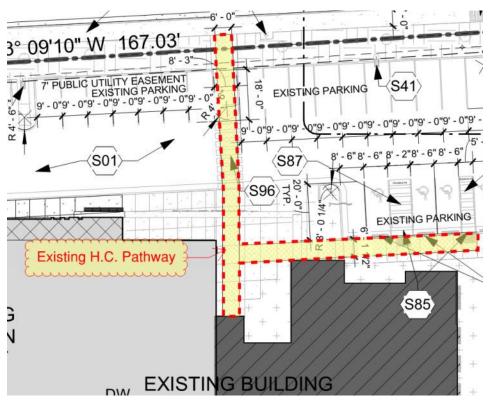

13. ADA accessible pedestrian pathway should not be placed behind parking space or adjacent to a vehicular way. Vehicle and pedestrian/wheelchair conflicts should be avoided as much as possible.

RESPONSE: See response to item 12, above.

14. Provide a copy of Fire Marshal and Solid Waste approval.

RESPONSE: A copy of the Fire Marshall's approved plan review is attached. Solid Waste approval shown in snip below:



15. Please provide a sight distance exhibit.

RESPONSE: The sight distance has been adjusted and corrected, see revised TCL plan.

16. Show the clear sight triangle and add the following note to the plan: "Landscaping and signage will not interfere with clear sight requirements. Therefore, signs, walls, trees, and shrubbery between 3 and 8 feet tall (as measured from the gutter pan) will not be acceptable in the clear sight triangle.

RESPONSE: This note is in the CLEAR SIGHT TRIANGLE notes. The current design complies with the requirements.

17. Please specify the City Standard Drawing Number when applicable.

RESPONSE: TCL has been revised to add the reference.

18. Add a note stating "All broken or cracked sidewalk must be replaced with sidewalk and curb & gutter." A build note must be provided referring to the appropriate City Standard drawing.

RESPONSE: Added note to GENERAL NOTES "D" in the revised TCL, attached.

19. Traffic Studies: See the Traffic Impact Study (TIS) thresholds. In general, a minimum combination of 100 Vehicles entering and exiting in the peak hour warrants a Traffic Impact Study. Visit with Traffic Engineer for determination and fill



out a TIS Form that states whether one is warranted. In some cases, a trip generation may be requested for determination (Contact Matt Grush: mgrush@cabq.gov).

RESPONSE: See attached Scoping Form, noting no TIS is required.

20. Please provide a letter of response for all comments given. RESPONSE: Noted.

If you have any questions regarding any of the above, please do not hesitate to contact me.

Sincerely,

Fanning Bard Tatum Architects AIA Ltd. by,

mett UE

Ted Grumblatt, Principal

enc: Updated drawings of TCL1 and TCL2(2-24x36 drawing) Approved FIRE 1 drawing (24x36 drawing) (1-24x36 drawing) Copy of approved TIS Scoping Form (3 pages, 8 ½ x 11) Letter approving Grading and Drainage Plan (1-8 1/2x11) Copy of approved Grading and Drainage Plan (Sheet C-101), 24x36 drawing

CITY OF ALBUQUERQUE

Planning Department Alan Varela, Director



Mayor Timothy M. Keller

November 7, 2022

Mike Walla, P.E. Walla Engineering 6501 Americas Pwky NE, Suite 301 Albuquerque, NM 87110

RE: GAAR Office Building - Renovations 1635 University Blvd. NE Grading & Drainage Plan Engineer's Stamp Date: 10/18/22 Hydrology File: H15D008

Dear Mr. Walla:

Based upon the information provided in your submittal received 10/18/2022, the Grading & Drainage Plan is approved for Building Permit. Please attach a copy of this approved plan in the construction sets for Building Permit processing along with a copy of this letter.

PO Box 1293 PRIOR TO CERTIFICATE OF OCCUPANCY:

- Albuquerque 1. Engineer's Certification, per the DPM Part 6-14 (F): *Engineer's Certification Checklist For Non-Subdivision* is required.
 - 2. Please provide the Drainage Covenant with Exhibit A for the stormwater quality ponds per Article 6-15(C) of the DPM prior to Permanent Release of Occupancy. Please submit the original copies along with the \$25.00 recording fee check made payable to Bernalillo County to Carrie Compton (cacompton@cabq.gov) on the 4th floor of Plaza de Sol.
- www.cabq.gov As a reminder, if the project total area of disturbance (including the staging area and any work within the adjacent Right-of-Way) is 1 acre or more, then an Erosion and Sediment Control (ESC) Plan and Owner's certified Notice of Intent (NOI) is required to be submitted to the Stormwater Quality Engineer (Doug Hughes, PE, jhughes@cabq.gov, 924-3420) 14 days prior to any earth disturbance.

If you have any questions, please contact me at 924-3995 or <u>rbrissette@cabq.gov</u>.

Sincerely,

NM 87103

Renée C. Brissette

Renée C. Brissette, P.E. CFM Senior Engineer, Hydrology Planning Department



City of Albuquerque

Planning Department Development Review Services Division

Traffic Scoping Form (REV 12/2020)

Project Title: GAAR 1635 University Blvd Renov. Building Permit #: BP-2022-23390	Hydrology File #: <u>H15D008</u>
Zone Atlas Page: <u>H15Z</u> DRB#: <u>07DRB-00040</u> EPC#: <u>1005330</u>	Work Order#:
Zone Atlas Page: H15Z DRB#: 07DRB-00040 EPC#: 1005330 Lot 1-A-1, Lands of the Albuquergue Board of Realtors, Bernalillo County, New Mexico Legal Description: 1-A Replat of Lots 1&2 Lands of the Albuquergue Board of Realtors Containing Approx	o x. 2.8992 Acres
City Address: 1635 University Blvd. NE, Albuquerque, NM 87102	
Applicant: Greater Albuquerque Association of Realtors (GAAR)	Contact: Nathan Brooks
Address: 1635 University Blvd. NE, Albuquerque, NM 87102	
Phone#: (505)724-3476 Fax#:	E-mail: <u>nbrooks@gaar.com</u>
Development Information	
Build out/Implementation Year: 2022 Current/Proposed Zo	oning: IDO NR-C
Project Type: New: () Change of Use: () Same Use/Unchanged: (X) Same	
Proposed Use (mark all that apply): Residential: () Office: (X) Retail: () Mix	ed-Use: ()
Describe development and Uses: The development is the renovation and reconstruction of the existing office/training center for (GAAR. It includes an expansion of
2,500 s.f. The building primary use is office as well as training classrooms for visiting guests.	
Days and Hours of Operation (if known): The primary use for operations is 8:00 AM to 5:0	00 PM, Monday thru, Friday,
Facility	
Building Size (sq. ft.): 18,430 square feet	
Number of Residential Units:0	
Number of Commercial Units:	
Traffic Considerations	
Expected Number of Daily Visitors/Patrons (if known):*50-60 Visitors	ITE Land Use #715 Single Tenet Office
	Building 20.9 K SQ FT
Expected Number of Employees (if known):* 17 Employees	AM peak 32 trips PM peak 44 trips
Expected Number of Delivery Trucks/Buses per Day (if known):* 2/week or .4 /day	
Trip Generations during PM/AM Peak Hour (if known):* Not known.	
Driveway(s) Located on: <u>Street Name</u> University Blvd.	
Adjacent Roadway(s) Posted Speed: Street Name Indian School	Posted Speed 35 MPH

Street Name 1-40 Frontage Road

Posted Speed 40 MPH

* If these values are not known, assumptions will be made by City staff. Depending on the assumptions, a full TIS may be required

Roadway Information (adjacent to site)

Comprehensive Plan Corridor Designation/Functional Classification: Minor Arterial
(arterial, collecdtor, local, main street)
Comprehensive Plan Center Designation: Other City Limits
(urban center, employment center, activity center)
Jurisdiction of roadway (NMDOT, City, County): City
Adjacent Roadway(s) Traffic Volume: 16,100 Avg. Annual Weekday Volume-to-Capacity Ratio:
Adjacent Transit Service(s): Indian School Rd. Nearest Transit Stop(s): .28 miles on Indian School Rd.
Is site within 660 feet of Premium Transit?: <u>No</u>
Current/Proposed Bicycle Infrastructure: Current bike path is located on Indian School Rd./Proposed bike lane on University Blvd.
(bike lanes, trails)
Current/Proposed Sidewalk Infrastructure: Current on University Blvd.

Relevant Web-sites for Filling out Roadway Information:

City GIS Information: <u>http://www.cabq.gov/gis/advanced-map-viewer</u>

Comprehensive Plan Corridor/Designation: <u>https://abc-zone.com/document/abc-comp-plan-chapter-5-land-use</u> (map after Page 5-5)

Road Corridor Classification: <u>https://www.mrcog-nm.gov/DocumentCenter/View/1920/Long-Range-Roadway-System-LRRS-PDF?bidId</u>=

Traffic Volume and V/C Ratio: https://www.mrcog-nm.gov/285/Traffic-Counts and https://public.mrcog-nm.gov/taqa/

Bikeways: <u>http://documents.cabq.gov/planning/adopted-longrange-plans/BTFP/Final/BTFP%20FINAL_Jun25.pdf</u> (Map Pages 75 to 81)

TIS Determination

Note: Changes made to development proposals / assumptions, from the information provided above, will result in a new TIS determination.

Traffic Impact Study (TIS) Required: Yes [] No 😽 Borderline []

Thresholds Met? Yes [] No

Mitigating Reasons for Not Requiring TIS:

.....

Previously Studied: []

.....

Notes:

MPM-P.E.

11/16/2022

TRAFFIC ENGINEER

DATE

<u>Submittal</u>


The Scoping Form must be submitted as part of any building permit application, DRB application, or EPC application. See the Development Process Manual Chapter 7.4 for additional information.

Submit by email to the City Traffic Engineer mgrush@cabq.gov. Call 924-3362 for information.

Site Plan/Traffic Scoping Checklist

Site plan, building size in sq. ft. (show new, existing, remodel), to include the following items as applicable:

- 1. Access -- location and width of driveways
- 2. Sidewalks (Check DPM and IDO for sidewalk requirements. Also, Centers have wider sidewalk requirements.)
- 3. Bike Lanes (check for designated bike routes, long range bikeway system) <u>(check MRCOG Bikeways and Trails in the</u> 2040 MTP map)
- 4. Location of nearby multi-use trails, if applicable (check MRCOG Bikeways and Trails in the 2040 MTP map)
- 5. Location of nearby transit stops, transit stop amenities (eg. bench, shelter). Note if site is within 660 feet of premium transit.
- 6. Adjacent roadway(s) configuration (number of lanes, lane widths, turn bays, medians, etc.)
- 7. Distance from access point(s) to nearest adjacent driveways/intersections.
- 8. Note if site is within a Center and more specifically if it is within an Urban Center.
- 9. Note if site is adjacent to a Main Street.
- 10. Identify traffic volumes on adjacent roadway per MRCOG information. If site generates more than 100 vehicles per hour, identify v/c ratio on this form.

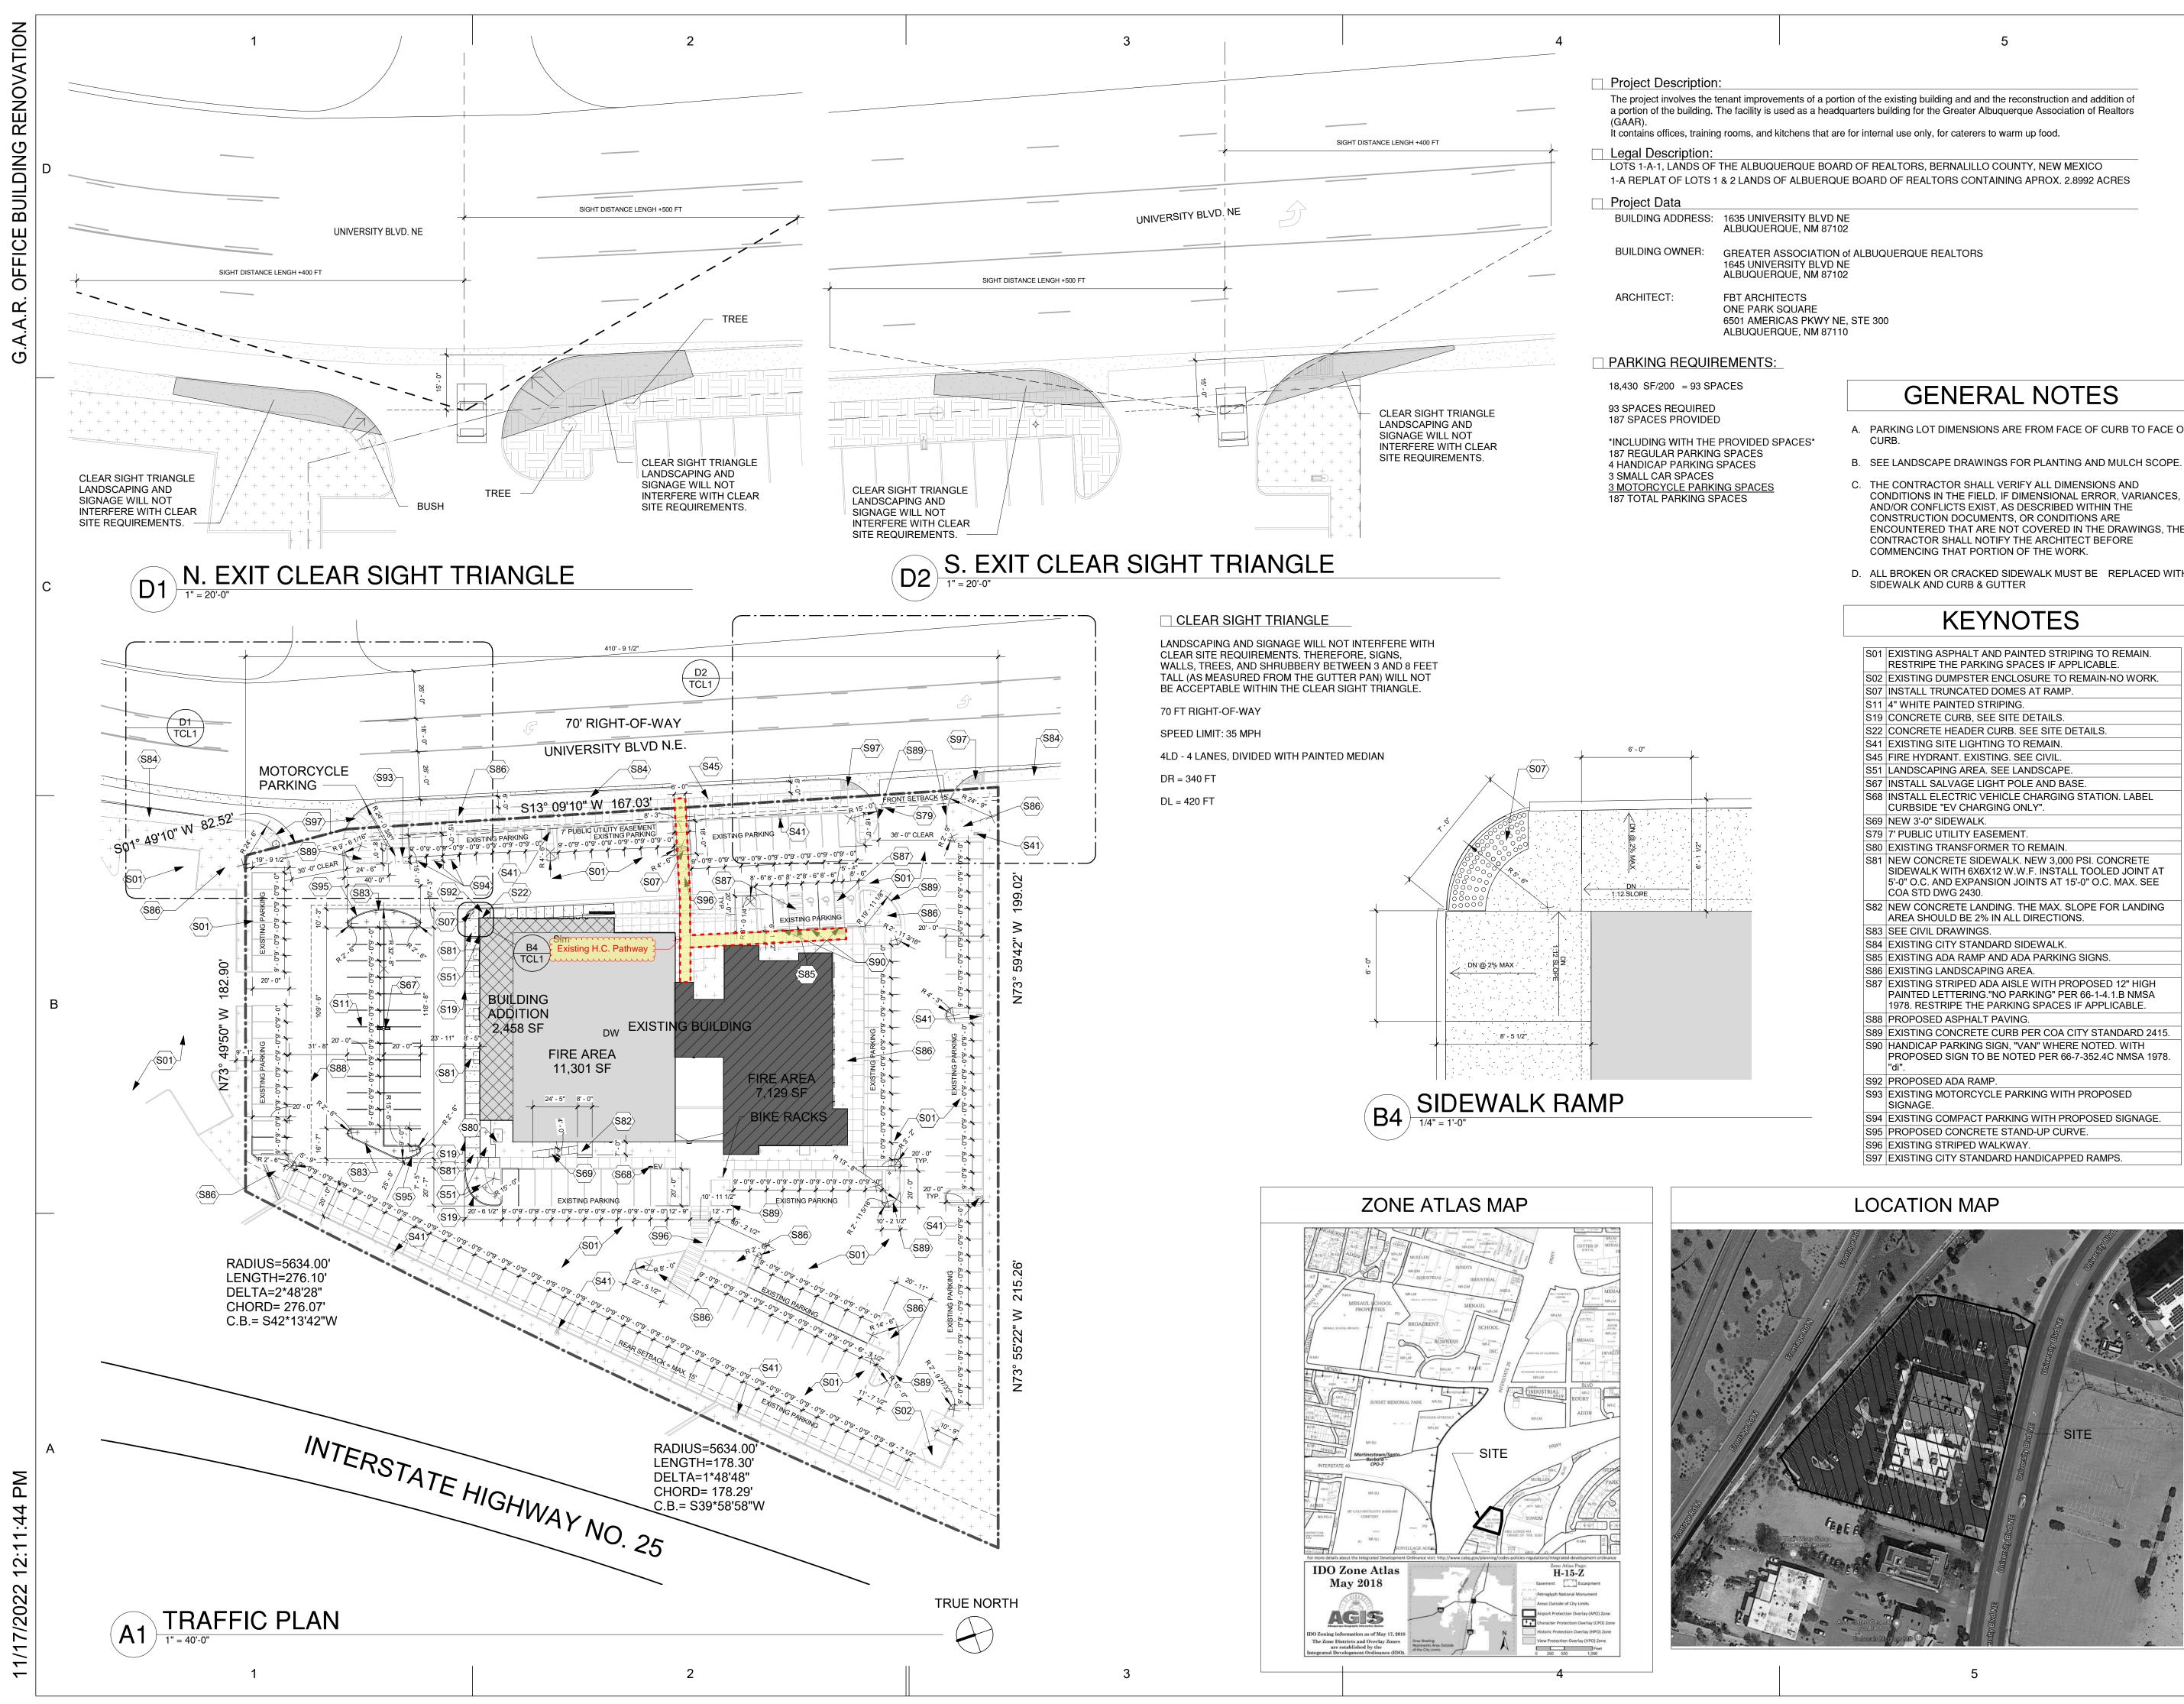

- A. PARKING LOT DIMENSIONS ARE FROM FACE OF CURB TO FACE OF
 - - ENCOUNTERED THAT ARE NOT COVERED IN THE DRAWINGS, THE
 - D. ALL BROKEN OR CRACKED SIDEWALK MUST BE REPLACED WITH

fbt architects

PHO: 505.883.5200

FAX: 505.884.5390

WEB: www.fbtarch.com

MAIL: 6501 Americas Pkwy NE., Ste. 300 Albuquerque, NM 87110

CONSULTANT

<u>OWNER</u> GAAR

1635 UNIVERSITY BLVD NE ALBUQUERQUE, NM 87102 505-724-3476 NATHAN BROOKS NBROOKS@GAAR.COM

ARCHITECT

FBT ARCHITECTS LTD. ONE PARK SQUARE 6501 AMERICAS PKWY NE, STE 300 ALBUQUERQUE, NM 87110 P 505.883.5200 CONTACT: TED GRUMBLAT LEED AP PRINCIPAL TCG@FBTARCH.COM

LANDSCAPE ARCHITECT:

GROUNDWORK STUDIO ONE PARK SQUARE 6501 AMERICAS PKWY NE, STE 300 ALBUQUERQUE, NM 87110 505.212.9126 CONTACT: WILL MOSES WILL@GROUNDWORKSTUDIONM.COM

STRUCTURAL ENGINEER

WALLA ENGINEERING ONE PARK SQUARE 6501 AMERICAS PKWY NE, STE 301 ALBUQUERQUE, NM 87110 505881.3008 CONTACT: MIKE WALLA PE MIKEW@WALLAENGINEERING.COM

MECHANICAL/ PLUMBING

ARSED ENGINEERING 4700 LINCOLN RD, NE ALBUQUERQUE, NM 87109 CONTACT: PAT SEDILLO PSEDILL@ARSEDENGR.COM

ELECTRICAL ENGINEER:

AC ENGINEERING ENTERPRISES, LLC 120 ALISO DRIVE, SE ALBUQUERQUE, NM 87109 P: 505.842.5787 CONTACT: BUD TELC, PE BUD@ACENM.COM



G.A.A.R. OFFICE **BUILDING RENOVATION**

CONSTRUCTION DOCUMENTS

1635 UNIVERSITY BLVD. NE ALBUQUERQUE, NM 87102

09.08.22

MARK DATE


DESCRIPTION


ISSUE: DATE: PROJECT NO: CAD DWG FILE: DRAWN BY: CHECKED BY: SHEET TITLE

Author Checker

TRAFFIC CIRCULATION LAYOUT PLAN

TCL1

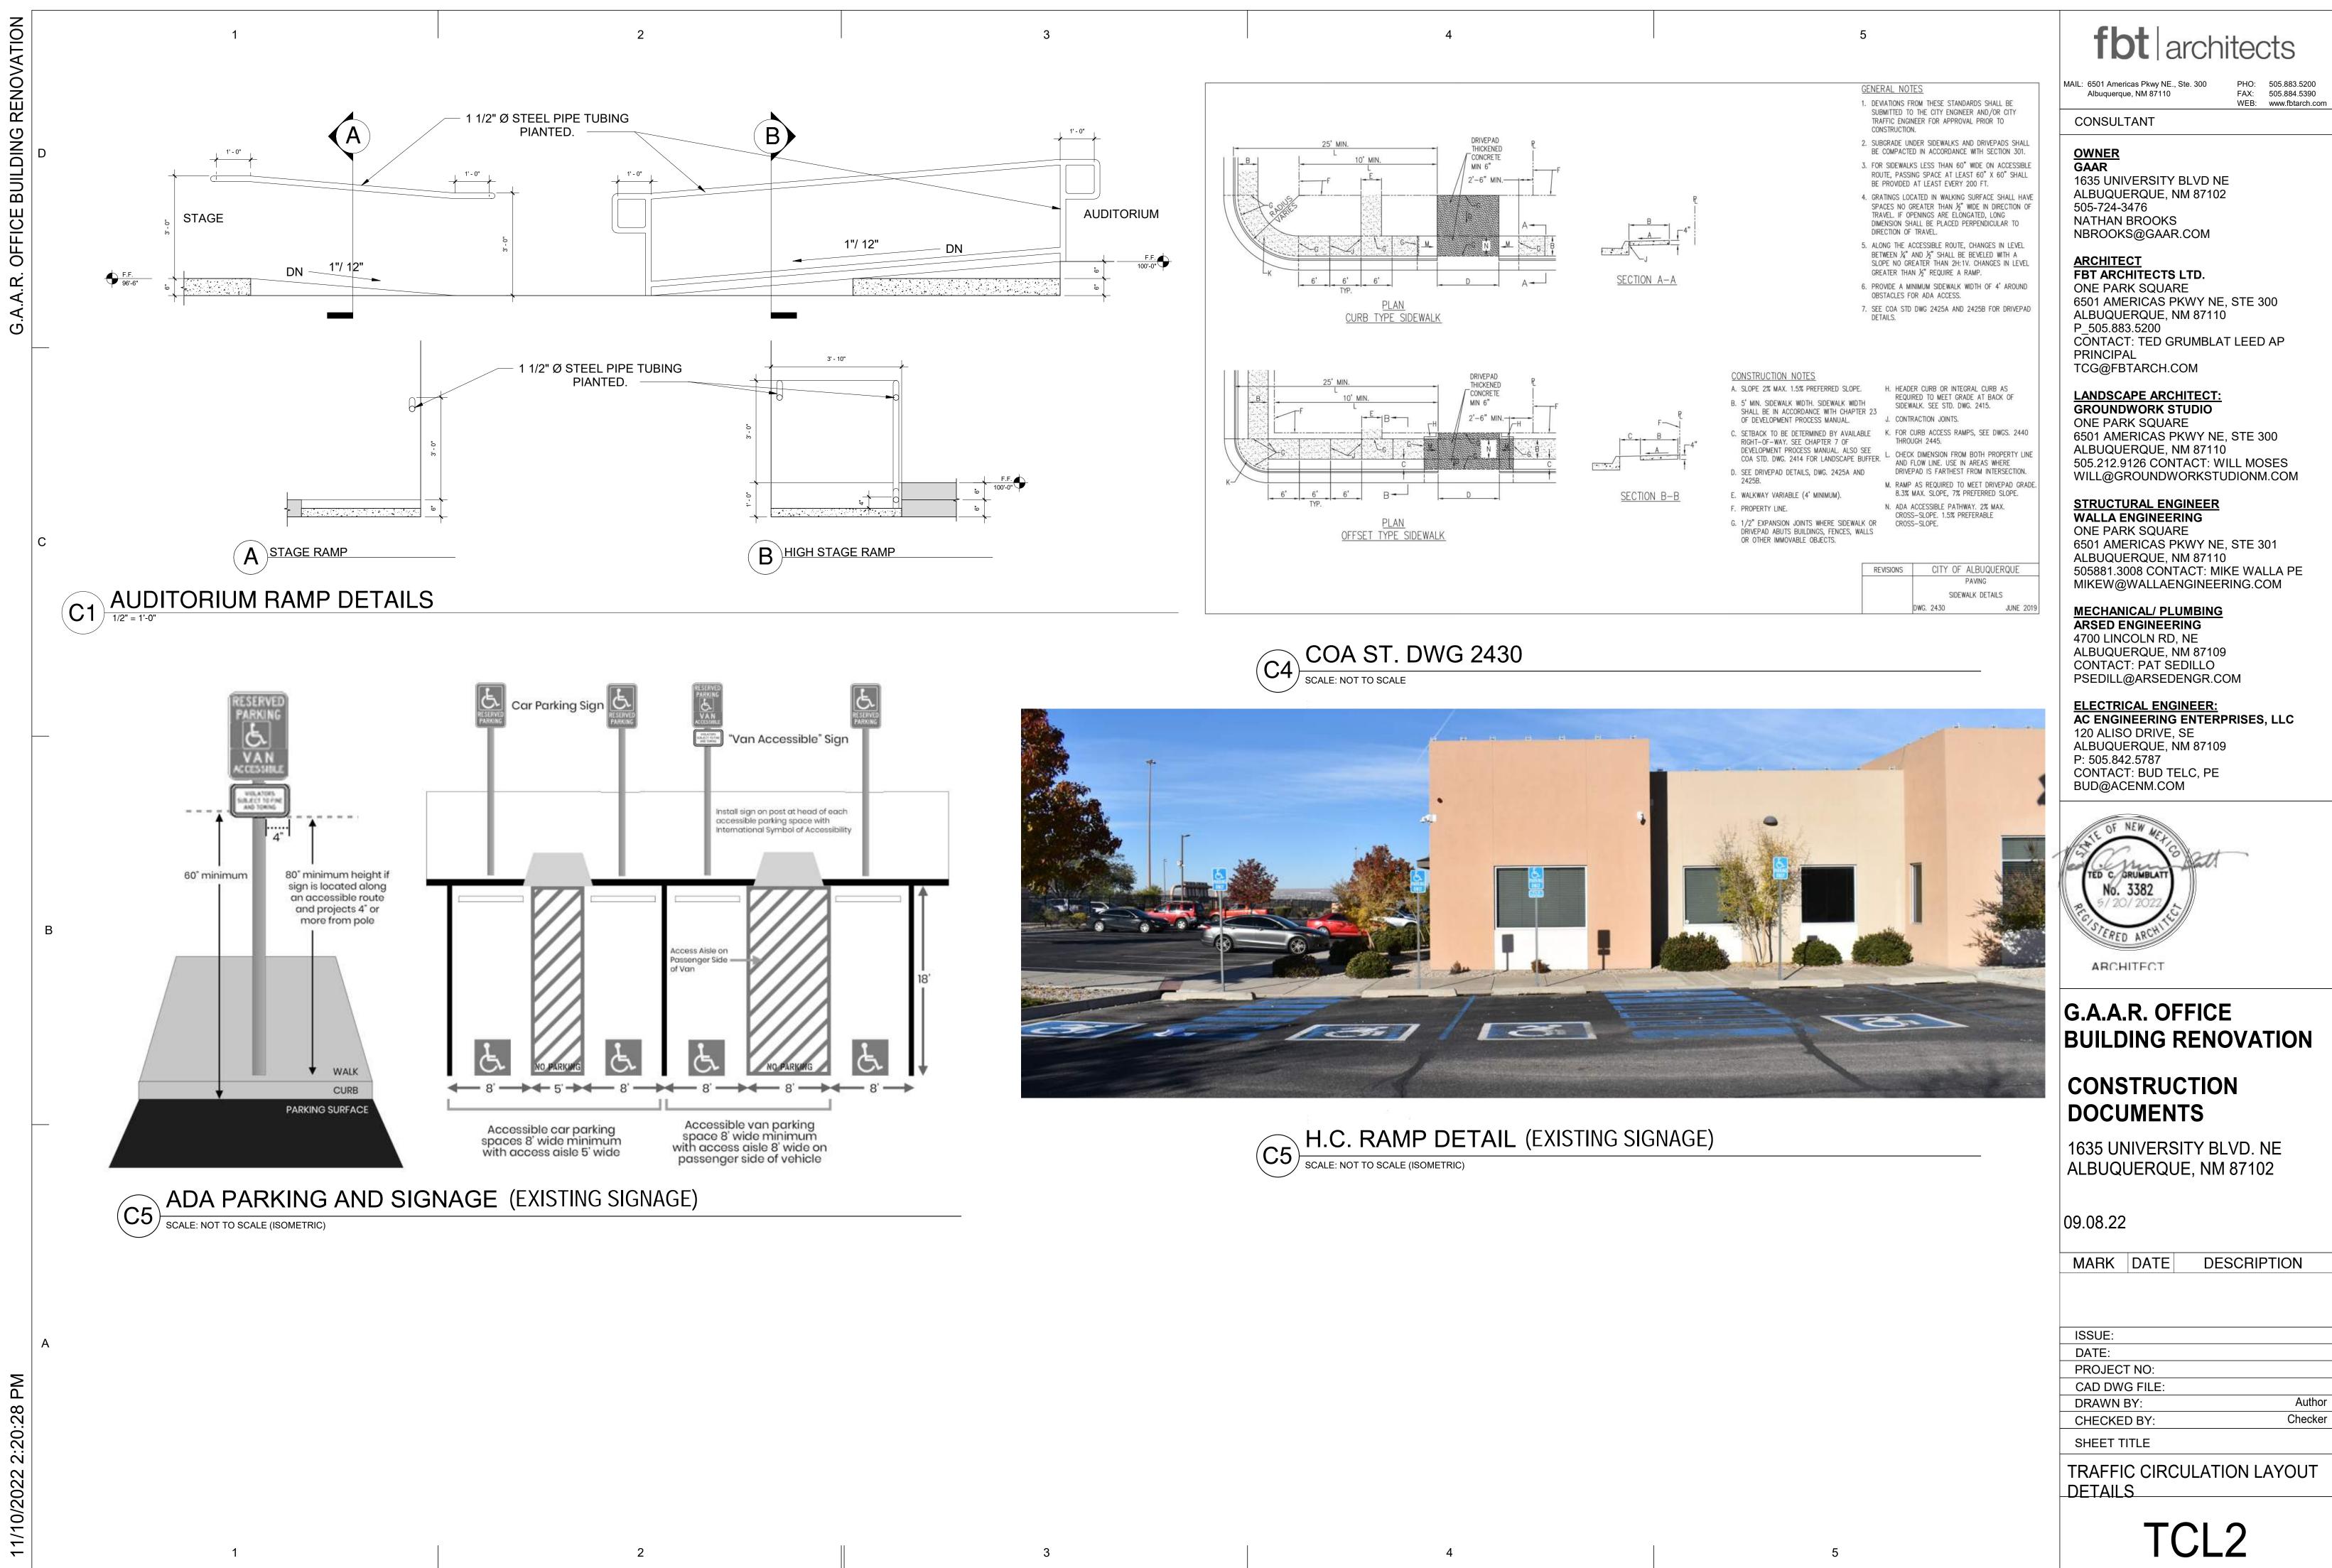

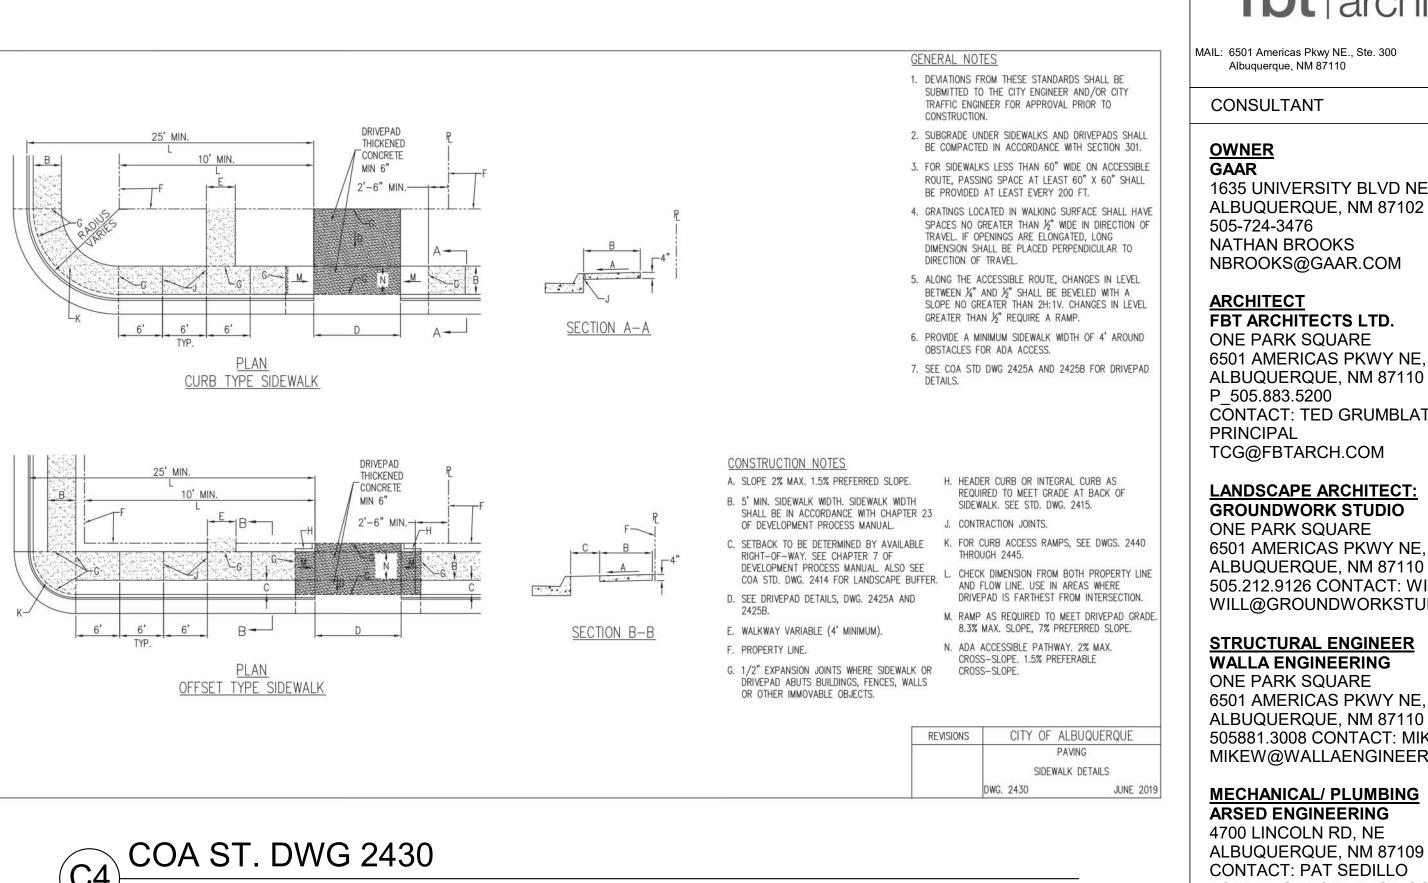



fbt architects

6501 AMERICAS PKWY NE, STE 300 CONTACT: TED GRUMBLAT LEED AP

6501 AMERICAS PKWY NE, STE 300 505.212.9126 CONTACT: WILL MOSES WILL@GROUNDWORKSTUDIONM.COM

6501 AMERICAS PKWY NE, STE 301 505881.3008 CONTACT: MIKE WALLA PE MIKEW@WALLAENGINEERING.COM

AC ENGINEERING ENTERPRISES, LLC


BUILDING RENOVATION

1635 UNIVERSITY BLVD. NE ALBUQUERQUE, NM 87102

DESCRIPTION

Author Checker


TRAFFIC CIRCULATION LAYOUT

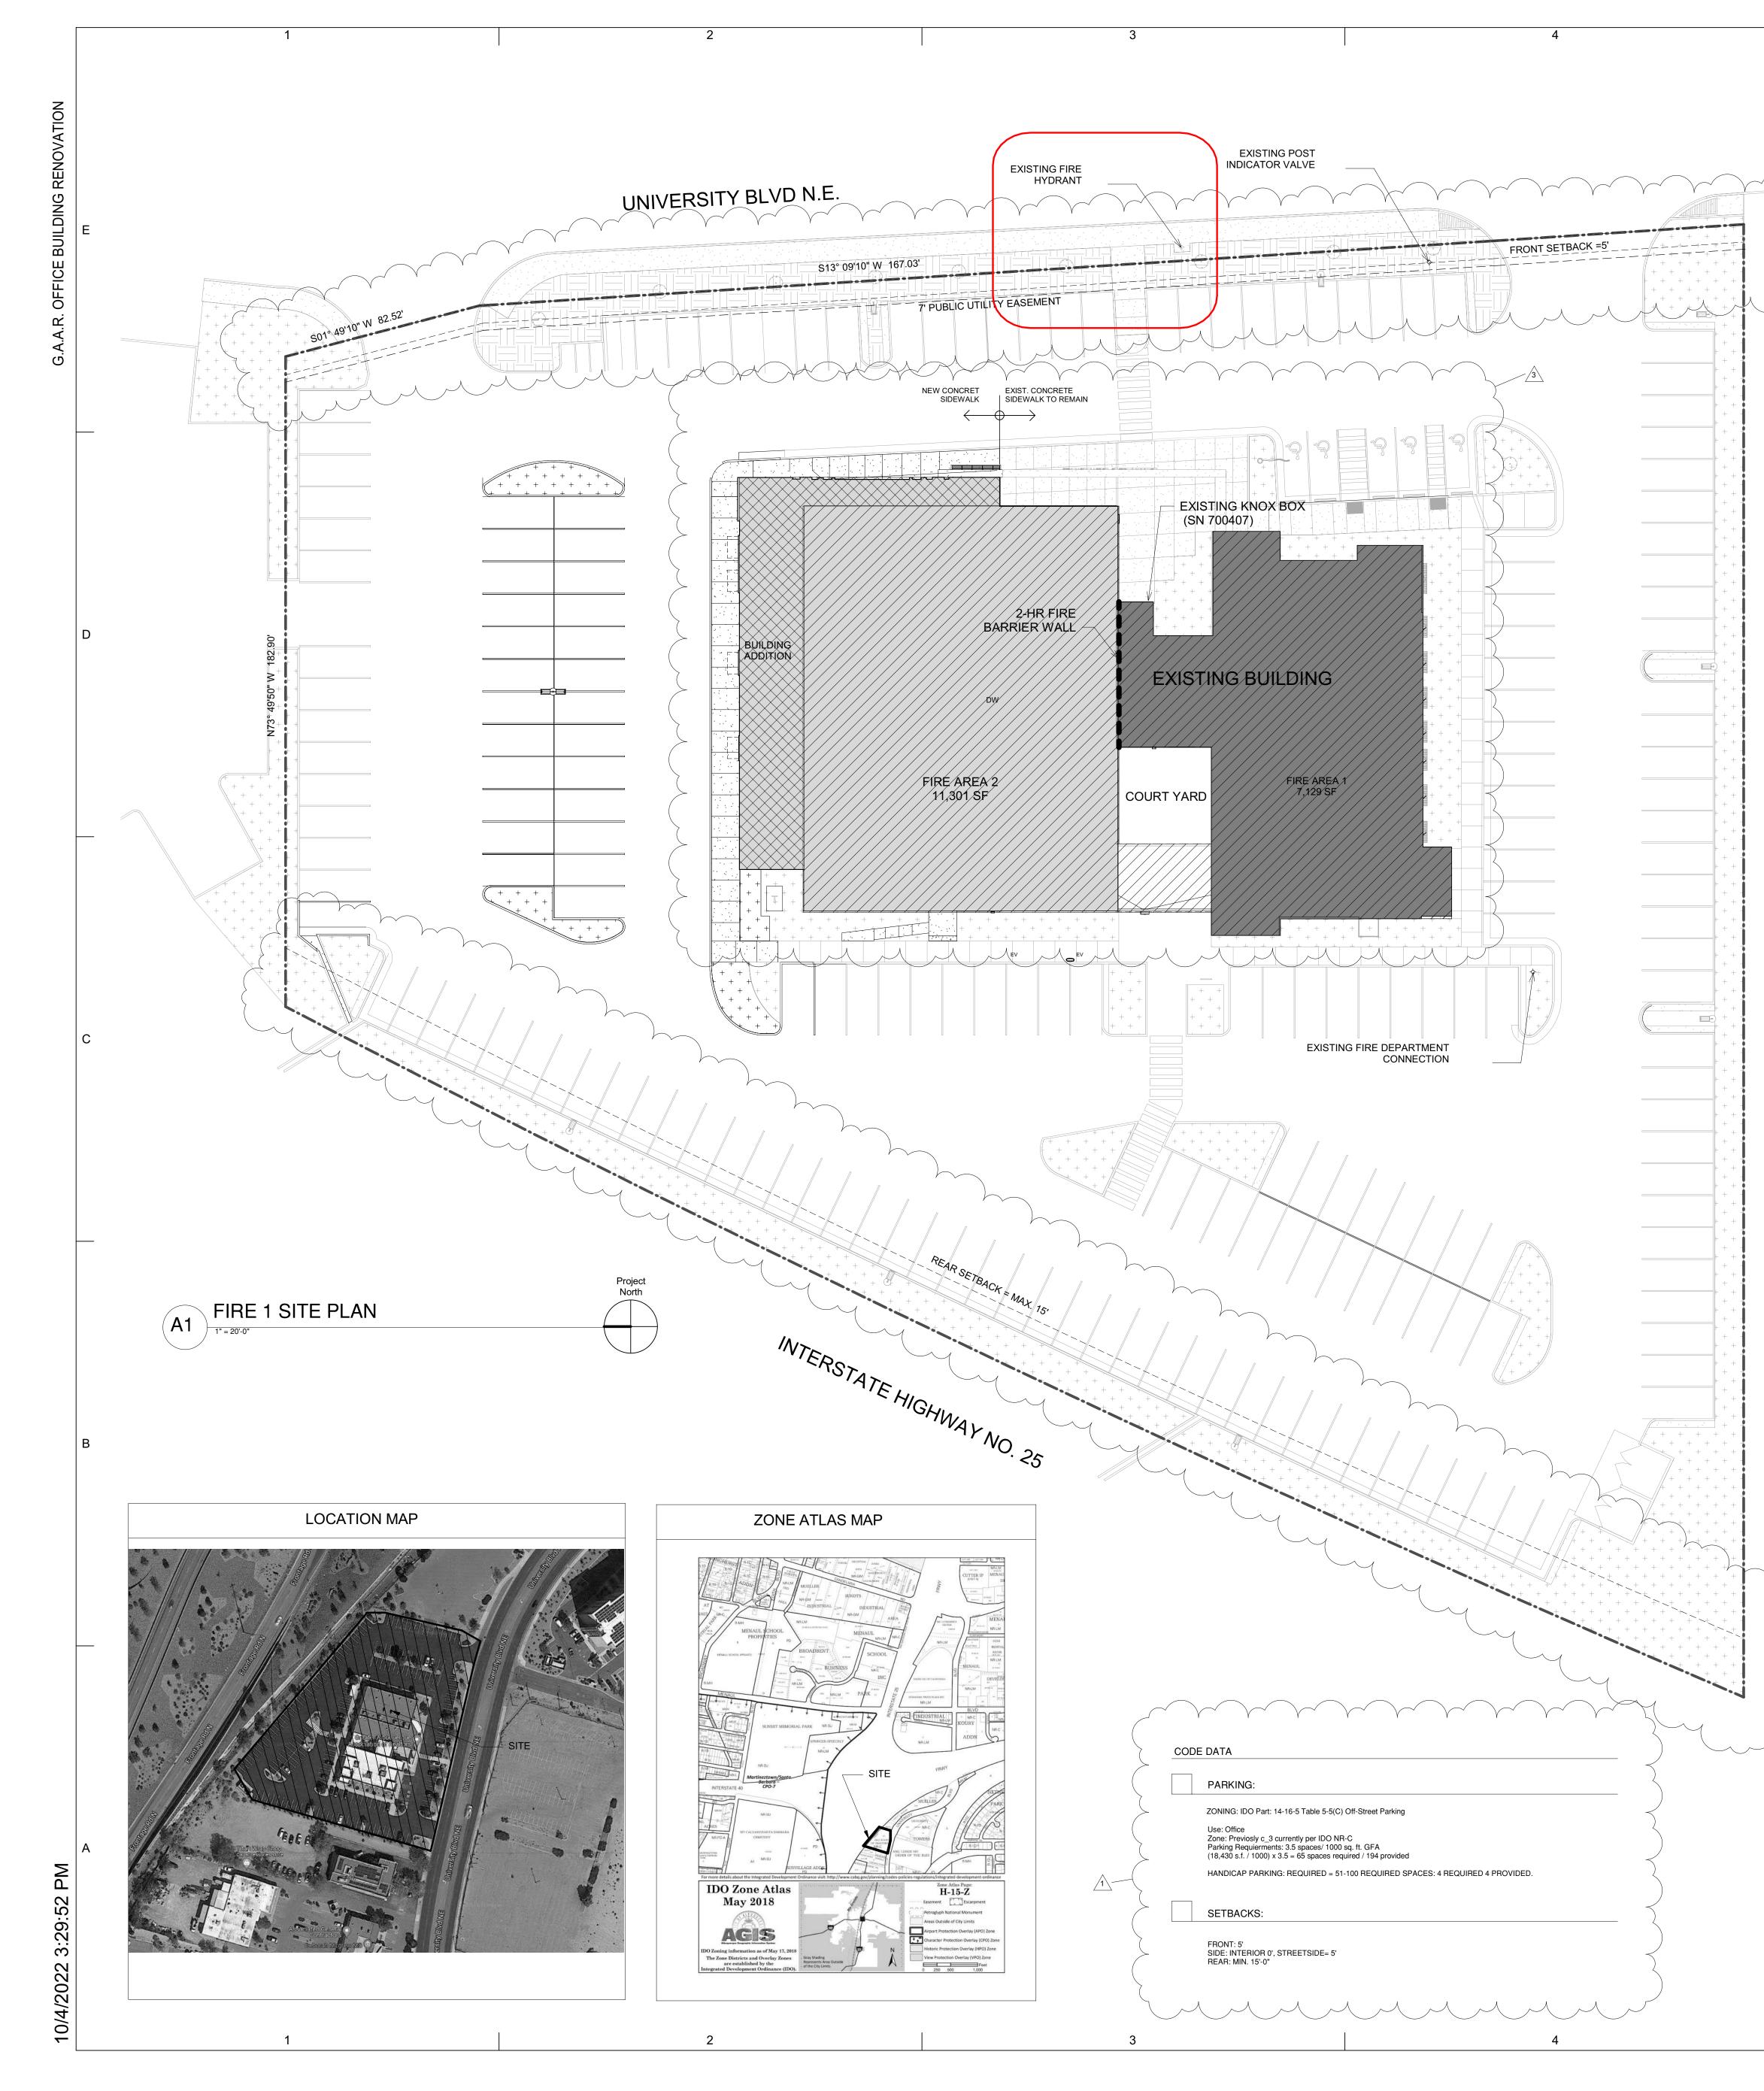

	PERMIT NUMBER: FP-22-0/1590
Project Description:	APPROVED DATE: 10/06/22 APPROVED DATE: 10/06/22 APPROVED MAIL: 6501 Americas Pkwy NE., Ste. 300 Albuquerque, NM 87110 PHO: 505.82 WEB: www.f
The project involves the tenant improvements of a portion of the existing bridding conservation of a portion of the building. The facility is used as a headquarters building for the building.	
It contains offices, training rooms, and kitchens that are for internal use only for category to wait the second s	INATIONAL FIRE CODE, AND NFPA STANDARDS. THIS ISO DAYS. FINAL INSPECTION IS REQUIRED. D GPM 1 Fire Hydrant CONSULTANT
Legal Description: LOTS 1-A-1, LANDS OF THE ALBUQUERQUE BOARD OF REALTORS, BERNALILLO COUNTY, NEW MEXICO	<u>OWNER</u>
1-A REPLAT OF LOTS 1 & 2 LANDS OF ALBUERQUE BOARD OF REALTORS CONTAINING APROX. 2.8992 ACI Project Data	1635 UNIVERSITY BLVD NE
BUILDING ADDRESS: 1635 UNIVERSITY BLVD NE	ALBUQUERQUE, NM 87102 505-724-3476 NATHAN BROOKS
ALBUQUERQUE, NM 87102 BUILDING OWNER:	NBROOKS@GAAR.COM
GREATER ASSOCIATION of ALBUQUERQUE REALTO 1645 UNIVERSITY BLVD NE ALBUQUERQUE, NM 87102	ARCHITECT FBT ARCHITECTS LTD.
ARCHITECT: FBT ARCHITECTS ONE PARK SQUARE	ONE PARK SQUARE 6501 AMERICAS PKWY NE, STE 300
6501 AMERICAS PKWY NE, STE 300 ALBUQUERQUE, NM 87110	ALBUQUERQUE, NM 87110 P_505.883.5200
REFERENCES:	CONTACT: TED GRUMBLAT LEED AP PRINCIPAL TCG@FBTARCH.COM
2015 INTERNATIONAL BUILDING CODE 2015 UNIFORM F 2015 INTERNATIONAL EXISTING BUILDING CODE 2000 NFPA 101 LI	
2015 NEW MEXICO BUILDING CODE ATBCB, JANUAR' 2003 ANSI A117.1 NEPA 90C	
	6501 AMERICAS PKWY NE, STE 300 ALBUQUERQUE, NM 87110
OCCUPANCY CLASSIFICATION: (CHAPTER 3)	505.212.9126 CONTACT: WILL MOSES WILL@GROUNDWORKSTUDIONM.CO
B (SECTION 304) CONSTRUCTION TYPE (TABLE 601):	STRUCTURAL ENGINEER
TYPE VB - SPRINKLERED (NO FIRE RATING REQUIREMENTS)	WALLA ENGINEERING ONE PARK SQUARE 6501 AMERICAS PKWY NE, STE 301
	ALBUQUERQUE, NM 87110 505881.3008 CONTACT: MIKE WALLA I
	MIKEW@WALLAENGINEERING.COM
Total Building Occupant Load: 597 OCCUPANTS	MECHANICAL/ PLUMBING ARSED ENGINEERING
EXIT WIDTHS	4700 LINCOLN RD, NE ALBUQUERQUE, NM 87109
2 REQUIRED / 8 PROVIDED AS PART OF RENOVATION SCOPE REQUIRED: 185 OCC. x .15= 27.75" 185 OCC. x .2 = 37"	CONTACT: PAT SEDILLO PSEDILL@ARSEDENGR.COM
185 OCC. x .2 = 37" PROVIDED: 3 x 36" = 108"	ELECTRICAL ENGINEER:
LEVEL OF ALTERATION (IEBC CHAPTER 3)	AC ENGINEERING ENTERPRISES, LLO 120 ALISO DRIVE, SE
LEVEL 3 ALTERATION - LEVEL OF ALTERATIONS APPLY TO MORE	ALBUQUERQUE, NM 87109 P: 505.842.5787 CONTACT: BUD TELC, PE
THAN 50% OF THE BUILDING	BUD@ACENM.COM
FIRE BARRIER WALLS	
2-HR WALL - SEE PLAN FOR LOCATION	
ALLOWABLE AREA : (TABLE 504 AND SECTION 506)	TE OF NEW MEY
	- Same
BASE ALLOWABLE AREA (TABLE 506.2): 36,000 SF (S1- SPRINKLERE FIRE AREA 1 SF = 7,129 SF	D) TED C. GRUMBLATT No. 3382
FIRE AREA 2 SF = 11,301 SF	175 5/20/2022 S
TOTAL BUILDING SF = 18,430 SF	FRED ARCH
ALLOWABLE TRAVEL DISTANCES (IBC TABLE 1017.2)	ABCHITECT
THE MAXIMUM LENGTH OF EXIT ACCESS TRAVEL: OCCUPANCIES B = 300 FEET. (SPRINKLERED)	
MAXIMUM LENGTH OF EXIT ACCESS TRAVEL PROVIDED: 133 FEET	
	\leq
DEAD END CORRIDOR (IBC TABLE 1020.1 AND 1020.4):	G.A.A.R. OFFICE
50 FT. MAXIMUM (SPRINKLERED)	
PLUMBING FIXTURE CALCULATIONS:	
THE FOLLOWING CALCULATIONS BASED ON TOTAL OCCUPANT LOAD OF 597. 299 MALES & 299 FEMALES	
	CONSTRUCTION
1/25 FOR FIRST 50 & 1/50 FOR THE REMAINDER = 7 MALE & 7 FEMALE WATER CLOSETS: REQUIRED PROVIDED	DOCUMENTS
7 MALE & 7 FEMALE	7 MALE & 8 FEMALE
LAVATORIES REQUIRED: 1/40 FOR FIRST 80 & 1/80 FOR THE REMAINDER = 5 MALE & 5 FEMALE	
LAVATORIES: REQUIRED PROVIDED	1635 UNIVERSITY BLVD NE ALBUQUERQUE, NM 87102
5 MALE & 5 FEMALE	5 MALE & 5 FEMALE
//100= 2 = 1 ACCESSIBLE AND 1 NON-ACCESSIBLE (STANDING PERSONS)	09.08.22
DRINKING FOUNTAINS: 2015 IBC TABLE 2902.1 REQUIRED PROVIDED	MARK DATE DESCRIPTIO
TOTAL OCCUPANT LOAD: 597/100=6 (1 PER 100) 6 6	2 ACCESSIBLE (HI/LOW) 2 9/2/22 CABQ Plan review changes 2 MCCESSIBLE (HI/LOW) 2 9/18/22 FIRE 1 REVIEW
JANITOR'S CLOSET: REQUIRED PROVIDED	2 9/10/22 THE THEVIEW 3 9/27/22 ADDENDUM 2
PARKING REQUIREMENTS: LANDSCAPE REQUIREMENTS: 10 400 SE/000 - 00 SEACES 126 324 SE GEOSS LAND ABEA	
18,430 SF/200 = 93 SPACES 126,324 SF GROSS LAND AREA 93 SPACES REQUIRED - 18,430 SF BUILDING AREA 187 SPACES PROVIDED 107,894 NET LOT AREA	DATE:
 107,894 NET LOT AREA x 15% = *INCLUDING WITH THE PROVIDED SPACES* 16,184 SF LANDSCAPING REQUIRED 187 REGULAR PARKING SPACES 	PROJECT NO: CAD DWG FILE:
4 HANDICAP PARKING SPACES 3 SMALL CAR SPACES <u>3 MOTORCYCLE PARKING SPACES</u>	DRAWN BY:
	Street Parking
Use: Office Zone: Previously C-3 Currently per IDO MX-H Parking Requirements: 3.5 spaces / 1,000 sq. ft. GFA (18,430 s.f. / 1,000) x 3.5 = 65 spaces required / 194 provided	SHEET TITLE
2018 IECC (INTERNATIONAL ENERGY CONSERVATION CODE)) SITE PLAN
CHAPTER 3-C301-CLIMATE ZONE: 4B	
CHAPTER 4-Table C402.1.3: INSULATION ABOVE ROOF DECK R-30ci WALLS-METAL FRAME R-13+R-7.5ci HEATED SLAB R-10, 24" BELOW	
7	FIRE 1

N73° 59'42"

'22" W 215.26'

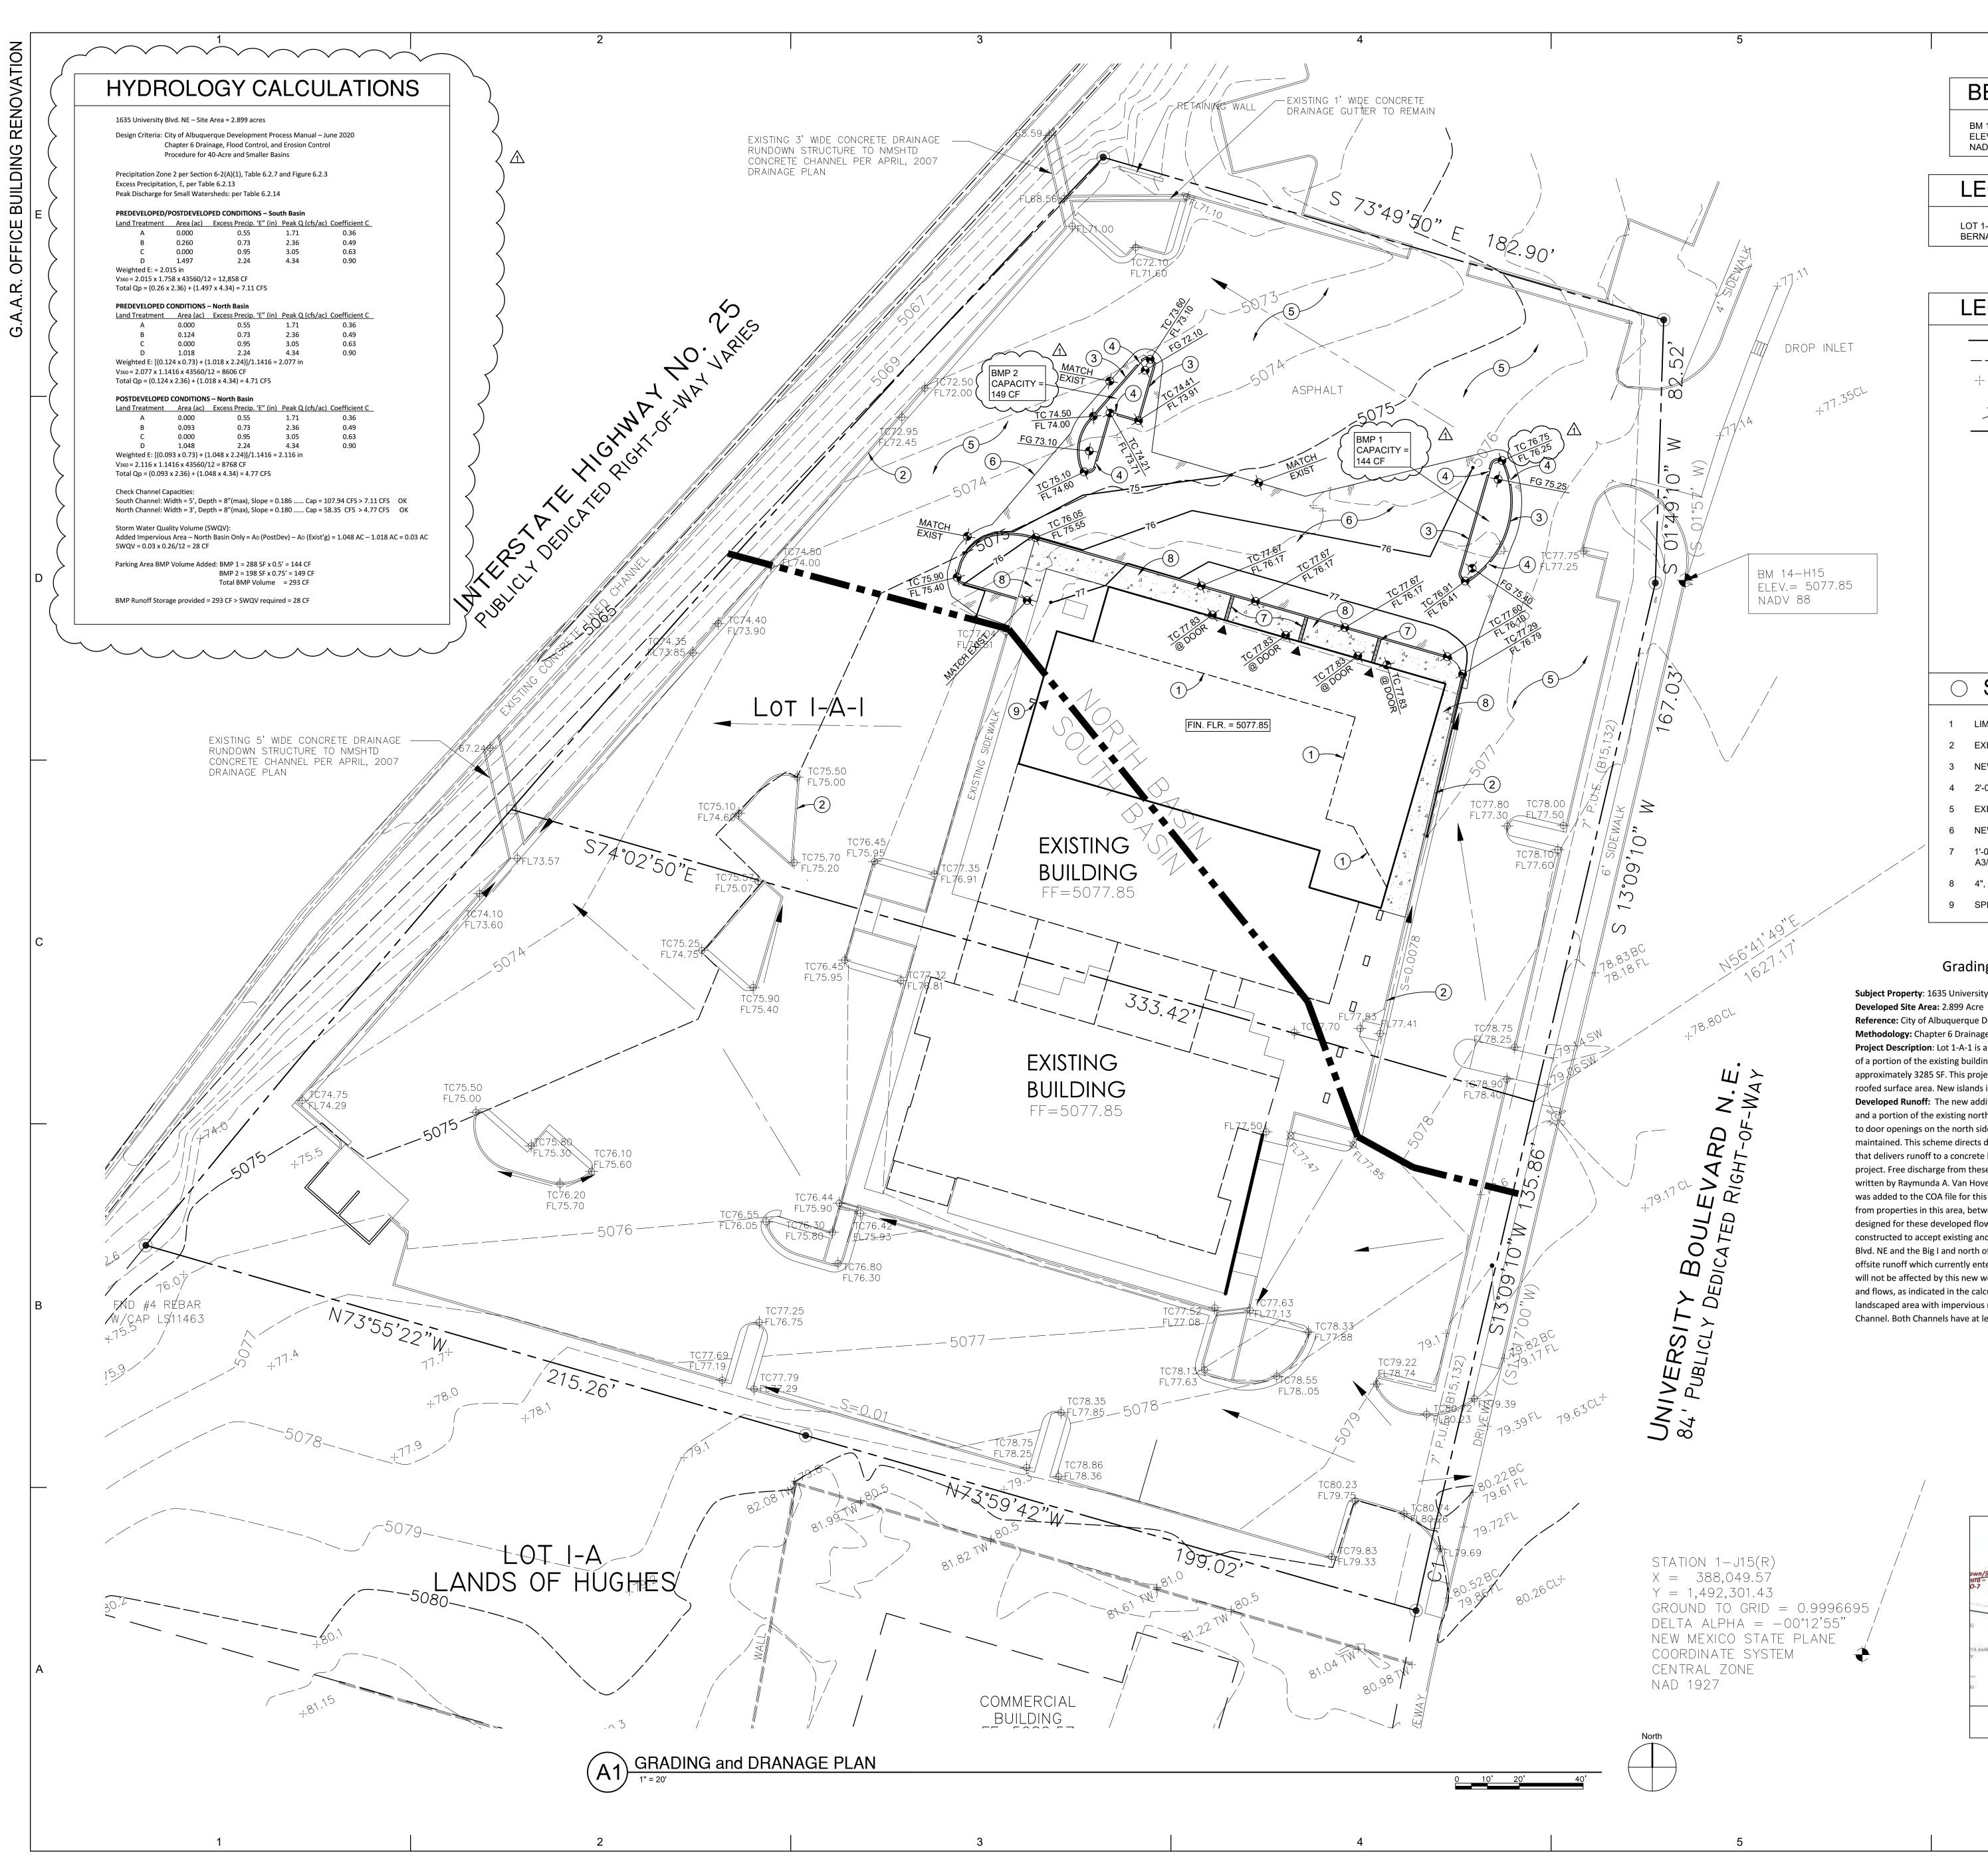

BENCHMARK

BM 14-H15 ELEVATION = 5077.85 NADV 88

LEGAL DESCRIPTION

LOT 1-A-1, ALBUQUERQUE BOARD OF REALTORS, ALBUQUERQUE, BERNALILLO COUNTY, NEW MEXICO

LEGEND

----- PROPERTY LINE — — 5073— — EXISTING CONTOUR NEW SPOT ELEVATION 74.00 ——74—— NEW CONTOUR TC TOP OF CONCRETE FG FINISHED GRADE FF FINISHED FLOOR ROOF DRAIN DRAINAGE SWALE BASIN BOUNDARY

NEW CONCRETE PAVING

NEW ASPHALT PAVING

SHEET KEYNOTES

- 1 LIMIT OF NORTH END OF EXISTING BUILDING
- 2 EXISTING CURB AND GUTTER TO REMAIN
- 3 NEW 6" CONCRETE CURB WALL PER A1/C-201
- 4 2'-0" WIDE CURB BREAK FOR DRAINAGE RUNOFF CONVEYANCE
- 5 EXISTING ASPHALT PAVING TO REMAIN
- 6 NEW ASPHALT PAVING PER DETAIL A2/C-201
- 1'-0" WIDE SIDEWALK CULVERT AT ROOF DRAIN PER DETAILS A3/C-201 AND A4/C-201
- 8 4", 4000 PSI, AIR-ENTRAINED CONCRETE SIDEWALK 9 SPLASH BLOCK AT ROOF DRAIN

Grading & Drainage Design Narrative

Subject Property: 1635 University Blvd NE, City of Albuquerque

Reference: City of Albuquerque Development Process Manual (DPM), June 2020


Methodology: Chapter 6 Drainage, Flood Control, And Erosion Control of the DPM Project Description: Lot 1-A-1 is a 2.8992 acre site that is fully developed. The project is the demolition

of a portion of the existing building and addition that will increase the size of the building by approximately 3285 SF. This project will eliminate a small portion of landscaped area and replace it with roofed surface area. New islands in the parking lot will be added as well.

Developed Runoff: The new addition will have the same finished floor elevation as the existing building and a portion of the existing north parking lot will be removed and regraded in order to provide access to door openings on the north side of the addition. Otherwise, the historic site drainage scheme will be maintained. This scheme directs developed runoff to two concrete rundowns at the west property edge that delivers runoff to a concrete lined drainage channel constructed as part of the Big I Interstate project. Free discharge from these sites west of University Blvd. was allowed by the NMSHTD in a letter written by Raymunda A. Van Hoven, Drainage Engineer, NMSHTD, dated August 14, 2002. This letter was added to the COA file for this site in a previous project. The letter allows for concrete rundowns

from properties in this area, between University Blvd and the Interstate, to a concrete channel has been designed for these developed flows. The letter states "The subject channel was designed and constructed to accept existing and future developed flows from properties located between University Blvd. NE and the Big I and north of Indian School Rd. NE and south of the Interstate." All negligible offsite runoff which currently enters the site and is conveyed through the site to the existing rundowns will not be affected by this new work. The new work will negligibly change the existing runoff volumes and flows, as indicated in the calculations on the plan. The addition will replace approximately 1350 of landscaped area with impervious roof and paved area. This will add 0.06 CFS runoff to the North Channel. Both Channels have at least 10 times the capacity needed to handle runoff from the site.

> Development Review Services HYDROLOGY SECTION **APPROVED** 11/07/22 DATE: Brissette BY: H15D008 HydroTrans #

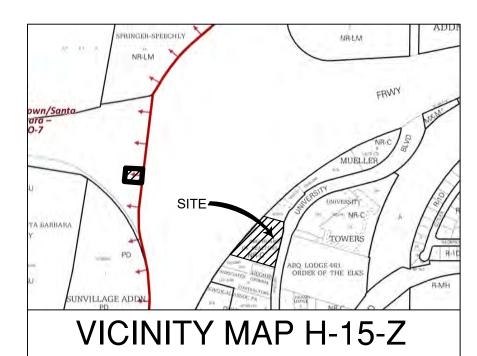



fbt architects

MAIL: 6501 Americas Pkwy NE., Ste. 300

Albuquerque, NM 87110

PHO: 505.883.5200

FAX: 505.884.5390

WEB: www.fbtarch.com