

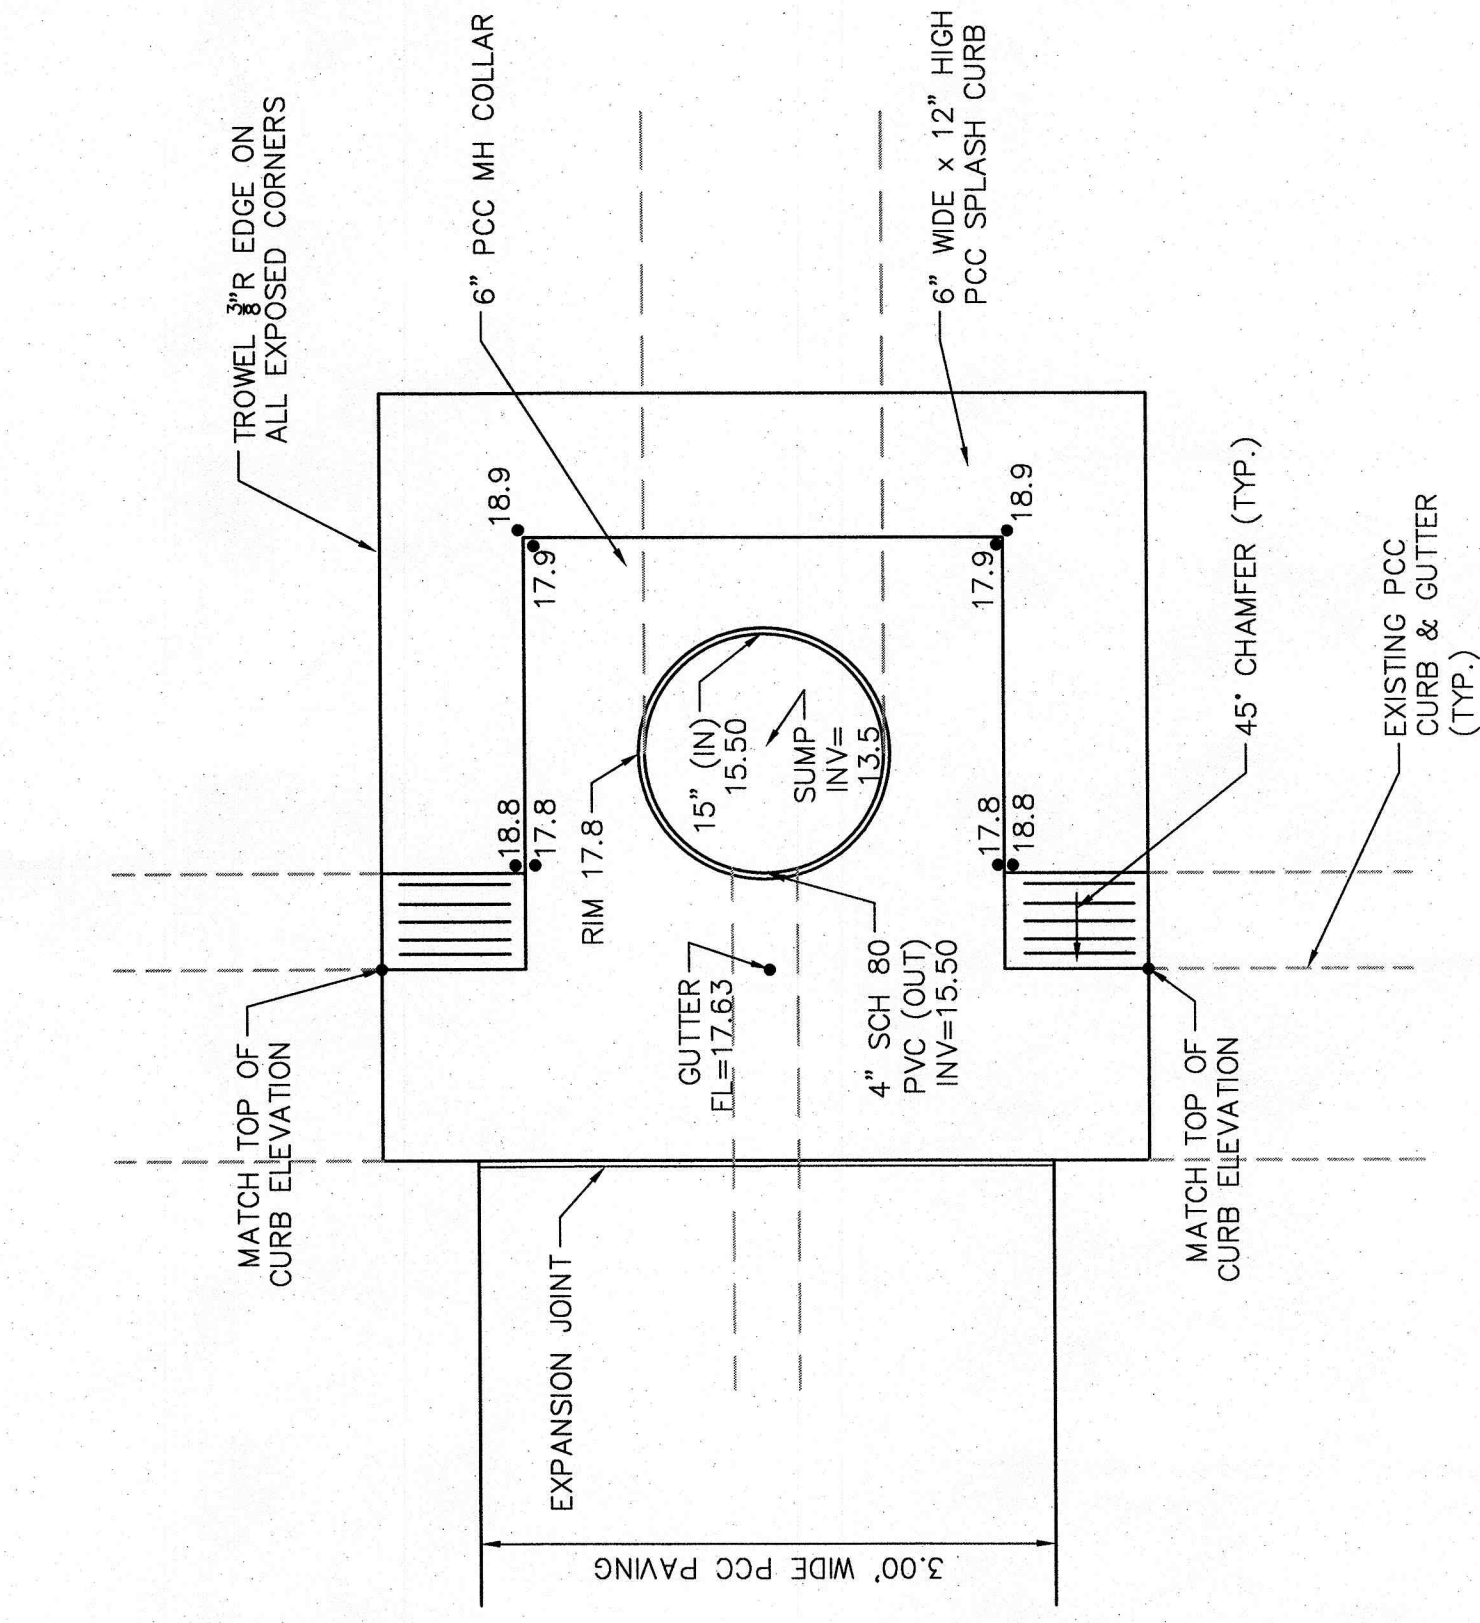
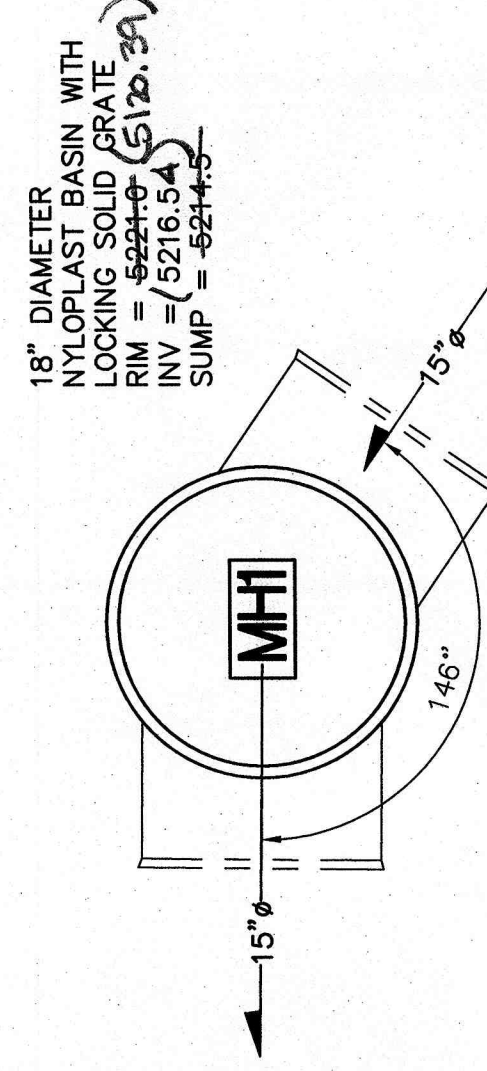


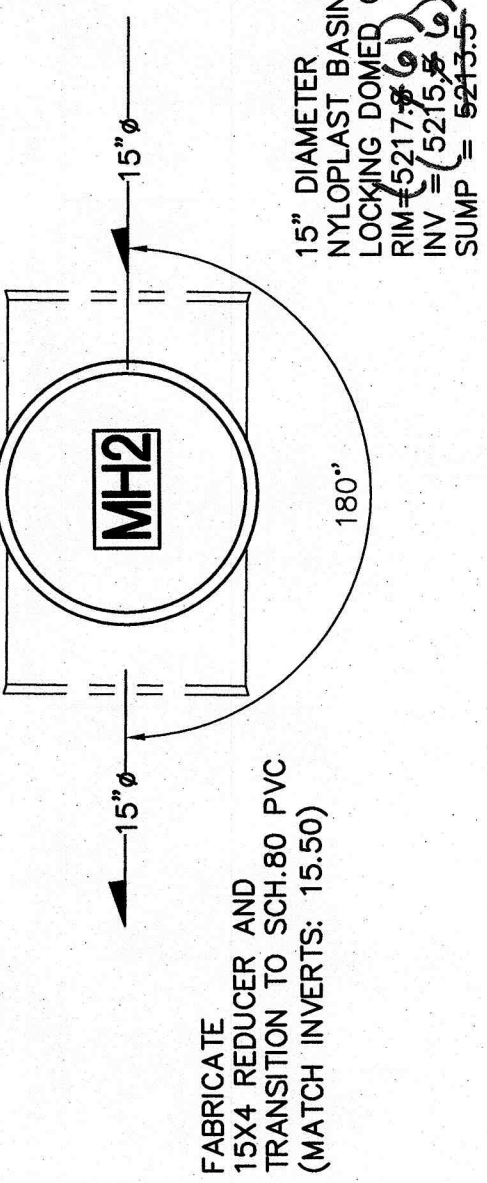


C5 BUBBLER CONTAINMENT CURB
1"=1'-0"

C5 ADS NYLOPLAST BASIN
DESIGN INFORMATION


NYLOPLAST BASIN - SEE PLAN LAYOUT DETAIL FOR DIAMETER, PIPE LAYOUT AND GRATE TYPE. SEE STORM DRAIN DESIGN THIS SHEET FOR RIM, INVERT AND SUMP ELEVATIONS.

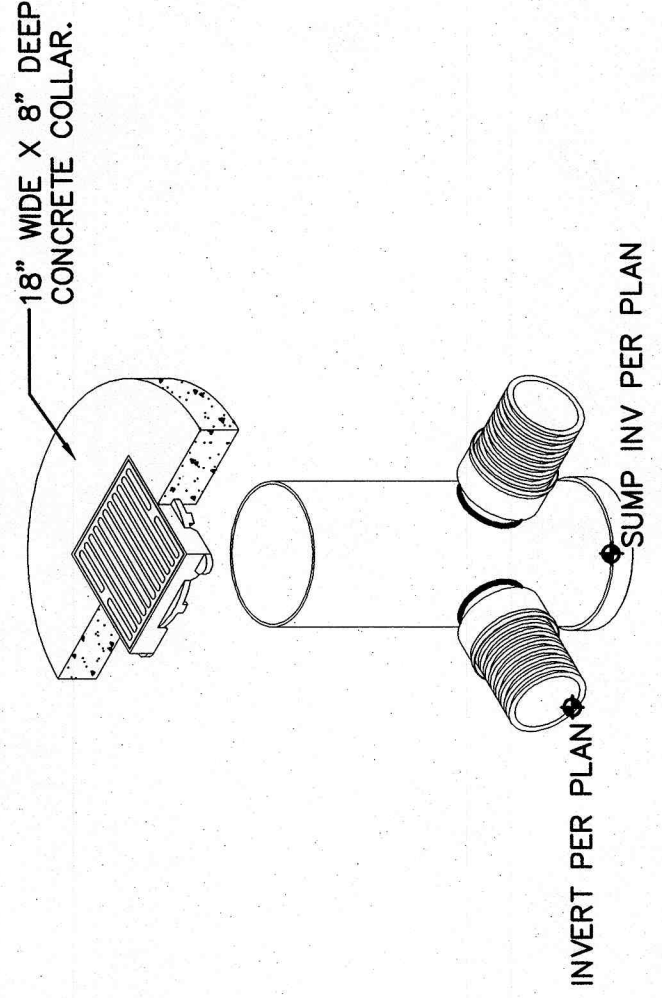

C4 ADS NYLOPLAST BASIN - PLAN LAYOUT
SCALE: N.T.S.

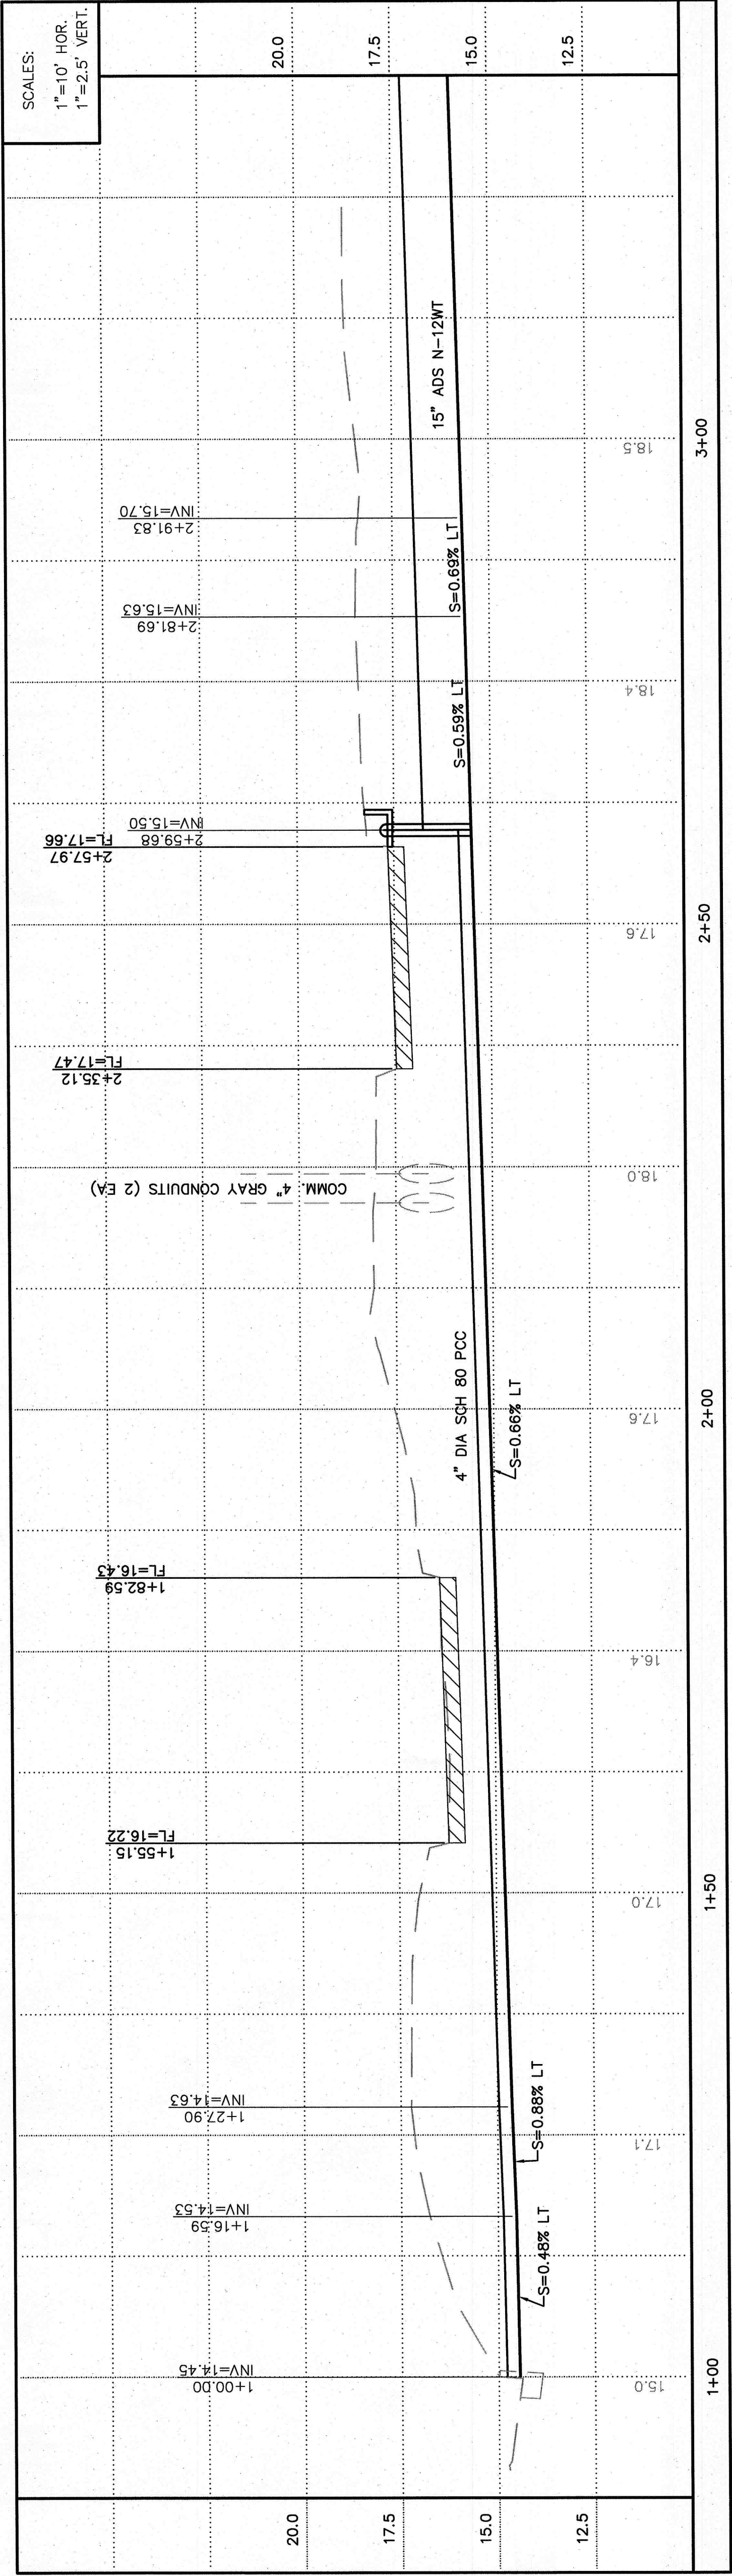

E1 STORM DRAIN PLAN - BASE BID

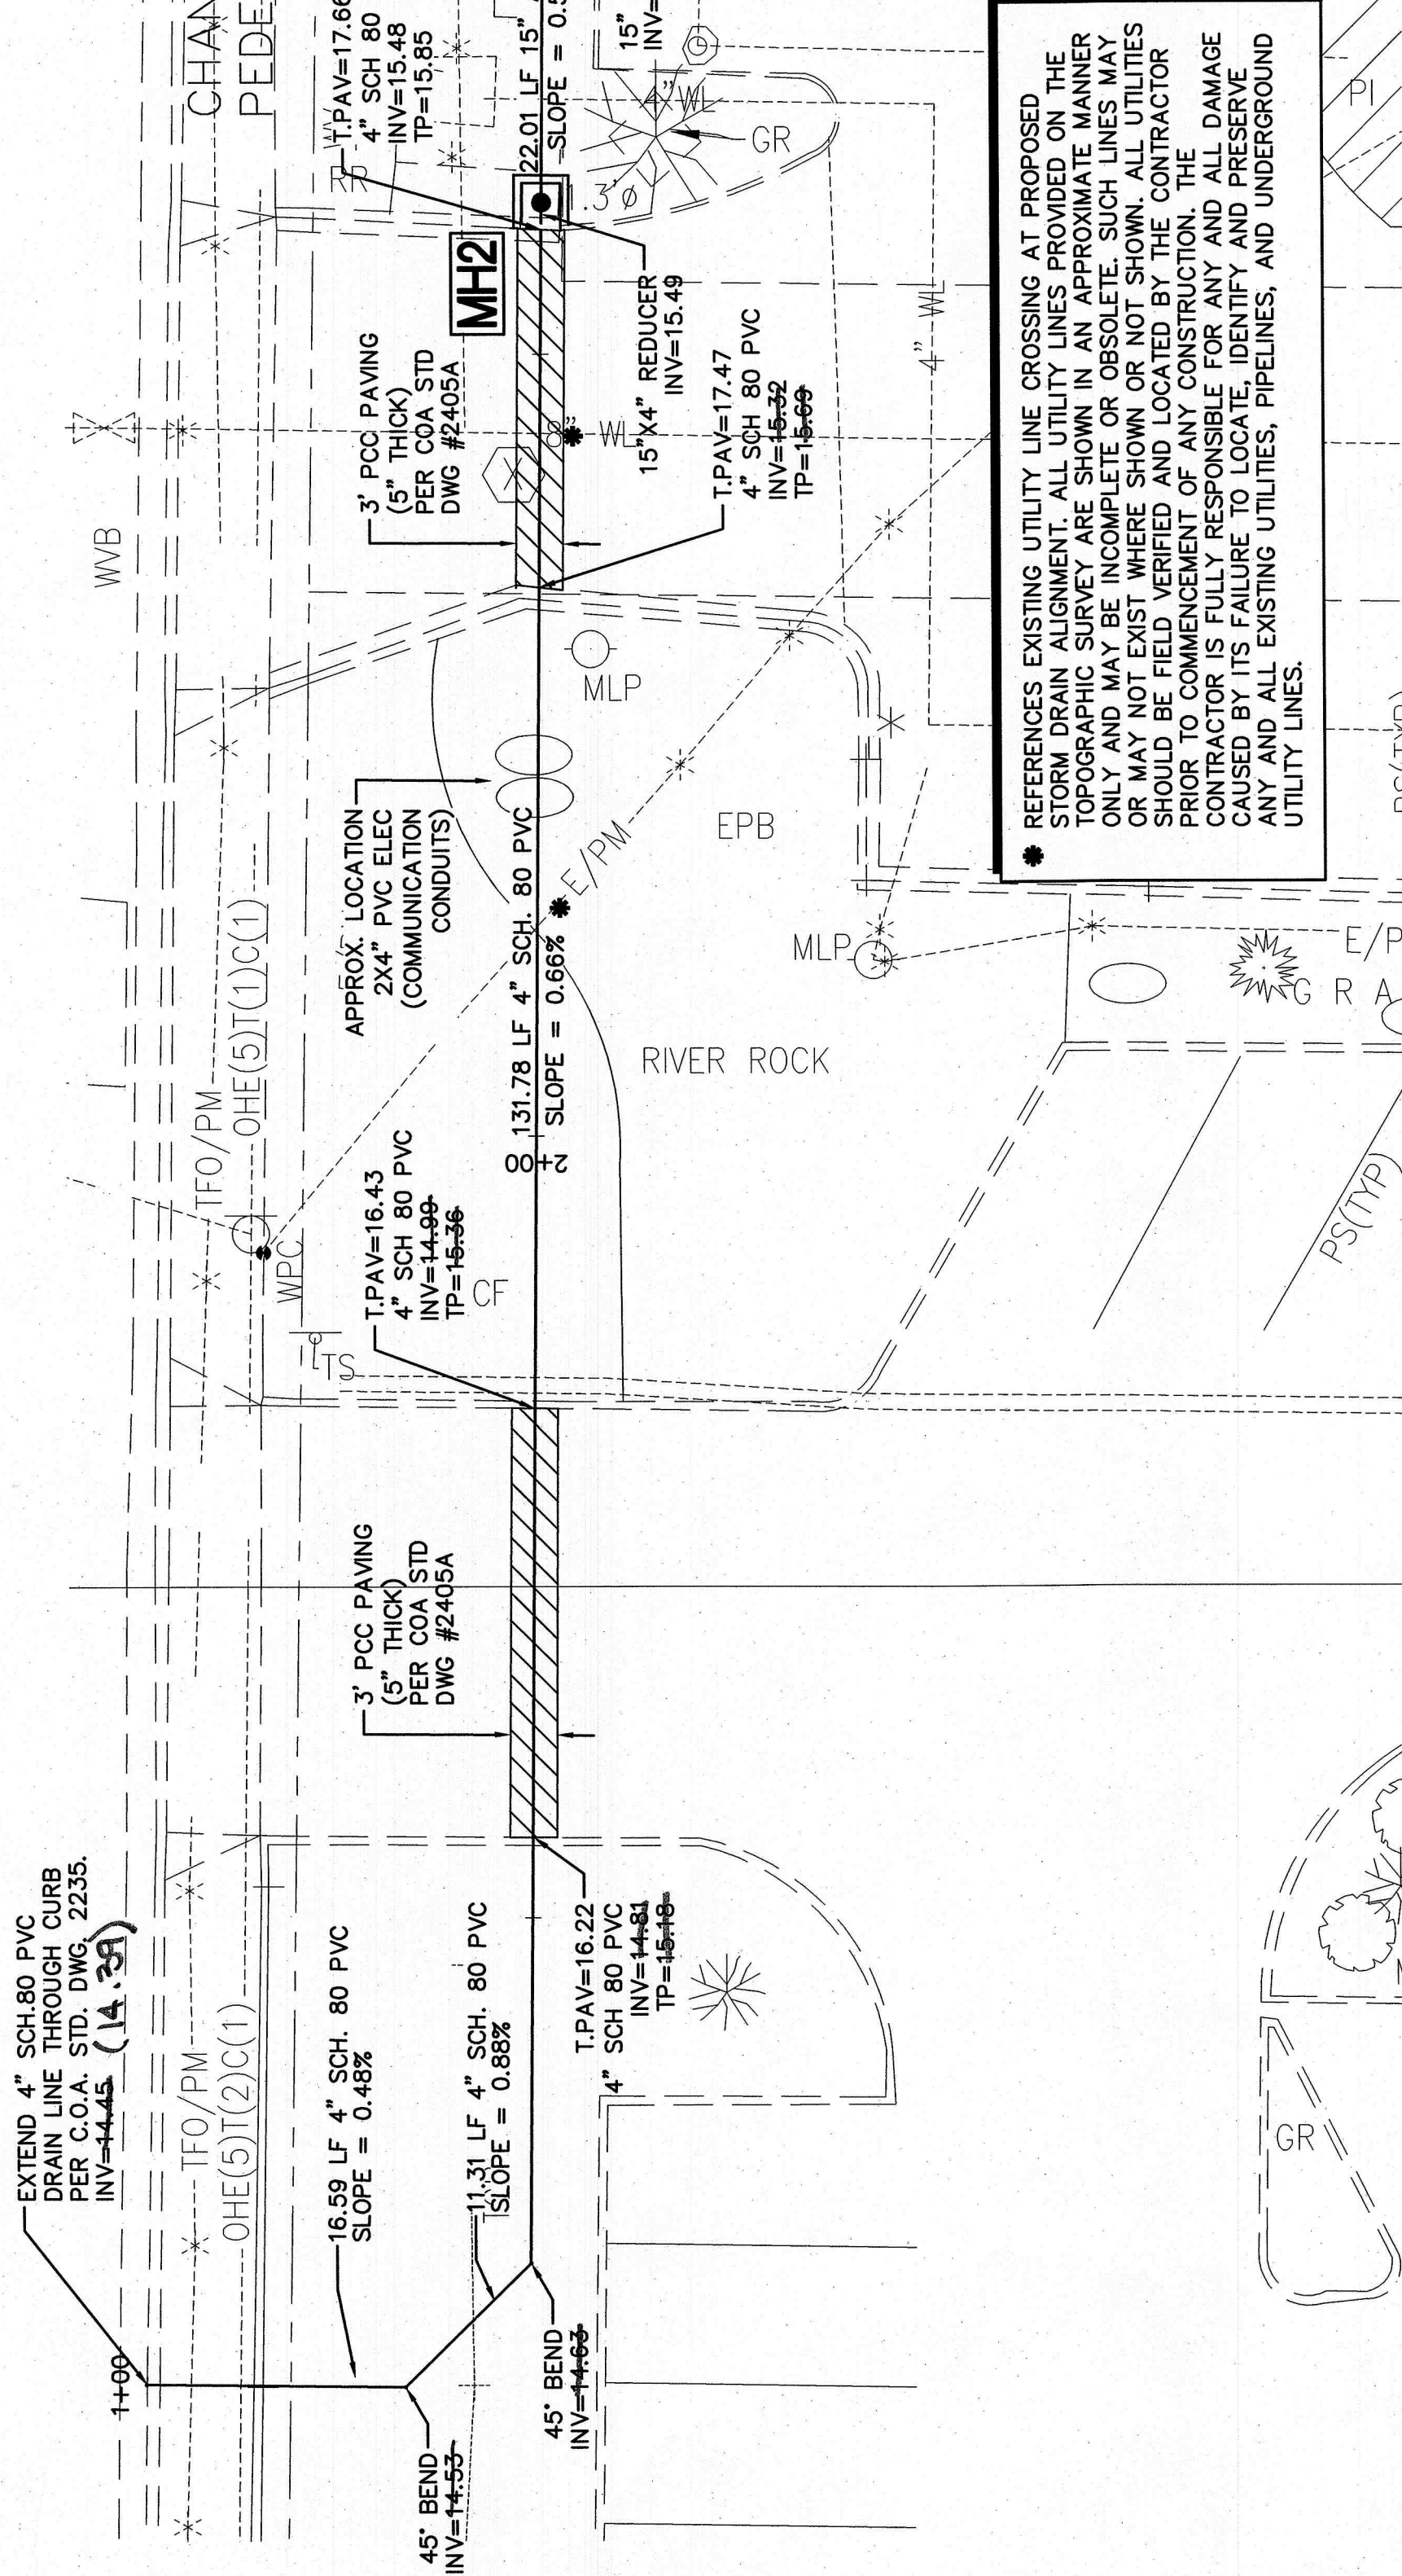

E1 STORM DRAIN PLAN - BASE BID

- A. ALL STORM DRAIN LINES AND FITTINGS TO BE ADS N-12WT WATERTIGHT.
- B. INSTALL ALL STORM DRAIN INLETS AND PIPE PER MANUFACTURER'S SPECIFICATIONS.
- C. STORM DRAIN SYSTEM WILL REQUIRE REGULAR MAINTENANCE TO ENSURE PROPER FUNCTIONING. THE CONTRACTOR SHALL INSPECT AND MAINTENANCE CRITERIA SCHEDULED TO OCCUR ON A REGULAR BASIS AND AFTER EACH STORM EVENT.

B5 STORM DRAIN GENERAL NOTES
SCALE: N.T.S.

ISAACSON & ARFMAN, P.A.
Consulting Engineering Associates
128 Monroe Street N.E.
Albuquerque, New Mexico 87108
Ph. 505-268-8528 www.isaifirm.com
1928 CG-5015.dwg Jul 12,2013

GENERAL NOTES

- A. COORDINATE WORK WITH SITE PLAN, UTILITY PLAN, AND DEMOLITION PLAN.
- B. ALL TRASH, DEBRIS, & SURFACE VEGETATION SHALL BE CLEARED AND LEGALLY DISPOSED OF OFFSITE.
- C. ALL SUBGRADE, OVEREXCAVATION, AND FILL SHALL BE PLACED AND / OR COMPACTED PER THE GEOTECHNICAL REPORT AND CITY OF ALBUQUERQUE SPECIFICATIONS.
- D. FINAL GRADES SHOWN REPRESENT TOP OF FINISH MATERIAL (I.E. PAVEMENT, CONCRETE, ETC.) UNLESS OTHERWISE NOTED. CONTRACTOR SHALL GRADE, COMPACT SUBGRADE AND SUBGRADE MATERIAL TO THE FINISH ELEVATIONS SHOWN. MINIMUM FINISH MATERIAL THICKNESSES:
 - EXISTING UTILITY LINES ARE SHOWN IN AN APPROXIMATE MANNER ONLY AND MAY BE INCOMPLETE OR OBSOLETE. SUCH LINES MAY OR MAY NOT EXIST WHERE SHOWN OR NOT SHOWN. THE CONTRACTOR SHALL BE RESPONSIBLE FOR VERIFYING THE LOCATION AND DEPTH OF ALL EXISTING UTILITIES, PIPELINES, AND UNDERGROUND UTILITY LINES.
 - ADJUST RIMS OF EXISTING UTILITY FEATURES AS NECESSARY TO MATCH NEW GRADES, TYPICAL.
 - ALL NEW PAVEMENT SURFACES SHALL BE CONSTRUCTED WITH POSITIVE SLOPE AWAY FROM BUILDINGS AND DRIVEWAYS. SLOPE TOWARD EXISTING AND/OR PROPOSED DRAINAGE PATHS.
 - WHERE NEW GRASSES ARE SHOWN, THE CONTRACTOR SHALL MAINTAIN TO EXISTING SHALL BE SMOOTH AND LEVEL.
 - ENGINEER RECOMMENDS THAT OWNER MAINTAIN EROSION PROTECTION ELEMENTS. ENGINEER RECOMMENDS THAT OWNER INSPECT SITE YEARLY AND AFTER EACH RAINFALL TO IDENTIFY EROSION AND REPAIR AS NEEDED. EROSION PROTECTION ELEMENTS SHALL BE MAINTAINED AS NECESSARY PROTECTION AS NEEDED BASED ON ACTUAL OCCURRENCES.

Albuquerque Public Schools
New Futures School Cafeteria Addition and Remodel
5400 Cutler Ave. NE
Albuquerque, New Mexico 87110



GREGORY T. HICK
& ASSOCIATES, P.A.
ARCHITECTS • PLANNERS

The Sunshine Building
110 Second St. S. Suite 200
Albuquerque, NM 87102
T: (505) 243-7411
F: (505) 243-1111
e-mail: gthide@gtfide.com

