

CITY OF ALBUQUERQUE

Planning Department
Alan Varela, Director



Mayor Timothy M. Keller

November 1, 2022

Ryan Morrissey, P.E.
Burkhardt Engineering
28 North Cherry St.
Germantown, OH, 45327

RE: Champion Xpress Car Wash
7509 Menaul Blvd. NE
Engineer's Certification Date: 10/21/22
Engineer's Stamp Date: 07/20/21
Hydrology File: H19D091

Dear Mr. Morrissey:

PO Box 1293

Based on the Certification received 10/24/2022 and site visit on 10/28/22, this certification is approved in support of ROFG/SIA by Hydrology.

Albuquerque

If you have any questions, please contact me at 924-3995 or rbrissette@cabq.gov.

Sincerely,

NM 87103

www.cabq.gov

Renée C. Brissette, P.E. CFM
Senior Engineer, Hydrology
Planning Department



City of Albuquerque

Planning Department

Development & Building Services Division

DRAINAGE AND TRANSPORTATION INFORMATION SHEET (REV 10/2018)

Project Title: Xpress Car Wash **Building Permit #:** 2021-17219 **Hydrology File #:** H19D091
DRB#: _____ **EPC#:** _____ **Work Order#:** _____
Legal Description: * 003 008BROAD ACRES and * 004 008BROAD ARCES XLT 5X6
City Address: 7509 Menaul NE Albuquerque, NM 87110 and 7521 Menaul NE Albuquerque, NM 87110

Applicant: Ryan Morrissey **Contact:** _____
Address: 28 North Cherry Street Germantown, OH 45327
Phone#: 937-694-3142 **Fax#:** _____ **E-mail:** rmorrissey@burkhardtinc.com

Other Contact: Modulus Architects **Contact:** Regina Okoye
Address: 100 Sun Ave. NE, suite 600, Albuquerque, NM 87109
Phone#: 505-267-7686 **Fax#:** _____ **E-mail:** rokoye@modulusarchitects.com

TYPE OF DEVELOPMENT: _____ PLAT (# of lots) _____ RESIDENCE _____ DRB SITE ☒ ADMIN SITE

IS THIS A RESUBMITTAL? _____ Yes ☒ No

DEPARTMENT: _____ TRAFFIC/TRANSPORTATION ☒ HYDROLOGY/DRAINAGE

Check all that Apply:

TYPE OF SUBMITTAL:

- ☒ ENGINEER/ARCHITECT CERTIFICATION
☐ PAD CERTIFICATION
☐ CONCEPTUAL G & D PLAN
☐ GRADING PLAN
☐ DRAINAGE MASTER PLAN
☐ DRAINAGE REPORT
☐ FLOODPLAIN DEVELOPMENT PERMIT APPLIC
☐ ELEVATION CERTIFICATE
☐ CLOMR/LOMR
☐ TRAFFIC CIRCULATION LAYOUT (TCL)
☐ TRAFFIC IMPACT STUDY (TIS)
☐ OTHER (SPECIFY) _____
☐ PRE-DESIGN MEETING?

TYPE OF APPROVAL/ACCEPTANCE SOUGHT:

- ☐ BUILDING PERMIT APPROVAL
☐ CERTIFICATE OF OCCUPANCY
☐ PRELIMINARY PLAT APPROVAL
☐ SITE PLAN FOR SUB'D APPROVAL
☐ SITE PLAN FOR BLDG. PERMIT APPROVAL
☐ FINAL PLAT APPROVAL
☒ SIA/ RELEASE OF FINANCIAL GUARANTEE
☐ FOUNDATION PERMIT APPROVAL
☐ GRADING PERMIT APPROVAL
☐ SO-19 APPROVAL
☐ PAVING PERMIT APPROVAL
☐ GRADING/ PAD CERTIFICATION
☐ WORK ORDER APPROVAL
☐ CLOMR/LOMR
☐ FLOODPLAIN DEVELOPMENT PERMIT
☐ OTHER (SPECIFY) _____

DATE SUBMITTED: 10/24/2022 **By:** Ryan Morrissey

COA STAFF:

ELECTRONIC SUBMITTAL RECEIVED: _____

FEE PAID: _____

City of Albuquerque
Planning Department
Development Review Services
HYDROLOGY SECTION
APPROVED
DATE: 08/13/21
BY: *Renee Brummett*
HydroTeam # H19D091

THE APPROVAL OF THESE PLANS SHALL NOT BE
CONSIDERED TO BE A GUARANTEE OF ANY CITY
ENGINEER OR THE CITY OF ALBUQUERQUE. THE CITY
ENGINEER OR THE CITY OF ALBUQUERQUE DOES NOT
WARRANT OR GUARANTEE THE ACCURACY OF THE
INFORMATION OR DATA OF CONSULTANTS IN PLANS.
SPECIFICATIONS AND CONDITIONS SHALL BE APPROVED
BY THE CITY ENGINEER OR THE CITY OF ALBUQUERQUE.
AUTOMATICALLY.

DRAINAGE CERTIFICATION

I, RYAN JOSEPH MORRISSEY, NMP# 25323, OF THE FIRM BURKHARDT ENGINEERING COMPANY, HEREBY
CERTIFY THAT THIS PROJECT HAS BEEN GRADED AND WILL DRAIN IN SUBSTANTIAL COMPLIANCE WITH
AND IN ACCORDANCE WITH THE DESIGN INTENT OF THE APPROVED PLAN DATED 7/20/2021. THE RECORD
INFORMATION EDITED ONTO THE ORIGINAL DESIGN DOCUMENT HAS BEEN OBTAINED BY STEVEN JOHN
SANDOVAL, NMP# 12351, OF THE FIRM CONSTRUCTION SURVEYING SERVICES.

I FURTHER CERTIFY THAT I HAVE PERSONALLY REVIEWED PHOTOGRAPHY AND HAVE DETERMINED BY
VISUAL INSPECTION THAT THE SURVEY DATA PROVIDED IS REPRESENTATIVE OF ACTUAL SITE
CONDITIONS AND IS TRUE AND CORRECT TO THE BEST OF MY KNOWLEDGE AND BELIEF.

THIS CERTIFICATION IS SUBMITTED IN SUPPORT OF A REQUEST FOR CERTIFICATE OF OCCUPANCY.

THE RECORD INFORMATION PRESENTED HEREON IS NOT NECESSARILY COMPLETE AND INTENDED ONLY
TO VERIFY SUBSTANTIAL COMPLIANCE OF THE GRADING AND DRAINAGE ASPECTS OF THIS PROJECT.

THOSE RELYING ON THIS RECORD DOCUMENT ARE ADVISED TO OBTAIN INDEPENDENT VERIFICATION OF
ITS ACCURACY BEFORE USING IT FOR ANY OTHER PURPOSE.



PERMITTING CONTACT INFORMATION:

PLANNING / ZONING / BUILDING
City of Albuquerque - Planning Department
Contact: David Campbell
Telephone: 505.924.3860
Email: dscampbell@cabq.gov

UTILITY CONTACT INFORMATION:

SANITARY SEWER / WATER
Albuquerque Bernalillo County Water Utility Authority
Contact: David Gutierrez
Telephone: 505.289.3307
Email: dggutierrez@abwcwa.org


GAS
New Mexico Gas Company
Contact: Customer Service
Telephone: 505.697.3335

ELECTRIC
PNM (Public Service Company of New Mexico)
Contact: Michael Moyer
Telephone: 505.241.3697
Email: mmoyer@pnm.com

TELECOM
CenturyLink
Contact: Customer Service
Telephone: 866.465.2313

VERTICAL & HORIZONTAL CONTROL:
Reference - ALTA / NSPS Land Survey of the subject property
prepared by Steve Sandoval Professional Land Surveyor - New
Mexico Registration No. 12351 (NAD 83, NAVD88)

Rotated to City of Albuquerque Survey Monuments 15, H18 and
11, H19 and pinned to a one-point opus static GPS solution
performed on the subject property at North Latitude 35°06'33.96794"
West Longitude 106°33'37.30036" N1495266.12 E1547596.14 SPC
NM C Zone 3002 Orthometric Height of 5342.81 NAVD 1988.

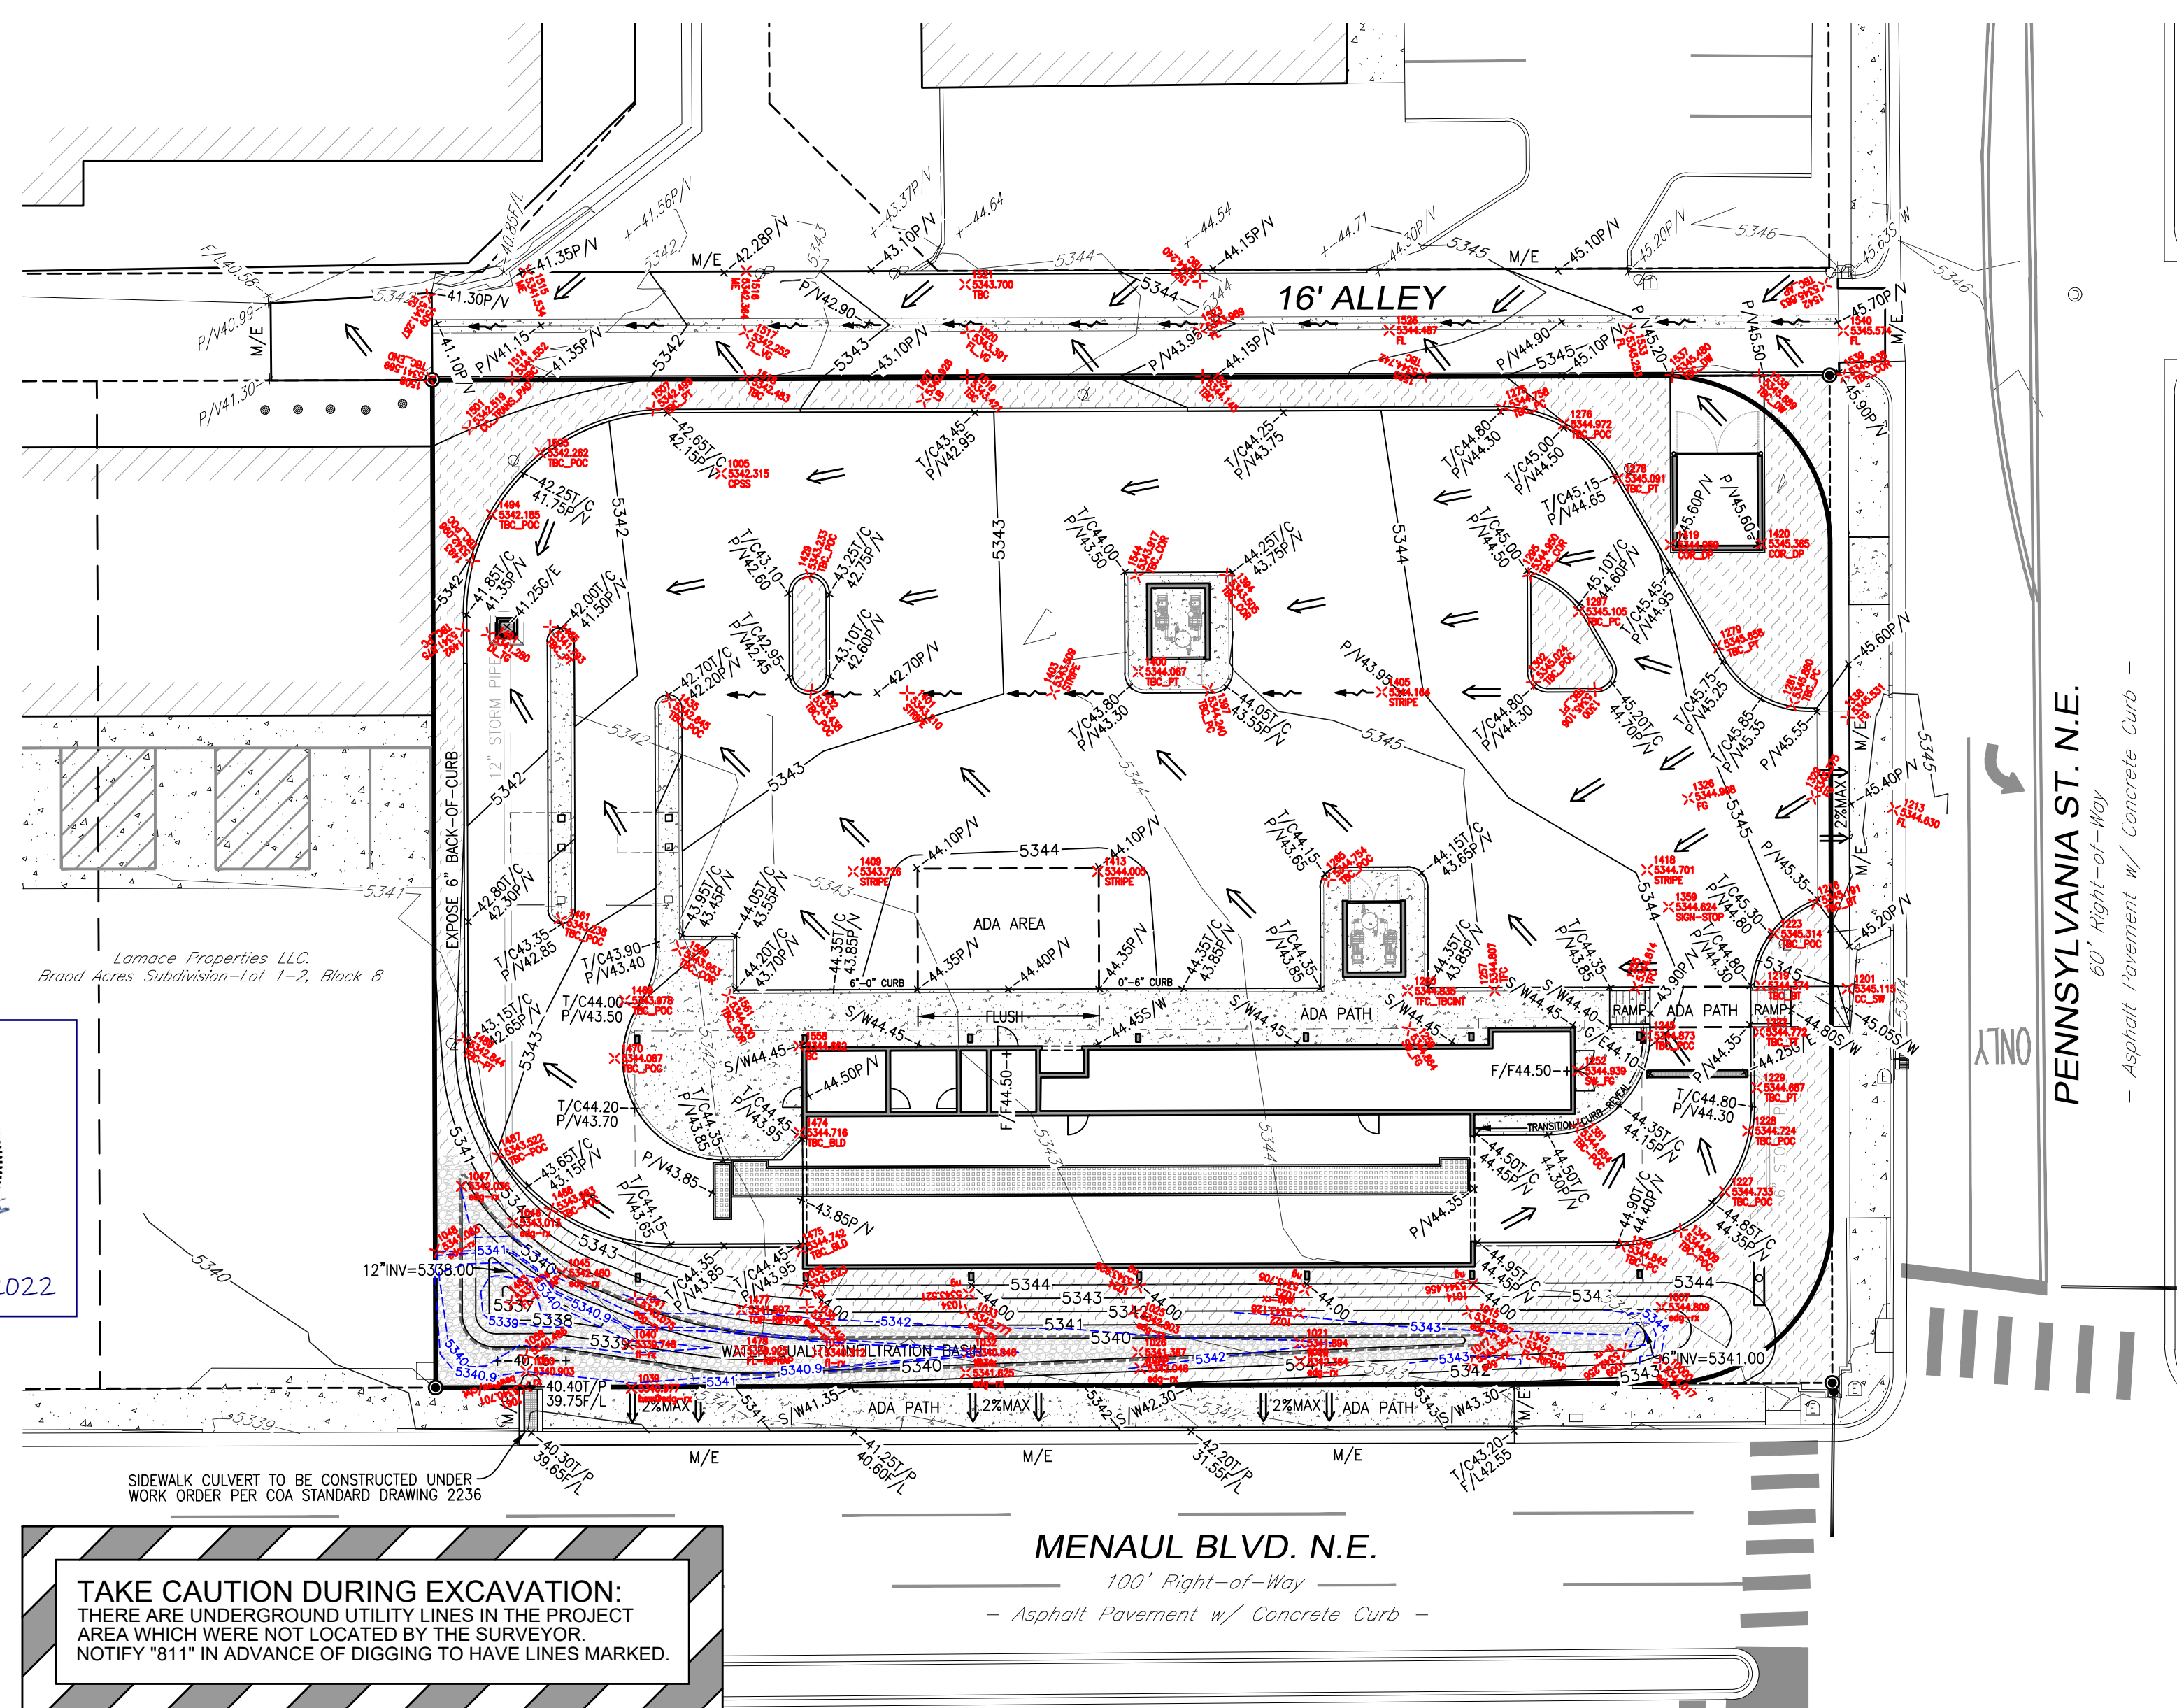

TAKE CAUTION DURING EXCAVATION:
THERE ARE UNDERGROUND UTILITY LINES IN THE PROJECT
AREA WHICH WERE NOT LOCATED BY THE SURVEYOR.
NOTIFY "811" IN ADVANCE OF DIGGING TO HAVE LINES MARKED.

National Flood Hazard Layer FIRMette



Legend

SEE FIRM REPORT FOR DETAILED LEGEND AND INDEX MAP FOR FIRM PANEL LAYOUT

SPECIAL FLOOD HAZARD AREAS

- Without Base Flood Elevation (BFE) Zone X, Zone 9, Zone 10, Zone 11, Zone 1662,

Private Drainage Facilities within City Right-of-Way
Notice to Contractor
(Special Order 19 ~ "SO-19")

1. Build sidewalk culvert per COA STD DWG 2236.
2. Contact Storm Drain Maintenance at (505) 857-8033 to schedule a meeting prior to forming.
3. An excavation permit will be required before beginning any work within City Right-Of-Way.
4. All work on this project shall be performed in accordance with applicable federal, state and local laws, rules and regulations concerning construction safety and health.
5. Two working days prior to any excavation, the contractor must contact New Mexico One Call, dial "811" [or (505) 260-1990] for the location of existing utilities.
6. Prior to construction, the contractor shall excavate and verify the locations of all obstructions. Should a conflict exist, the contractor shall notify the engineer so that the conflict can be resolved with a minimum amount of delay.
7. Backfill compaction shall be according to traffic/street use.
8. Maintenance of the facility shall be the responsibility of the owner of the property being served.
9. Work on arterial streets may be required on a 24-hour basis.
10. Contractor must contact Storm Drain Maintenance at (505) 857-8033 to schedule a construction inspection. For excavating and barricading inspections, contact Construction Coordination at (505) 924-3416.

STORM WATER MANAGEMENT NOTES:

Existing Lot Coverage - 87% impervious / 13% landscaping & gravel
Proposed Lot Coverage - 83% impervious / 17% landscaping

Net Decrease in Storm Water Runoff due to Development
No Storm Water Detention Required

Methodology:

Albuquerque Development Process Manual

Chapter 22, Section 2, Part A;

"A simplified procedure for projects with sub-basins smaller than 40 acres has been developed based on initial abstraction / uniform infiltration precipitation losses and Rational Method procedures."

Storm Water Quality Volume (WQv) = Impervious Area x 0.26 inches

Precipitation Zone:


Precipitation Zone 3: "Between the San Mateo and Eubank"

Drainage Summary:

Area = 0.717 acres
Treatment B (Desert Landscaping Area) - 17%
Treatment D (Impervious Area) - 83% = 0.595 acres
100-year peak Discharge Rate = 4.14 cfs/acre (Table A-9)
Q₁₀₀ = 2.97 cfs
WQv = 677 cu-ft (required)

Provided Water Quality Storage Volume:

Elevation (ft)	Contour Area (sq-ft)	Incremental Vol. (cu-ft)	ΣVolume (cu-ft)
5337	8	0	0
5338	46	27	27
5339	250	148	175
5340	791	521	696
5340.15	895	126	822 - overflow to R/W

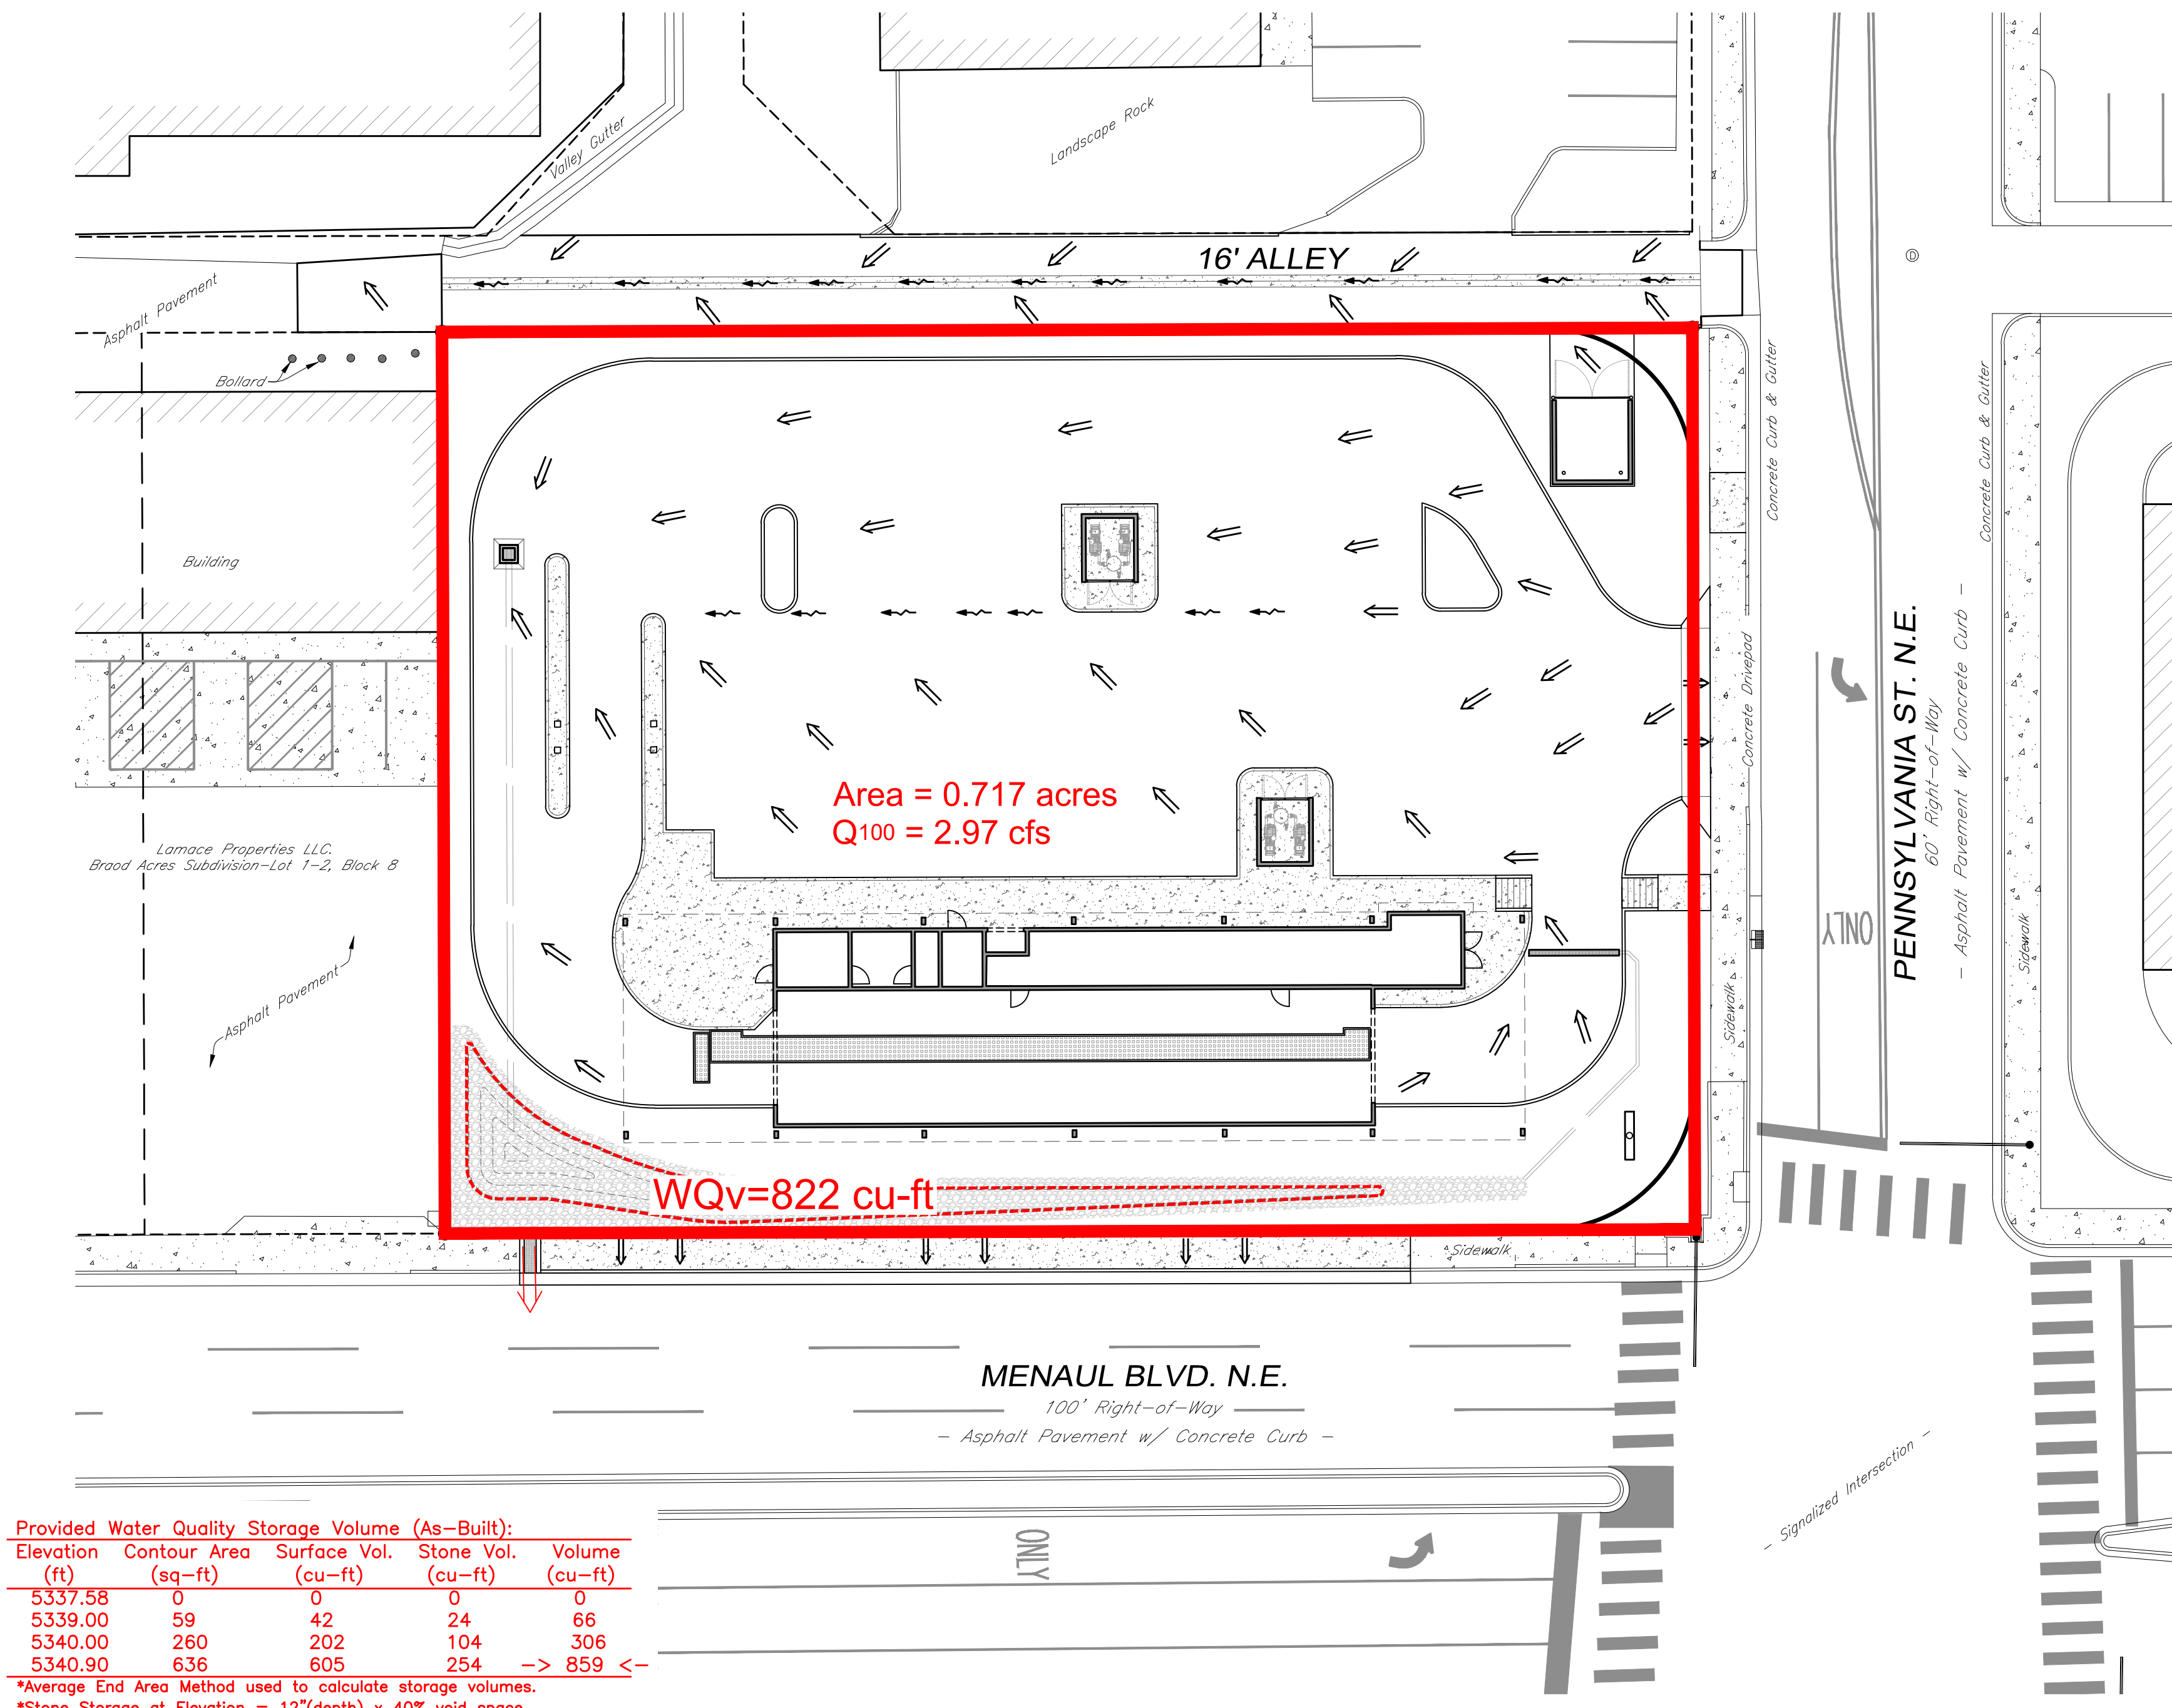


Provided Water Quality Storage Volume (As-Built):				
Elevation (ft)	Contour Area (sq-ft)	Surface Vol. (cu-ft)	Stone Vol. (cu-ft)	Volume (cu-ft)
5337.58	0	0	0	0
5339.00	59	42	24	66
5340.00	260	202	104	306
5340.90	636	605	254	859 <-
*Average End Area Method used to calculate storage volumes.				
*Stone Storage at Elevation = 12" (depth) x 40% void space.				
*Provided Volume exceeds Required Volume.				

*Average End Area Method used to calculate storage volumes.


Curb Cut and Sidewalk Culvert Capacity:

Weir Equation: $Q = CxLxH^{3/2}$ where,
Q = discharge (cfs)
C = weir coefficient = 3.33
L = length of weir (ft)
H = head or depth (ft)

For the 24" wide Curb Cuts and Sidewalk Culverts with a max depth of 7";
Maximum Flow = 2.97 cfs (meets 100-year discharge)

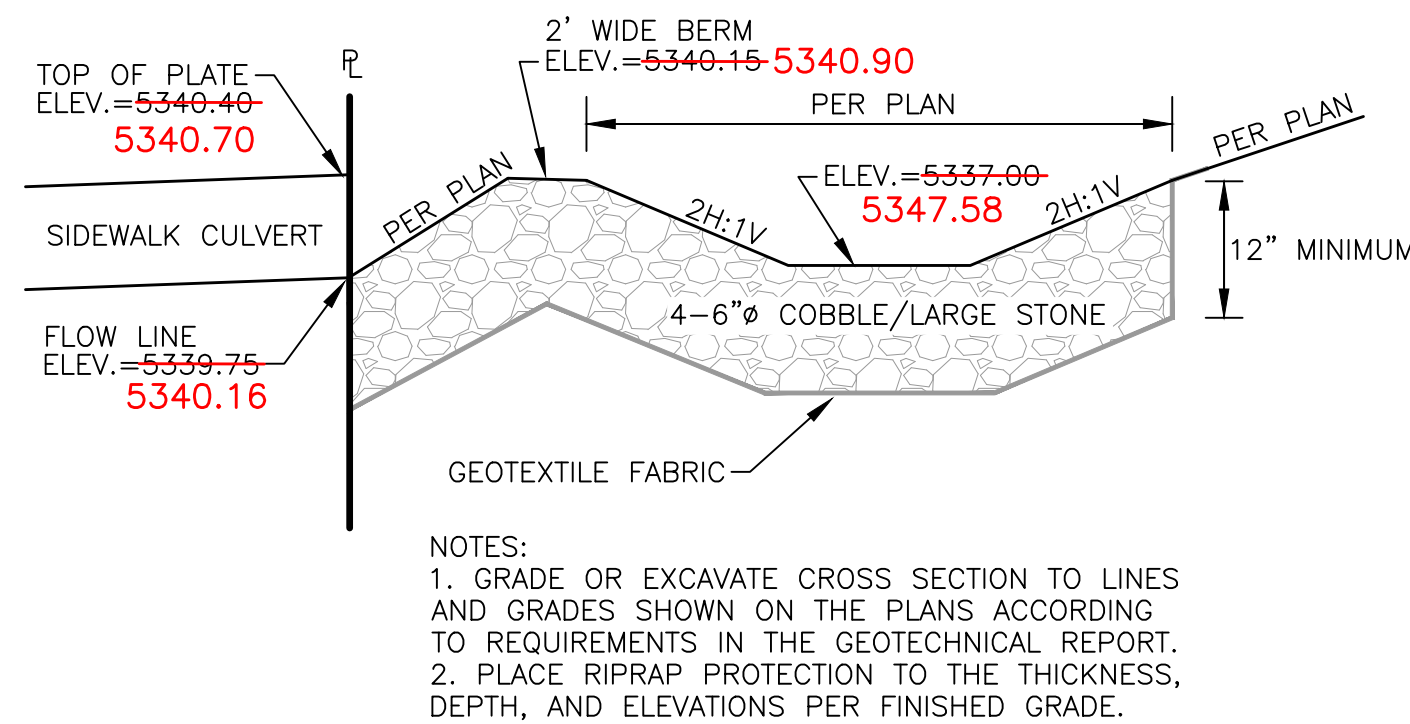

WQv AREA SECTION
NOT TO SCALE

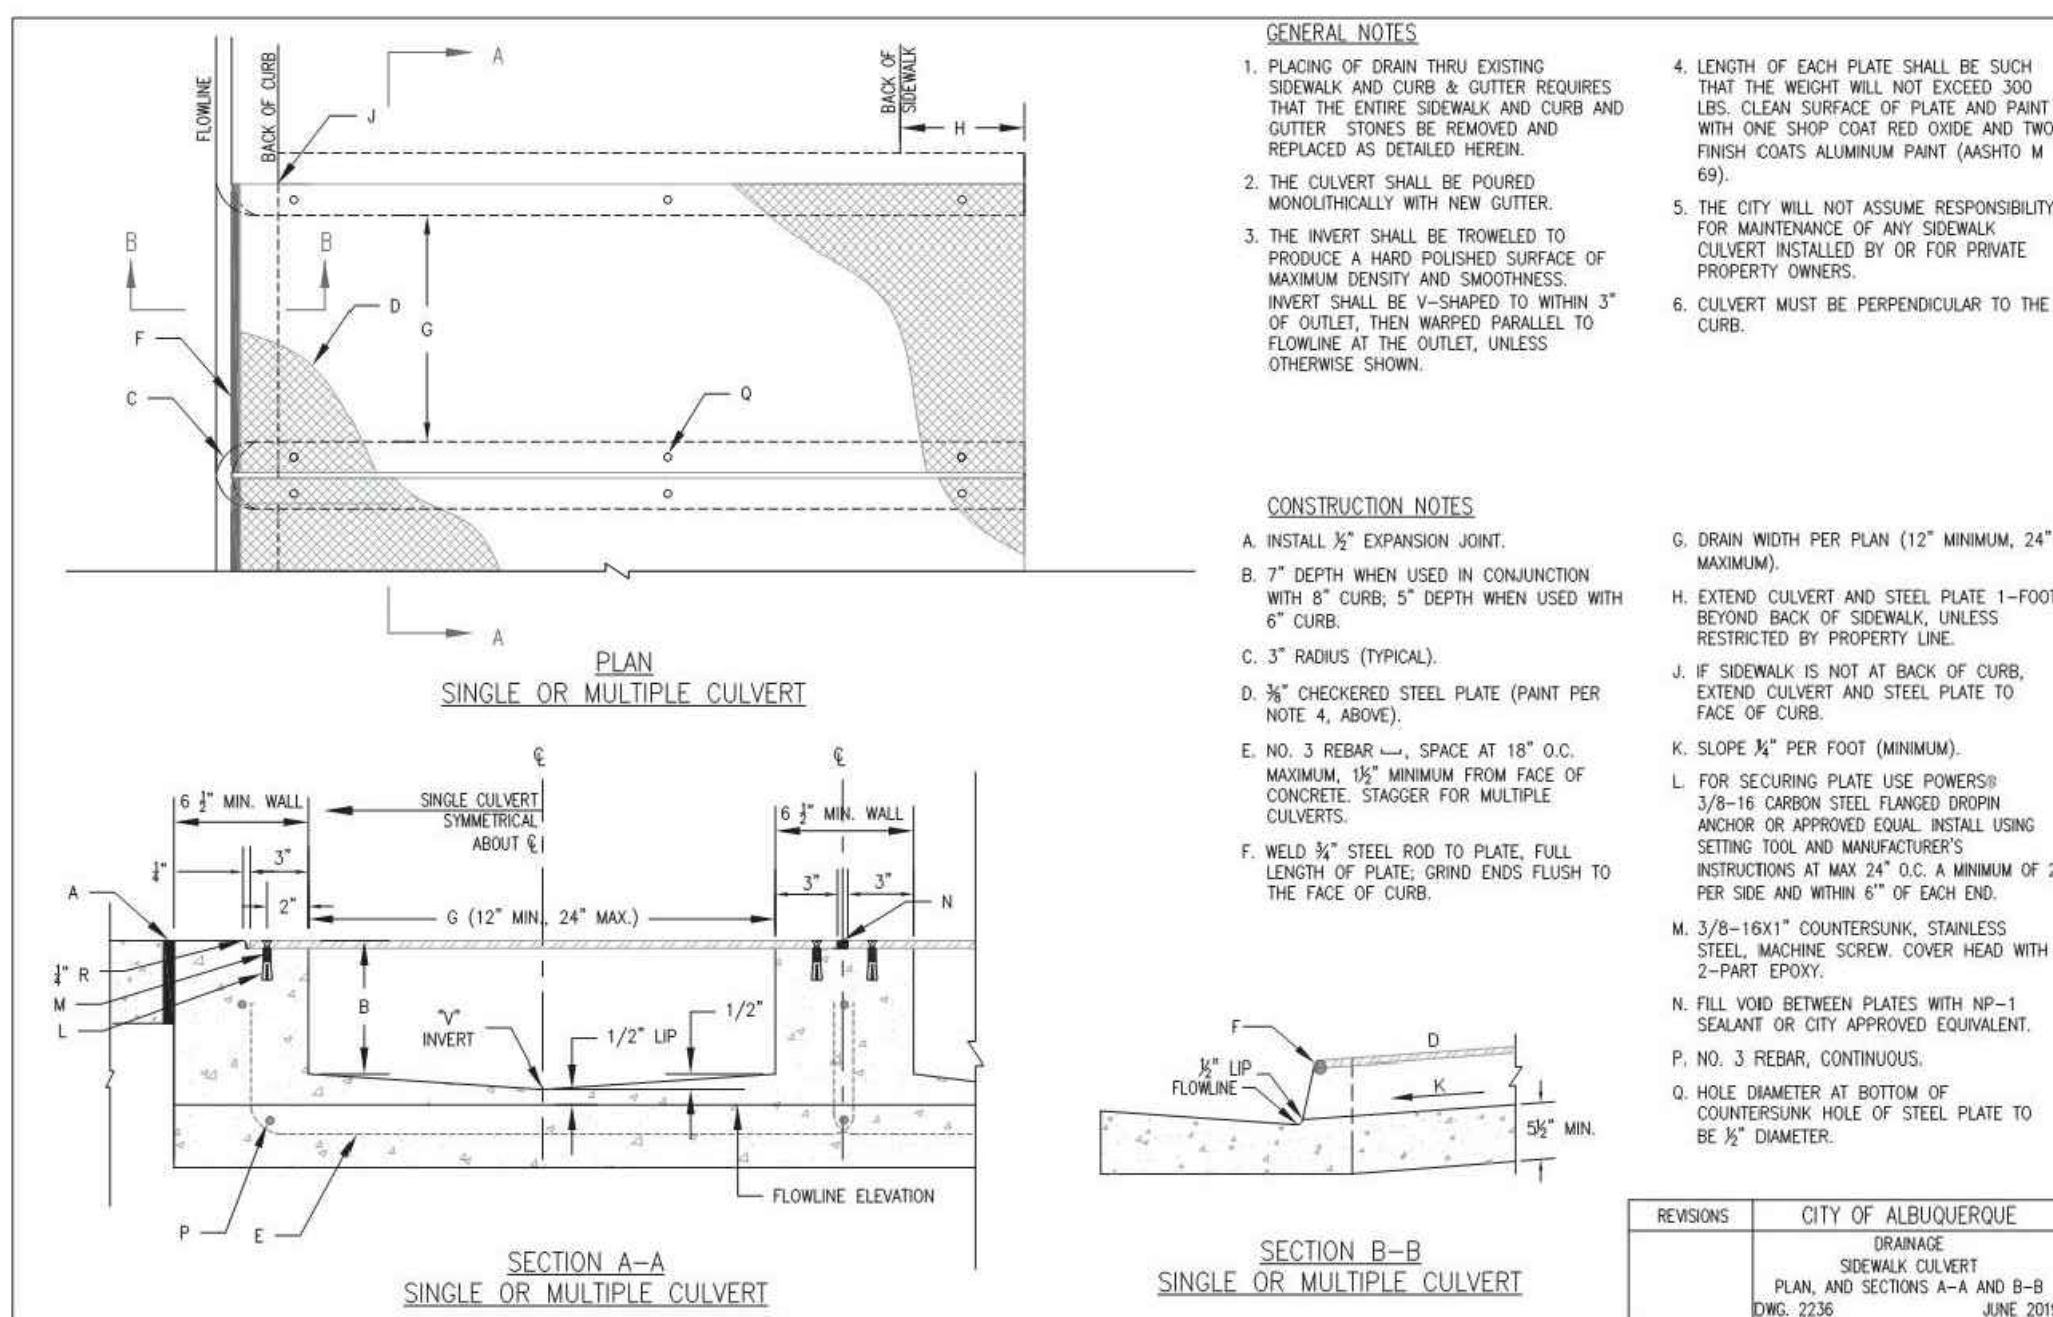


GENERAL GRADING, EARTHWORK & DRAINAGE NOTES

1. All spot elevations indicated in pavement areas are at bottom face of curb and/or finished pavement grade unless noted otherwise. All spot elevations indicated in grass or landscape areas are finished grade unless noted otherwise.
2. The Contractor shall be responsible for the removal and disposal of all vegetation and organic materials from the site that results from clearing & grubbing activities.
3. The Contractor shall be responsible for stripping and removal of all excess topsoil from the site. All topsoil that cannot be used on site shall be removed from the site at the Contractor's expense. The Contractor may dispose of excess topsoil by burying topsoil in landscape areas only at the direction of the Owner or the Owner's Representative.
4. The Contractor will be responsible for all safety requirements and for the protection of all existing and proposed utilities or structures during earthwork procedures.
5. The Contractor shall be responsible for the import of structural fill materials if suitable material is not available on site. The location and testing of suitable material shall be the Contractor's responsibility. The Contractor shall be responsible for the export and disposal of all excess or unsuitable materials.
6. The Contractor shall provide construction dewatering as necessary to complete construction as outlined in plans.
7. The Contractor shall exercise extreme care in establishing all grades and slopes in pavement areas, ramps and sidewalks in the vicinity of handicap parking and access areas and shall comply with Federal, State, and Local Codes.
8. In areas where sheet drainage flows from grass or landscape areas onto paved areas, the finished grade in grass or landscape areas shall be 1/2 inch above the top of curb or above the pavement in areas without curb. In areas where sheet drainage flows from pavement to grass or landscaped areas, the finished grade in grass or landscape areas shall be 1/2 inch below the pavement.
9. The Contractor shall provide positive drainage in all areas and away from all buildings.
10. All pavement shall be laid on a straight, even, and uniform grade with a minimum of 1:100 (1.0%) slope toward the collection points unless otherwise specified on plans. Cut or fill slopes in unpaved areas shall not exceed 3:1 (33.3%) maximum grade unless otherwise noted on plans.
11. ADA accessible areas shall not exceed the following slopes:
Ramps - 1:12 (8.3%) max.
Routes - 1:20 (5.0%) max.
Parking - 1:50 (2.0%) max.
Cross Slopes - 1:50 (2.0%) max.
12. The Contractor shall adjust tops/lids/grates of all cleanouts, manholes, inlets, valves, etc. to match final grade.
13. Following grading of subsoil to subgrade elevations, the Contractor shall provide 4" of topsoil (minimum) in all disturbed areas which are not to be paved. Final grades should be smoothly finished to surrounding areas and ensure positive drainage. Stockpiled topsoil shall be screened prior to respreading and should be free of subsoil, debris, and stones.
14. The Contractor shall be responsible for determining exact quantities of cut and/or fill for estimating and construction and should alert the Engineer of any excessive cut and/or fill, especially if additional cut and/or fill will be required due to poor existing soil conditions discovered during earthwork operations.
15. Refer to the Architectural and Structural Plans for information regarding any perimeter foundation drains.
16. The Contractor shall obtain a copy of the Geotechnical / Soils Report and become thoroughly familiar with site and subgrade information and fully implement recommendations given therein.



DRAINAGE CERTIFICATION

I, RYAN JOSEPH MORRISSEY, NMPE 25323, OF THE FIRM BURKHARDT ENGINEERING COMPANY, HEREBY CERTIFY THAT THIS PROJECT HAS BEEN GRADED AND WILL DRAIN IN SUBSTANTIAL COMPLIANCE WITH AND IN ACCORDANCE WITH THE DESIGN INTENT OF THE APPROVED PLAN DATED 7/20/2021. THE RECORD INFORMATION PRESENTED HEREIN IS NOT NECESSARILY COMPLETE AND INTENDED ONLY TO VERIFY SUBSTANTIAL COMPLIANCE OF THE GRADING AND DRAINAGE ASPECTS OF THIS PROJECT. THOSE RELYING ON THIS RECORD DOCUMENT ARE ADVISED TO OBTAIN INDEPENDENT VERIFICATION OF ITS ACCURACY BEFORE USING IT FOR ANY OTHER PURPOSE.

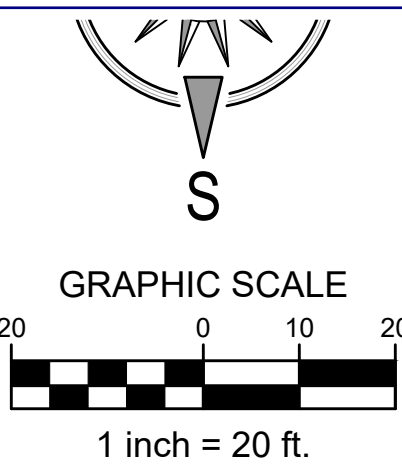

Date	06/04/21
Item	1
Description	Rev 5 - Revised per DRE Comments.

SITE DEVELOPMENT PLANS FOR
CHAMPION XPRESS CAR WASH
NORTHWEST OF THE INTERSECTION OF
MENAU BOULEVARD N.E. & PENNSYLVANIA STREET N.E.
LOTS 3-6, BLOCK 8, BROAD ACRES SUBDIVISION
CITY OF ALBUQUERQUE, BERNALILLO COUNTY, NEW MEXICO

BURKHARDT
ENGINEERS & SURVEYORS
28 North Cherry Street | Albuquerque, NM 87101 | Phone: 505-261-9901 | BURKHARDT.COM
CIVIL ENGINEERING | LAND SURVEYING | NATIONAL RETAIL SITE DEVELOPMENT

Design: RJM Proj: 19-106
Draw: JMM Dwg: 19-106.dwg
Check: RJM Tab: C3.1-GP
Scale: 1" = 20'

Date: 02.05.2021

Sheet: GRADING & DRAINAGE NOTES AND DETAILS

Sheet No.: C-3.1

