

LEGAL DESCRIPTION
TRACK B-1, BLOCK 130
SNOW HEIGHTS ADDITION
ALBUQUERQUE, BERNALILLO COUNTY,
NEW MEXICO.

GENERAL NOTES:

1. An excavation/construction permit will be required before beginning any work within the City right-of-way. Approved copy of this plan must be submitted at the time of application for permit.
2. All work detailed in this plan to be preformed, except as otherwise stated or provided hereon, shall be constructed in accordance with City of Albuquerque Interim Standard Specification for Public Works Construction 1985.
3. Two working days prior to any excavation, contractor must contact line locating Services at (505) 260-1990 for locating existing utilities.
4. Prior to construction, the contractor shall excavate and verify the horizontal and vertical location of all construction. Should a conflict exist, the contractor shall notify the engineer so that the conflict can be resolved with a minimum amount of delay.
5. Backfill compaction shall be according to residential street use.
6. All work on this project shall be performed in accordance with applicable Federal, State and local laws, rules and regulations concerning construction safety and health.

EROSION CONTROL MEASURES:

THE CONTRACTOR SHALL BE HELD RESPONSIBLE FOR MANAGEMENT OF STORM RUNOFF DURING CONSTRUCTION; HE SHALL INSURE THAT THE FOLLOWING MEASURES ARE TAKEN:

- ADJACENT PROPERTY SHALL BE PROTECTED AT ALL TIMES BY CONSTRUCTION OF BERMS, DIKES, SWALES, PONDS AND OTHER TEMPORARY GRADING AS REQUIRED TO PREVENT STORM RUNOFF TO LEAVE THE SITE AND ENTERING ADJACENT PROPERTY.
- ADJACENT PUBLIC RIGHT-OF-WAYS SHALL BE PROTECTED AT ALL TIMES FROM STORM WATER RUNOFF FROM THE SITE. NO SEDIMENT BEARING WATER SHALL BE PERMITTED TO ENTER THE PUBLIC STREETS.
- THE CONTRACTOR SHALL IMMEDIATELY AND THOROUGHLY REMOVE ANY OR ALL SEDIMENT WITHIN THE PUBLIC STREETS THAT HAVE BEEN ERODED FROM THE SITE AND DEPOSITED THERE.


BENCH-MARK INFORMATION

TEMPORARY BENCH-MARK BEING THE FINISH FLOOR ELEVATION OF EXISTING BUILDING BEARING ELEVATION 5421.39 MSL REFERENCE TO CITY BENCH-MARK 9-H20, LOCATED AT THE OF MOON & INDAIN SCHOOL BEARS ELEVATION 5419.28(MSL).

DRAINAGE CALCULATIONS

- I. REFERENCES:
A. SECTION 22.2, HYDROLOGY OF THE DEVELOPMENT PROCESS MANUAL, VOLUME 2, DESIGN CRITERIA FOR THE CITY OF ALBUQUERQUE, NEW MEXICO IN COOPERATION WITH BERNALILLO COUNTY, NEW MEXICO AND THE ALBUQUERQUE METROPOLITAN ARROYO FLOOD CONTROL AUTHORITY.
B. FLOODWAY, FLOOD BOUNDARY AND FLOODWAY MAP, CITY OF ALBUQUERQUE, NEW MEXICO, PANEL 24 OF 50.
C. ZONE ATLAS PAGE H-20-Z.
- II. GENERAL INFORMATION:
A. SITE LIES IN ZONE THREE(3) (SEE REF. A, PAGE A-1)
B. 100 YEAR, 6 HOUR RAINFALL CRITERIA
C. TIME OF CONCENTRATION, Tc; Tc = 0.2 hr(12 MINUTES).
- III. IMPERVIOUSNESS:
- | TREATMENT | TYPES OF SURFACES | EXISTING SQ. FT | ACRES | PROPOSED SQ. FT | ACRES |
|-----------|-------------------|-----------------|--------|-----------------|--------|
| A | UNDEVELOPED | 0 | 0.0000 | 0 | 0.0000 |
| B | LANDSCAPING | 0 | 0.0000 | 5,530 | 0.1270 |
| C | COMPACTED/VACANT | 0 | 0.0000 | 0 | 0.0000 |
| D | IMPERVIOUS | 24,356 | 0.5591 | 18,826 | 0.4322 |
| | TOTAL AREA (TA) | 24,356 | 0.5591 | 24,356 | 0.5591 |
- IV. PEAK DISCHARGE 100 YEAR (REF. A, TABLE A-9):
- | TREATMENT | TYPES OF SURFACES | CFS/Ac | EXISTING Qp(100) | PROPOSED CFS/Ac | PROPOSED Qp(100) |
|-----------|--------------------------|--------|------------------|-----------------|------------------|
| A | UNDEVELOPED | 1.87 | 0.00 | 1.87 | 0.00 |
| B | LANDSCAPING | 2.60 | 0.00 | 2.60 | 0.33 |
| C | COMPACTED/VACANT | 3.45 | 0.00 | 3.45 | 0.00 |
| D | IMPERVIOUS | 5.02 | 2.81 | 0.02 | 2.17 |
| | PEAK DISCHARGE FROM SITE | | 2.81 CFS | | 2.50 CFS |
- V. PEAK DISCHARGE 10 YEAR (REF. A, TABLE A-9):
- | TREATMENT | TYPES OF SURFACES | CFS/Ac | EXISTING Qp(10) | PROPOSED CFS/Ac | PROPOSED Qp(10) |
|-----------|--------------------------|--------|-----------------|-----------------|-----------------|
| A | UNDEVELOPED | 0.58 | 0.00 | 0.58 | 0.00 |
| B | LANDSCAPING | 1.19 | 0.00 | 1.19 | 0.15 |
| C | COMPACTED/VACANT | 2.00 | 0.00 | 2.00 | 0.00 |
| D | IMPERVIOUS | 3.39 | 1.90 | 3.39 | 1.47 |
| | PEAK DISCHARGE FROM SITE | | 1.90 CFS | | 1.62 CFS |
- VI. WEIGHTED "E" 100 YEAR, 6 HR. (REF. A, TABLE A-8):
- | TREATMENT | TYPES OF SURFACES | EXISTING E _W /A _T | PROPOSED E _W /A _T |
|-----------|---------------------|---|---|
| A | UNDEVELOPED | 0.66 | 0.66 |
| B | LANDSCAPING | 0.92 | 0.92 |
| C | COMPACTED/VACANT | 1.29 | 1.29 |
| D | IMPERVIOUS | 2.36 | 2.36 |
| | WEIGHTED "E" FACTOR | 2.36 IN | 2.03 IN |
- VI. VOLUME 100 YEAR, V(360) (REF. A, TABLE A-8):
- | TREATMENT | TYPES OF SURFACES | EXISTING VOLUME | PROPOSED VOLUME |
|-----------|-------------------|-----------------------------------|-----------------------------------|
| A | UNDEVELOPED | 2.36 x 0.5591/12 = 0.1100 AC. FT. | |
| B | LANDSCAPING | = 4,790 CU. FT. | |
| C | COMPACTED/VACANT | | 2.03 x 0.5591/12 = 0.0947 AC. FT. |
| D | IMPERVIOUS | | = 4,126 CU. FT. |

MOON ST. NE


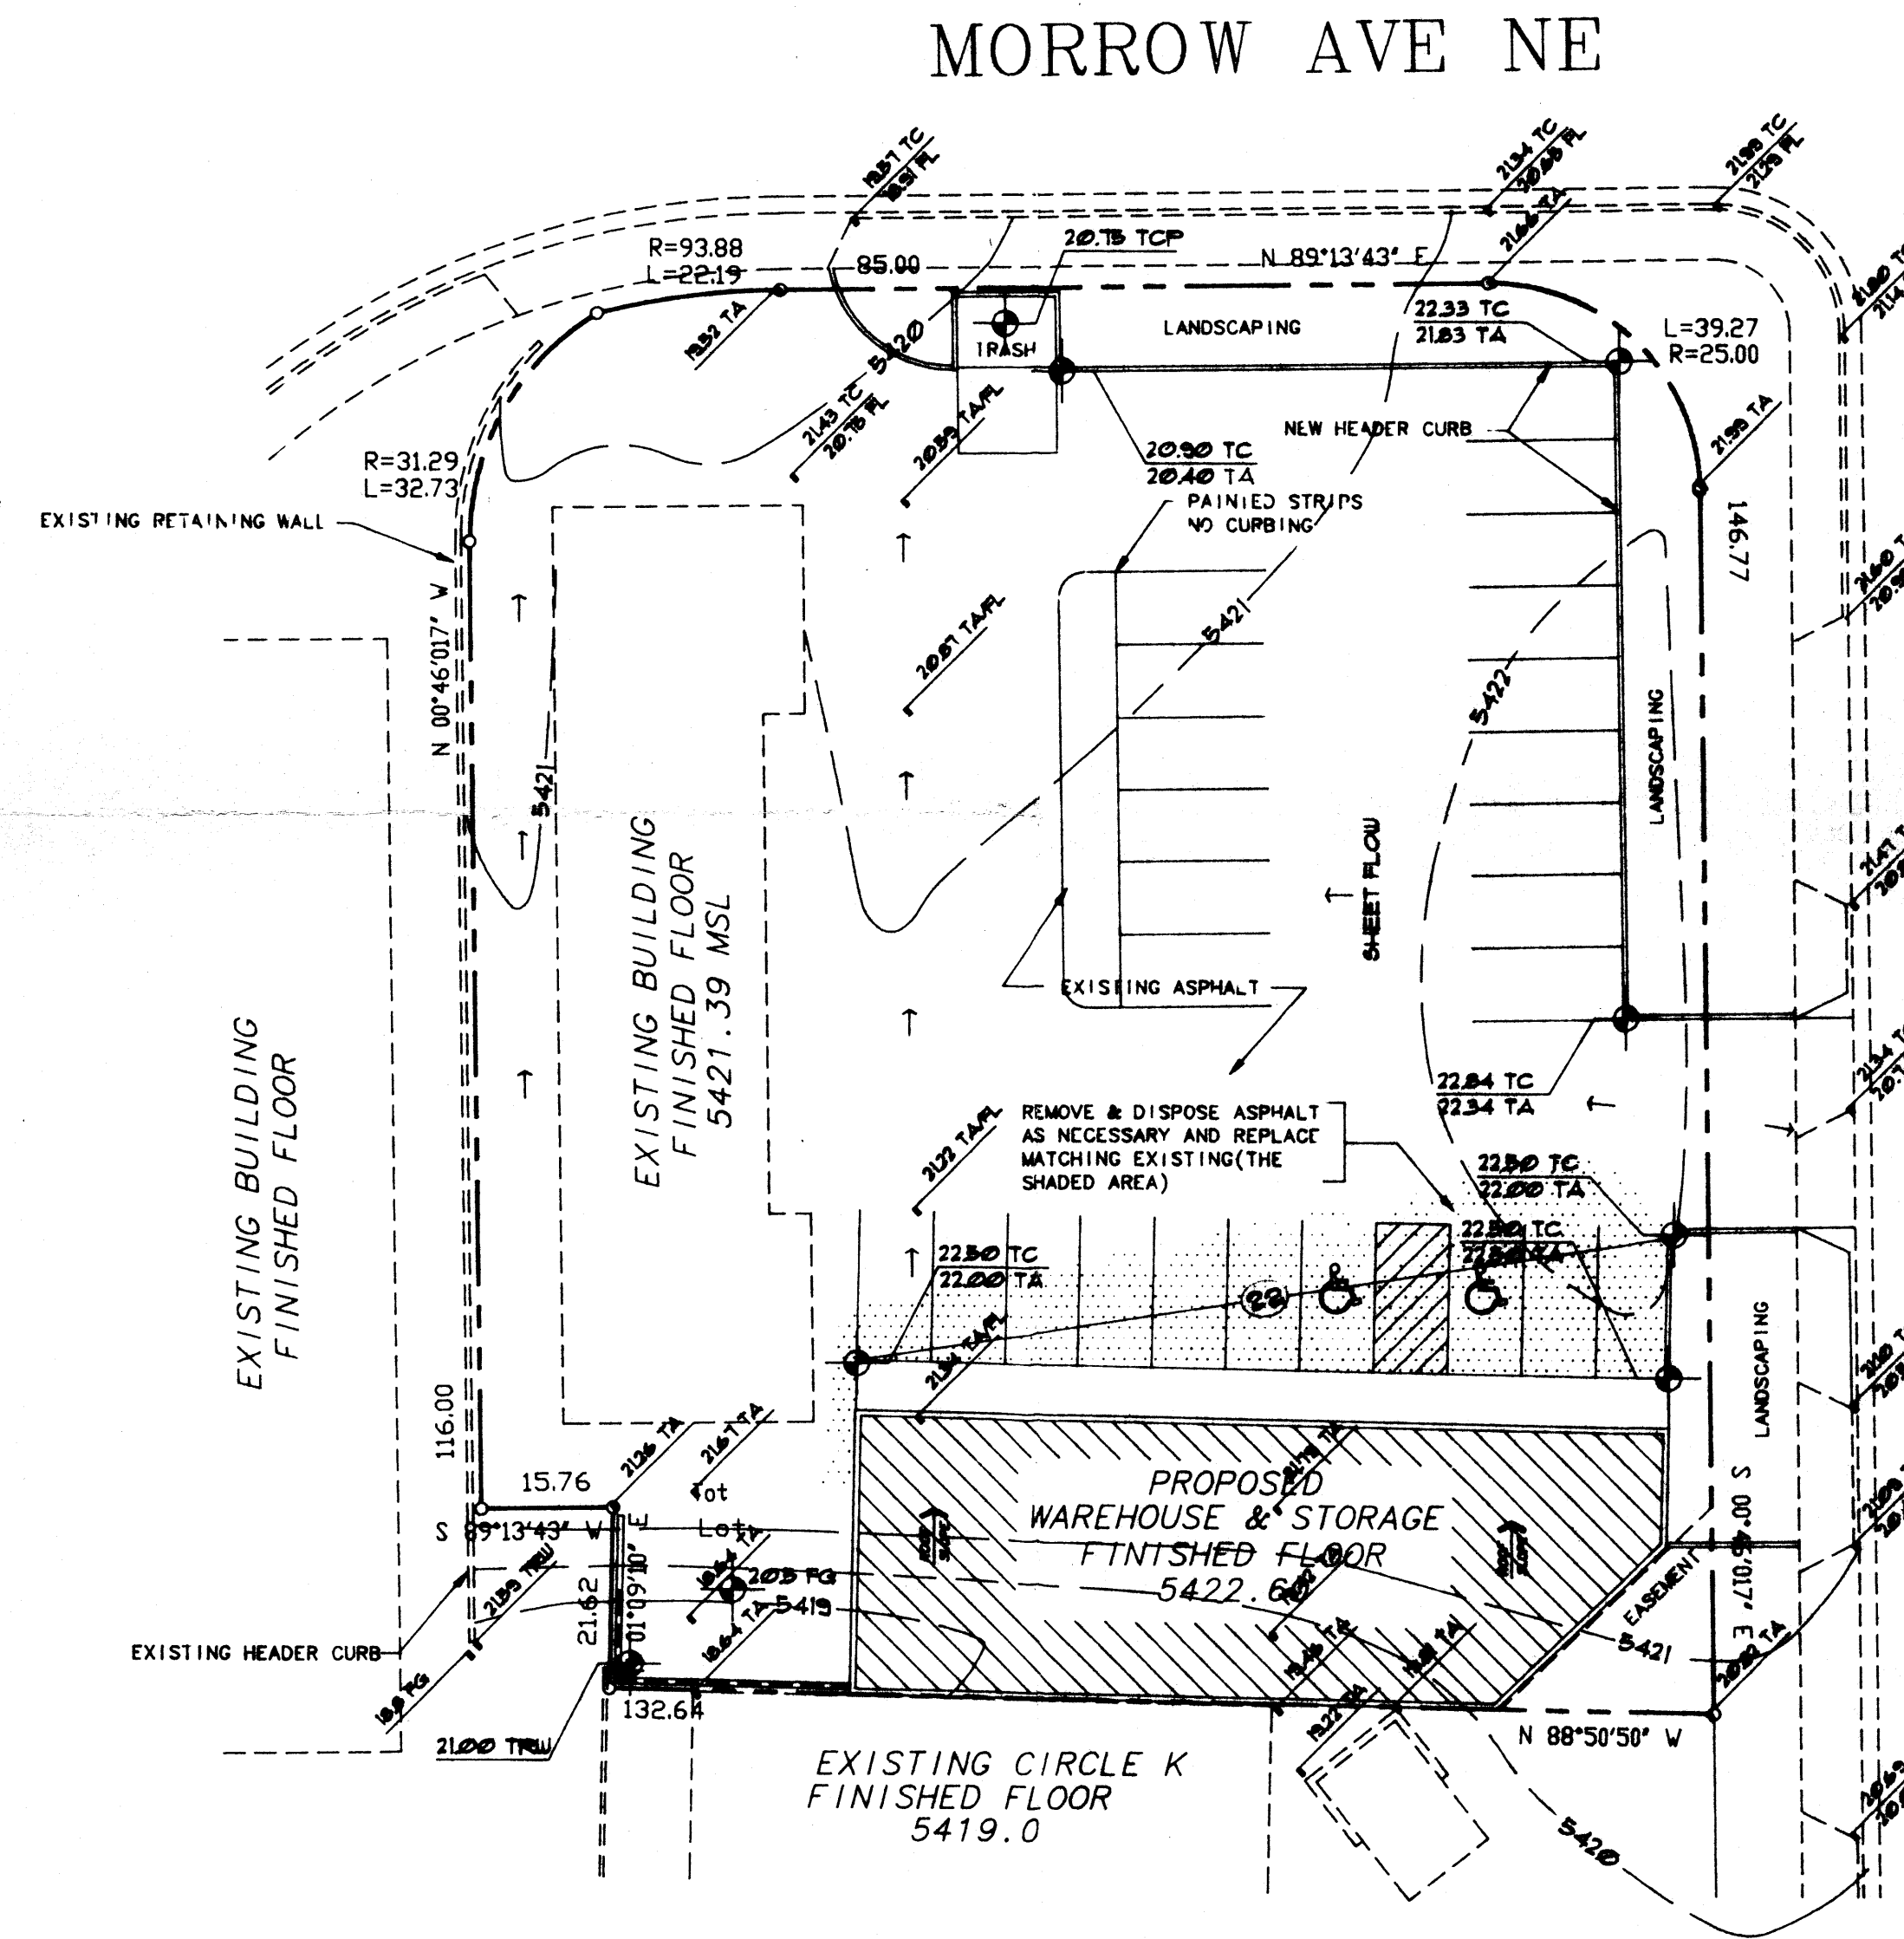


SYMBOL LEGEND


- EXISTING CONTOUR ——— 5102
- PROPOSED CONTOUR ——— (E2)
- ASBUILT SPOT ELEVATION ——— 66.50 TC
- PROPERTY LINE ———
- EASEMENT LINE ———
- FLOW DIRECTION ———
- EXISTING SPOT ELEVATION ———
- NEW RETAINING WALL ———

ABBREVIATION LEGEND

- TOP OF CONC PAD — TCP
- TOP OF CURB — TC
- TOP OF ASPHALT — TA
- FINISHED GRADE — FG
- FLOWLINE — FL
- TOP OF RET WALL — TRW

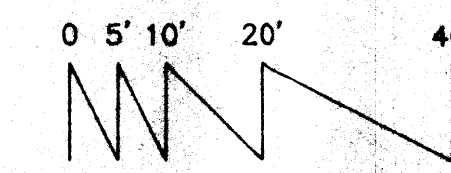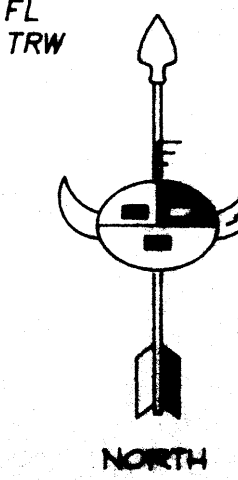

GRADING & DRAINAGE PLAN SCALE: 1"=20.0'

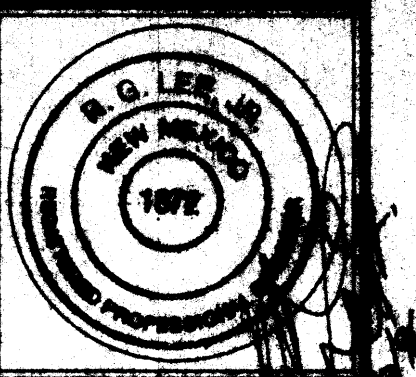

Job Number 9624
Date April 15, 1986
Revised


Sheet Title
GRADING & DRAINAGE PLAN
 Drawn by HMOOD
 Checked by NS LEE, JR.

MILLER and ASSOCIATES
 2505 Richmond, N.E.
 ALBUQUERQUE, NEW MEXICO

PROPOSED OFFICE BUILDING
 FOR
RON WORLEY

Job Title
C1

APR 30 1986

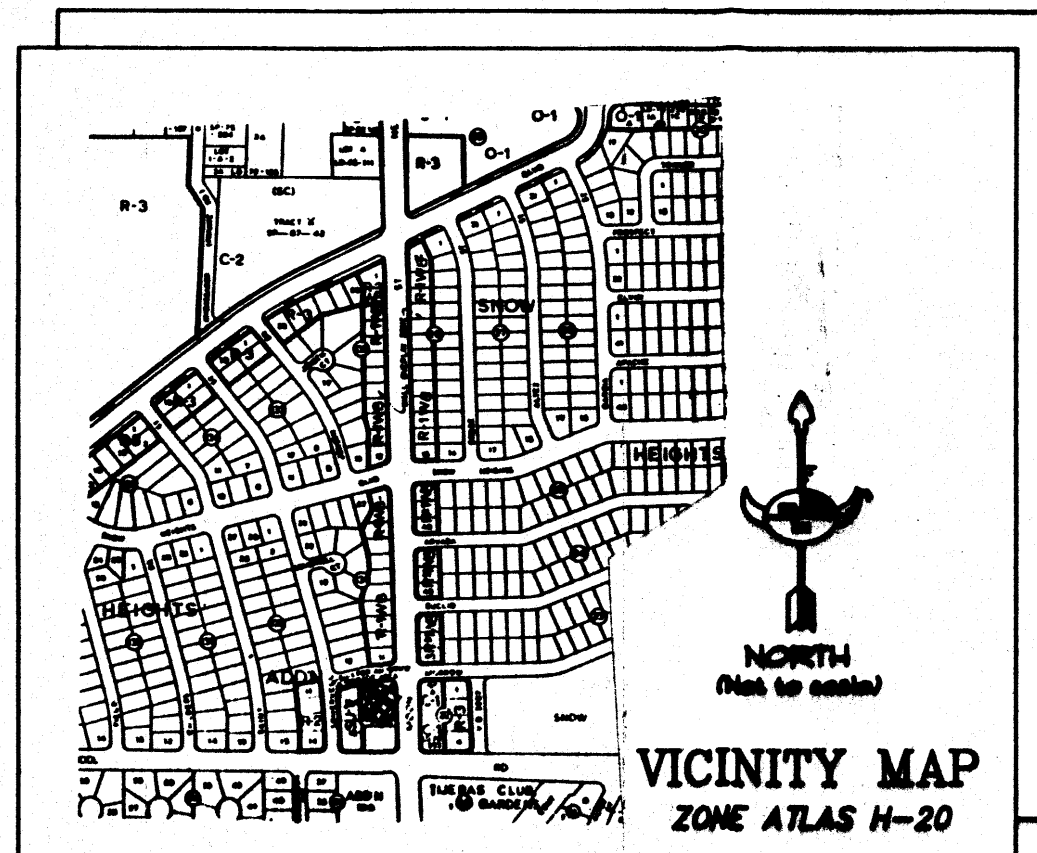

LEGAL DESCRIPTION

TRACK B-1, BLOCK 130
SNOW HEIGHTS ADDITION
ALBUQUERQUE, BERNALILLO COUNTY,
NEW MEXICO.

GENERAL NOTES:

1. An excavation/construction permit will be required before beginning any work within the City right-of-way. Approved copy of this plan must be submitted at the time of application for permit.
2. All work detailed in this plan to be performed, except as otherwise stated or provided hereon, shall be constructed in accordance with City of Albuquerque Interim Standard Specification for Public Works Construction 1985.
3. Two working days prior to any excavation, contractor must contact line locating Services at (505) 260-1980 for locating existing utilities.
4. Prior to construction, the contractor shall excavate and verify the horizontal and vertical location of all construction. Should a conflict exist, the contractor shall notify the engineer so that the conflict can be resolved with a minimum amount of delay.
5. Backfill compaction shall be according to residential street use.
6. All work on this project shall be performed in accordance with applicable Federal, State and local laws, rules and regulations concerning construction safety and health.

EROSION CONTROL MEASURES:

THE CONTRACTOR SHALL BE HELD RESPONSIBLE FOR MANAGEMENT OF STORM RUNOFF DURING CONSTRUCTION; HE SHALL INSURE THAT THE FOLLOWING MEASURES ARE TAKEN:
 - ADJACENT PROPERTY SHALL BE PROTECTED AT ALL TIMES BY CONSTRUCTION OF BERMS, DIKES, SWALES, PONDS AND OTHER TEMPORARY GRADING AS REQUIRED TO PREVENT STORM RUNOFF TO LEAVE THE SITE AND ENTERING ADJACENT PROPERTY.
 - ADJACENT PUBLIC RIGHT-OF-WAYS SHALL BE PROTECTED AT ALL TIMES FROM STORM WATER RUNOFF FROM THE SITE. NO SEDIMENT BEARING WATER SHALL BE PERMITTED TO ENTER THE PUBLIC STREETS.
 - THE CONTRACTOR SHALL IMMEDIATELY AND THOROUGHLY REMOVE ANY OR ALL SEDIMENT WITHIN THE PUBLIC STREETS THAT HAVE BEEN ERODED FROM THE SITE AND DEPOSITED THERE.

BENCH-MARK INFORMATION

TEMPORARY BENCH-MARK BEING THE FINISH FLOOR ELEVATION OF EXISTING BUILDING BEARING ELEVATION 5421.39 MSL REFERENCE TO CITY BENCH-MARK 9-H20, LOCATED AT THE OF MOON & INDAIN SCHOOL BEARS ELEVATION 5419.28(MSL).

DRAINAGE CALCULATIONS

I. REFERENCES:

- A. SECTION 22.2, HYDROLOGY OF THE DEVELOPMENT PROCESS MANUAL, VOLUME 2, DESIGN CRITERIA FOR THE CITY OF ALBUQUERQUE, NEW MEXICO IN COOPERATION WITH BERNALILLO COUNTY, NEW MEXICO AND THE ALBUQUERQUE METROPOLITAN ARROYO FLOOD CONTROL AUTHORITY.
- B. FLOODWAY, FLOOD BOUNDARY AND FLOODWAY MAP, CITY OF ALBUQUERQUE, NEW MEXICO, PANEL 24 OF 50.
- C. ZONE ATLAS PAGE H-20-Z.

II. GENERAL INFORMATION:

- A. SITE LIES IN ZONE THREE(3) (SEE REF. A, PAGE A-1)
- B. 100 YEAR, 6 HOUR RAINFALL CRITERIA
- C. TIME OF CONCENTRATION, Tc; Tc = 0.2 hr(12 MINUTES).

III. IMPERVIOUSNESS:

TREATMENT TYPE	TYPES OF SURFACES	EXISTING SQ. FT.	EXISTING ACRES	PROPOSED SQ. FT.	PROPOSED ACRES
A	UNDEVELOPED	0	0.0000	0	0.0000
B	LANDSCAPING	0	0.0000	5,530	0.1270
C	COMPACTED/VACANT	0	0.0000	0	0.0000
D	IMPERVIOUS	24,356	0.5591	18,826	0.4322
TOTAL AREA (TA)		24,356	0.5591	24,356	0.5591

IV. PEAK DISCHARGE 100 YEAR (REF. A, TABLE A-9):

TREATMENT TYPE	TYPES OF SURFACES	EXISTING CFS/Ac	EXISTING Qp(100)	PROPOSED CFS/Ac	PROPOSED Qp(100)
A	UNDEVELOPED	1.87	0.00	1.87	0.00
B	LANDSCAPING	2.80	0.00	2.80	0.33
C	COMPACTED/VACANT	3.45	0.00	3.45	0.00
D	IMPERVIOUS	5.02	2.81	5.02	2.17
PEAK DISCHARGE FROM SITE		2.81 CFS		2.50 CFS	

V. PEAK DISCHARGE 10 YEAR (REF. A, TABLE A-9):

TREATMENT TYPE	TYPES OF SURFACES	EXISTING CFS/Ac	EXISTING Qp(10)	PROPOSED CFS/Ac	PROPOSED Qp(10)
A	UNDEVELOPED	0.58	0.00	0.58	0.00
B	LANDSCAPING	1.19	0.00	1.19	0.15
C	COMPACTED/VACANT	2.00	0.00	2.00	0.00
D	IMPERVIOUS	3.39	1.90	3.39	1.47
PEAK DISCHARGE FROM SITE		1.90 CFS		1.82 CFS	

VI. WEIGHTED "E" 100 YEAR, 6 HR. (REF. A, TABLE A-8):

TREATMENT TYPE	TYPES OF SURFACES	EXISTING E	EXISTING ExA/TA	PROPOSED E	PROPOSED ExA/TA
A	UNDEVELOPED	0.66	0.00	0.66	0.00
B	LANDSCAPING	0.92	0.00	0.92	0.21
C	COMPACTED/VACANT	1.29	0.00	1.29	0.00
D	IMPERVIOUS	2.36	2.36	2.36	1.82
WEIGHTED "E" FACTOR		2.36 IN		2.03 IN	

VII. VOLUME 100 YEAR, V(360) (REF. A, TABLE A-8):


EXISTING	2.36 x 0.5591/12 =	0.1100 AC. FT.
	=	4,790 CU. FT.
PROPOSED	2.03 x 0.5591/12 =	0.0947 AC. FT.
	=	4,126 CU. FT.

SYMBOL LEGEND

- EXISTING CONTOUR ----- 5102
- PROPOSED CONTOUR ----- 52
- ASBUILT SPOT ELEVATION 6630 TC
- PROPERTY LINE -----
- EASEMENT LINE -----
- FLOW DIRECTION ←
- EXISTING SPOT ELEVATION
- NEW RETAINING WALL

ABBREVIATION LEGEND

- TOP OF CONC PAD - TCP
- TOP OF CURB - TC
- TOP OF ASPHALT - TA
- FINISHED GRADE - FG
- FLOWLINE - FL
- TOP OF RET WALL - TRW

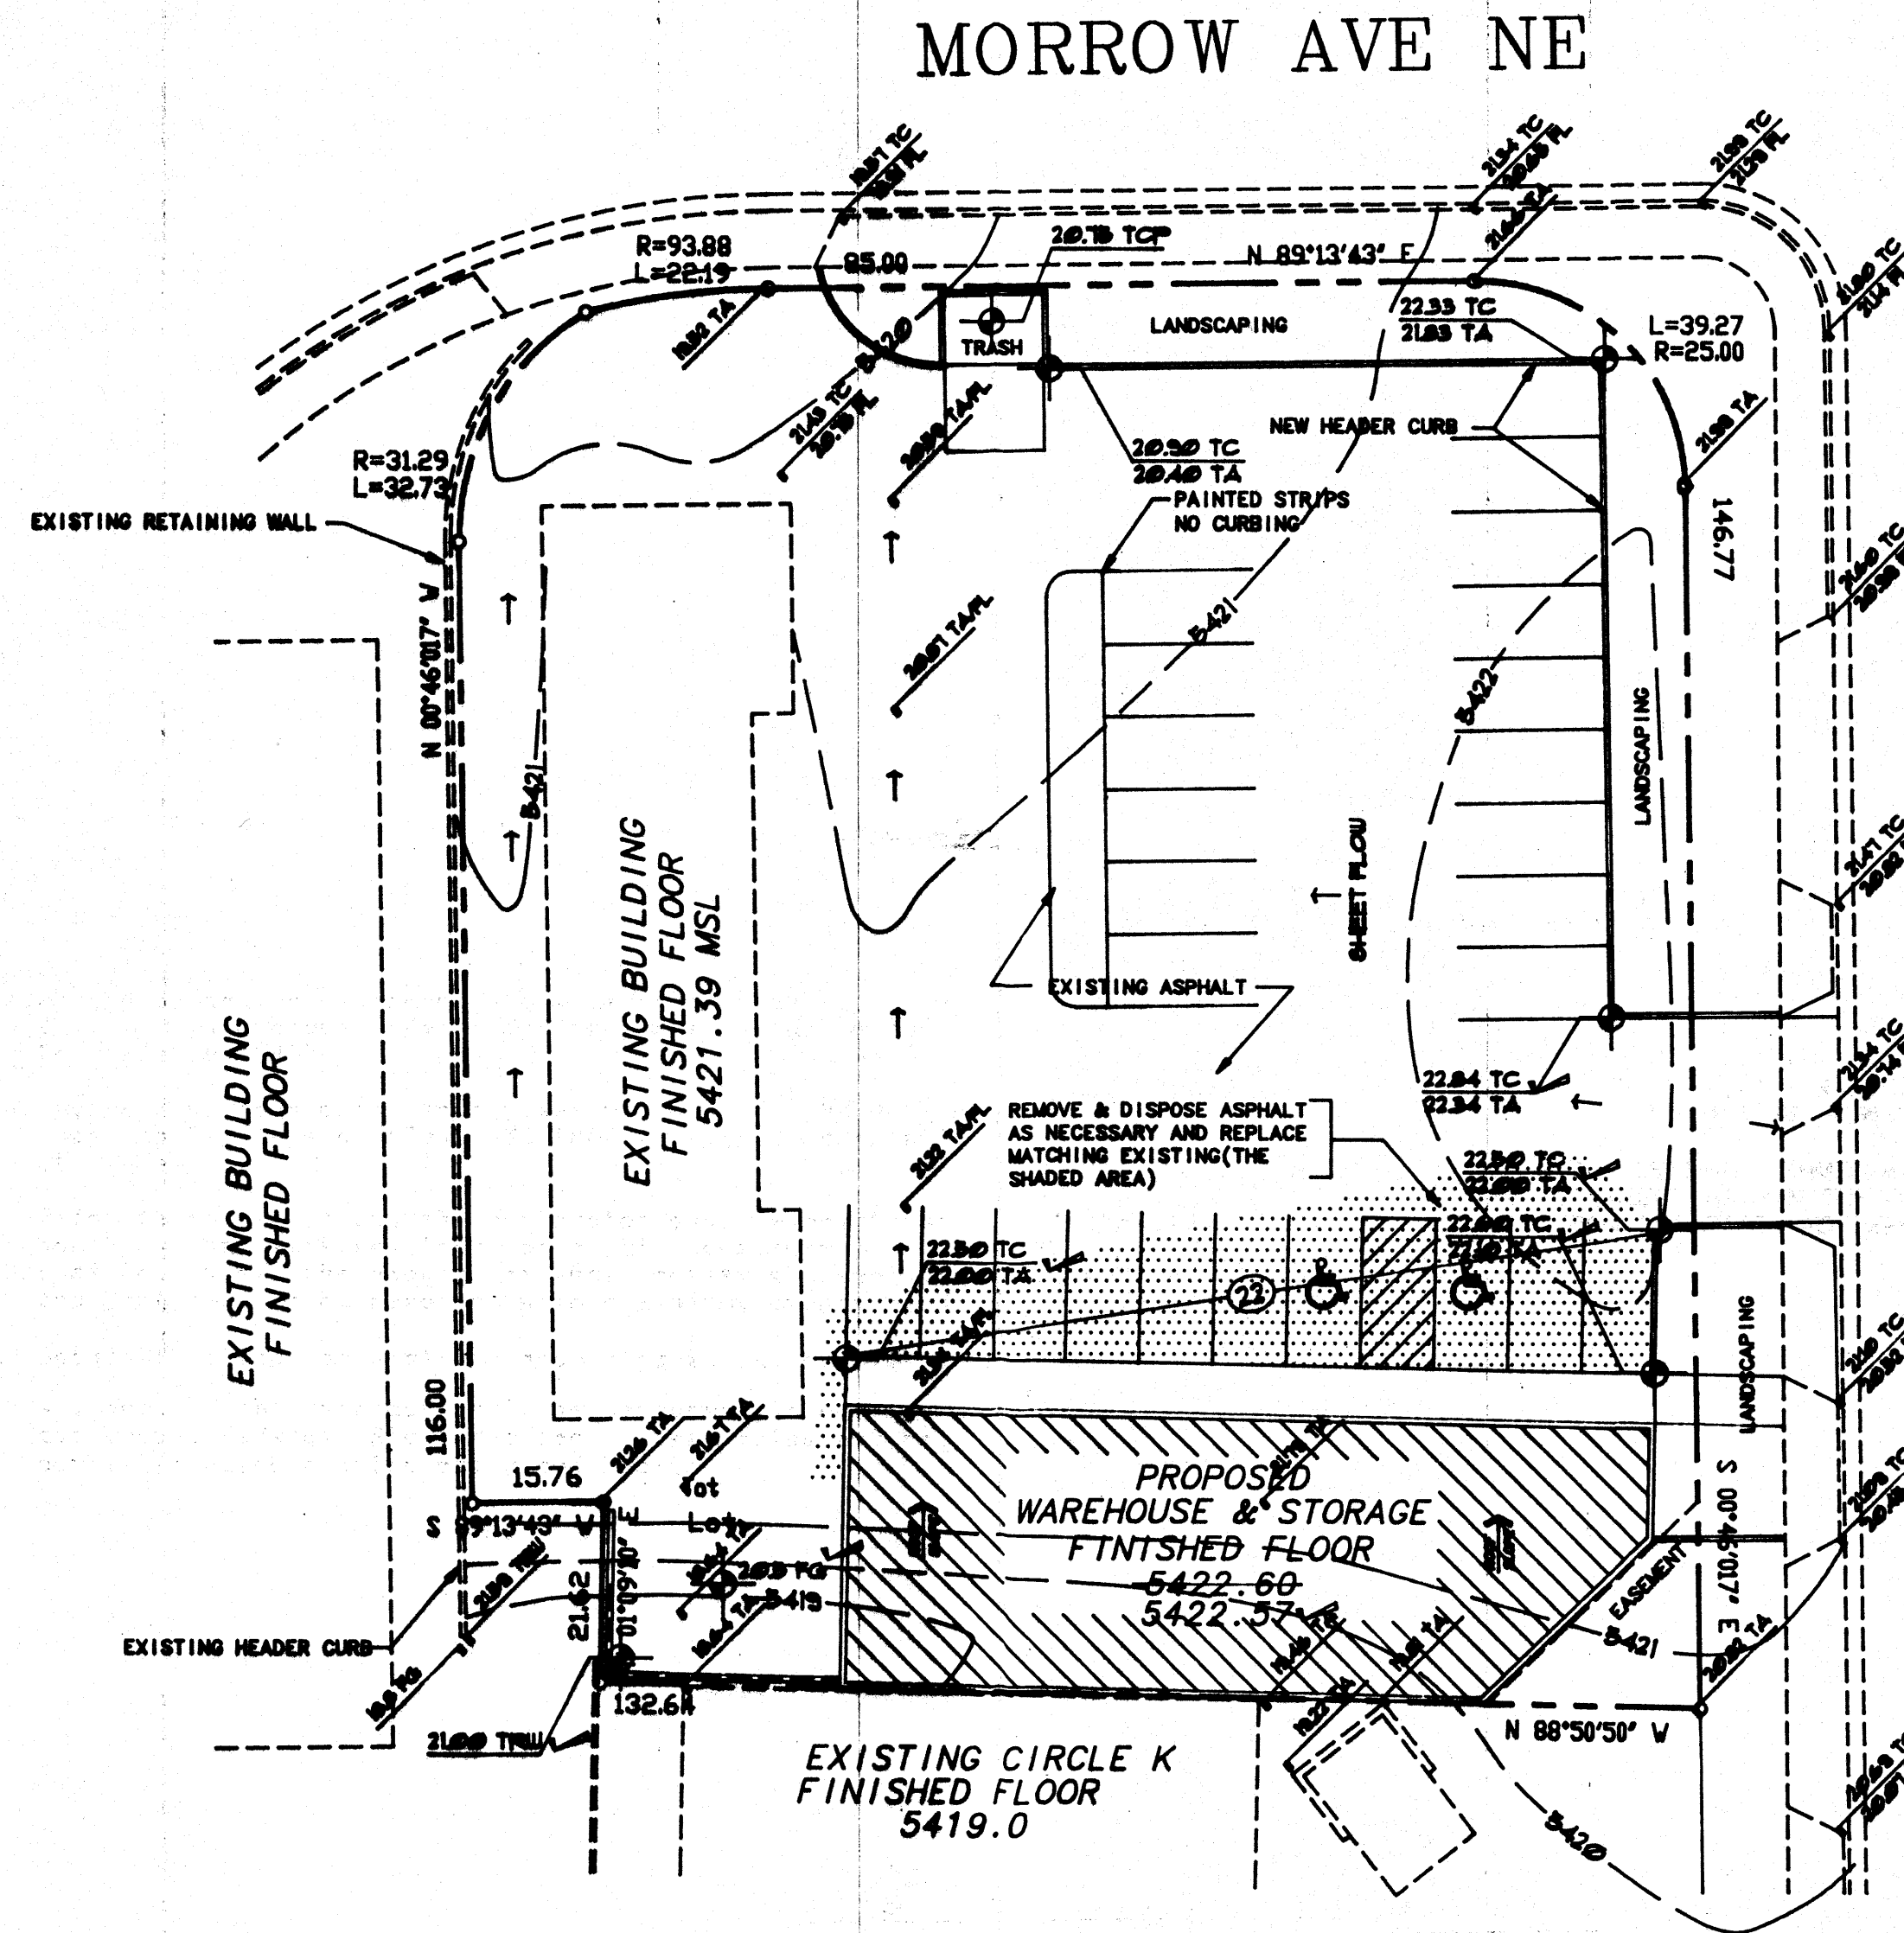





CERTIFICATION

I, R.G. Lee, Jr., Registered Professional Engineer hereby certify the improvements shown hereon are in substantial compliance with the approved drainage plan.

R.G. Lee, Jr.
R.G. LEE, JR.

[Signature]
Date

AS-BUILT
GRADING & DRAINAGE PLAN SCALE: 1"=20.0'

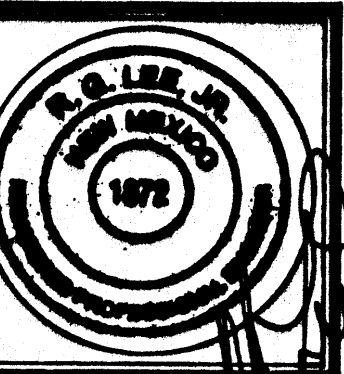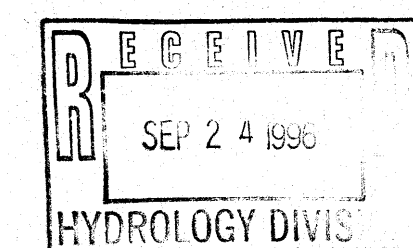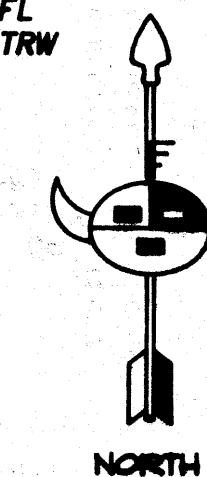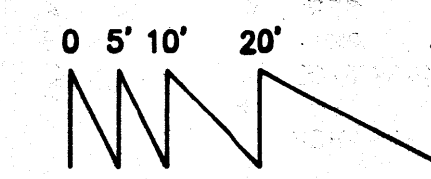

Job Number 9624
Date April 19, 1986
Revised SEPTEMBER 23, 1986

GRADING & DRAINAGE PLAN
Checked by R.G. LEE, JR.
Drawn by MUCCO

MILLER and ASSOCIATES
3000 North Central Ave. N.E.
ALBUQUERQUE, NEW MEXICO

PROPOSED OFFICE BUILDING FOR ROB. WORLEY

Job Title