
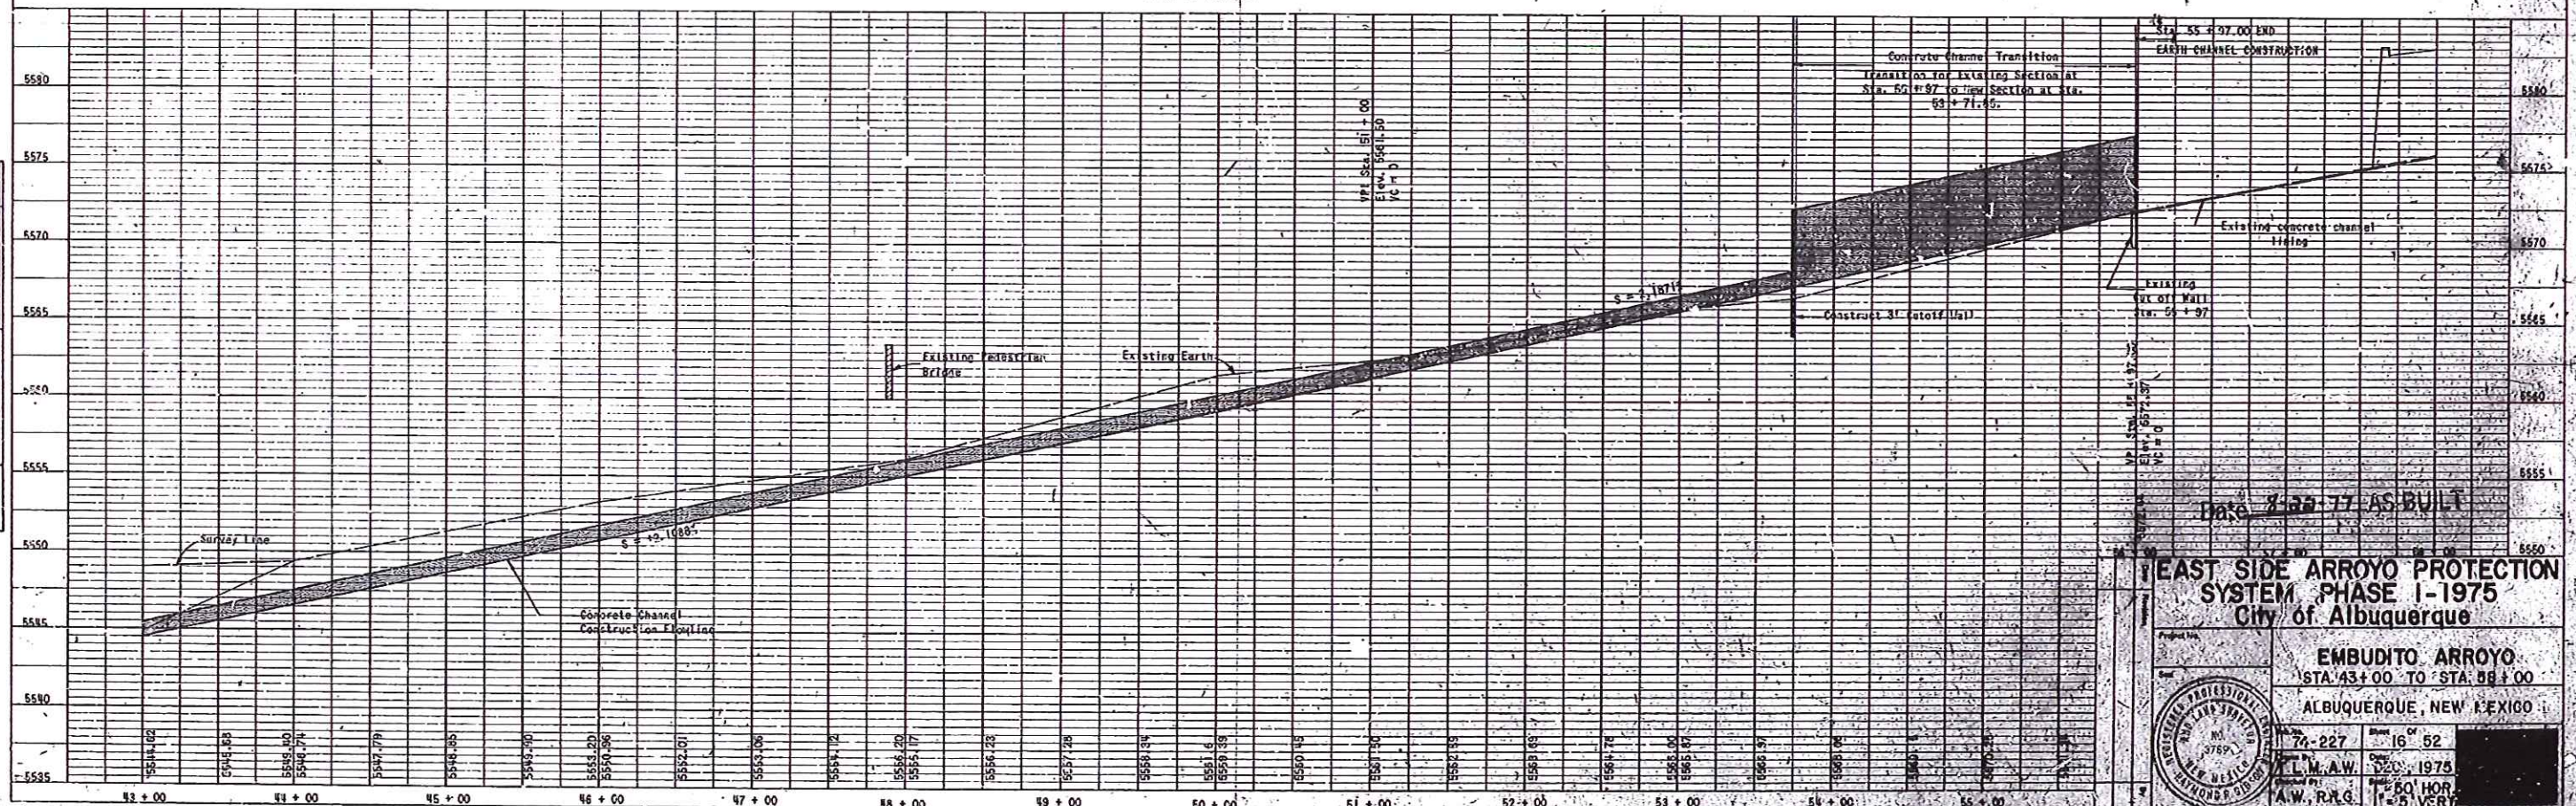


PLAN	DATE
SURVEYED	BY
PLOTTED	BY
NOTE BOOK	NO.
REVISIONS	

PROFILE	DATE
SURVEYED	BY
PLOTTED	BY
NOTE BOOK	NO.
REVISIONS	

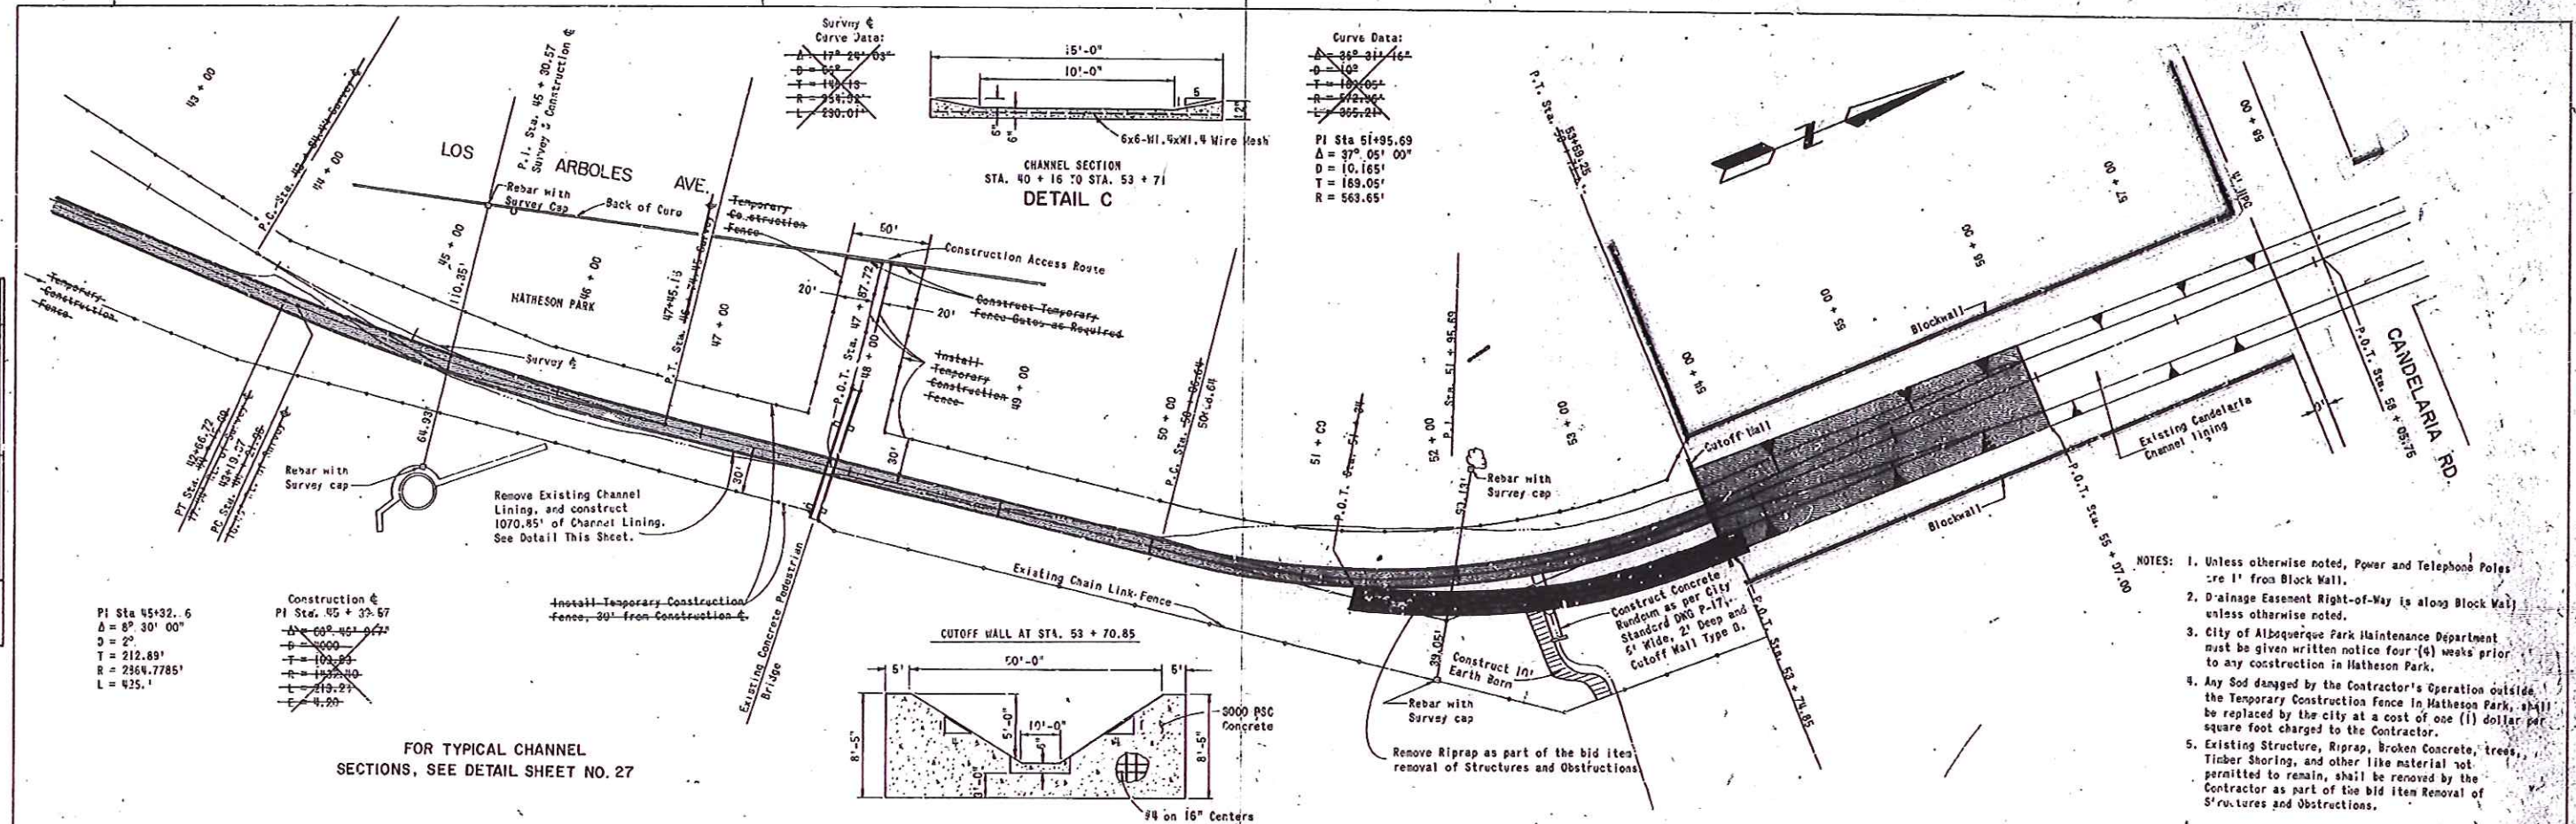

- NOTES:
1. Unless otherwise noted, Power and Telephone Poles are 1' from Block Wall.
 2. Drainage Easement Right-of-Way is along Block Wall unless otherwise noted.
 3. City of Albuquerque Park Maintenance Department must be given written notice four (4) weeks prior to any construction in HATHESON PARK.
 4. Any Sod damaged by the Contractor's Operation outside the Temporary Construction Fence in HATHESON PARK, shall be replaced by the city at a cost of one (1) dollar per square foot charged to the Contractor.
 5. Existing Structure, Riprap, Broken Concrete, trees, Timber Shoring, and other like material not permitted to remain, shall be removed by the Contractor as part of the bid item Removal of Structures and Obstructions.

Date: 2-22-77 AS BUILT



EAST SIDE ARROYO PROTECTION SYSTEM PHASE I-1975
City of Albuquerque

EMBUDITO ARROYO
STA. 43+00 TO STA. 57+00
ALBUQUERQUE, NEW MEXICO

Project No. 74-227
Sheet 16 of 52
Date: 2-22-77
By: L.W.A.W.
Checked: A.W.R.G.
Reviewed: J.S.V.B.

PLAN	SURVEYED	DATE
	GRADES CHECKED	BY
	NOTE BOOK	NO.
	RT. OF WAY CHECKED	


PROFILE	SURVEYED	DATE
	GRADES CHECKED	BY
	NOTE BOOK	NO.
	STRUCTURE NOTING CYNO	

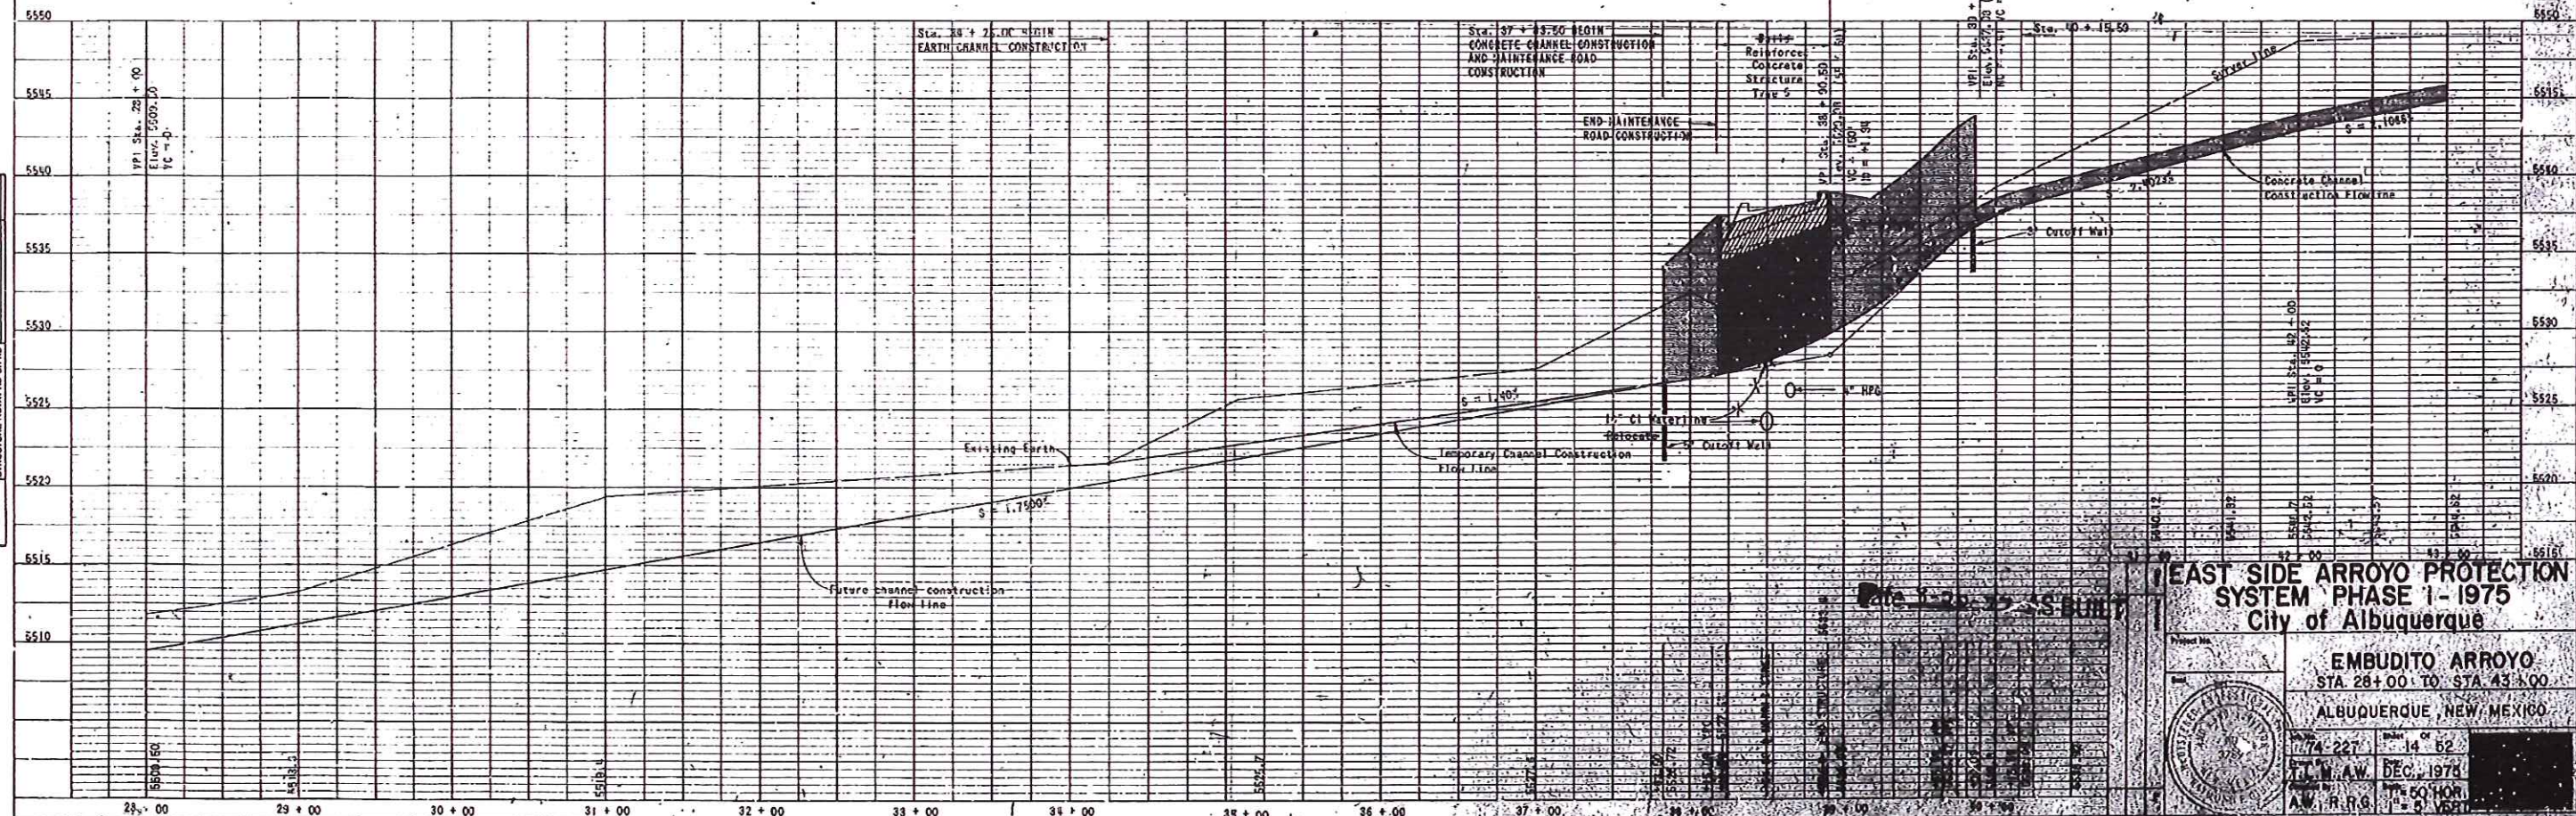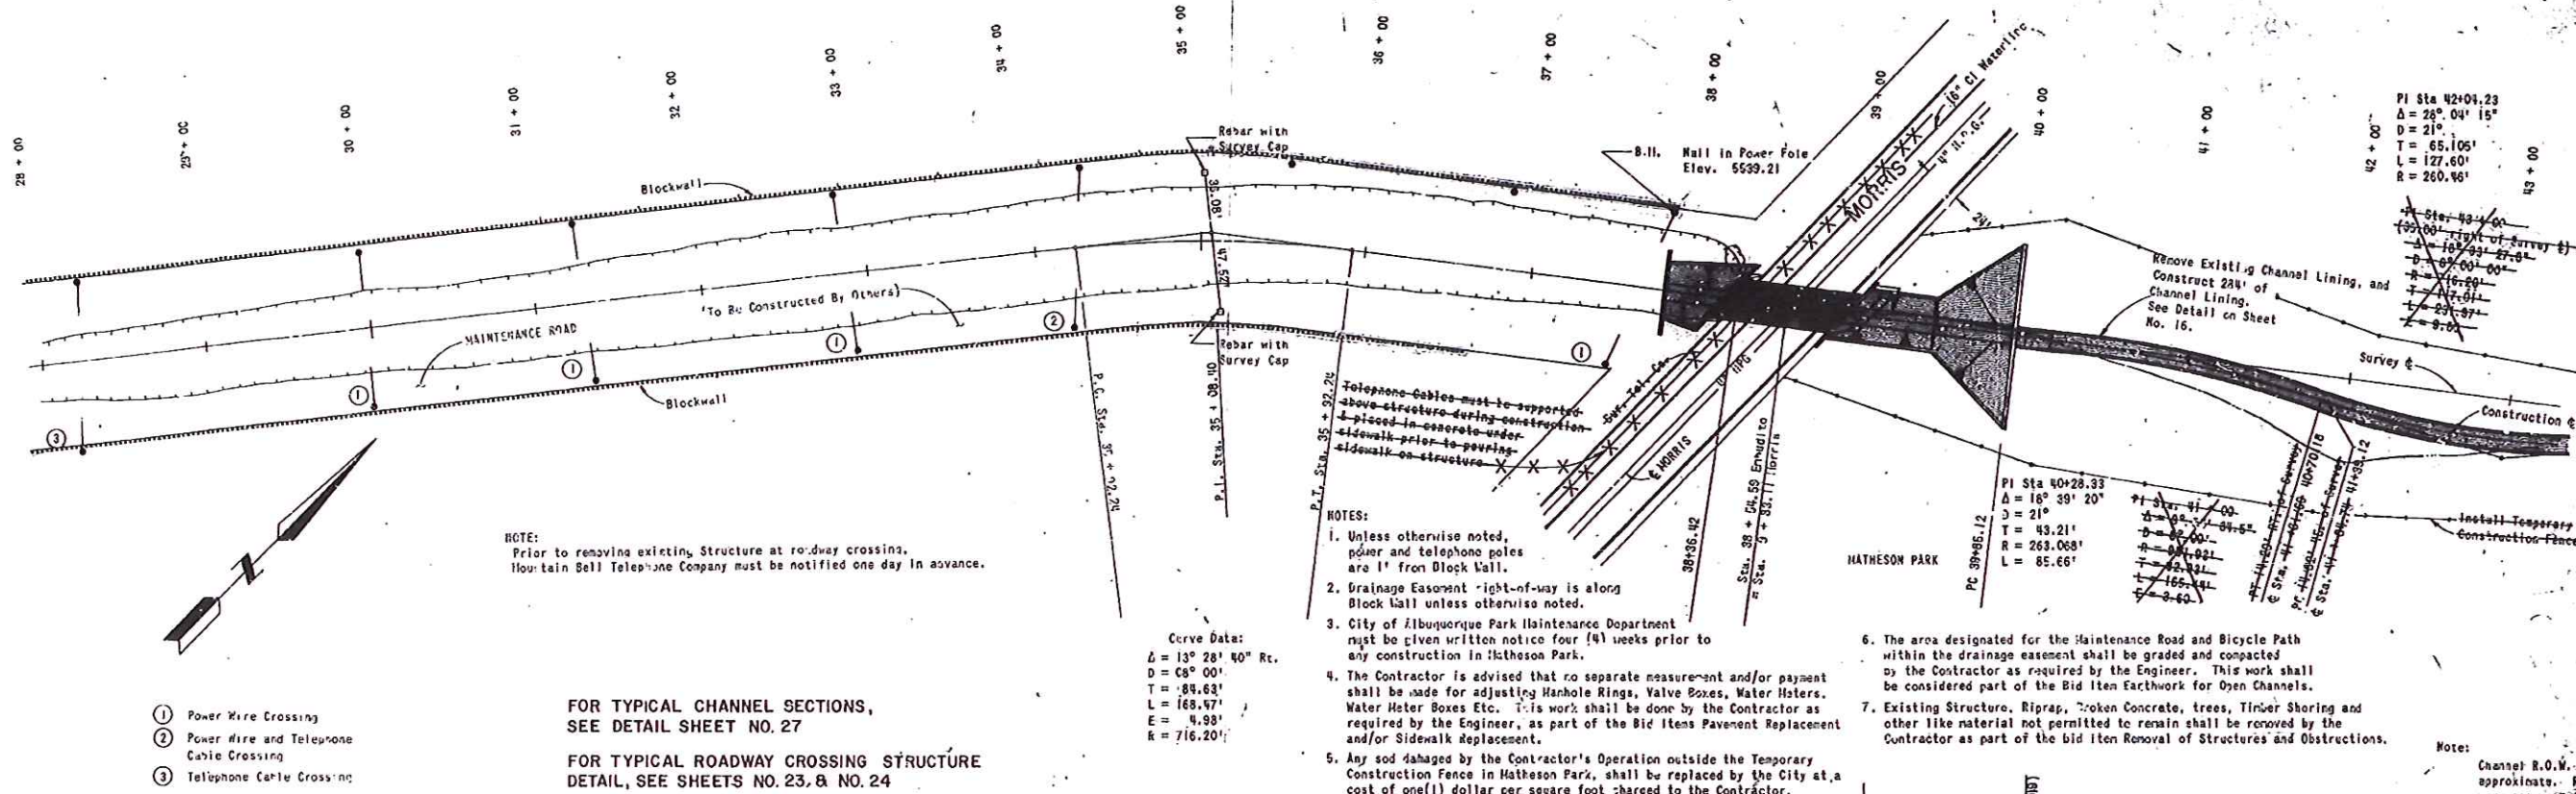

EAST SIDE ARROYO PROTECTION SYSTEM PHASE 1-1975	
City of Albuquerque	
Project No. EMBUDITO ARROYO	
Sta. 28+00 TO STA. 43+00	
ALBUQUERQUE, NEW MEXICO	
Drawn By 74-227	Check By 14-52
Design By DEC. 1975	Scale 1" = 50'
Author AW	Reviewer AW

PLAN	DATE	BY	REVISIONS
	NO.	NO.	NO.

PROFILE	DATE	BY	REVISIONS
	NO.	NO.	NO.

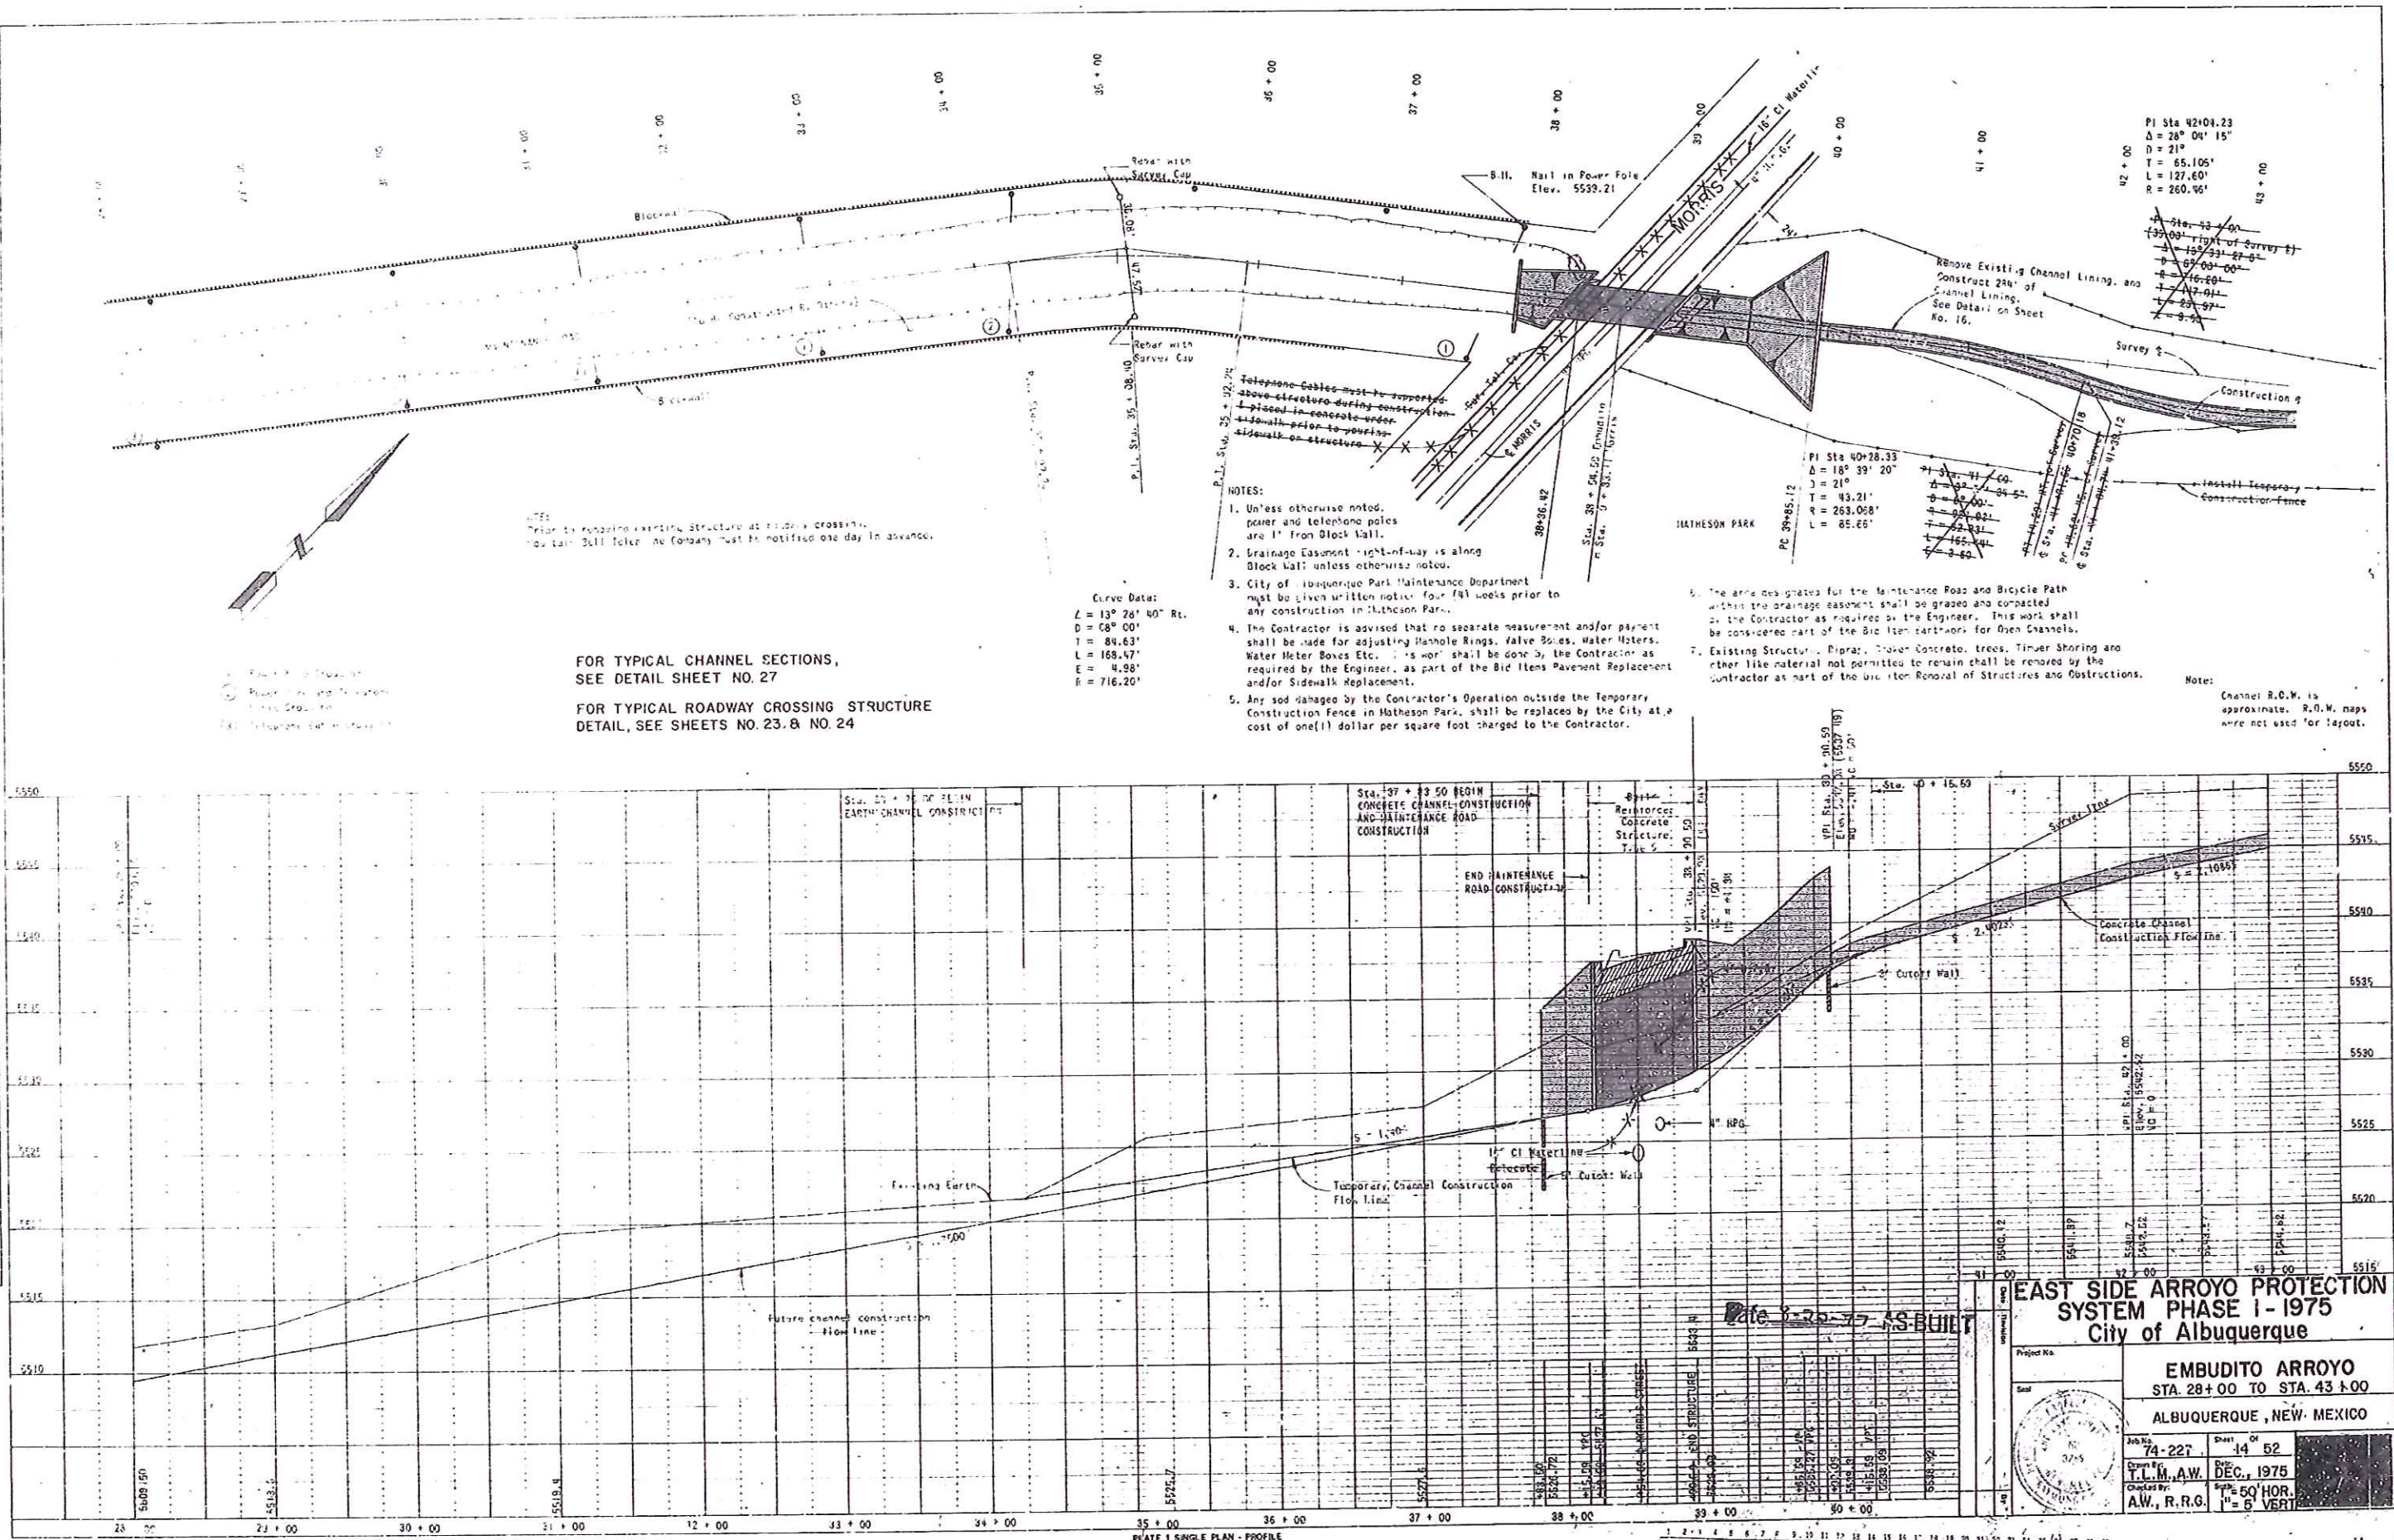

NOTES:
Prior to removing existing structure as shown on crossing, you shall call for the company must be notified one day in advance.

FOR TYPICAL CHANNEL SECTIONS,
SEE DETAIL SHEET NO. 27
FOR TYPICAL ROADWAY CROSSING STRUCTURE
DETAIL, SEE SHEETS NO. 23 & NO. 24

Curve Data:
L = 13° 28' 40" R.L.
D = 68° 00'
T = 84.63'
L = 168.47'
E = 4.98'
R = 716.20'

NOTES:

1. Unless otherwise noted, power and telephone poles are 1" from block wall.
2. Drainage easement right-of-way is along block wall unless otherwise noted.
3. City of Albuquerque Park Maintenance Department must be given written notice four (4) weeks prior to any construction in Matheson Park.
4. The Contractor is advised that no separate measurement and/or payment shall be made for adjusting Manhole Rings, Valve Boxes, Water Meters, Water Meter Boxes Etc. This work shall be done by the Contractor as required by the Engineer, as part of the Bid Items Pavement Replacement and/or Sidewalk Replacement.
5. Any sod damaged by the Contractor's Operation outside the Temporary Construction Fence in Matheson Park, shall be replaced by the City at a cost of one(1) dollar per square foot charged to the Contractor.

6. The area designated for the Maintenance Road and Bicycle Path within the drainage easement shall be graded and compacted by the Contractor as required by the Engineer. This work shall be considered part of the Bid Item earthwork for Open Channels.
7. Existing Structures, Piers, Timber Shoring and other like material not permitted to remain shall be removed by the Contractor as part of the Bid Item Removal of Structures and Obstructions.

Note:
Channel R.O.W. is approximate. R.O.W. maps were not used for layout.

PI Sta 42+04.23
Δ = 28° 04' 15"
D = 21°
T = 65.105'
L = 127.60'
R = 260.96'

PI Sta 40+28.33
Δ = 18° 39' 20"
D = 21°
T = 43.21'
L = 263.058'
R = 85.66'

EAST SIDE ARROYO PROTECTION SYSTEM PHASE I-1975 City of Albuquerque	
EMBUDITO ARROYO STA. 28+00 TO STA. 43+00 ALBUQUERQUE, NEW MEXICO	
Project No.	74-227
Sheet No.	14 52
Drawn By	T.L.M.A.W.
Checked By	A.W., R.R.G.
Date	DEC. 1975
Scale	1" = 50' HOR. 1" = 6' VERT

0.8 0.04 11.47 10 59214