CITY OF ALBUQUERQUE



January 6, 2020

Morey E. Walker, PE Walker Engineering 905 Camino Sierra Vista Santa Fe, NM 87505

Re: Blake's Lotaburger

1801 Juan Tabo Blvd. NE

Request Temporary C.O. - Accepted

Engineer's Stamp dated: 5-9-19 (H21D012)

Certification dated: 1-6-20

Dear Mr. Goodwin,

Based on the Certification received 1/3/2020, Hydrology has no objection to the issuance of a Temporary Certification of Occupancy based solely on the Hydrology Certification received from Morey Walker, PE. This letter serves as a "green tag" from Hydrology for a Temporary Certificate of Occupancy to be issued by the Building and Safety Division.

PO Box 1293

Prior to the issuance of a permanent Certificate of Occupancy, the Hydrology Department must receive a complete acceptable submittal package from the applicant. An inspection of the site must be conducted by the City of Albuquerque Hydrology Department with all site improvements in compliance with all City of Albuquerque Standards.

Albuquerque

If you have any questions, you can contact me at 924-3995 or Totten Elliott at 924-3982.

NM 87103

Sincerely,

www.cabq.gov

Renée C. Brissette, P.E. CFM Senior Engineer, Hydrology

Renée C. Brusselo

Planning Department

TE/RB

C: email Michelle Costilla; Fox, Debi; Tena, Victoria C.; Sandoval, Darlene M.

STAKING NOTE

INFORMATION SHOWN IS FOR GRADING AND DRAINAGE ONLY AND IS NOT TO BE USED FOR STAKING PURPOSES. SEE SITE PLAN FOR ACTUAL LOCATION OF IMPROVEMENTS.

TOPOGRAPHY NOTE


ALL EXISTING TOPOGRAPHIC SURVEY DATA SHOWN ON THESE PLANS HAS BEEN OBTAINED AND CERTIFIED BY OTHERS. WALKER ENGINEERING HAS UNDERTAKEN NO FIELD VERIFICATION OF THIS TOPOGRAPHY INFORMATION, AND MAKES NO REPRESENTATION PERTAINING THERETO, AND ASSUMES NO RESPONSIBILITY OR LIABILITY THEREFOR OF THIS TOPOGRAPHY. WALKER ENGINEERING RESPONSIBILITY IS LIMITED TO THE ENGINEERING ANALYSIS THAT UTILIZES THE TOPOGRAPHY SURVEY.

LEGAL DESCRIPTION


LOT 1-A, BLOCK 96 SNOW HEIGHTS
ALBUQUERQUE, BERNALILLO COUNTY, NEW MEXICO,
ACCORDING TO REPLAT OF BLOCKS 94 AND 95 THE
NORTHEASTERLY PORTIONS OF BLOCK 96 AND THE EASTERLY
PORTIONS OF BLOCKS 89,91,92 AND 93 OF SNOW HEIGHTS
FILED: AUGUST 26, 1958, VOLUME C4, FOLIO 17


FLOOD PLAIN NOTE

FIRM MAP: 35001C0357H EFFECTIVE DATE:8/16/2012 ZONE X

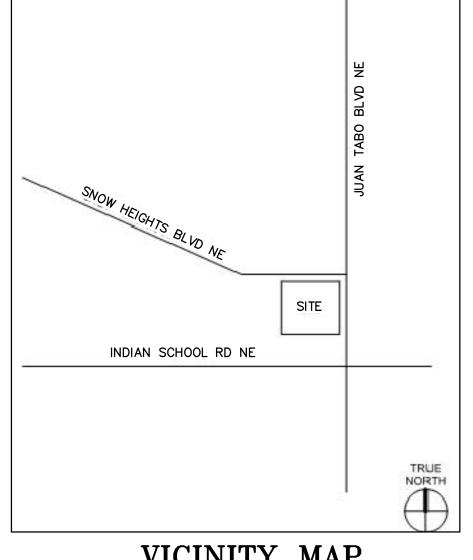

VICINITY MAP

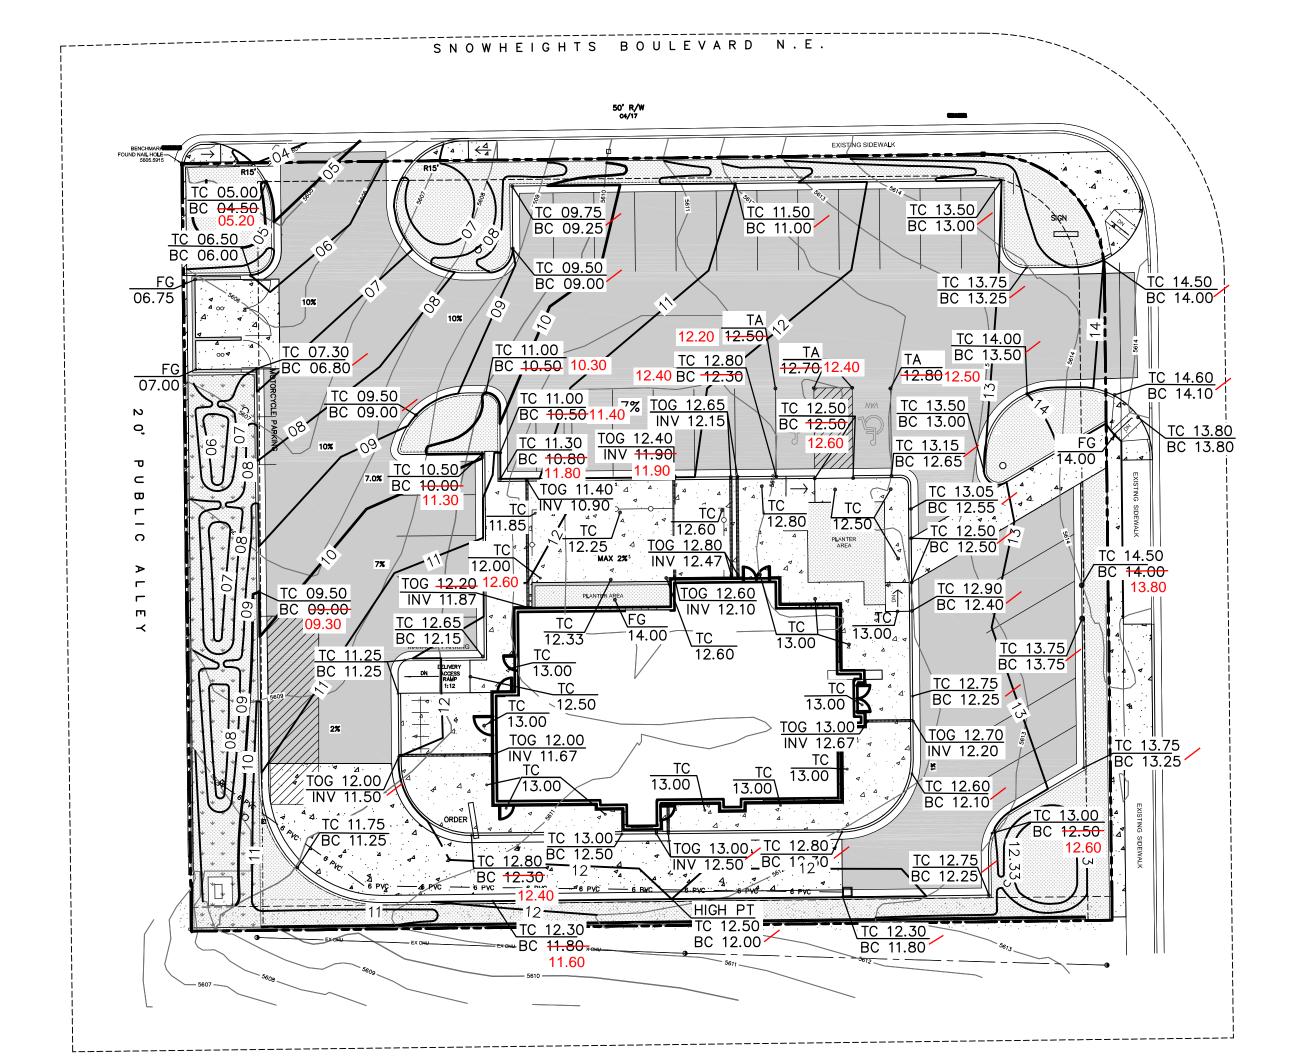

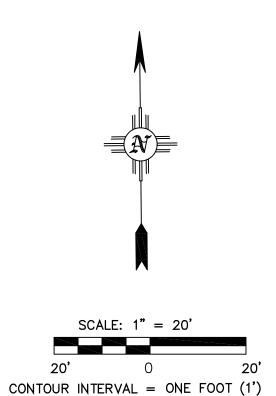

RECORD DRAWINGS

THIS RECORD DOCUMENT HAS BEEN PREPARED BASED ON THE BEST AVAILABLE INFORMATION AS PROVIDED BY OTHERS. WALKER ENGINEERING CERTIFIES THAT THE INFORMATION SHOWN IS A REASONABLE DOCUMEN ATION OF THE FINAL CONSTRUCTION.

MOREY E. WALKER,

P.E. 12105

O DATE


Civil Engineering • Water Resource PPROVE
Traffic Engineering

W• E

Walker Engineer inspects

905 Camino Sierra Vista
Santa Fe, NM 87505

505-820-7990 FAX 505-820-3539 E-MAIL civil@walkerengineering.net

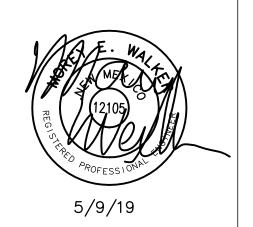

BLAKE'S
LOTABURGER #64
1801 JUAN TABO BLVD. NE
ALRIGHFROUF NM 87112

LEGEND

EXISTING CONTOURS

DESIGN CONTOURS

SITE BOUNDARY

PROPOSED SPOT ELEVATION

FG FIELD GRADE

TA TOP OF ASPHALT

TC/BC TOP OF CURB/BOTTOM OF CURB

L/S LANDSCAPE AREA

WATER FLOW DIRECTION

FFE FINISHED PAD

NEW ASPHALT

NEW CONCRETE

ISSUE	D				
MARK	DATE		DESCRI	DESCRIPTION	
PROJEC	T NO.				
FI L E NA	ME				
DRAWN	N BY				
CHECK	ED BY				
Sheet	Name				
	GR	ΔΓ	ING	AND	
г					
L	JKA	.117,	AGE	PLAN	
Shee	t No.				
			C1A		
			J 1 / (