



# ***City of Albuquerque***

P.O. BOX 1293 ALBUQUERQUE, NEW MEXICO 87103

March 2, 1995

Larry L. Parker, P.E.  
Galloway, Romero & Assoc.  
14202 E. Evans Ave.  
Aurora, CO 80014

RE: ENGINEER'S CERTIFICATION FOR DIAMOND SHAMROCK #1240 (H22/D65)  
RECEIVED FEBRUARY 14, 1995 FOR CERTIFICATE OF OCCUPATION  
ENGINEER'S STAMP DATED 1-18-95

Dear Mr. Parker:

Based on the information included in the submittal referenced above, City Hydrology accepts the Engineer's Certification and releases the Certificate of Occupancy for this project at 12501 Menaul Blvd NE.

12521  
If I can be of further assistance, You may contact me at 768-2727.

Sincerely,

John P. Curtin, P.E.  
Civil Engineer/Hydrology

c: Andrew Garcia  
Doug Kirk, Nuckolls Construction, 12501 Menaul NE 87112



# City of Albuquerque

P.O. BOX 1293 ALBUQUERQUE, NEW MEXICO 87103

September 12, 1994

Larry L. Parker, P.E.  
Galloway, Romero & Assoc.  
14202 E. Evans Ave.  
Aurora, CO 80014

RE: DRAINAGE REPORT FOR DIAMOND SHAMROCK #1240 (H-22/D65)  
RECEIVED AUGUST 30, 1994 FOR BUILDING PERMIT APPROVAL  
ENGINEER'S STAMP DATED 8-2-94 REVISED 8/17/94

Dear Mr. Parker:

Based on the information included in the submittal referenced above, City Hydrology approves this project for Building Permit.

Include a copy of the approved Drainage Plan in the set of construction documents that will be submitted to the "one stop" for the Building Permit.

A separate permit is required for construction of private drainage facilities within the City Right-of-Way. A copy of this letter must be on hand when applying for the excavation permit.

Engineer's Certification of grading & drainage per DPM checklist must be approved before any Certificate of Occupancy will be released.

If you have any questions about this project, You may contact me at 768-2727.

Sincerely,

John P. Curtin, P.E.  
Civil Engineer/Hydrology

c: Andrew Garcia:  
Arlene Portillo  
Glen Bates; Kevin Georges & Assoc; 127-A Jefferson NE; 87108

WPHYD/8750/jpc

## **I. INTRODUCTION**

This report is being prepared for Diamond Shamrock, Inc., the owner/developer of the site, to fulfill the final drainage requirements of Albuquerque, New Mexico. The report analyzes offsite and onsite runoff from the minor, 10 year frequency, and major, 100 year frequency storms and routes these flows through the site.

The 0.9079 acre site is located in Section 10, Township 10 North, Range 4 East of the New Mexico Principal Meridian, City of Albuquerque, County of Bernalillo, State of New Mexico. The site is bound by Tramway Boulevard on the East, by Menaul Boulevard on the South and by undeveloped, C-1 neighborhood commercial zoned property on the West and North. According to the Flood Insurance Rate Map for the City of Albuquerque, Community Panel Number 350002 0025 C, with an effective date of October 14, 1983, the site lies within Zone C, an area of minimal flooding.

Currently the site is undeveloped and covered with native grasses and weeds. The site slopes downward from East to West at grades ranging from 2.5 to 8 percent. Small offsite basins along the East and South property lines contribute unconcentrated runoff to the site.

## **II. DESIGN CRITERIA**

This report is being prepared using the criteria and methodology as presented in Section 22.2, Hydrology of the "Development Process Manual" for the City of Albuquerque in cooperation with Bernalillo County, New Mexico, dated January 1993. Peak runoff for the minor and major storms (10 and 100 year frequency, respectively), excess precipitation and runoff volume was calculated using values for Precipitation Zone 4. Calculations and applicable tables and graphs are included in the appendix of this report.

## **III. EXISTING DRAINAGE**

The site is divided into 3 existing basins, A through C. Basin A is a 0.009 acre basin, at the northeasterly corner of the site, that is covered with native grasses and weeds. The 10 and 100 year runoff of 0.01 and 0.02 CFS, respectively, is unconcentrated and flows easterly to the Tramway Boulevard right-of-way.

Basin B is a 0.200 acre basin that is the northerly one-third of the site and is covered with native grasses and weeds. The 10 and 100 year runoff of 0.23 and 0.51 CFS, respectively, is largely unconcentrated and exits the site along the northerly property line.

Basin C is a 0.501 acre basin that consists of the majority of the site and is covered with native grasses and weeds. This basin receives offsite runoff along the sites East and South property lines. The offsite basin, OS-1, contains 0.079 acres and is covered with native grasses and weeds. The 10 and 100 year runoff of 0.09 and 0.20 CFS, respectively, is unconcentrated and sheetflows into Basin C. This runoff combines with Basin C's 10 and 100 year runoff of 0.58 and 1.28 CFS, respectively and flows westerly until it exits the site. The combined 10 and 100 year runoff at the sites westerly property line is 0.67 and 1.48 CFS, respectively.

#### **IV. DEVELOPED DRAINAGE**

The site is divided into 5 developed basins, A through E. Basin A is a 0.293 acre basin that consists of landscaping, roof and paved areas. This basin receives offsite runoff from the East and South. The offsite basin, OS-1, contains 0.063 acres and is covered with native grasses and weeds. The 10 and 100 year runoff of 0.07 and 0.16 CFS, respectively, is unconcentrated and sheetflows into Basin A. This runoff combines with Basin A's 10 and 100 year runoff of 0.88 and 1.41 CFS, respectively, and flows to a sump condition City of Albuquerque single "C" inlet. The combined 10 and 100 year runoff at the inlet is 0.95 and 1.57 CFS, respectively. This runoff is then piped westerly where it ultimately discharges into Menaul Boulevard through a sidewalk culvert.

This private storm sewer systems capacity was checked by using a 100 year flow of 1.75 CFS. That runoff will occur at the inlet if the car wash were constructed. That event would reduce the landscaped area and consequently the developed runoff would increase. Those calculations are included in the Appendix of this report.

Basin B is a 0.081 acre basin that consists of landscaping, roof and paved areas. This basin also receives offsite runoff from the South. That basin, OS-2, is a 0.007 acre basin that consists of native grasses and weeds. The 10 and 100 year runoff of 0.01 and 0.02 CFS, respectively, is unconcentrated and sheetflows into Basin B. This runoff combines with Basin B's 10 and 100 year runoff of 0.26 and 0.40 CFS, respectively and flows to the Menaul Boulevard curb cut. The combined 10 and 100 year runoff at the curb cut is 0.27 and 0.42 CFS, respectively.

Basin C is a 0.219 acre basin that consists of roof and paved areas. The 10 and 100 year runoff of 0.78 and 1.15 CFS, respectively, flows to the private access drive. The runoff sheetflows across the access drive and is discharged in to Menaul Boulevard through the most westerly curb cut.

Basin D is a 0.053 acre basin that is entirely landscaped. A minor swale directs the basin's 10 and 100 year flow of 0.08 and 0.15 cfs, respectively towards Menaul Boulevard.

Basin E is a 0.062 acre basin, along the northerly and westerly property lines, that is entirely landscaped. The 10 and 100 year runoff of 0.09 and 0.18 CFS, is unconcentrated and sheetflows off the site along the property lines.




#### V. DETENTION

Free discharge to Menaul Boulevard has been granted for this site and consequently detention is not required. This is per a pre-design conference with the City's Hydrology Section on June 21, 1994. A copy of the conference findings are included in the Appendix.

#### VI. CONCLUSIONS

The majority of the sites runoff discharges into Menaul Boulevard by gutter flow or a private storm sewer system. Should the sump condition inlet plug, water will pond to elevation 14.0 until it overflows the high point and flows to the curb cut. This elevation is 1.0 foot below the convenience stores finished floor elevation.

This report has been prepared using the methodology and information contained within Section 22.2 of the Development Process Manual for the City of Albuquerque in cooperation with Bernalillo County, New Mexico, dated January, 1993. Runoff from the minor/major storms is safely routed through the site and is discharged without causing potential harm to the public.

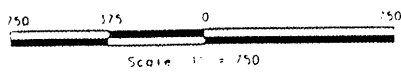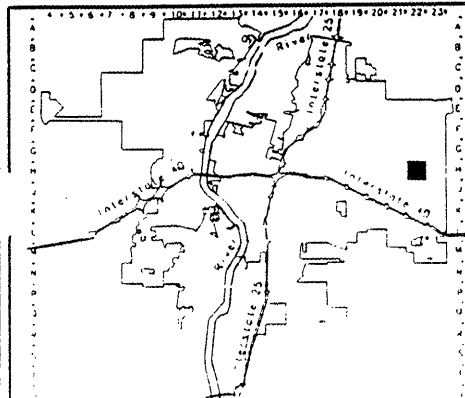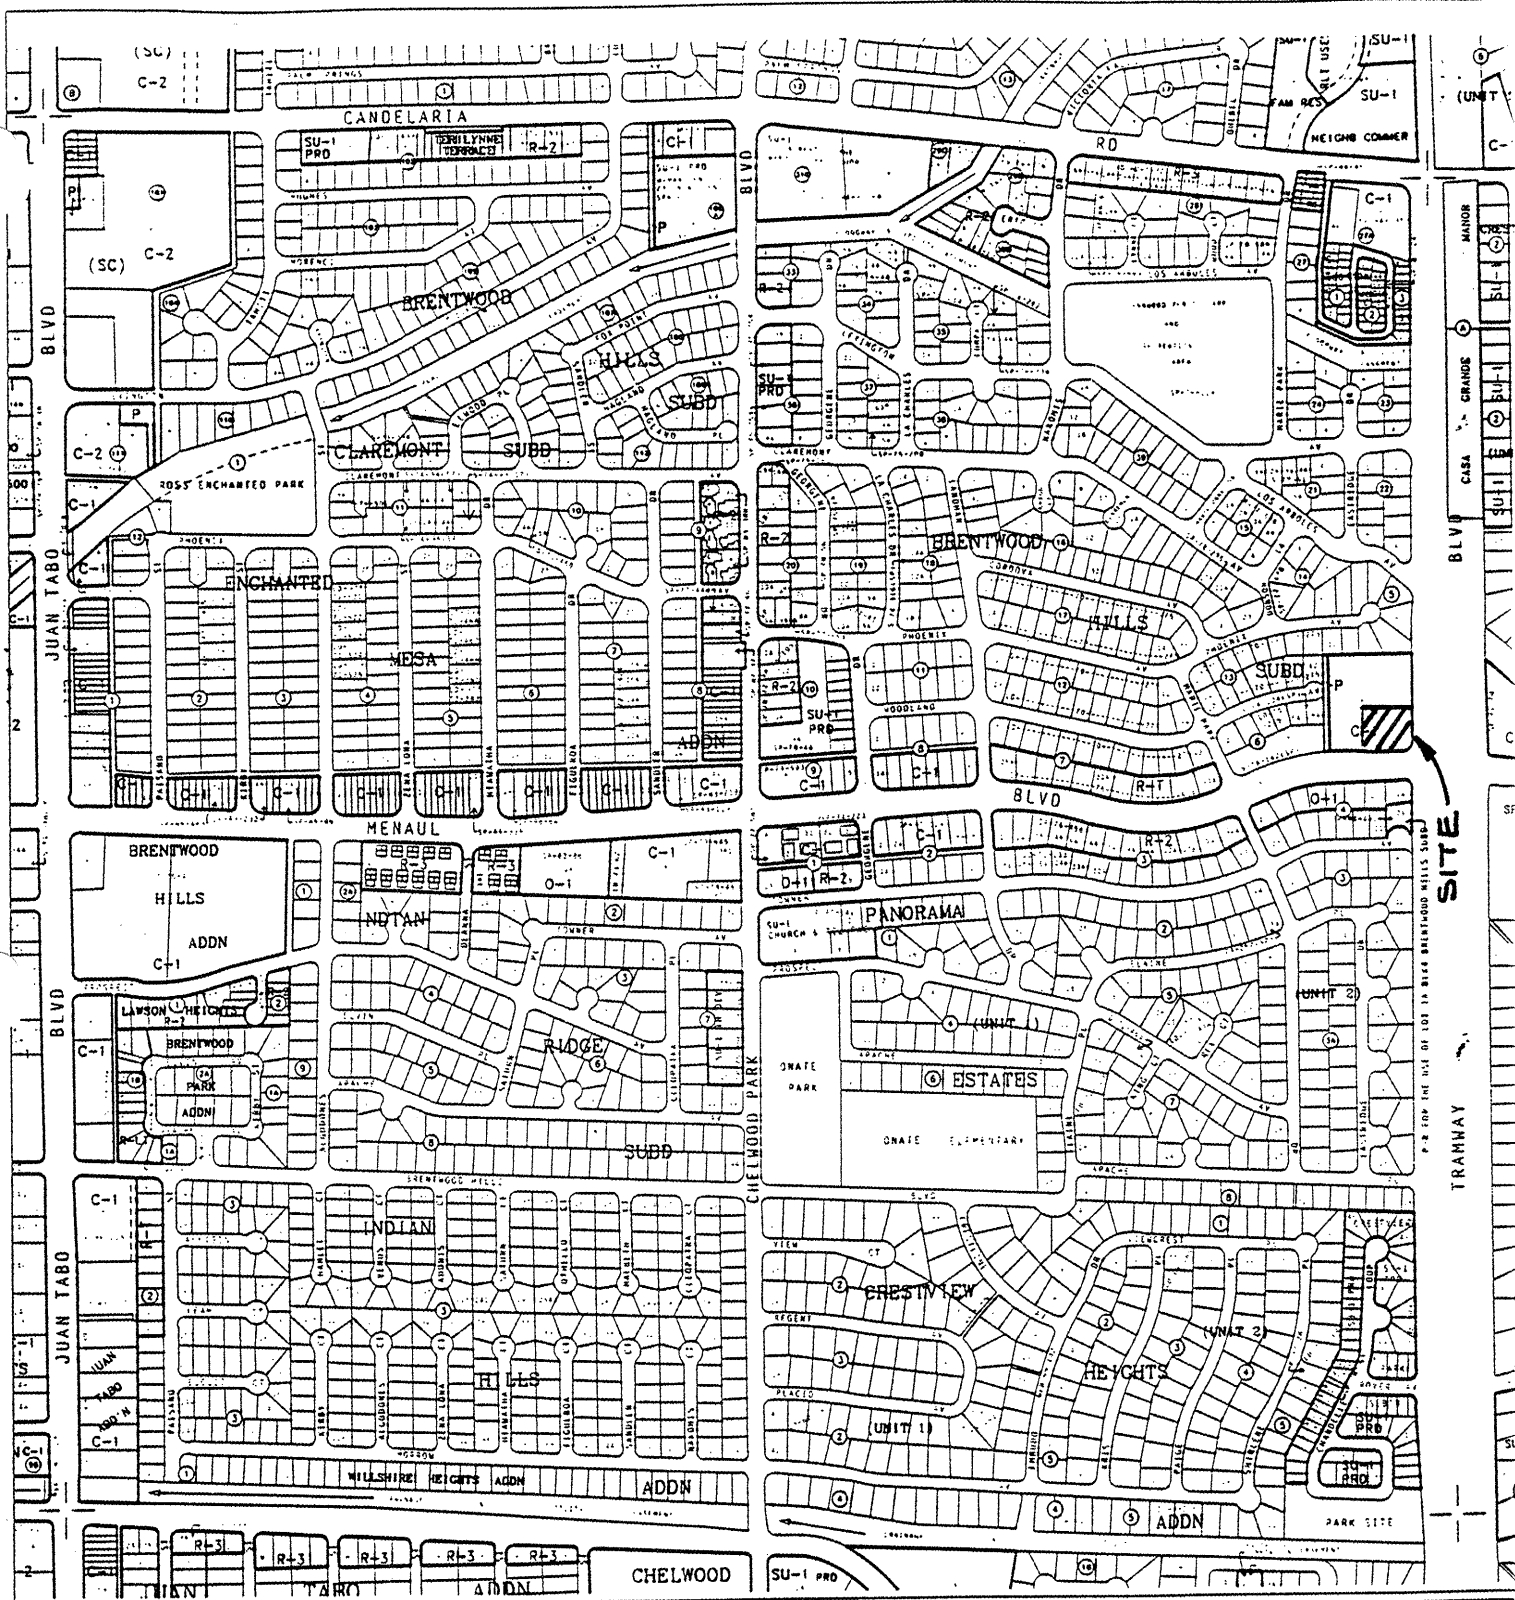

LEGAL DESCRIPTION

T10N  
R4E  
SEC 10

UNIFORM PROPERTY CODE

1 022 059

**H-22-Z**

VICINITY MAP A.1

# EXISTING RUNOFF - PEAK DISCHARGE METHOD

BASIN DESIGNATION	OVERALL AREA SF	TREATMENT		$Q_{10}$	$Q_{100}$
		A	B		
OS-1	3440	1720	1720	0.09	0.20
A	388	194	194	0.01	0.02
B	10900	5450	5450	0.29	0.64
C	21828	10914	10914	0.58	1.28

$T_c$  FOR ALL RUNOFF = 0.2 HOURS

TABLE A-9. PEAK DISCHARGE (cfs/acre)				
Zone	Treatment			100-YR [ 2-YR, 10-YR ]
	A	B	C	D
1	1.29 [ 0.00, 0.24 ]	2.03 [ 0.03, 0.76 ]	2.87 [ 0.47, 1.49 ]	4.37 [ 1.69, 2.89 ]
2	1.56 [ 0.00, 0.38 ]	2.28 [ 0.08, 0.95 ]	3.14 [ 0.60, 1.71 ]	4.70 [ 1.86, 3.14 ]
3	1.87 [ 0.00, 0.58 ]	2.60 [ 0.21, 1.19 ]	3.45 [ 0.78, 2.00 ]	5.02 [ 2.04, 3.39 ]
4	2.20 [ 0.05, 0.87 ]	2.92 [ 0.38, 1.45 ]	3.73 [ 1.00, 2.26 ]	5.25 [ 2.17, 3.57 ]

42-381 50 SHEETS VELAS 5 SQUARE  
42-382 100 SHEETS VELAS 5 SQUARE  
42-383 200 SHEETS VELAS 5 SQUARE  
42-384 100 RECYCLED WHITE 5 SQUARE  
42-385 200 RECYCLED WHITE 5 SQUARE  
MADE IN U.S.A.



# DEVELOPED RUNOFF - PEAK DISCHARGE METHOD

BASIN DESIGNATION	OVERALL AREA SF	TREATMENT			$Q_{10}$ CFS	$Q_{100}$ CFS
		A SF	B SF	D SF		
OS-1	2746	1373	1373	-	0.07	0.16
OS-2	312	156	156	-	0.01	0.02
A	12746	-	3433	9313	0.88	1.41
B	3522	-	522	3000	0.26	0.40
C	9551	-	-	9551	0.78	1.15
D	2308	-	2304	-	0.08	0.15
E	2710	-	2710	-	0.09	0.18

## COMBINED FLOWS AT DESIGN POINTS

①  $\Sigma$  OS-1 & A, USE  $T_c = 0.2$  HR OR 12 MIN

$$Q_{10} = 0.95 \text{ CFS}$$

$$Q_{100} = 1.57 \text{ CFS}$$

②  $\Sigma$  OS-2 & B, USE  $T_c = 0.2$  HR OR 12 MIN

$$Q_{10} = 0.27 \text{ CFS}$$

$$Q_{100} = 0.42 \text{ CFS}$$



## INLET & PRIVATE STORM LATERAL SIZING

- CONTRIBUTING BASINS OS-1 & BASIN A, USE BASIN A FUTURE CONDITION (WITH CAR WASH), THIS PRODUCES THE MAXIMUM AMOUNT OF RUNOFF

BASIN A 14050 SF OVERALL, 2694 SF TREATMENT  
B, 11356 TREATMENT D

$$Q_{10} = \left( \frac{2694}{43560} \right) 1.45 + \left( \frac{11356}{43560} \right) 3.57 = 1.02 \text{ CFS}$$

$$Q_{100} = \left( \frac{2694}{43560} \right) 2.92 + \left( \frac{11356}{43560} \right) 5.25 = 1.55 \text{ CFS}$$

### INTO INLET

$$Q_{10} = 1.02 + 0.07 = 1.09 \text{ CFS}$$

$$Q_{100} = 1.55 + 0.16 = 1.71 \text{ CFS} \leftarrow$$

8" OUTFALL PIPE, ALLOW PONDING TO TOP OF INLET

$$H_w = 12.55 - 10.15 - \left( \frac{4}{12} \right) = 2.07 \text{ FT}$$

ORIFICE EQUATION

$$Q = 0.65 \left( \frac{4}{12} \right)^2 \pi (2 \cdot 32.2 \cdot 2.07)^{1/2} = 2.62 \text{ CFS} \leftarrow \text{OK}$$

AT JUNCTION BOX, 2~6" CI PIPES WILL CONVEY WATER


$$Q_{1/2} = 1.71 \text{ CFS} / 2 = 0.86 \text{ CFS, ALLOW PONDING TO } \frac{1}{2} \text{ OF } 8" \text{ OUTFALL PIPE AT INLET}$$

$$\text{ELEV} = 10.15 + \left( \frac{4}{12} \right) = 10.48$$

$$H_w = 10.48 - 8.50 - \left( \frac{3}{12} \right) = 1.73 \text{ FT}$$

ORIFICE EQUATION

$$Q = 0.65 \left( \frac{3}{12} \right)^2 \pi (2 \cdot 32.2 \cdot 1.73)^{1/2} = 1.35 \text{ CFS} \leftarrow \text{OK}$$

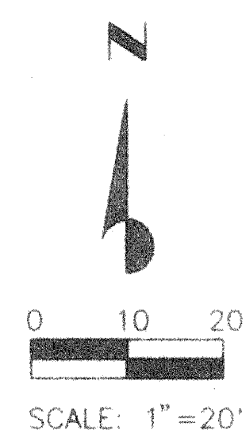

TRAMWAY BOULEVARD N.E.

### EROSION CONTROL NOTES

1. THE CONTRACTOR SHALL ENSURE THAT NO SOIL ERODES FROM THE SITE INTO PUBLIC RIGHT-OF-WAY OR INTO PRIVATE PROPERTY. THIS CAN BE ACHIEVED BY CONSTRUCTING TEMPORARY BERM AT THE PROPERTY LINES AND WETTING THE SOIL TO KEEP IT FROM BLOWING.
2. THE CONTRACTOR SHALL PROMPTLY CLEAN UP ANY MATERIAL EXCAVATED WITHIN THE PUBLIC RIGHT-OF-WAY SO THAT THE EXCAVATED MATERIAL IS NOT SUSCEPTIBLE TO BEING WASHED DOWN THE STREET.
3. THE CONTRACTOR SHALL SECURE TOPSOIL DISTURBANCE PERMIT PRIOR TO BEGINNING CONSTRUCTION.



VICINITY MAP  
ZONE ATLAS H-22-2  
SCALE: 1"=750'

### NOTES:

1. BENCHMARK: 1"=20" A BRASS CAP SET 0.10 FEET BELOW GROUND WITHIN AN 8" DIAMETER STEEL MONUMENT BOX LOCATED AT THE INTERSECTION OF TRAMWAY & MENAUL BOULEVARDS N.E. ELEVATION: 5814.50
2. ALL SPOT ELEVATIONS SHOWN ADJACENT TO CURBS REFER TO FLOWLINE.

### LEGAL DESCRIPTION

A CERTAIN PARCEL OF LAND BEING IDENTIFIED AS A PORTION OF TRACT 14, AS THE SAME IS SHOWN AND DESIGNATED ON THE PLAT ENTITLED "REPLAT OF BLOCKS 1, 8 & 9, BLOCK 6, LOTS 9, 10, 11 & 12, BLOCK 13 & LOTS 4 & 5, BLOCK 14, BRENTWOOD HILLS A SUBDIVISION, ALBUQUERQUE, NEW MEXICO AND INCLUDING VACATED PORTIONS OF EASTRIDGE DRIVE, PHOENIX AVENUE & WOODLAND AVENUE" FILED IN THE OFFICE OF THE COUNTY CLERK OF BERNALILLO COUNTY, NEW MEXICO ON APRIL 16, 1971 IN VOLUME 7, FOLIO 205 AND BEING MORE PARTICULARLY DESCRIBED IN METES AND BOUNDS AS FOLLOWS:

BEGINNING AT THE SOUTHWEST CORNER OF THE PARCEL HEREIN DESCRIBED; A POINT ON THE NORTHERLY RIGHT-OF-WAY OF MENAUL BOULEVARD N.E. WHEN THE SOUTHWEST CORNER OF SAID TRACT 14 BEARS S89°04'30"W A DISTANCE OF 154.87 FEET;

THENCE, N07°55'30"W A DISTANCE OF 161.00 FEET TO THE NORTHWEST CORNER OF THE PARCEL HEREIN DESCRIBED;

THENCE, N89°04'30"E A DISTANCE OF 190.00 FEET TO A POINT ON THE WESTERLY RIGHT-OF-WAY OF TRAMWAY BOULEVARD N.E. AND THE NORTHEAST CORNER OF THE PARCEL HEREIN DESCRIBED;

THENCE, S00°55'30"E A DISTANCE OF 138.00 FEET ALONG, ADJOINING AND ADJACENT TO SAID WESTERLY RIGHT-OF-WAY OF TRAMWAY BOULEVARD N.E. TO A POINT OF CURVATURE;

THENCE, S00°55'30"E A DISTANCE OF 39.27 FEET ALONG THE ARC OF A CURVE BEARING TO THE RIGHT (SAID ARC HAVING A RADIUS OF 25.00 FEET AND A LONG CHORD WHICH BEARS S44°04'30"W A DISTANCE OF 35.36 FEET) TO A POINT OF TANGENCY AND A POINT ON SAID NORTHERLY RIGHT-OF-WAY OF MENAUL BOULEVARD N.E.

THENCE, S89°04'30"W A DISTANCE OF 165.00 FEET ALONG, ADJOINING AND ADJACENT TO THE NORTHERLY RIGHT-OF-WAY OF MENAUL BOULEVARD N.E. TO THE SOUTHWEST CORNER AND POINT OF BEGINNING OF THE PARCEL HEREIN DESCRIBED AND CONTAINING 10.8375 ACRES FEET OR 0.7079 ACRES MORE OR LESS.

### LEGEND

- 14- - - - - EXISTING CONTOUR
- 14- - - - - PROPOSED CONTOUR
- 14.0 - - - - - EXISTING SPOT ELEVATION
- 14.0 - - - - - FUTURE SPOT ELEVATION
- 14.0 - - - - - FINISHED SPOT ELEVATION
- FF - - - - - FINISHED FLOOR ELEVATION
- TOT - - - - - TOP OF TANKS
- TI - - - - - TOP OF ISLAND
- TC - - - - - TOP OF CURB
- HP - - - - - HIGH POINT
- LP - - - - - LOW POINT
- ME - - - - - MATCH EXISTING
- WB - - - - - WATER BLOCK
- FL INT - - - - - FLOWLINE INTERSECTION
- PCR - - - - - POINT OF CURB RETURN
- - - - - BASIN LINE
- △ - - - - - DESIGN POINT
- A - - - - - BASIN DESIGNATION
- 0.293 - - - - - AREA IN ACRES
- - - - - - FLOW ARROW
- Q10 - - - - - 10 YEAR RUNOFF IN CFS
- Q100 - - - - - 100 YEAR RUNOFF IN CFS
- AB - - - - - AS BUILT

NOTE: THE CONTRACTOR SHALL SECURE A "TOPSOIL DISTURBANCE PERMIT" PRIOR TO BEGINNING CONSTRUCTION


THIS IS TO CERTIFY THAT THE DIAMOND SHAMROCK SITE AT 12501 MENAUL BLVD. N.E. WAS CONSTRUCTED IN SUBSTANTIAL COMPLIANCE WITH THE APPROVED GRADING AND DRAINAGE PLAN.

*Rafael E. Romero*  
RAFAEL E. ROMERO PE No. 4859  
NEW MEXICO REGISTERED PROFESSIONAL ENGINEER  
DATE: 1-18-95

### NOTICE TO CONTRACTOR


1. AN EXCAVATION/CONSTRUCTION PERMIT WILL BE REQUIRED BEFORE BEGINNING ANY WORK WITHIN CITY RIGHT-OF-WAY. AN APPROVED COPY OF THESE PLANS MUST BE SUBMITTED AT THE TIME OF APPLICATION FOR THIS PERMIT.
2. ALL WORK DETAILED ON THESE PLANS TO BE PERFORMED, EXCEPT AS OTHERWISE STATED OR PROVIDED HEREON, SHALL BE CONSTRUCTED IN ACCORDANCE WITH CITY OF ALBUQUERQUE STANDARD SPECIFICATIONS FOR PUBLIC WORKS CONSTRUCTION 1986 WITH CURRENT UPDATES.
3. TWO WORKING DAYS PRIOR TO ANY EXCAVATION, CONTRACTOR MUST CONTACT LINE LOCATING SERVICE (505) 260-1990, FOR LOCATION OF EXISTING UTILITIES.
4. PRIOR TO CONSTRUCTION, THE CONTRACTOR SHALL EXCAVATE AND VERIFY THE HORIZONTAL AND VERTICAL LOCATIONS OF ALL CONSTRUCTIONS. SHOULD A CONFLICT EXIST, THE CONTRACTOR SHALL NOTIFY THE ENGINEER SO THAT THE CONFLICT CAN BE RESOLVED WITH A MINIMUM AMOUNT OF DELAY.
5. BACKFILL COMPACTION SHALL BE ACCORDING TO ARTERIAL STREET USE.

APPROVALS	NAME	DATE	TITLE
DESIGN			DIAMOND SHAMROCK CORNER STORE No. 1240
INSPECTOR			DEVELOPED DRAINAGE PLAN
FIELD			PERMIT No. MAP No. H-22

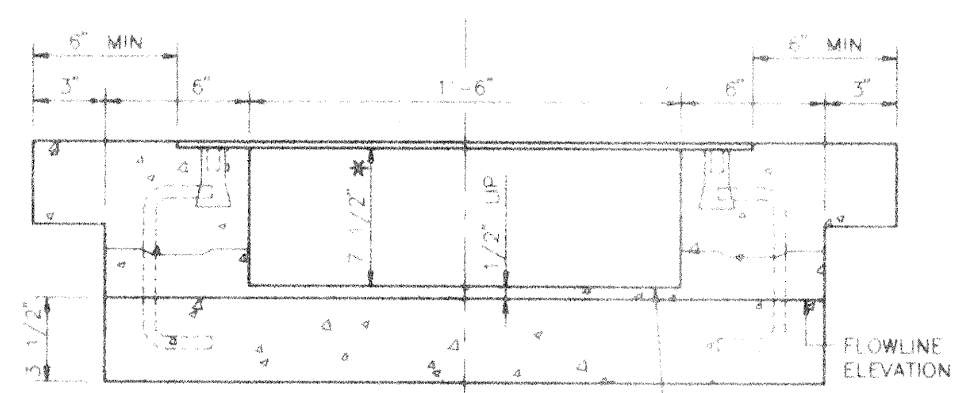


SECTION A-A  
NOT TO SCALE  
DO NOT CONSTRUCT  
INVERT FOR 2 LF  
SOUTH OF PROPERTY LINE

SIDEWALK CULVERT SECTION AT UPSTREAM END  
MODIFIED COA STD DRAWING 2236 ALL OTHER DETAILS  
APPLY AS SHOWN

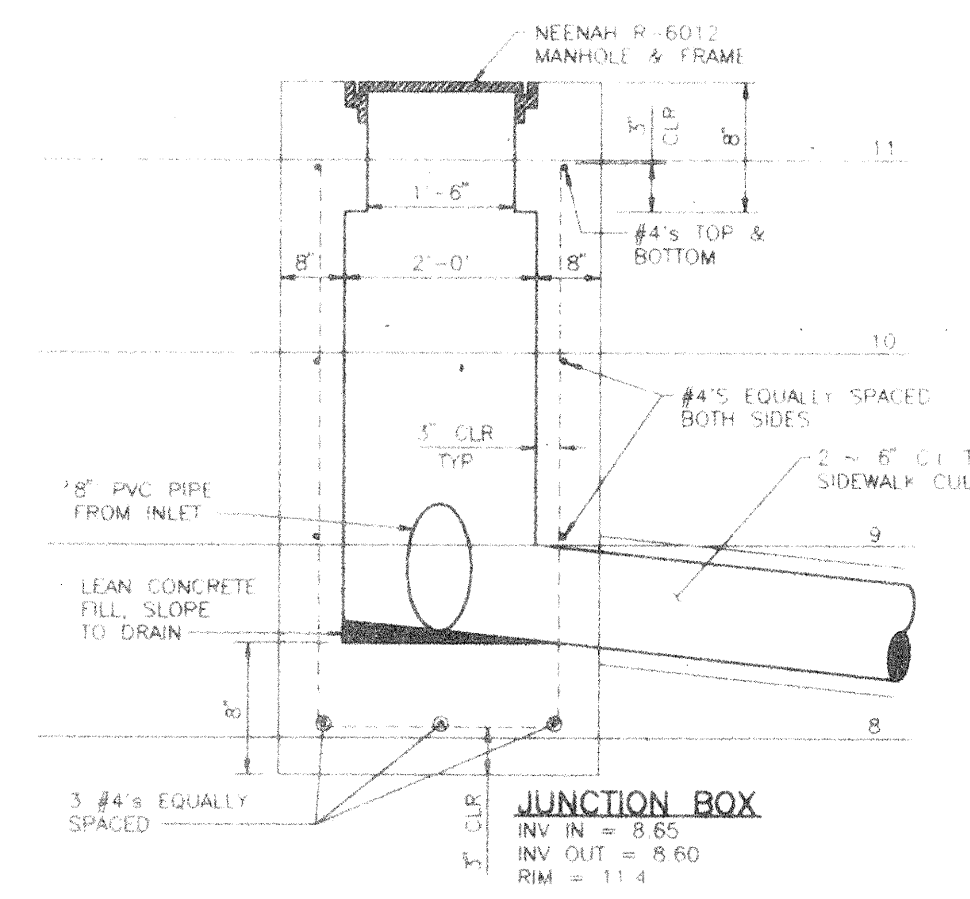

JUNCTION BOX SECTION  
NOT TO SCALE  
SCALE: 1"=2' HORIZONTAL  
1"=1' VERTICAL

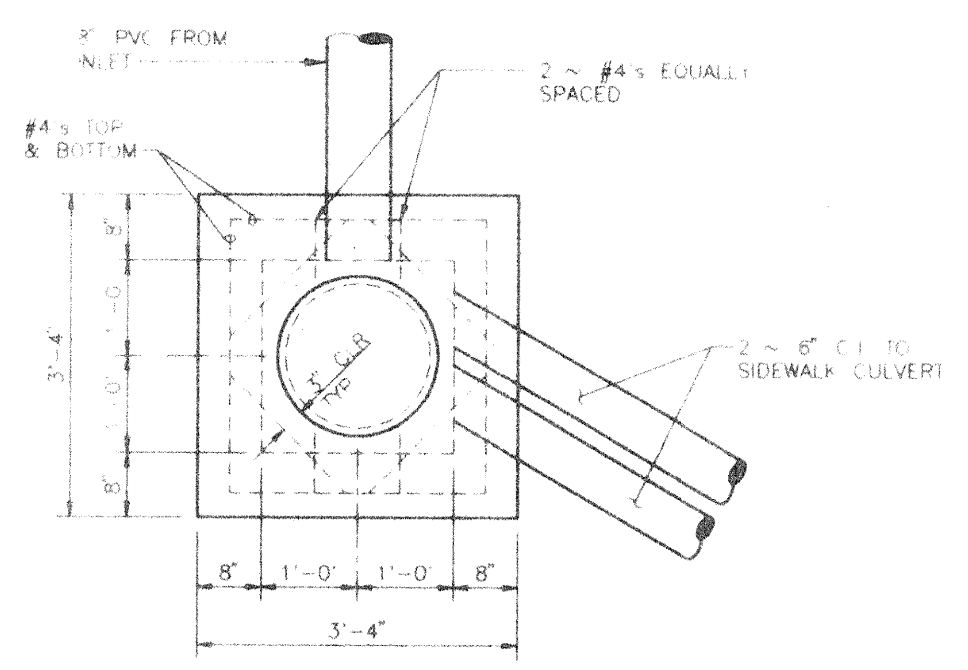

JUNCTION BOX PLAN  
NOT TO SCALE  
SCALE: 1"=2'

REVISIONS	No.	Description	Des. By	Drn. By	Date
1	1	PER JIM REED	LLP	RDG	8/5/94
2	2	PER DRG COMMENTS	LLP	RDG	8/17/94
3	3	EXTEND SW CULVERT, ADD TRENCH DRAIN	LLP	CJH	9/15/94
4	4	PER CITY OF ALBUQUERQUE	LLP	CJH	10/31/94
5	5	ADD AS BUILT INFORMATION	LLP	RDG	1/17/95


**DIAMOND SHAMROCK**  
9702 BROCKBANK  
DALLAS, TEXAS 75220  
(214) 357-7386

**Galloway, Romero & Associates**  
Design: Engineering Planning  
14202 East Evans Avenue  
Aurora, Colorado 80013  
Tel: (303) 745-7448  
Fax: (303) 745-7480

### AS BUILT DEVELOPED DRAINAGE PLAN

STORE #1240  
TRAMWAY BLVD NE & MENAUL BLVD NE  
ALBUQUERQUE, NEW MEXICO

Designed By	LLP	Date	AUGUST, 1994
Drawn By	RDG	Scale	1" = 20'-0"
Checked By	LLP	Disk File	D51240SP

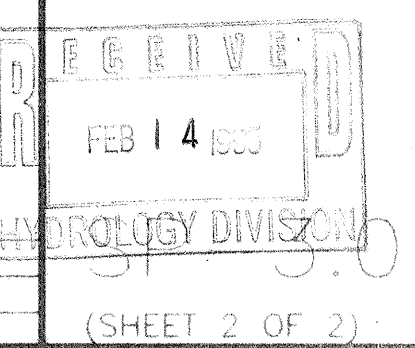

NOTICE: THIS DOCUMENT IS THE PROPERTY OF DIAMOND SHAMROCK. NEITHER THIS DOCUMENT NOR ANY DATA OF INFORMATION HEREIN SHALL BE COPIED OR REPRODUCED IN ANY MANNER, LOANED, OR OTHERWISE DISPOSED OF, OR USED FOR ANY PURPOSE WHATSOEVER WITHOUT THE PRIOR WRITTEN PERMISSION OF DIAMOND SHAMROCK. IF THIS DOCUMENT IS LOANED BY OR WITH THE AUTHORITY OF DIAMOND SHAMROCK, THE BORROWER, IN CONSIDERATION OF SUCH LOAN, AGREES TO THE FOREGOING CONDITIONS AND TO RETURN THIS DOCUMENT UPON REQUEST OR UPON COMPLETION OF THE SPECIFICALLY AUTHORIZED WORK FOR WHICH IT WAS USED.