# CITY OF ALBUQUERQUE



May 24, 2018

Yolanda Padilla-Moyer, PE Bohannan-Huston 7500 Jefferson St NE Courtyard I Albuquerque, NM 87109

#### Re: Del Webb @ Mirehaven 2B Pad Certification for lots 112-113 Engineer's Stamp dated: 3-11-16 (H09D017F) Certification dated: 5-21-18

Dear Ms. Padilla-Moyer,

Based upon the information provided in your submittal received 5/21/2018, the above referenced lots cannot be accepted for Pad Certification by Hydrology until the following comments are addressed:

• The pads are not graded per the approved G & D. The pads need to be cleared of debris.

PO Box 1293

If you have any questions, you can contact me at 924-3986 or Totten Elliott at 924-3982.

Albuquerque

NM 87103

www.cabq.gov


James D. Hughes, P.E.

Principal Engineer, Planning Dept.


Development and Review Services

TE/JH C: email


Sincerely,

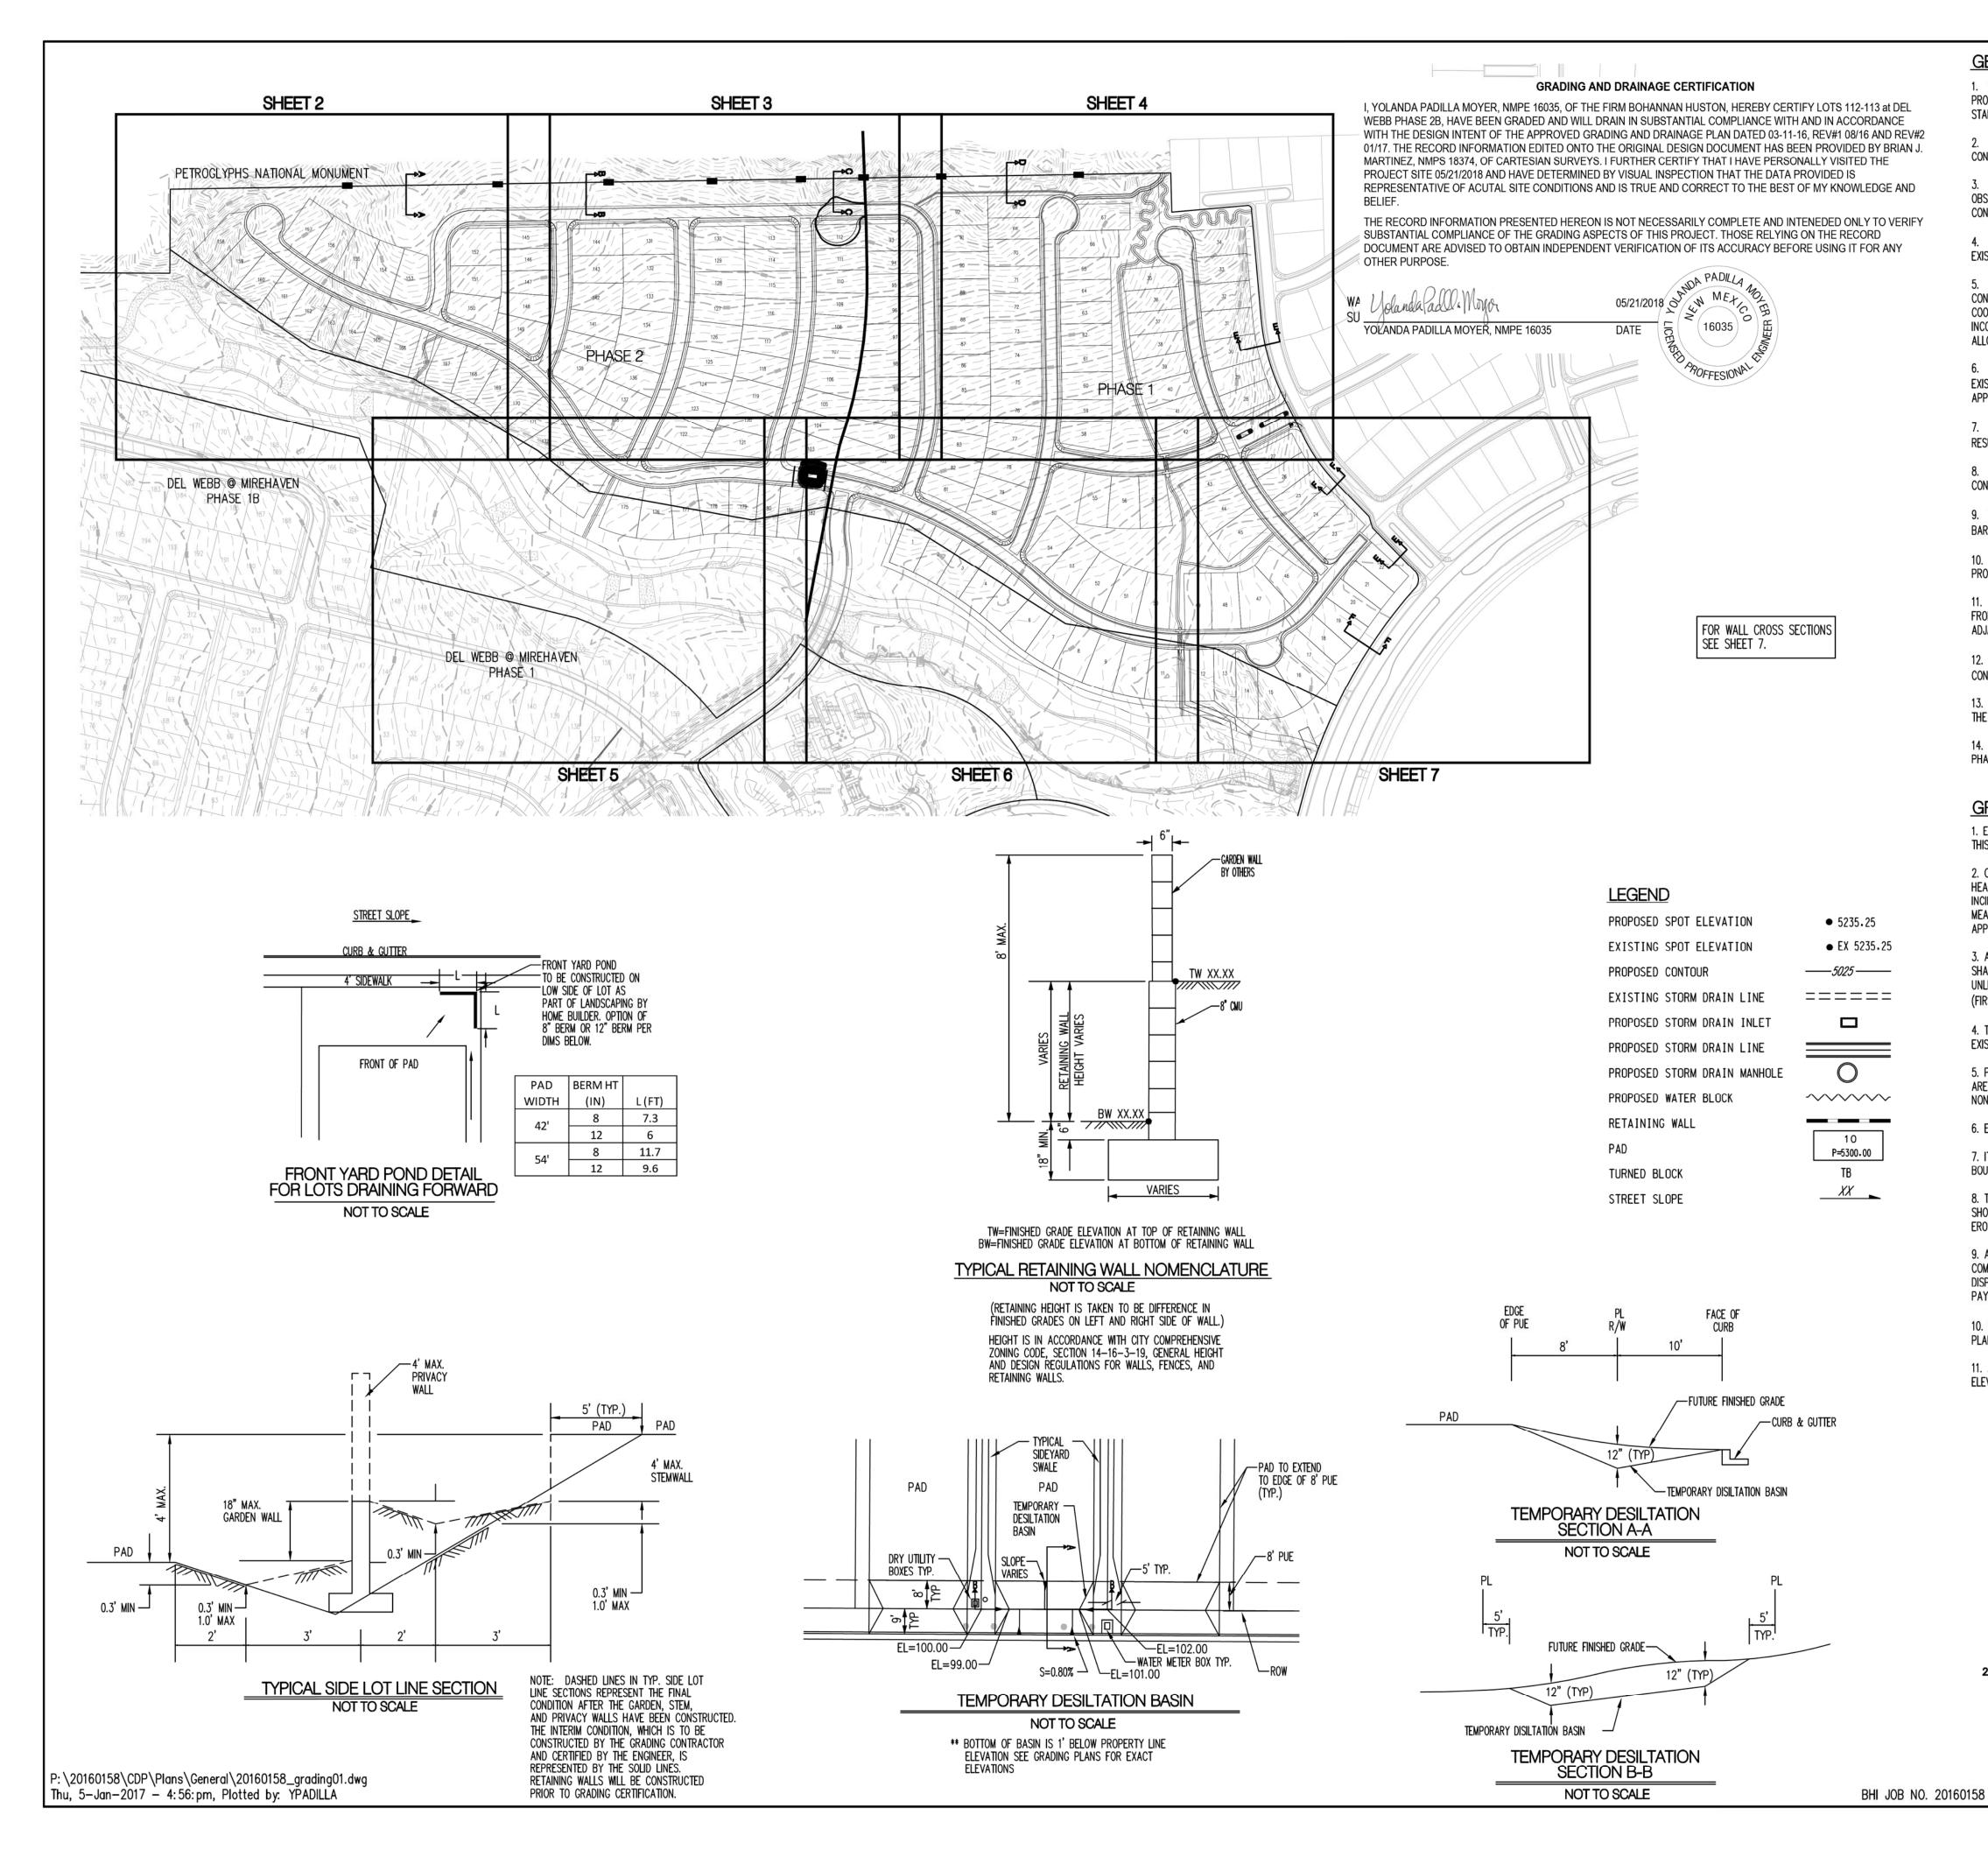


### GENERAL NOTES 1. ALL WORK DETAILED ON THESE PLANS AND PERFORMED UNDER THIS CONTRACT SHALL BE CONSTRUCTED IN ACCORDANCE WITH THE PROJECT SPECIFICATIONS AND THE PROJECT GEOTECHNICAL REPORT. WHERE APPLICABLE, CITY OF ALBUQUERQUE PUBLIC WORKS STANDARDS SHALL APPLY. 2. THE CONTRACTOR SHALL ABIDE BY ALL LOCAL, STATE, AND FEDERAL LAWS, RULES AND REGULATIONS WHICH APPLY TO THE CONSTRUCTION OF THESE IMPROVEMENTS, INCLUDING EPA REQUIREMENTS WITH RESPECT TO STORM WATER DISCHARGE. 3. PRIOR TO CONSTRUCTION, THE CONTRACTOR SHALL FIELD VERIFY THE HORIZONTAL AND VERTICAL LOCATIONS OF ALL POTENTIAL OBSTRUCTIONS INCLUDING ALL UNDERGROUND UTILITIES. SHOULD A CONFLICT EXIST, THE CONTRACTOR SHALL NOTIFY THE CONSTRUCTION OBSERVER OR ENGINEER SO THAT THE CONFLICT CAN BE RESOLVED WITH A MINIMUM AMOUNT OF DELAY. 4. TWO (2) WORKING DAYS PRIOR TO ANY EXCAVATION, THE CONTRACTOR SHALL CONTACT LINE LOCATING SERVICE FOR LOCATION OF EXISTING UTILITIES. 5. ALL ELECTRICAL, TELEPHONE, CABLE TV, GAS AND OTHER UTILITY LINES, CABLES, AND APPURTENANCES ENCOUNTERED DURING CONSTRUCTION THAT REQUIRE RELOCATION, SHALL BE COORDINATED WITH THAT UTILITY. THE CONTRACTOR SHALL BE RESPONSIBLE FOR COORDINATION OF ALL NECESSARY UTILITY ADJUSTMENTS. NO ADDITIONAL COMPENSATION WILL BE ALLOWED FOR DELAYS OR INCONVENIENCES CAUSED BY UTILITY COMPANY WORK CREWS. THE CONTRACTOR MAY BE REQUIRED TO RESCHEDULE HIS ACTIVITIES TO ALLOW UTILITY CREWS TO PERFORM THEIR REQUIRED WORK. 6. THE CONTRACTOR IS RESPONSIBLE FOR PROTECTING ALL EXISTING UTILITY LINES WITHIN THE CONSTRUCTION AREA. ANY DAMAGE TO EXISTING FACILITIES CAUSED BY CONSTRUCTION ACTIVITY SHALL BE REPAIRED OR REPLACED AT THE CONTRACTOR'S EXPENSE AND APPROVED BY THE CONSTRUCTION OBSERVER. 7. CONSTRUCTION ACTIVITY SHALL BE LIMITED TO THE PROPERTY AND/OR PROJECT LIMITS. ANY DAMAGE TO ADJACENT PROPERTIES RESULTING FROM THE CONSTRUCTION PROCESS SHALL BE REPAIRED OR REPLACED AT THE CONTRACTOR'S EXPENSE. 8. OVERNIGHT PARKING OF CONSTRUCTION EQUIPMENT SHALL NOT OBSTRUCT DRIVEWAYS OR DESIGNATED TRAFFIC LANES. THE CONTRACTOR SHALL NOT STORE ANY EQUIPMENT OR MATERIAL WITHIN THE PUBLIC RIGHT-OF-WAY. 063 9. THE CONTRACTOR SHALL OBTAIN ALL THE NECESSARY PERMITS FOR THE PROJECT PRIOR TO COMMENCING CONSTRUCTION (I.E., BARRICADING, TOPSOIL DISTURBANCE, EXCAVATION PERMITS, EPA STORM WATER PERMITS, ETC.). 10. ALL PROPERTY CORNERS DESTROYED DURING CONSTRUCTION SHALL BE REPLACED AT THE CONTRACTOR'S EXPENSE. ALL PROPERTY CORNERS MUST BE RESET BY A REGISTERED LAND SURVEYOR. 11. THE CONTRACTOR SHALL PREPARE A CONSTRUCTION TRAFFIC CONTROL AND SIGNING PLAN AND OBTAIN APPROVAL OF SUCH PLAN FROM THE CITY OF ALBUQUERQUE, TRAFFIC ENGINEERING DEPARTMENT, PRIOR TO BEGINNING ANY CONSTRUCTION WORK ON OR ADJACENT TO EXISTING STREETS. 12. ALL BARRICADES AND CONSTRUCTION SIGNING SHALL CONFORM TO APPLICABLE SECTIONS OF THE "MANUAL ON UNIFORM TRAFFIC CONTROL DEVICES" (MUTCD), US DEPARTMENT OF TRANSPORTATION, LATEST EDITION. 13. THE CONTRACTOR SHALL MAINTAIN ALL CONSTRUCTION BARRICADES AND SIGNING AT ALL TIMES. THE CONTRACTOR SHALL VERIFY THE PROPER LOCATION OF ALL BARRICADING AT THE END AND BEGINNING OF EACH DAY. 14. THE CONTRACTOR SHALL TAKE ALL STEPS NECESSARY TO CONFORM WITH EPA REQUIREMENTS, INCLUDING COMPLIANCE WITH NPDES PHASE 2 REQUIREMENTS. GRADING NOTES 1. EXCEPT AS PROVIDED HERIN, GRADING SHALL BE PERFORMED AT THE ELEVATIONS AND IN ACCORDANCE WITH THE DETAILS SHOWN ON THIS PLAN. 2. CONTRACTOR SHALL OBTAIN AND ABIDE BY A TOPSOIL DISTURBANCE PERMIT FROM THE CITY OF ALBUQUERQUE ENVIRONMENTAL HEALTH DIVISION, PRIOR TO CONSTRUCTION. THE COST FOR REQUIRED CONSTRUCTION DUST AND EROSION CONTROL MEASURES SHALL BE INCIDENTAL TO THE PROJECT COST. THE CONTRACTOR SHALL CONFORM TO ALL CITY, COUNTY, STATE, AND FEDERAL DUST CONTROL MEASURES AND REQUIREMENTS AND WILL BE RESPONSIBLE FOR PREPARING AND OBTAINING ALL NECESSARY APPLICATIONS AND APPROVALS. 3. ALL WORK RELATIVE TO FOUNDATION CONSTRUCTION, SITE PREPARATION, AND PAVEMENT INSTALLATION, AS SHOWN ON THIS PLAN, SHALL BE CONSTRUCTED IN ACCORDANCE WITH THE SOILS REPORT PREPARED BY X8EVINYARD DATED JULY 22, 2013. ALL OTHER WORK, UNLESS OTHERWISE STATED OR PROVIDED FOR HEREON, SHALL BE CONSTRUCTED IN ACCORDANCE WITH THE PROJECT SPECIFICATIONS TUFFESION (FIRST PRIORITY), AND/OR THE CITY OF ALBUQUERQUE (COA) STANDARD SPECIFICATIONS FOR PUBLIC WORKS (SECOND PRIORITY). 4. TWO WORKING DAYS PRIOR TO EXCAVATION, CONTRACTOR MUST CONTACT LINE LOCATING SERVICE (765-1264) FOR LOCATION OF EXISTING UTILITIES. YPM BY 5. PRIOR TO GRADING, ALL VEGETATION DEBRIS, AND NEAR SURFACE ORGANICALLY CONTAMINATED SOIL SHALL BE STRIPPED FROM ALL AREAS TO BE GRADED. VEGETATION AND DEBRIS SHALL BE DISPOSED OF OFF-SITE OR STOCK-PILED FOR USE IN PLANTERS AND A CRADING\RETAINING WALLS DRAIN TO WOODS WASH TR. REMARKS NON-STRUCTURAL FILLS. 6. EARTH SLOPES SHALL NOT EXCEED 4 HORIZONTAL TO 1 VERTICAL UNLESS SHOWN OTHERWISE. 7. IT IS THE INTENT OF THESE PLANS THAT THIS CONTRACTOR SHALL NOT PERFORM ANY WORK OUTSIDE OF THE PROPERTY BOUNDARIES EXCEPT AS REQUIRED BY THIS PLAN. 8. THE CONTRACTOR IS TO ENSURE THAT NO SOIL ERODES FROM THE SITE ONTO ADJACENT PROPERTY OR PUBLIC RIGHT-OF-WAY. THIS SHOULD BE ACHIEVED BY CONSTRUCTING TEMPORARY BERMS AT THE PROPERTY LINES WETTING THE SOIL TO PROTECT IT FROM WIND EROSION. 9. A DISPOSAL SITE FOR ALL EXCESS EXCAVATION AND UNSUITABLE MATERIAL SHALL BE OBTAINED BY THE CONTRACTOR IN COMPLIANCE WITH APPLICABLE ENVIRONMENTAL REGULATIONS AND APPROVED BY THE OBSERVER. ALL COSTS INCURRED IN OBTAINING A DISPOSAL SITE AND HAUL THERETO SHALL BE CONSIDERED INCIDENTAL TO THE PROJECT, AND NO SEPARATE MEASUREMENT OR PAYMENT SHALL BE MADE. NORTH 3-67 [ 10. PAVING AND ROADWAY GRADES SHALL BE +/- 0.1' FROM PLAN ELEVATIONS. PAD ELEVATION SHALL BE +/- 0.05' FROM BUILDING PLAN ELEVATIONS. REVISED N LOTS 58-11. ALL SPOT ELEVATIONS ARE TO FLOWLINE UNLESS OTHERWISE NOTED. VALLEY GUTTER ELEVATIONS ARE SHOWN AT FLOWLINE ELEVATION. **Bohannan Huston** 800.877.5332 www.bhinc.com **CITY OF ALBUQUERQUE** N **DEPARTMENT OF MUNICIPAL DEVELOPMENT** DEL WEBB @ MIREHAVEN PHASE 2 OVERALL GRADING PLAN MO./DAY/YR. MO./DAY/YR. CITY ENGINEER APPROVAL DESIGN REVIEW COMMITTEE 200 100 200 SCALE: 1"=200' CITY PROJECT NO. ZONE MAP NO. SHEET OF

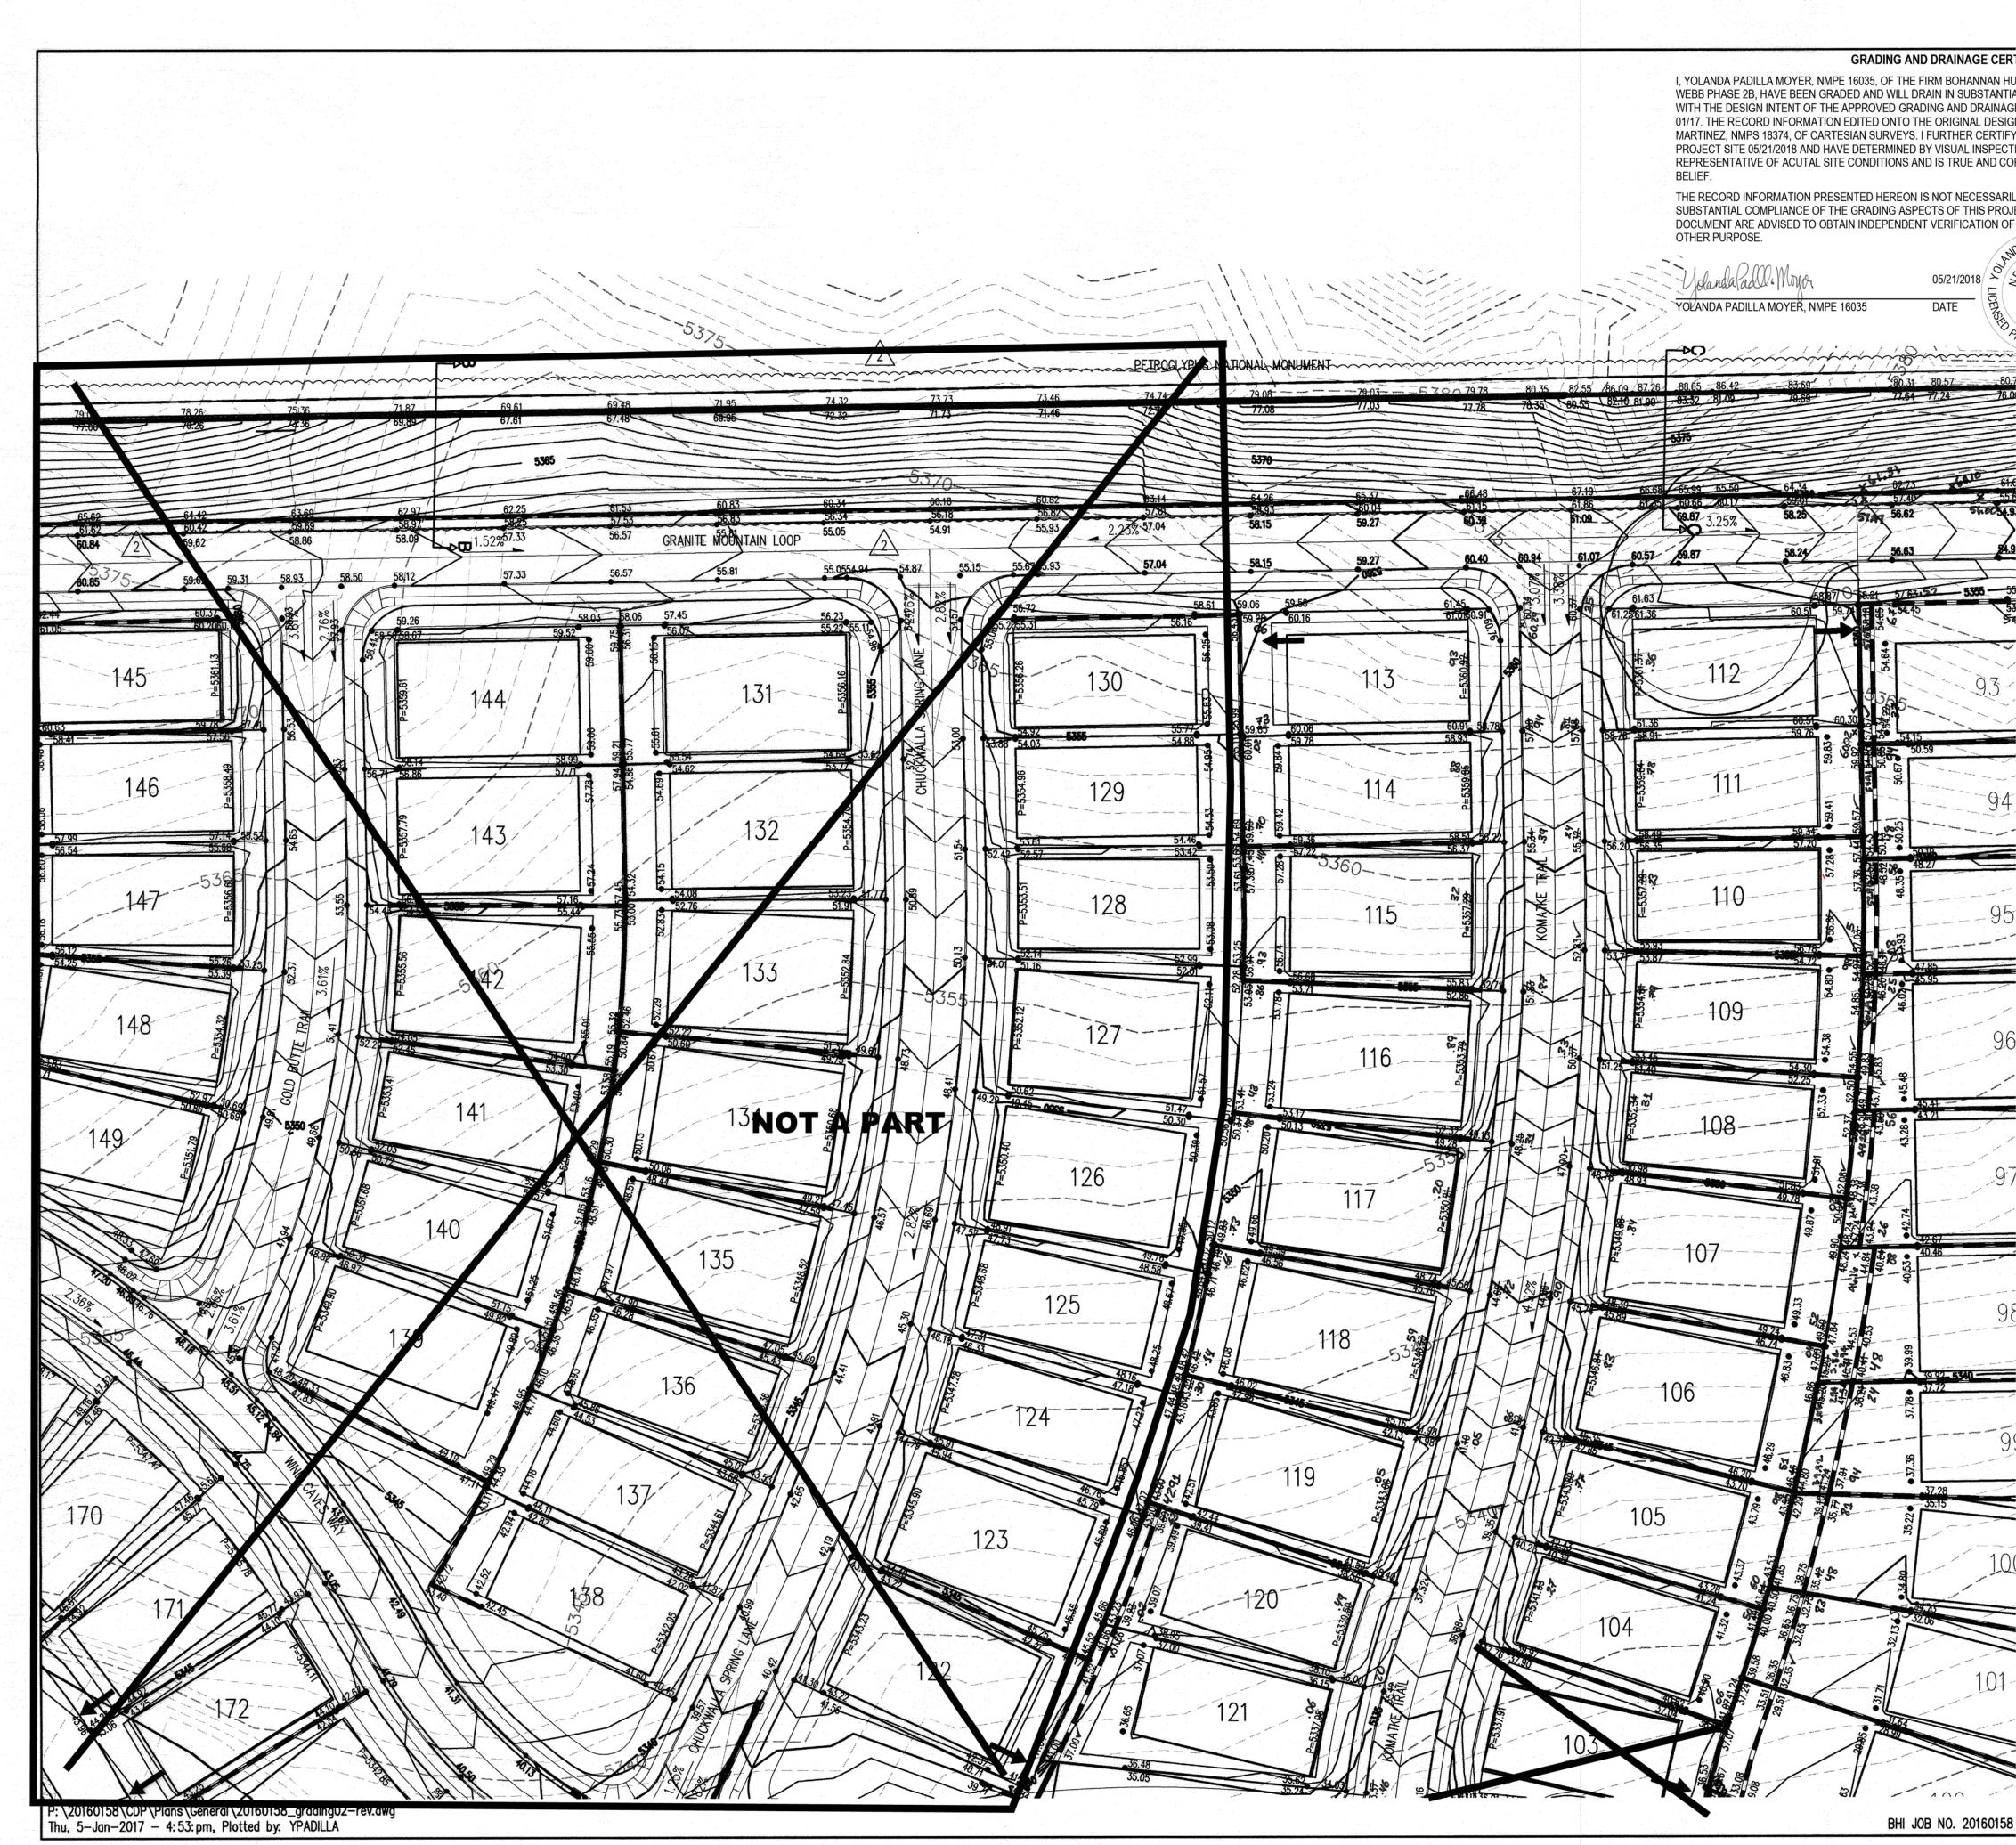

I, YOLANDA PADILLA MOYER, NMPE 16035, OF THE FIRM BOHANNAN HUSTON, HEREBY CERTIFY LOTS 112-113 at DEL LEGEND WEBB PHASE 2B, HAVE BEEN GRADED AND WILL DRAIN IN SUBSTANTIAL COMPLIANCE WITH AND IN ACCORDANCE WITH THE DESIGN INTENT OF THE APPROVED GRADING AND DRAINAGE PLAN DATED 03-11-16, REV#1 08/16 AND REV#2 PROPOSED SPOT ELEVATION • 5235.25 01/17. THE RECORD INFORMATION EDITED ONTO THE ORIGINAL DESIGN DOCUMENT HAS BEEN PROVIDED BY BRIAN J. MARTINEZ, NMPS 18374, OF CARTESIAN SURVEYS. I FURTHER CERTIFY THAT I HAVE PERSONALLY VISITED THE • EX 5235.25 EXISTING SPOT ELEVATION PROJECT SITE 05/21/2018 AND HAVE DETERMINED BY VISUAL INSPECTION THAT THE DATA PROVIDED IS REPRESENTATIVE OF ACUTAL SITE CONDITIONS AND IS TRUE AND CORRECT TO THE BEST OF MY KNOWLEDGE AND PROPOSED CONTOUR \_\_\_\_ EXISTING STORM DRAIN LINE THE RECORD INFORMATION PRESENTED HEREON IS NOT NECESSARILY COMPLETE AND INTENEDED ONLY TO VERIFY SUBSTANTIAL COMPLIANCE OF THE GRADING ASPECTS OF THIS PROJECT. THOSE RELYING ON THE RECORD PROPOSED STORM DRAIN INLET DOCUMENT ARE ADVISED TO OBTAIN INDEPENDENT VERIFICATION OF ITS ACCURACY BEFORE USING IT FOR ANY PROPOSED STORM DRAIN LINE 0 PROPOSED STORM DRAIN MANHOLE 05/21/2018  $\sim\sim\sim\sim\sim\sim\sim\sim$ PROPOSED WATER BLOCK Constant Contractor Streetwork RETAINING WALL 10 the state of the second st PAD P=5300.00 TURNED BLOCK TB / 71.54 74.82 80.31 80.57 80.73 78 18 XX STREET SLOPE 668 CONTRACTOR SHALL INSTALL 7' WIDE 1' DEEP SWALE ALONG THE NORTHSIDE OF MIREHAVEN ARROYO MAINTENANCE ROAD FROM LOT 158 TO PEDESTRIAN TRAIL BETWEEN LOTS 166/167, - 5355 -AN 8' WIDE 1' DEEP SWALE FROM LOT 167 TO 0 Z U THE PEDESTRIAN TRAIL BETWEEN LOTS 174/175 AND A 12' WIDE 1.5' DEEP SWALE FROM LOT 175 TO POND WEST OF WILLOW CANYON. CONTRACTOR SHALL INSTALL 8' WIDE 1' DEEP SWALE ALONG THE NORTHSIDE OF MIREHAVEN ARROYO MAINTENANCE ROAD FROM LOT 1 TO POND BEHIND LOT 15. CONTRACTOR SHALL INSTALL 7' WIDE 1' DEEP SWALE ALONG THE BACKSIDE OF LOT 23 TO LOT 27 AND FROM THE POND AT LOT 16 TO LOT 22. SWALE LOCATION VARIES BEHIND LOTS 9-11 AND 172-174. SEE PLAN FOR LOCATION SWALE SHALL BE 12" OF 95% COMPACTION WITH FILTER FABRIC AND 1" TO 2" FRACTURED COBBLE <u>үРМ</u> WALL: DS W N SCALE: 1"=40' Bohannan 🛦 Huston 800.877.5332 www.bhinc.com CITY OF ALBUQUERQUE DEPARTMENT OF MUNICIPAL DEVELOPMENT DEL WEBB @ MIREHAVEN PHASE 2 GRADING PLAN DESIGN REVIEW COMMITTEE MO./DAY/YR. MO./DAY/YR. CITY ENGINEER APPROVAL

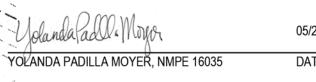

### **GRADING AND DRAINAGE CERTIFICATION**

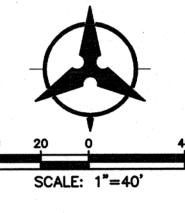

ROFFESION

DATE

			ast design update			
<b>y</b> 1	CITY PROJECT NO.	ZONE MAP	NO.	 SHEET	7	OF

# Bohannan 🛦 Huston

May 21, 2018

Courtyard I 7500 Jefferson St. NE Albuquerque, NM 87109-4335

www.bhinc.com

voice: 505.823.1000 facsimile: 505.798.7988 toll free: 800.877.5332

Mr. Dana Peterson Hydrology Section City of Albuquerque 600 2<sup>nd</sup> Street NW Albuquerque, NM 87102

Re: Partial Grading and Drainage Certification (Lots 112-113) Del Webb @ Mirehaven Phase 2B - DRB Case No. 1006864

Dear Dana:

We are submitting a partial grading and drainage certification for Del Webb @ Mirehaven Phase 2B. The partial certification includes Lots 112-113. Enclosed for your review is the approved grading and drainage plan dated 03/11/16, rev #1 08/16, rev#2 01/17. These lots have been graded; retaining walls, curb and gutter, pavement and downstream infrastructure have been constructed. The remaining lots have been graded, but the retaining walls have not been completed. The remaining lots will be certified once construction of all improvements has been completed.

After reviewing these as-built elevations and visiting the site on 05-21-18. It is my belief that the above lots have been graded in substantial compliance with the approved grading and drainage plan and that the interim drainage improvements allow runoff to be managed in the interim condition.

Your review and approval is requested for Building Permit Approval for the above listed buildings. I appreciate your time and consideration. If you have questions or require additional information, please contact me at 823-1000.

Sincerely,

Yolanda adl. Morpor

Yolanda Padilla Moyer, P.E. Senior Project Manager Community Development & Planning

Enclosure

cc: Kevin Patton, Pulte Homes

- Engineering **A**
- Spatial Data 🔺
- Advanced Technologies **A**



## City of Albuquerque

Planning Department Development & Building Services Division DRAINAGE AND TRANSPORTATION INFORMATION SHEET (REV 3/2018)

Project Title: DEL WEBB @ MIREHAVEN PHASE 2B	Building Permit	#: Hydrology File #: H-9					
DRB#: 1006864	EPC#:	Work Order#: 650480					
Legal Description: Del Webb Phase 2B at Mireha	aven						
City Address:							
Applicant: BOHANNAN HUSTON INC		Contact: Yolanda Mover					
Address: 7500 JEFFERSON ST NE COURTYARD 1		Contact: Yolanda Moyer					
Phone#: 798-7945	Fax#: 190-1900	E-mail: ypadilla@bhinc.com					
Other Contact:		Contact:					
Address:							
		E-mail:					
Check all that Apply:		IS THIS A RESUBMITTAL?: Yes No					
DEPARTMENT: X HYDROLOGY/ DRAINAGE TRAFFIC/ TRANSPORTATION TYPE OF SUBMITTAL: X ENGINEER/ARCHITECT CERTIFICATION PAD CERTIFICATION CONCEPTUAL G & D PLAN CONCEPTUAL G & D PLAN GRADING PLAN DRAINAGE MASTER PLAN DRAINAGE REPORT FLOODPLAIN DEVELOPMENT PERMIT A ELEVATION CERTIFICATE CLOMR/LOMR TRAFFIC CIRCULATION LAYOUT (TCL) TRAFFIC IMPACT STUDY (TIS)	PPLIC	TYPE OF APPROVAL/ACCEPTANCE SOUGHT:   BUILDING PERMIT APPROVAL   CERTIFICATE OF OCCUPANCY   PRELIMINARY PLAT APPROVAL   SITE PLAN FOR SUB'D APPROVAL   SITE PLAN FOR BLDG. PERMIT APPROVAL   FINAL PLAT APPROVAL   SIA/ RELEASE OF FINANCIAL GUARANTEE   FOUNDATION PERMIT APPROVAL   GRADING PERMIT APPROVAL   AOVING PERMIT APPROVAL   AGRADING/ PAD CERTIFICATION					
OTHER (SPECIFY) PRE-DESIGN MEETING?		WORK ORDER APPROVAL CLOMR/LOMR FLOODPLAIN DEVELOPMENT PERMIT OTHER (SPECIFY)					

DATE SUBMITTED: 05-21-18

.....

By: YOLANDA PADILLA MOYER, P.E.

\_\_\_\_\_

COA STAFF:

ELECTRONIC SUBMITTAL RECEIVED:

FEE PAID:

.....