## CITY OF ALBUQUERQUE

*Planning Department* Brennon Williams, Director



Mayor Timothy M. Keller

December 27, 2020

Yolanda Padilla Moyer, PE Bohannan-Huston 7500 Jefferson St NE Courtyard I Albuquerque, NM 87109

RE: Inspiration Subdivision Request for Partial Pad Certification Lots 42-48, 84-89, 144, 240, 247-249, 226-227, 231-233 - Approved Grading Plan Stamp Date: 6/6/19 Certification Dated: 12/18/20 Drainage File: J08D005

Dear Ms. Padilla Moyer:

- PO Box 1293 Based on the submittal received on 12/23/20, this certification is approved for Building Permit for the lots listed above.
- Albuquerque Please note, Certificate of Occupancy will be held until Infrastructure improvements are complete.
- NM 87103 If you have any questions, please contact me at 924-3986 or earmijo@cabq.gov.

www.cabq.gov

Sincerely,

Ernest Armijo, P.E. Principal Engineer, Hydrology Planning Department Development Review Services

# Bohannan 🛦 Huston

December 18, 2020

Courtyard I 7500 Jefferson St. NE Albuquerque, NM 87109-4335

www.bhinc.com

voice: 505.823.1000 facsimile: 505.798.7988 toll free: 800.877.5332

Mr. Ernest Armijo, P.E. Hydrology Section City of Albuquerque 600 2<sup>nd</sup> Street NW Albuquerque, NM 87102

Re: Partial Grading and Drainage Certification (42-48, 84, 85-89, 144, 240, 247-249, 226-227, 231-233) Inspiration Subdivision); DRB Case No. PR- 2018-001759; Hydrology File J08D101

Dear Ernest,

We are submitting a partial grading and drainage certification for Inspiration Subdivision. The partial certification includes Lots 42-48, 84, 85-89, 144, 240, 247-249, 226-227, 231-233. Enclosed for your review is the approved grading and drainage plan dated 06/06/19. These lots have been graded; retaining walls and curb and gutter and asphalt have been constructed. Five lots, lots 84, 86-88 and 144, have been dug and banded, however, based off of the as-built survey and the site walk through, it appears that those lots were properly graded prior to forming the frame for the pads.

After reviewing these as-built elevations and visiting the site on 12-18-2020 it is my belief that the above lots have been graded in substantial compliance with the approved grading and drainage plan and that the interim drainage improvements allow runoff to be managed in the interim condition.

Your review and approval is requested for Building Permit Approval for the above listed buildings. I appreciate your time and consideration. If you have questions or require additional information, please contact me at 823-1000.

Sincerely,

Jolanda adl. Moreor

Yólanda Padilla Moyer, P.E. Vice President Community Development & Planning

Enclosure

cc: Kevin Patton, Pulte Homes Brian Anderson, Pulte Homes

- Engineering **A**
- Spatial Data 🔺
- Advanced Technologies **A**



## City of Albuquerque

Planning Department Development & Building Services Division DRAINAGE AND TRANSPORTATION INFORMATION SHEET (REV 11/2018)


	Hydrology File #: Work Order#:
SUBDIVISION	
	Contact: Yolanda Moyer
Fax#:	E-mail: ypadilla@bhinc.com
	Contact: KEVIN PATTON
0 ALBUQ. NM 87109	
Fax#:	E-mail: kevin.patton@pultegroup.com
	B SITE ADMIN SITE
	RAINAGE
X BUILDING CERTIFICA PRELIMINA SITE PLAN SITE PLAN FINAL PLA FINAL PLA SIA/ RELEA APPLIC FOUNDATI GRADING SO-19 APPI PAVING PH X GRADING/ CLOMR/LC	ASE OF FINANCIAL GUARANTEE ION PERMIT APPROVAL PERMIT APPROVAL ROVAL ERMIT APPROVAL PAD CERTIFICATION DER APPROVAL
	LOTS) RESIDENCE DRI es No TATION X HYDROLOGY/ DI TYPE OF APPR X BUILDING CERTIFICA PRELIMINA SITE PLAN SITE PLAN SITE PLAN SITE PLAN SITE PLAN GRADING GRADING SO-19 APP N PAVING PI X GRADING/ WORK ORE CLOMR/LC

DATE SUBMITTED: 12-18-2020


By: <u>Yolanda Padilla M</u>oyer, P.E.


ELECTRONIC SUBMITTAL RECEIVED:

FEE PAID:

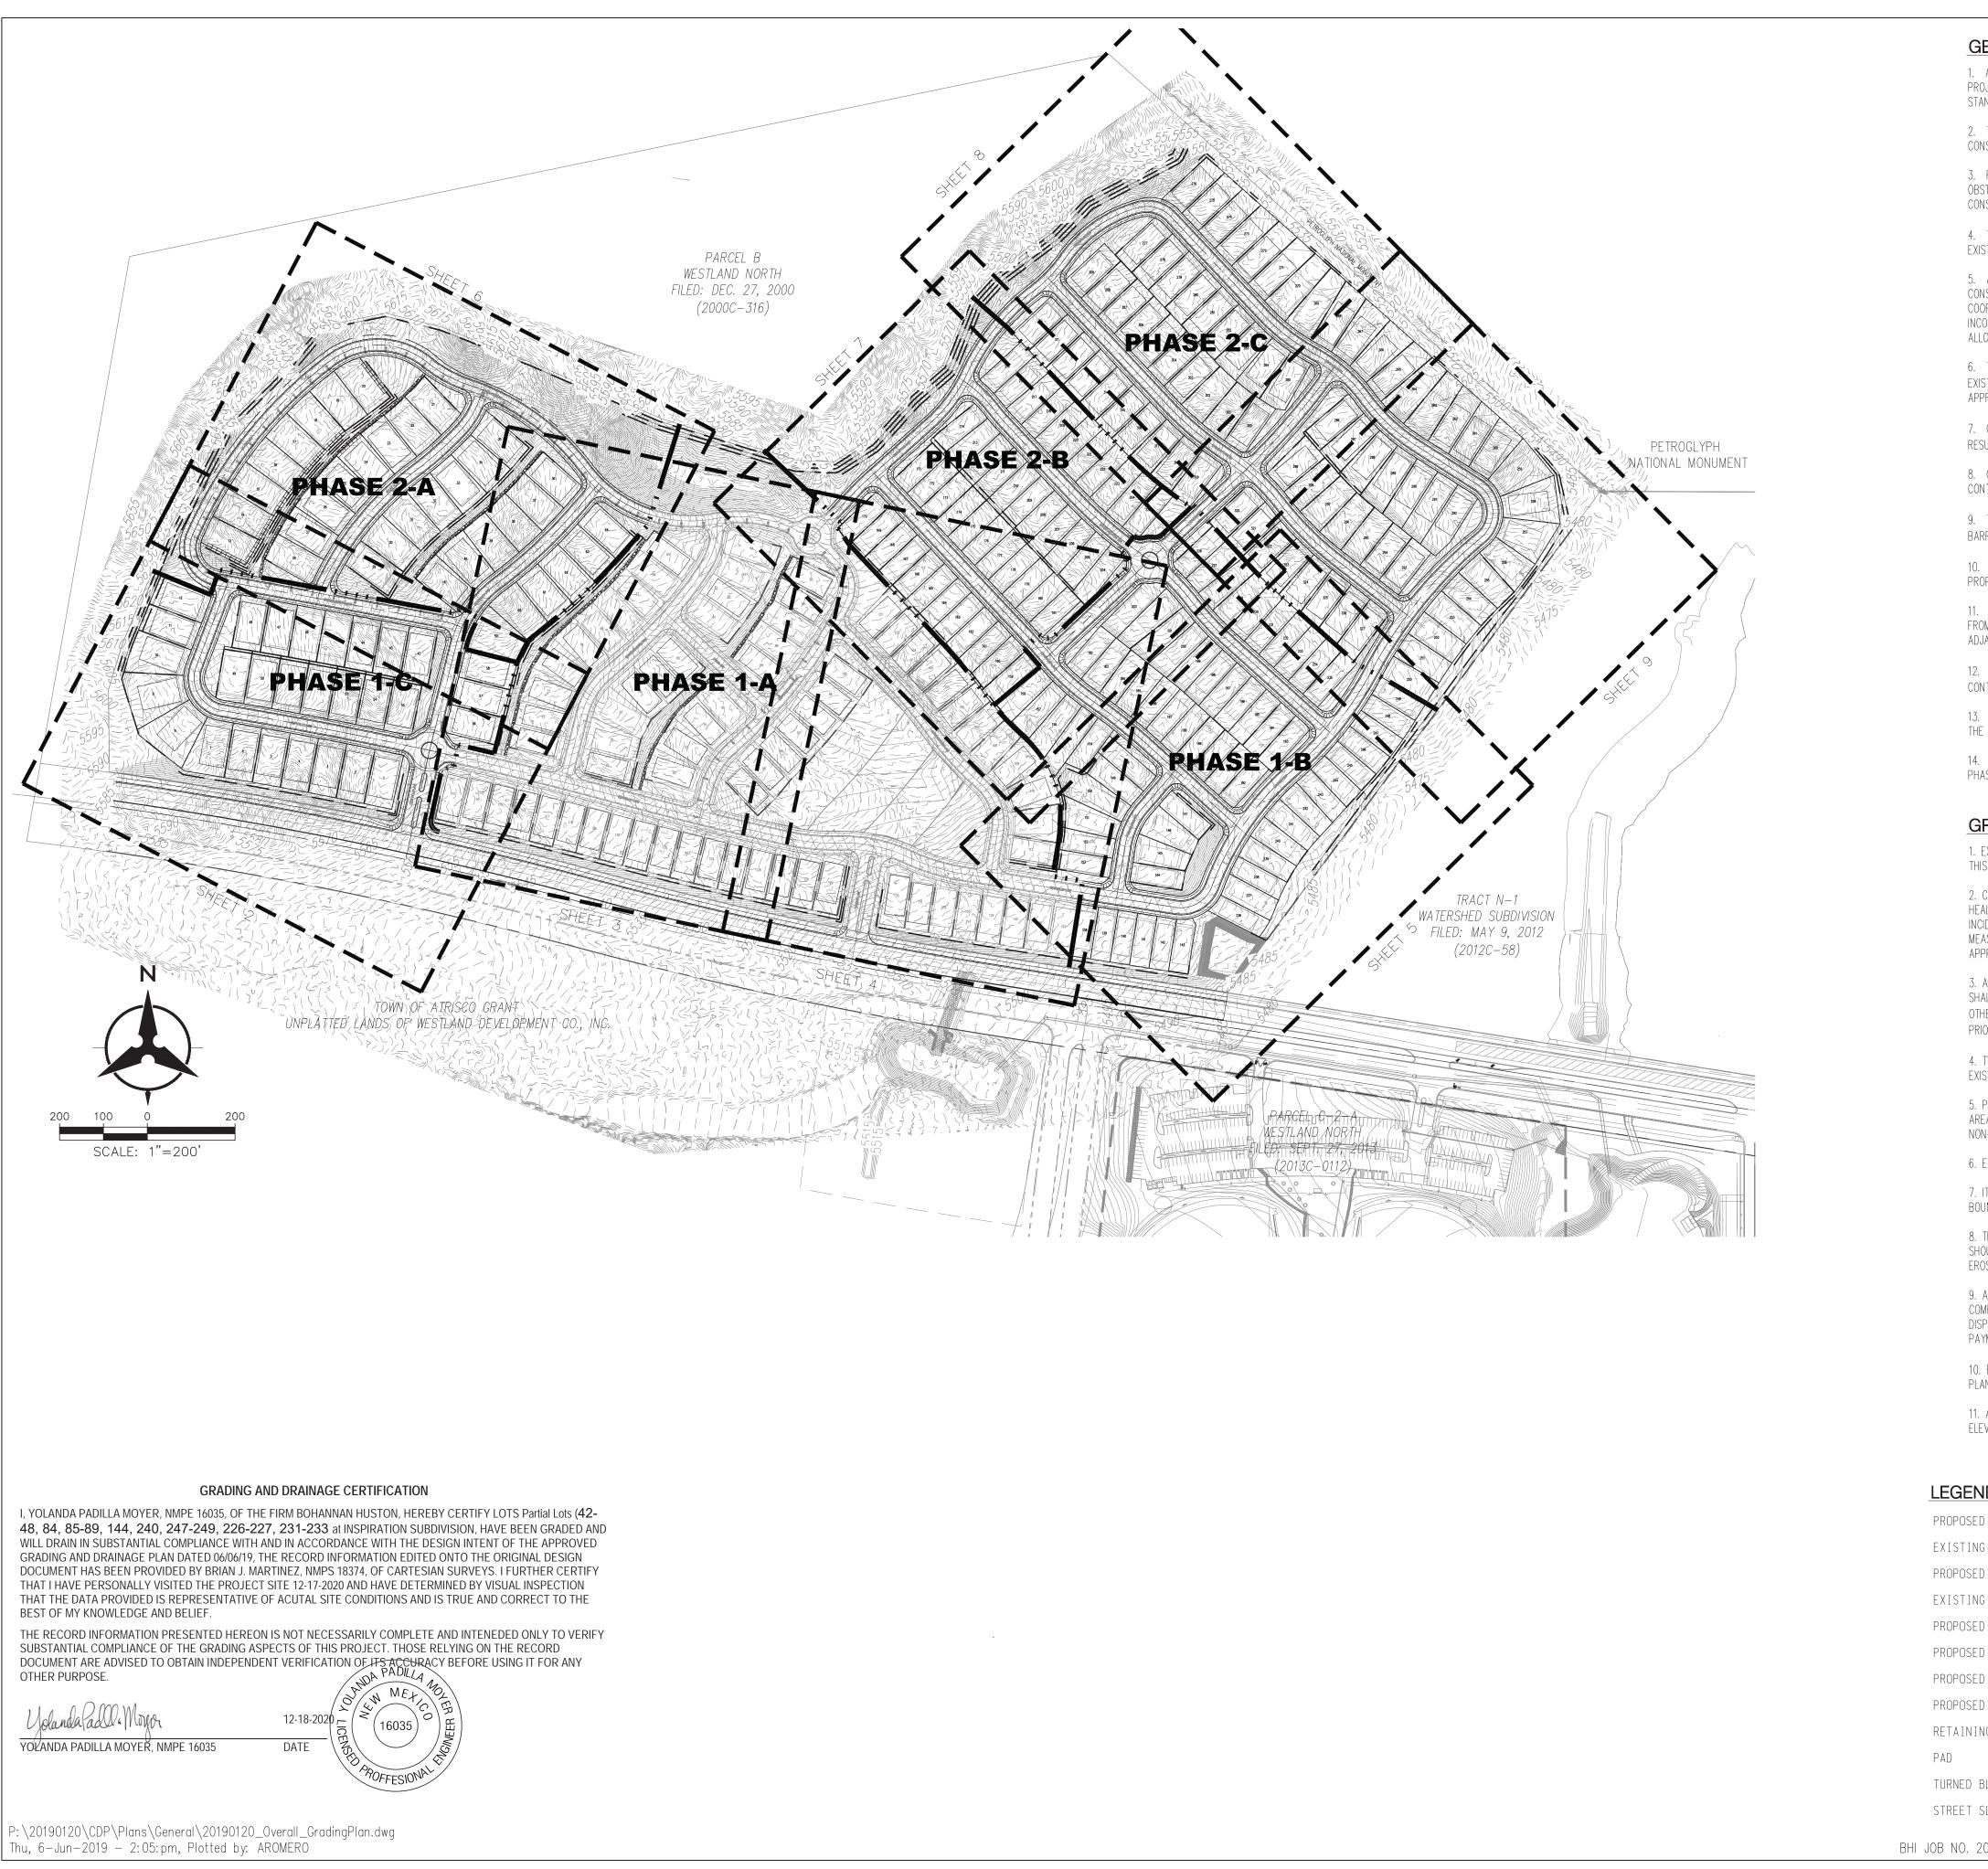


GENERAL NOTES 1. ALL WORK DETAILED ON THESE PLANS AND PERFORMED UNDER THIS CONTRACT SHALL BE CONSTRUCTED IN ACCORDANCE WITH THE	TION	DATE	DATE	DATE	DATE	ATE	ATION	ATE	ATE
PROJECT SPECIFICATIONS AND THE PROJECT GEOTECHNICAL REPORT. WHERE APPLICABLE, CITY OF ALBUQUERQUE PUBLIC WORKS STANDARDS SHALL APPLY.	DRMA	DA	DA	DA	DA	DA	FORM	DA	DA
2. THE CONTRACTOR SHALL ABIDE BY ALL LOCAL, STATE, AND FEDERAL LAWS, RULES AND REGULATIONS WHICH APPLY TO THE CONSTRUCTION OF THESE IMPROVEMENTS, INCLUDING EPA REQUIREMENTS WITH RESPECT TO STORM WATER DISCHARGE. 3. PRIOR TO CONSTRUCTION, THE CONTRACTOR SHALL FIELD VERIFY THE HORIZONTAL AND VERTICAL LOCATIONS OF ALL POTENTIAL	LINF.						MINI		
OBSTRUCTIONS INCLUDING ALL UNDERGROUND UTILITIES. SHOULD A CONFLICT EXIST, THE CONTRACTOR SHALL NOTIFY THE CONSTRUCTION OBSERVER OR ENGINEER SO THAT THE CONFLICT CAN BE RESOLVED WITH A MINIMUM AMOUNT OF DELAY.	BUILT	JR		S CE BY		m		ВY	
4. TWO (2) WORKING DAYS PRIOR TO ANY EXCAVATION, THE CONTRACTOR SHALL CONTACT LINE LOCATING SERVICE FOR LOCATION OF EXISTING UTILITIES.	AS-	ONTRACTOR	WORK STAKED BY	SPECTOR'S	0	RAWINGS	<b>MICR(</b>	RECORDED	
5. ALL ELECTRICAL, TELEPHONE, CABLE TV, GAS AND OTHER UTILITY LINES, CABLES, AND APPURTENANCES ENCOUNTERED DURING CONSTRUCTION THAT REQUIRE RELOCATION, SHALL BE COORDINATED WITH THAT UTILITY. THE CONTRACTOR SHALL BE RESPONSIBLE FOR COORDINATION OF ALL NECESSARY UTILITY ADJUSTMENTS. NO ADDITIONAL COMPENSATION WILL BE ALLOWED FOR DELAYS OR INCONVENIENCES CAUSED BY UTILITY COMPANY WORK CREWS. THE CONTRACTOR MAY BE REQUIRED TO RESCHEDULE HIS ACTIVITIES TO ALLOW UTILITY CREWS TO PERFORM THEIR REQUIRED WORK.		EWARD 1969" CO	8TC ST	AC		DR		RE	OZ
6. THE CONTRACTOR IS RESPONSIBLE FOR PROTECTING ALL EXISTING UTILITY LINES WITHIN THE CONSTRUCTION AREA. ANY DAMAGE TO EXISTING FACILITIES CAUSED BY CONSTRUCTION ACTIVITY SHALL BE REPAIRED OR REPLACED AT THE CONTRACTOR'S EXPENSE AND APPROVED BY THE CONSTRUCTION OBSERVER.	RKS	۳. ۲	83)	ATES		819	99675005	26"	319.688
7. CONSTRUCTION ACTIVITY SHALL BE LIMITED TO THE PROPERTY AND/OR PROJECT LIMITS. ANY DAMAGE TO ADJACENT PROPERTIES RESULTING FROM THE CONSTRUCTION PROCESS SHALL BE REPAIRED OR REPLACED AT THE CONTRACTOR'S EXPENSE.	MAR	STAMPED	N (NAD	COORDINATE		491190.8	0.99967	0"17"12.2	N = 531
8. OVERNIGHT PARKING OF CONSTRUCTION EQUIPMENT SHALL NOT OBSTRUCT DRIVEWAYS OR DESIGNATED TRAFFIC LANES. THE CONTRACTOR SHALL NOT STORE ANY EQUIPMENT OR MATERIAL WITHIN THE PUBLIC RIGHT-OF-WAY.	ENCH	DISC	<b>OSITION</b>	ANE	E)	3 E=14	GRID = (	00 - =	EVATION
9. THE CONTRACTOR SHALL OBTAIN ALL THE NECESSARY PERMITS FOR THE PROJECT PRIOR TO COMMENCING CONSTRUCTION (I.E., BARRICADING, TOPSOIL DISTURBANCE, EXCAVATION PERMITS, EPA STORM WATER PERMITS, ETC.).	B	BRAS	ЦС	TATE PL	AL ZONE)	364.06	0L	ALPHA	988 EL
10. ALL PROPERTY CORNERS DESTROYED DURING CONSTRUCTION SHALL BE REPLACED AT THE CONTRACTOR'S EXPENSE. ALL PROPERTY CORNERS MUST BE RESET BY A REGISTERED LAND SURVEYOR.		USC&GS	GEOGRA	N.M. ST.	CENTRAL	=1487	GROUND	DELTA /	NAVD 19
11. THE CONTRACTOR SHALL PREPARE A CONSTRUCTION TRAFFIC CONTROL AND SIGNING PLAN AND OBTAIN APPROVAL OF SUCH PLAN FROM THE CITY OF ALBUQUERQUE, TRAFFIC ENGINEERING DEPARTMENT, PRIOR TO BEGINNING ANY CONSTRUCTION WORK ON OR			A TE			Z	0		
ADJACENT TO EXISTING STREETS. 12. ALL BARRICADES AND CONSTRUCTION SIGNING SHALL CONFORM TO APPLICABLE SECTIONS OF THE "MANUAL ON UNIFORM TRAFFIC	ATION	( ^	Ô						
CONTROL DEVICES" (MUTCD), US DEPARTMENT OF TRANSPORTATION, LATEST EDITION. 13. THE CONTRACTOR SHALL MAINTAIN ALL CONSTRUCTION BARRICADES AND SIGNING AT ALL TIMES. THE CONTRACTOR SHALL VERIFY	ORM	NOTES							
THE PROPER LOCATION OF ALL BARRICADING AT THE END AND BEGINNING OF EACH DAY. 14. THE CONTRACTOR SHALL TAKE ALL STEPS NECESSARY TO CONFORM WITH EPA REQUIREMENTS, INCLUDING COMPLIANCE WITH NPDES	× INF	ELD	Β						
PHASE 2 REQUIREMENTS.	JR VE								
GRADING NOTES 1. EXCEPT AS PROVIDED HERIN, GRADING SHALL BE PERFORMED AT THE ELEVATIONS AND IN ACCORDANCE WITH THE DETAILS SHOWN ON	SU		NO						
THIS PLAN. 2. CONTRACTOR SHALL OBTAIN AND ABIDE BY A TOPSOIL DISTURBANCE PERMIT FROM THE CITY OF ALBUQUERQUE ENVIRONMENTAL	AL			/	PA				
HEALTH DIVISION, PRIOR TO CONSTRUCTION. THE COST FOR REQUIRED CONSTRUCTION DUST AND EROSION CONTROL MEASURES SHALL BE INCIDENTAL TO THE PROJECT COST. THE CONTRACTOR SHALL CONFORM TO ALL CITY, COUNTY, STATE, AND FEDERAL DUST CONTROL MEASURES AND REQUIREMENTS AND WILL BE RESPONSIBLE FOR PREPARING AND OBTAINING ALL NECESSARY APPLICATIONS AND	S SE	Y	di		N	MA	A A	論	h
APPROVALS. 3. ALL WORK RELATIVE TO FOUNDATION CONSTRUCTION, SITE PREPARATION, AND PAVEMENT INSTALLATION, AS SHOWN ON THIS PLAN,	EER'	(	SICENO		10416	039	Jer 1	MOINEE	01
SHALL BE CONSTRUCTED IN ACCORDANCE WITH THE SOILS REPORT PREPARED BY NV5 DATED DEC. 11, 2018. ALL OTHER WORK, UNLESS OTHERWISE STATED OR PROVIDED FOR HEREON, SHALL BE CONSTRUCTED IN ACCORDANCE WITH THE PROJECT SPECIFICATIONS (FIRST PRIORITY), AND/OR THE CITY OF ALBUQUERQUE (COA) STANDARD SPECIFICATIONS FOR PUBLIC WORKS (SECOND PRIORITY).	ENGINE		X	C	PAR-	ESIO	WAY	/	
4. TWO WORKING DAYS PRIOR TO EXCAVATION, CONTRACTOR MUST CONTACT LINE LOCATING SERVICE (765–1264) FOR LOCATION OF EXISTING UTILITIES.					$\succ$				
5. PRIOR TO GRADING, ALL VEGETATION DEBRIS, AND NEAR SURFACE ORGANICALLY CONTAMINATED SOIL SHALL BE STRIPPED FROM ALL AREAS TO BE GRADED. VEGETATION AND DEBRIS SHALL BE DISPOSED OF OFF—SITE OR STOCK—PILED FOR USE IN PLANTERS AND NON—STRUCTURAL FILLS.					Ξ			E11/18	E11/18 F11/18
6. EARTH SLOPES SHALL NOT EXCEED 4 HORIZONTAL TO 1 VERTICAL UNLESS SHOWN OTHERWISE.								DAT	DAT
7. IT IS THE INTENT OF THESE PLANS THAT THIS CONTRACTOR SHALL NOT PERFORM ANY WORK OUTSIDE OF THE PROPERTY BOUNDARIES EXCEPT AS REQUIRED BY THIS PLAN.									
8. THE CONTRACTOR IS TO ENSURE THAT NO SOIL ERODES FROM THE SITE ONTO ADJACENT PROPERTY OR PUBLIC RIGHT-OF-WAY. THIS SHOULD BE ACHIEVED BY CONSTRUCTING TEMPORARY BERMS AT THE PROPERTY LINES WETTING THE SOIL TO PROTECT IT FROM WIND EROSION.					RKS	S			
9. A DISPOSAL SITE FOR ALL EXCESS EXCAVATION AND UNSUITABLE MATERIAL SHALL BE OBTAINED BY THE CONTRACTOR IN COMPLIANCE WITH APPLICABLE ENVIRONMENTAL REGULATIONS AND APPROVED BY THE OBSERVER. ALL COSTS INCURRED IN OBTAINING A DISPOSAL SITE AND HAUL THERETO SHALL BE CONSIDERED INCIDENTAL TO THE PROJECT, AND NO SEPARATE MEASUREMENT OR PAYMENT SHALL BE MADE.					REMA	REVISION	DESIGN		
					.				
10. PAVING AND ROADWAY GRADES SHALL BE +/– 0.1'FROM PLAN ELEVATIONS. PAD ELEVATION SHALL BE +/– 0.05'FROM BUILDING PLAN ELEVATIONS. 11. ALL SPOT ELEVATIONS ARE TO FLOWLINE UNLESS OTHERWISE NOTED. VALLEY GUTTER ELEVATIONS ARE SHOWN AT FLOWLINE ELEVATION.								Ψ	
PLAN ELEVATIONS. 11. ALL SPOT ELEVATIONS ARE TO FLOWLINE UNLESS OTHERWISE NOTED. VALLEY GUTTER ELEVATIONS ARE SHOWN AT FLOWLINE ELEVATION.					A TE			ВҮ ҮРМ	AR XD AR
PLAN ELEVATIONS. 11. ALL SPOT ELEVATIONS ARE TO FLOWLINE UNLESS OTHERWISE NOTED. VALLEY GUTTER ELEVATIONS ARE SHOWN AT FLOWLINE					D. DATE			ж	BY AR
PLAN ELEVATIONS. 11. ALL SPOT ELEVATIONS ARE TO FLOWLINE UNLESS OTHERWISE NOTED. VALLEY GUTTER ELEVATIONS ARE SHOWN AT FLOWLINE ELEVATION. END SED SPOT ELEVATION • 5235.25 • EX 5235.25 • EX 5235.25 • EX 5235.25					NO. DATE			SIGNED BY	AR XD AR
PLAN ELEVATIONS. 11. ALL SPOT ELEVATIONS ARE TO FLOWLINE UNLESS OTHERWISE NOTED. VALLEY GUTTER ELEVATIONS ARE SHOWN AT FLOWLINE ELEVATION. END SED SPOT ELEVATION ING SPOT ELEVATION SED CONTOUR ING STORM DRAIN LINE SED STORM DRAIN LINE			<b>5</b> 1	U	<b>E</b> NO. DATE			SIGNED BY	AWN BY AR
PLAN ELEVATIONS. 11. ALL SPOT ELEVATIONS ARE TO FLOWLINE UNLESS OTHERWISE NOTED. VALLEY GUTTER ELEVATIONS ARE SHOWN AT FLOWLINE ELEVATION. END SED SPOT ELEVATION SED SPOT ELEVATION SED CONTOUR SED STORM DRAIN LINE SED STORM DRAIN INLET SED STORM DRAIN STORM STORM STORM STORM STORM STORM STORM STORM STOR	EN	T	<b>5</b> 1	U	<b>E</b> NO. DATE			SIGNED BY	AWN BY AR
PLAN ELEVATIONS. 11. ALL SPOT ELEVATIONS ARE TO FLOWLINE UNLESS OTHERWISE NOTED. VALLEY GUTTER ELEVATIONS ARE SHOWN AT FLOWLINE ELEVATION SED SPOT ELEVATION SED STORM DRAIN LINE SED STORM DRAIN MANHOLE SED ST	EN ION	Ť						DESIGNED BY	DRAWN BY AR
PLAN ELEVATIONS. 11. ALL SPOT ELEVATIONS ARE TO FLOWLINE UNLESS OTHERWISE NOTED. VALLEY GUTTER ELEVATIONS ARE SHOWN AT FLOWLINE ELEVATION. END SED SPOT ELEVATION • 5235.25 SED CONTOUR • 5225 SED CONTOUR • 5225 SED STORM DRAIN LINE SED STORM DRAIN LINE SED STORM DRAIN LINE SED STORM DRAIN MANHOLE SED STORM DRAIN MANHOLE SED WATER BLOCK • CITY ENGINEER APPROVAL		Ť	<b>Q</b> <sup>1</sup>				)./DA	DESIGNED BY	DRAWN BY AR
PLAN ELEVATIONS. 11. ALL SPOT ELEVATIONS ARE TO FLOWLINE UNLESS OTHERWISE NOTED. VALLEY GUTTER ELEVATIONS ARE SHOWN AT FLOWLINE ELEVATION. END SED SPOT ELEVATION • 5235.25 SED CONTOUR • 5225 SED CONTOUR • 5225 SED STORM DRAIN LINE SED STORM DRAIN LINE SED STORM DRAIN LINE SED STORM DRAIN MANHOLE SED STORM DRAIN MANHOLE SED WATER BLOCK • CITY ENGINEER APPROVAL		Ť					)./DA	DESIGNED BY	DRAWN BY AR
PLAN ELEVATIONS. 11. ALL SPOT ELEVATIONS ARE TO FLOWLINE UNLESS OTHERWISE NOTED. VALLEY GUTTER ELEVATIONS ARE SHOWN AT FLOWLINE ELEVATION. END SED SPOT ELEVATION SED STORM DRAIN LINE SED STORM DRAIN LINE SED STORM DRAIN LINE SED STORM DRAIN LINE SED STORM DRAIN MANHOLE SED STORM DRAIN MANHOLE SED STORM DRAIN MANHOLE SED WATER BLOCK NING WALL 10 10 11 11 11 12 11 11 11 11 11 11		<b>Т</b>						DESIGNED BY	DRAWN BY AR

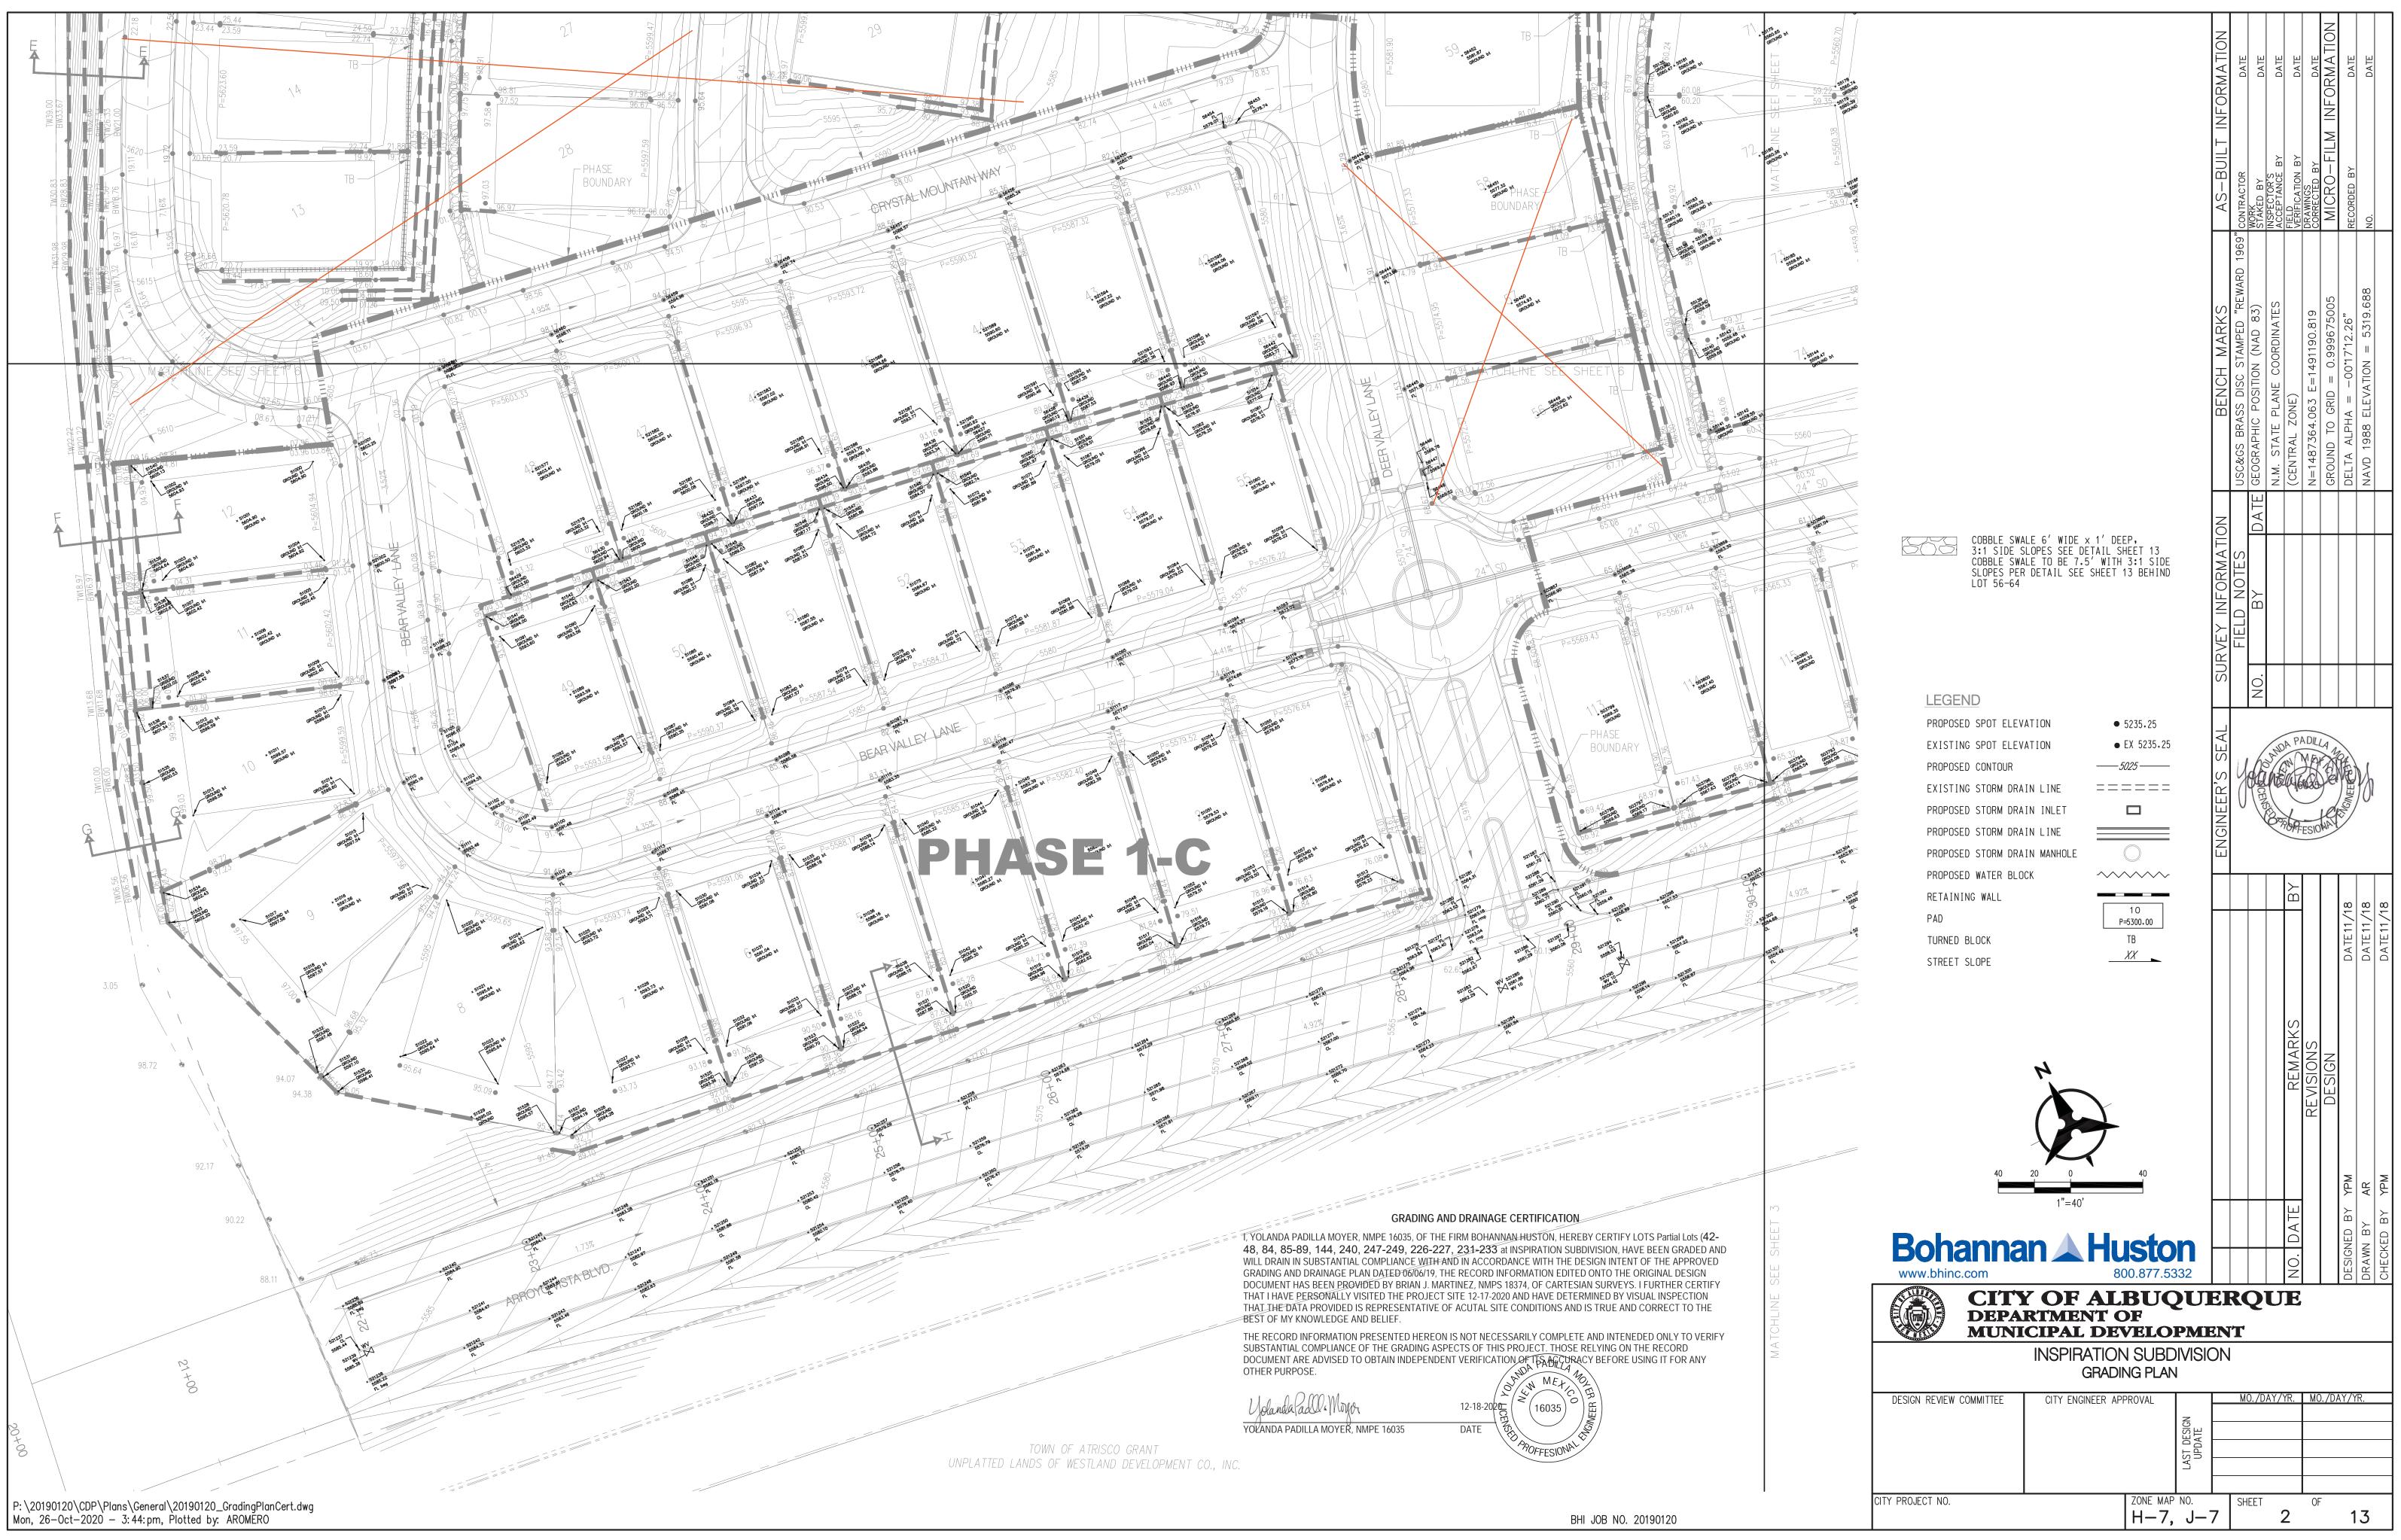

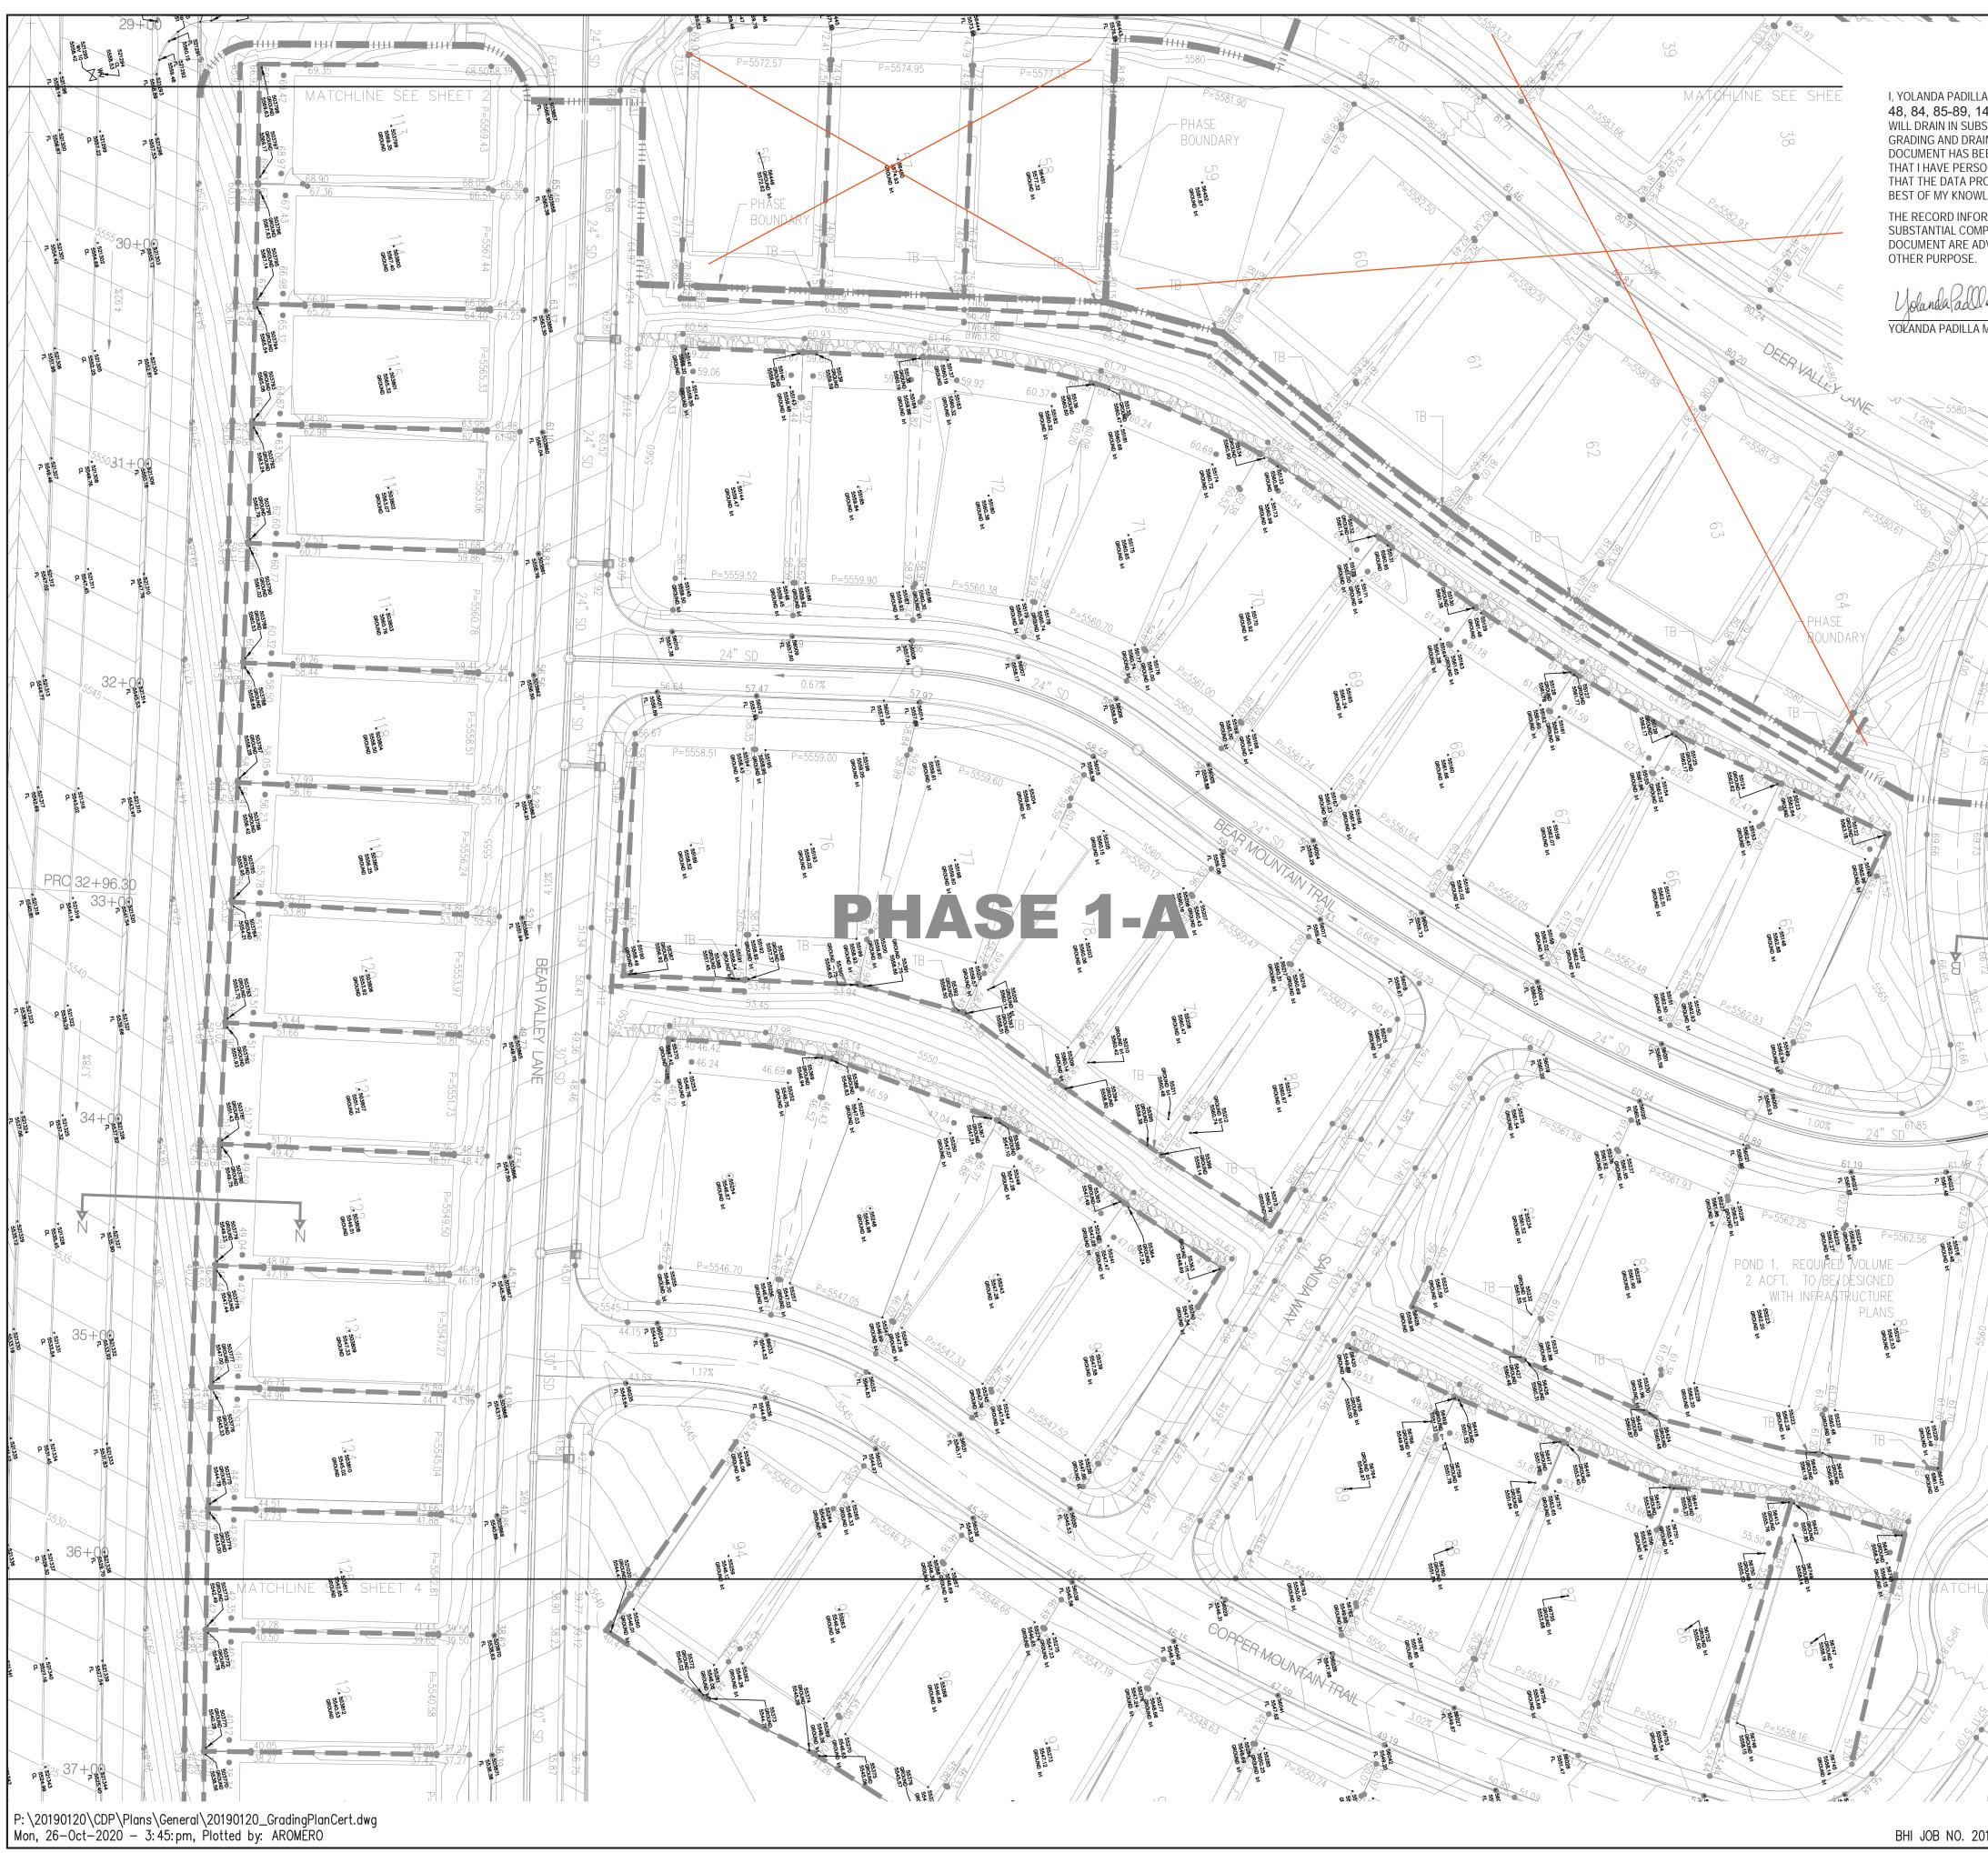

GRADING AND DRAINAGE CERTIFIC	ATION			ATION	DATE	DATE	DATE	DATE	<u>ATION</u>	DATE	
LA MOYER, NMPE 16035, OF THE FIRM BOHANNAN HUSTON 144, 240, 247-249, 226-227, 231-233 at INSPIRATION 3STANTIAL COMPLIANCE WITH AND IN ACCORDANCE WITH AINAGE PLAN DATED 06/06/19, THE RECORD INFORMATION 3EEN PROVIDED BY BRIAN J. MARTINEZ, NMPS 18374, OF C	ON SUBDIVISION, HAVE BEEN GRADE I THE DESIGN INTENT OF THE APPRO I EDITED ONTO THE ORIGINAL DESIG	D AND VED N		INFORM	Δ				INFORM		
SONALLY VISITED THE PROJECT SITE 12-17-2020 AND HAVE ROVIDED IS REPRESENTATIVE OF ACUTAL SITE CONDITIO VLEDGE AND BELIEF. DRMATION PRESENTED HEREON IS NOT NECESSARILY CO	E DETERMINED BY VISUAL INSPECTIO NS AND IS TRUE AND CORRECT TO T	N HE		-BUILT	OR	BY TOR'S			CT -	E D	
MPLIANCE OF THE GRADING ASPECTS OF THIS PROJECT.	THOSE RELYING ON THE RECORD			AS-	1 2 1	WURK STAKED BY INSPECTOR	FIELD VERIFICATION	DRAWINGS CORRECTE	MICR	NO.	
D. Mayor 12-18-2020 M M M A MOYER, NMPE 16035 DATE	DILLA HOLE USING TITOK AN				EWARD 1969						
PROFFEE	SIONAL			ARKS	D"R	(NAD 83) DRDINATES		491190.819	99675005 '12 26"	1 m	
				MCH NCH	DISC STAN			Ш Ш Ц Ц Ц	= 0.9		
22 (5575) (5575) (5575)				BF	s Brass			37364.063	ND TO GRID	1988 EL	
						TE GEOGR	(CENTRAL	N=148	GROUNI DEL TA	NAVD	
	COBBLE SWA 3:1 SIDE S	ALE 6' WIDE x 1' DEE SLOPES SEE DETAIL SF ALE TO BE 7.5' WITH ? DETAIL SEE SHEET 1	P, IEET 13 3.1 SIDE	ATION	ഗ	DA					
	SLOPES PEF LOT 56-64	R DETAIL SEE SHEET 1	3 BEHIND	INFORM		В					
				JRVEY	FIELI						
	LEGEND PROPOSED SPOT ELEV		5235.25	Ω Ω		N N					
	EXISTING SPOT ELEV PROPOSED CONTOUR	ATION •	EX 5235.25 <i>025</i> ———	S SEAL	Y	North State	DA P.	ADILL	enter enter	a le	
66.72 4:1	EXISTING STORM DRA PROPOSED STORM DRA PROPOSED STORM DRA	IN INLET		GINEER'	V	CENSER	and the state	ESIO	AL AL	10	
	PROPOSED STORM DRA PROPOSED WATER BLO										
	RETAINING WALL PAD TURNED BLOCK		10 5300.00 TB	-					DATE11 /18	$\langle \rangle$	DATE11/18
	STREET SLOPE		XX								DA
ANDE							ARKS	NS	_		
0925			•				REM	REVISIO	DESIG		
	40	20 0 1"=40'	40	-					May Ya	-	ВҮ ҮРМ
	Bohanna www.bhinc.com		<b>ISto</b> 0.877.53				NO. DA		DESIGNED	DRAWN BY	CHECKED
LINE SEE SHEET 4	CITY DEPA	Y OF AL RTMENT C CIPAL DE	BUQ	UE		<b>2</b> U	JE	<b>I</b>		<u> </u>	
HASE BOUNDARY		INSPIRATION									
53 43.73 56.14 56.14 56.04	DESIGN REVIEW COMMITTEE	CITY ENGINEER APF		LAST DESIGN UPDATE	МС	)./DAY,	/YR.	MO.	/DAY,	YR.	
20190120	CITY PROJECT NO.		ZONE MAP		SHE		3	OF		13	

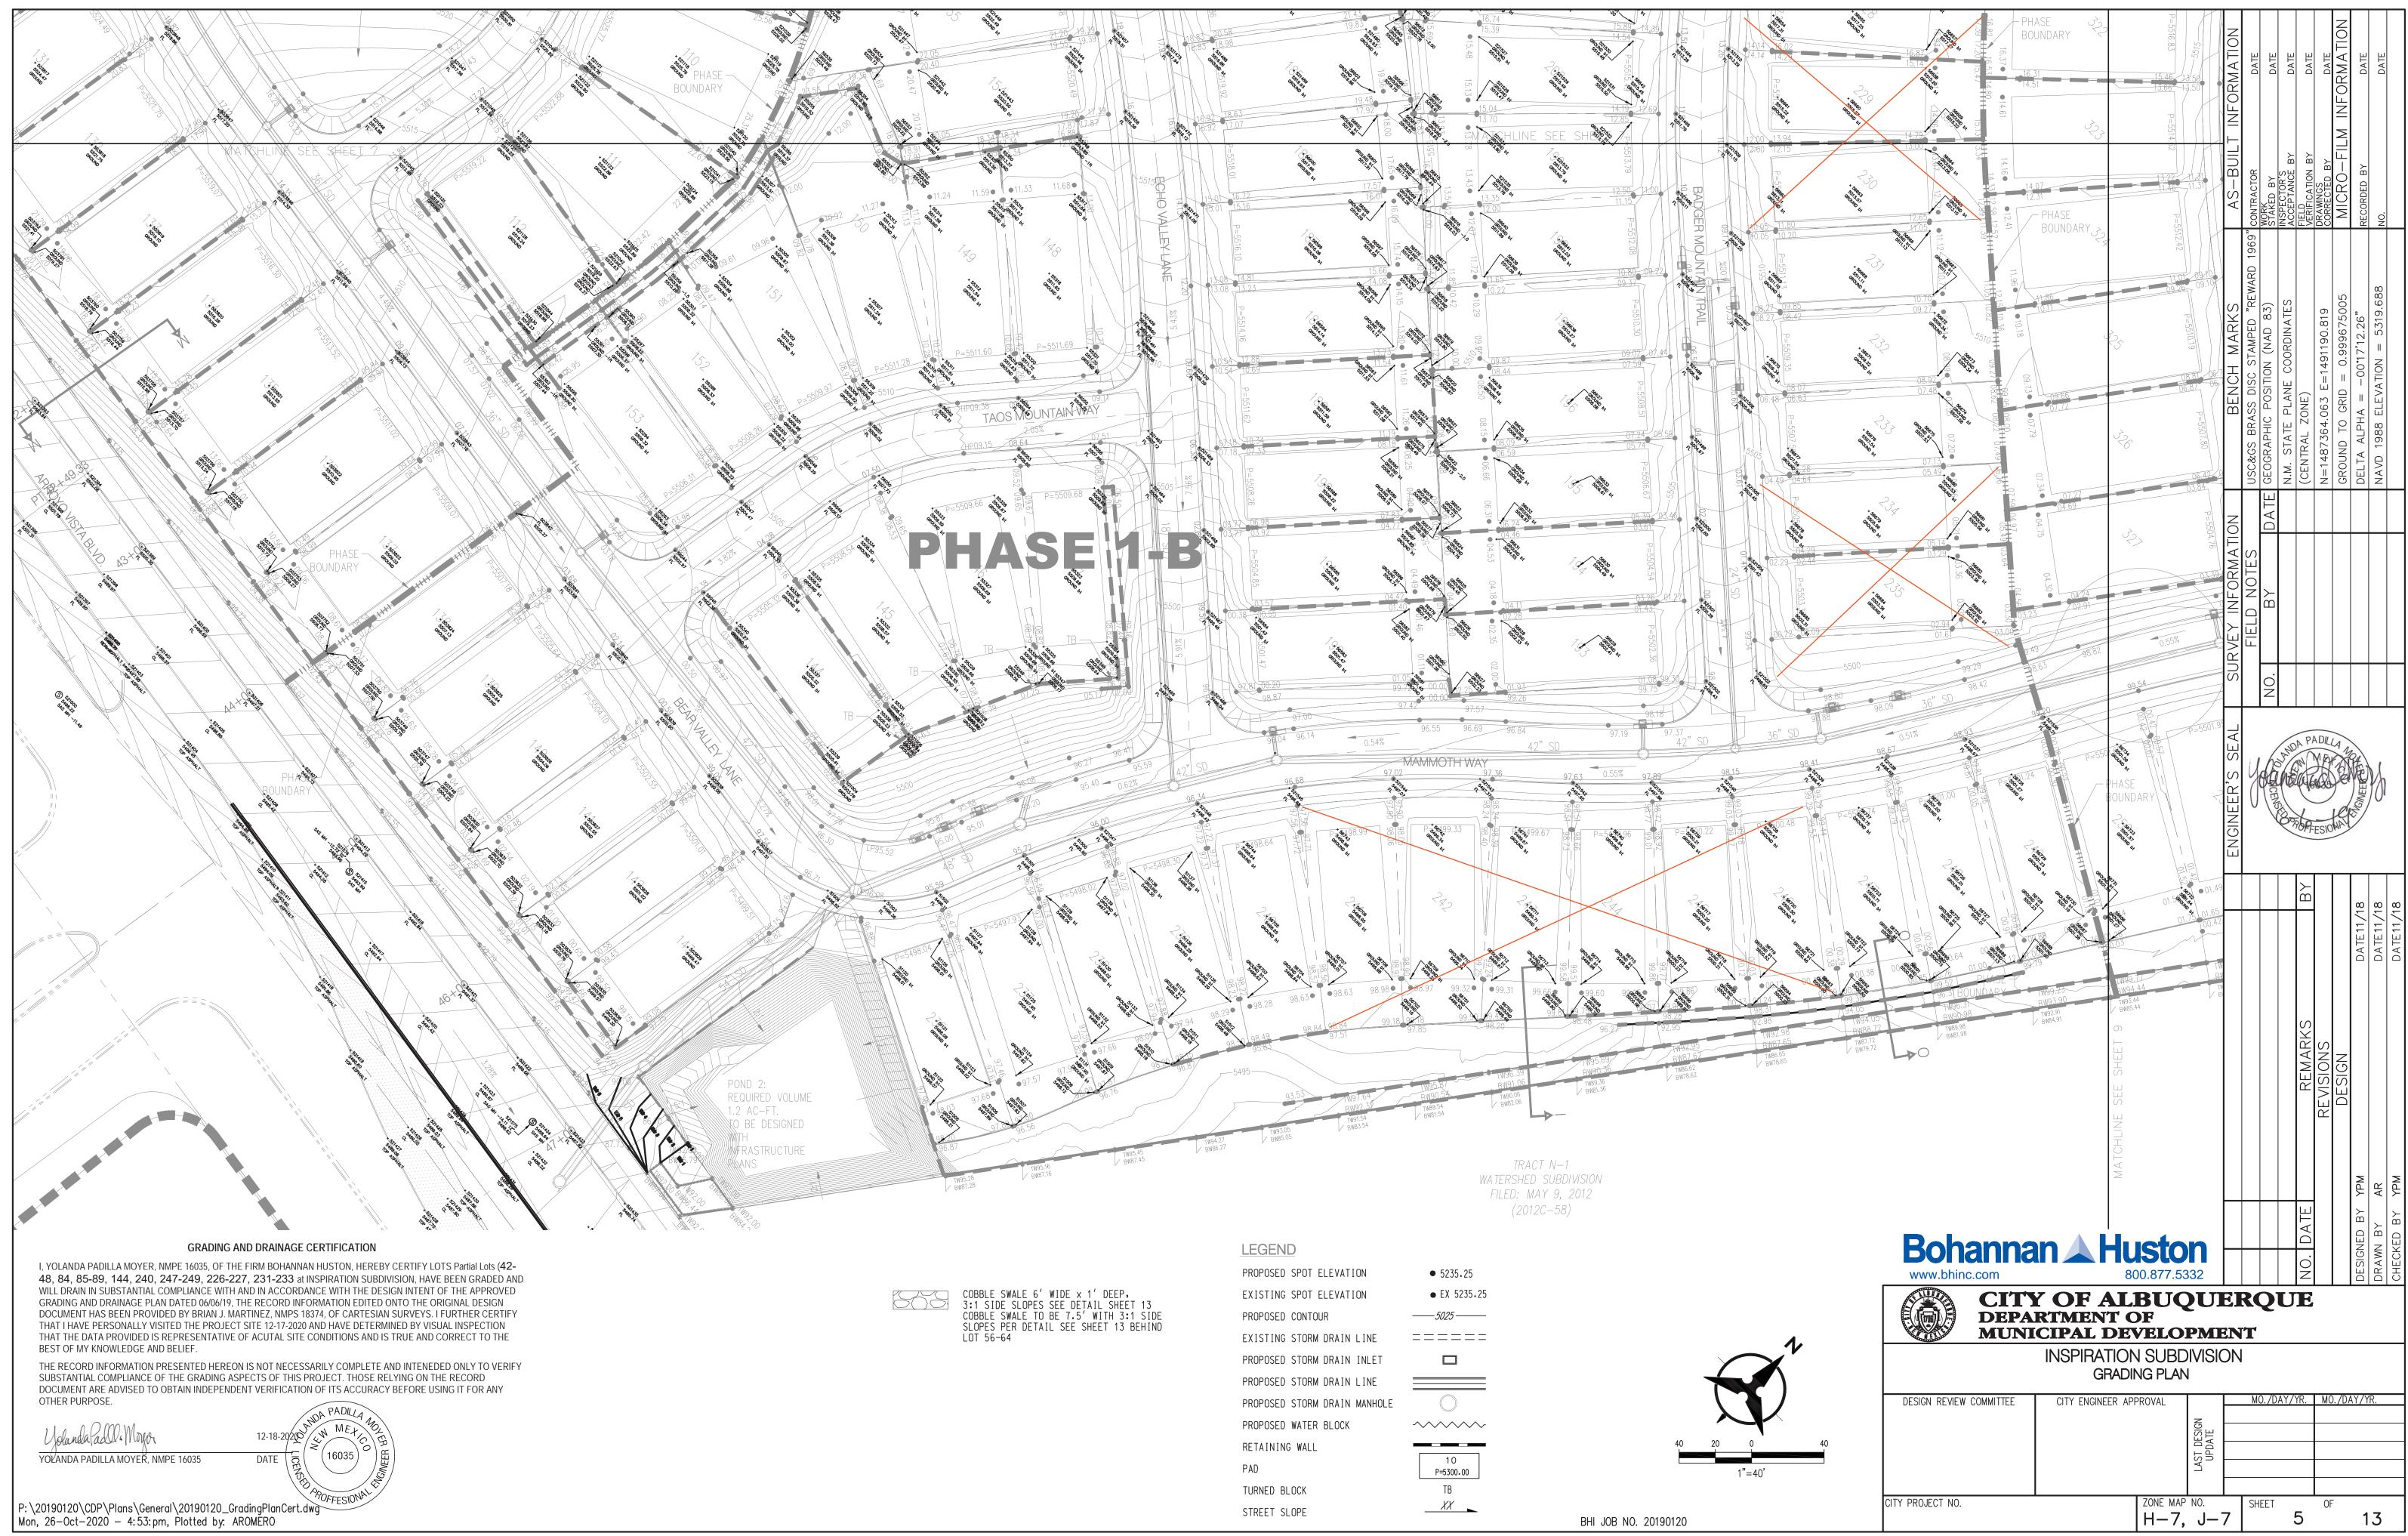

• 5235.25
• EX 5235.25
=====
10 P=5300.00
P=5300.00

