## CITY OF ALBUQUERQUE



September 25, 2020

Tate Fishburn, RA
Tate Fishburn Architect
P.O. Box 2941
Corrales, NM 87048

Re: Office Warehouse, Unit A

7601 Los Volcanes NW,

**Request for Certificate of Occupancy** 

**Transportation Development Final Inspection** 

Engineer's/Architect's Stamp dated 3-20-19(DRB) (J10D002G)

Certification dated 9-13-20

Dear Mr. Fishburn,

Based upon the information provided in your submittal received 9-14-20, Transportation Development has no objection to the issuance of a <u>Permanent Certificate of Occupancy</u>. This letter serves as a "green tag" from Transportation Development for a <u>Permanent Certificate of Occupancy</u> to be issued by the Building

and Safety Division.

If you have any questions, please contact Ernie Gomez at (505) 924-3981.

Albuquerque

PO Box 1293

Sincerely,

Ernie Gomez

NM 87103

Jeanne Wolfenbarger, P.E.

Traffic Engineer, Planning Dept. Development Review Services

banne Wolfenbarger


www.cabq.gov

·

Plan Checker, Planning Dept.

Development Review Services

EG via: email C: CO Clerk, File

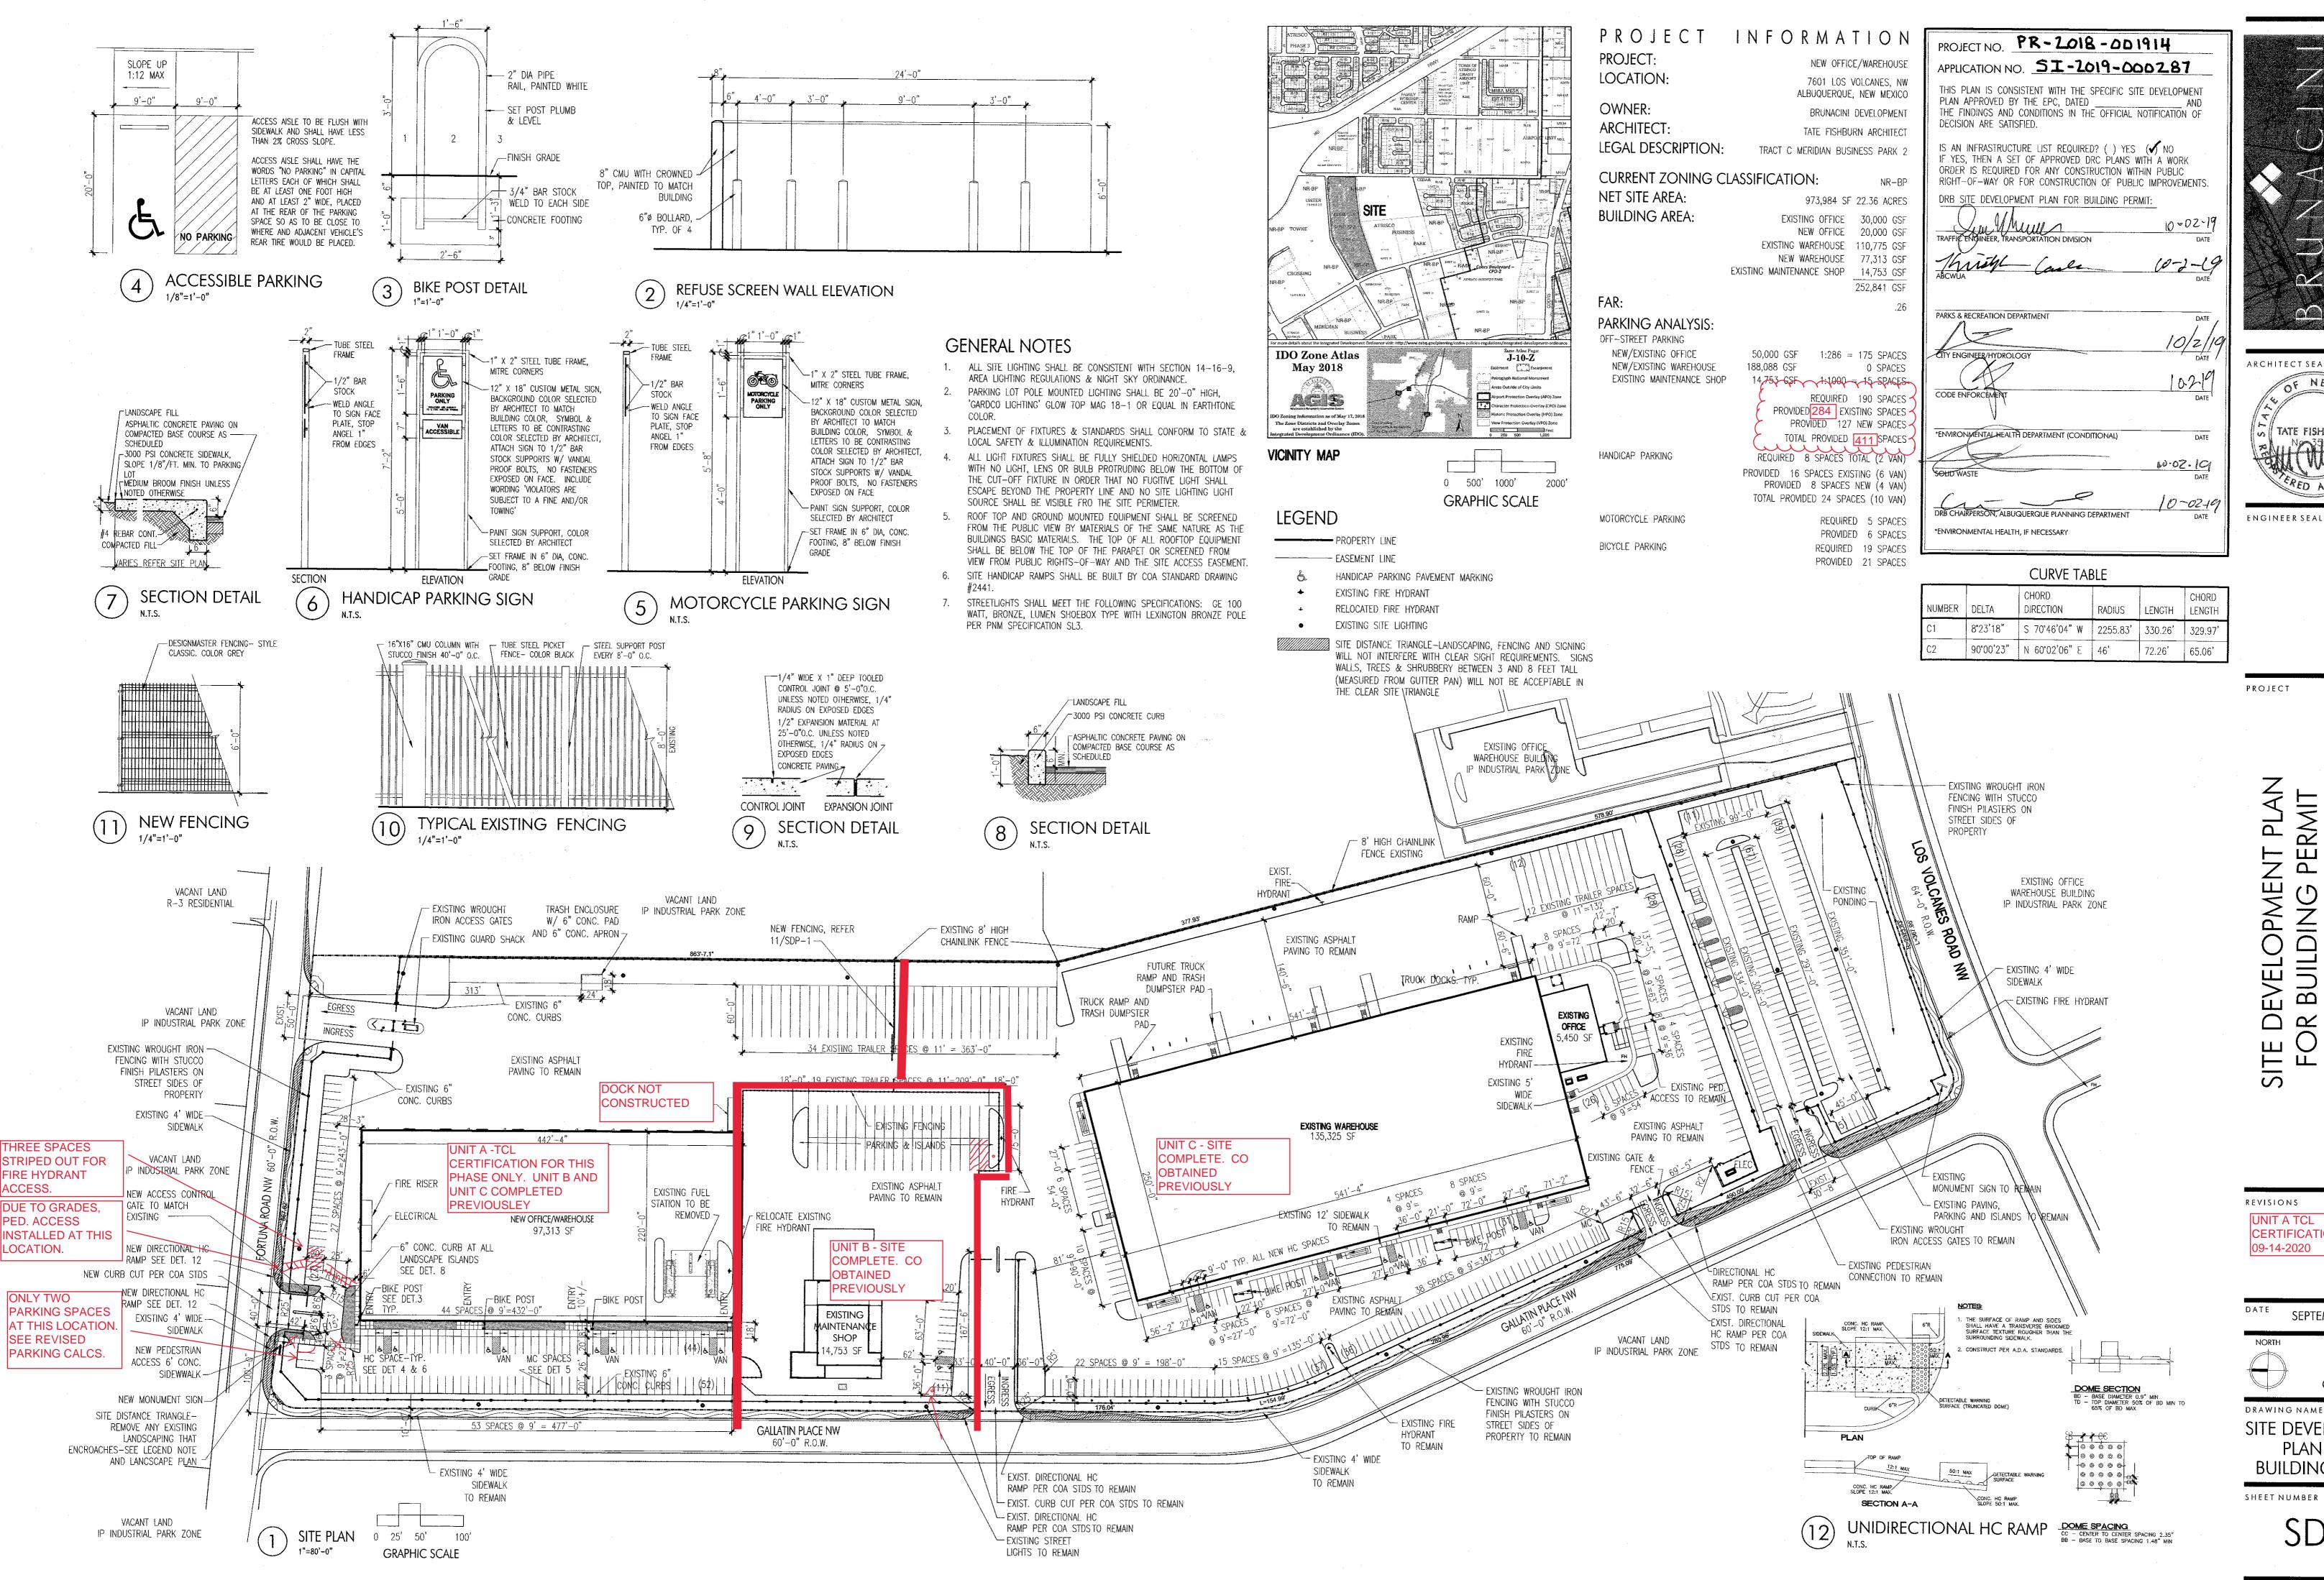

ARCHITECTSEAL TATE FISHBURN ENGINEER SEAL

> S, EX > 回

REVISIONS UNIT A TCL CERTIFICATION 09-14-2020

<u>—</u> <u>—</u>

Ø4

0

SEPTEMBER 27, 2019

1"=80' OR AS NOTED DRAWING NAME SITE DEVELOPMENT PLAN FOR

**BUILDING PERMIT** 

## TATE FISHBURN ARCHITECT

September 14, 2020

Hydrology Development-TCL City of Albuquerque 600 2<sup>nd</sup> St., N.W., Second Floor West Albuquerque, NM

Ref: TCL Certification

Unit A Phase, 7601 Los Volcanes, NW Albuquerque NM

I, Tate Fishburn, NMRA #3550, of the firm Tate Fishburn Architect, hereby certify that this project is in substantial compliance with and in accordance with the design intent of the SDP-1 dated 03-13-19 and approved 03-20-19. The phase of this certification is for the Unit A building and surrounding site work as shown on the attached site plan. The Unit B and Unit C buildings were previously approved as separate phases and have permanent CO's. The South portion of site will be developed in the future as Unit D. The site for Unit A was built per the approved design document with minor changes as shown on provided copy. I further certify that I have personally visited the project site on 09-11-2020 and have determined by visual observation that the TCL plan provided is representative of actual site conditions and is true and correct to the best of my knowledge and belief. This certification is submitted in support of a request for Traffic Circulation Layout certification.

The record information presented hereon is not necessarily complete and intended only to verify substantial compliance of the traffic aspects of this project. Those relying on the record document are advised to obtain independent verification of it's accuracy before using it for any other purpose.

Tate Fishburn Architect

(Whin

04-13-2020