

CITY OF ALBUQUERQUE



July 28, 2016

J. Graeme Means, PE
High Mesa Consulting Group
6010 -B Midway Park Blvd NE
Albuquerque, NM 87109

Re: West Mesa High School New Classroom Building A
6701 Fortuna Rd NW
Request Permanent C.O. - Accepted
Engineer's Stamp dated: 4/13/2015 (J10D005)
Certification dated: 7-22-16

Dear Mr. Graeme,

Based on the Certification received 7/28/2016, the site is acceptable for release of Certificate of Occupancy by Hydrology.

PO Box 1293

Albuquerque

- The North side of New Classroom Building A will remain fenced off during construction of the New Classroom Building B.
- The grated lid at the NW corner of building A will remain swaddled during construction of the New Classroom Building B.

If you have any questions, you can contact me at 924-3695 or Totten Elliott at 924-3982.

New Mexico 87103

www.cabq.gov

Sincerely,

Rita Harmon, P.E.
Senior Engineer, Planning Dept.
Development Review Services

TE/RH



C: email,

Cordova, Camille C.; Miranda, Rachel; Sandoval, Darlene M.;
Lois Blocker

NOTE:
THIS IS NOT A BOUNDARY SURVEY; APPARENT PROPERTY CORNERS ARE SHOWN FOR ORIENTATION ONLY.
THE BOUNDARY AND TOPOGRAPHIC INFORMATION DEPICTED HEREON IS BASED UPON THE BOUNDARY,
TOPOGRAPHIC AND UTILITY SURVEYS PREPARED BY HIGH MESA CONSULTING GROUP, NMPS NO. 11184,
DATED 03/28/2014 (2013.180.3).


B1 OVERALL DRAINAGE SITE PLAN

SCALE: 1" = 100'

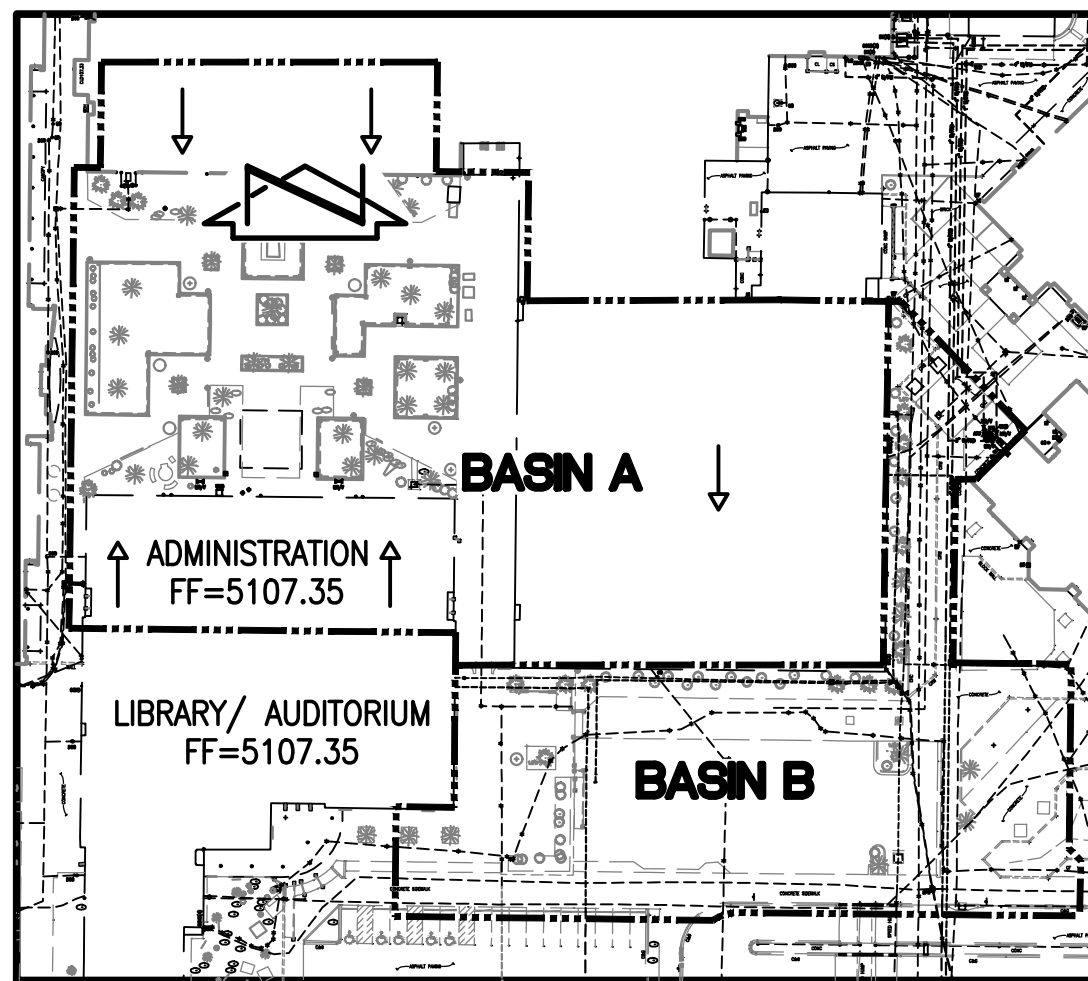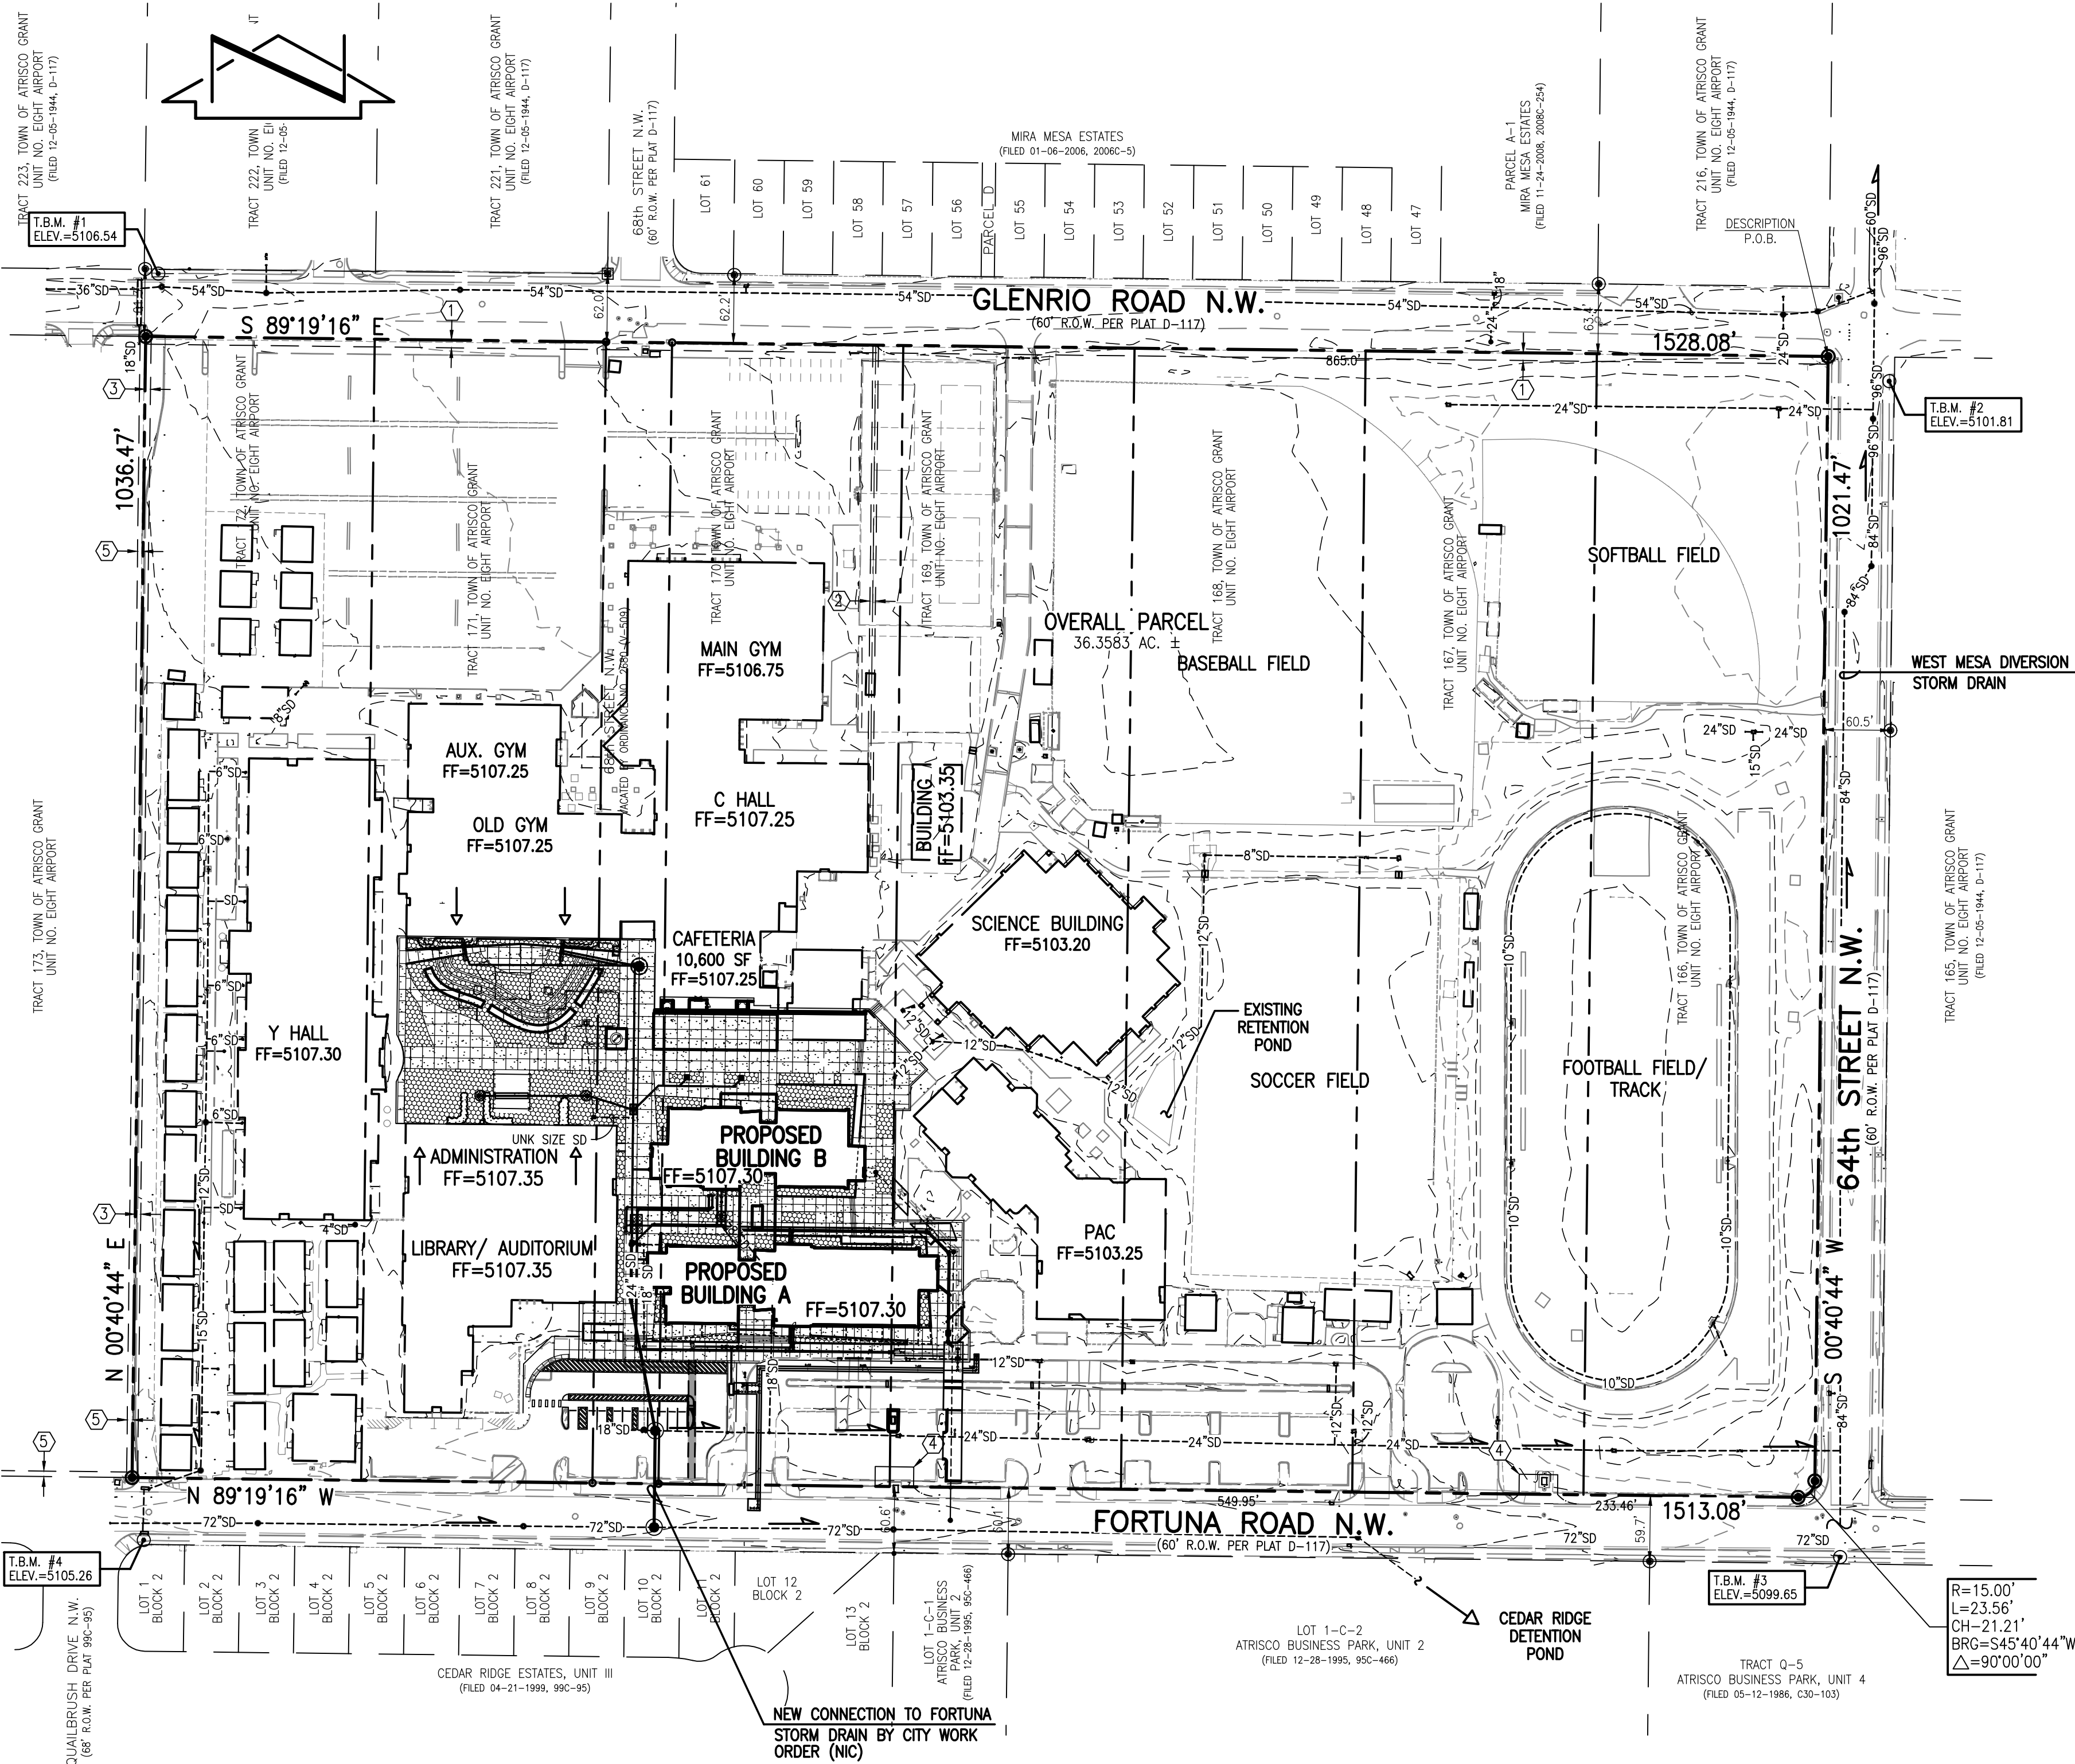

A2 EXISTING BASIN PLAN

SCALE: 1" = 100'

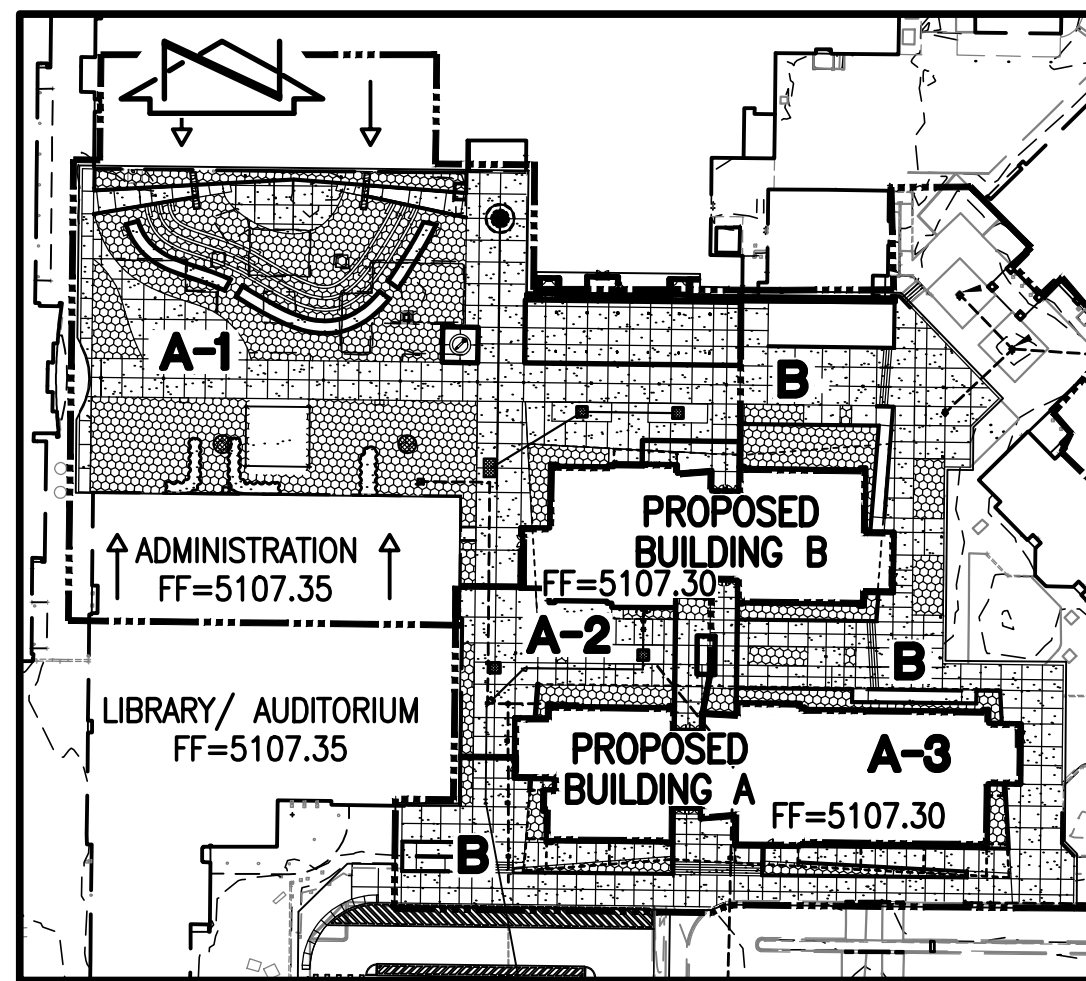

A3 PROPOSED BASIN PLAN

SCALE: 1" = 100'

BENCHMARKS

PROJECT BENCHMARK

AN A.G.R.S. BRASS DISK STAMPED "18-J11", SET FLUSH IN THE SIDEWALK. LOCATED IN THE NORTHEAST QUADRANT OF THE INTERSECTION OF COORS ROAD AND GLENRIO ROAD. ELEVATION = 5099.609 FEET (NAVD 1988)

LEGAL DESCRIPTION

TRACTS 166 THROUGH 172, INCLUSIVE, TOWN OF ATRISCO GRANT, AIRPORT UNIT, ALBUQUERQUE, NEW MEXICO.

EXISTING EASEMENTS

- 7' PNM AND MST&T EASEMENT GRANTED BY DOCUMENT EXECUTED 09-08-1965
- 5' PNM AND MST&T EASEMENT GRANTED BY DOCUMENT EXECUTED 09-08-1965
- 5' PNM AND MST&T EASEMENT GRANTED BY DOCUMENT EXECUTED 04-07-1969
- ABCWUA PUBLIC WATER LINE EASEMENT FOR WATER METERS GRANTED BY DOCUMENT FILED 07-20-2010, DOC. #2010072287
- 5' PNM AND MST&T EASEMENT DEPICTED BY DOCUMENT EXECUTED 04-07-1969

CONSTRUCTION NOTES:


- TWO (2) WORKING DAYS PRIOR TO ANY EXCAVATION, CONTRACTOR MUST CONTACT NEW MEXICO ONE CALL (811) FOR DESIGNATION (LINE-SPOTTING) OF EXISTING PUBLIC UTILITIES AND EXISTING PRIVATE UTILITIES OWNED AND OPERATED BY ALBUQUERQUE PUBLIC SCHOOLS.
- PRIOR TO CONSTRUCTION, THE CONTRACTOR SHALL EXCAVATE AND VERIFY THE HORIZONTAL AND VERTICAL LOCATION OF ALL POTENTIAL OBSTRUCTIONS. SHOULD A CONFLICT EXIST, THE CONTRACTOR SHALL NOTIFY THE ENGINEER IN WRITING SO THAT THE CONFLICT CAN BE RESOLVED WITH A MINIMUM AMOUNT OF DELAY. THE CONTRACTOR SHALL BE RESPONSIBLE FOR ALL INTERPRETATIONS IT MAKES WITHOUT FIRST CONTACTING THE ENGINEER AS REQUIRED ABOVE.
- ALL WORK ON THIS PROJECT SHALL BE PERFORMED IN ACCORDANCE WITH APPLICABLE FEDERAL, STATE AND LOCAL LAWS, RULES AND REGULATIONS CONCERNING CONSTRUCTION SAFETY AND HEALTH.
- ALL CONSTRUCTION WITHIN PUBLIC RIGHT-OF-WAY SHALL BE PERFORMED IN ACCORDANCE WITH APPLICABLE CITY OF ALBUQUERQUE STANDARDS AND PROCEDURES.
- IF ANY UTILITY LINES, PIPELINES, OR UNDERGROUND UTILITY LINES ARE SHOWN ON THESE DRAWINGS, THEY ARE SHOWN IN AN APPROXIMATE MANNER ONLY. AND SUCH LINES MAY EXIST WHERE NONE ARE SHOWN. IF ANY SUCH EXISTING LINES ARE SHOWN, THE LOCATION IS BASED UPON INFORMATION PROVIDED BY THE OWNER OF SAID UTILITY, AND THE INFORMATION MAY BE INCOMPLETE, OR MAY BE OBSOLETE BY THE TIME CONSTRUCTION COMMENCES. THE ENGINEER HAS CONDUCTED ONLY PRELIMINARY INVESTIGATION OF THE LOCATION, DEPTH, SIZE, OR TYPE OF EXISTING UTILITY LINES, PIPELINES, OR UNDERGROUND UTILITY LINES. THIS INVESTIGATION IS NOT CONCLUSIVE, AND MAY NOT BE COMPLETE, THEREFORE, MAKES NO REPRESENTATION PERTAINING THERETO, AND ASSUMES NO RESPONSIBILITY OR LIABILITY THEREFOR. THE CONTRACTOR SHALL IN ADVANCE OF AND DURING EXCAVATION WORK, THE CONTRACTOR IS FULLY RESPONSIBLE FOR ANY AND ALL DAMAGE CAUSED BY ITS FAILURE TO LOCATE, IDENTIFY AND PRESERVE ANY AND ALL EXISTING UTILITY LINES, PIPELINES, AND UNDERGROUND UTILITY LINES. IN PLANNING AND CONDUCTING EXCAVATION, THE CONTRACTOR SHALL COMPLY WITH STATE STATUTES, MUNICIPAL AND LOCAL ORDINANCES, RULES AND REGULATIONS, IF ANY, PERTAINING TO THE LOCATION OF THESE LINES AND FACILITIES.
- THE DESIGN OF PLANTERS AND LANDSCAPED AREAS IS NOT PART OF THIS PLAN. ALL PLANTERS AND LANDSCAPED AREAS ADJACENT TO THE BUILDING(S) SHALL BE PROVIDED WITH POSITIVE DRAINAGE TO AVOID ANY PONDING ADJACENT TO THE STRUCTURE, FOR CONSTRUCTION DETAILS, REFER TO LANDSCAPING PLAN.
- REFER TO SHEETS A-001 AND A-002 FOR DEMOLITION PLANS.
- REFER TO SHEETS A-101 TO A-107 FOR SITE PLAN AND LAYOUT.

EROSION CONTROL MEASURES:

- THE CONTRACTOR SHALL ENSURE THAT NO SOIL ERODES FROM THE SITE INTO PUBLIC RIGHT-OF-WAY OR ONTO PRIVATE PROPERTY.
- THE CONTRACTOR SHALL PROMPTLY CLEAN UP ANY MATERIAL EXCAVATED WITHIN THE PUBLIC RIGHT-OF-WAY SO THAT THE EXCAVATED MATERIAL IS NOT SUSCEPTIBLE TO BEING WASHED DOWN THE STREET.
- CONTRACTOR SHALL, ON BEHALF OF THEMSELVES AND THE OWNER, SECURE "TOPSOIL DISTURBANCE PERMIT" FROM THE CITY AND FILE A NOTICE OF INTENT (N.O.I.) WITH THE EPA PRIOR TO BEGINNING CONSTRUCTION.

GENERAL NOTES:

- ALL WORK DETAILED ON THESE PLANS TO BE PERFORMED UNDER CONTRACT SHALL BE RESPONSIBLE FOR ANY AND ALL DAMAGE CAUSED BY ITS FAILURE TO LOCATE, IDENTIFY AND PRESERVE ANY AND ALL EXISTING UTILITY LINES, PIPELINES, AND UNDERGROUND UTILITY LINES. IN PLANNING AND CONDUCTING EXCAVATION, THE CONTRACTOR SHALL COMPLY WITH STATE STATUTES, MUNICIPAL AND LOCAL ORDINANCES, RULES AND REGULATIONS, IF ANY, PERTAINING TO THE LOCATION OF THESE LINES AND FACILITIES.
- TWO (2) WORKING DAYS PRIOR TO ANY EXCAVATION, CONTRACTOR MUST CONTACT NEW MEXICO ONE CALL SYSTEM, 811, FOR DESIGNATION (LINE-SPOTTING) OF EXISTING PUBLIC UTILITIES AND EXISTING UTILITIES OWNED AND OPERATED BY ALBUQUERQUE PUBLIC SCHOOLS.
- IF ANY UTILITY LINES, PIPELINES, OR UNDERGROUND UTILITY LINES ARE SHOWN ON THESE DRAWINGS, THEY ARE SHOWN IN AN APPROXIMATE MANNER ONLY, AND SUCH LINES MAY EXIST WHERE NONE ARE SHOWN. IF ANY SUCH EXISTING LINES ARE SHOWN, THE LOCATION IS BASED UPON INFORMATION PROVIDED BY THE OWNER OF SAID UTILITY, AND THE INFORMATION MAY BE INCOMPLETE, OR MAY BE OBSOLETE BY THE TIME CONSTRUCTION COMMENCES. THE ENGINEER HAS CONDUCTED ONLY PRELIMINARY INVESTIGATION OF THE LOCATION, DEPTH, SIZE, OR TYPE OF EXISTING UTILITY LINES, PIPELINES, OR UNDERGROUND UTILITY LINES. THIS INVESTIGATION IS NOT CONCLUSIVE, AND MAY NOT BE COMPLETE, THEREFORE, MAKES NO REPRESENTATION PERTAINING THERETO, AND ASSUMES NO RESPONSIBILITY OR LIABILITY THEREFOR. THE CONTRACTOR SHALL IN ADVANCE OF AND DURING EXCAVATION WORK, THE CONTRACTOR IS FULLY RESPONSIBLE FOR ANY AND ALL DAMAGE CAUSED BY ITS FAILURE TO LOCATE, IDENTIFY AND PRESERVE ANY AND ALL EXISTING UTILITY LINES, PIPELINES, AND UNDERGROUND UTILITY LINES. IN PLANNING AND CONDUCTING EXCAVATION, THE CONTRACTOR SHALL COMPLY WITH STATE STATUTES, MUNICIPAL AND LOCAL ORDINANCES, RULES AND REGULATIONS, IF ANY, PERTAINING TO THE LOCATION OF THESE LINES AND FACILITIES.
- SHOULD A CONFLICT EXIST BETWEEN THESE PLANS AND ACTUAL FIELD CONDITIONS, THE CONTRACTOR SHALL PROMPTLY NOTIFY THE ENGINEER IN WRITING SO THAT THE CONFLICT CAN BE RESOLVED WITH A MINIMUM AMOUNT OF DELAY FOR ALL PARTIES.
- THE CONTRACTOR SHALL MAINTAIN ACCESS TO ADJACENT PROPERTIES DURING CONSTRUCTION.
- ALL WORK ON THIS PROJECT SHALL BE PERFORMED IN ACCORDANCE WITH APPLICABLE FEDERAL, STATE AND LOCAL LAWS, RULES AND REGULATIONS CONCERNING CONSTRUCTION.
- THE CONTRACTOR SHALL ENSURE THAT NO SOIL ERODES FROM THE SITE INTO PUBLIC RIGHT-OF-WAY OR ONTO PRIVATE PROPERTY.
- THE CONTRACTOR SHALL PROMPTLY CLEAN UP ANY MATERIAL EXCAVATED WITHIN THE PUBLIC RIGHT-OF-WAY SO THAT THE EXCAVATED MATERIAL IS NOT SUSCEPTIBLE TO BEING WASHED DOWN THE STREET.
- CONTRACTOR SHALL NOTIFY THE ENGINEER NOT LESS THAN SEVEN (7) DAYS PRIOR TO STARTING WORK IN ORDER THAT THE ENGINEER MAY TAKE NECESSARY MEASURES TO PRESERVE SURVEY MONUMENTS. CONTRACTOR SHALL NOT DISTURB PERMANENT SURVEY MONUMENTS WITHOUT THE CONSENT OF THE ENGINEER AND SHALL NOTIFY THE ENGINEER AND BEAR THE EXPENSE OF REPLACING ANY THAT MAY BE DISTURBED WITHOUT PERMISSION. REPLACEMENT SHALL BE DONE ONLY BY THE ENGINEER. WHEN A CHANGE IS MADE IN THE ELEVATION OF ANY MONUMENT COVER TO THE NEW GRADE UNLESS OTHERWISE SPECIFIED.
- ALL PAVEMENT MARKINGS AND TRAFFIC SIGNS SHALL COMPLY WITH THE MANUAL OF UNIFORM TRAFFIC CONTROL DEVICES (MUTCD) PUBLISHED BY THE U.S. DEPARTMENT OF TRANSPORTATION FEDERAL HIGHWAY ADMINISTRATION, LATEST EDITION.
- IF THE REMOVAL OF EXISTING CURB AND GUTTER, SIDEWALK, AND/OR PAVING IS REQUIRED, THE CONTRACTOR SHALL SAWCUT AND/OR REMOVE TO THE NEAREST JOINT. WHEN ABUTTING NEW PAVEMENT TO EXISTING, THE CONTRACTOR SHALL CUT BACK THE EXISTING PAVING TO A STRAIGHT LINE IN ORDER TO REMOVE ANY BROKEN OR CRACKED PAVEMENT. CURB AND GUTTER AND/OR PAVEMENT SHOWN AS EXISTING AND NOT TO BE REMOVED UNDER THIS CONTRACT AND WHICH IS DAMAGED OR DISPLACED BY THE CONTRACTOR SHALL BE REMOVED AND REPLACED BY THE CONTRACTOR AT THE CONTRACTOR'S EXPENSE.
- A DISPOSAL SITE FOR ALL EXCESS EXCAVATION MATERIAL (CONTAMINATED OR OTHERWISE), ASPHALTIC PAVING, CONCRETE PAVING, ETC. SHALL BE OBTAINED BY THE CONTRACTOR IN COMPLIANCE WITH APPLICABLE REGULATIONS. ALL COSTS INCURRED IN OBTAINING A DISPOSAL SITE AND IN HAUL THERETO SHALL BE CONSIDERED INCIDENTAL TO CONSTRUCTION, THEREFORE, NO SEPARATE PAYMENT SHALL BE MADE.
- A BORROW SITE FOR IMPORT MATERIAL SHALL BE OBTAINED BY THE CONTRACTOR IN COMPLIANCE WITH APPLICABLE REGULATIONS. ALL COSTS INCURRED IN OBTAINING A BORROW SITE AND IN HAUL THERETO SHALL BE CONSIDERED INCIDENTAL TO CONSTRUCTION, THEREFORE, NO SEPARATE PAYMENT SHALL BE MADE.
- THE CONTRACTOR SHALL BE RESPONSIBLE FOR SAFELY OBTAINING THE REQUIRED PERMIT. THE CONTRACTOR SHALL SELECT AND USE METHODS WHICH SHALL NOT BE INJURIOUS OR DAMAGING TO THE EXISTING FACILITIES AND STRUCTURES WHICH SURROUND THE WORK AREAS.
- THE CONTRACTOR SHALL CONFINE HIS WORK WITHIN THE CONSTRUCTION LIMITS IN ORDER TO PRESERVE THE EXISTING IMPROVEMENTS AND SO AS NOT TO INTERFERE WITH THE OPERATIONS OF THE EXISTING FACILITIES.
- THE CONTRACTOR SHALL BE RESPONSIBLE FOR SELECTING APPROPRIATE MEANS AND METHODS TO EXCAVATE AND TRENCH AND/OR INSTALL PIPE SO AS TO NOT EXCEED RIGHT-OF-WAY OR EASEMENT LIMITS, AND SO AS NOT TO INTERFERE WITH OTHER UTILITIES OR IMPROVEMENTS. THIS SHALL BE CONSIDERED INCIDENTAL TO CONSTRUCTION, THEREFORE, NO SEPARATE PAYMENT WILL BE MADE.
- THE CONTRACTOR SHALL BE RESPONSIBLE FOR PROTECTING, SUPPORTING AND REPLACING, IF DAMAGED, ALL UTILITIES ENCOUNTERED DURING CONSTRUCTION. THIS SHALL BE CONSIDERED INCIDENTAL TO CONSTRUCTION, THEREFORE, NO SEPARATE PAYMENT WILL BE MADE.
- ALL DIMENSIONS AND RADII OF CURB, CURB RETURNS, AND WALLS ARE SHOWN TO THE FACE OF CURB AND/OR WALL.
- CONTRACTOR SHALL NOTIFY THE OWNER 48 HOURS PRIOR TO STRIPING SO THAT LAYOUT CAN BE VERIFIED.
- PRIOR TO CONSTRUCTION, THE CONTRACTOR SHALL EXCAVATE AND VERIFY THE HORIZONTAL AND VERTICAL LOCATION OF ALL POTENTIAL OBSTRUCTIONS. SHOULD A CONFLICT EXIST, THE CONTRACTOR SHALL NOTIFY THE ENGINEER IN WRITING SO THAT THE CONFLICT CAN BE RESOLVED WITH A MINIMUM AMOUNT OF DELAY. THE CONTRACTOR SHALL BE RESPONSIBLE FOR ALL INTERPRETATIONS IT MAKES WITHOUT FIRST CONTACTING THE ENGINEER AS REQUIRED ABOVE.
- CONTRACTOR SHALL SECURE, ON BEHALF OF THE OWNER AND OPERATORS, "TOPSOIL DISTURBANCE PERMIT" FROM THE CITY AND FILE A NOTICE OF INTENT (N.O.I.) WITH THE EPA PRIOR TO BEGINNING CONSTRUCTION.
- ALL FILL SHALL BE CLEAN, FREE FROM VEGETATION, DEBRIS, AND OTHER DELETERIOUS MATERIALS, AND SHALL NOT BE CONTAMINATED WITH HYDROCARBONS OR OTHER CHEMICAL CONTAMINANTS.
- ALL FILL SHALL BE COMPACTED TO A MINIMUM OF 95% ASTM D-1557 UNLESS A GREATER COMPACTION REQUIREMENT IS OTHERWISE SPECIFIED.
- CAUTION: THESE DRAWINGS DO NOT INCLUDE NECESSARY COMPONENTS FOR CONSTRUCTION SAFETY WHICH SHALL REMAIN THE RESPONSIBILITY OF THE CONTRACTOR. ALL EXCAVATION, TRENCHING AND SHORING ACTIVITIES MUST BE CARRIED-OUT IN ACCORDANCE WITH OSHA 29 CFR 1926, SUBPART P-EXCAVATIONS.

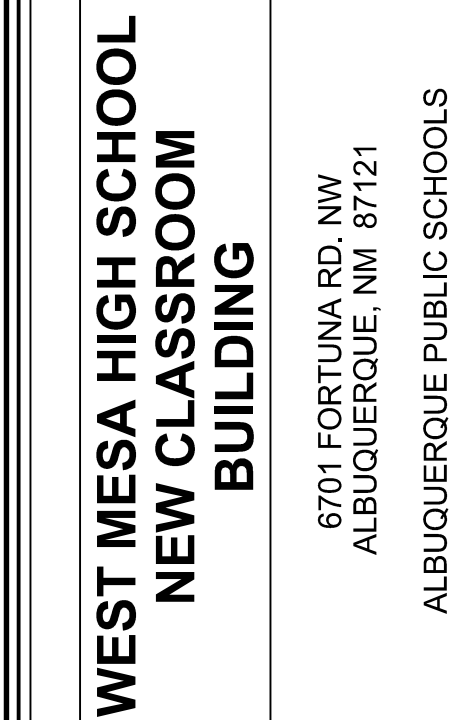

DATE	DESCRIPTION
07/16	RECORD DRAWING AND CERTIFICATION-PAGE 1
MM/DD/YY	MARK

PROJECT NO: WMHS
FILE NAME:
DRAWN BY: J.Y.R./S.C.C.
CHECKED BY: G.M.
COPYRIGHT:
DATE: 03-2015

SHEET TITLE:

OVERALL DRAINAGE SITE PLAN

CG-101

RECORD DRAWING


2015.184.9
2014.006.1

SURVEY NOTE:


THIS IS NOT A BOUNDARY SURVEY; DATA IS SHOWN FOR ORIENTATION ONLY. THE BOUNDARY INFORMATION DEPICTED BY THIS PLAN IS BASED UPON A BOUNDARY SURVEY PREPARED BY HIGH MESA CONSULTING GROUP, NMPS 11184, DATED 03/28/2014 (2013.180.3). THIS IS NOT A TOPOGRAPHIC SURVEY. THE TOPOGRAPHIC AND UTILITY INFORMATION DEPICTED HEREON IS BASED UPON THE TOPOGRAPHIC AND UTILITY SURVEY PREPARED BY HIGH MESA CONSULTING GROUP, NMPS NO. 11184, DATED 03/28/2014 (2013.180.3).

NOTES:

1. REFER TO SHEET C-001 FOR LEGEND AND CONSTRUCTION NOTES.
2. REFER TO SHEETS A-001 AND A-002 FOR DEMOLITION PLANS.
3. REFER TO SHEETS A-101 TO A-107 FOR SITE PLAN AND LAYOUT.
4. GRADES SHOWN ARE FINISHED GRADE. LANDSCAPE AREAS SHALL BE LEFT 4" BELOW DESIGN GRADE FOR SUBSEQUENT INSTALLATION BY SEPARATE PROJECT (NIC).

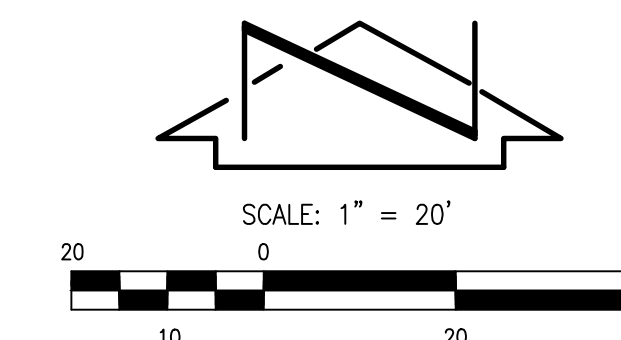

206 BROADWAY BLVD. SE
ALBUQUERQUE, NM 87102
505.243.0101 fax 505.243.1334
WWW.MAHMANSTUDIO.COM

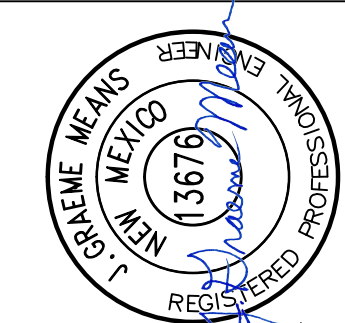

HIGH MESA
Consulting Group
6010 B MIDWAY PARK BLVD. NE
ALBUQUERQUE, NM 87121
PHONE: 505.243.0101
WWW.HIGHMESACG.COM

**WEST MESA HIGH SCHOOL
NEW CLASSROOM
BUILDING**

8701 FORTUNA RD. NW
ALBUQUERQUE, NM 87121
ALBUQUERQUE PUBLIC SCHOOLS

DATE	REVISION	DESCRIPTION
07/16	01/16	RECORD DRAWING
05/16	02/16	VARIOUS REVISIONS
03/16	03/16	ADDED ROOF DRAIN CONNECTION
08/27/15	08/27/15	ADDITIONAL RD CONNECTIONS
05/14/15	05/14/15	ADDENDUM #2
N/A	N/A	NO CHANGE
MM/DD/YY	MM/DD/YY	DESCRIPTION


PROJECT NO: WMHS
FILE NAME:
DRAWN BY: J.Y.R./S.C.C.
CHECKED BY: G.M.
COPYRIGHT:
DATE: 03-2015

SHEET TITLE:
**GRADING
PLAN**

CG-102

**RECORD DRAWING
FOR CERTIFICATION, SEE SHEET CG-001**

2015.184.9
2014.006.1

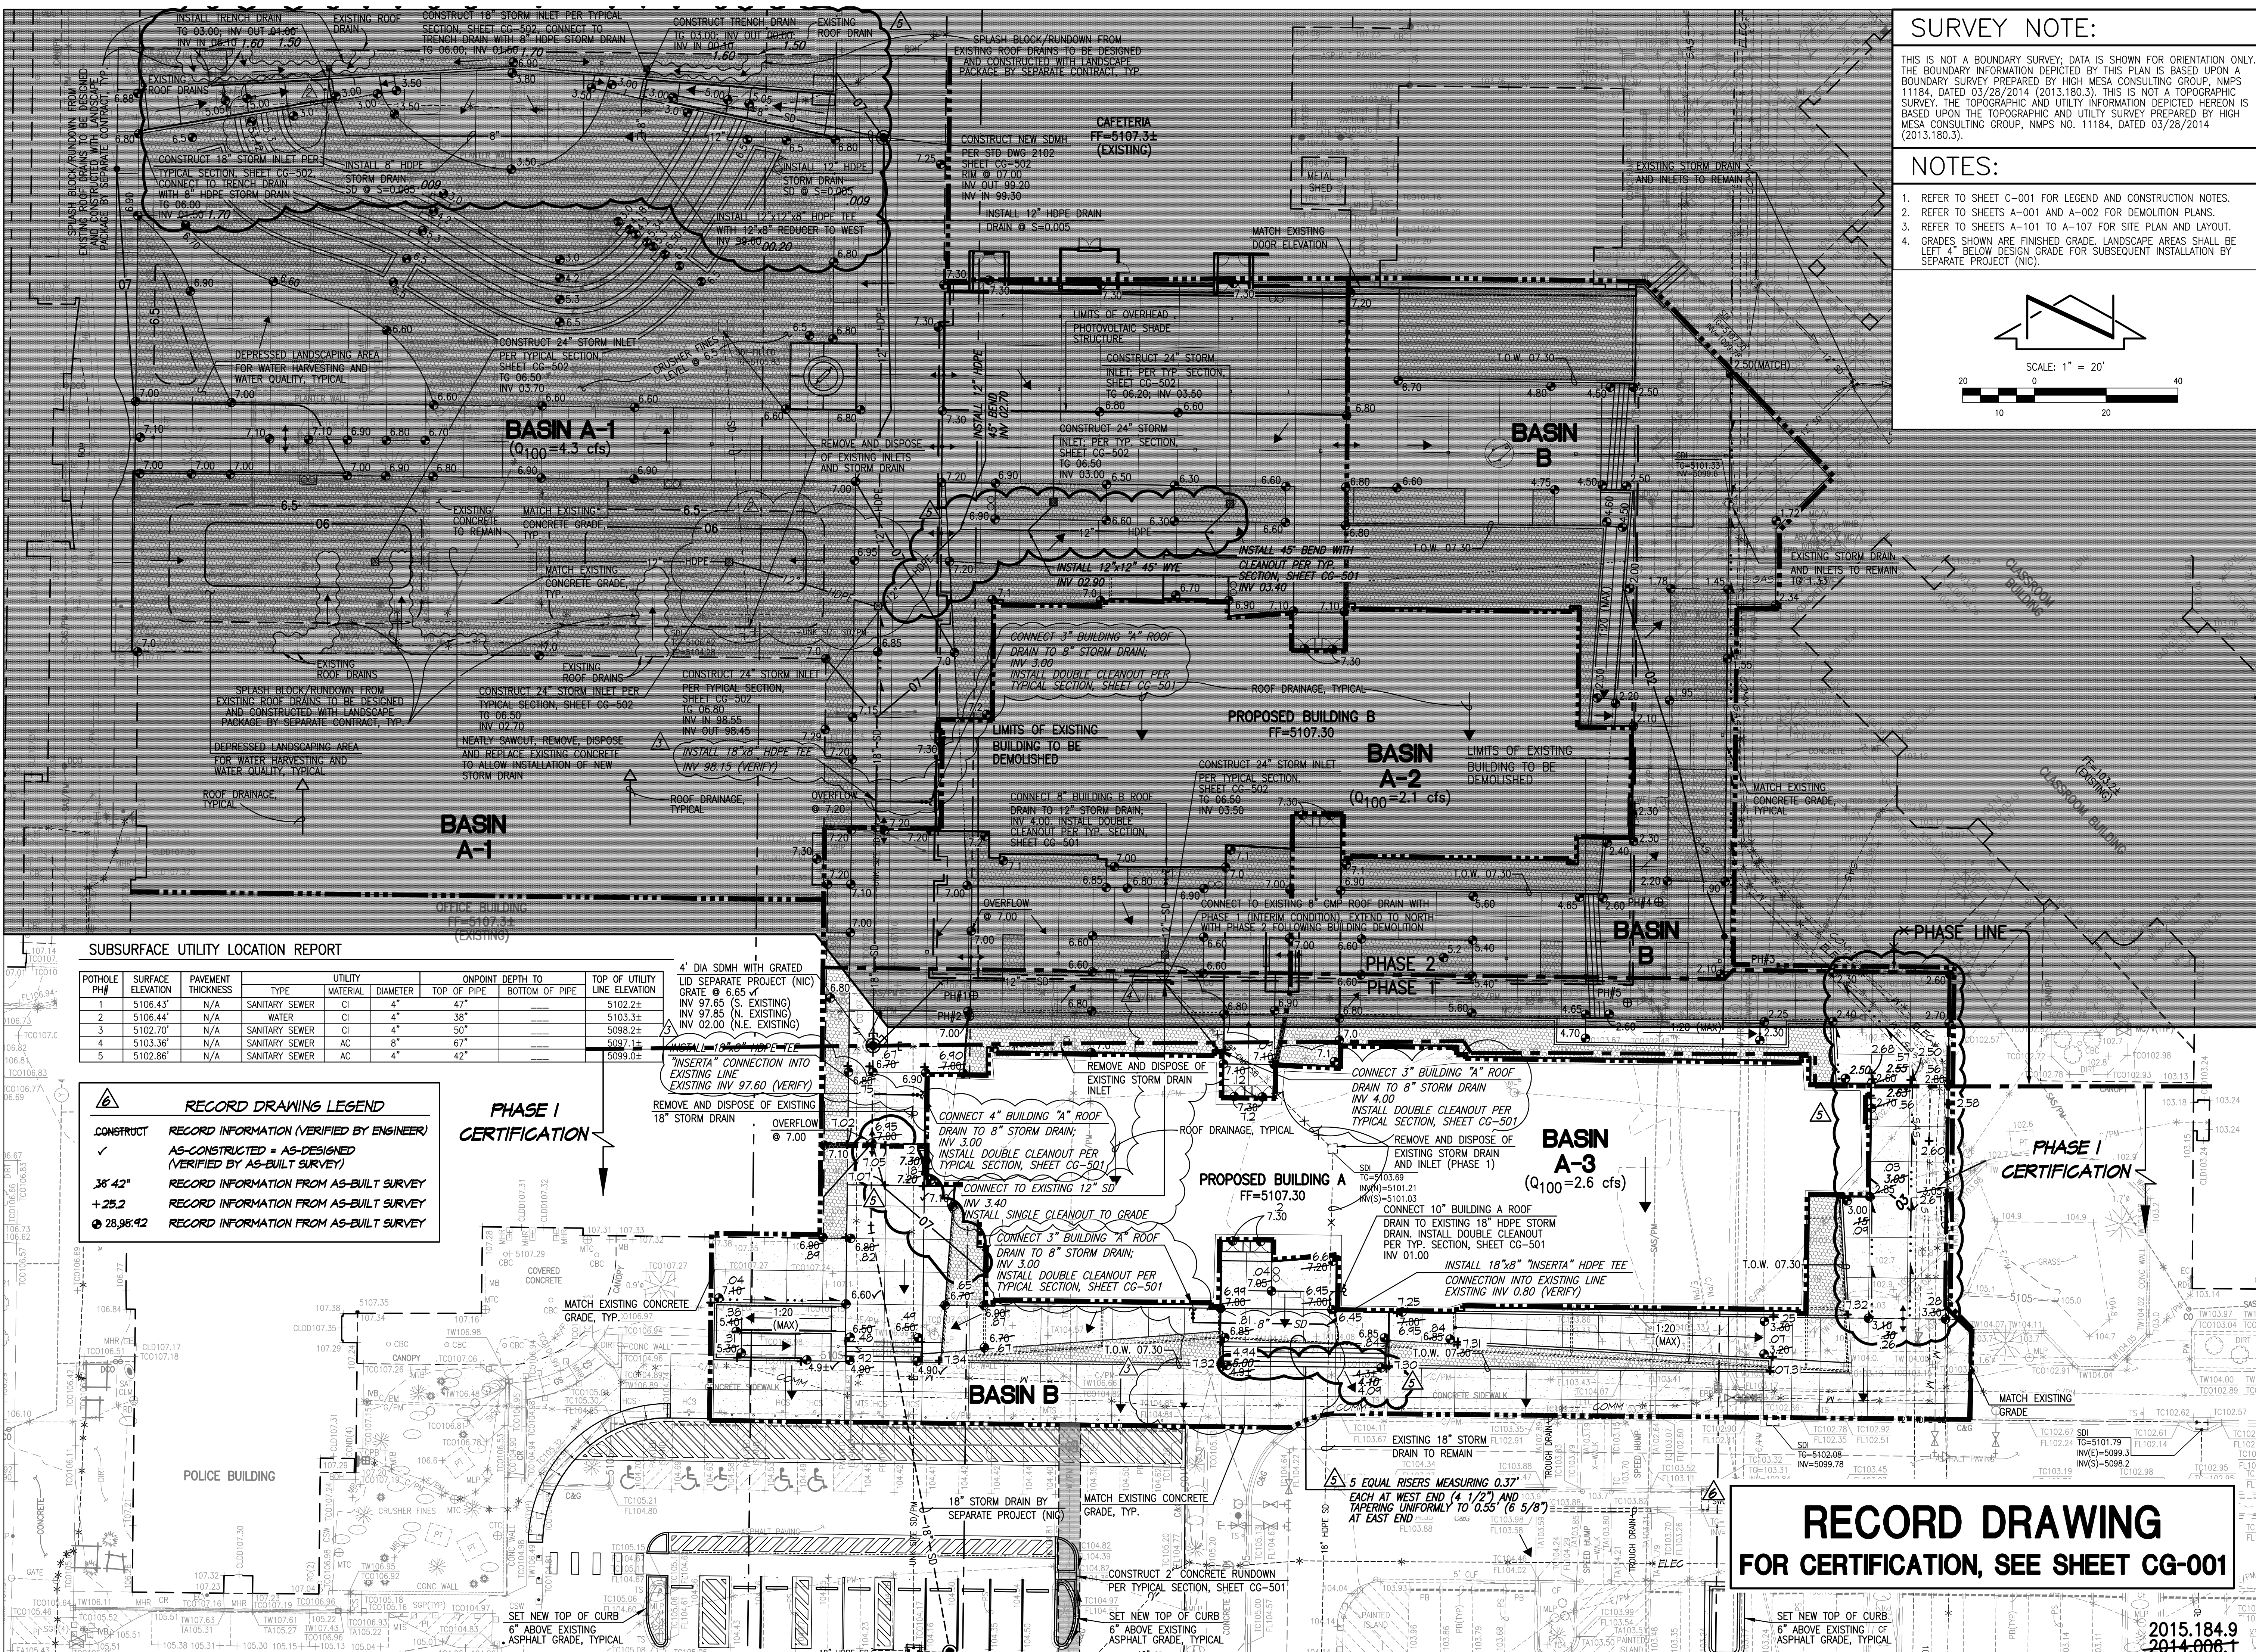

SUBSURFACE UTILITY LOCATION REPORT







POT HOLE PH#	SURFACE ELEVATION	PAVEMENT THICKNESS	TYPE	UTILITY MATERIAL	DIAMETER	ONPOINT DEPTH TO TOP OF PIPE	TOP OF UTILITY LINE ELEVATION
1	5106.43'	N/A	SANITARY SEWER	CI	4"	47"	5102.24'
2	5106.44'	N/A	WATER	CI	4"	38"	5103.34'
3	5102.70'	N/A	SANITARY SEWER	CI	4"	50"	5098.24'
4	5103.36'	N/A	SANITARY SEWER	AC	8"	67"	5097.14'
5	5102.86'	N/A	SANITARY SEWER	AC	4"	42"	5099.04'


RECORD DRAWING LEGEND	
CONSTRUCT	RECORD INFORMATION (VERIFIED BY ENGINEER)
✓	AS-CONSTRUCTED = AS-DESIGNED (VERIFIED BY AS-BUILT SURVEY)
38" 42"	RECORD INFORMATION FROM AS-BUILT SURVEY
+25.2	RECORD INFORMATION FROM AS-BUILT SURVEY
28.98.12	RECORD INFORMATION FROM AS-BUILT SURVEY

**PHASE I
CERTIFICATION**


**PHASE I
CERTIFICATION**

File Path: P:\MAHMAN\2015\03\05\184\9\001 Plot Date: 07-21-2016
File Name: 151849 CG-102 RECORDING Plot Time: 10:59 am

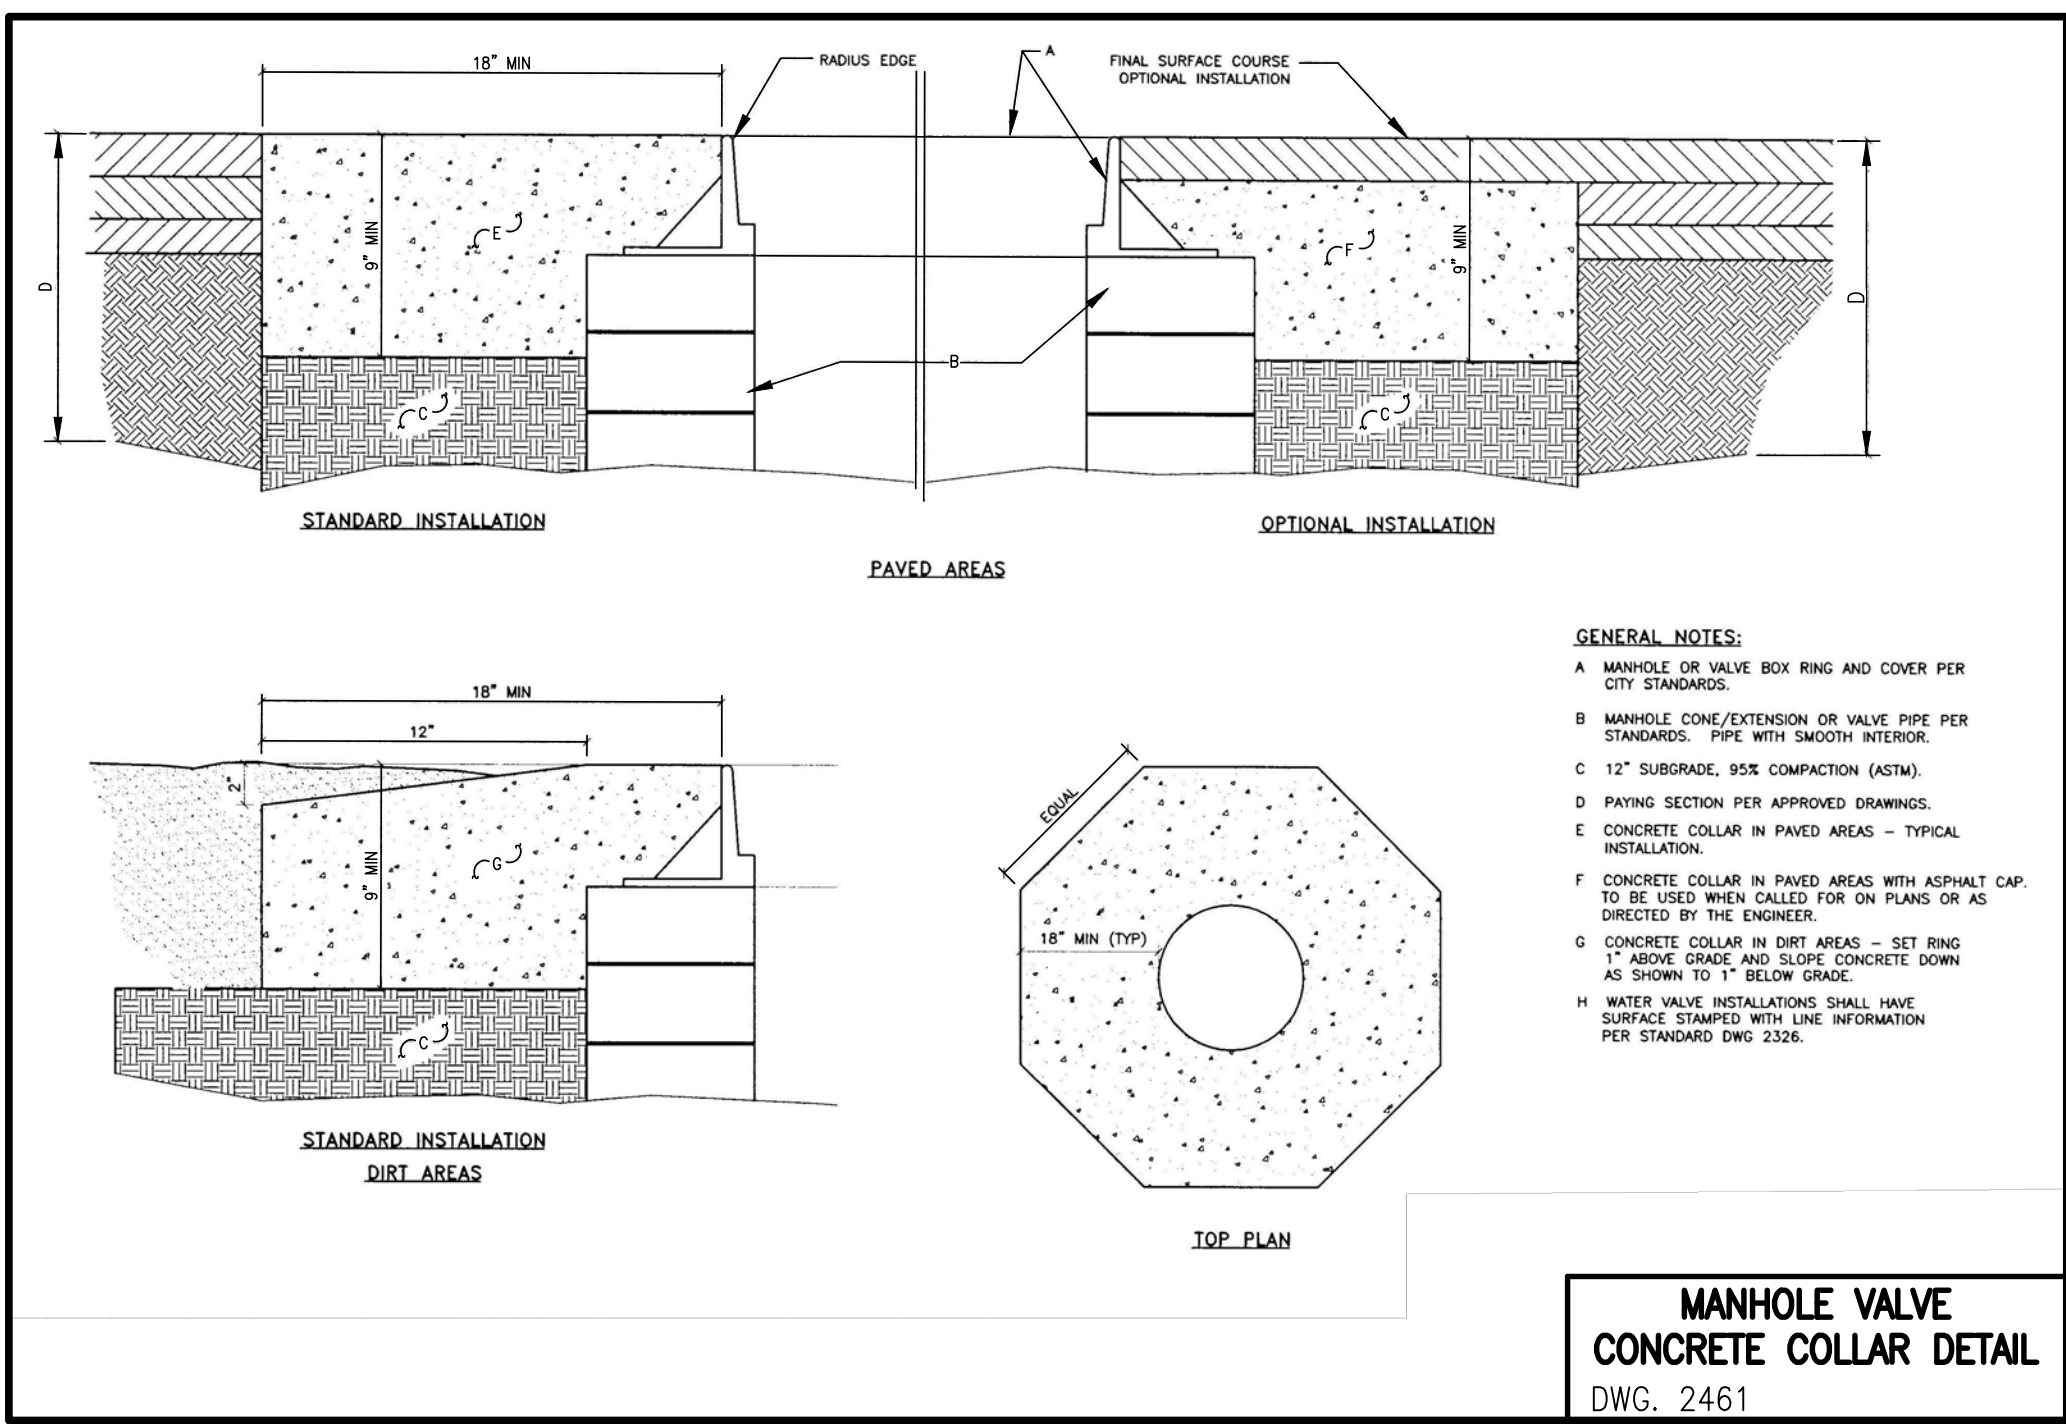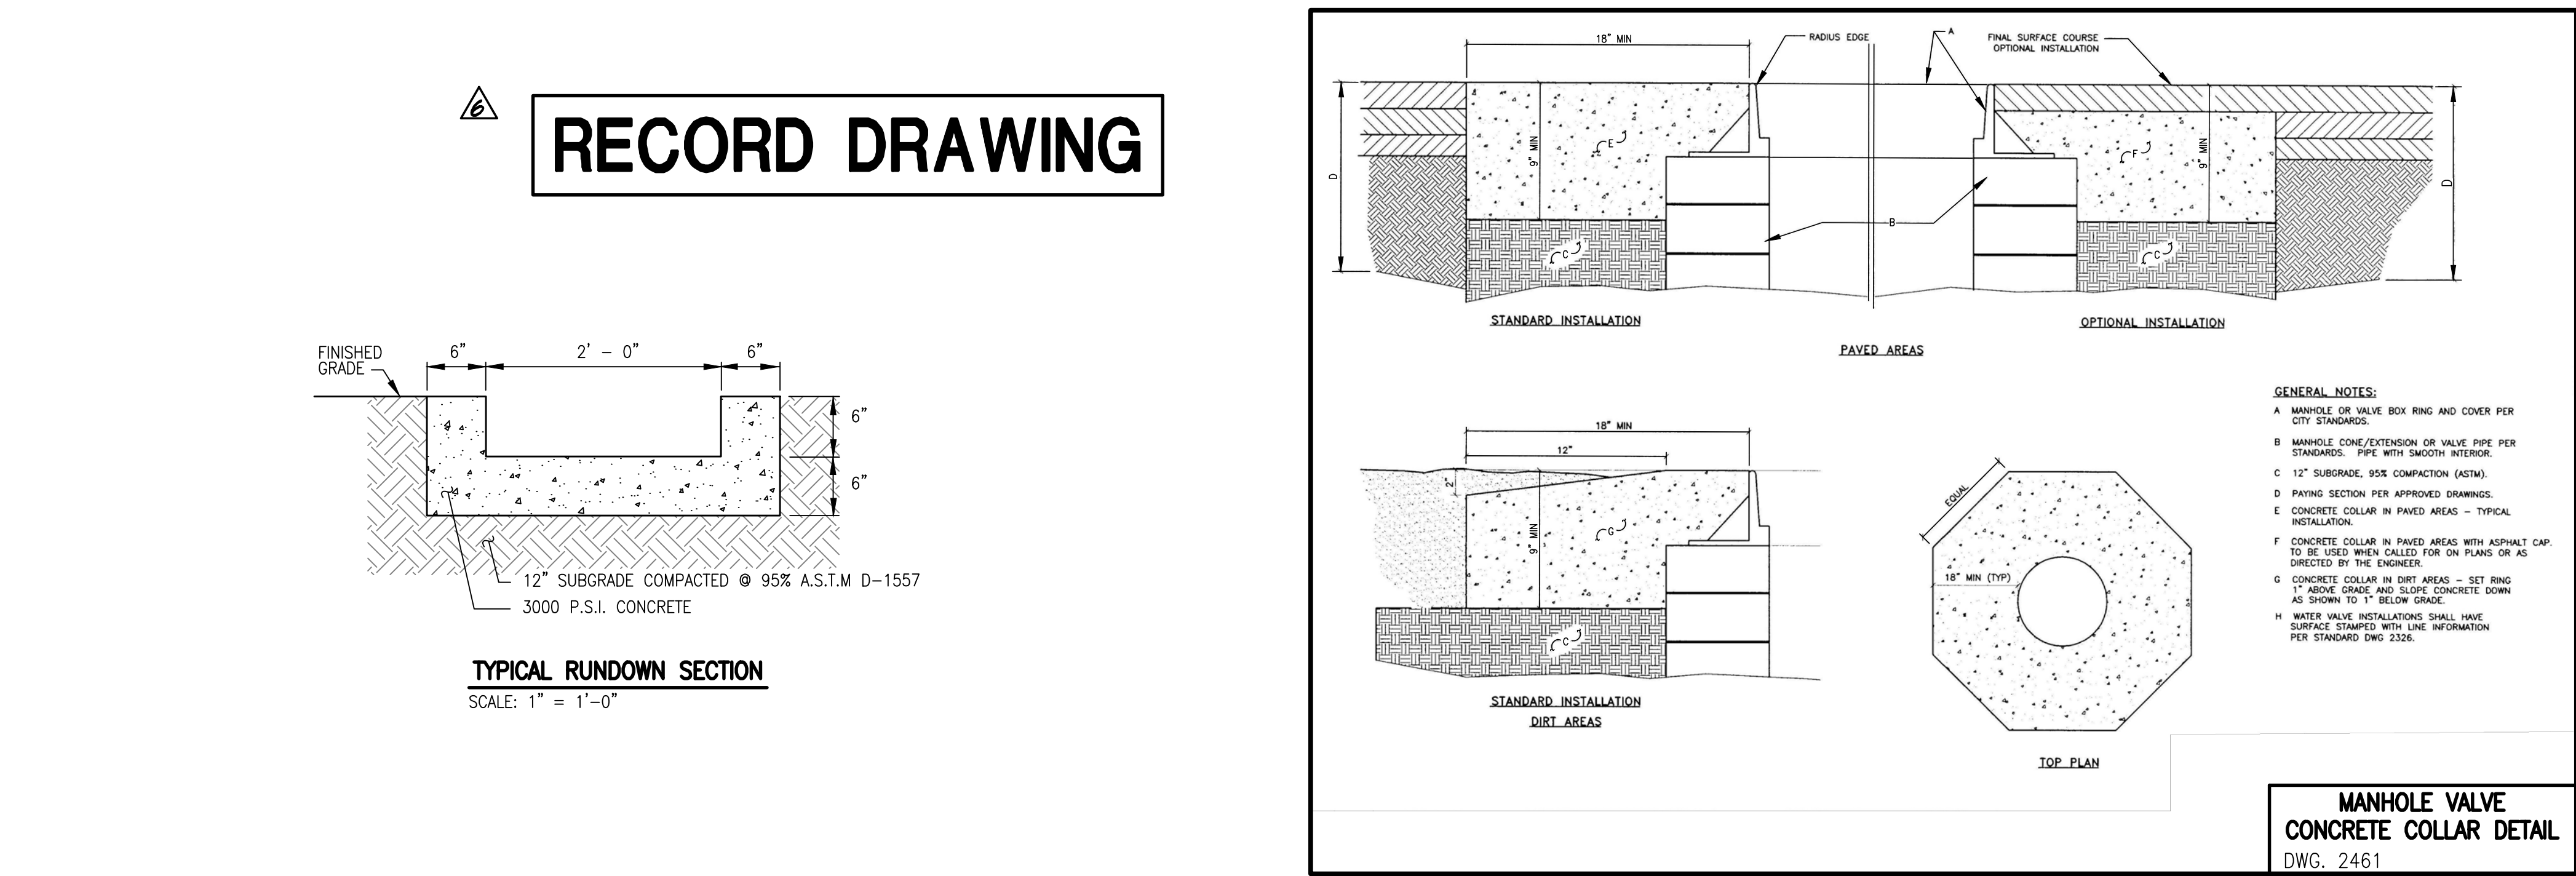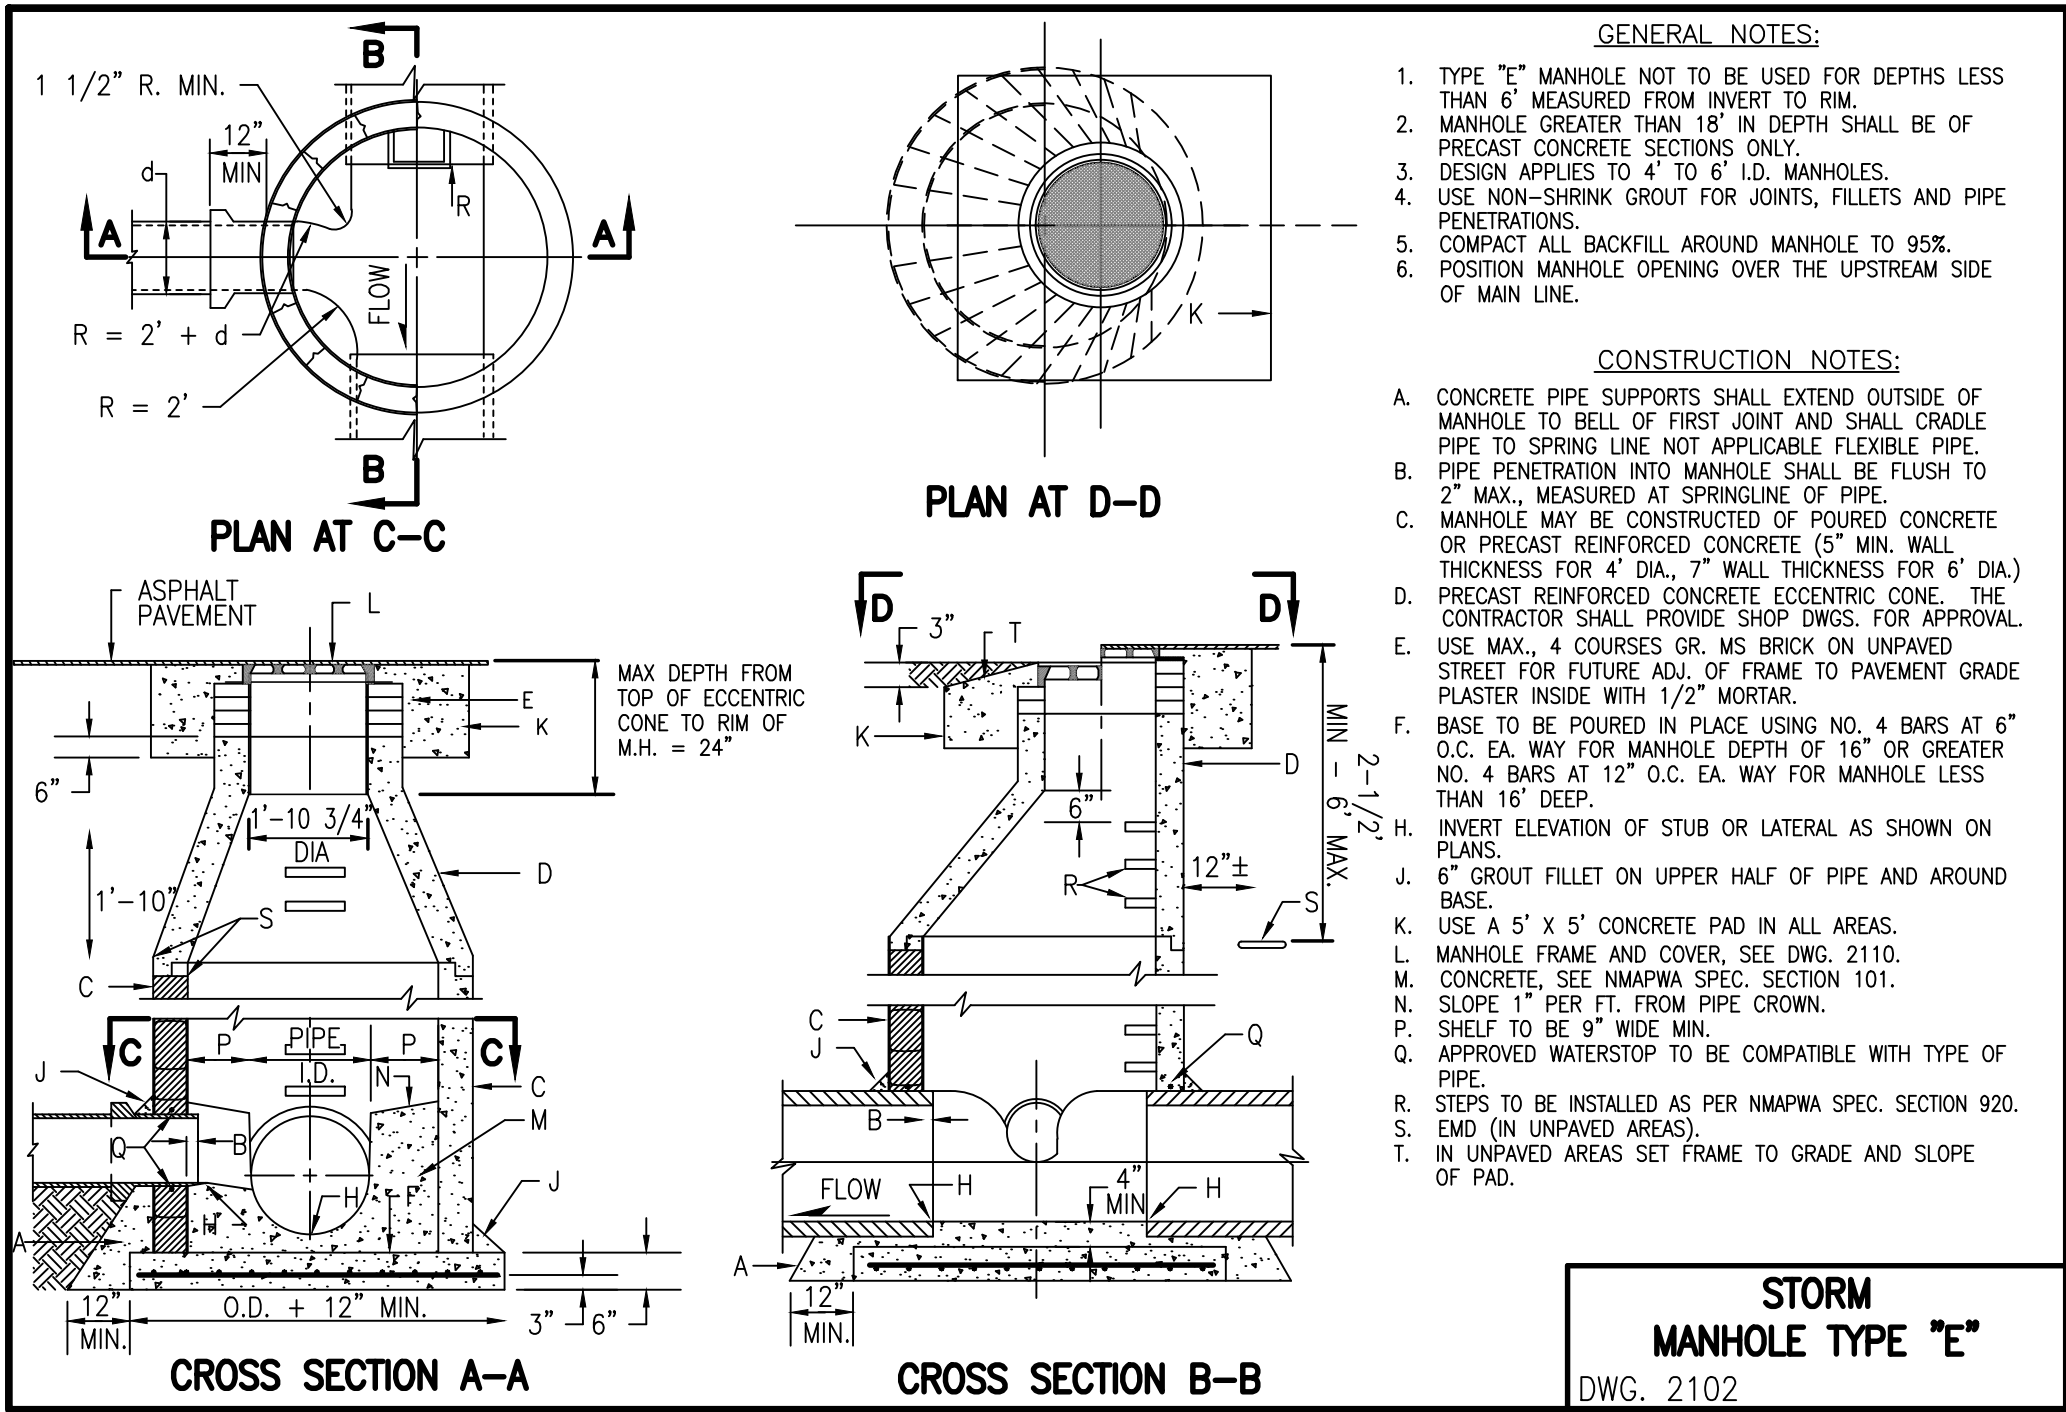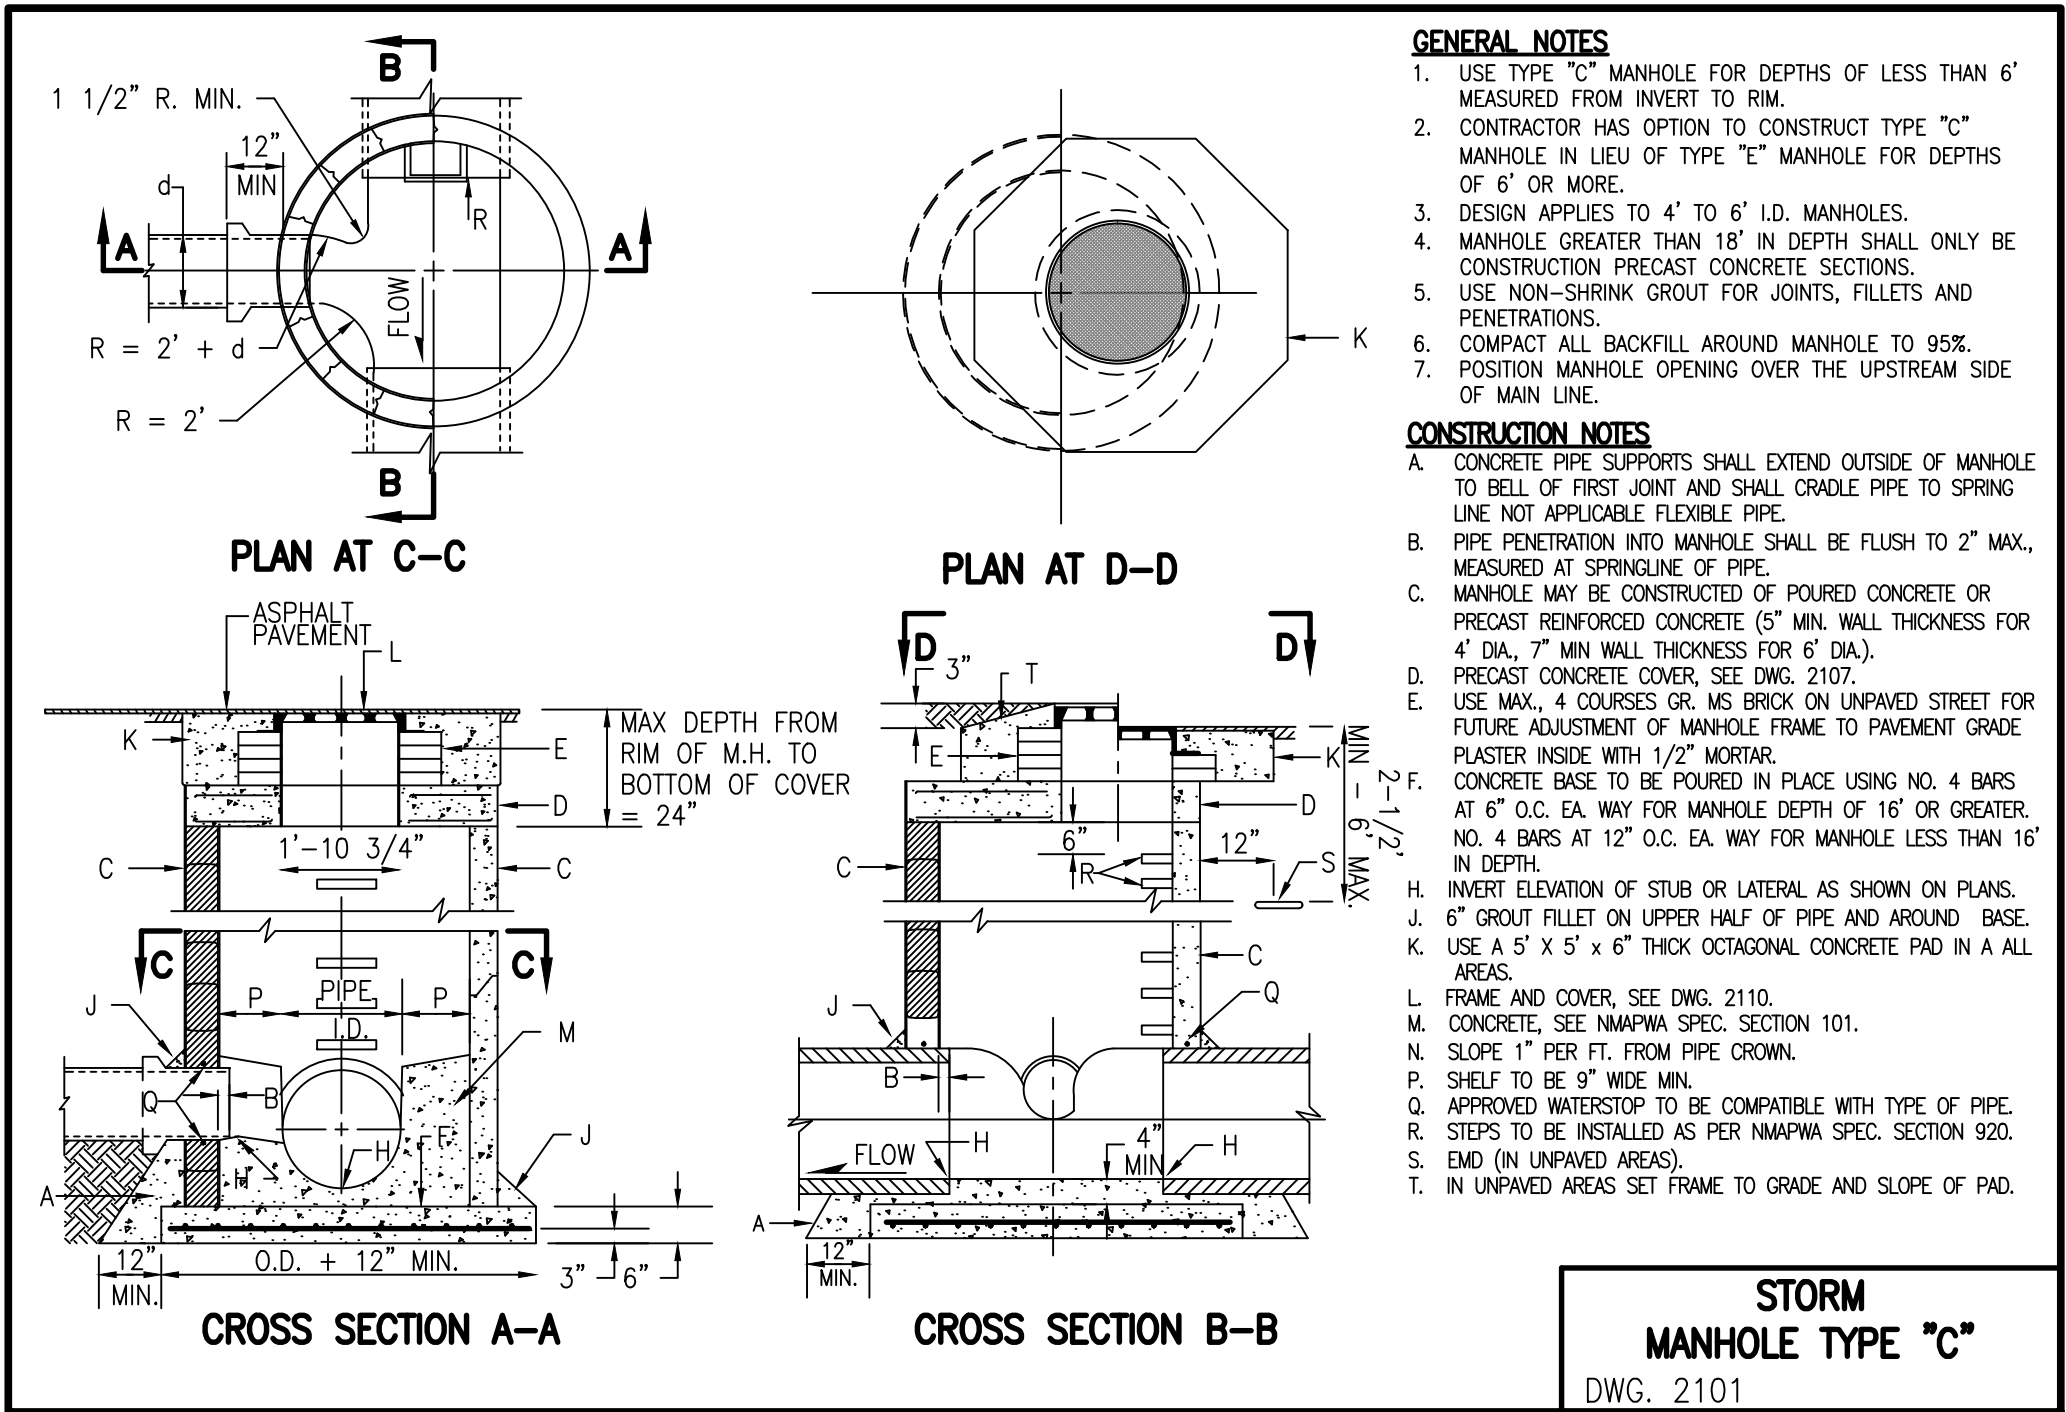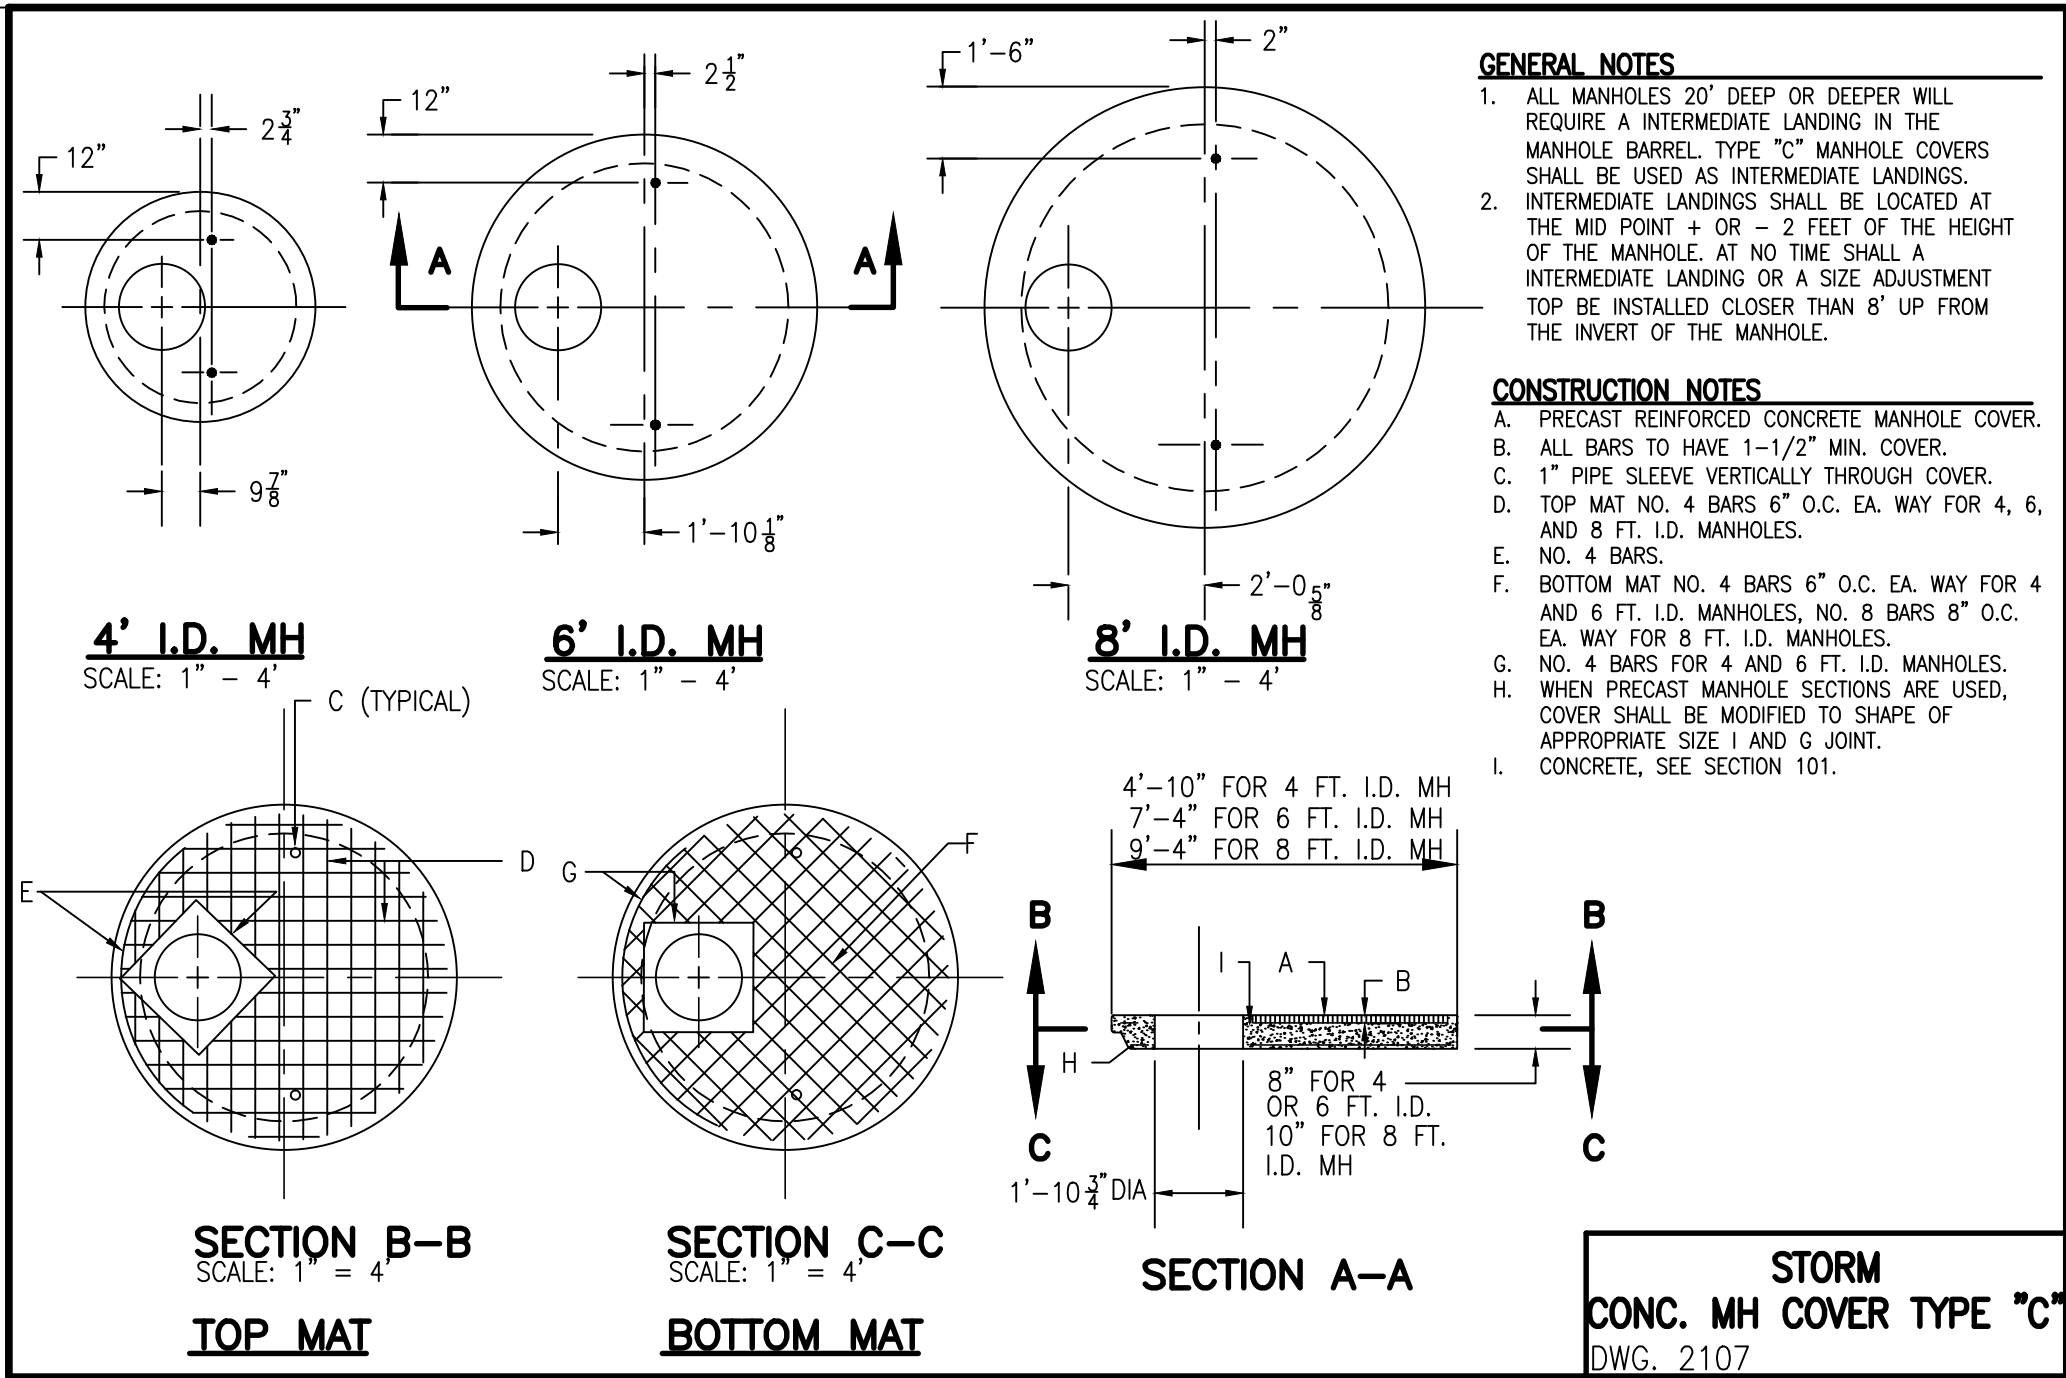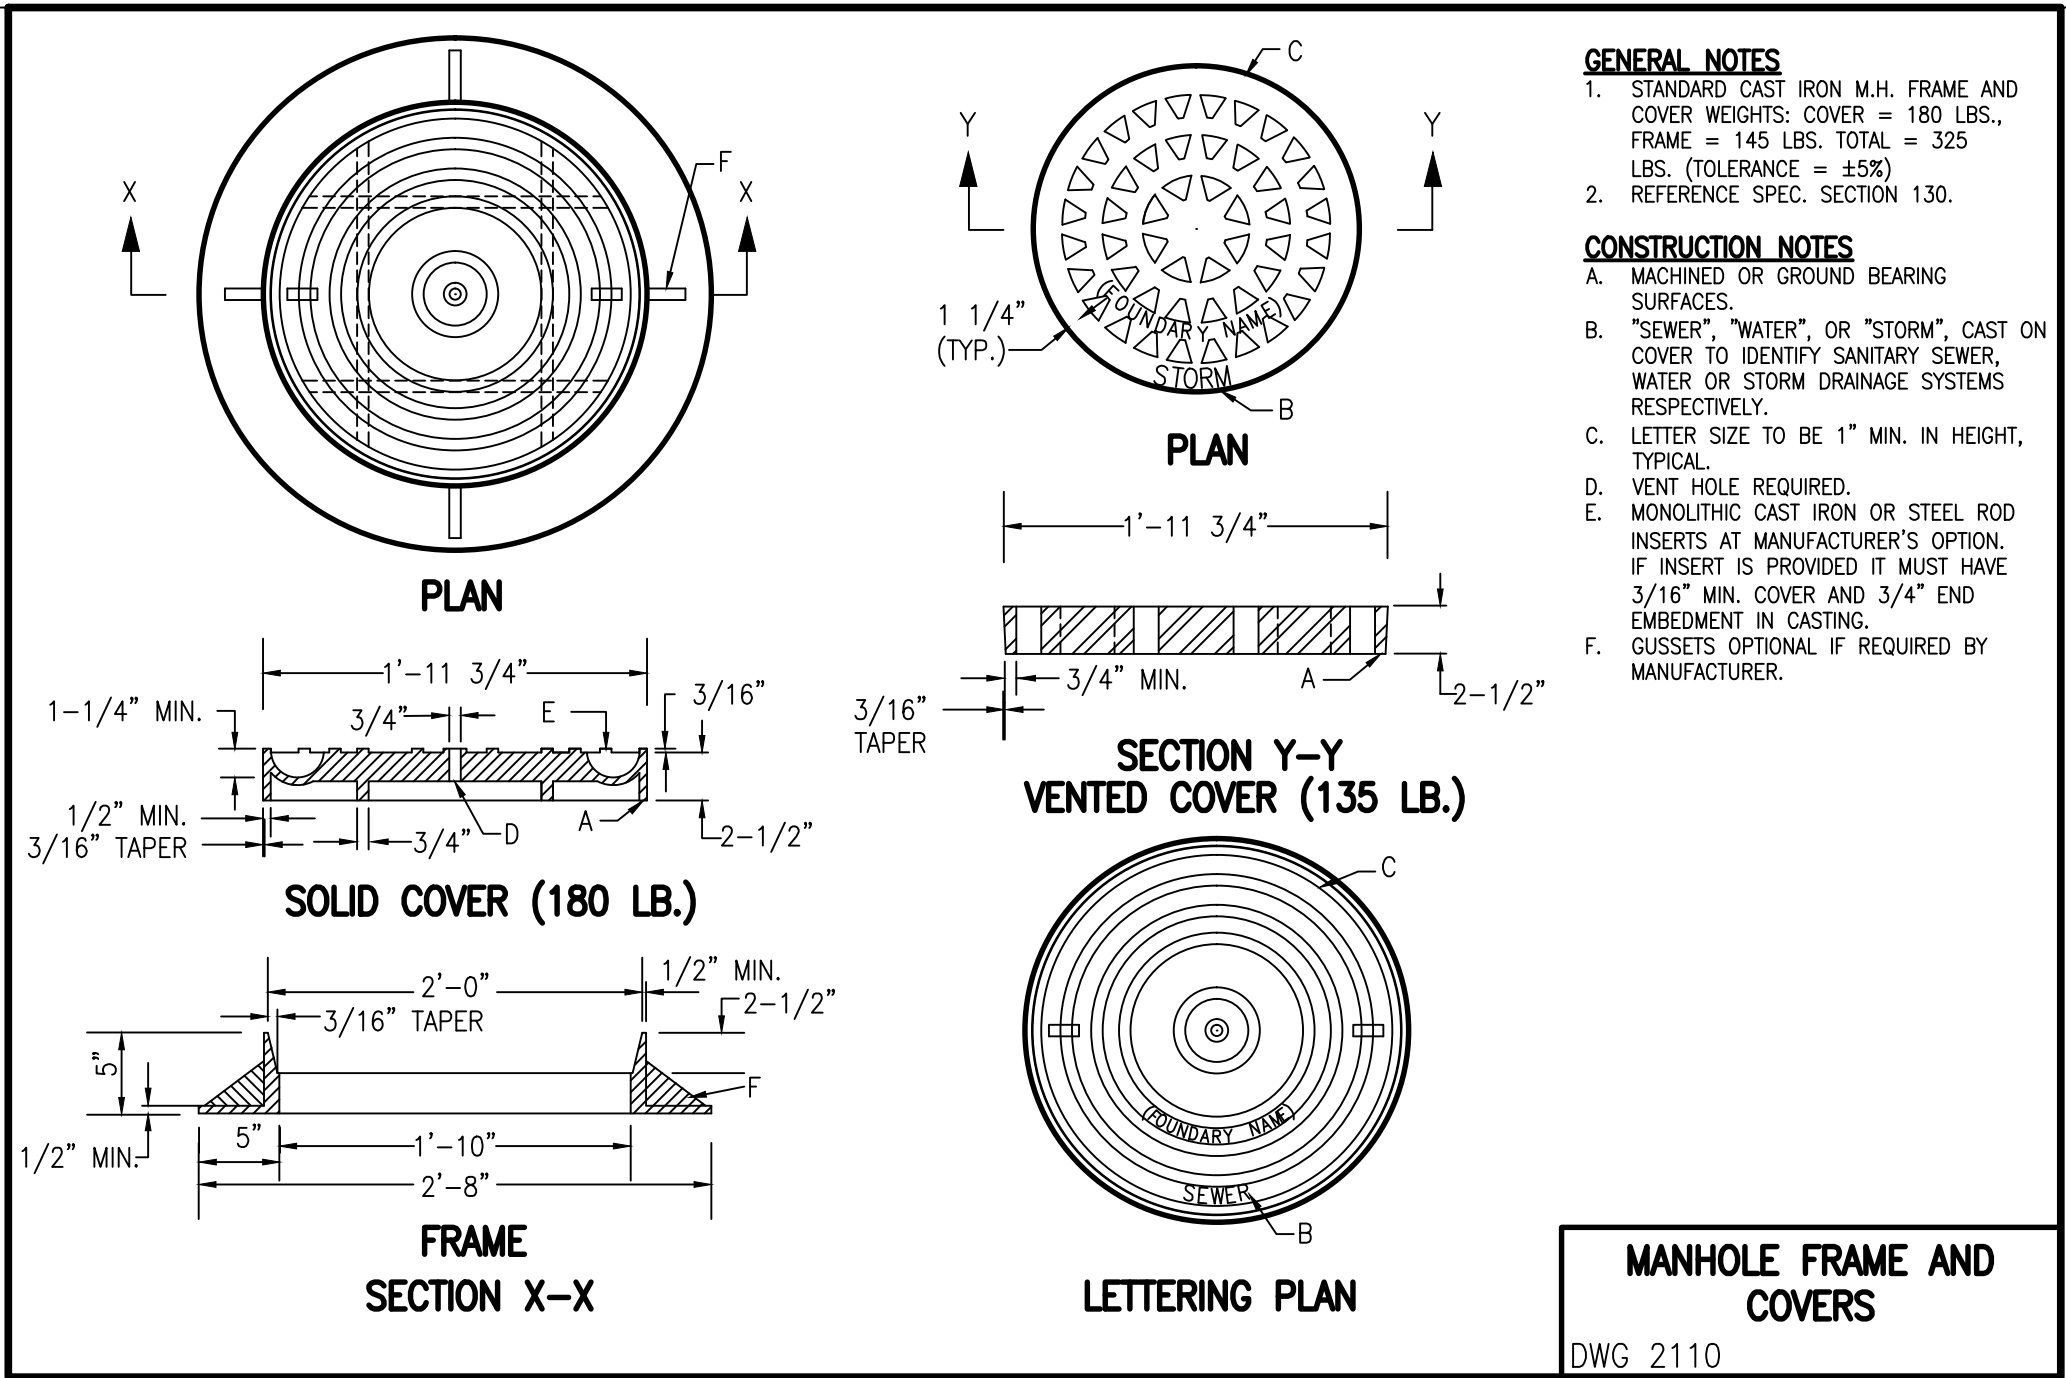


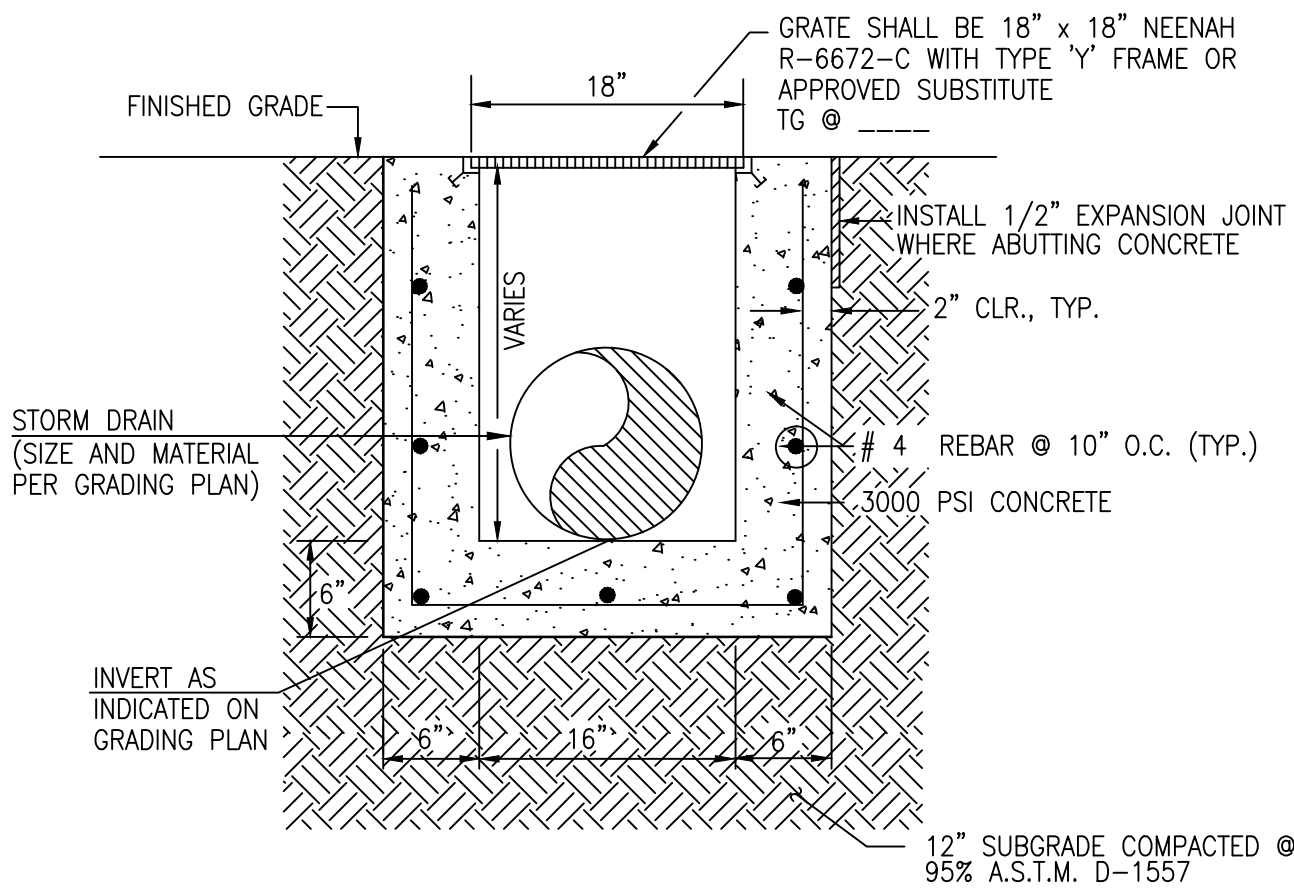


A1 TYPICAL 18"X18" STORM INLET SECTION
SCALE: 1" = 1' - 0"

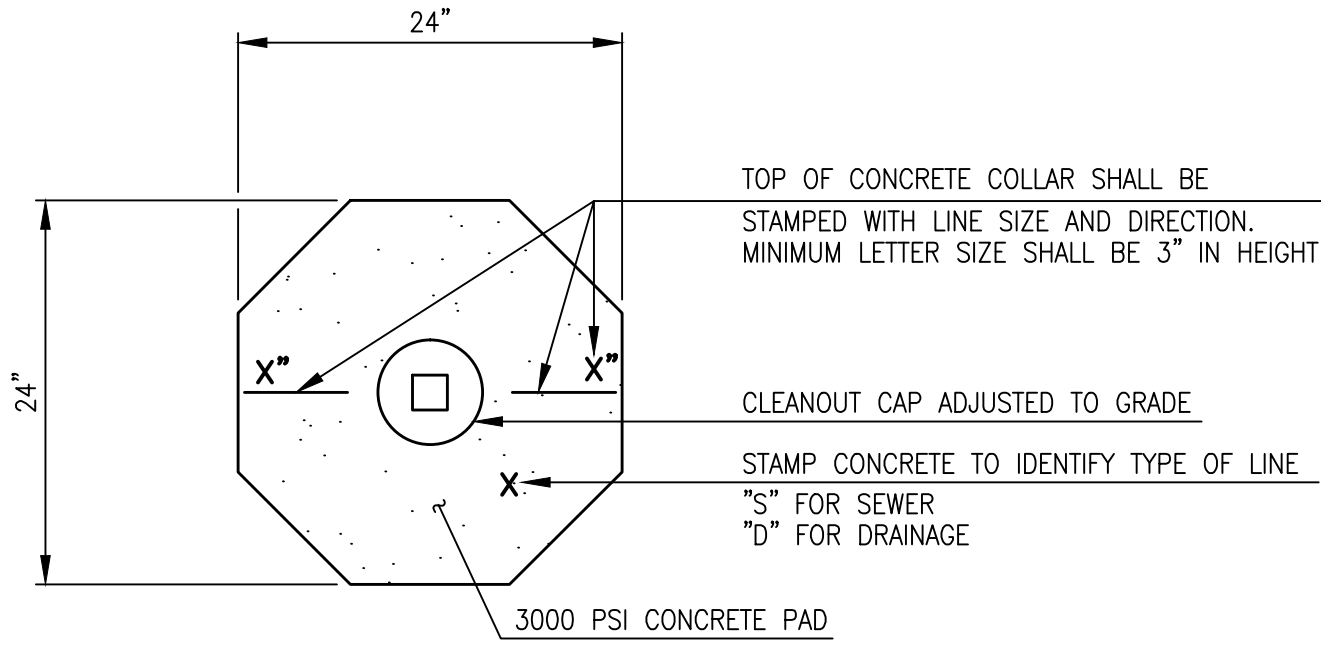


C3 TYPICAL CLEANOUT COLLAR DETAIL
SCALE: 1" = 1'-0"

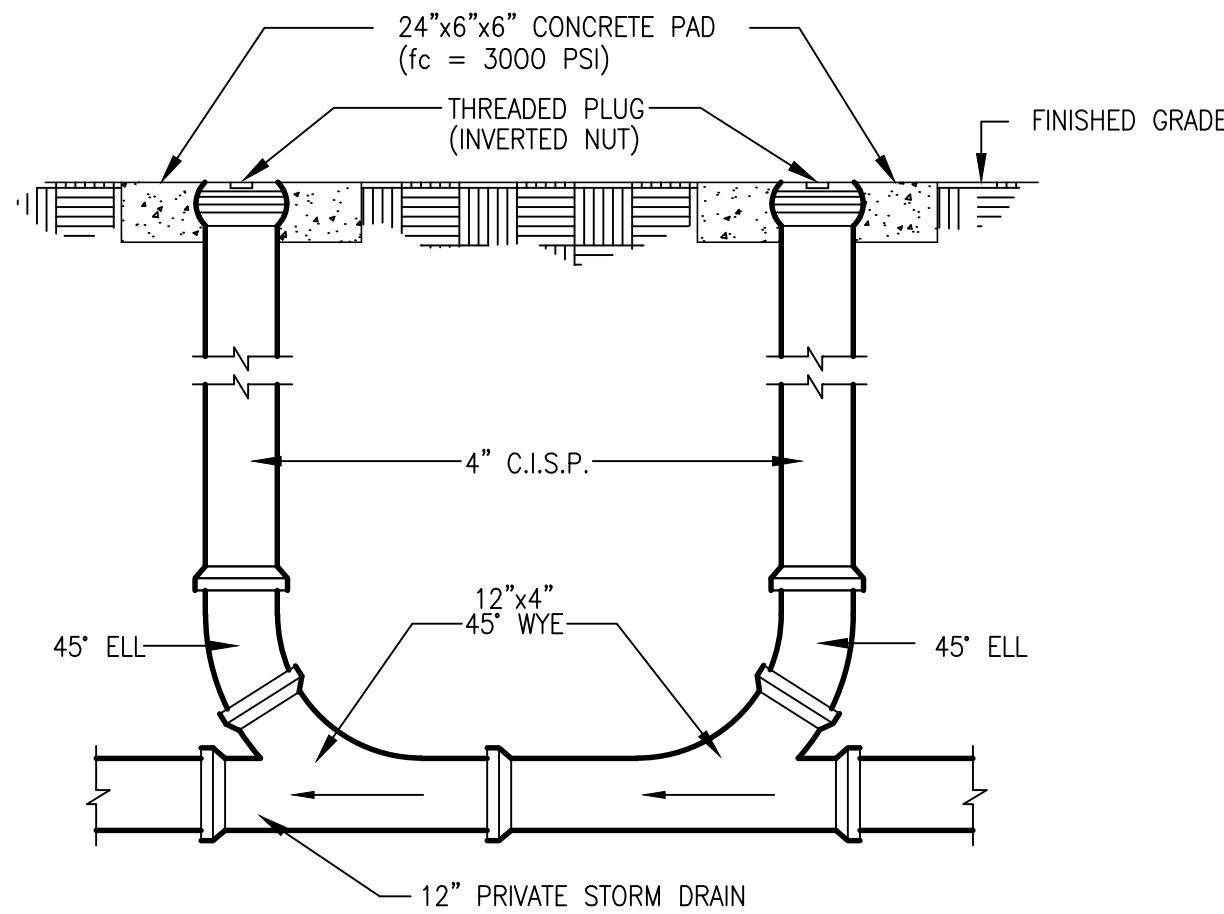

A3 TYPICAL DOUBLE CLEANOUT SECTION
NOT TO SCALE

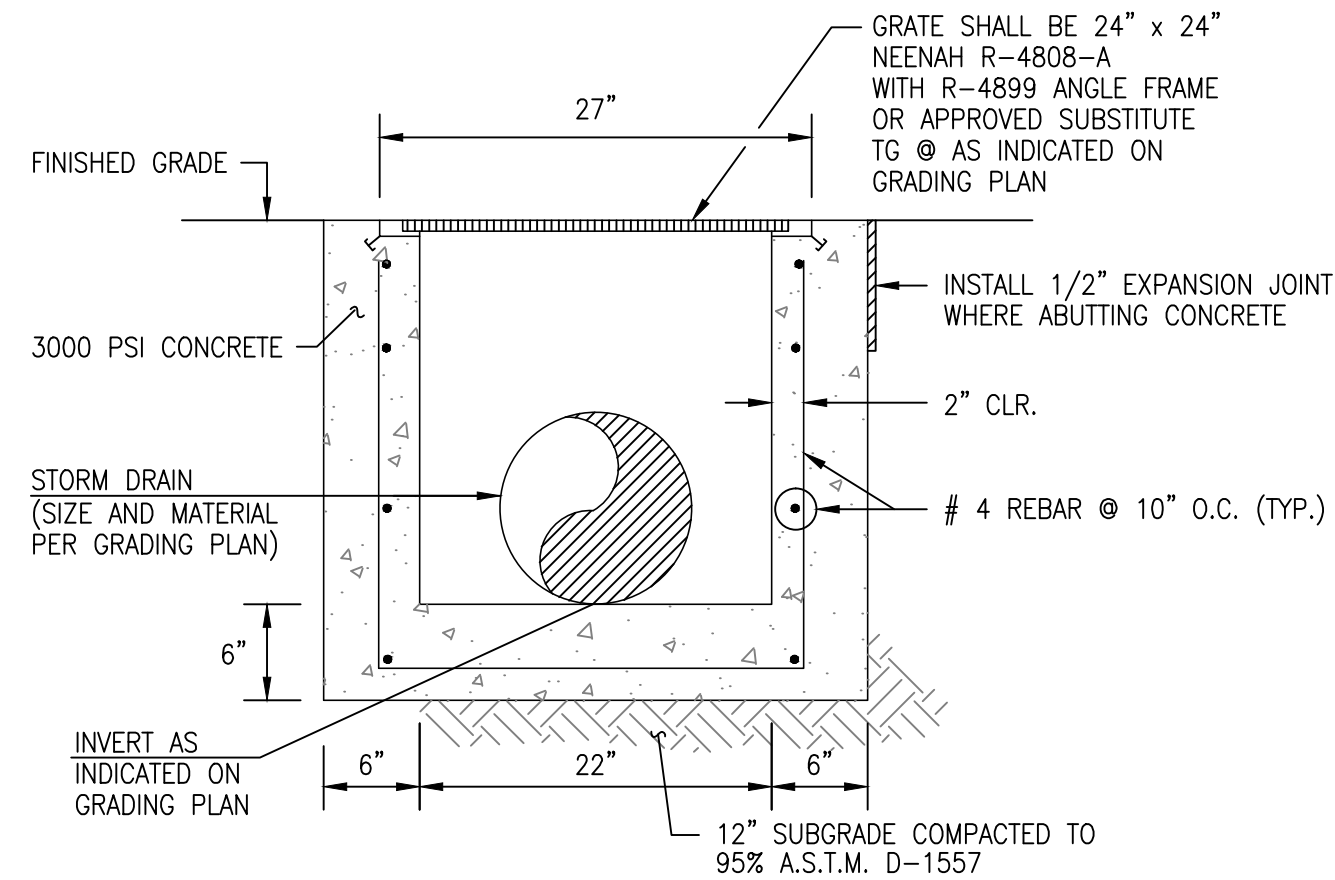

D5 TYPICAL 24"X24" STORM INLET SECTION
SCALE: 1" = 1' - 0"

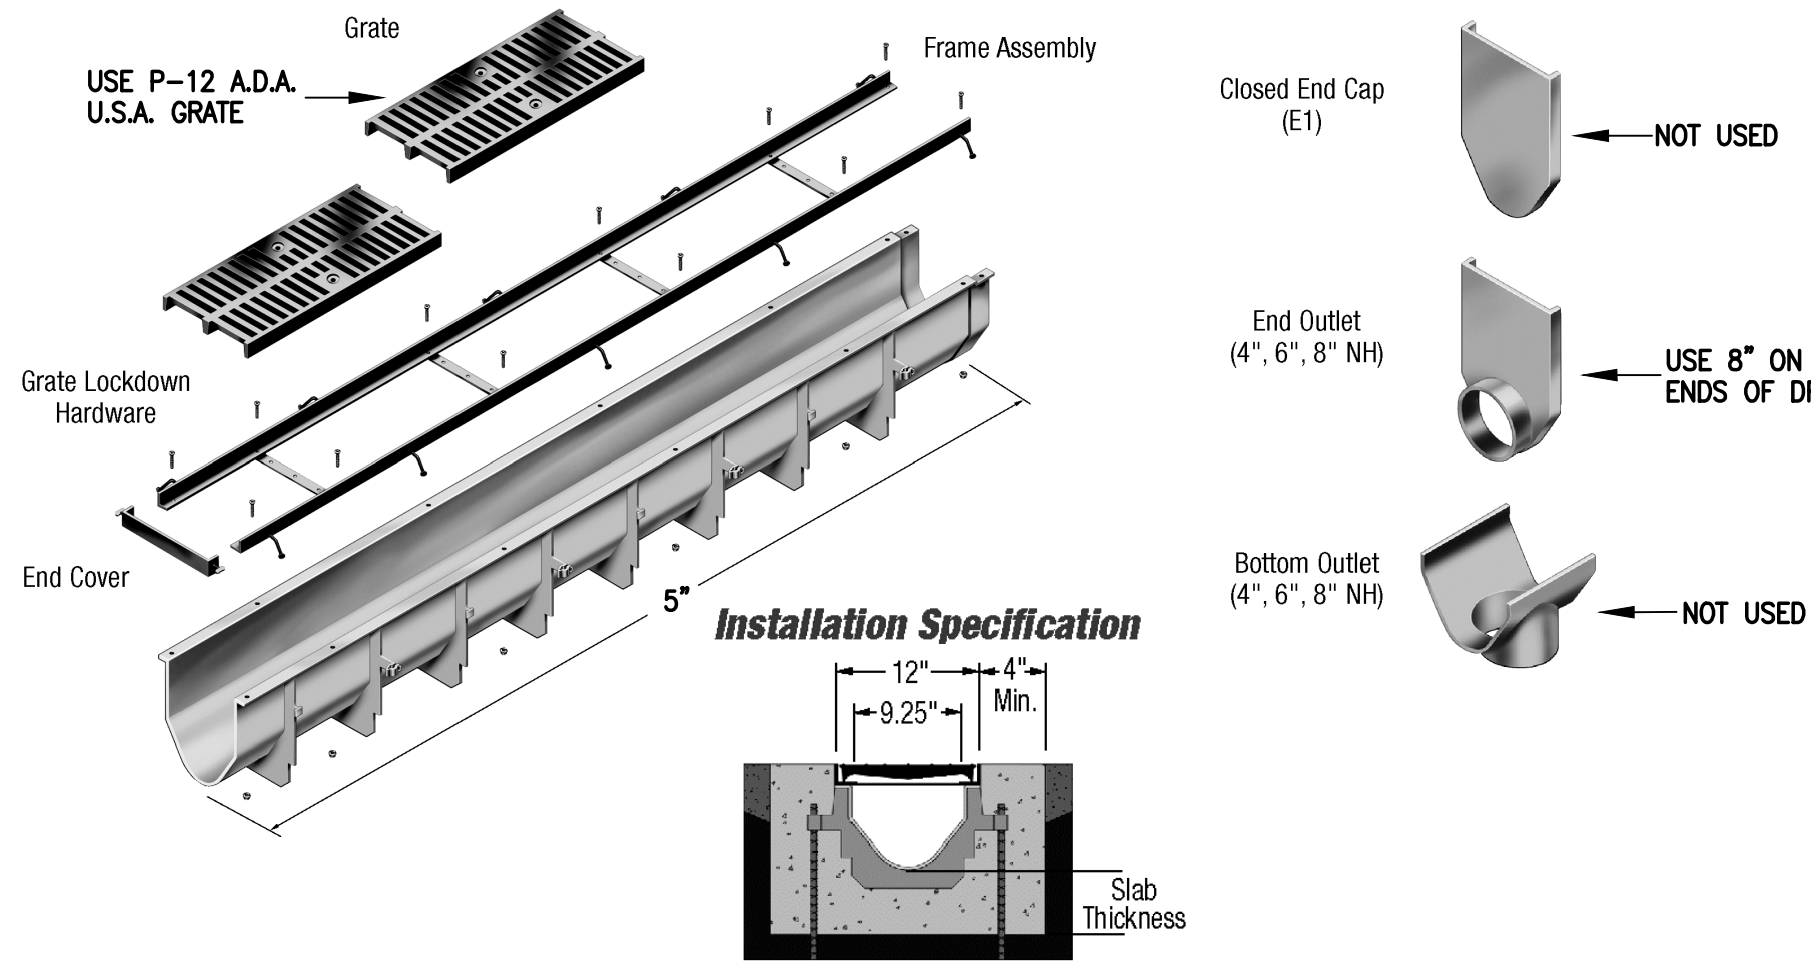

A5 TRENCH DRAIN SECTIONS AND DETAILS (ZURN Z-882)
SCALE: 1" = 2'-0"



RECORD DRAWING

2015.184.9
2014.006.1



City of Albuquerque

Planning Department

Development & Building Services Division

DRAINAGE AND TRANSPORTATION INFORMATION SHEET (REV 09/2015)

Project Title: West Mesa High School New Classroom Building **Building Permit #:** _____ **City Drainage #:** J-10/D005
DRB#: _____ **EPC#:** _____ **Work Order#:** _____
Legal Description: Tracts 166 Through 172, Town of Atrisco Grant, Airport Unit
City Address: 6701 Fortuna RD NW

Engineering Firm: High Mesa Consulting Group **Contact:** J. Graeme Means
Address: 6010-B Midway Park Blvd NE, Albuquerque, NM 87109
Phone#: 505-345-4250 **Fax#:** 505-345-4254 **E-mail:** Gmeans@highmesacg.com

Owner: Albuquerque Public Schools **Contact:** David Ritchey
Address: 915 Oak Street SE, Albuquerque, NM 87106
Phone#: 505-848-8876 **Fax#:** 505-246-9020 **E-mail:** ritchey_d@aps.edu

Architect: NCA Architects **Contact:** Tom Wilber
Address: 1306 Rio Grande Blvd NW, Albuquerque NM 87104
Phone#: 505-255-6400 **Fax#:** _____ **E-mail:** twilber@nca-architects.com

Other Contact: N/A **Contact:** _____
Address: _____
Phone#: _____ **Fax#:** _____ **E-mail:** _____

Check all that Apply:

DEPARTMENT:

☒ HYDROLOGY/ DRAINAGE
☐ TRAFFIC/ TRANSPORTATION
☐ MS4/ EROSION & SEDIMENT CONTROL

TYPE OF SUBMITTAL:

☒ ENGINEER/ ARCHITECT CERTIFICATION
☐ CONCEPTUAL G & D PLAN
☐ GRADING PLAN
☐ DRAINAGE MASTER PLAN
☐ DRAINAGE REPORT
☐ CLOMR/LOMR
☐ TRAFFIC CIRCULATION LAYOUT (TCL)
☐ TRAFFIC IMPACT STUDY (TIS)
☐ EROSION & SEDIMENT CONTROL PLAN (ESC)
☐ OTHER (SPECIFY) _____

CHECK TYPE OF APPROVAL/ACCEPTANCE SOUGHT:

☐ BUILDING PERMIT APPROVAL
☒ CERTIFICATE OF OCCUPANCY
☐ PRELIMINARY PLAT APPROVAL
☐ SITE PLAN FOR SUB'D APPROVAL
☐ SITE PLAN FOR BLDG. PERMIT APPROVAL
☐ FINAL PLAT APPROVAL
☐ SIA/ RELEASE OF FINANCIAL GUARANTEE
☐ FOUNDATION PERMIT APPROVAL
☐ GRADING PERMIT APPROVAL
☐ SO-19 APPROVAL
☐ PAVING PERMIT APPROVAL
☐ GRADING/ PAD CERTIFICATION
☐ WORK ORDER APPROVAL
☐ CLOMR/LOMR
☐ PRE-DESIGN MEETING
☐ OTHER (SPECIFY) _____

IS THIS A RESUBMITTAL?: ☒ Yes ☐ No

DATE SUBMITTED: 7-28-16 By: Graeme Means

COA STAFF: _____ ELECTRONIC SUBMITTAL RECEIVED: _____

G. Graeme Means