

CITY OF ALBUQUERQUE



July 26, 2016

J. Graeme Means, PE
High Mesa Consulting Group
6010 -B Midway Park Blvd NE
Albuquerque, NM 87109

**Re: West Mesa High School New Classroom Building
6701 Fortuna Rd NW
Request Permanent C.O. – Not Accepted
Engineer's Stamp dated: 4/13/2015 (J10D005)
Certification dated: 7-22-16**

Dear Mr. Means

Based on the Certification received 7/22/2016, the above mentioned site cannot be accepted for release of Certificate of Occupancy by Hydrology until the following comments are addressed:

PO Box 1293

Albuquerque

- The grated lid at the northwest corner of the building is covered. The fabric needs to be removed.
- There is an open trench on the north side of the building that needs to be backfilled.
- The parking lots are fenced off with construction equipment, trucks, materials, etc. thru-out the lots and drive entrances. The parking lots need to be opened and cleared.

New Mexico 87103 An inspection by our office will need to take place after these corrects are made.

If you have any questions, you can contact me at 924-3695 or Totten Elliott at 924-3982.

www.cabq.gov

Sincerely,

Rita Harmon, P.E.
Senior Engineer, Planning Dept.
Development Review Services

TE/RH

C: email

Cordova, Camille C.; Miranda, Rachel; Sandoval, Darlene M.;
Lois Blocker

DRAINAGE PLAN

I. INTRODUCTION AND EXECUTIVE SUMMARY

THIS PROJECT, LOCATED WITHIN THE NORTHWEST MESA OF THE ALBUQUERQUE METROPOLITAN AREA, REPRESENTS A MODIFICATION TO AN EXISTING APS SCHOOL SITE WITHIN AN INFILL AREA. THE PROPOSED DEVELOPMENT IS COMPRISED OF TWO PHASES. THE FIRST PHASE IS THE CONSTRUCTION OF A NEW CLASSROOM BUILDING. THE SECOND PHASE IS DEMOLITION OF AN EXISTING CLASSROOM WING FOLLOWED BY CONSTRUCTION OF A SECOND BUILDING AND RECONSTRUCTION OF AN EXISTING COURTYARD. THE CITY HYDROLOGY FILE NO. IS J100005. THE DRAINAGE CONCEPT FOR THE PROJECT WILL BE THE CONTINUED FREE DISCHARGE OF DEVELOPED RUNOFF TO EXISTING PUBLIC AND PRIVATE STORM DRAINS THAT OUTFALL TO THE EXISTING WEST MESA DETENTION BASIN AND TO THE WEST MESA DIVERSION STORM DRAIN (CPN 538103).

THIS SUBMITTAL IS BEING MADE FOR BUILDING PERMIT APPROVAL.

II. PROJECT DESCRIPTION

THE SCHOOL SITE IS LOCATED AT THE NORTHWEST CORNER OF THE INTERSECTION OF FORTUNA ROAD NW AND 64TH STREET NW, BOTH FULLY DEVELOPED CITY STREETS. THE SITE IS DEVELOPED AS AN ALBUQUERQUE PUBLIC SCHOOLS HIGH SCHOOL. GLENRO ROAD NW, A PARTIALLY DEVELOPED CITY STREET LIES TO THE NORTH. IT LACKS CURB AND GUTTER ALONG THE SCHOOL FRONTAGE. THE CITY OF ALBUQUERQUE WEST MESA AQUATIC CENTER LIES TO THE WEST OF THE SCHOOL SITE. THE SURROUNDING AREA IS DEVELOPED, MAINLY SINGLE FAMILY RESIDENTIAL, MAKING THIS A MODIFICATION TO AN EXISTING SITE WITHIN AN INFILL AREA. THE SITE CONSISTS OF PREVIOUSLY PLATTED LOTS AND FORMER CITY STREETS THAT MAY HAVE BEEN VACATED. AS SHOWN BY PANEL 350010027H OF THE NATIONAL FLOOD INSURANCE PROGRAM FLOOD INSURANCE RATE MAPS PUBLISHED BY FEMA FOR BERNALILLO COUNTY, NEW MEXICO, REVISED AUGUST 16, 2012, THIS SITE DOES NOT LIE WITHIN A DESIGNATED FLOOD HAZARD ZONE.

III. BACKGROUND DOCUMENTS

THE PREPARATION OF THIS PLAN RELIED UPON THE FOLLOWING DOCUMENTS AND ACTIVITIES:

1. BOUNDARY, TOPOGRAPHIC, AND UTILITY SURVEY PREPARED BY HIGH MESA CONSULTING GROUP DATED 3/26/2014 (HMPS 11184). THIS SURVEY PROVIDES THE BASIS FOR THE EXISTING CONDITIONS OF THE PROJECT SITE.
2. PREDESIGN CONFERENCE RECAPS DATED 02-13-2014 AND 9-10-2014 CONDUCTED WITH HIGH MESA CONSULTING GROUP. THE RECAPS CONFIRMED THAT THE CONTINUED FREE DISCHARGE OF DEVELOPED RUNOFF TO THE ADJACENT PUBLIC STORM DRAIN SYSTEMS VIA PRIVATE STORM DRAIN CONNECTIONS IS APPROPRIATE, AND THAT IT IS PERMISSIBLE TO DIVERT RUNOFF FROM EXISTING BASINS 104 AND 105 TO THE FORTUNA STORM DRAIN.
3. DRAINAGE PLAN FOR WEST MESA HIGH SCHOOL CLASSROOM WING "M" REPLACEMENT & COURTYARD IMPROVEMENTS PREPARED BY HIGH MESA CONSULTING GROUP DATED 12/31/2014 (NMPE 13676). THIS SUBMITTAL SUPPORTED WORK ORDER APPROVAL FOR A NEW STORM DRAIN CONNECTION TO FORTUNA THAT WILL SERVE THIS NEW BUILDING CONSTRUCTION. THIS SUBMITTAL INCLUDED A COMPREHENSIVE ANALYSIS OF EXISTING CONDITIONS AND SUPPORTED THE DIVERSION OF APPROXIMATELY 2.2 ACRES OF THE HIGH SCHOOL SITE TO THE EXISTING 72 INCH PUBLIC STORM DRAIN IN FORTUNA RD VIA THE NEW STORM DRAIN CONNECTION, AS IDENTIFIED IN THIS REFERENCE DOCUMENT. HISTORIC BULDOZING IN THIS WATERSHED HAS RESULTED IN A NET REDUCTION OF 47 ACRES OF DEVELOPED PROPERTY DRAINING TO FORTUNA AS COMPARED TO THE BASINS ESTABLISHED FOR THE PUBLIC STORM DRAINS. 4.0 ACRES FROM THE WEST MESA AQUATIC CENTER, AND A NET OF 0.7 ACRES WITHIN THE HIGH SCHOOL DUE TO ON-SITE PRIVATE STORM DRAIN CONSTRUCTION UNDER REFERENCE 4. THIS DECREASE IN AREA DRAINING TO FORTUNA MEANS THERE IS CORRESPONDING EXCESS CAPACITY SWITCHING 2.2 ACRES AS PROPOSED WILL STILL LEAVE A NET DECREASE OF 2.5 ACRES DRAINING TO FORTUNA AFTER IMPLEMENTATION OF THIS NEW PROPOSED CONNECTION AND DIVERSION.
4. WORK ORDER CONSTRUCTION PLANS FOR WEST MESA HIGH SCHOOL PUBLIC AND PRIVATE WATER, SANITARY SEWER, AND STORM DRAIN LIAISON SITE IMPROVEMENTS APPLICABLE TO A HIGH SCHOOL SITE. AS EXPLAINED AND DEMONSTRATED BY THE AFOREMENTIONED DRAINAGE PLAN (REF. 4), THE OVERALL SITE IS CHARACTERIZED BY THIRTEEN (13) DRAINAGE BASINS, OF WHICH FOUR WILL BE AFFECTED BY THIS PROJECT.

IV. EXISTING CONDITIONS

THIS SITE IS DEVELOPED AS A HIGH SCHOOL OPERATED AND MAINTAINED BY THE ALBUQUERQUE PUBLIC SCHOOLS (APS). THE SCHOOL SITE CONSISTS OF PERMANENT AND PORTABLE CLASSROOM BUILDINGS, PAVED PARKING AREAS AND WALKWAYS, LANDSCAPING, ATHLETIC FIELDS, AND OTHER SITE IMPROVEMENTS APPLICABLE TO A HIGH SCHOOL SITE. AS EXPLAINED AND DEMONSTRATED BY THE AFOREMENTIONED DRAINAGE PLAN (REF. 4), THE OVERALL SITE IS CHARACTERIZED BY THIRTEEN (13) DRAINAGE BASINS, OF WHICH FOUR WILL BE AFFECTED BY THIS PROJECT.

FOR THE PURPOSES OF THIS SPECIFIC PROJECT, THE IMPACTED PORTION OF THE SITE HAS BEEN DIVIDED INTO TWO DRAINAGE BASINS WITH BASIN A BEING THE PORTION OF THE SITE THAT DISCHARGES DIRECTLY TO AN EXISTING PRIVATE STORM DRAIN SYSTEM THAT CURRENTLY DRAINS TO THE EAST TO THE EXISTING PUBLIC WEST MESA DIVERSION STORM DRAIN, AND BASIN B BEING THE PORTION THAT DRAINS OVERLAND TO THE EXISTING INTERNAL PRIVATE STORM DRAIN SYSTEM. THESE BASINS ARE SHOWN ON SHEET CG-101. THERE ARE NO OFFSITE FLOWS DISCHARGING OUTDO THE PROJECT SITE AS THE PROJECT LIMITS LIE WELL WITHIN THE OVERALL SCHOOL SITE AND NOT ADJACENT TO NEIGHBORING PROPERTIES.

V. DEVELOPED CONDITIONS

THE OVERALL PROJECT CONSISTS OF CONSTRUCTING TWO NEW BUILDINGS TO REPLACE THE EXISTING "M" HALL AND RE-CONSTRUCTING THE EXISTING COURTYARD. THE PROJECT WILL BE CONSTRUCTED IN PHASES, WITH THE FIRST PHASE BEING CONSTRUCTION OF BUILDING "A" WITHIN AN EXISTING PARKING LOT. AS SHOWN BY THE GRADING PLAN ON SHEET CG-102, THE ROOF DRAINS AND A PORTION OF SITE WORK WILL DRAIN DIRECTLY TO THE NEW STORM DRAIN CONNECTION TO THE EXISTING 72 INCH PUBLIC STORM DRAIN IN FORTUNA TO BE CONSTRUCTED UNDER CITY WORK ORDER IN ACCORDANCE WITH THE CONCEPT ESTABLISHED BY THE AFOREMENTIONED PLAN (REF. 3) AND THE PREDESIGN RECAPS (REF. 2). THIS FIRST PHASE IS INTENDED TO STAND ALONE WITH THE INTENT OF OBTAINING A CERTIFICATE OF OCCUPANCY FOR BUILDING "A" IN ADVANCE OF PHASE 2 CONSTRUCTION. THIS IS ACCEPTABLE BECAUSE PHASE 1 CONSTRUCTION DOES NOT RELY UPON PHASE 2 IMPROVEMENTS. PHASE 1 CONSTRUCTION LIES WITHIN AN EXISTING PAVED PARKING LOT, HENCE THE NEW CONSTRUCTION WILL NOT RESULT IN AN INCREASE IN RUNOFF DURING THE INTERIM CONDITION BETWEEN PHASE 1 AND PHASE 2.

PHASE 2 CONSTRUCTION WILL INCLUDE THE DEMOLITION OF THE EXISTING "M" HALL, CONSTRUCTION OF BUILDING "B", AND RECONSTRUCTION OF THE EXISTING COURTYARD. THE PRIVATE STORM DRAIN THAT WILL DISCHARGE TO THE NEW FORTUNA CONNECTION WILL BE EXTENDED WITH THIS PHASE TO SERVE BUILDING "B" AND THE COURTYARD. AN EXISTING STORM DRAIN CURRENTLY SERVING THE COURTYARD WILL BE REPLACED WITH A NEW STORM DRAIN.

AS SHOWN BY THE PLANS, SITE ROOF DRAINAGE WILL BE DIRECTLY PIPED TO PROPOSED PRIVATE STORM DRAINS. ALL SITE SURFACE RUNOFF WILL BE DIRECTED TO NEW STORM DRAIN INLETS THAT ARE MOSTLY LOCATED IN LANDSCAPED AREAS THAT WILL HAVE A CRUSHED FINES SURFACING. IN MOST CASES, THE CONCEPT OF "DISCONNECTED IMPERVIOUSNESS" IS EMPLOYED WHEREBY RUNOFF FROM HARDCAPED AREAS FLOWS ACROSS THE CRUSHER FINES BEFORE REACHING THE INLETS. BECAUSE THIS IS AN INFILL PROJECT AT AN EXISTING SCHOOL CAMPUS, THERE IS LIMITED ABILITY TO INTRODUCE AREAS OF RETENTION IN THE PERVIOUS AREAS BECAUSE THEY ARE INTENDED FOR STUDENTS TO GATHER DURING LUNCH BREAK, AND RETENTION WOULD RESULT IN STANDING WATER IN PEDESTRIAN AREAS. AS SUCH, THE INTENT OF THE "FIRST FLUSH" REQUIREMENTS WILL NOT BE MET BY A SPECIFIC RETENTION OF VOLUME, BUT RATHER THROUGH THE USE OF DISCONNECTED IMPERVIOUSNESS COMBINED WITH THE AFOREMENTIONED TRANSFER OF 2.2 ACRES OF AREA FROM THE CURRENT FREE DISCHARGE CONDITION TO THE WEST MESA DIVERSION STORM DRAIN, TO THE WEST MESA DETENTION POND THAT IS IDENTIFIED AS A WATER QUALITY FEATURE ON THE AMAFCA MAINTENANCE MAPS.

VI. GRADING PLAN (SHEET CG-102)

THE GRADING PLAN ON SHEET CG-102 SHOWS 1) EXISTING AND PROPOSED GRADINGS INDICATED BY SPOT ELEVATIONS AND CONTOURS AT 1'-0" INTERVALS, 2) THE LIMIT AND CHARACTER OF THE EXISTING AND PROPOSED IMPROVEMENTS, 3) PROPOSED PRIVATE STORM DRAIN IMPROVEMENTS, AND 4) CONTINITY BETWEEN EXISTING AND PROPOSED GRADINGS.

VII. CALCULATIONS

CALCULATIONS SHOWN HEREON ANALYZE THE EXISTING AND DEVELOPED CONDITIONS FOR THE 100-YEAR, 6-HOUR RAINFALL EVENT. THE PROCEDURE FOR 40 ACRE AND SMALLER BASINS, AS SET FORTH IN THE REVISION OF SECTION 22.2, HYDROLOGY OF THE DEVELOPMENT PROCESS MANUAL, VOLUME 2, DESIGN CRITERIA, DATED JANUARY 1989, WILL BE USED TO QUANTIFY THE PEAK RATE OF DISCHARGE AND VOLUME OF RUNOFF GENERATED. AS SHOWN BY THE CALCULATIONS, THERE WILL BE A MINOR DECREASE IN 100-YEAR VOLUME AND NO CHANGE IN 100-YEAR PEAK DISCHARGE ATTRIBUTABLE TO THIS PROJECT.

VIII. CONCLUSIONS

THE FOLLOWING CONCLUSIONS HAVE BEEN ESTABLISHED AS A RESULT OF THE ANALYSIS AND EVALUATIONS CONTAINED HEREIN:

1. THE PROPOSED IMPROVEMENTS REPRESENT MODIFICATIONS TO AN EXISTING SITE WITHIN AN INFILL AREA.
2. THE FREE DISCHARGE OF DEVELOPED RUNOFF TO THE ADJACENT PUBLIC STORM DRAIN IS CONSISTENT WITH THE PREVIOUSLY APPROVED PLANS FOR THE SCHOOL SITE AND WITH MASTER DRAINAGE PLANS FOR THE WATERSHED.
3. THE PROPOSED IMPROVEMENTS WILL NOT ADVERSELY IMPACT DOWNSTREAM PROPERTIES OR DOWNSTREAM DRAINAGE CONDITIONS.
4. THE PROPOSED DIVERSION OF RUNOFF FROM 2.2 ACRES OF THE HIGH SCHOOL WAS ESTABLISHED BY PREVIOUS SUBMITTAL, AND WILL RESULT IN THIS AREA BEING ROUTED THROUGH A PUBLIC DETENTION FACILITY WITH WATER QUALITY BENEFITS.
5. THE PROPOSED IMPROVEMENTS WILL NOT AFFECT NOR BLOCK OFFSITE FLOWS.

1

2.20

142.880

SF

3.28

AC

101.310

SF

TREATMENT

A

B

C

D

AREA (SF/AC)

9.900 / 0.23

7.000 / 0.16

84.410 / 1.94

%

9.8

6.9

83.3

100

41.570

SF

TREATMENT

A

B

C

D

AREA (SF/AC)

5.120 / 0.12

5.080 / 0.12

31.370 / 0.72

%

12.3

12.2

75.5

100

72.030

SF

TREATMENT

A

B

C

D

AREA (SF/AC)

11.770 / 0.27

11.140 / 0.26

49.120 / 1.13

%

16.3

15.5

68.2

100

21.680

SF

TREATMENT

A

B

C

D

AREA (SF/AC)

580 / 0.01

21.100 / 0.48

%

2.7

97.3

100

25.950

SF

TREATMENT

A

B

C

D

AREA (SF/AC)

370 / 0.01

25.580 / 0.59

%

1.4

98.6

100

23.220

SF

TREATMENT

A

B

C

D

AREA (SF/AC)

840 / 0.02

3.560 / 0.08

18.820 / 0.43

%

3.6

15.3

81.1

100

1

2.20

142.880

SF

3.28

AC

101.310

SF

TREATMENT

A

B

C

D

AREA (SF/AC)

9.900 / 0.23

7.000 / 0.16

84.410 / 1.94

%

9.8

6.9

83.3

100

41.570

SF

TREATMENT

A

B

C

D

AREA (SF/AC)

5.120 / 0.12

5.080 / 0.12

31.370 / 0.72

%

12.3

12.2

75.5

100

72.030

SF

TREATMENT

A

B

C

D

AREA (SF/AC)

11.770 / 0.27

11.140 / 0.26

49.120 / 1.13

%

16.3

15.5

68.2

100

21.680

SF

TREATMENT

A

B

C

D

AREA (SF/AC)

580 / 0.01

21.100 / 0.48

%

2.7

97.3

100

25.950

SF

TREATMENT

A

B

C

D

AREA (SF/AC)

370 / 0.01

25.580 / 0.59

%

1.4

98.6

100

23.220

SF

TREATMENT

A

B

C

D

AREA (SF/AC)

840 / 0.02

3.560 / 0.08

18.820 / 0.43

%

3.6

15.3

81.1

100

1

2.20

142.880

SF

3.28

AC

101.310

SF

TREATMENT

A

B

C

D

AREA (SF/AC)

9.900 / 0.23

7.000 / 0.16

84.410 / 1.94

%

9.8

6.9

83.3

100

41.570

SF

TREATMENT

A

B

C

D

AREA (SF/AC)

5.120 / 0.12

5.080 / 0.12

31.370 / 0.72

%

12.3

12.2

75.5

100

72.030

SF

TREATMENT

A

B

C

D

AREA (SF/AC)

11.770 / 0.27

11.140 / 0.26

49.120 / 1.13

%

16.3

15.5

68.2

100

21.680

SF

TREATMENT

A

B

C

D

AREA (SF/AC)

580 / 0.01

21.100 / 0.48

%

2.7

97.3

100

25.950

SF

TREATMENT

A

B

C

D

AREA (SF/AC)

370 / 0.01

25.580 / 0.59

%

1.4

98.6

100

23.220

SF

TREATMENT

A

B

C

D

AREA (SF/AC)

840 / 0.02

3.560 / 0.08

18.820 / 0.43

%

3.6

15.3

81.1

100

1

2.20

142.880

SF

3.28

AC

101.310

SF

TREATMENT

A

B

C

D

AREA (SF/AC)

9.900 / 0.23

7.000 / 0.16

84.410 / 1.94

%

9.8

6.9

83.3

100

41.570

SF

TREATMENT

A

B

C

D

AREA (SF/AC)

5.120 / 0.12

5.080 / 0.12

31.370 / 0.72

%

12.3

12.2

75.5

100

72.030

SF

TREATMENT

A

B

C

D

AREA (SF/AC)

11.770 / 0.27

11.140 / 0.26

49.120 / 1.13

%

16.3

15.5

68.2

100

21.680

SF

TREATMENT

A

B

C

D

AREA (SF/AC)

580 / 0.01

21.100 / 0.48

%

2.7

97.3

100

25.950

SF

TREATMENT

A

B

C


D

AREA (SF/AC)

370 / 0.01



25.580 / 0.59

LEGEND	
ADO AR BLDG BOH CLM C&G C C/P-M	AUTOMATIC DOOR OPENER ASPHALT RAMP BUILDING BUILDING OVERHANG BARBED WIRE CURB & GUTTER COMMUNICATIONS LINE COMMUNICATIONS LINE BY PAINT MARK
CAM CBC CC CDP CGP CMH CHC CLD CLDD COMC CL CMP CMU CONC CPB CR CRD CS CSP CSW CTC DBL DCO	CAMERA CONCRETE BUILDING COLUMN COMMUNICATIONS CONDUIT CONCRETE DRIVE PAD CONCRETE GUARD POST COMMUNICATIONS MANHOLE CONCRETE HEADER CURB CENTERLINE DOOR CENTERLINE DOUBLE DOOR COMMUNICATIONS LINE MARKER CONCRETE LANDING COMMUNICATIONS PANEL CONCRETE MASONRY UNIT WALL CAN SANITARY SEWER CLEANOUT CONCRETE PULLBOX CONCRETE RAMP CONCRETE ROUNDOWN CONCRETE STEPS CONCRETE SPLASH PAD CONCRETE SIDEWALK CONCRETE TRASH CAN DOUBLE DOUBLE SANITARY SEWER CLEANOUT
E/P-M EA EC EO EP EPB FH FL FLC FNT FP FRD G/P-M G GRV GS HCS ICB INV IVB MCB MC/B MC/V MHR MR MTS OH(Ch) OH(E) PI PIV	ELECTRIC LINE BY PAINT MARK EDGE OF ASPHALT ELECTRIC CONDUIT ELECTRIC OUTLET ELECTRIC PANEL ELECTRIC PULLBOX FIRE HYDRANT FLOWLINE FIRE LINE CONNECTION FOUNTAIN FLAG POLE FROM RECORD DRAWING GAS LINE BY PAINT MARK GAS LINE GRAVEL GAS SERVICE HANDCAPPED PARKING SIGN IRRIGATION CONTROL BOX INVERT INVERT IRRIATION VALVE BOX METAL BUILDING COLUMN METER CAN WITH BIB VALVE METER CAN WITH VALVE MANHOLE METAL HAND RAIL METAL RAMP METAL SIGN OVERHEAD COMMUNICATIONS (# OF LINES) OVERHEAD ELECTRIC (# OF LINES) PAINTED PARKING LOT ISLAND POST INDICATOR VANE
PROPOSED SPOT ELEVATION EXISTING FLOWLINE PROPOSED FLOWLINE PROPOSED CONTOUR PROPOSED DIRECTION OF FLOW RIGHT OF WAY LINE PUBLIC EASEMENT LINE HIGH POINT / DWIDE PROPOSED STORM INLET PROPOSED STORM DRAIN MANHOLE PROPOSED FIRE HYDRANT FIRE DEPARTMENT CONNECTION HIGH POINT/WATER BLOCK	PS RRT RAS SAT SD SDI SGP SG SPD SWA TA TC TCO TG TRN TRS TV TP/M TVR UNK W/ W/PM WHB WMB WPP WW WBV XW 2.5' Ø DECIDUOUS TREE SMALL DECIDUOUS TREE CONFIFEROUS TREE SMALL CONFIFEROUS TREE SMALL SHRUB BOULDER PAINTED UTILITY MARKER STUMP INVT TOP OF ASPHALT PAVEMENT TOP OF CURB TG + 20.05 - 51.05 EXISTING DIRECTION OF FLOW EXISTING STORM DRAIN MH EXISTING FIRE HYDRANT EXISTING GAS MANHOLE EXISTING VALVE BOX EXISTING DOUBLE CLEANOUP EXISTING SINGLE CLEANOUP EXISTING WATER LINE --SAS-- EXISTING SANITARY SEWER --F-P-- EXISTING FIRE LINE EXISTING P.I.V. SANITARY SEWER MANHOLE PROPOSED VALVE BOX PROPOSED DOUBLE CLEANOUP PROPOSED SINGLE CLEANOUP PROPOSED WATER SERVICE PROPOSED WATER LINE PROPOSED SANITARY SEWER PROPOSED FIRE LINE PROPOSED P.I.V. PROPOSED STORM DRAIN PROPOSED CONCRETE PROPOSED CRUSHER FINES / LANDSCAPED AREA DRAINAGE BASIN PHASE LINE
ENGINEER'S FINAL DRAINAGE CERTIFICATION	
I, J. GRAEME MEANS, NMPE 13676, OF THE FIRM HIGH MESA CONSULTING GROUP HEREBY CERTIFY THAT THIS PROJECT HAS BEEN GRADED AND DRAINED IN SUBSTANTIAL COMPLIANCE WITH AND IN ACCORDANCE WITH THE DESIGN INTENT OF THE APPROVED PLAN DATED 10-31-2013. THE RECORD INFORMATION EDITED ONTO THE ORIGINAL DESIGN DOCUMENT WAS OBTAINED 6-24-2014 AND 5/12/16 BY HIGH MESA CONSULTING GROUP UNDER THE DIRECTION OF CHARLES G. CALA, JR., NMPS 11184, AND IS TRUE AND CORRECT TO THE BEST OF MY KNOWLEDGE AND BELIEF. THIS CERTIFICATION IS SUBMITTED TO SATISFY CONDITIONS OF APPROVAL FOR BUILDING PERMIT AND TO DOCUMENT COMPLETION OF THE IMPROVEMENTS FOR THE OWNER. THE CERTIFA WAS PREVIOUSLY CERTIFIED IN JULY OF 2015 AT WHICH TIME A TEMPORARY CO WAS RECOMMENDED FOR THE KINDERGARTEN BUILDING DUE TO REQUIRED CORRCTIONS. THIS SUBMITAL NO RECOMMENS PERMANENT CERTIFICATE OF OCCUPANCY FOR THE KINDERGARTEN ADDITION. AS IDENTIFIED BY THE PREVIOUS SUBMITMAL, THERE WAS AN AREA OF ASPHALT PAVEMEMNT THAT REQUIRED REMOVAL AND REPLACEMENT. THIS WORK HAS BEEN DONE AND IS DOCUMENTED ON REVISED SHEET C-301-K. ADDITIONALLY, THE APRONS AROUND THE BUILDING HAVE BEEN REMOVED AND REPLACED AT THE REQUEST OF THE ARCHITECT. THE AS-BUILT CONDITION IS ALSO DOCUMENTED ON SHEET C-301-K. THE RECORD INFORMATION PRESENTED HEREON IS NOT NECESSARILY COMPLETE AND INTENDED ONLY TO VERIFY SUBSTANTIAL COMPLIANCE OF THE GRADING AND DRAINAGE ASPECTS OF THIS PROJECT. THIS CERTIFICATION DOES NOT ADDRESS ADA COMPLIANCE WHICH IS BEYOND THE SCOPE OF GRADING AND DRAINAGE. THOSE RELYING ON THIS RECORD DOCUMENT ARE ADVISED TO OBTAIN INDEPENDENT VERIFICATION OF ITS ACCURACY BEFORE USING IT FOR ANY OTHER PURPOSE.	
J.GRAEME MEANS, NMPE 13676	
DATE 07/22/2016	
INDEX OF DRAWINGS	
SHEET	DESCRIPTION
CG-001	DRAINAGE PLAN & CALCULATIONS
CG-101	OVERALL DRAINAGE SITE PLAN
CG-102	GRADING PLAN
CG-501	STORM DRAIN MANHOLE SECTIONS & DETAILS
CG-502	DRAINAGE SECTIONS & DETAILS
CU-101	WATER AND SANITARY SEWER SITE PLAN
CU-501	WATER AND SANITARY SEWER SECTIONS & DETAILS

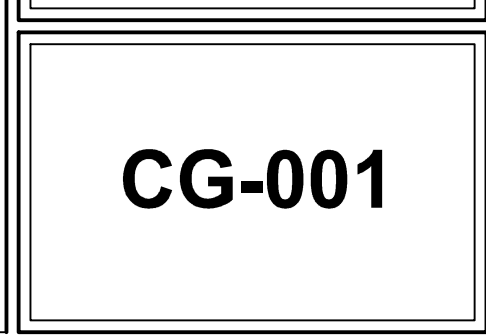


NOTE:
THIS IS NOT A BOUNDARY SURVEY; APPARENT PROPERTY CORNERS ARE SHOWN FOR ORIENTATION ONLY.
THE BOUNDARY AND TOPOGRAPHIC INFORMATION DEPICTED HEREON IS BASED UPON THE BOUNDARY,
TOPOGRAPHIC AND UTILITY SURVEYS PREPARED BY HIGH MESA CONSULTING GROUP, NMPS NO. 11184,
DATED 03/28/2014 (2013.180.3).

B1 OVERALL DRAINAGE SITE PLAN
SCALE: 1" = 100'

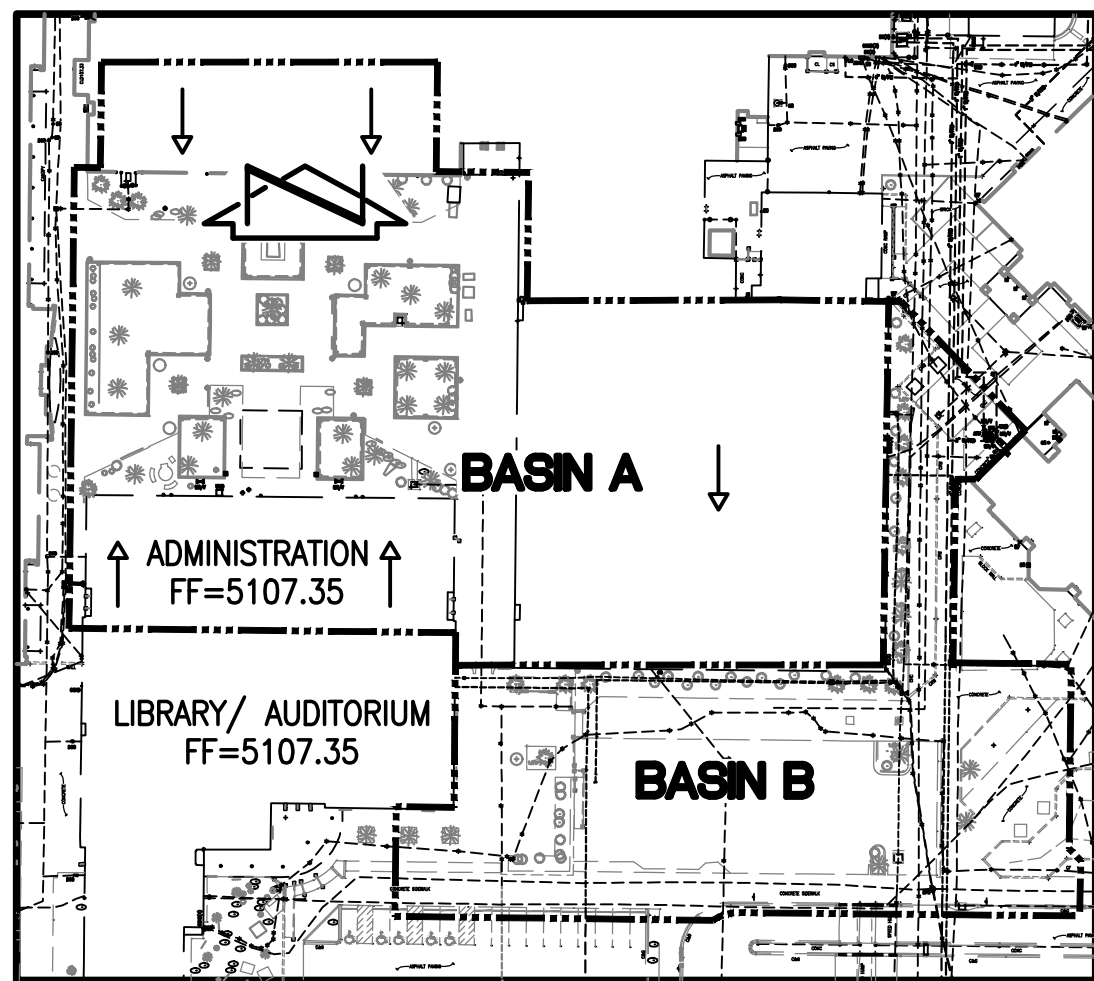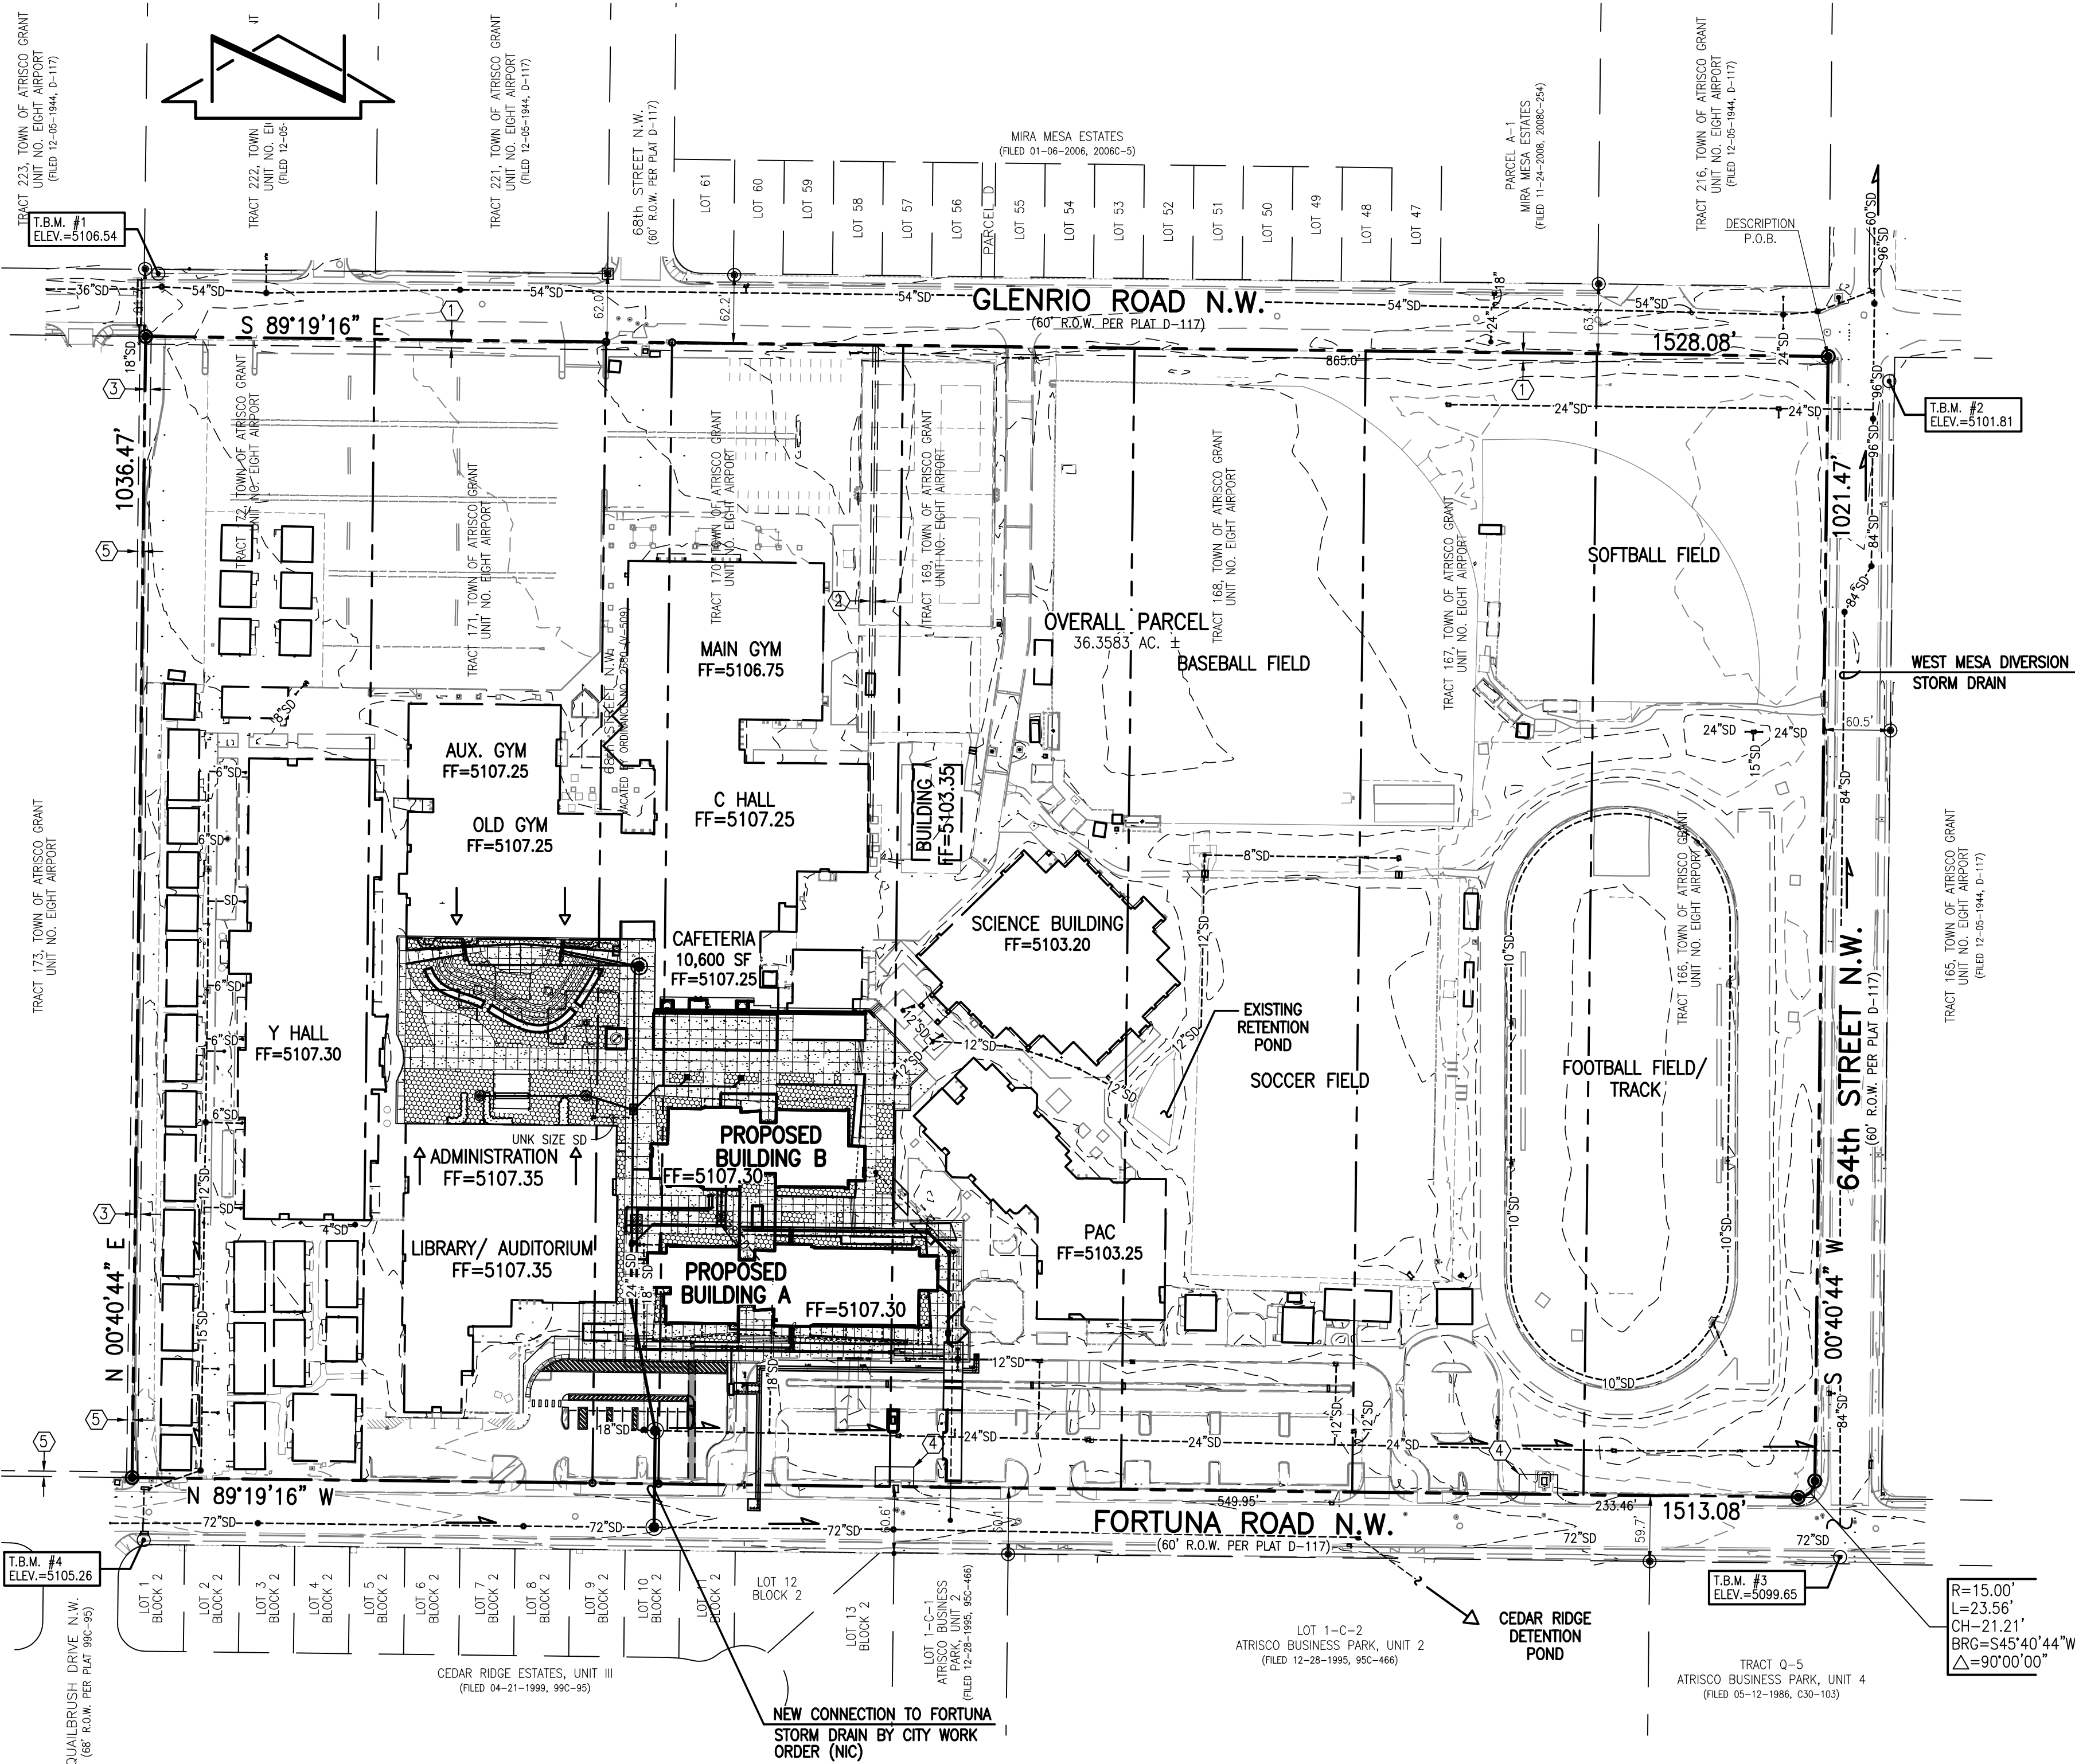

A2 EXISTING BASIN PLAN
SCALE: 1" = 100'

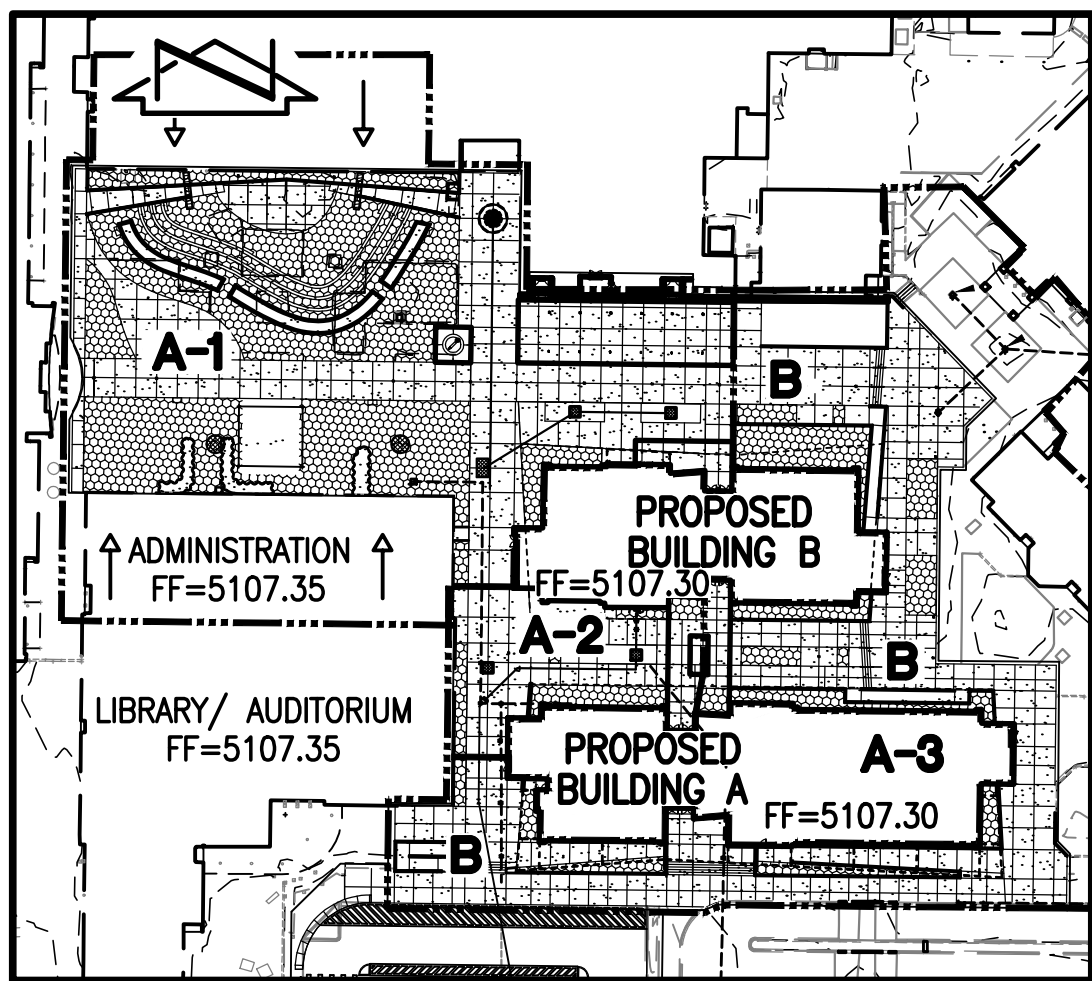

A3 PROPOSED BASIN PLAN
SCALE: 1" = 100'

BENCHMARKS

PROJECT BENCHMARK

AN A.G.R.S. BRASS DISK STAMPED "18-J11", SET FLUSH IN THE SIDEWALK. LOCATED IN THE NORTHEAST QUADRANT OF THE INTERSECTION OF COORS ROAD AND GLENRIO ROAD. ELEVATION = 5099.609 FEET (NAVD 1988)

LEGAL DESCRIPTION

TRACTS 166 THROUGH 172, INCLUSIVE, TOWN OF ATRISCO GRANT, AIRPORT UNIT, ALBUQUERQUE, NEW MEXICO.

EXISTING EASEMENTS

- 7' PNM AND MST&T EASEMENT GRANTED BY DOCUMENT EXECUTED 09-08-1965
- 5' PNM AND MST&T EASEMENT GRANTED BY DOCUMENT EXECUTED 09-08-1965
- 5' PNM AND MST&T EASEMENT GRANTED BY DOCUMENT EXECUTED 04-07-1969
- ABCWUA PUBLIC WATER LINE EASEMENT FOR WATER METERS GRANTED BY DOCUMENT FILED 07-20-2010, DOC. #2010072287
- 5' PNM AND MST&T EASEMENT DEPICTED BY DOCUMENT EXECUTED 04-07-1969

CONSTRUCTION NOTES:

- TWO (2) WORKING DAYS PRIOR TO ANY EXCAVATION, CONTRACTOR MUST CONTACT NEW MEXICO ONE CALL (811) FOR DESIGNATION (LINE-SPOTTING) OF EXISTING PUBLIC UTILITIES AND EXISTING PRIVATE UTILITIES OWNED AND OPERATED BY ALBUQUERQUE PUBLIC SCHOOLS.
- PRIOR TO CONSTRUCTION, THE CONTRACTOR SHALL EXCAVATE AND VERIFY THE HORIZONTAL AND VERTICAL LOCATION OF ALL POTENTIAL OBSTRUCTIONS. SHOULD A CONFLICT EXIST, THE CONTRACTOR SHALL NOTIFY THE ENGINEER IN WRITING SO THAT THE CONFLICT CAN BE RESOLVED WITH A MINIMUM AMOUNT OF DELAY. THE CONTRACTOR SHALL BE RESPONSIBLE FOR ALL INTERPRETATIONS IT MAKES WITHOUT FIRST CONTACTING THE ENGINEER AS REQUIRED ABOVE.
- ALL WORK ON THIS PROJECT SHALL BE PERFORMED IN ACCORDANCE WITH APPLICABLE FEDERAL, STATE AND LOCAL LAWS, RULES AND REGULATIONS CONCERNING CONSTRUCTION SAFETY AND HEALTH.
- ALL CONSTRUCTION WITHIN PUBLIC RIGHT-OF-WAY SHALL BE PERFORMED IN ACCORDANCE WITH APPLICABLE CITY OF ALBUQUERQUE STANDARDS AND PROCEDURES.
- IF ANY UTILITY LINES, PIPELINES, OR UNDERGROUND UTILITY LINES ARE SHOWN ON THESE DRAWINGS, THEY ARE SHOWN IN AN APPROXIMATE MANNER ONLY. AND SUCH LINES MAY EXIST WHERE NONE ARE SHOWN. IF ANY SUCH EXISTING LINES ARE SHOWN, THE LOCATION IS BASED UPON INFORMATION PROVIDED BY THE OWNER OF SAID UTILITY, AND THE INFORMATION MAY BE INCOMPLETE, OR MAY BE OBSOLETE BY THE TIME CONSTRUCTION COMMENCES. THE ENGINEER HAS CONDUCTED ONLY PRELIMINARY INVESTIGATION OF THE LOCATION, DEPTH, SIZE, OR TYPE OF EXISTING UTILITY LINES, PIPELINES, OR UNDERGROUND UTILITY LINES. THIS INVESTIGATION IS NOT CONCLUSIVE, AND MAY NOT BE COMPLETE, THEREFORE, MAKES NO REPRESENTATION PERTAINING THERETO, AND ASSUMES NO RESPONSIBILITY OR LIABILITY THEREFOR. THE CONTRACTOR SHALL INFORM ITSELF OF THE LOCATION OF ANY UTILITY LINE, PIPELINE, OR UNDERGROUND UTILITY LINE IN OR NEAR THE AREA OF THE WORK IN ADVANCE OF AND DURING EXCAVATION WORK. THE CONTRACTOR IS FULLY RESPONSIBLE FOR ANY AND ALL DAMAGE CAUSED BY ITS FAILURE TO LOCATE, IDENTIFY AND PRESERVE ANY AND ALL EXISTING UTILITY LINES, PIPELINES, AND UNDERGROUND UTILITY LINES. IN PLANNING AND CONDUCTING EXCAVATION, THE CONTRACTOR SHALL COMPLY WITH STATE STATUTES, MUNICIPAL AND LOCAL ORDINANCES, RULES AND REGULATIONS, IF ANY, PERTAINING TO THE LOCATION OF THESE LINES AND FACILITIES.
- THE DESIGN OF PLANTERS AND LANDSCAPED AREAS IS NOT PART OF THIS PLAN. ALL PLANTERS AND LANDSCAPED AREAS ADJACENT TO THE BUILDING(S) SHALL BE PROVIDED WITH POSITIVE DRAINAGE TO AVOID ANY PONDING ADJACENT TO THE STRUCTURE, FOR CONSTRUCTION DETAILS, REFER TO LANDSCAPING PLAN.
- REFER TO SHEETS A-001 AND A-002 FOR DEMOLITION PLANS.
- REFER TO SHEETS A-101 TO A-107 FOR SITE PLAN AND LAYOUT.

EROSION CONTROL MEASURES:

- THE CONTRACTOR SHALL ENSURE THAT NO SOIL ERODES FROM THE SITE INTO PUBLIC RIGHT-OF-WAY OR ONTO PRIVATE PROPERTY.
- THE CONTRACTOR SHALL PROMPTLY CLEAN UP ANY MATERIAL EXCAVATED WITHIN THE PUBLIC RIGHT-OF-WAY SO THAT THE EXCAVATED MATERIAL IS NOT SUSCEPTIBLE TO BEING WASHED DOWN THE STREET.
- CONTRACTOR SHALL, ON BEHALF OF THEMSELVES AND THE OWNER, SECURE "TOPSOIL DISTURBANCE PERMIT" FROM THE CITY AND FILE A NOTICE OF INTENT (N.O.I.) WITH THE EPA PRIOR TO BEGINNING CONSTRUCTION.
- CONTRACTOR SHALL SECURE, ON BEHALF OF THE OWNER AND OPERATORS, "TOPSOIL DISTURBANCE PERMIT" FROM THE CITY AND FILE A NOTICE OF INTENT (N.O.I.) WITH THE EPA PRIOR TO BEGINNING CONSTRUCTION.
- ALL FILL SHALL BE CLEAN, FREE FROM VEGETATION, DEBRIS, AND OTHER DELETERIOUS MATERIALS, AND SHALL NOT BE CONTAMINATED WITH HYDROCARBONS OR OTHER CHEMICAL CONTAMINANTS.
- ALL FILL SHALL BE COMPACTED TO A MINIMUM OF 95% ASTM D-1557 UNLESS A GREATER COMPACTION REQUIREMENT IS OTHERWISE SPECIFIED.
- CAUTION: THESE DRAWINGS DO NOT INCLUDE NECESSARY COMPONENTS FOR CONSTRUCTION SAFETY WHICH SHALL REMAIN THE RESPONSIBILITY OF THE CONTRACTOR. ALL EXCAVATION, TRENCHING AND SHORING ACTIVITIES MUST BE CARRIED-OUT IN ACCORDANCE WITH OSHA 29 CFR 1926, SUBPART P-EXCAVATIONS.

GENERAL NOTES:

- ALL WORK DETAILED ON THESE PLANS TO BE PERFORMED UNDER CONTRACT SHALL BE RESPONSIBLE FOR ANY AND ALL DAMAGE CAUSED BY ITS FAILURE TO LOCATE, IDENTIFY AND PRESERVE ANY AND ALL EXISTING UTILITY LINES, PIPELINES, AND UNDERGROUND UTILITY LINES. IN PLANNING AND CONDUCTING EXCAVATION, THE CONTRACTOR SHALL COMPLY WITH STATE STATUTES, MUNICIPAL AND LOCAL ORDINANCES, RULES AND REGULATIONS, IF ANY, PERTAINING TO THE LOCATION OF THESE LINES AND FACILITIES.
- TWO (2) WORKING DAYS PRIOR TO ANY EXCAVATION, CONTRACTOR MUST CONTACT NEW MEXICO ONE CALL SYSTEM, 811, FOR DESIGNATION (LINE-SPOTTING) OF EXISTING PUBLIC UTILITIES AND EXISTING UTILITIES OWNED AND OPERATED BY ALBUQUERQUE PUBLIC SCHOOLS.
- IF ANY UTILITY LINES, PIPELINES, OR UNDERGROUND UTILITY LINES ARE SHOWN ON THESE DRAWINGS, THEY ARE SHOWN IN AN APPROXIMATE MANNER ONLY, AND SUCH LINES MAY EXIST WHERE NONE ARE SHOWN. IF ANY SUCH EXISTING LINES ARE SHOWN, THE LOCATION IS BASED UPON INFORMATION PROVIDED BY THE OWNER OF SAID UTILITY, AND THE INFORMATION MAY BE INCOMPLETE, OR MAY BE OBSOLETE BY THE TIME CONSTRUCTION COMMENCES. THE ENGINEER HAS CONDUCTED ONLY PRELIMINARY INVESTIGATION OF THE LOCATION, DEPTH, SIZE, OR TYPE OF EXISTING UTILITY LINES, PIPELINES, OR UNDERGROUND UTILITY LINES. THIS INVESTIGATION IS NOT CONCLUSIVE, AND MAY NOT BE COMPLETE, THEREFORE, MAKES NO REPRESENTATION PERTAINING THERETO, AND ASSUMES NO RESPONSIBILITY OR LIABILITY THEREFOR. THE CONTRACTOR SHALL INFORM ITSELF OF THE LOCATION OF ANY UTILITY LINE, PIPELINE, OR UNDERGROUND UTILITY LINE IN OR NEAR THE AREA OF THE WORK IN ADVANCE OF AND DURING EXCAVATION WORK. THE CONTRACTOR IS FULLY RESPONSIBLE FOR ANY AND ALL DAMAGE CAUSED BY ITS FAILURE TO LOCATE, IDENTIFY AND PRESERVE ANY AND ALL EXISTING UTILITY LINES, PIPELINES, AND UNDERGROUND UTILITY LINES. IN PLANNING AND CONDUCTING EXCAVATION, THE CONTRACTOR SHALL COMPLY WITH STATE STATUTES, MUNICIPAL AND LOCAL ORDINANCES, RULES AND REGULATIONS, IF ANY, PERTAINING TO THE LOCATION OF THESE LINES AND FACILITIES.
- SHOULD A CONFLICT EXIST BETWEEN THESE PLANS AND ACTUAL FIELD CONDITIONS, THE CONTRACTOR SHALL PROMPTLY NOTIFY THE ENGINEER IN WRITING SO THAT THE CONFLICT CAN BE RESOLVED WITH A MINIMUM AMOUNT OF DELAY FOR ALL PARTIES.
- THE CONTRACTOR SHALL MAINTAIN ACCESS TO ADJACENT PROPERTIES DURING CONSTRUCTION.
- ALL WORK ON THIS PROJECT SHALL BE PERFORMED IN ACCORDANCE WITH APPLICABLE FEDERAL, STATE AND LOCAL LAWS, RULES AND REGULATIONS CONCERNING SAFETY AND HEALTH.
- THE CONTRACTOR SHALL ENSURE THAT NO SOIL ERODES FROM THE SITE INTO PUBLIC RIGHT-OF-WAY OR ONTO PRIVATE PROPERTY.
- THE CONTRACTOR SHALL PROMPTLY CLEAN UP ANY MATERIAL EXCAVATED WITHIN THE PUBLIC RIGHT-OF-WAY SO THAT THE EXCAVATED MATERIAL IS NOT SUSCEPTIBLE TO BEING WASHED DOWN THE STREET.
- CONTRACTOR SHALL NOTIFY THE ENGINEER NOT LESS THAN SEVEN (7) DAYS PRIOR TO STARTING WORK IN ORDER THAT THE ENGINEER MAY TAKE NECESSARY MEASURES TO PRESERVE SURVEY MONUMENTS. CONTRACTOR SHALL NOT DISTURB PERMANENT SURVEY MONUMENTS WITHOUT THE CONSENT OF THE ENGINEER AND SHALL NOTIFY THE ENGINEER AND BEAR THE EXPENSE OF REPLACING ANY THAT MAY BE DISTURBED WITHOUT PERMISSION. REPLACEMENT SHALL BE DONE ONLY BY THE ENGINEER. WHEN A CHANGE IS MADE IN THE ELEVATION OF ANY MONUMENT COVER TO THE ROADWAY IN WHICH A PERMANENT SURVEY MONUMENT IS LOCATED, CONTRACTOR SHALL, AT HIS OWN EXPENSE, ADJUST THE MONUMENT COVER TO THE NEW GRADE UNLESS OTHERWISE SPECIFIED.
- ALL PAVEMENT MARKINGS AND TRAFFIC SIGNS SHALL COMPLY WITH THE MANUAL OF UNIFORM TRAFFIC CONTROL DEVICES (MUTCD) PUBLISHED BY THE U.S. DEPARTMENT OF TRANSPORTATION FEDERAL HIGHWAY ADMINISTRATION, LATEST EDITION.
- IF THE REMOVAL OF EXISTING CURB AND GUTTER, SIDEWALK, AND/OR PAVING IS REQUIRED, THE CONTRACTOR SHALL SAWCUT AND/OR REMOVE TO THE NEAREST JOINT. WHEN ABUTTING NEW PAVEMENT TO EXISTING, THE CONTRACTOR SHALL CUT BACK THE EXISTING PAVING TO A STRAIGHT LINE IN ORDER TO REMOVE ANY BROKEN OR CRACKED PAVEMENT. CURB AND GUTTER AND/OR PAVEMENT SHOWN AS EXISTING AND NOT TO BE REMOVED UNDER THESE PLANS SHALL BE REMOVED AND REPLACED BY THE CONTRACTOR AT THE CONTRACTOR'S EXPENSE.
- A DISPOSAL SITE FOR ALL EXCESS EXCAVATION MATERIAL (CONTAMINATED OR OTHERWISE), ASPHALTIC PAVING, CONCRETE PAVING, ETC. SHALL BE OBTAINED BY THE CONTRACTOR IN COMPLIANCE WITH APPLICABLE REGULATIONS. ALL COSTS INCURRED IN OBTAINING A DISPOSAL SITE AND IN HAUL THERETO SHALL BE CONSIDERED INCIDENTAL TO CONSTRUCTION, THEREFORE, NO SEPARATE PAYMENT SHALL BE MADE.
- A BORROW SITE FOR IMPORT MATERIAL SHALL BE OBTAINED BY THE CONTRACTOR IN COMPLIANCE WITH APPLICABLE REGULATIONS. ALL COSTS INCURRED IN OBTAINING A BORROW SITE AND IN HAUL THERETO SHALL BE CONSIDERED INCIDENTAL TO CONSTRUCTION, THEREFORE, NO SEPARATE PAYMENT SHALL BE MADE.
- THE CONTRACTOR SHALL BE RESPONSIBLE FOR SAFELY OBTAINING THE REQUIRED PERMITS AND SELECT AND USE METHODS WHICH SHALL NOT BE INJURIOUS OR DAMAGING TO THE EXISTING FACILITIES AND STRUCTURES WHICH SURROUND THE WORK AREAS.
- THE CONTRACTOR SHALL CONFINE HIS WORK WITHIN THE CONSTRUCTION LIMITS IN ORDER TO PRESERVE THE EXISTING IMPROVEMENTS AND SO AS NOT TO INTERFERE WITH THE OPERATIONS OF THE EXISTING FACILITIES.
- THE CONTRACTOR SHALL BE RESPONSIBLE FOR SELECTING APPROPRIATE MEANS AND METHODS TO EXCAVATE AND TRENCH AND/OR INSTALL PIPE SO AS TO NOT EXCEED RIGHT-OF-WAY OR EASEMENT LIMITS, AND SO AS NOT TO INTERFERE WITH OTHER UTILITIES OR IMPROVEMENTS. THIS SHALL BE CONSIDERED INCIDENTAL TO CONSTRUCTION, THEREFORE, NO SEPARATE PAYMENT WILL BE MADE.
- THE CONTRACTOR SHALL BE RESPONSIBLE FOR PROTECTING, SUPPORTING AND REPLACING, IF DAMAGED, ALL UTILITIES ENCOUNTERED DURING CONSTRUCTION. THIS SHALL BE CONSIDERED INCIDENTAL TO CONSTRUCTION, THEREFORE, NO SEPARATE PAYMENT WILL BE MADE.
- ALL DIMENSIONS AND RADII OF CURB, CURB RETURNS, AND WALLS ARE SHOWN TO THE FACE OF CURB AND/OR WALL.
- CONTRACTOR SHALL NOTIFY THE OWNER 48 HOURS PRIOR TO STRIPING SO THAT LAYOUT CAN BE VERIFIED.
- PRIOR TO CONSTRUCTION, THE CONTRACTOR SHALL EXCAVATE AND VERIFY THE HORIZONTAL AND VERTICAL LOCATION OF ALL POTENTIAL OBSTRUCTIONS. SHOULD A CONFLICT EXIST, THE CONTRACTOR SHALL NOTIFY THE ENGINEER IN WRITING SO THAT THE CONFLICT CAN BE RESOLVED WITH A MINIMUM AMOUNT OF DELAY. THE CONTRACTOR SHALL BE RESPONSIBLE FOR ALL INTERPRETATIONS IT MAKES WITHOUT FIRST CONTACTING THE ENGINEER AS REQUIRED ABOVE.
- CONTRACTOR SHALL SECURE, ON BEHALF OF THE OWNER AND OPERATORS, "TOPSOIL DISTURBANCE PERMIT" FROM THE CITY AND FILE A NOTICE OF INTENT (N.O.I.) WITH THE EPA PRIOR TO BEGINNING CONSTRUCTION.
- ALL FILL SHALL BE CLEAN, FREE FROM VEGETATION, DEBRIS, AND OTHER DELETERIOUS MATERIALS, AND SHALL NOT BE CONTAMINATED WITH HYDROCARBONS OR OTHER CHEMICAL CONTAMINANTS.
- ALL FILL SHALL BE COMPACTED TO A MINIMUM OF 95% ASTM D-1557 UNLESS A GREATER COMPACTION REQUIREMENT IS OTHERWISE SPECIFIED.
- CAUTION: THESE DRAWINGS DO NOT INCLUDE NECESSARY COMPONENTS FOR CONSTRUCTION SAFETY WHICH SHALL REMAIN THE RESPONSIBILITY OF THE CONTRACTOR. ALL EXCAVATION, TRENCHING AND SHORING ACTIVITIES MUST BE CARRIED-OUT IN ACCORDANCE WITH OSHA 29 CFR 1926, SUBPART P-EXCAVATIONS.

MAHMAN ARCHITECTURE
2045 BRADWAY BLVD. S.E.
ALBUQUERQUE, NM 87102
505.243.0101 fax 505.243.1334
WWW.MAHMANSTUDIO.COM

CONSULTANT:
HIGH MESA CONSULTING GROUP
6010 S. MIDWAY PARK BLVD. NE
ALBUQUERQUE, NM 87113
PHONE: 505.345.4250 FAX: 505.345.4251
www.highmesacg.com

PROJECT NO: WMHS
FILE NAME:
DRAWN BY: J.Y.R./S.C.C.
CHECKED BY: G.M.
COPYRIGHT:
DATE: 03-2015

SHEET TITLE:
OVERALL DRAINAGE SITE PLAN

CG-101

WEST MESA HIGH SCHOOL
NEW CLASSROOM BUILDING

6701 FORTUNA RD. NW
ALBUQUERQUE, NM 87121

ALBUQUERQUE PUBLIC SCHOOLS

07/16
RECORD DRAWING AND
CERTIFICATION-PAGE 1


MARK
MMDDYY
DESCRIPTION

SURVEY NOTE:

THIS IS NOT A BOUNDARY SURVEY; DATA IS SHOWN FOR ORIENTATION ONLY. THE BOUNDARY INFORMATION DEPICTED BY THIS PLAN IS BASED UPON A BOUNDARY SURVEY PREPARED BY HIGH MESA CONSULTING GROUP, NMPS 11184, DATED 03/28/2014 (2013.180.3). THIS IS NOT A TOPOGRAPHIC SURVEY. THE TOPOGRAPHIC AND UTILITY INFORMATION DEPICTED HEREON IS BASED UPON THE TOPOGRAPHIC AND UTILITY SURVEY PREPARED BY HIGH MESA CONSULTING GROUP, NMPS NO. 11184, DATED 03/28/2014 (2013.180.3).

NOTES:

1. REFER TO SHEET C-001 FOR LEGEND AND CONSTRUCTION NOTES.
2. REFER TO SHEETS A-001 AND A-002 FOR DEMOLITION PLANS.
3. REFER TO SHEETS A-101 TO A-107 FOR SITE PLAN AND LAYOUT.
4. GRADES SHOWN ARE FINISHED GRADE. LANDSCAPE AREAS SHALL BE LEFT 4" BELOW DESIGN GRADE FOR SUBSEQUENT INSTALLATION BY SEPARATE PROJECT (NIC).

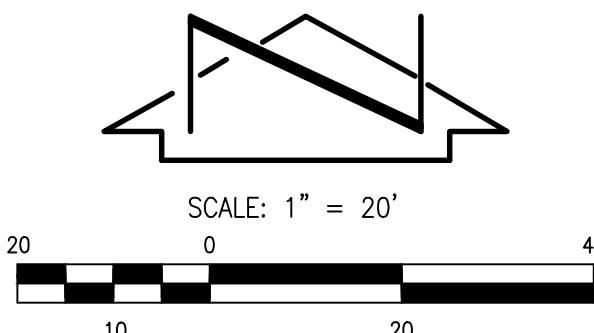

**WEST MESA HIGH SCHOOL
NEW CLASSROOM
BUILDING**


6701 FORTUNA RD. NW
ALBUQUERQUE, NM 87121
ALBUQUERQUE PUBLIC SCHOOLS

DATE	REVISION	DESCRIPTION
07/16	01/16	RECORD DRAWING
05/16	02/16	VARIOUS REVISIONS
03/16	03/16	ADDED ROOF DRAIN CONNECTION
08/27/15	08/27/15	ADDITIONAL RD CONNECTIONS
05/14/15	05/14/15	ADDENDUM #2
N/A	N/A	NO CHANGE
MM/DD/YY	MM/DD/YY	DESCRIPTION

PROJECT NO: WMHS
FILE NAME:
DRAWN BY: J.Y.R./S.C.C.
CHECKED BY: G.M.
COPYRIGHT:
DATE: 03-2015

SHEET TITLE:
**GRADING
PLAN**

CG-102

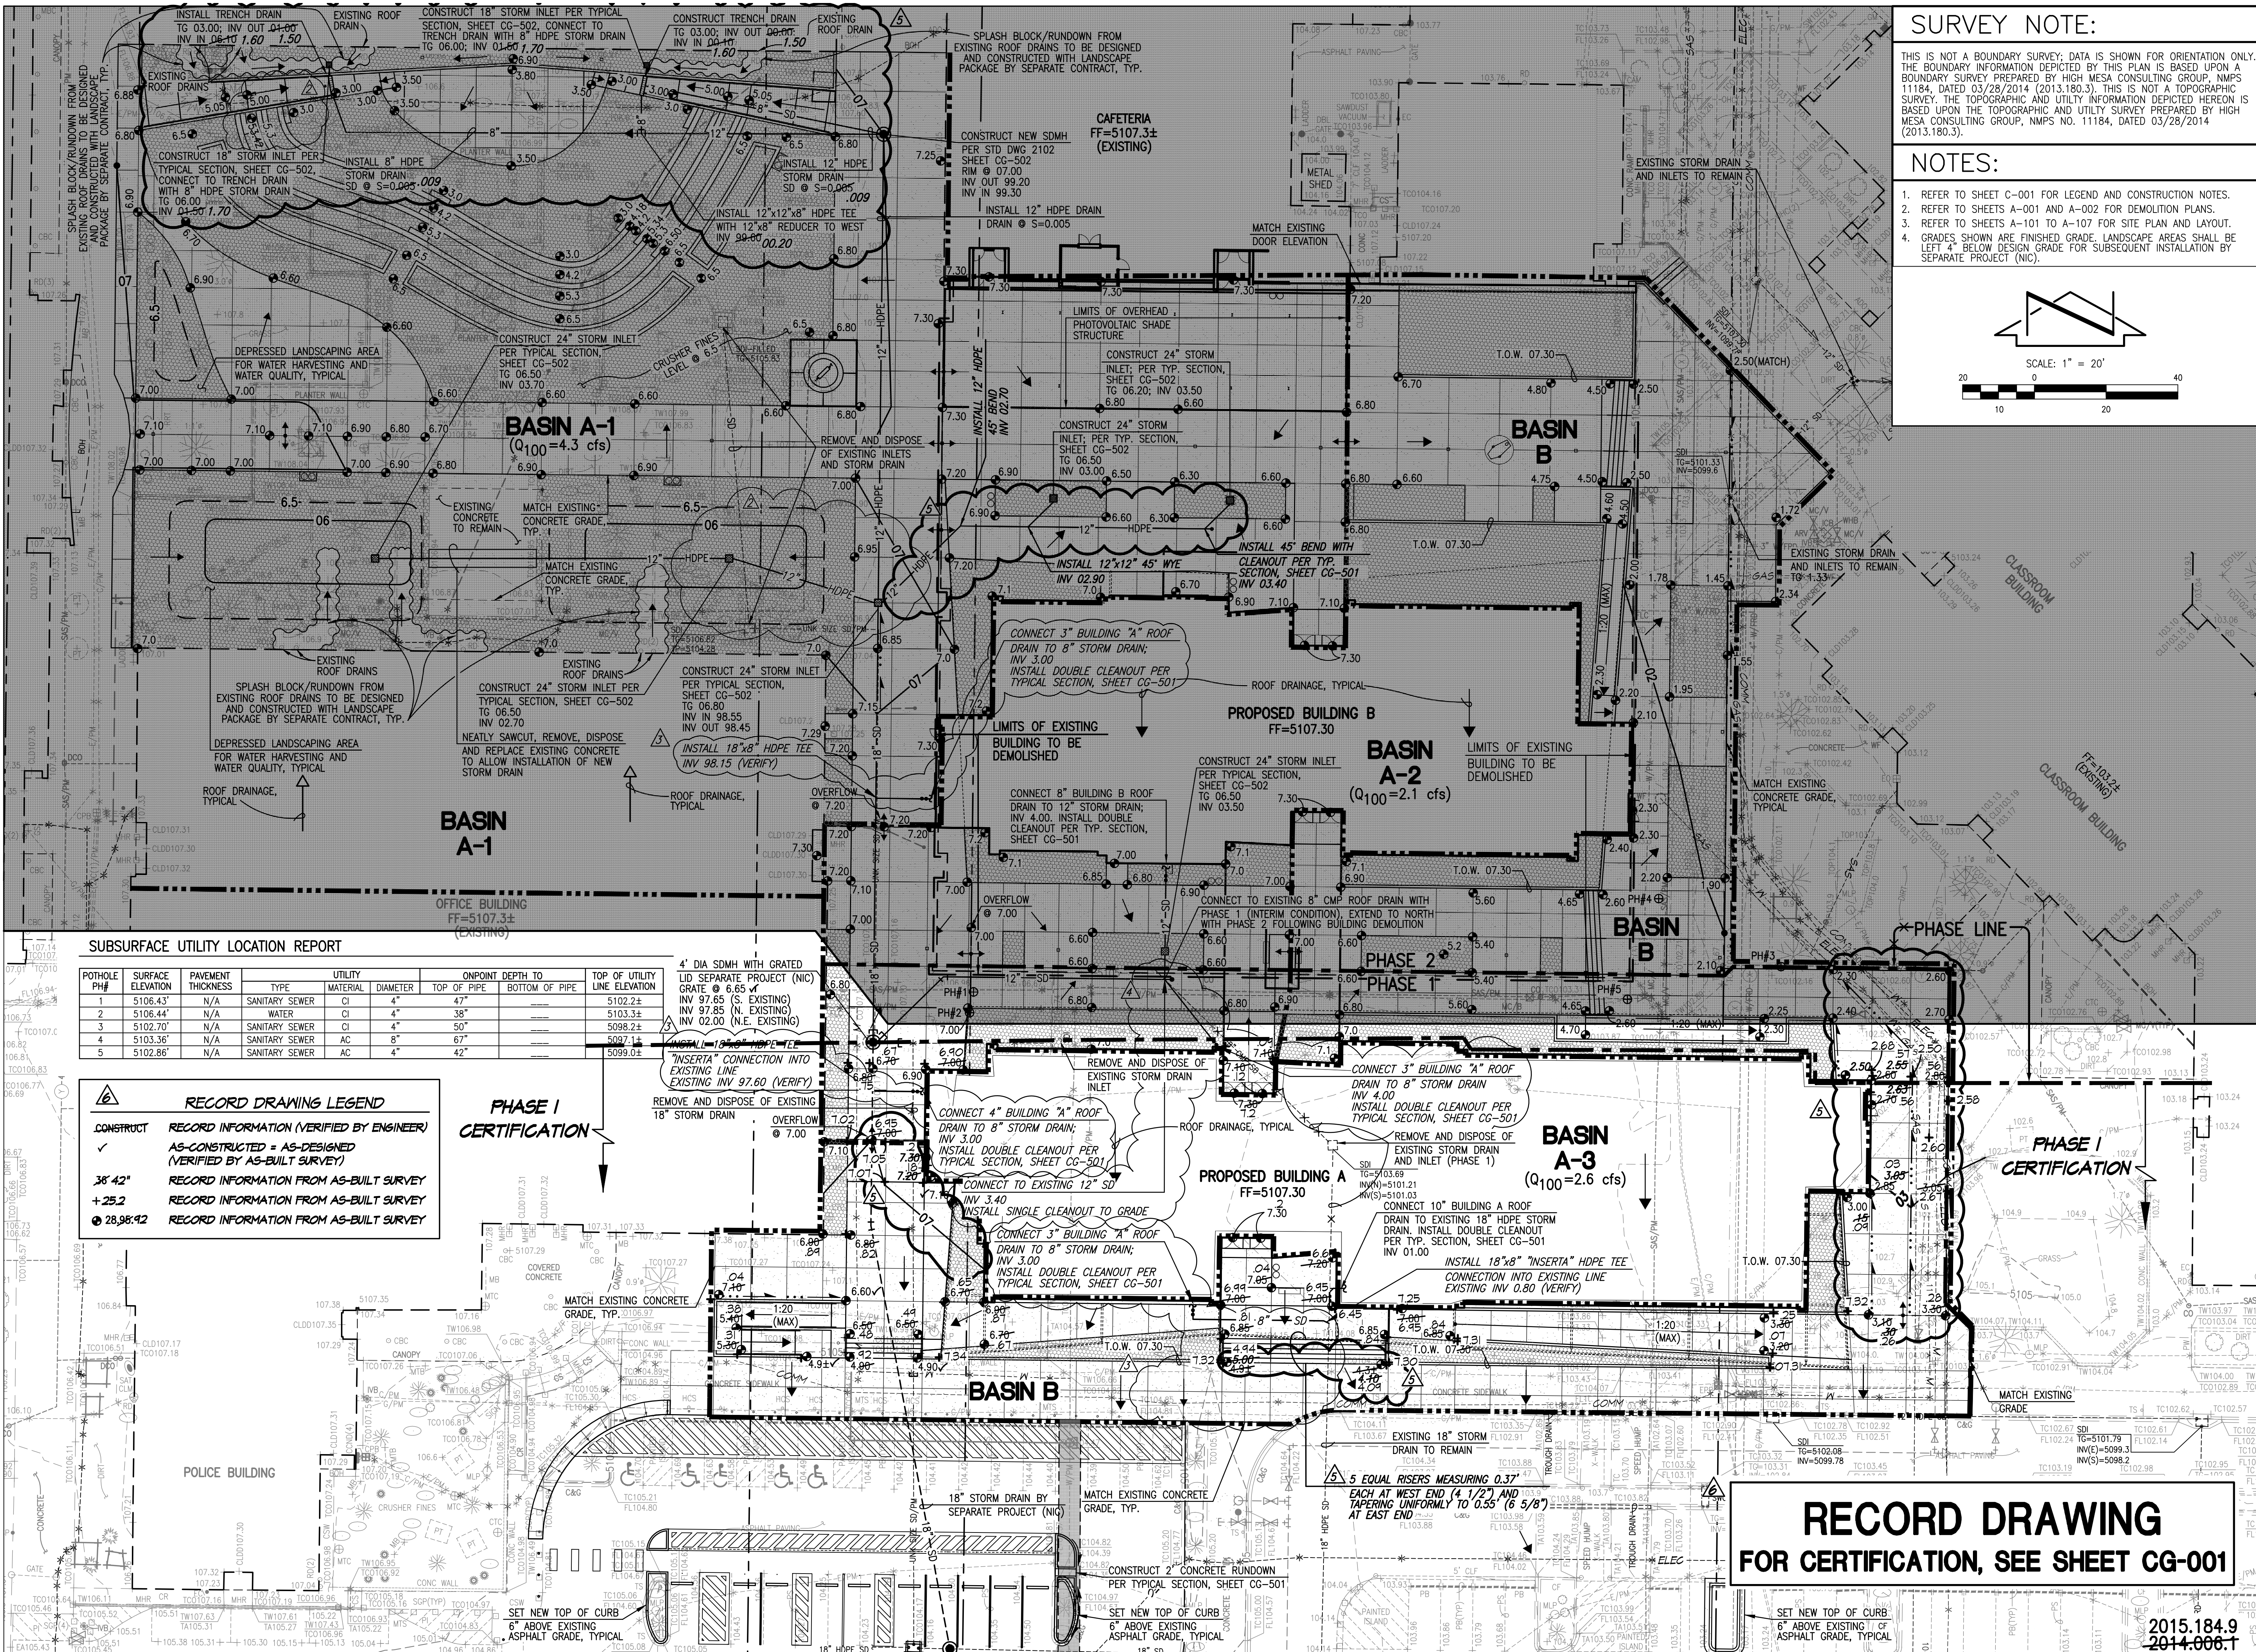

SUBSURFACE UTILITY LOCATION REPORT







POT HOLE PH#	SURFACE ELEVATION	PAVEMENT THICKNESS	TYPE	UTILITY MATERIAL	DIAMETER	ONPOINT DEPTH TO TOP OF PIPE	TOP OF UTILITY LINE ELEVATION
1	5106.43'	N/A	SANITARY SEWER	CI	4"	47"	5102.24'
2	5106.44'	N/A	WATER	CI	4"	38"	5103.34'
3	5102.70'	N/A	SANITARY SEWER	CI	4"	50"	5098.24'
4	5103.36'	N/A	SANITARY SEWER	AC	8"	67"	5097.14'
5	5102.86'	N/A	SANITARY SEWER	AC	4"	42"	5099.04'

CONSTRUCT	RECORD INFORMATION (VERIFIED BY ENGINEER)
✓	AS-CONSTRUCTED = AS-DESIGNED (VERIFIED BY AS-BUILT SURVEY)
38" 42"	RECORD INFORMATION FROM AS-BUILT SURVEY
+25.2	RECORD INFORMATION FROM AS-BUILT SURVEY
28.98:42	RECORD INFORMATION FROM AS-BUILT SURVEY

PHASE I CERTIFICATION

RECORD DRAWING FOR CERTIFICATION, SEE SHEET CG-001

2015.184.9
2014.006.1

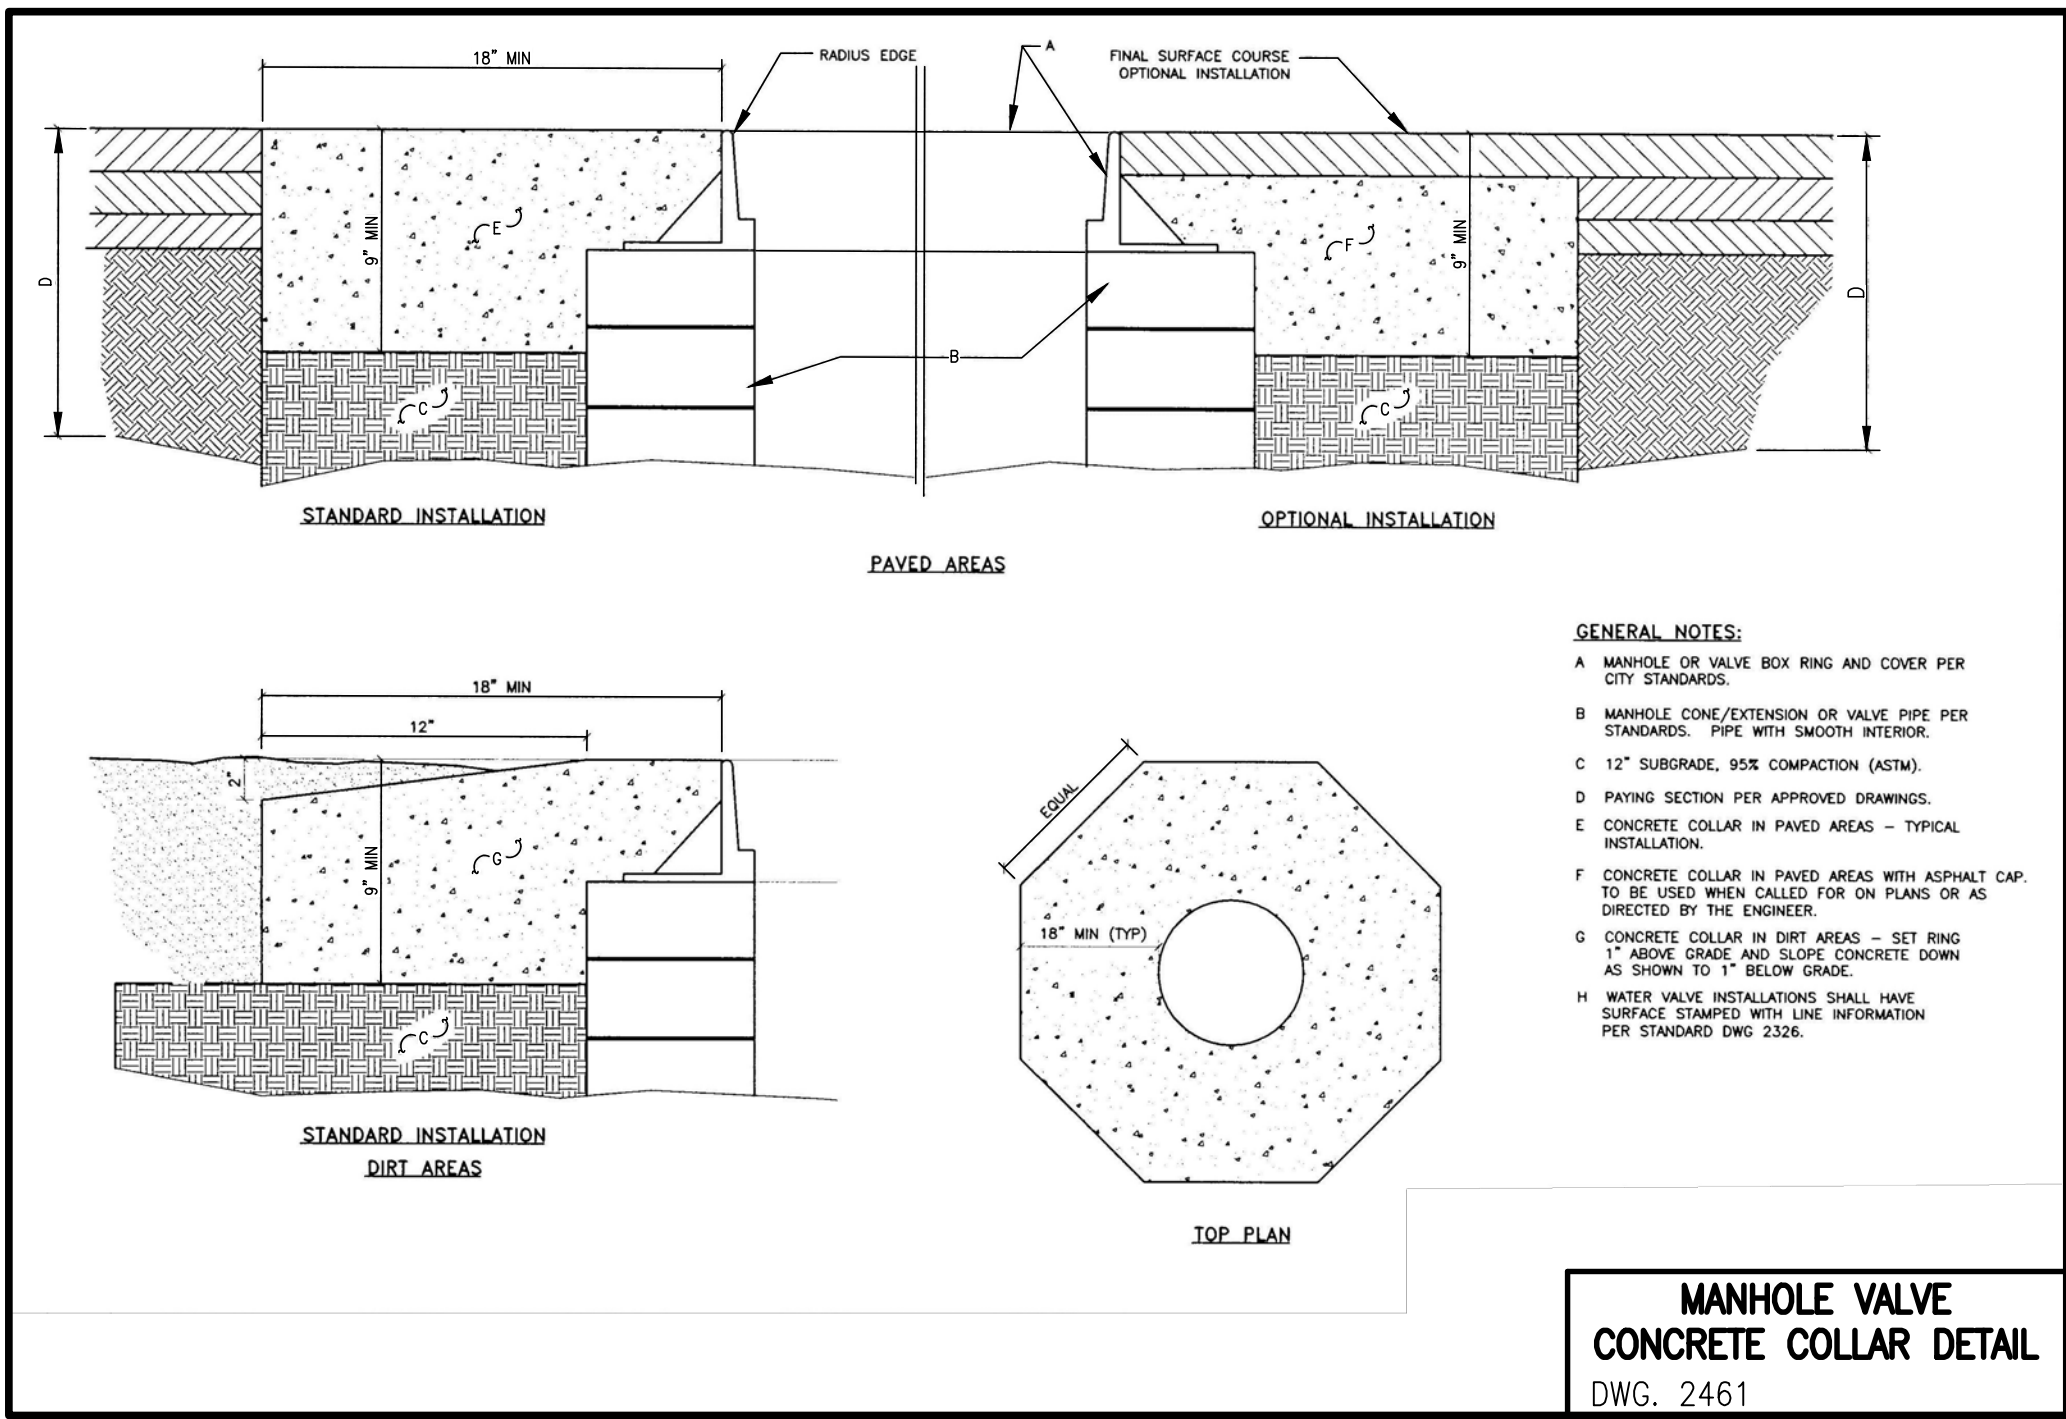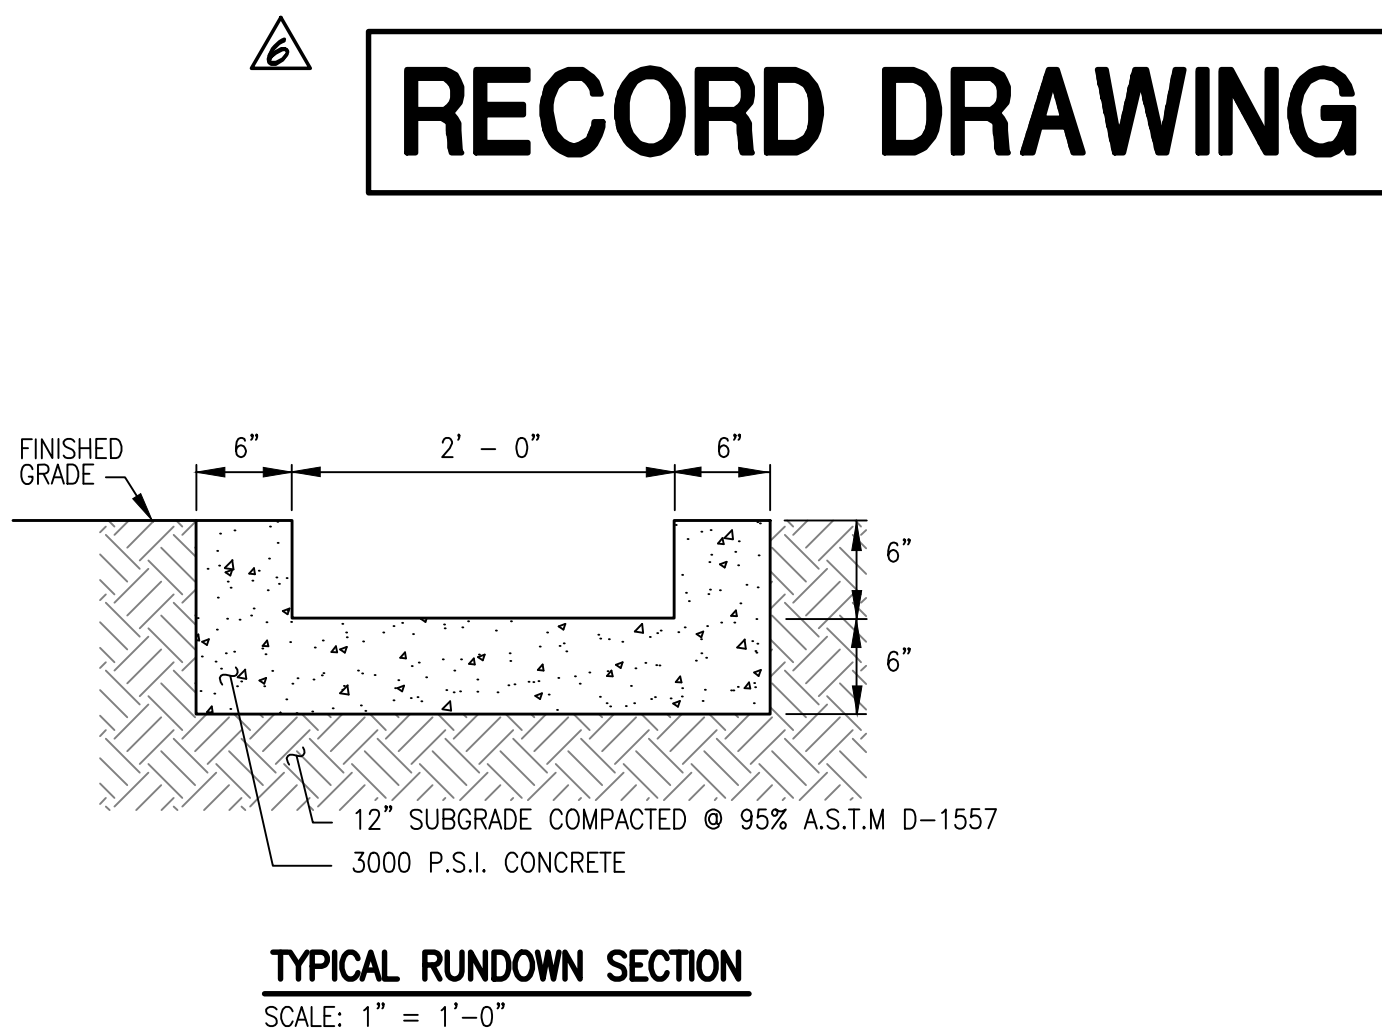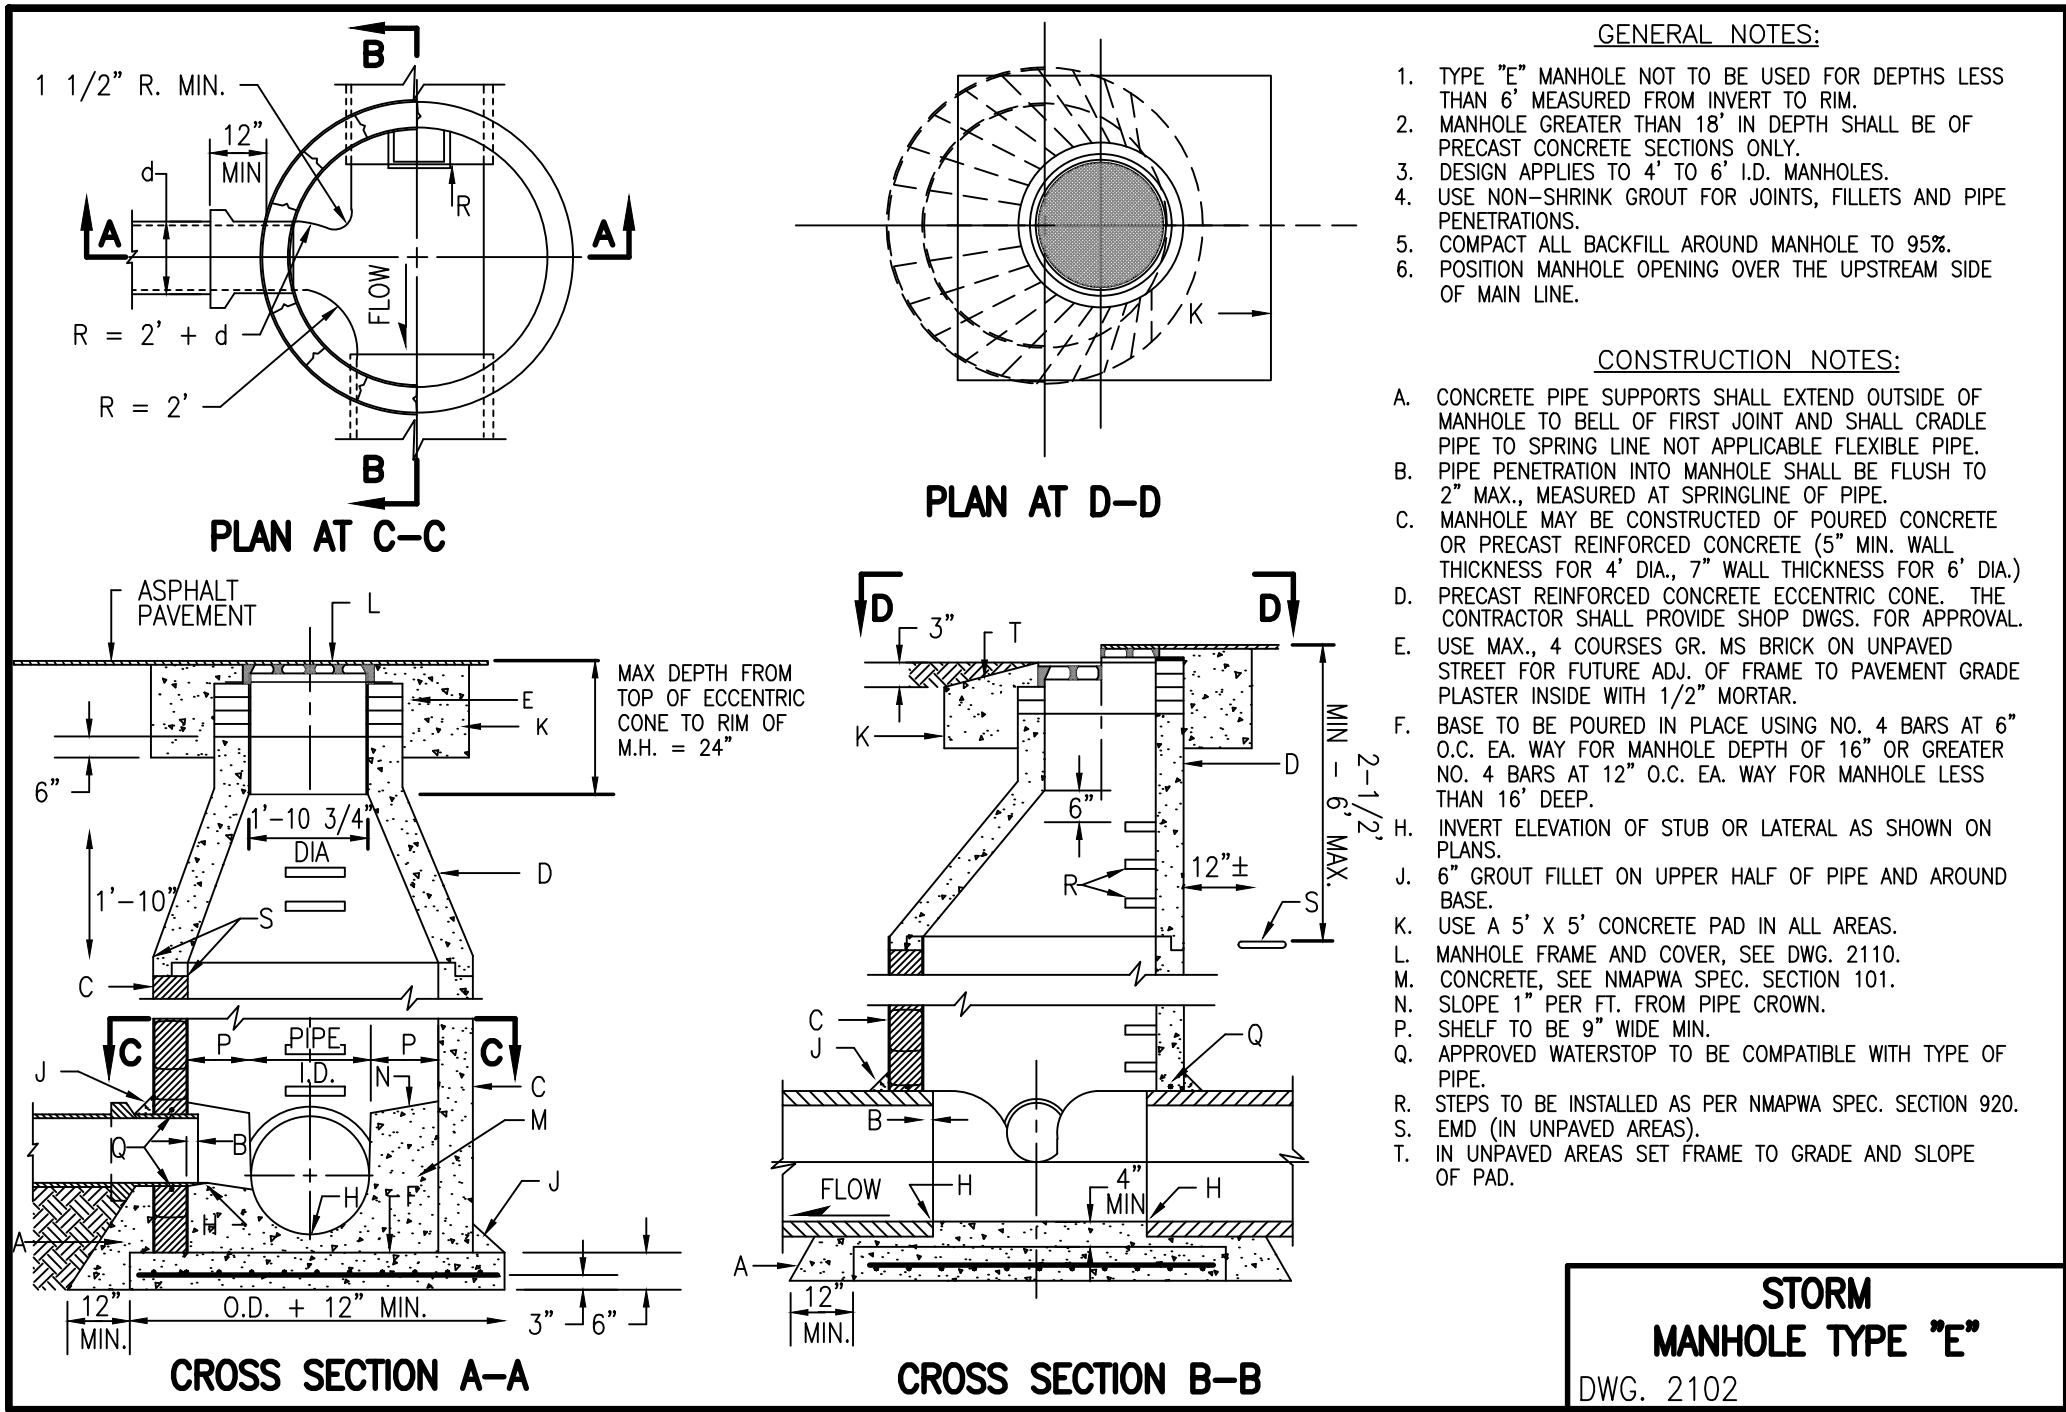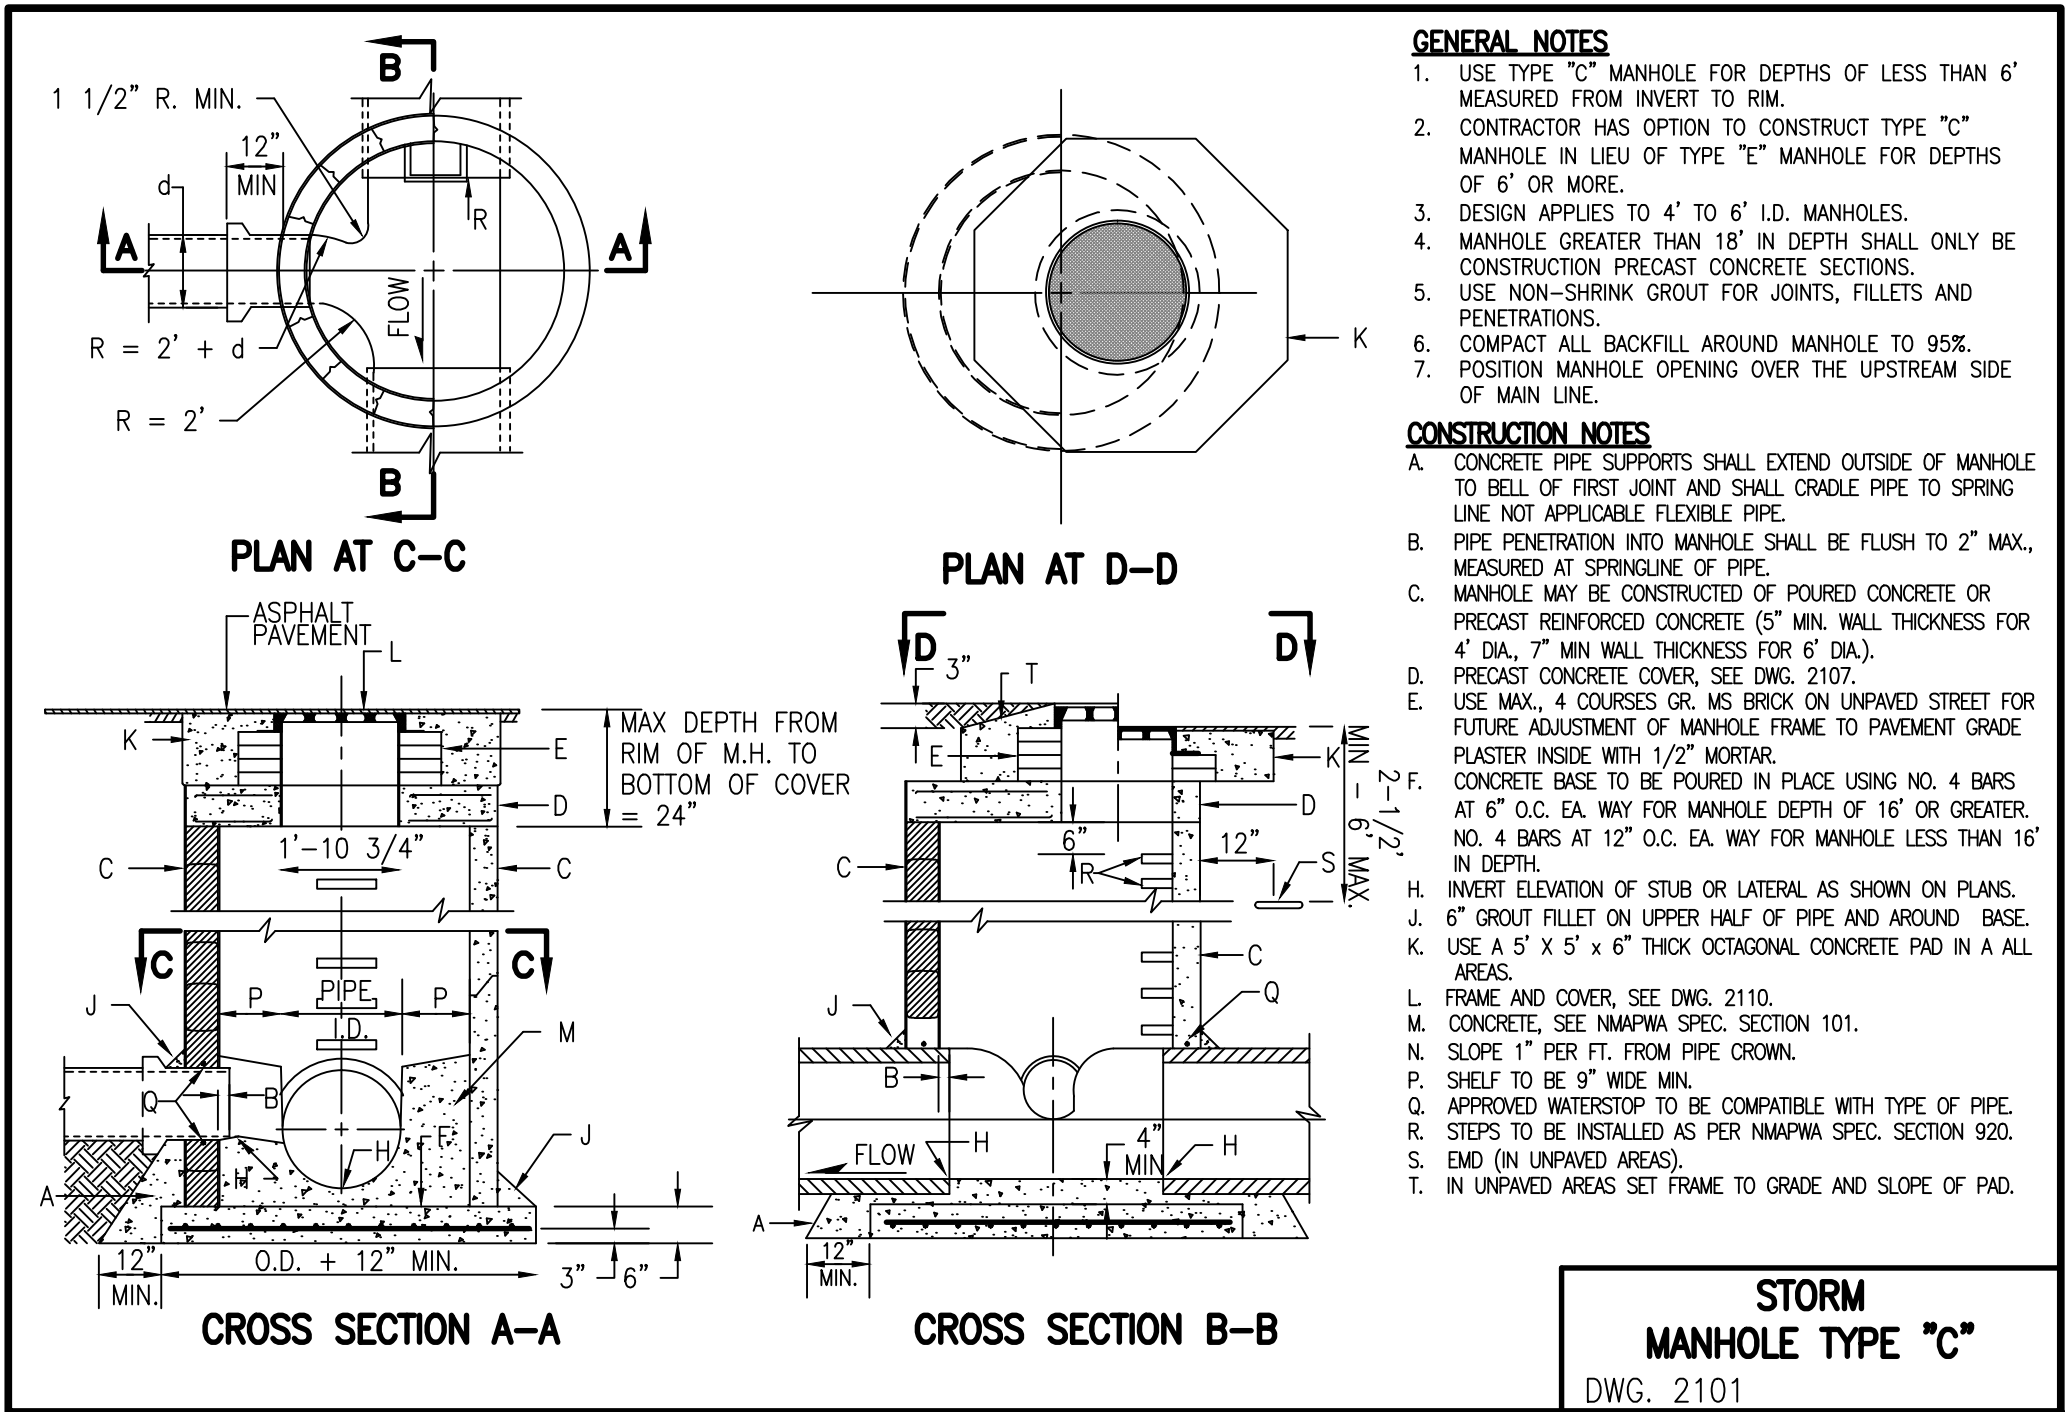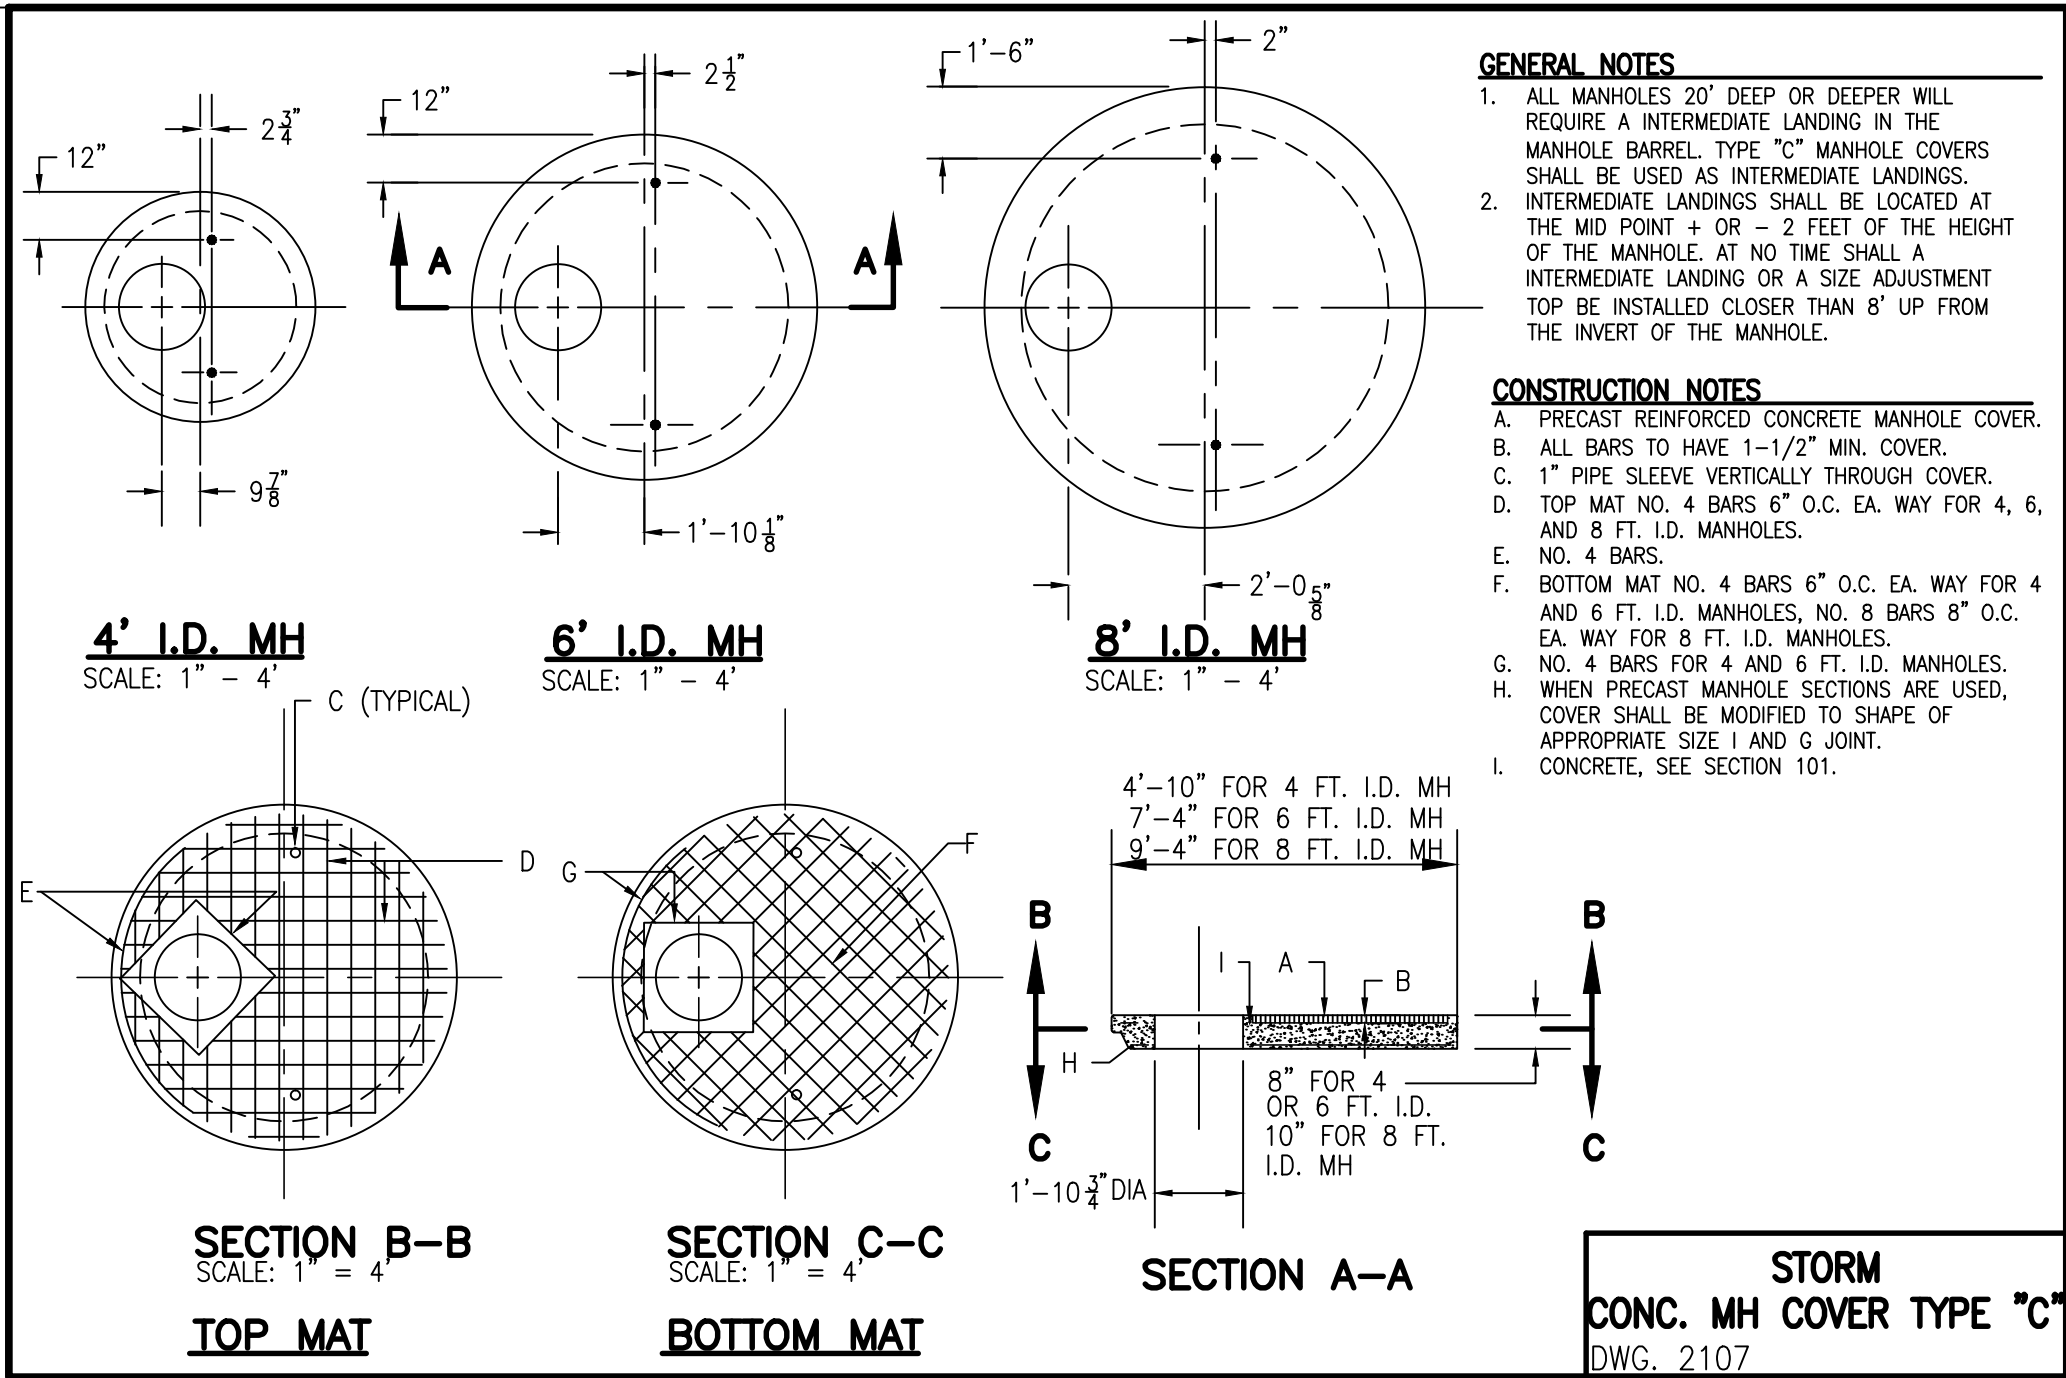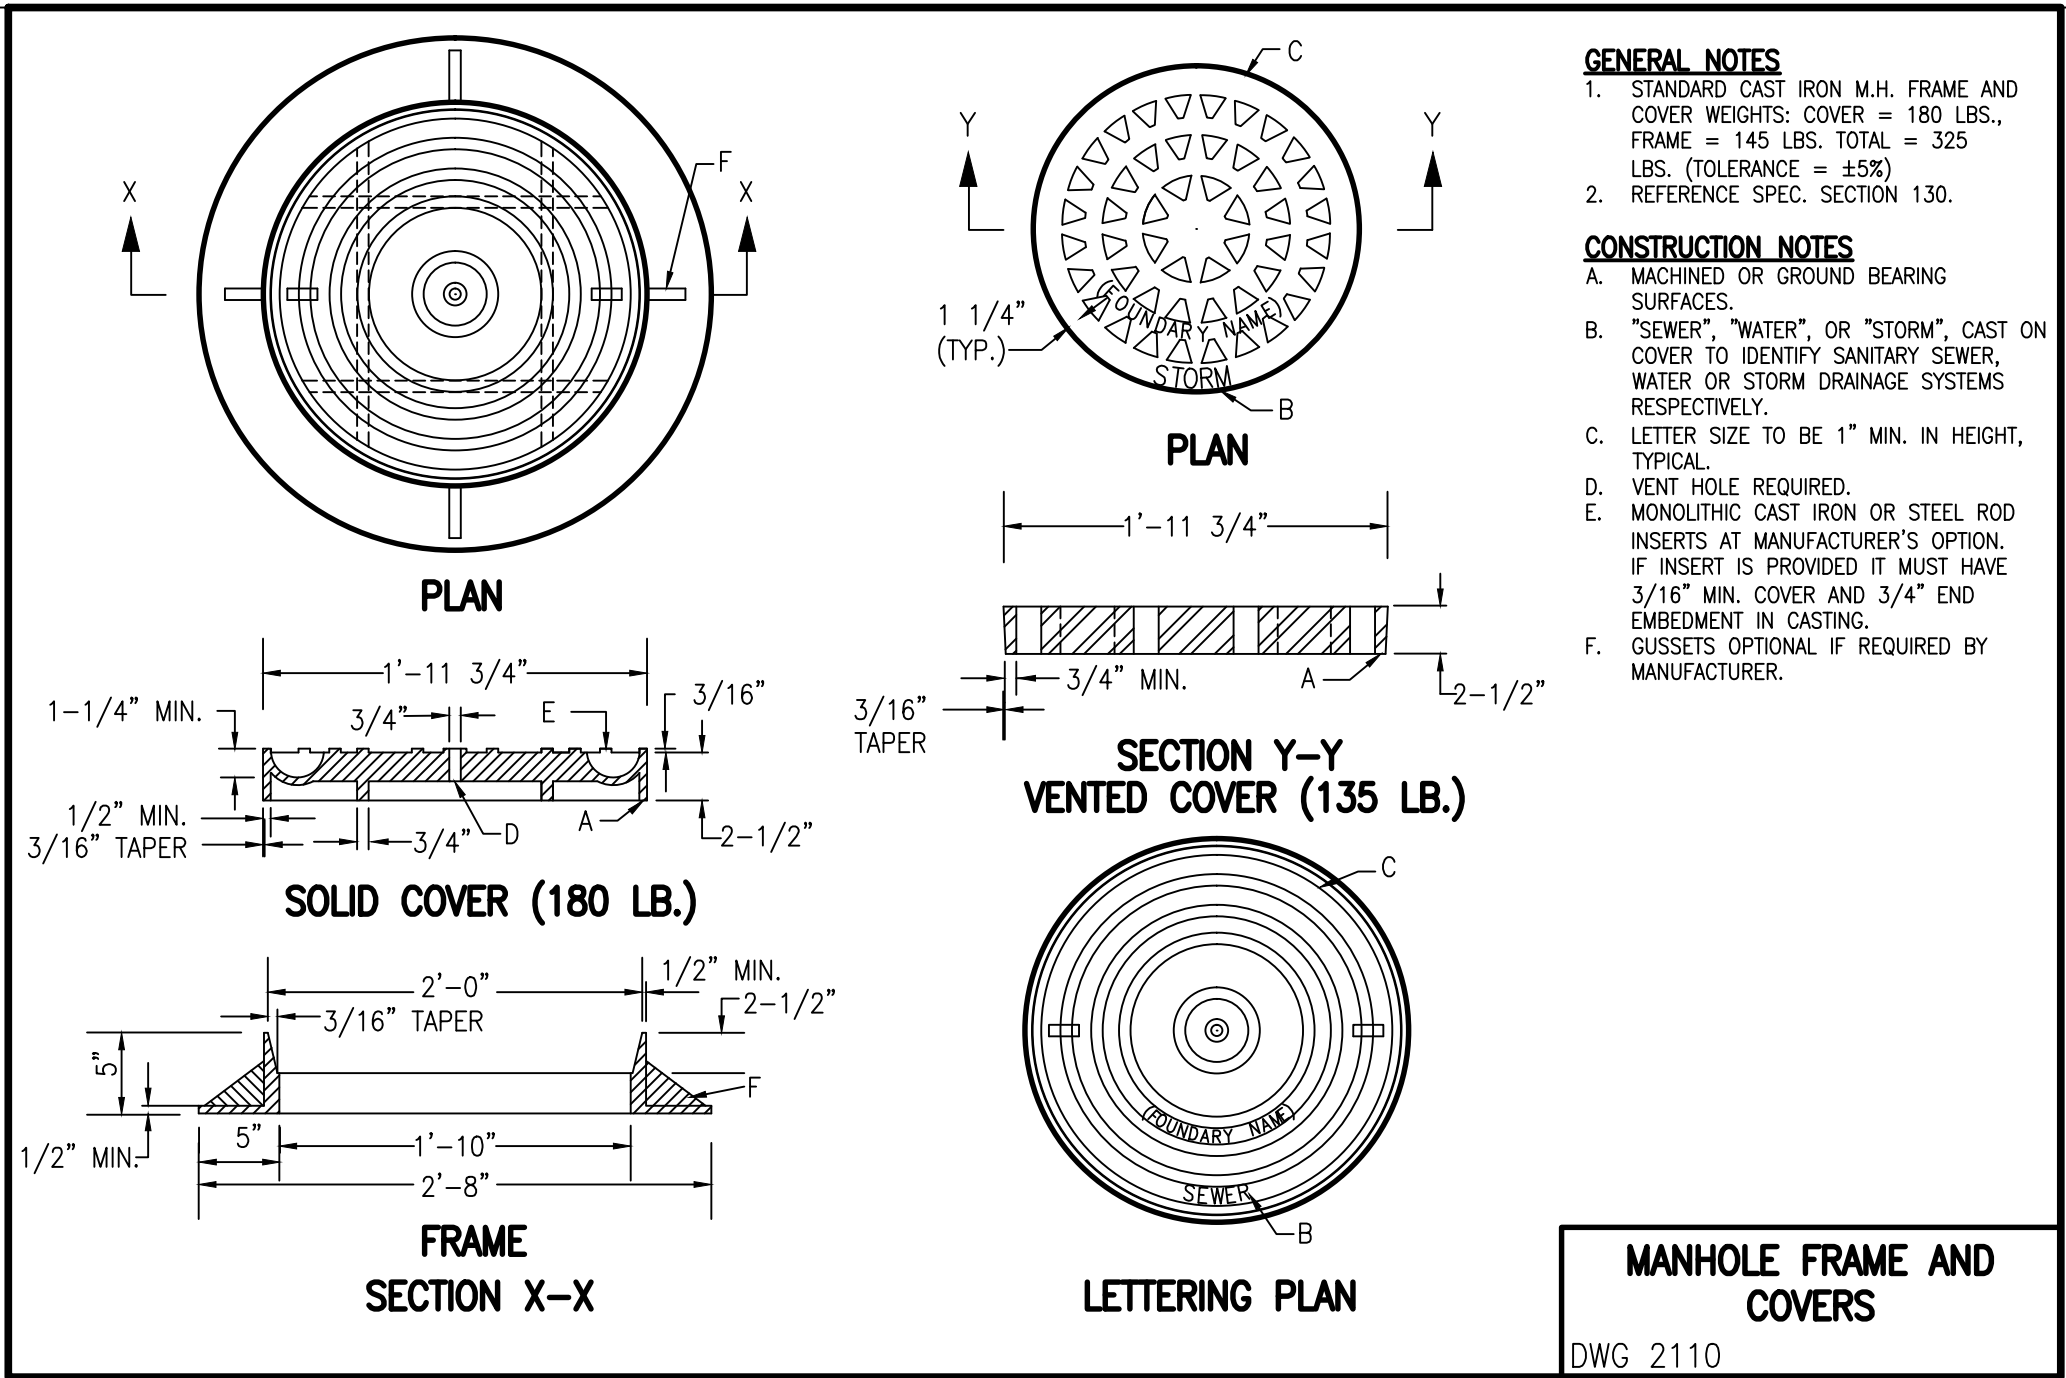

MAHMAN ARCHITECTURE

206 BROADWAY BLVD. SE
ALBUQUERQUE, NM 87102
505.243.0101 fax 505.243.1354
WWW.MAHMANSTUDIO.COM

PROFESSIONAL
REGISTERED
13676
NEW MEXICO
ENGINEER
MAHMAN ARCHITECTURE

04-13-2015
07-21-2016

CONSULTANT:
HIGH MESA
Consulting Group

6010 S. MIDWAY PARK BLVD. NE
ALBUQUERQUE, NM 87113
PHONE: 505.345.6250 FAX: 505.345.6254
www.hghmesagroup.com

WEST MESA HIGH SCHOOL
NEW CLASSROOM
BUILDING

6701 FORTUNA RD. NW
ALBUQUERQUE, NM 87121

ALBUQUERQUE PUBLIC SCHOOLS

07/16
MM/DD/YY

RECORD DRAWING-PHASE I


MARK
DESCRIPTION

PROJECT NO: WMHS
FILE NAME:
DRAWN BY: J.Y.R./S.C.C.
CHECKED BY: G.M.
COPYRIGHT:
DATE: 03-2015


SHEET TITLE:

GRADING
DRAINAGE
SECTIONS &
DETAILS


CG-501

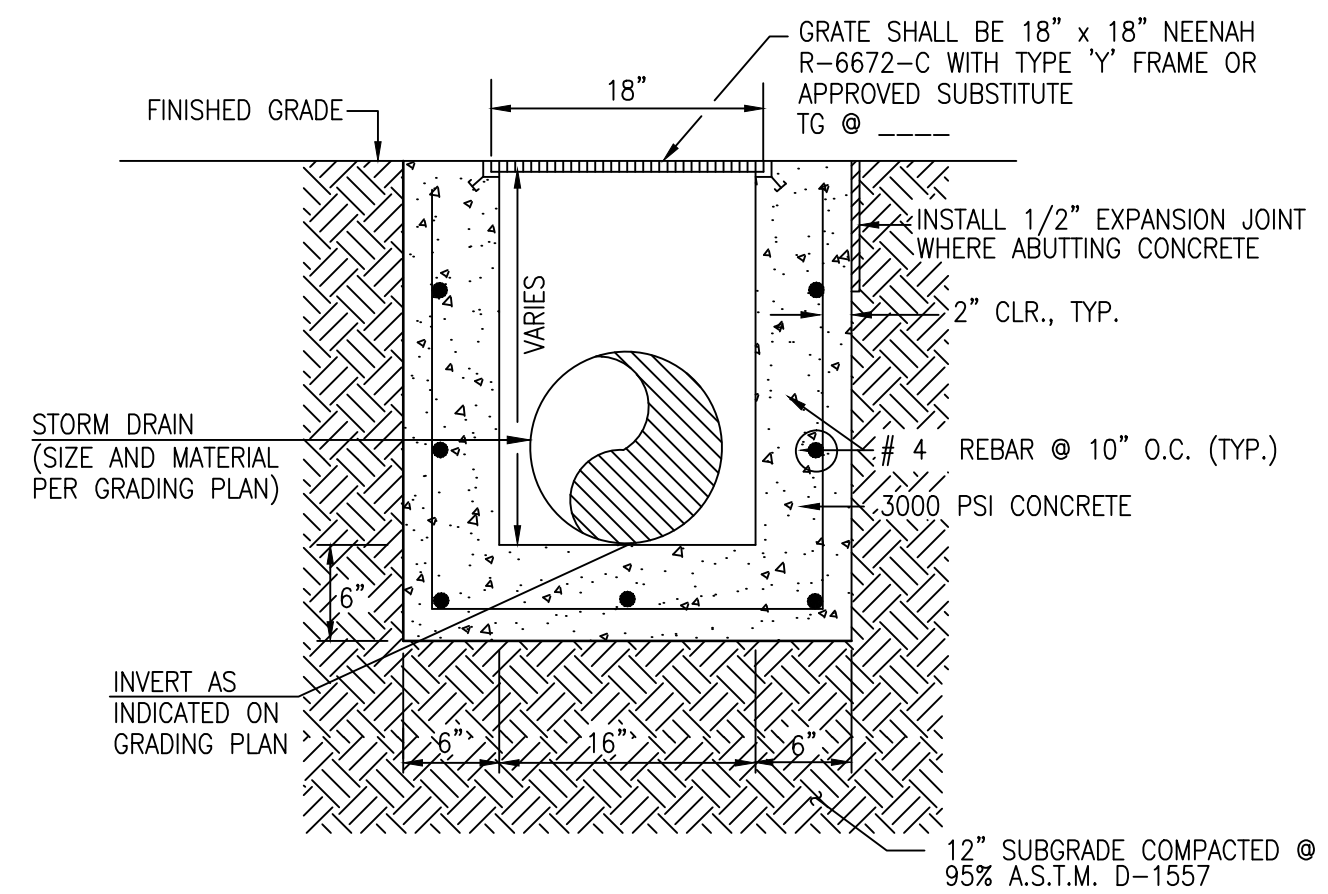


A1 TYPICAL 18"X18" STORM INLET SECTION
SCALE: 1" = 1' - 0"

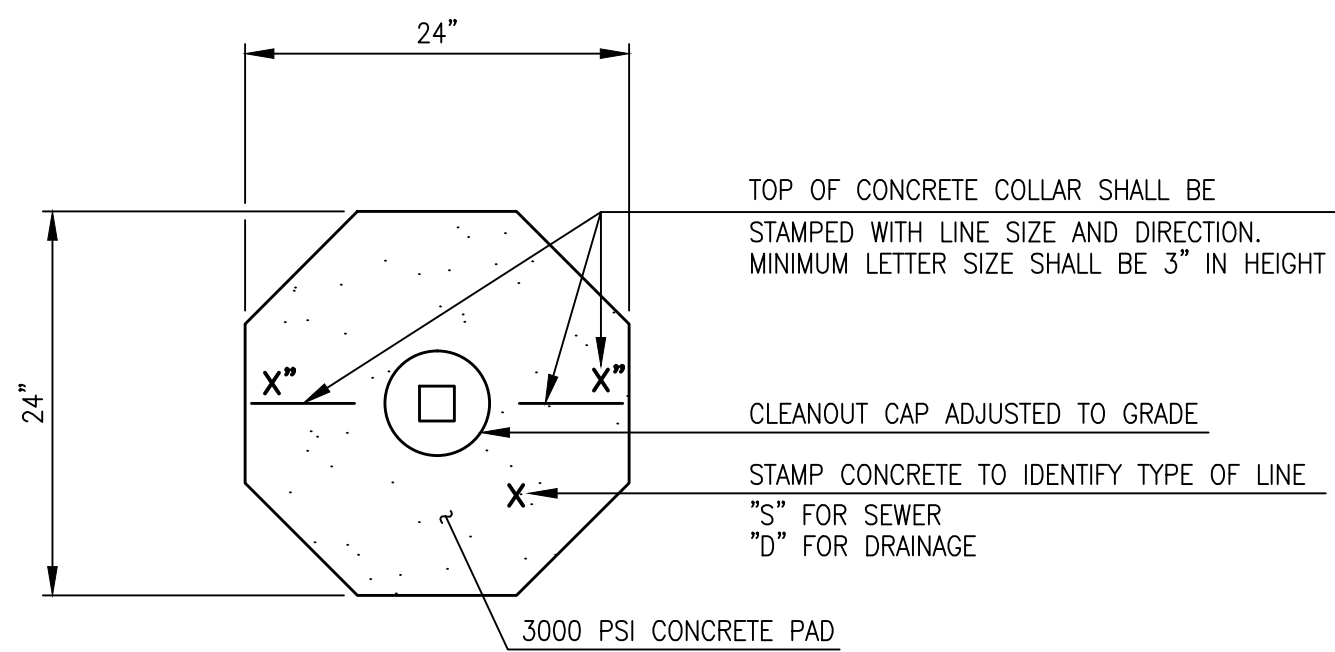


C3 TYPICAL CLEANOUT COLLAR DETAIL
SCALE: 1" = 1'-0"

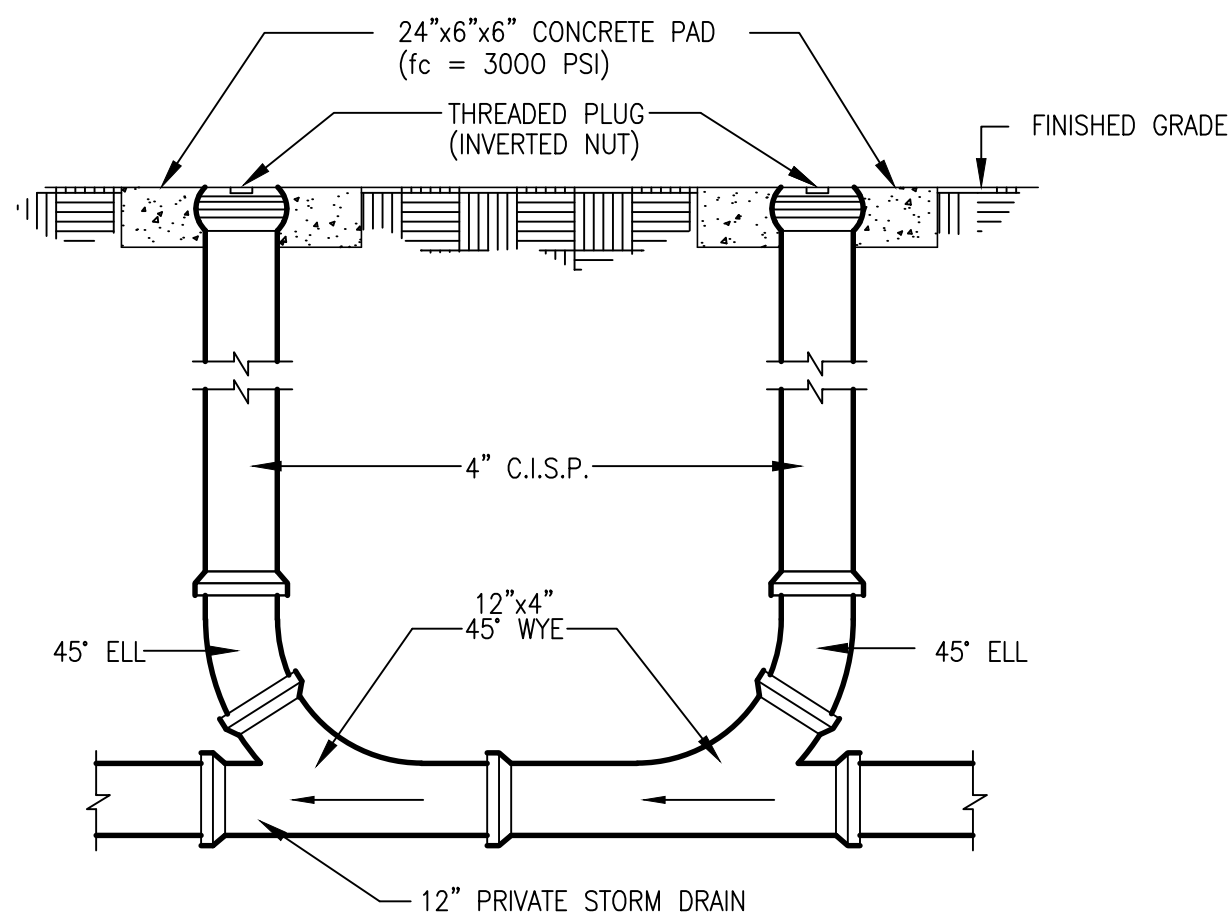



A3 TYPICAL DOUBLE CLEANOUT SECTION
NOT TO SCALE

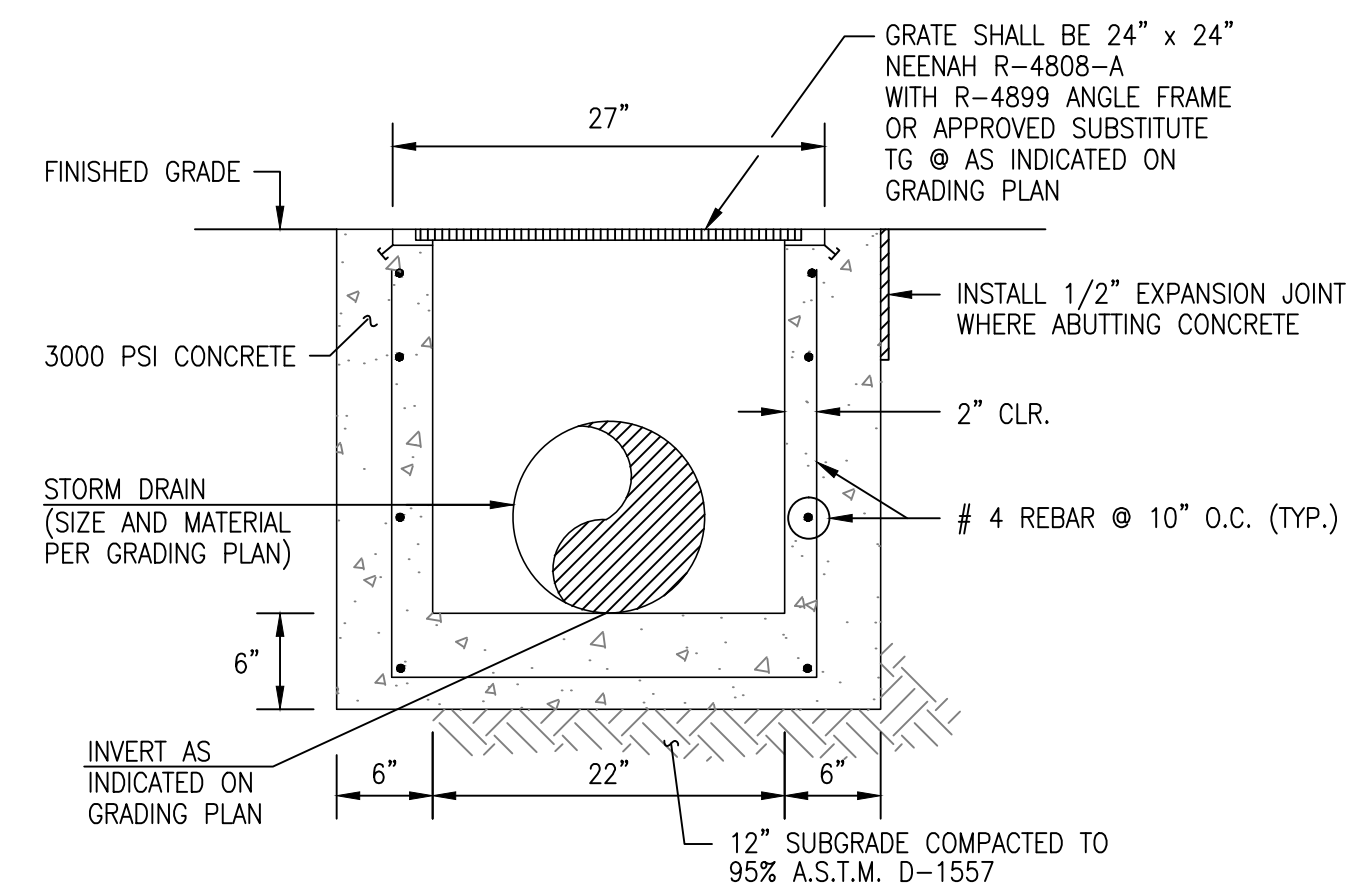

(D5) TYPICAL 24"X24" STORM INLET SECTION
SCALE: 1" = 1' - 0"

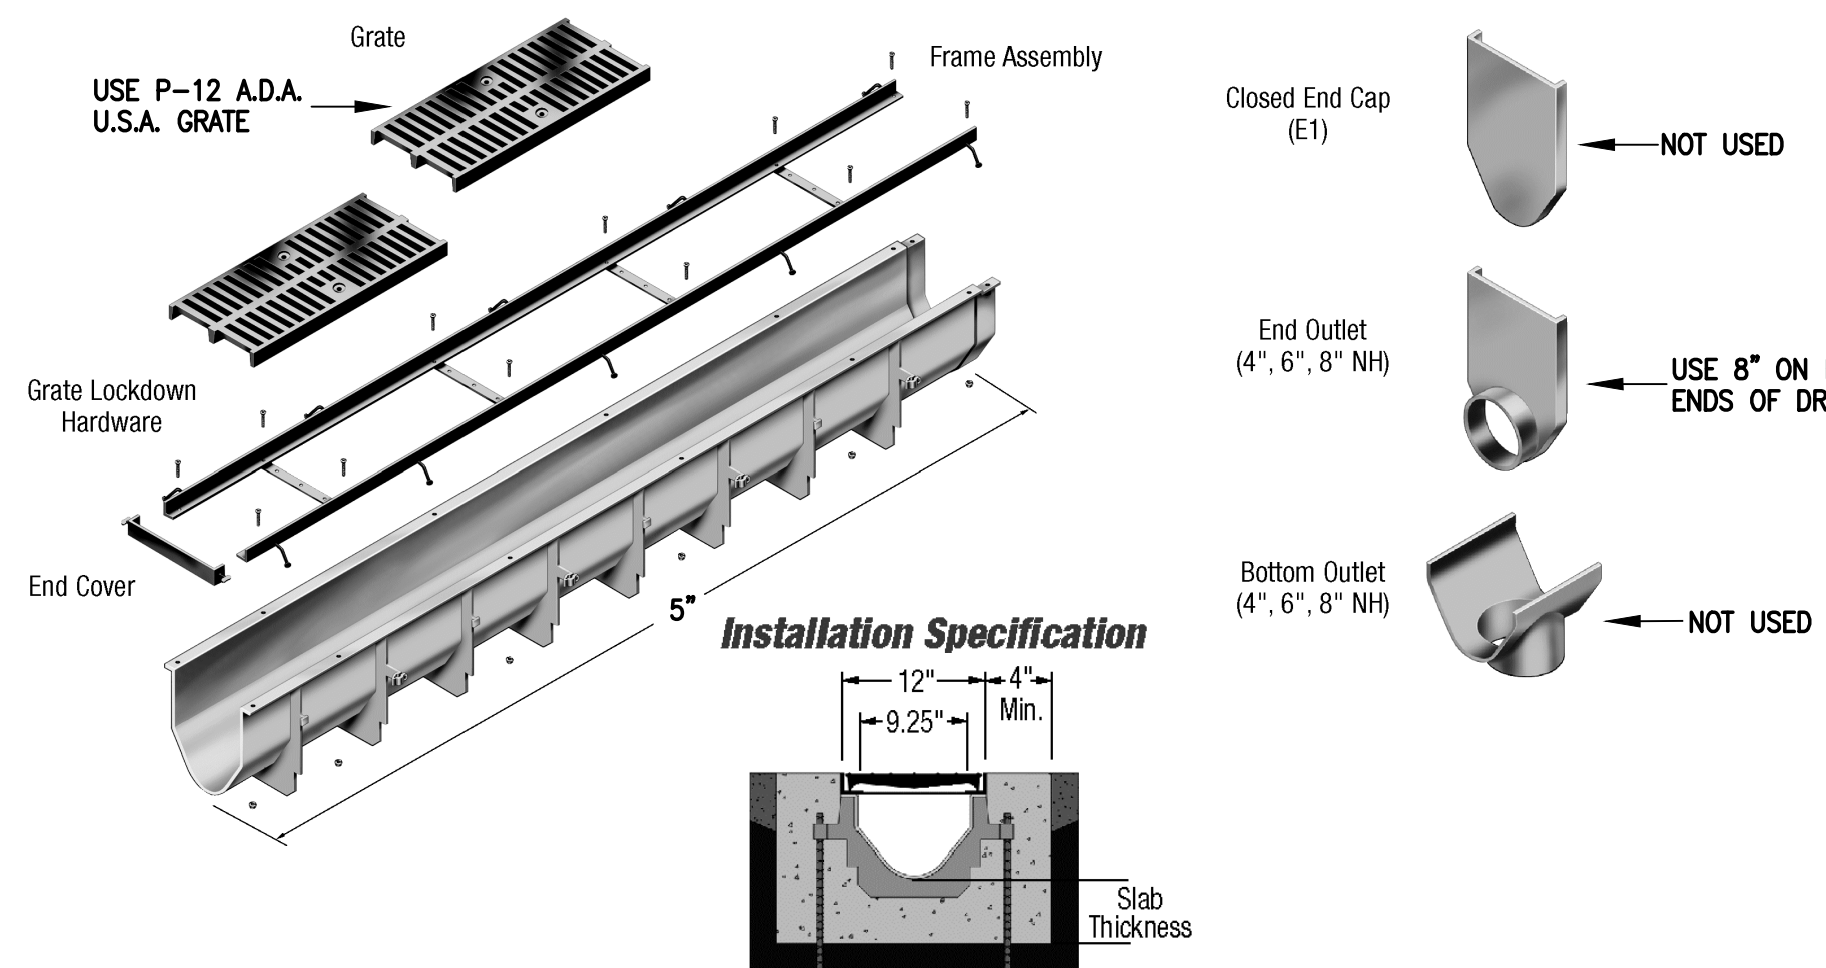

(A5) TRENCH DRAIN SECTIONS AND DETAILS (ZURN Z-882)
SCALE: 1" = 2'-0"

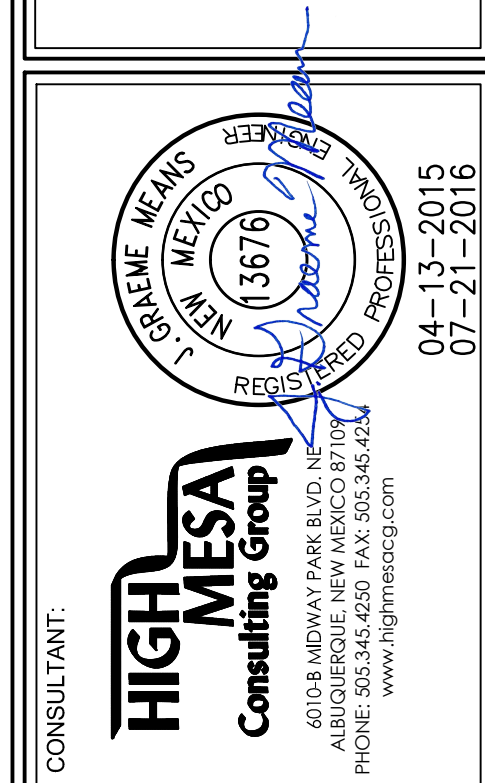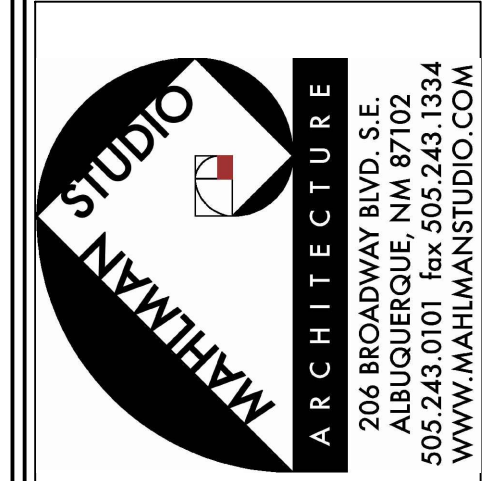

**WEST MESA HIGH SCHOOL
NEW CLASSROOM
BUILDING**

6701 FORTUNA RD. NW
ALBUQUERQUE, NM 87121

[illegible]

PROJECT NO: WMHS
FILE NAME:
DRAWN BY: J.Y.R./S.C.C.
CHECKED BY: G.M.
COPYRIGHT:
DATE: 03-2015

SHEET TITLE:

GRADING DRAINAGE SECTIONS & DETAILS

CG-502

Development & Building Services Division

COA STAFF: ELECTRONIC SUBMITTAL RECEIVED: