


ADDRESS:  
7500 LOS VOLCANES ROAD NW  
LEGAL DESCRIPTION:  
LOT 2, MERIDIAN BUSINESS PARK  
BENCH MARK:  
ACS MONUMENT 10-K10 LOCATED AT THE SOUTHEAST CORNER  
OF UNSER BLDV. AND LOS VOLCANES ROAD  
ELEVATION = 5142.79 FT (SLD 1929)

**LEGEND:**

- EXISTING SPOT ELEVATION
- NEW SPOT ELEVATION
- EXISTING CONTOUR
- NEW CONTOUR
- SWALE
- VERIFIED ELEVATION
- AS BUILT ELEVATION
- BASIN BOUNDARY
- PROPERTY LINE
- FLOW LINE
- GROUND
- INVERT
- TOP OF ASPHALT
- TOP OF CURB
- TOP OF GRATE
- TOP OF CONCRETE SLAB
- TOP OF WALL
- TEMPORARY BENCH MARK

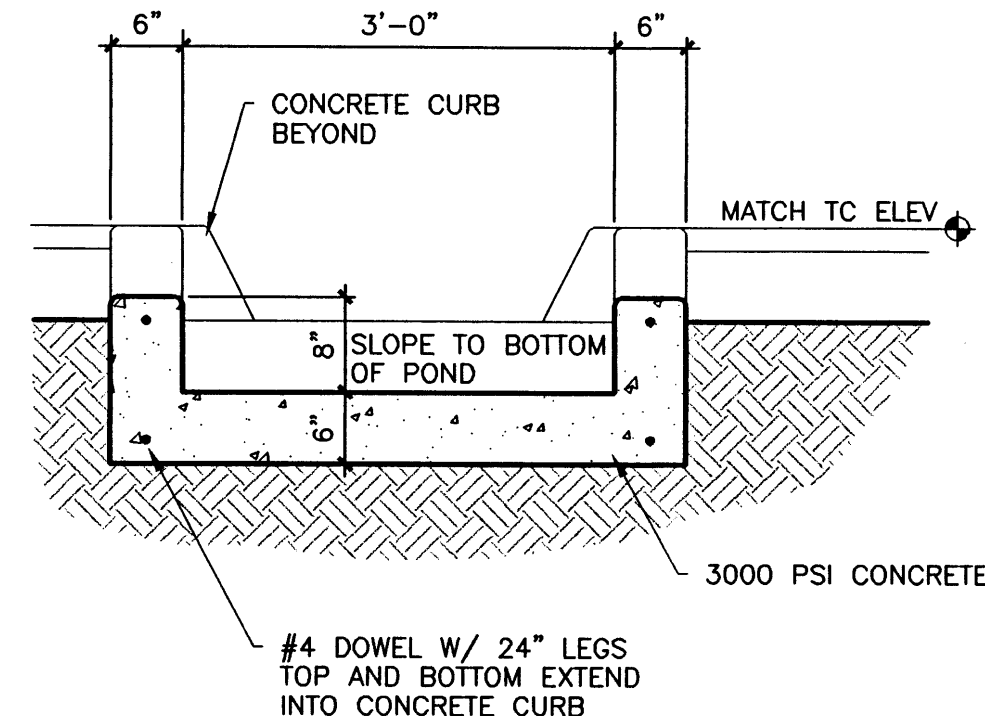

Engineer's Certification for  
Permanent Certificate of Occupancy  
Iron Mountain New Storage Facility - Lot 2



I hereby certify that I have inspected the site grading and drainage improvements and that they have been constructed and are expected to function in accordance with the intent of the approved Grading and Drainage Plan. Proposed contours have not been revised to reflect the as-constructed information and should be considered approximate. Spot elevations which have not been revised should be considered approximate.



J Arthur Blessen, PE  
NM PE# 13481  
9/14/00  
date

## 1 CONCRETE RUNDOWN

SCALE: 3/4" = 1'-0"

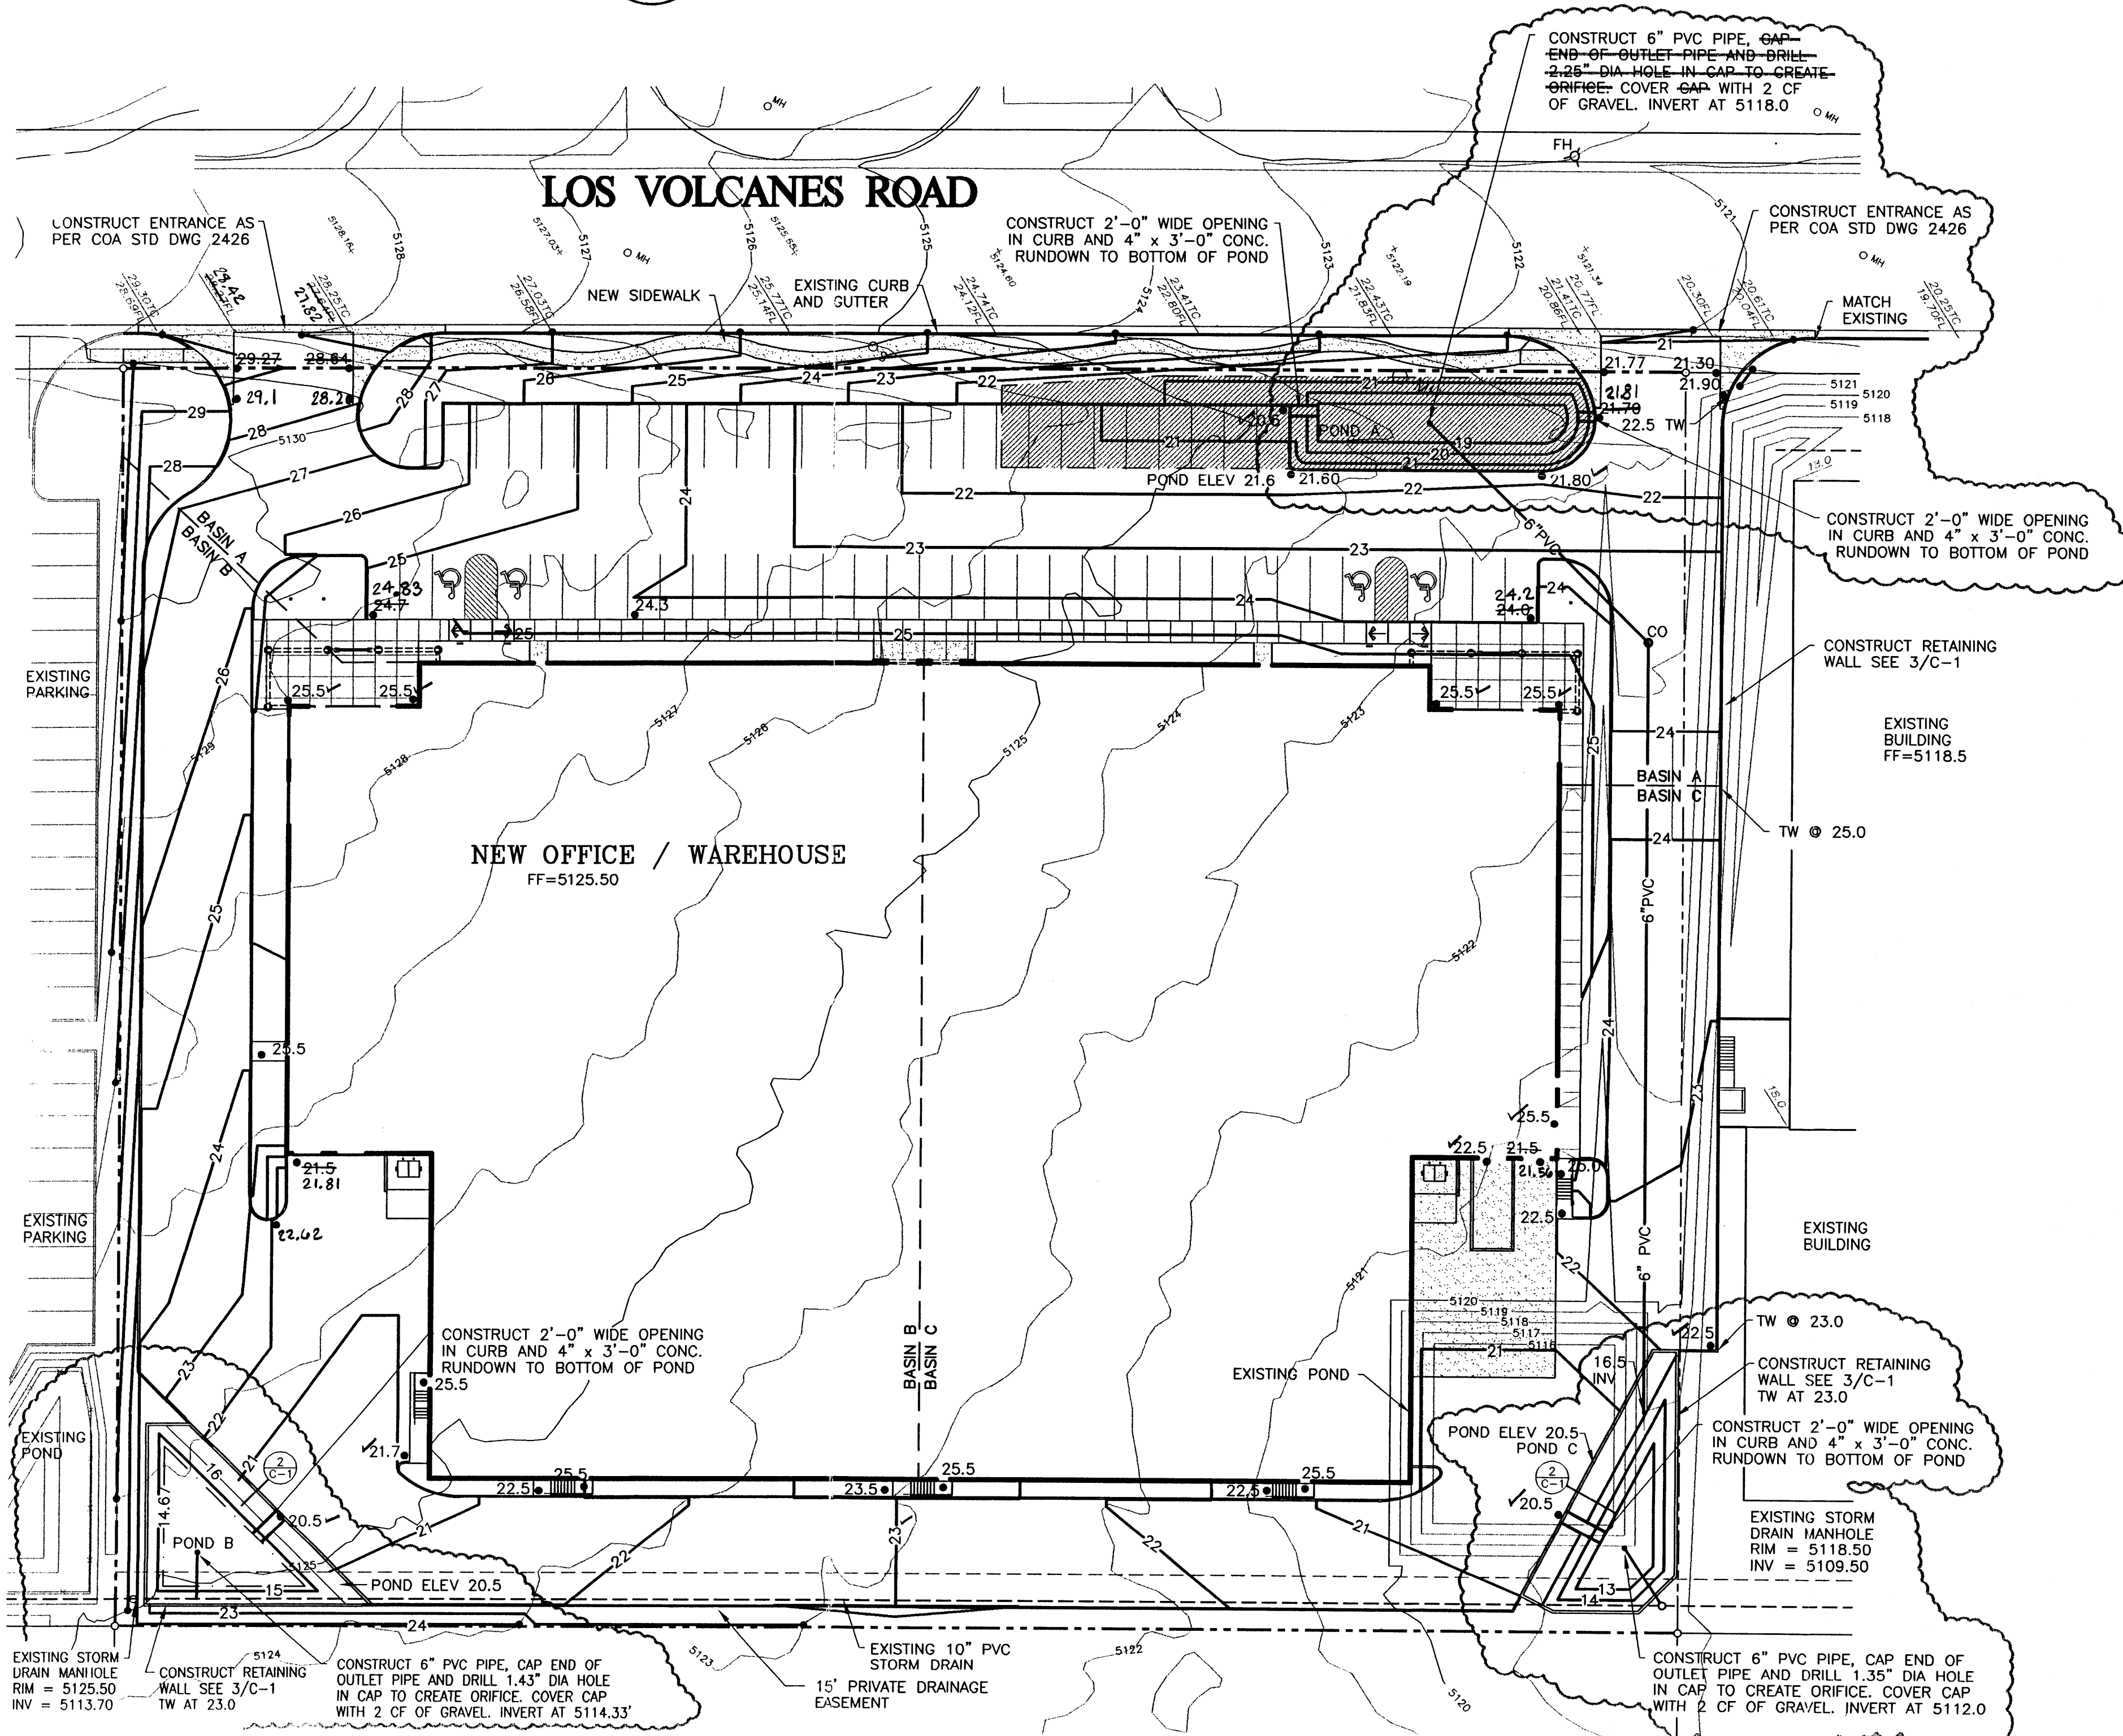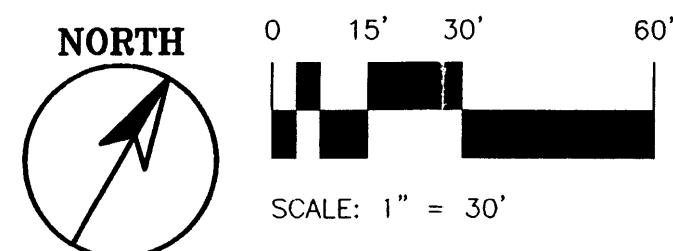

## GRADING AND DRAINAGE PLAN - LOT 2

### DRAINAGE PLAN

THE FOLLOWING ITEMS CONCERNING THE LOT-2, MERIDIAN BUSINESS PARK GRADING AND DRAINAGE PLAN ARE CONTAINED HEREON:

1. VICINITY MAP
2. GRADING PLAN
3. CALCULATIONS

THE PROPOSED IMPROVEMENTS, AS SHOWN BY THE VICINITY MAP, ARE LOCATED ON THE SOUTH SIDE OF MERIDIAN PLACE N.W. THE SITE IS UNDEVELOPED. THE LAND SLOPES FROM NORTHWEST TO SOUTHEAST AT A APPROXIMATE SLOPE OF 2.2%. THE SITE WAS IN A FLOOD HAZARD ZONE, BUT THE CONSTRUCTION OF THE UNSER DIVERSON CHANNEL REMOVED THE SITE FROM THE FLOOD HAZARD ZONE.

THE MASTER DRAINAGE PLAN FOR THIS SUBDIVISION WAS PREPARED BY EASTERLING AND ASSOCIATES. THE MASTER PLAN ESTABLISHED A DISCHARGE RATE OF 0.10 CFS/ACRE AND REQUIRES TEMPORARY DIVERSON DITCHES AND PONDS TO CONTROL THE RUNOFF BE CONSTRUCTED ON EACH LOT.

THIS SITE IS HIGHER THAN THE LAND TO THE SOUTH AND EAST, AND THE STREET TO THE NORTH PREVENTS OFF SITE FLOWS FROM THAT DIRECTION. THE SITE TO THE WEST HAS BEEN DEVELOPED. THEREFORE THE OFF SITE FLOWS ARE NOT CONSIDERED SIGNIFICANT.


THE GRADING PLAN SHOWS:

1. THE EXISTING AND PROPOSED GRADES, INDICATED BY SPOT ELEVATIONS AND CONTOURS AT 1'-0" INTERVALS.
2. CONTINUITY BETWEEN EXISTING AND PROPOSED ELEVATIONS.
3. THE LIMIT AND CHARACTER OF EXISTING IMPROVEMENTS, AND
4. THE LIMIT AND CHARACTER OF THE PROPOSED IMPROVEMENTS.

THE PROPOSED IMPROVEMENTS CONSIST OF A WAREHOUSE / OFFICE WITH ASSOCIATED ASSOCIATED PARKING AND LANDSCAPING. THE SITE IS DIVIDED INTO THREE DRAINAGE BASINS. BASIN A TO THE NORTH, 24% OF THE SITE, BASIN B TO THE SOUTHWEST, 39% OF THE SITE, AND BASIN C TO THE SOUTHEAST, 37% OF THE SITE. BASIN A FLOWS TO A POND ALONG THE NORTH PROPERTY LINE. BASIN B FLOWS TO A POND AT THE SOUTHWEST CORNER, AND BASIN C FLOWS TO A POND AT THE SOUTHEAST CORNER. EACH POND HAS A CONTROLLED DISCHARGE TO THE PRIVATE STORM DRAIN SYSTEM. THE DISCHARGE IS CONTROLLED BY ORIFICES TO CONFORM TO THE DISCHARGE LIMIT OF 0.10 CFS/ACRE.


THE CALCULATIONS BELOW ANALYZE THE EXISTING AND PROPOSED CONDITIONS FOR THE 6-HOUR, 100 YEAR RAINFALL EVENT. THE ANALYSIS IS IN ACCORDANCE WITH THE CITY OF ALBUQUERQUE DEVELOPMENT PROCESS MANUAL VOLUME II. AS SHOWN BY THESE CALCULATIONS, THE RATE AND VOLUME OF RUNOFF WILL INCREASE, BUT THE POND(S) WITH CONTROLLED OUTLETS WILL MITIGATE THE INCREASES. THIS PLAN IS IN CONFORMANCE WITH THE MASTER DRAINAGE PLAN.

**CALCULATIONS**  
PRECIPITATION ZONE = 1  
TOTAL SITE AREA = 3.4740 ACRES  
**BASIN A (NORTH)**  
AREA = 0.829 ACRES  
EXISTING CONDITIONS  
LAND TREATMENT A=100%  
E = 0.44(1.00) = 0.44 INCHES  
V = 0.44 (0.829) / 12 = 0.031 ACRE FEET  
Q = 1.29 (1.00) (0.829) = 1.07 CFS  
DEVELOPED CONDITIONS  
LAND TREATMENT B=24% D=76%  
E = 0.67 (0.24) + 1.97 (0.76) = 1.66 INCHES  
V = 1.66(0.829) / 12 = 0.115 ACRE FEET  
Q = [2.03 (0.24) + 4.37 (0.76)] (0.829) = 3.16 CFS  
INCREASE IN VOLUME OF RUNOFF = 0.115 - 0.031 = 0.084 ACRE FT  
INCREASE IN RATE OF RUNOFF = 3.16 - 1.07 = 2.09 CFS  
POND VOLUME REQUIRED V = (0.115) (43560) = 5,009 CF  
VOLUME @ ELEV 5121.5  
V = 0.5\*(4088+2574)\*0.6+0.5\*(2574+2\*1227+2\*727)=5,240 CF  
**ORIFICE SIZES**  
0.083 = 0.60 A  $\sqrt{2 (32.2) (3.6)}$  DIA = 1.29 INCHES  
**BASIN B (SOUTH WEST)**  
AREA = 1.363 ACRES  
EXISTING CONDITIONS  
LAND TREATMENT A=100%  
E = 0.44(1.00) = 0.44 INCHES  
V = 0.44 (1.363) / 12 = 0.050 ACRE FEET  
Q = 1.29 (1.00) (1.363) = 1.76 CFS  
DEVELOPED CONDITIONS  
LAND TREATMENT B=12% D=88%  
E = 0.67 (0.12) + 1.97 (0.88) = 1.82 INCHES  
V = 1.82 (1.363) / 12 = 0.207 ACRE FEET  
Q = [2.03 (0.12) + 4.37 (0.88)] (1.363) = 5.58 CFS  
INCREASE IN VOLUME OF RUNOFF = 0.207 - 0.050 = 0.157 ACRE FT  
INCREASE IN RATE OF RUNOFF = 5.58 - 1.76 = 3.83 CFS  
POND VOLUME REQUIRED V = (0.207) (43560) = 8,993 CF  
VOLUME @ ELEV 5120.5  
V = 0.5\*(1653+1547)\*0.5+0.5\*(1547+2\*(1477+1407+1336+1266+1196+861)+488)=8,960 CF  
**ORIFICE SIZES**  
0.1363 = 0.60 A  $\sqrt{2 (32.2) (6.17)}$  DIA = 1.43 INCHES  
**BASIN C (SOUTH EAST)**  
AREA = 1.282 ACRES  
EXISTING CONDITIONS  
LAND TREATMENT A=100%  
E = 0.44(1.00) = 0.44 INCHES  
V = 0.44 (1.282) / 12 = 0.047 ACRE FEET  
Q = 1.29 (1.00) (1.282) = 1.65 CFS  
DEVELOPED CONDITIONS  
LAND TREATMENT B=9% D=91%  
E = 0.67 (0.09) + 1.97 (0.91) = 1.85 INCHES  
V = 1.85 (1.282) / 12 = 0.198 ACRE FEET  
Q = [2.03 (0.09) + 4.37 (0.91)] (1.282) = 5.33 CFS  
INCREASE IN VOLUME OF RUNOFF = 0.198 - 0.047 = 0.151 ACRE FT  
INCREASE IN RATE OF RUNOFF = 5.33 - 1.65 = 3.68 CFS  
POND VOLUME REQUIRED V = (0.198) (43560) = 8,626 CF  
VOLUME @ ELEV 5120.5  
V = 0.5\*(1795+1718)\*0.5+0.5\*(1718+2\*(1641+1563+1484+1405+1326+822)+436)=8,604 CF  
**ORIFICE SIZES**  
0.1282 = 0.60 A  $\sqrt{2 (32.2) (8.5)}$  DIA = 1.35 INCHES

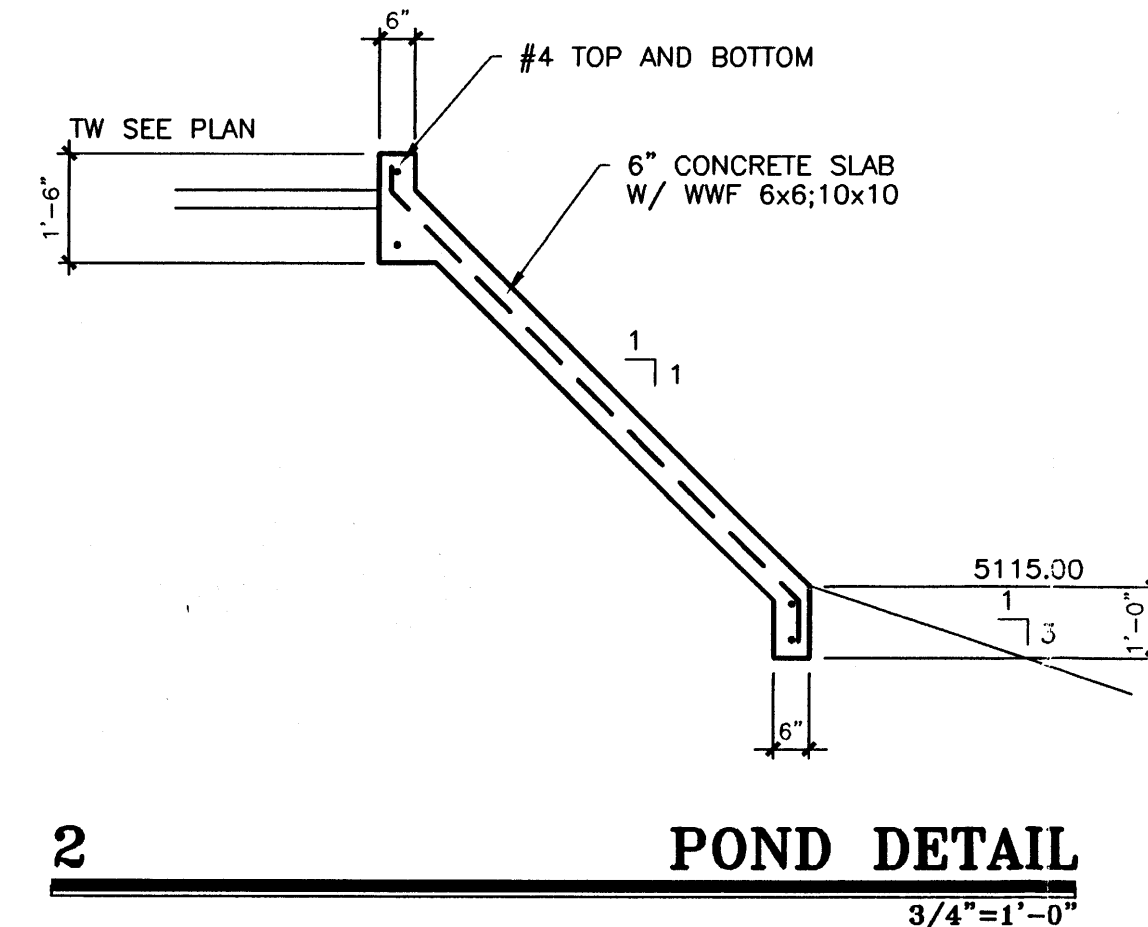

## 2 POND DETAIL

3/4"=1'-0"

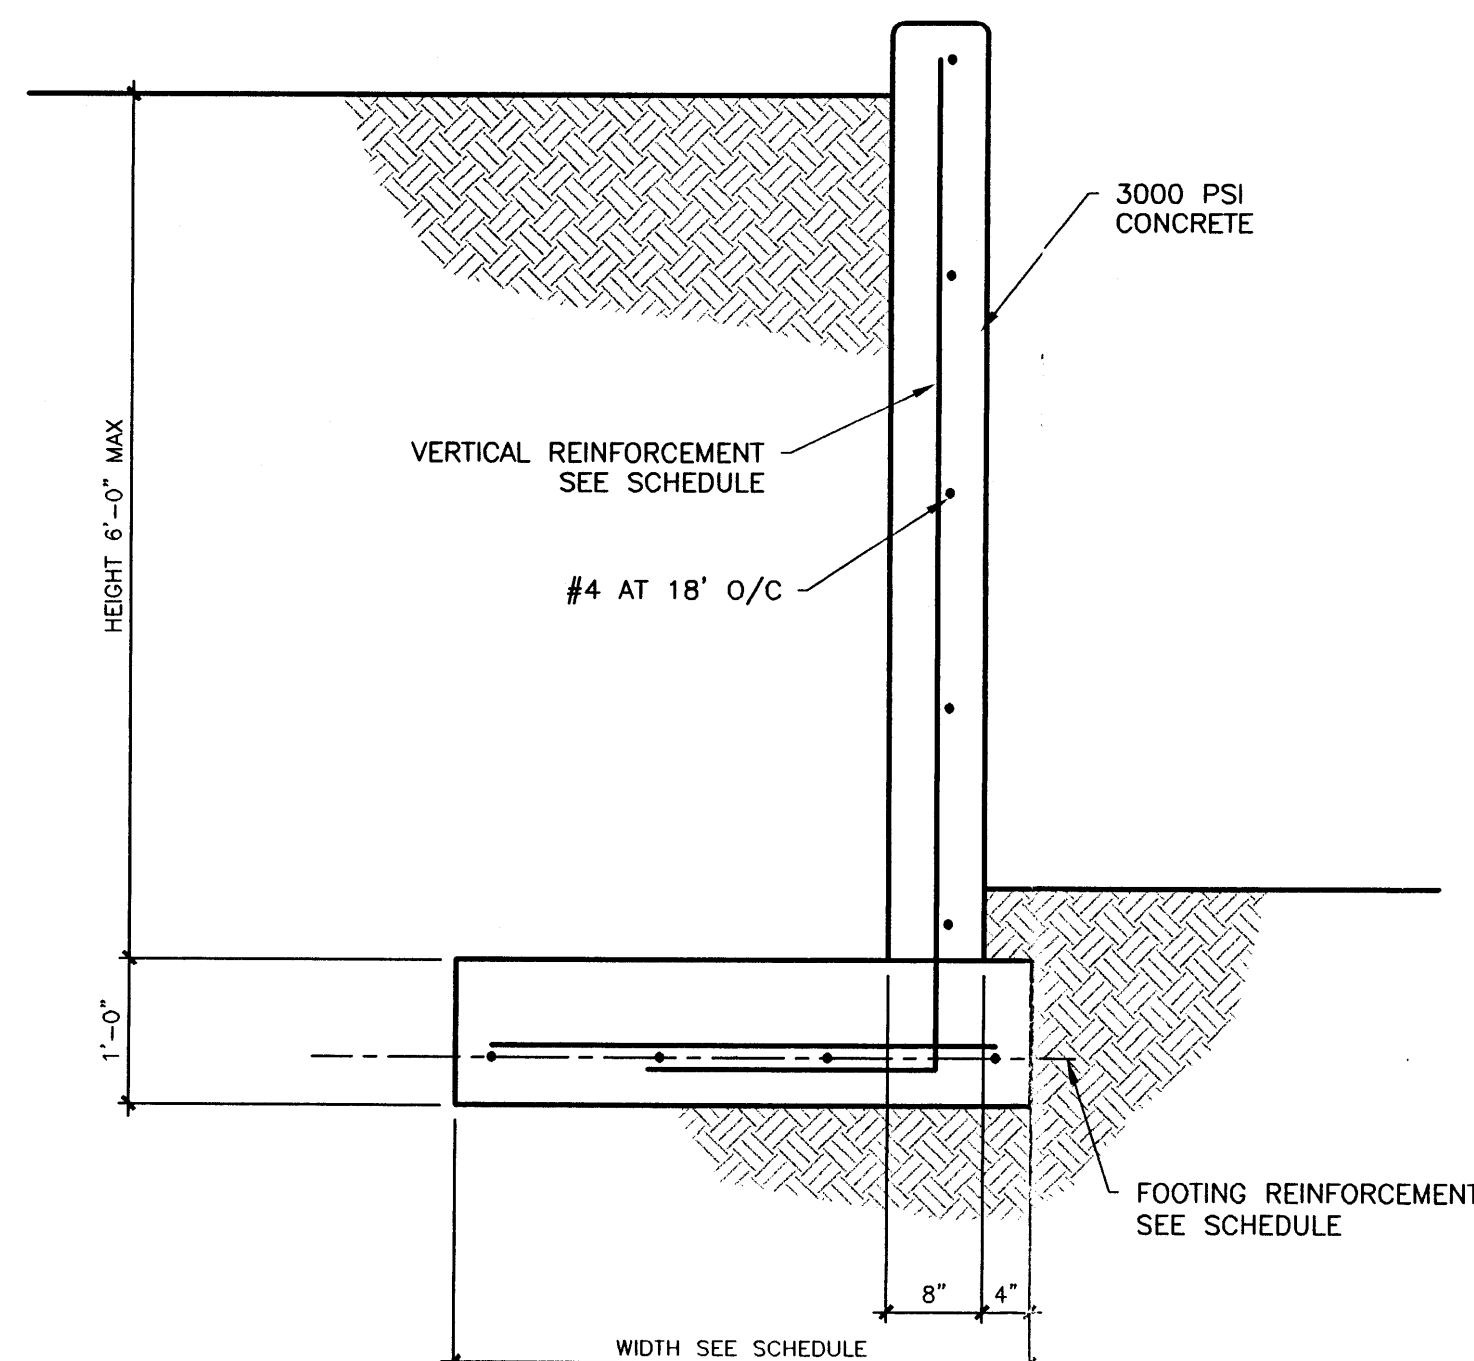

## TYPE A

## 3 RETAINING WALL DETAIL

3/4"=1'-0"

## RETAINING WALL SCHEDULE

TYPE	RETAINED HEIGHT "H"	FOOTING WIDTH "W"	FOOTING REINFORCEMENT LONGITUDINAL	FOOTING REINFORCEMENT TRANSVERSE	WALL REINFORCEMENT
A	6'-0" MAX	4'-0"	FOUR #5	#4 AT 16" O/C	#5 AT 12" O/C
A	5'-0" MAX	3'-0"	THREE #5	#4 AT 32" O/C	#5 AT 16" O/C
A	3'-0" MAX	2'-0"	THREE #5	#4 AT 48" O/C	#5 AT 16" O/C




NOVEMBER 30, 1999

## GRADING & DRAINAGE PLAN

1"=30'-0"

**CLAUDIO VIGIL ARCHITECTS**

**IRON MOUNTAIN  
NEW STORAGE FACILITY**  
7500 LOS VOLCANES  
ALBUQUERQUE, NEW MEXICO

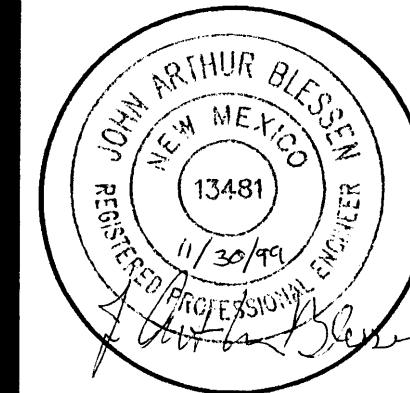

SHEET  
C-1

1305 Tijeras NW Albuquerque, NM 87102-2882  
Phone: 505/842-1113 Fax: 505/842-1330



