CITY OF ALBUQUERQUE



December 19, 2018

Simons Architecture Joseph f. Simons Jr. P.O. Box 67408 Albuquerque, NM **193**

Re: Car wash Vacuum 500 Coors Blvd. NW

Traffic Circulation Layout

Engineer's/Architect's Stamp 12-15-18 (J10D041)

Dear Mr. Simons,

Based upon the information provided in your submittal received 12-17-18, the above referenced plan cannot be approved for Building Permit until the following comments are addressed:

- The ADA accessible parking sign must have the required language per 66-7-352.4C NMSA 1978 "Violators Are Subject to a Fine and/or Towing." Please call out detail and location of HC signs.
- Note stating existing curb cut and note stating demo existing curb cut. Please clarify.
- 3. New curb cut not to exceed 30'. Extend landscaping west towards Coors Blvd.
- 4. Please specify the City Standard Drawing Number when applicable.
- 5. Indicate ramps and truncated domes on both access entrances and exits.
- List radii for all curves shown; for passenger vehicles, the minimum end island radius for passenger vehicles is 15 ft. Radius for delivery trucks, fire trucks, etc. is 25 ft. or larger.
- Where replacing existing vacuum stations fronting Coors. Google image shows 8 vacuum stations. TCL plan indicates 10 vacuum stations, please clarify.

Resubmit a revised plan along with fully completed Drainage Transportation Information Sheet to front counter personnel for log in and evaluation by Transportation. PDF copies of the plans and submittal package must be emailed to PLNDRS@cabq.gov at time of resubmittal. If you have any questions, please contact Ernie Gomez (505) 924-3981.

Sincerely,

Ernie Gomez

Plan Checker, Transportation & Hydrology

Development Review Services

EG via: email C: CO Clerk, File


Albuquerque - Making History 1706-2006


PO Box 1293

Albuquerque

NM 87103

www.cabq.gov

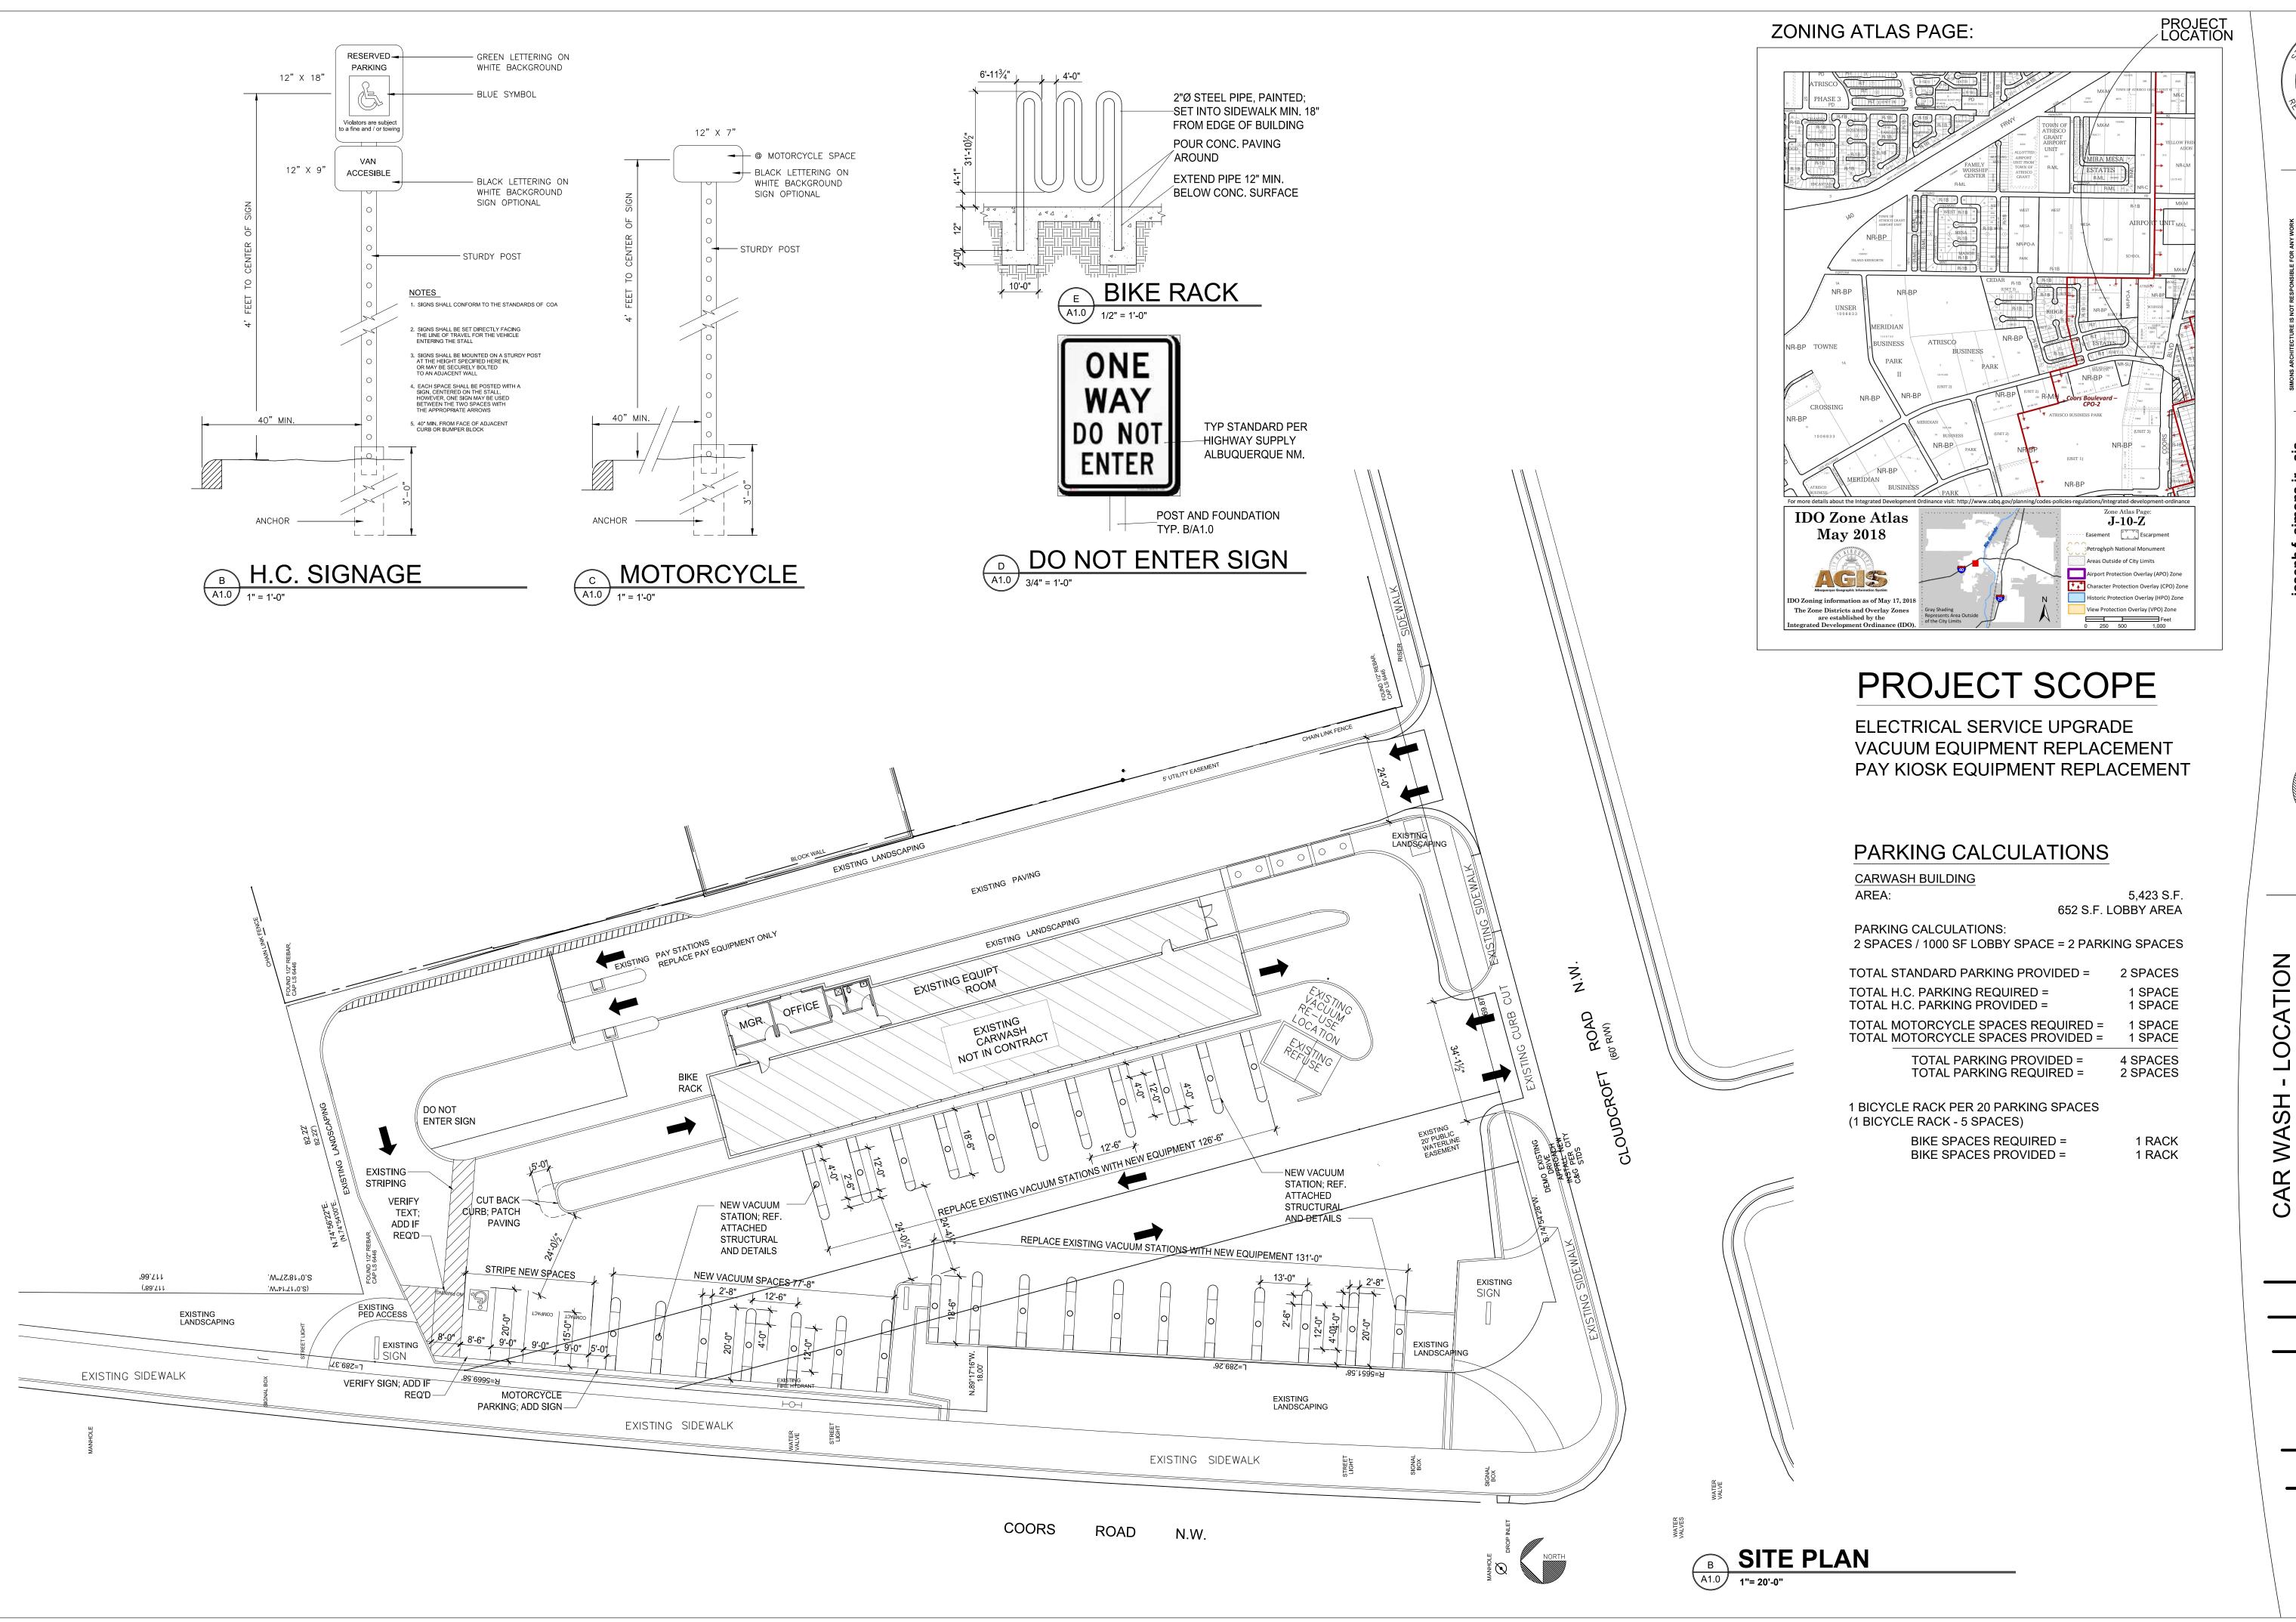

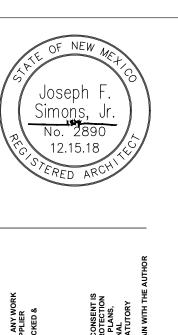

IONS ARCHITECTURE IS NOT RESPONSIBLE FOR ANY WORK

NE BY CONTRACTORSUB-CONTRACTOR OR SUPPLIER

L MEASUREMENTS AND DIMENSIONS TO BE CHECKED &
NEIRMED BY OWNER & CONTRACTOR.

IONS ARCHITECTURE, ALL RIGHTS RESERVED

PYRIGHT WARNING
SIGNS PREPARED BY SIMONS ARCHITECTURE

ETHE PROPERTY OF SIMONS ARCHITECTURE

FRODUCTION IN ANY FORM WITHOUT WRITTEN CONSENT IS
PRESSLY PROHIBITED. FEDERAL, COPYRIGHT PROTECTION
TENDS TO ORIGINAL AND MODIFIED DERIVATIVE PLANS,
PAPPLICABLE TO INTENTIONAL AND NINITENTIONAL
RINGEMENTS, AND PROVIDES FOR SPECIFIC STATUTORY
MAGGES, BOTT CYLLL AND CRIMINEL
PHYRIGHT OF ANY EXISTING BUILDINGS TO REMAIN WITH THE AUTH

oh f. simons jr., aia nm lic 002890 p.o. box 67408 abq, n.m., 87193-7408 ph.505.480.4796

SIMONS
ARCHITECTU

500 COORS BLVD NW ALBUQUERQUE, NM 87113
BERNALILLO COUNTY

JOB NUMBER LBJ-004 DATE 11.19.18

11.19.18 REVISIONS 12.15.18

DESIGNED & DRAWN BY

A1.0