


GENERAL NOTES


- 1. EDGES SHOULD BE REMOVED WITH 3/8" EDGING TOOL.
- 3000 PSI CONCRETE OVER SUBGRADE COMPACTED TO 95%.
- CONSTRUCTION CONTROL JOINTS @ 6' O.C.

'U' SHAPED PCC CHANNEL

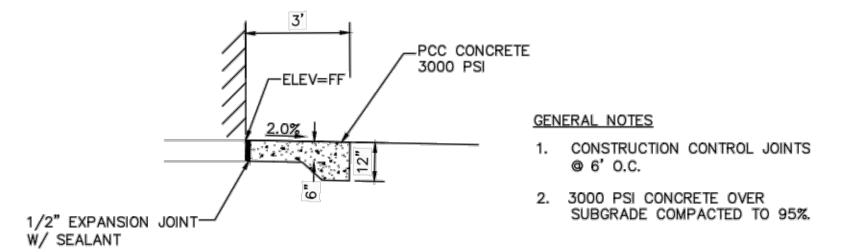

MOW CURB ADJACENT TO BUILDING

NTS

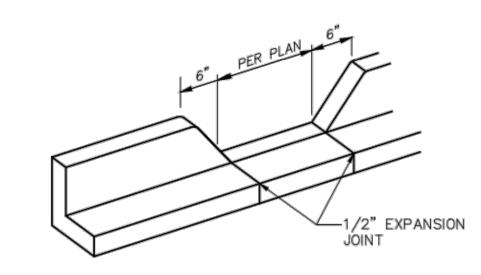


GENERAL NOTES

- 1. EDGES NOT SPECIFICALLY DIMENSIONED SHALL BE SHAPED WITH A 3/8" EDGING TOOL.
- 2. PROVIDE SMOOTH SURFACE ON BACK SIDE OF EXPOSED CURB.
- 3. 3000 PSI CONCRETE.


CURB OPENING


SCALE: N.T.S.

1"=10"

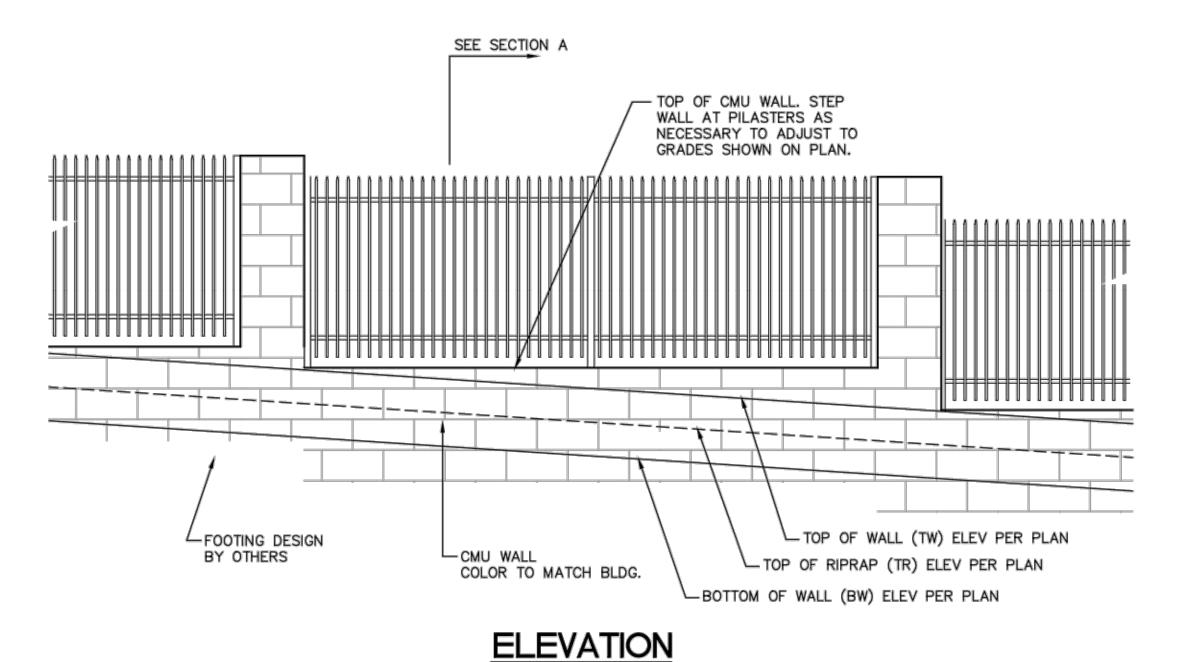

WROUGHT IRON FENCE W/ CMU RTG WALL ELEVATION AND SECTION

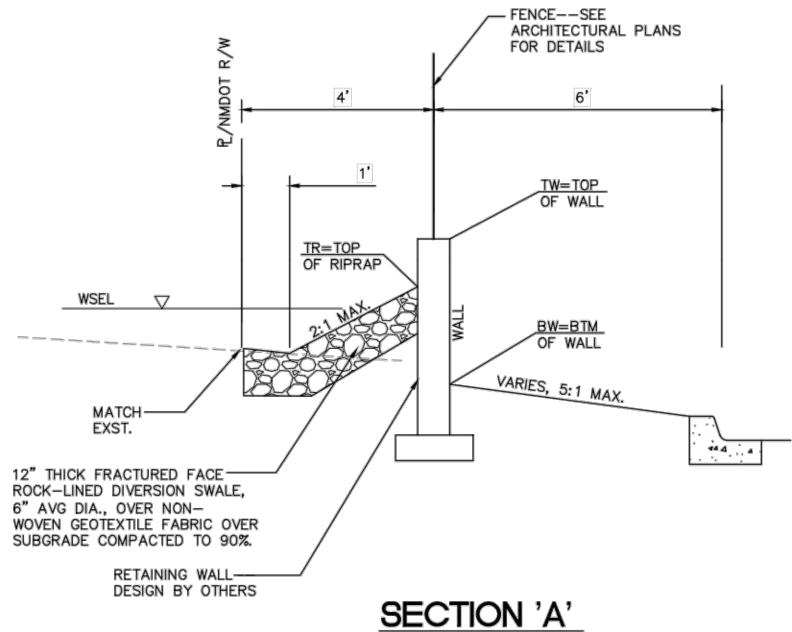

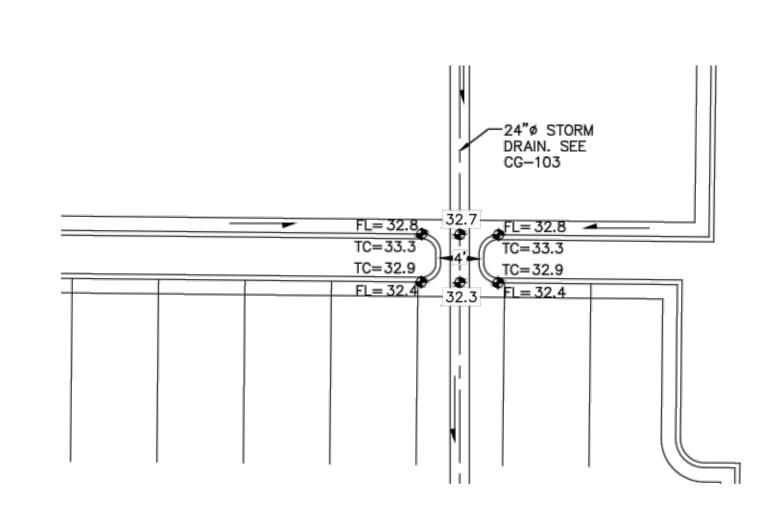

4' PCC RUNDOWN

ALONG WEST PROPERTY LINE


-INSTALL 2 LF OF 18" SD PIPE TO ALLOW ACCESS FOR GROUTING INTERIOR OF SAWCUT PIPES AND MATCH ENDS. GROUT INTERIOR OF PIPE JOINT WITH NON-SHRINK GROUT A. 2-#4 BARS W/ 3" CLEARANCE B. 6-#4 BARS W/ 3" CLEARANCE

NOTE;
24 HRS PRIOR TO POURING CONCRETE COLLAR, CONTRACTOR SHALL NOTIFY ENGINEER FOR INSPECTION.

CONCRETE COLLAR

18"X18" ADS H20 RATED,— LOCKING, HINGED, SOLID GRATE & FRAME 30" SQ. -18" NYLOPLAST CONCRETE -

ADS NYLOPLAST BASIN

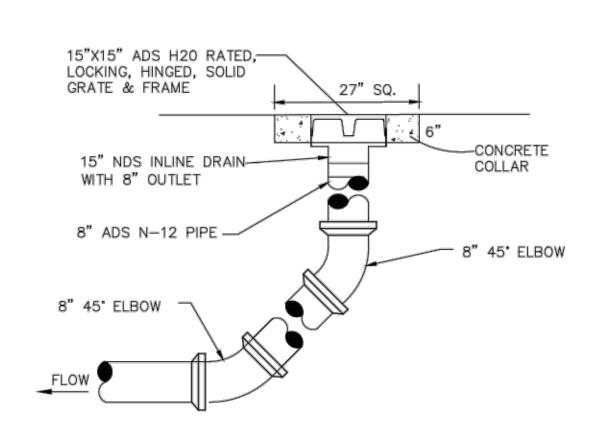

ADS NYLOPLAST INLINE DRAIN



ISAACSON & ARFMAN, P.A. Consulting Engineering Associates 128 Monroe Street N.E. Albuquerque, New Mexico 87108 Ph. 505-268-8828 www.iacivil.com 1941 CG-501.dwg Jun 18,2013

6/18/13

REVISIONS

CONSTRUCTORS, est Eleventh Street California 91786

KENWORTH UNA ROAD N.W.

DRAINAG

FOR:

KENWORTH

L-800 ABC-