
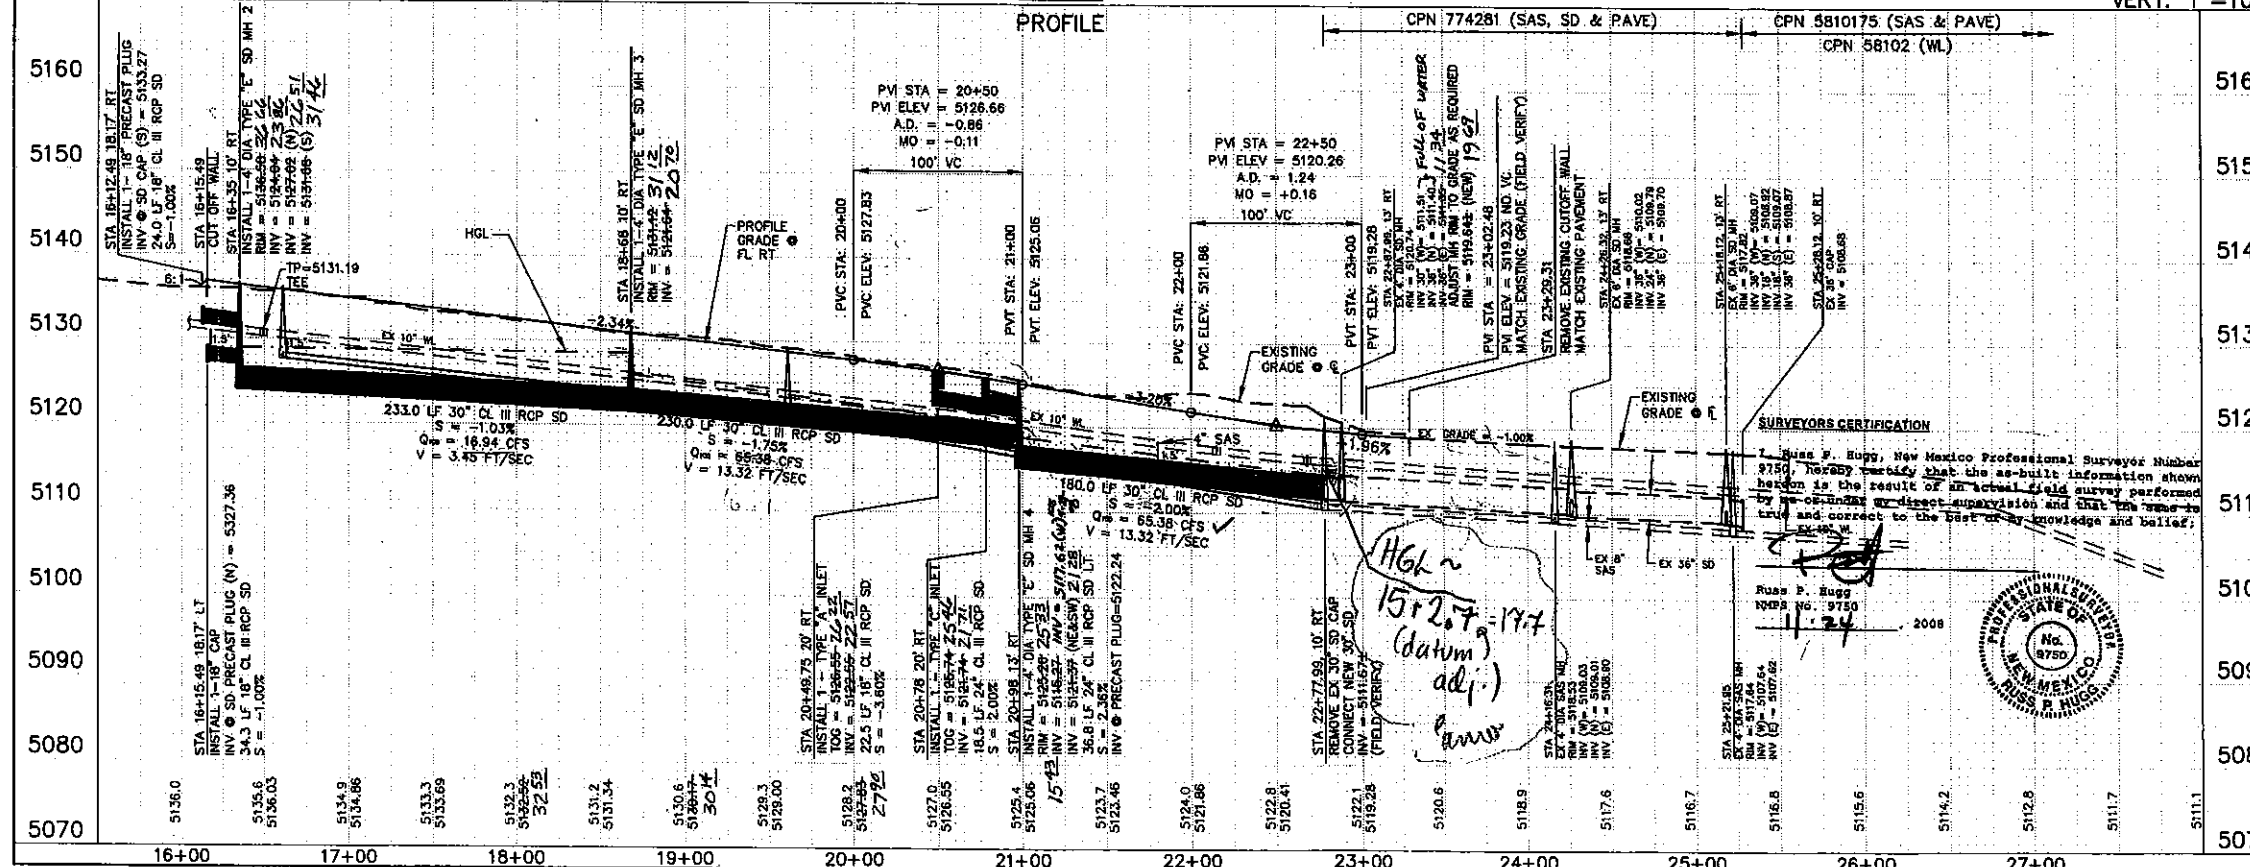


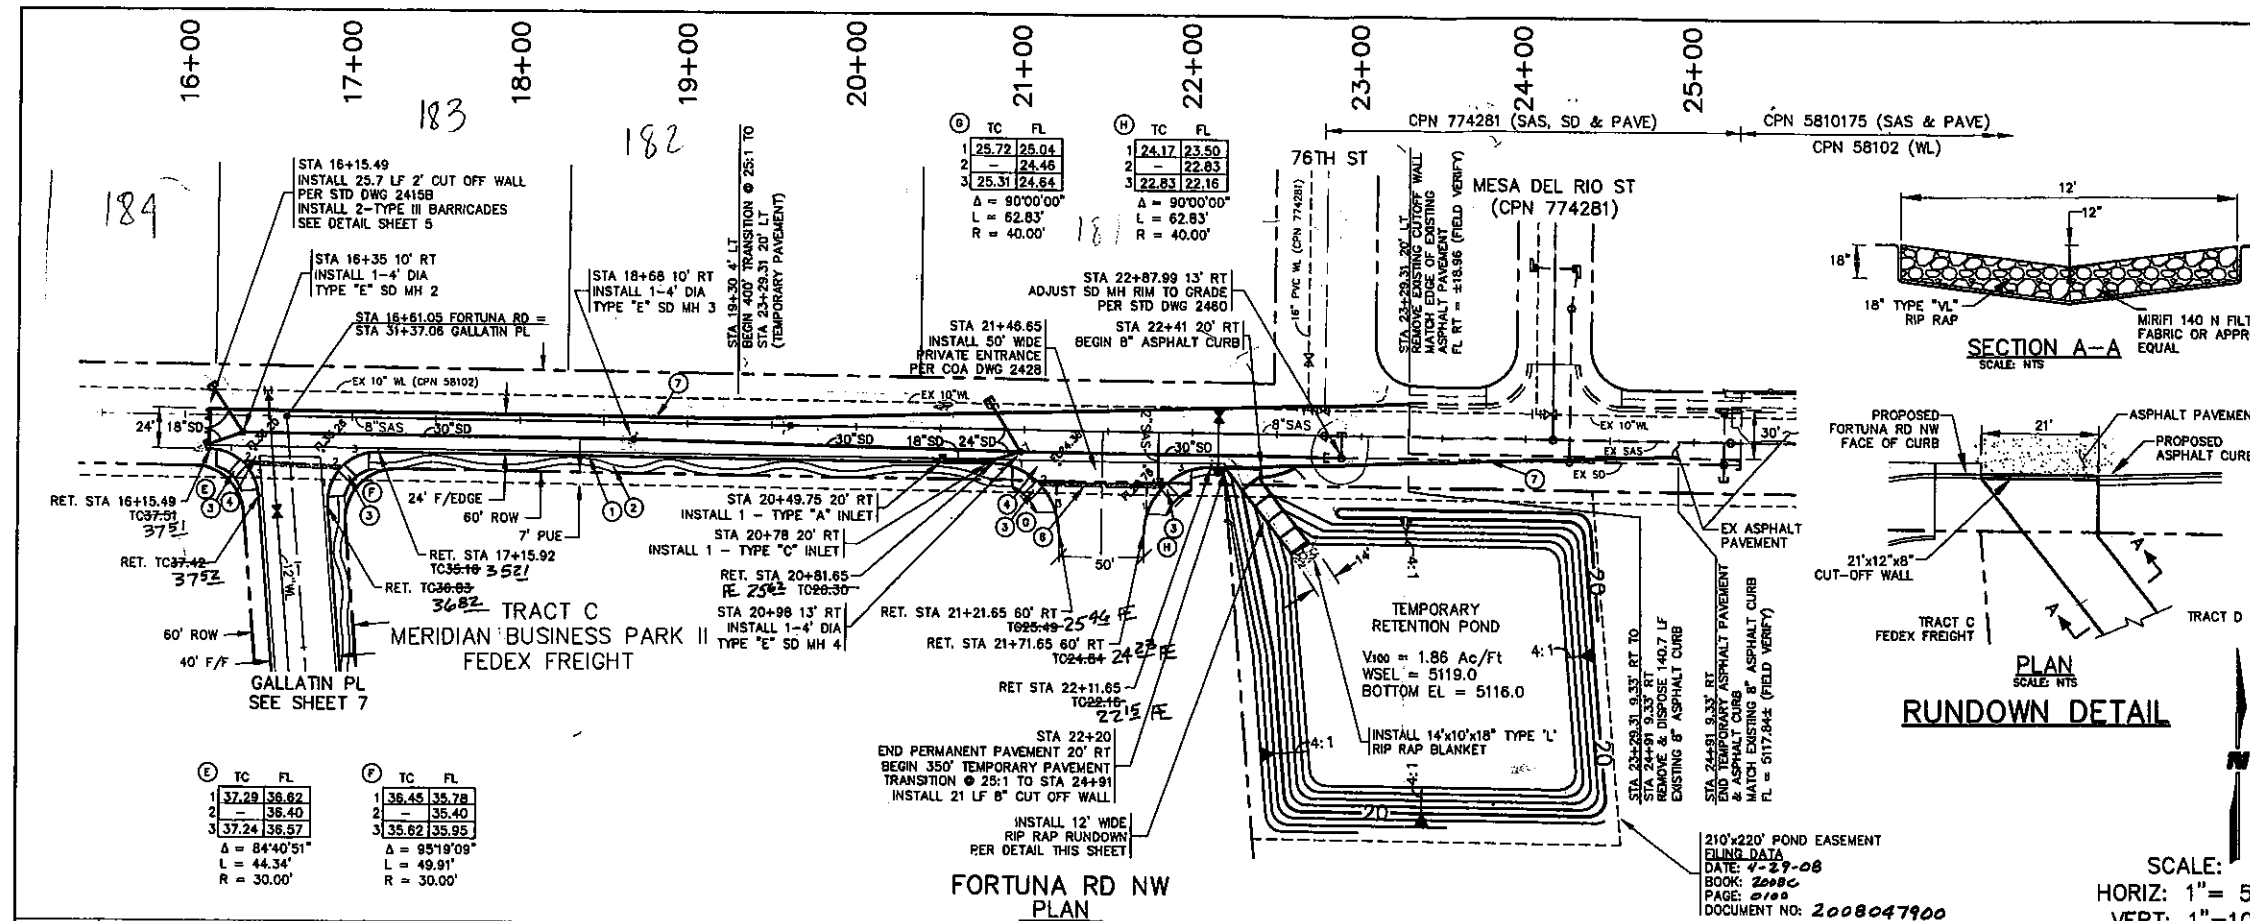

NOTES

SEE TYPICAL ROADWAY SECTION A SHEET 4

INSTALL TYPE "A" INLET PER STD DWG 2201 & 2202

INSTALL TYPE "C" INLET PER STD DWG 2205

INSTALL GRATES PER STD DWG 2220

ADJUST SD MH RIM TO GRADE PER STD DWG 2460

- CONSTRUCT STANDARD CURB & GUTTER PER STD DWG 2415A
- 4' MEANDERING SIDEWALK PER SITE PLAN FOR BUILDING PERMIT BY OTHERS
- CONSTRUCT WHEELCHAIR RAMP PER STD DWG 2441 CASE II WITH TRUNCATED DOMES PER DETAIL SHEET 4. CONTRACTOR TO SUBMIT SPECS TO CITY OF ALBUQUERQUE CONSTRUCTION ENGINEER FOR EVALUATION PRIOR TO INSTALLATION
- CONSTRUCT 6" VALLEY GUTTER PER STD DWG 2420
- 50' CROWN REDUCTION PER STD DWG 2401
- 2% CROSS SLOPE FOR ADA ACCESS PER DETAIL SHEET 4
- 4" SOLID WHITE

GENERAL NOTES

- THE CONTRACTOR SHALL VERIFY THE HORIZONTAL AND VERTICAL LOCATION OF ALL EXISTING UTILITIES WITHIN THE CONSTRUCTION AREA PRIOR TO CONSTRUCTION.

AS-BUILT INFORMATION

CONTRACTOR: [Blank]
DATE: [Blank]

BENCH MARKS

THE STA. IS A 3" x 3" ALUMINUM CAP STAMPED "10-K10 1889" SET FLUSH IN THE TOP OF CURB. THE STA IS LOCATED 4.3 MI. WEST OF D.T. ALSO TO REACH THE STA FROM I-40 & UNDER BLVD. GO S. ON UNDER BLVD. 0.4 MI. TO MONTANO RD. TURN W. ON MONTANO RD. 0.3 MI. TO LOS VOLCANES RD. THE STATION IS IN THE SE. QUADRANT OF THE INTX. IN A TRAFFIC ISLAND.
ELEVATION = 5142.790 FT.
(2ND ORDER-1ST CLASS) (NGVD 29)

SURVEY INFORMATION

NO.	DATE	BY

ENGINEER'S SEAL

BY: [Signature]
REVISIONS: [Blank]
NO. DATE

REVISIONS

NO.	DATE	REVISIONS

DESIGNED BY KIS
DRAWN BY GBR
CHECKED BY DSA

CITY OF ALBUQUERQUE
PUBLIC WORKS DEPARTMENT
ENGINEERING GROUP

GALLATIN PLACE NW/FORTUNA ROAD NW
PAVING PLAN & PROFILE
FORTUNA RD STA 16+00 TO STA 27+00

APPROVE
DESIGN REVIEW COMMITTEE
CITY ENGINEER

APPROVE
DESIGN REVIEW COMMITTEE
CITY ENGINEER

City Project No. 578082
Zone Map No. J-10
Sheet 10 of 13


WILSON & COMPANY

SCANNED BY: PJA



FORTUNA STORM DRAIN LINE TABLE		
LINE	LENGTH	BEARING
1.34	15.00	S89°48'42"E
1.35	15.00	S89°48'42"E
1.36	230.13	S89°48'42"E
1.37	15.00	S89°48'42"E
1.38	15.00	S89°48'42"E
1.39	15.00	S89°48'42"E

I, CHRISTOPHER A. MADON, N.E.E. NO. 15702, DO HEREBY CERTIFY THAT THE AS-BUILT INFORMATION SHOWN AND THE ACTUAL SURVEY WHICH IT WAS DERIVED FROM WAS PERFORMED BY ME OR UNDER MY DIRECT SUPERVISION AND THAT THE INFORMATION SHOWN IS TRUE AND CORRECT TO THE BEST OF MY KNOWLEDGE AND BELIEF.

Christopher A. Madon 4/26/06
CHRISTOPHER A. MADON, N.E.E. NO. 15702 DATE

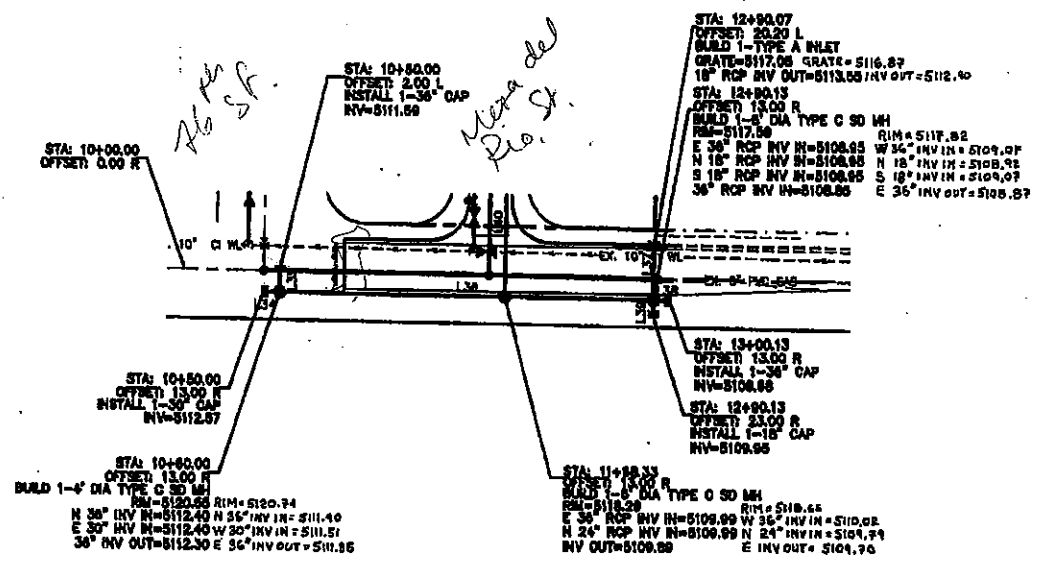

CAUTION
EXISTING UTILITIES ARE NOT SHOWN.
IT SHALL BE THE SOLE RESPONSIBILITY
OF THE CONTRACTOR TO CONDUCT ALL
NECESSARY FIELD INVESTIGATIONS PRIOR
TO ANY EXCAVATION TO DETERMINE THE
ACTUAL LOCATION OF UTILITIES & OTHER
IMPROVEMENTS.

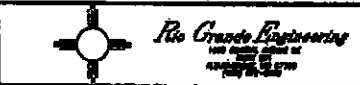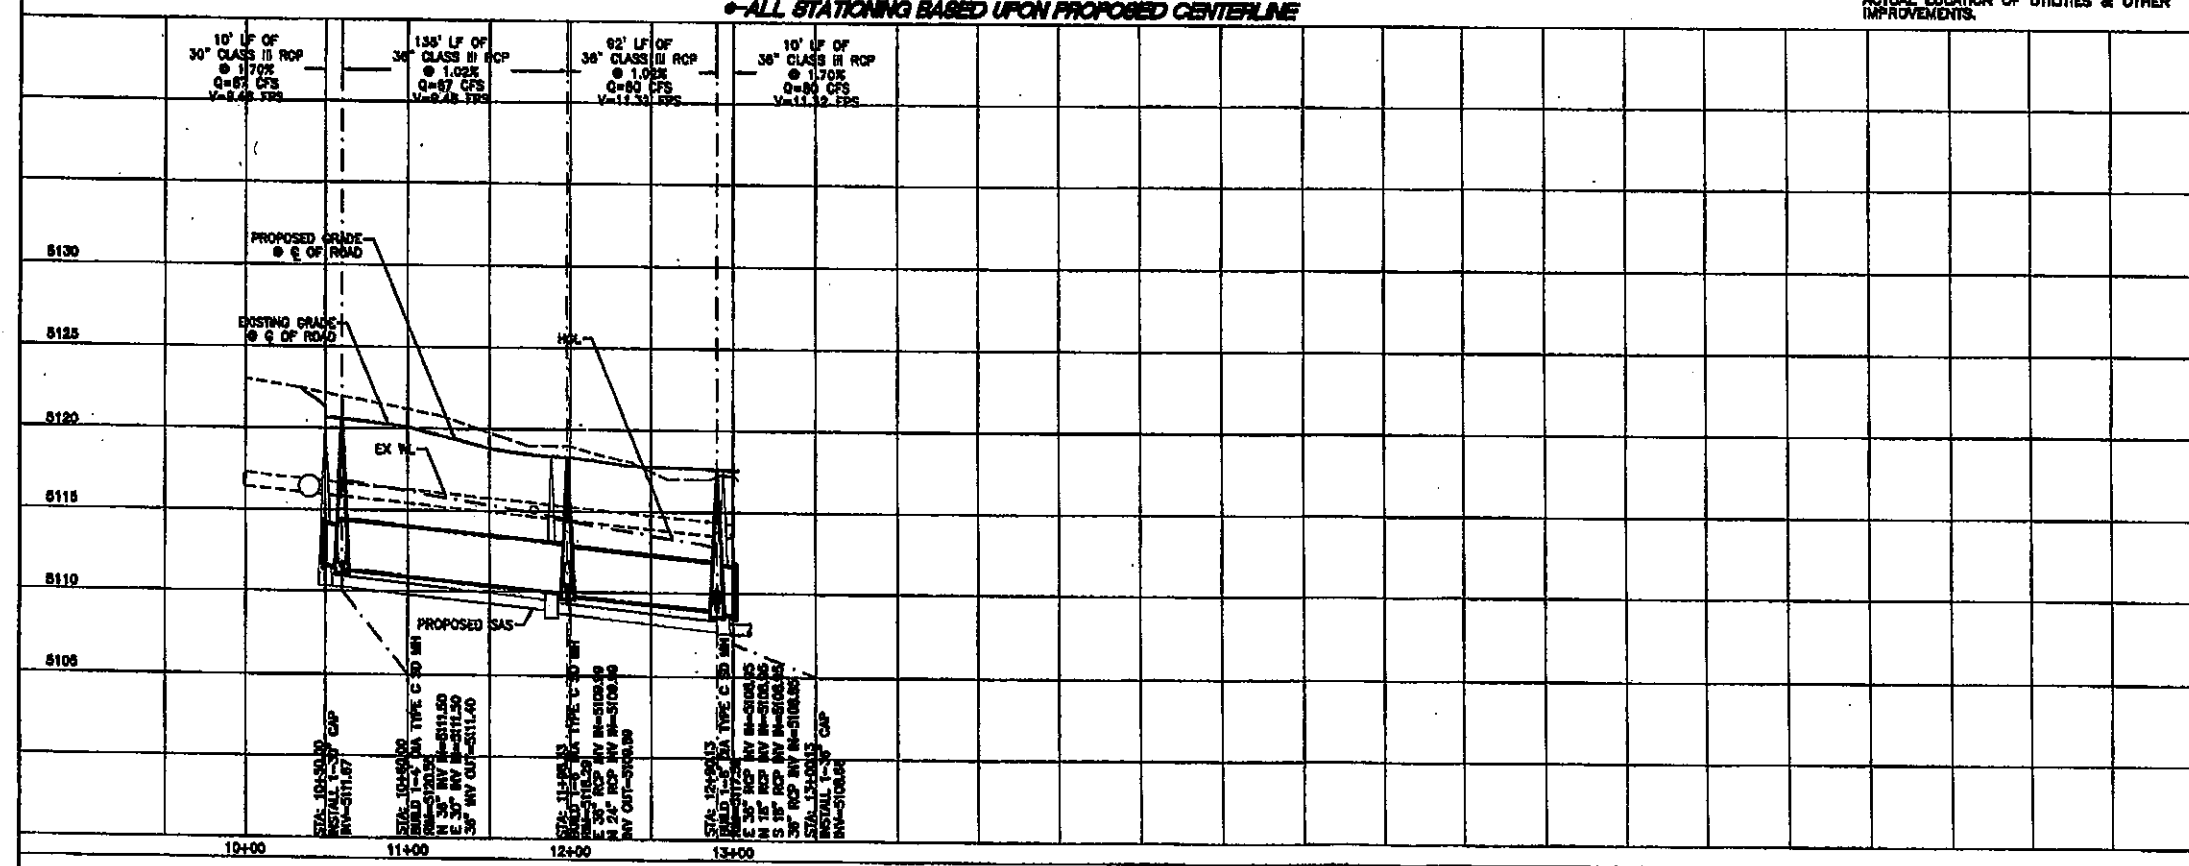

CITY OF ALBUQUERQUE
PUBLIC WORKS DEPARTMENT
ENGINEERING GROUP


TITLE: **MESA DEL RIO SUBDIVISION
FORTUNA ROAD STORM DRAIN IMPROVEMENTS**

DESIGNED BY: WEN	DATE: 9-16-03
DRAWN BY: WEN	DATE: 10-05
CHECKED BY: DS	DATE: 9-18-03

CITY PROJECT NO. 774281

ZONE MAP NO. J-10-Z

SHEET 15 OF 16



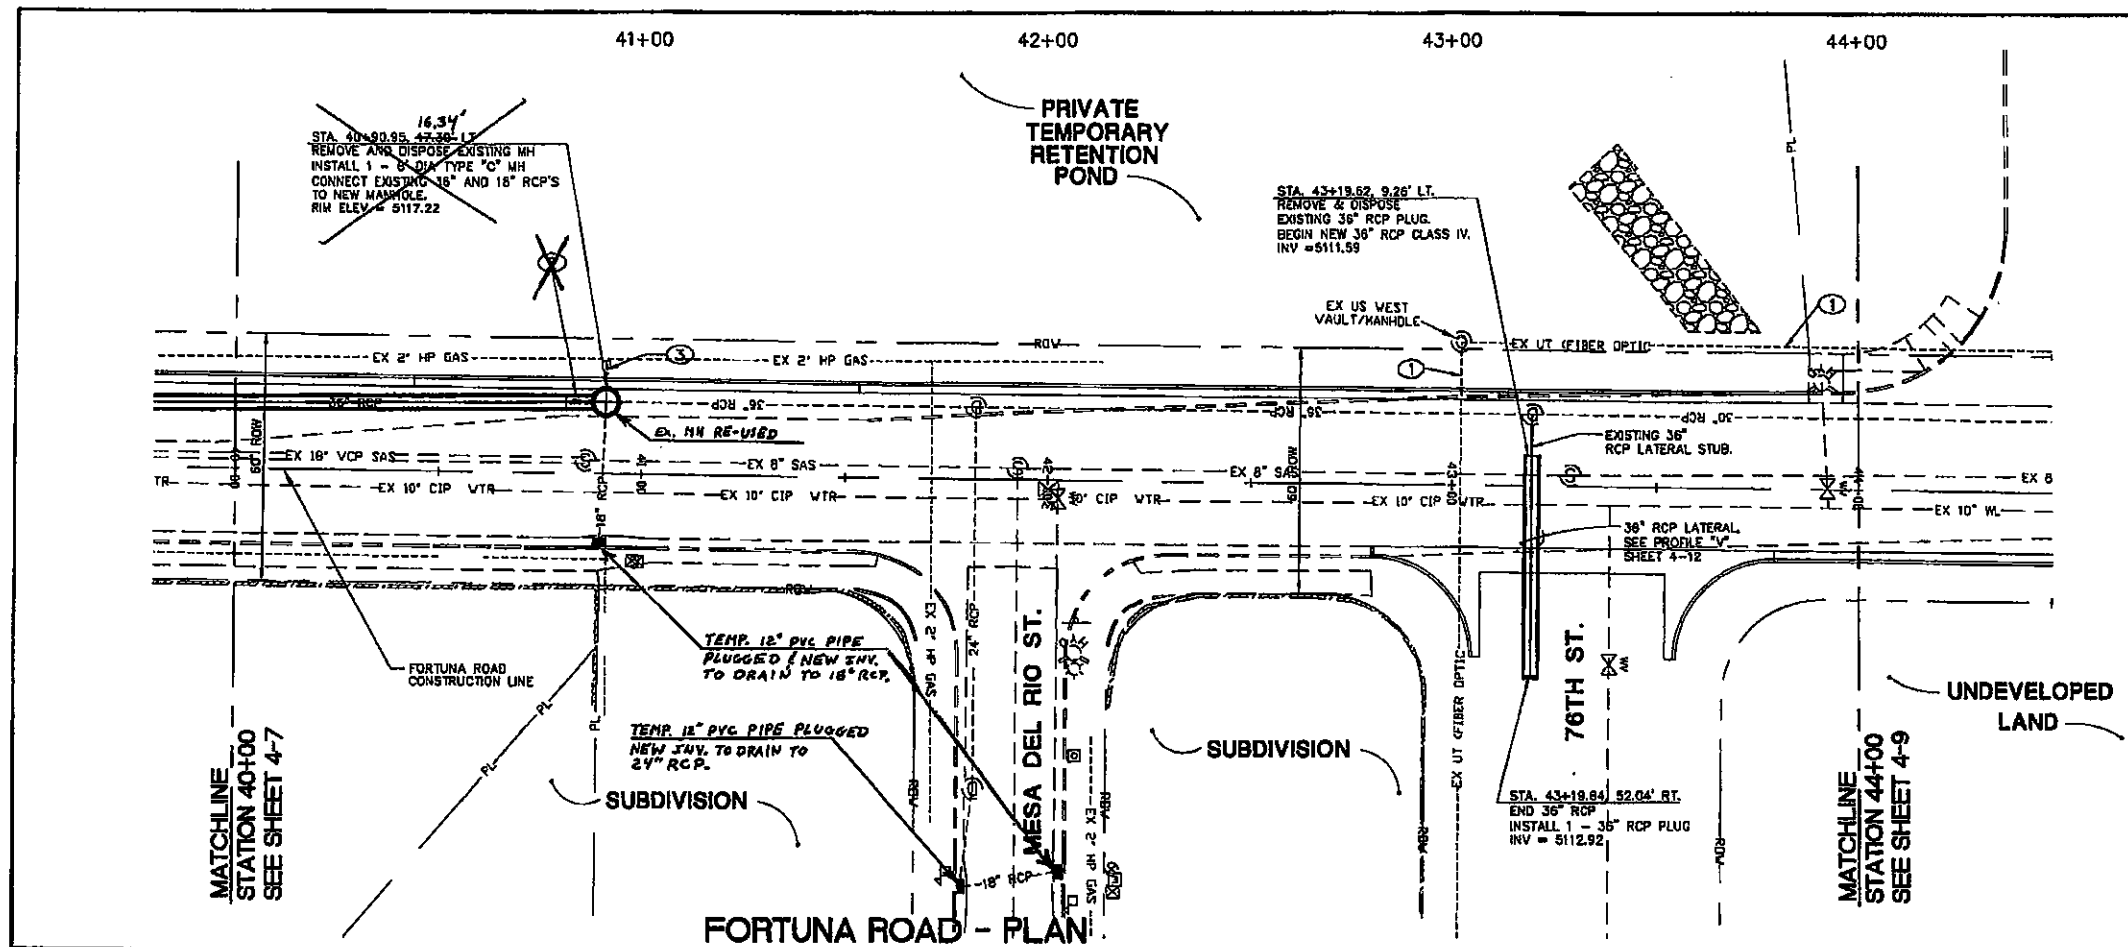


KEYED NOTES:

1. PRIOR TO THE START OF CONSTRUCTION THE CONTRACTOR SHALL COORDINATE WITH QWEST (BEVERLY YOUNG (505) 245-3934) NOTE: QWEST REQUIRES 4 WEEKS TO SCHEDULE CREWS TO PERFORM ANY WORK.
2. REMOVE AND DISPOSE 8\"/>

GENERAL NOTES

1. ALL CONSTRUCTION MUST TAKE PLACE WITHIN CITY OF ALBUQUERQUE RIGHT OF WAY. THE CONTRACTOR SHALL USE SHORING, TRENCH BOXES, ETC. DURING THE TRENCHING AND BACKFILLING PROCESS SO AS NOT TO DAMAGE ANY FACILITIES, UTILITIES, FENCES, WALLS, PAVEMENT, ETC. THAT EXIST ON PRIVATE PROPERTY. ANY DAMAGE TO ITEMS LOCATED ON PRIVATE PROPERTY WILL BE THE RESPONSIBILITY OF THE CONTRACTOR TO REPLACE AT NO ADDITIONAL COST TO THE OWNER.
2. THE CONTRACTOR SHALL NOT USE LARGE/HEAVY VIBRATORY COMPACTION MACHINES/DEVICES BELOW SPRING LINE OF THE PROPOSED STORM DRAIN PIPE DUE TO THE AGE OF THE EXISTING 18\"/>

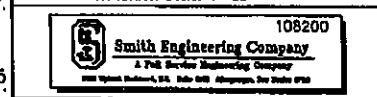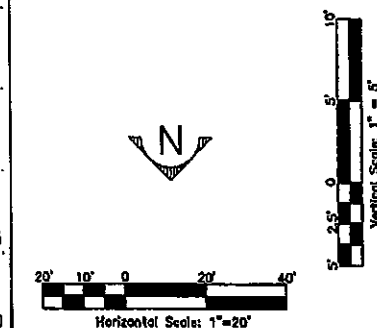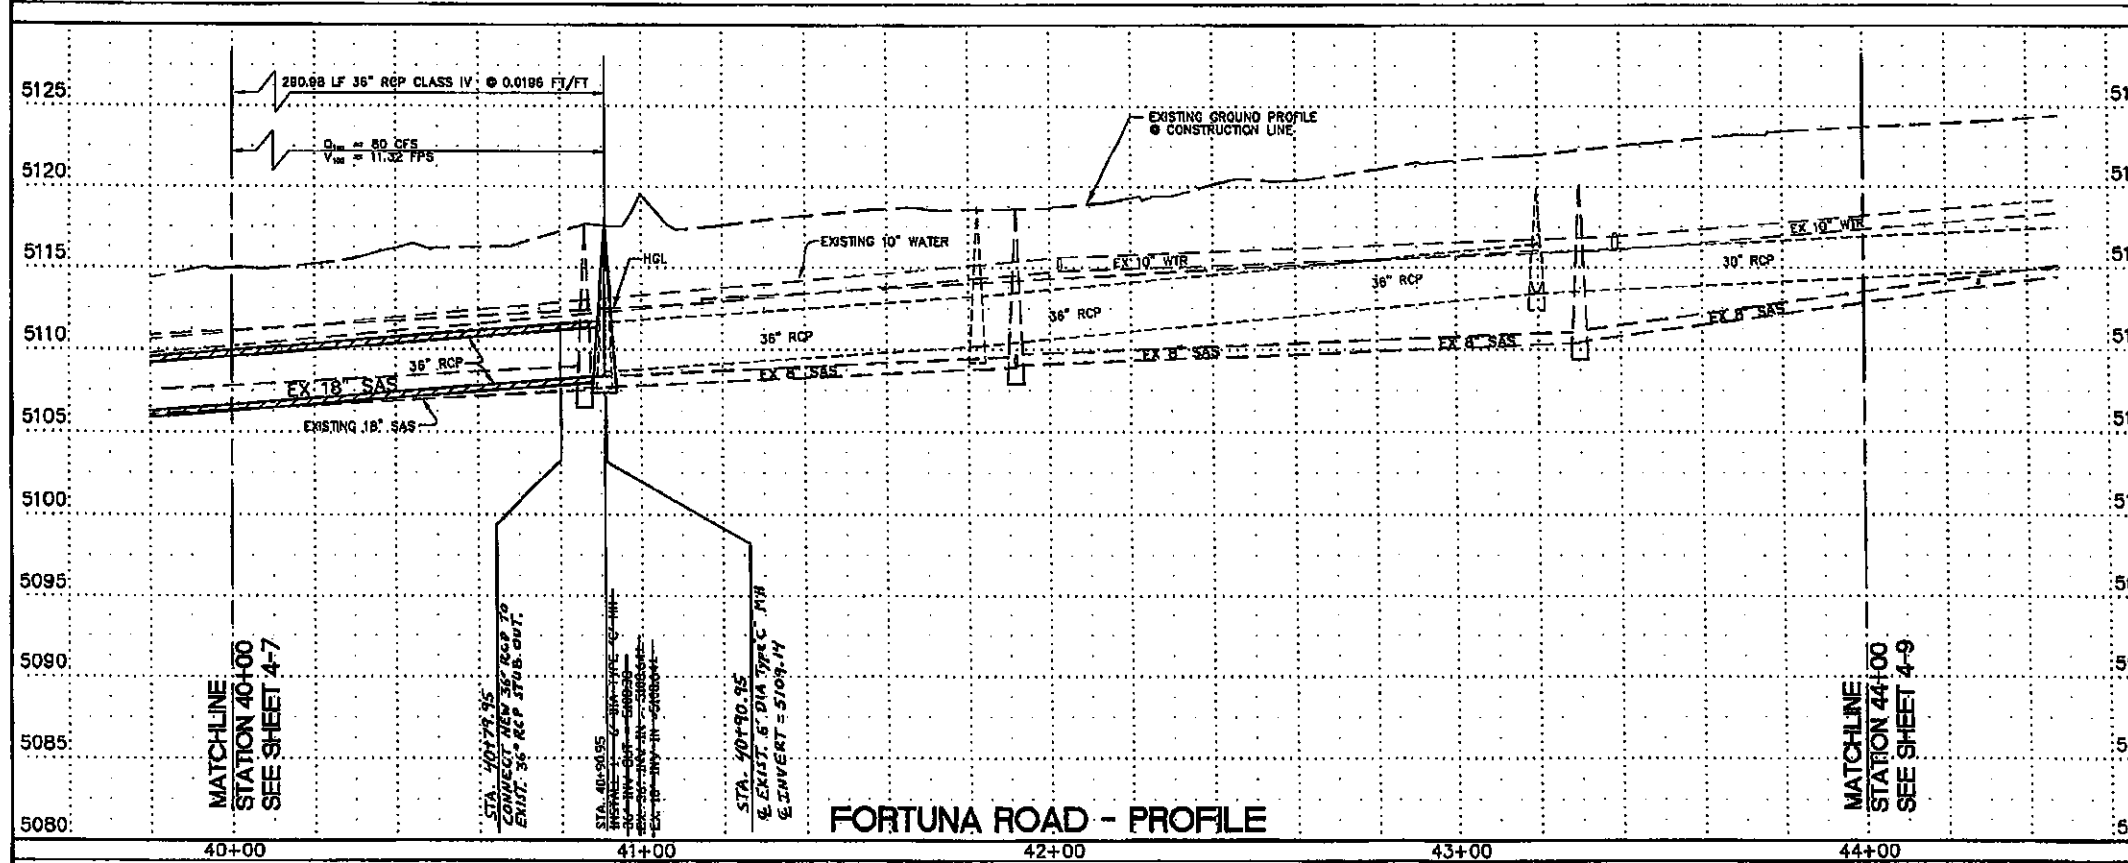

CITY OF ALBUQUERQUE
DEPARTMENT OF MUNICIPAL DEVELOPMENT
ENGINEERING DIVISION

TITLE: FORTUNA ROAD IMPROVEMENTS
STORM DRAIN P&P: FORTUNA ROAD: STA 40+00 TO 42+29.08

DESIGN REVIEW COMMITTEE	CITY ENGINEER APPROVAL
APPROVED	APPROVED
DESIGNER	CITY ENGINEER

City Project No.	Zone Map No.	Sheet No.	Sheet	Of
5780.91	J-10	4-8	35	61

AS BUILT INFORMATION			
CONTRACTOR	DATE	BY	NO.
1-40-18 NMSHC/ACS ELEV. 5103.88 FEET (SLD 1923)			
SURVEY INFORMATION			
FIELD NOTES	DATE	BY	NO.
STATION IS LOCATED 3.5 MILES NW OF DOWNTOWN ALBUQUERQUE, AT THE INTERCHANGE. STATION MARK IS A 448 (COORS RD, NW) INTERCHANGE. STATION MARK IS A STANDARD NMSHC BRASS TABLET, STAMPED "STA 1-40-18", SET IN TOP OF A CONCRETE POST FLUSH WITH THE GROUND. (N 1494850.08, E 364150.83)			
ENGINEER'S SIGNATURE			
<i>David J. Adams</i>	DATE	BY	NO.
	06/2009	DESIGN	
	06/2009		
	06/2009		