


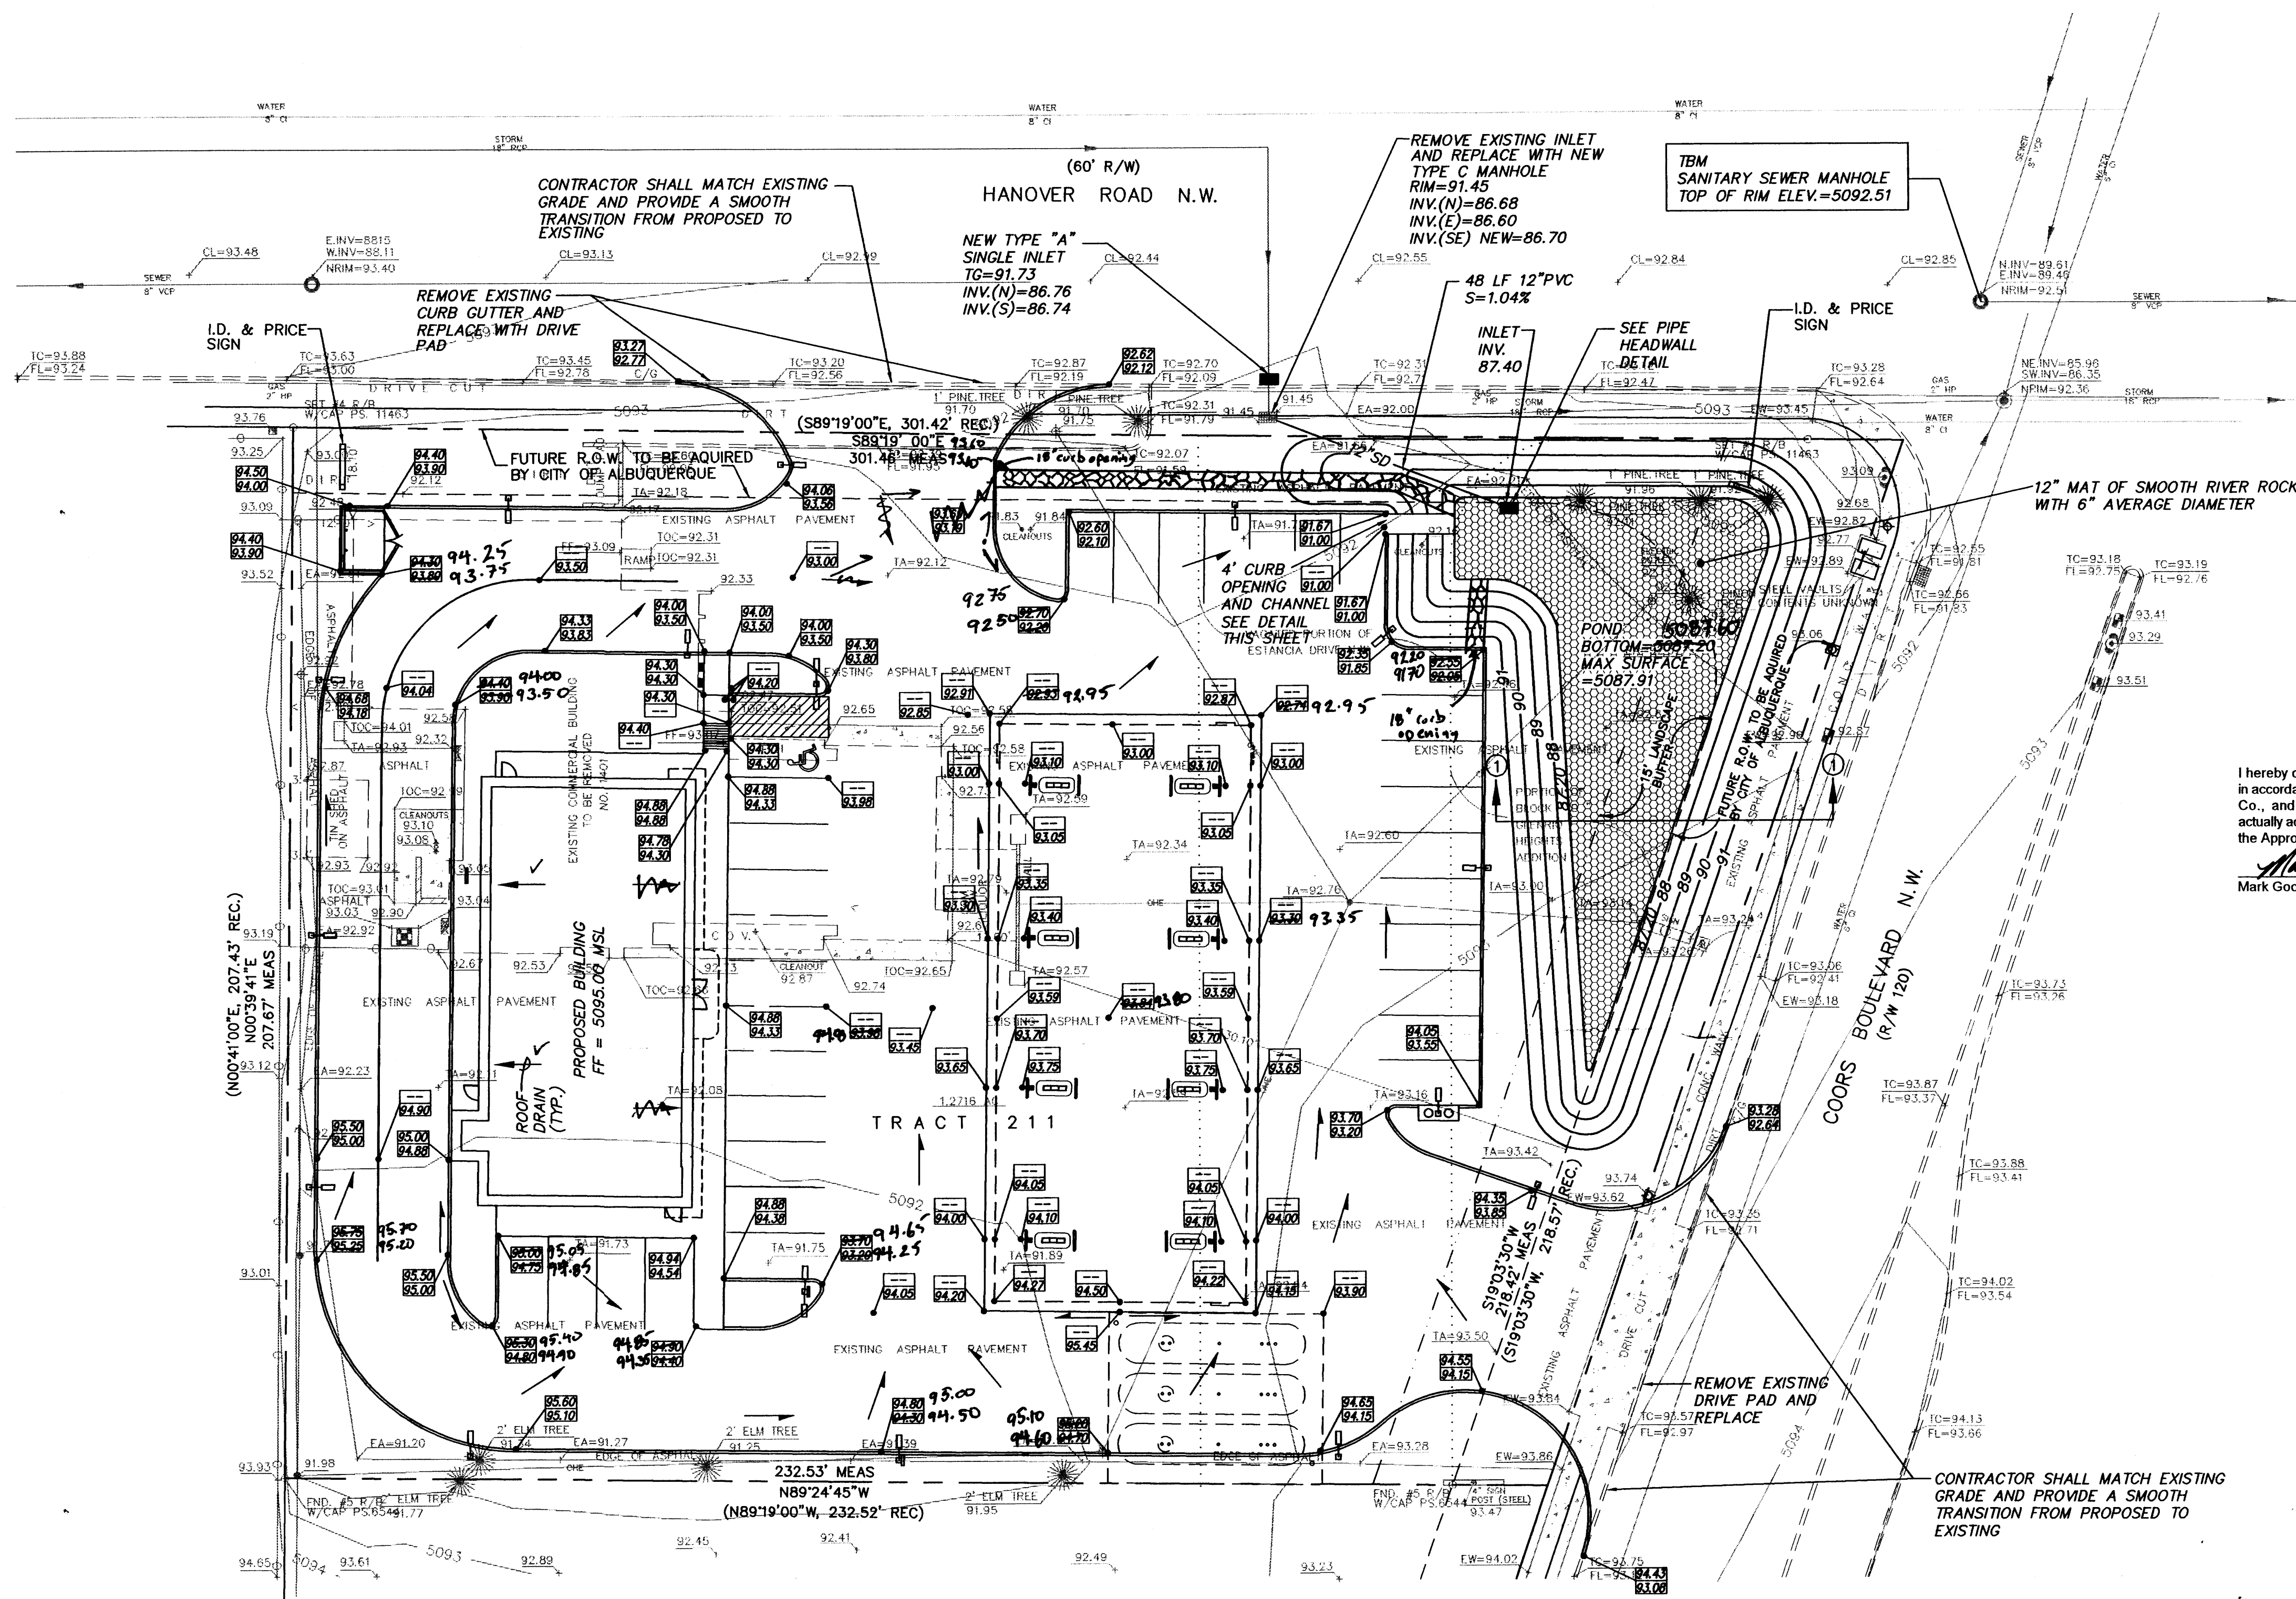






RECORD DRAWING

I hereby certify that the information contained on this drawing has been revised in accordance with information furnished by the contractor, Baker Construction Co., and by the surveyor, Wilson Hamby, and reflects the construction as actually accomplished. This plan as constructed is in substantial compliance with the Approved Plan.

Mark Goodwin 10/22/98
Mark Goodwin NMPE 8948



William Jones
APPROVED STORM DRAIN MAINTENANCE

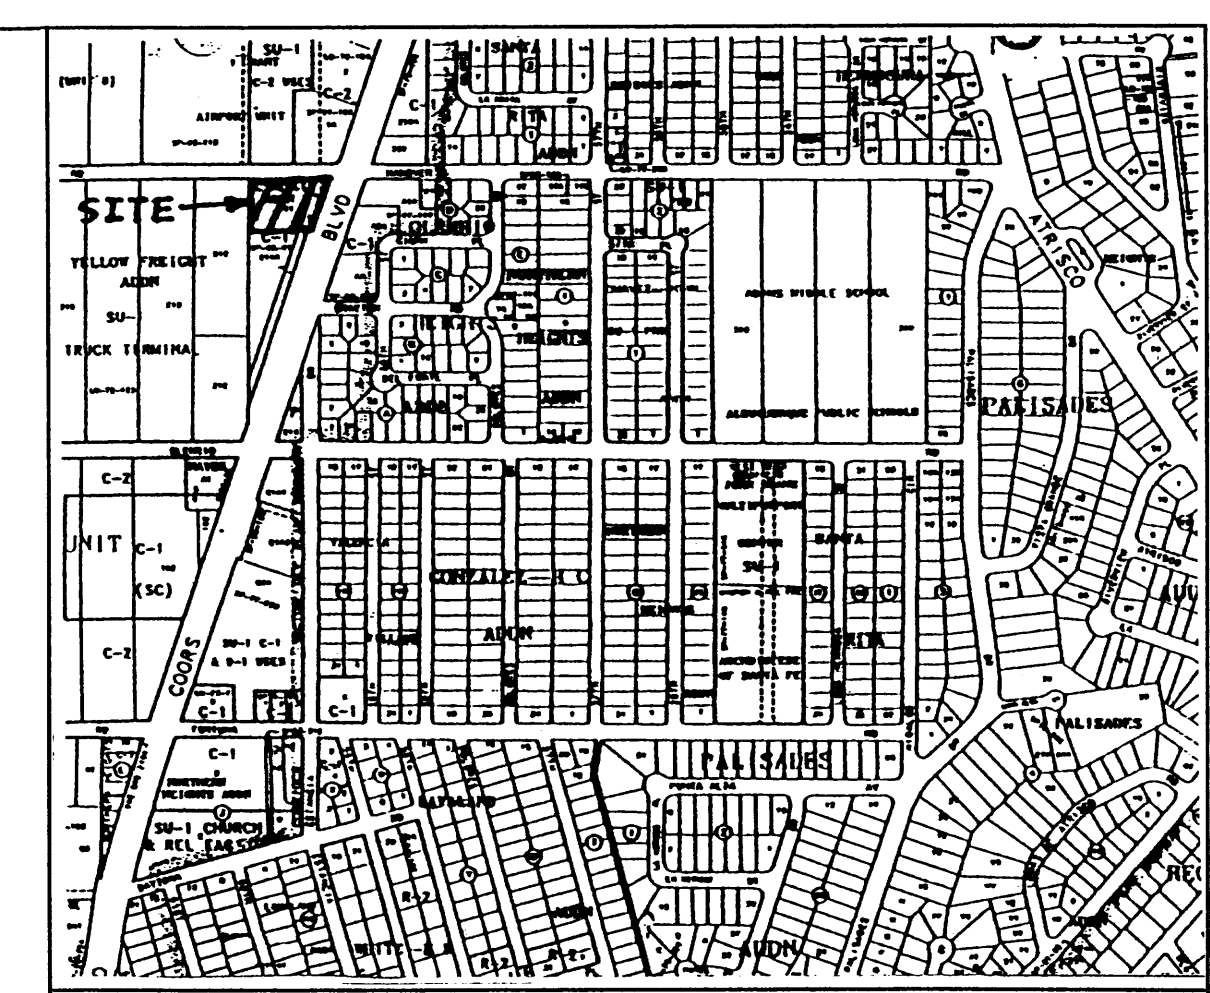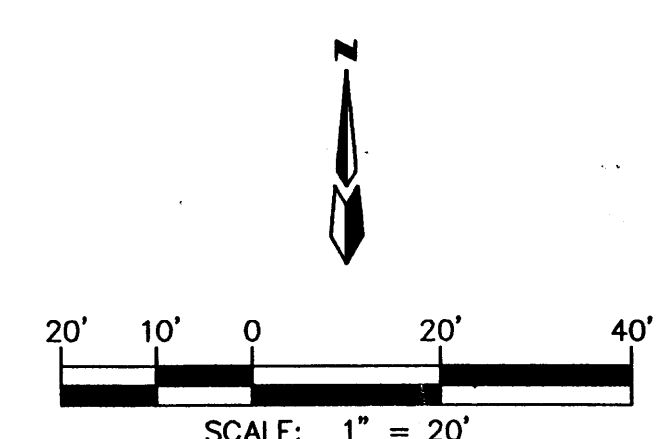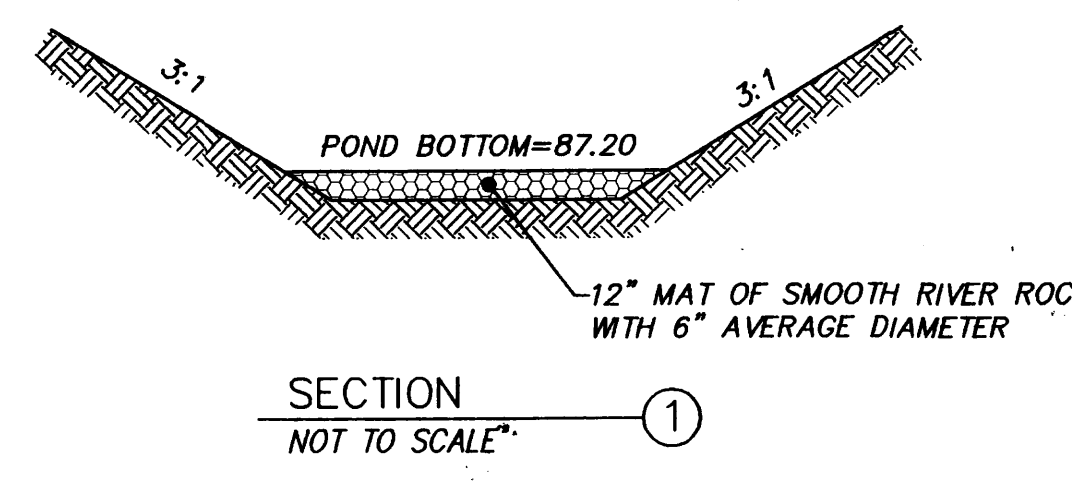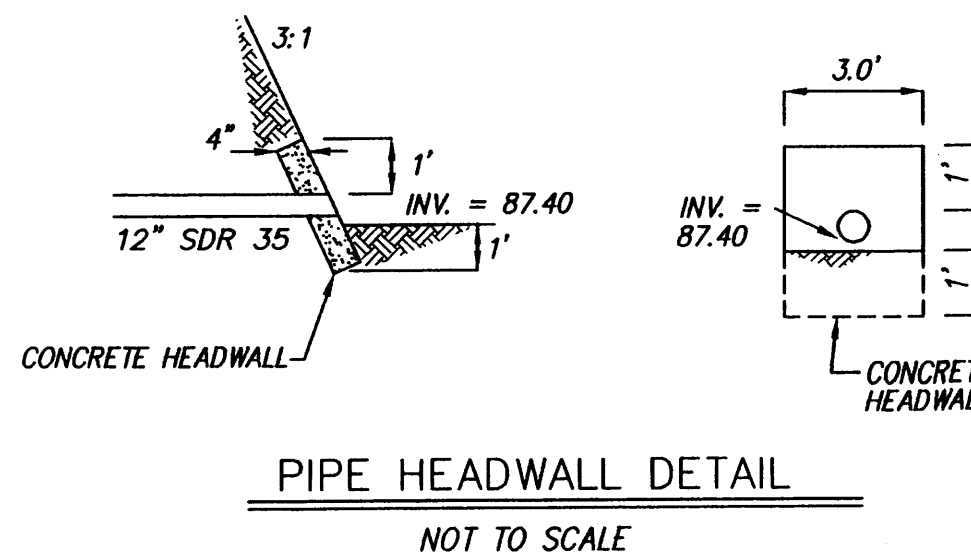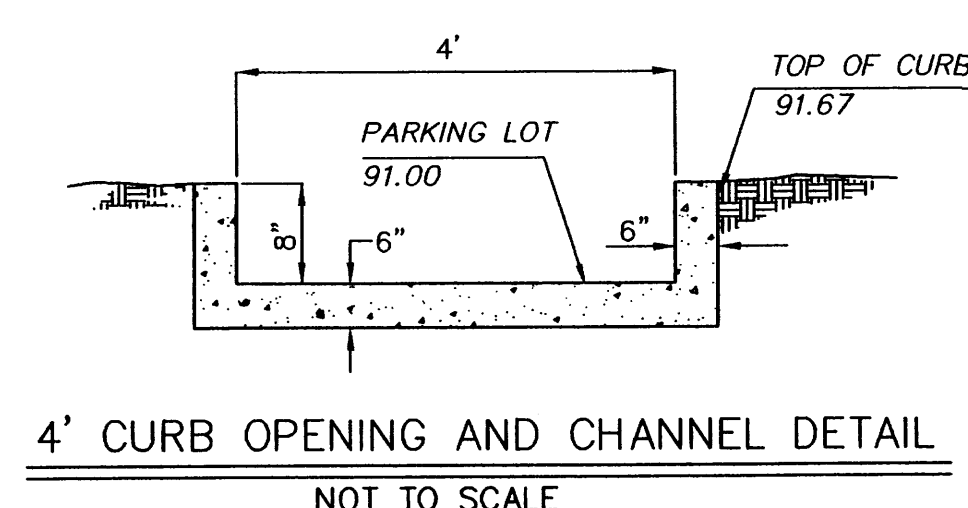

VICINITY MAP ZONE MAP: J-11-Z

TBM (TEMPORARY BENCHMARK)
AT INTERSECTION OF HANOVER ROAD AND COORS BOULEVARD
SANITARY SEWER MANHOLE TOP OF RIM ELEV.=5092.51

ACS BENCHMARK
LOCATED AT THE INTERSECTION OF HANOVER RD., AND 57TH STREET, N.W., IN THE SOUTHEAST QUADRANT OF THE INTERSECTION. AN "X" CHISLED ON TOP OF CONCRETE CURB AT THE ESE CURB RETURN. ELEV.=5092.868

LEGAL DESCRIPTION
TRACT 211 CINELLI ADDITION, TOWN OF ATRISCO GRANT, CITY OF ALBUQUERQUE, BERNALILLO COUNTY, NEW MEXICO.



NOTES
1. SITE LIES ENTIRELY WITHIN A 100 YEAR FLOOD ZONE. ELEV.=5094.00 M.S.L.
2. INLET RELOCATION TO BE ACCOMPLISHED BY WORK ORDER.

- LEGEND**
- AS-Built
 - NEW TOP OF CURB AND FLOWLINE SPOT ELEVATION
 - PROPERTY LINE
 - EXISTING CURB
 - NEW CURB
 - EXISTING CONTOUR
 - NEW CONTOUR
 - FF = 5095.00 FINISHED FLOOR ELEVATION
 - NEW INLET
 - NEW FLOW ARROW
 - EXISTING SPOT ELEVATION
 - EXISTING SANITARY SEWER MANHOLE
 - EXISTING STORM DRAIN MANHOLE
 - EXISTING INLET
 - EXISTING LIGHT POLE
 - EXISTING TRAFFIC SIGNAL BOX
 - NEW LIGHT

PHILLIPS 66 - HANOVER AND COORS
GRADING AND DRAINAGE PLAN

dmg MARK GOODWIN & ASSOCIATES, P.A.
CONSULTING ENGINEERS
P.O. BOX 90606
ALBUQUERQUE, NEW MEXICO 87199
(505) 828-2200

Designed: DPS Drawn: WLW Checked: DMG Sheet 1 of 1
Scale: 1" = 20' Date: 09/97 Job: 97033

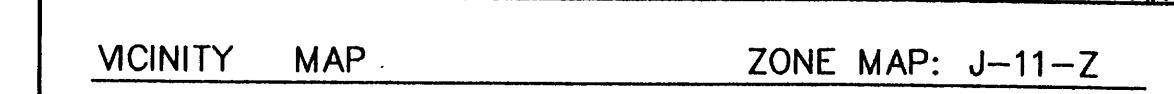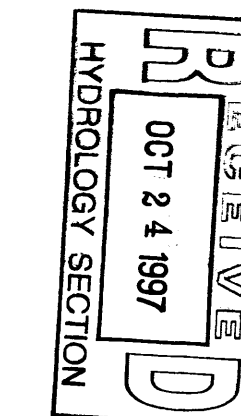



LEGAL DESCRIPTION

TRACT 211 CINELLI ADDITION, TOWN OF ATRISCO GRANT, CITY OF ALBUQUERQUE, BERNALILLO COUNTY, NEW MEXICO.

NOTES

1. SITE LIES ENTIRELY WITHIN A 100 YEAR FLOOD ZONE.
ELEV.=5094.00 M.S.L.
2. INLET RELOCATION TO BE ACCOMPLISHED BY WORK ORDER.

 LEGEND

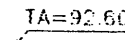	NEW TOP OF CURB AND FLOWLINE SPOT ELEVATION
	PROPERTY LINE
	EXISTING CURB
	NEW CURB
	EXISTING CONTOUR
	NEW CONTOUR
	FINISHED FLOOR ELEVATION
	NEW INLET
	NEW FLOW ARROW
	EXISTING SPOT ELEVATION
	EXISTING SANITARY SEWER MANHOLE
	EXISTING STORM DRAIN MANHOLE
	EXISTING INLET
	EXISTING LIGHT POLE
	EXISTING TRAFFIC SIGNAL BOX
	NEW LIGHT

PHILLIPS 66 - HANOVER AND COORS
CONCEPTUAL GRADING AND DRAINAGE PLAN

 D. MARK GOODWIN & ASSOCIATES, P.A.
CONSULTING ENGINEERS & SURVEYORS
P.O. BOX 90606
ALBUQUERQUE, NEW MEXICO 87199
(505) 828-2200

Designed: <i>DPS</i>	Drawn: <i>WLW</i>	Checked: <i>DMG</i>	Sheet 1 of 1
Scale: 1" = 20'	Date: 09/97	Job: 97033	

0094 93.61 509.3 92.89

1. Submit to
Local meeting
for Air Vortex
EPA ROP

2. Pond located on the
Northwest side of the
Site not the Northwest
Site indicated on the report

3. What type of Treatment is
proposed at the bottom of the proposed pond?

4"

PARKING LOT
91.00




6"



6"

TOP OF CURB
91.67

12" SDR 35

CONCRETE HEADWALL

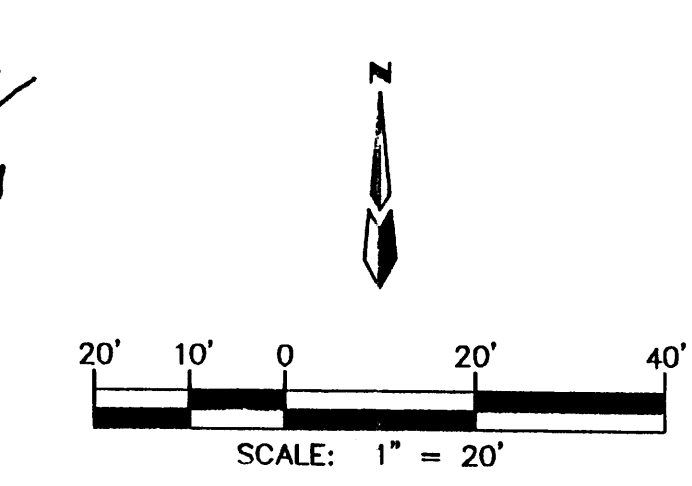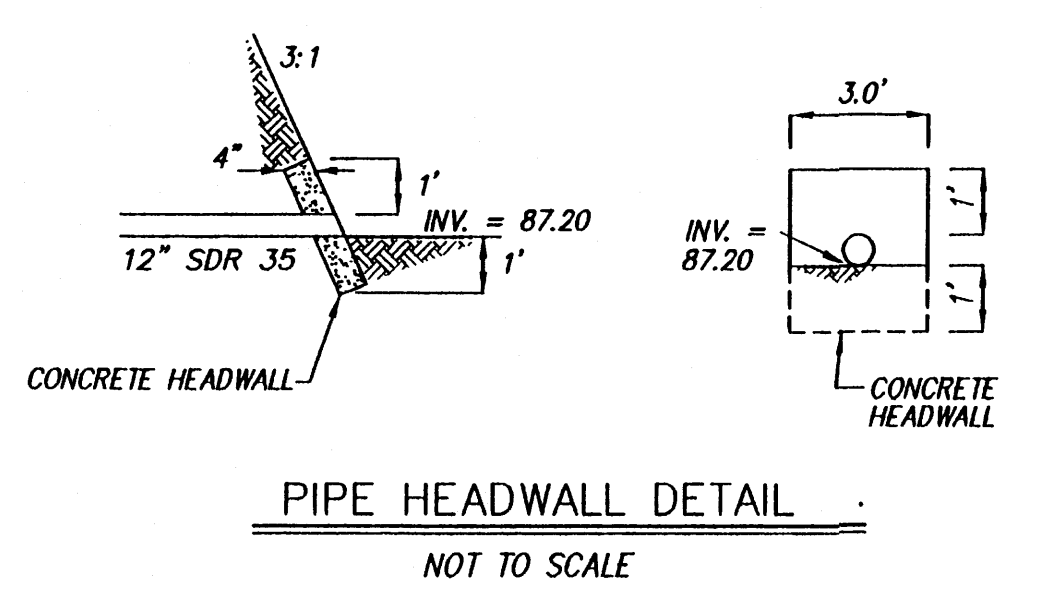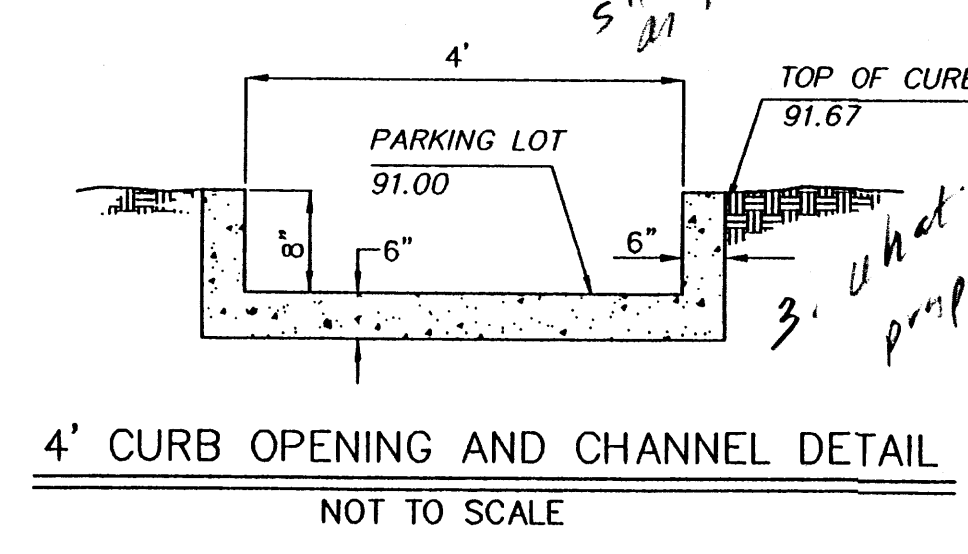

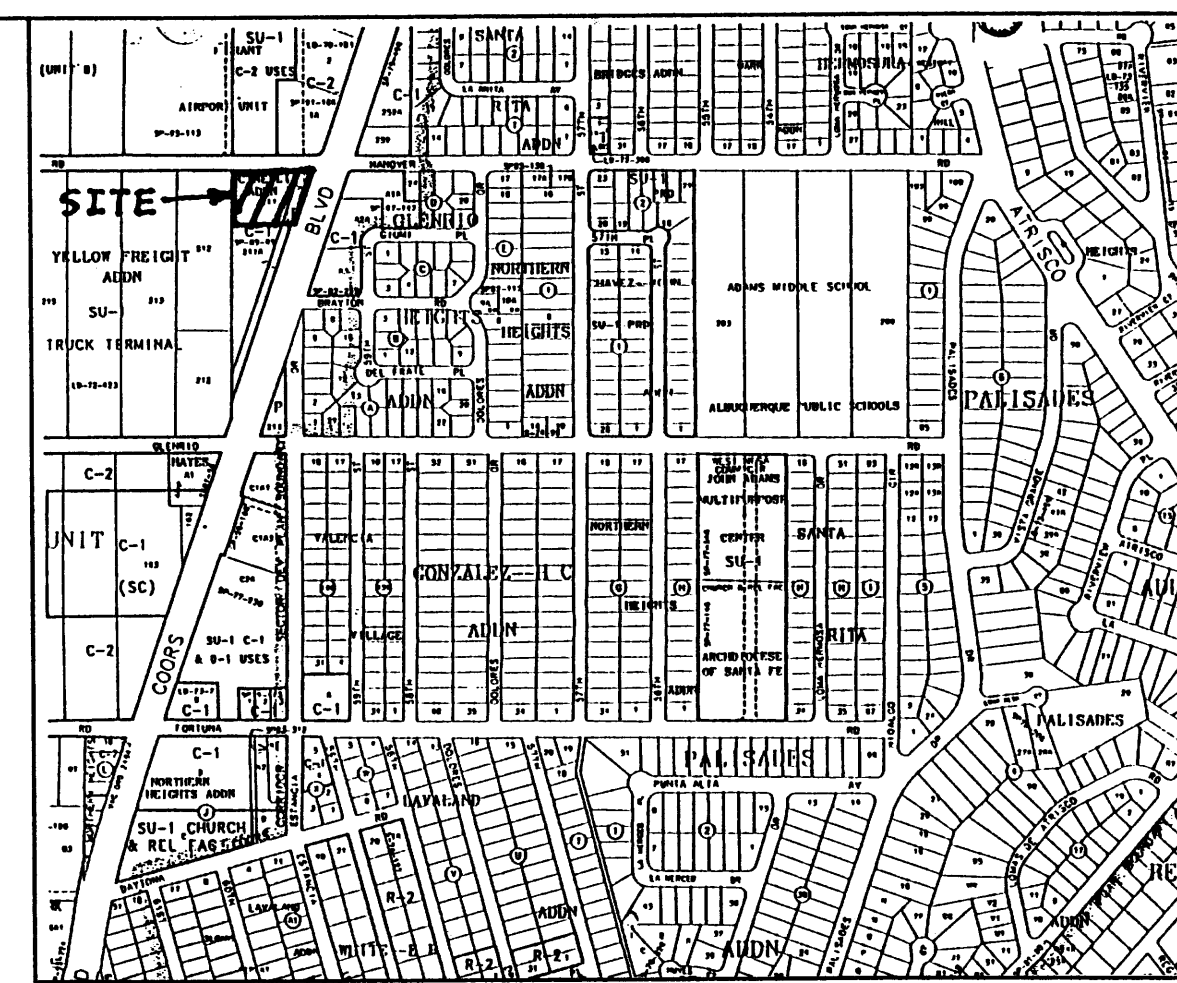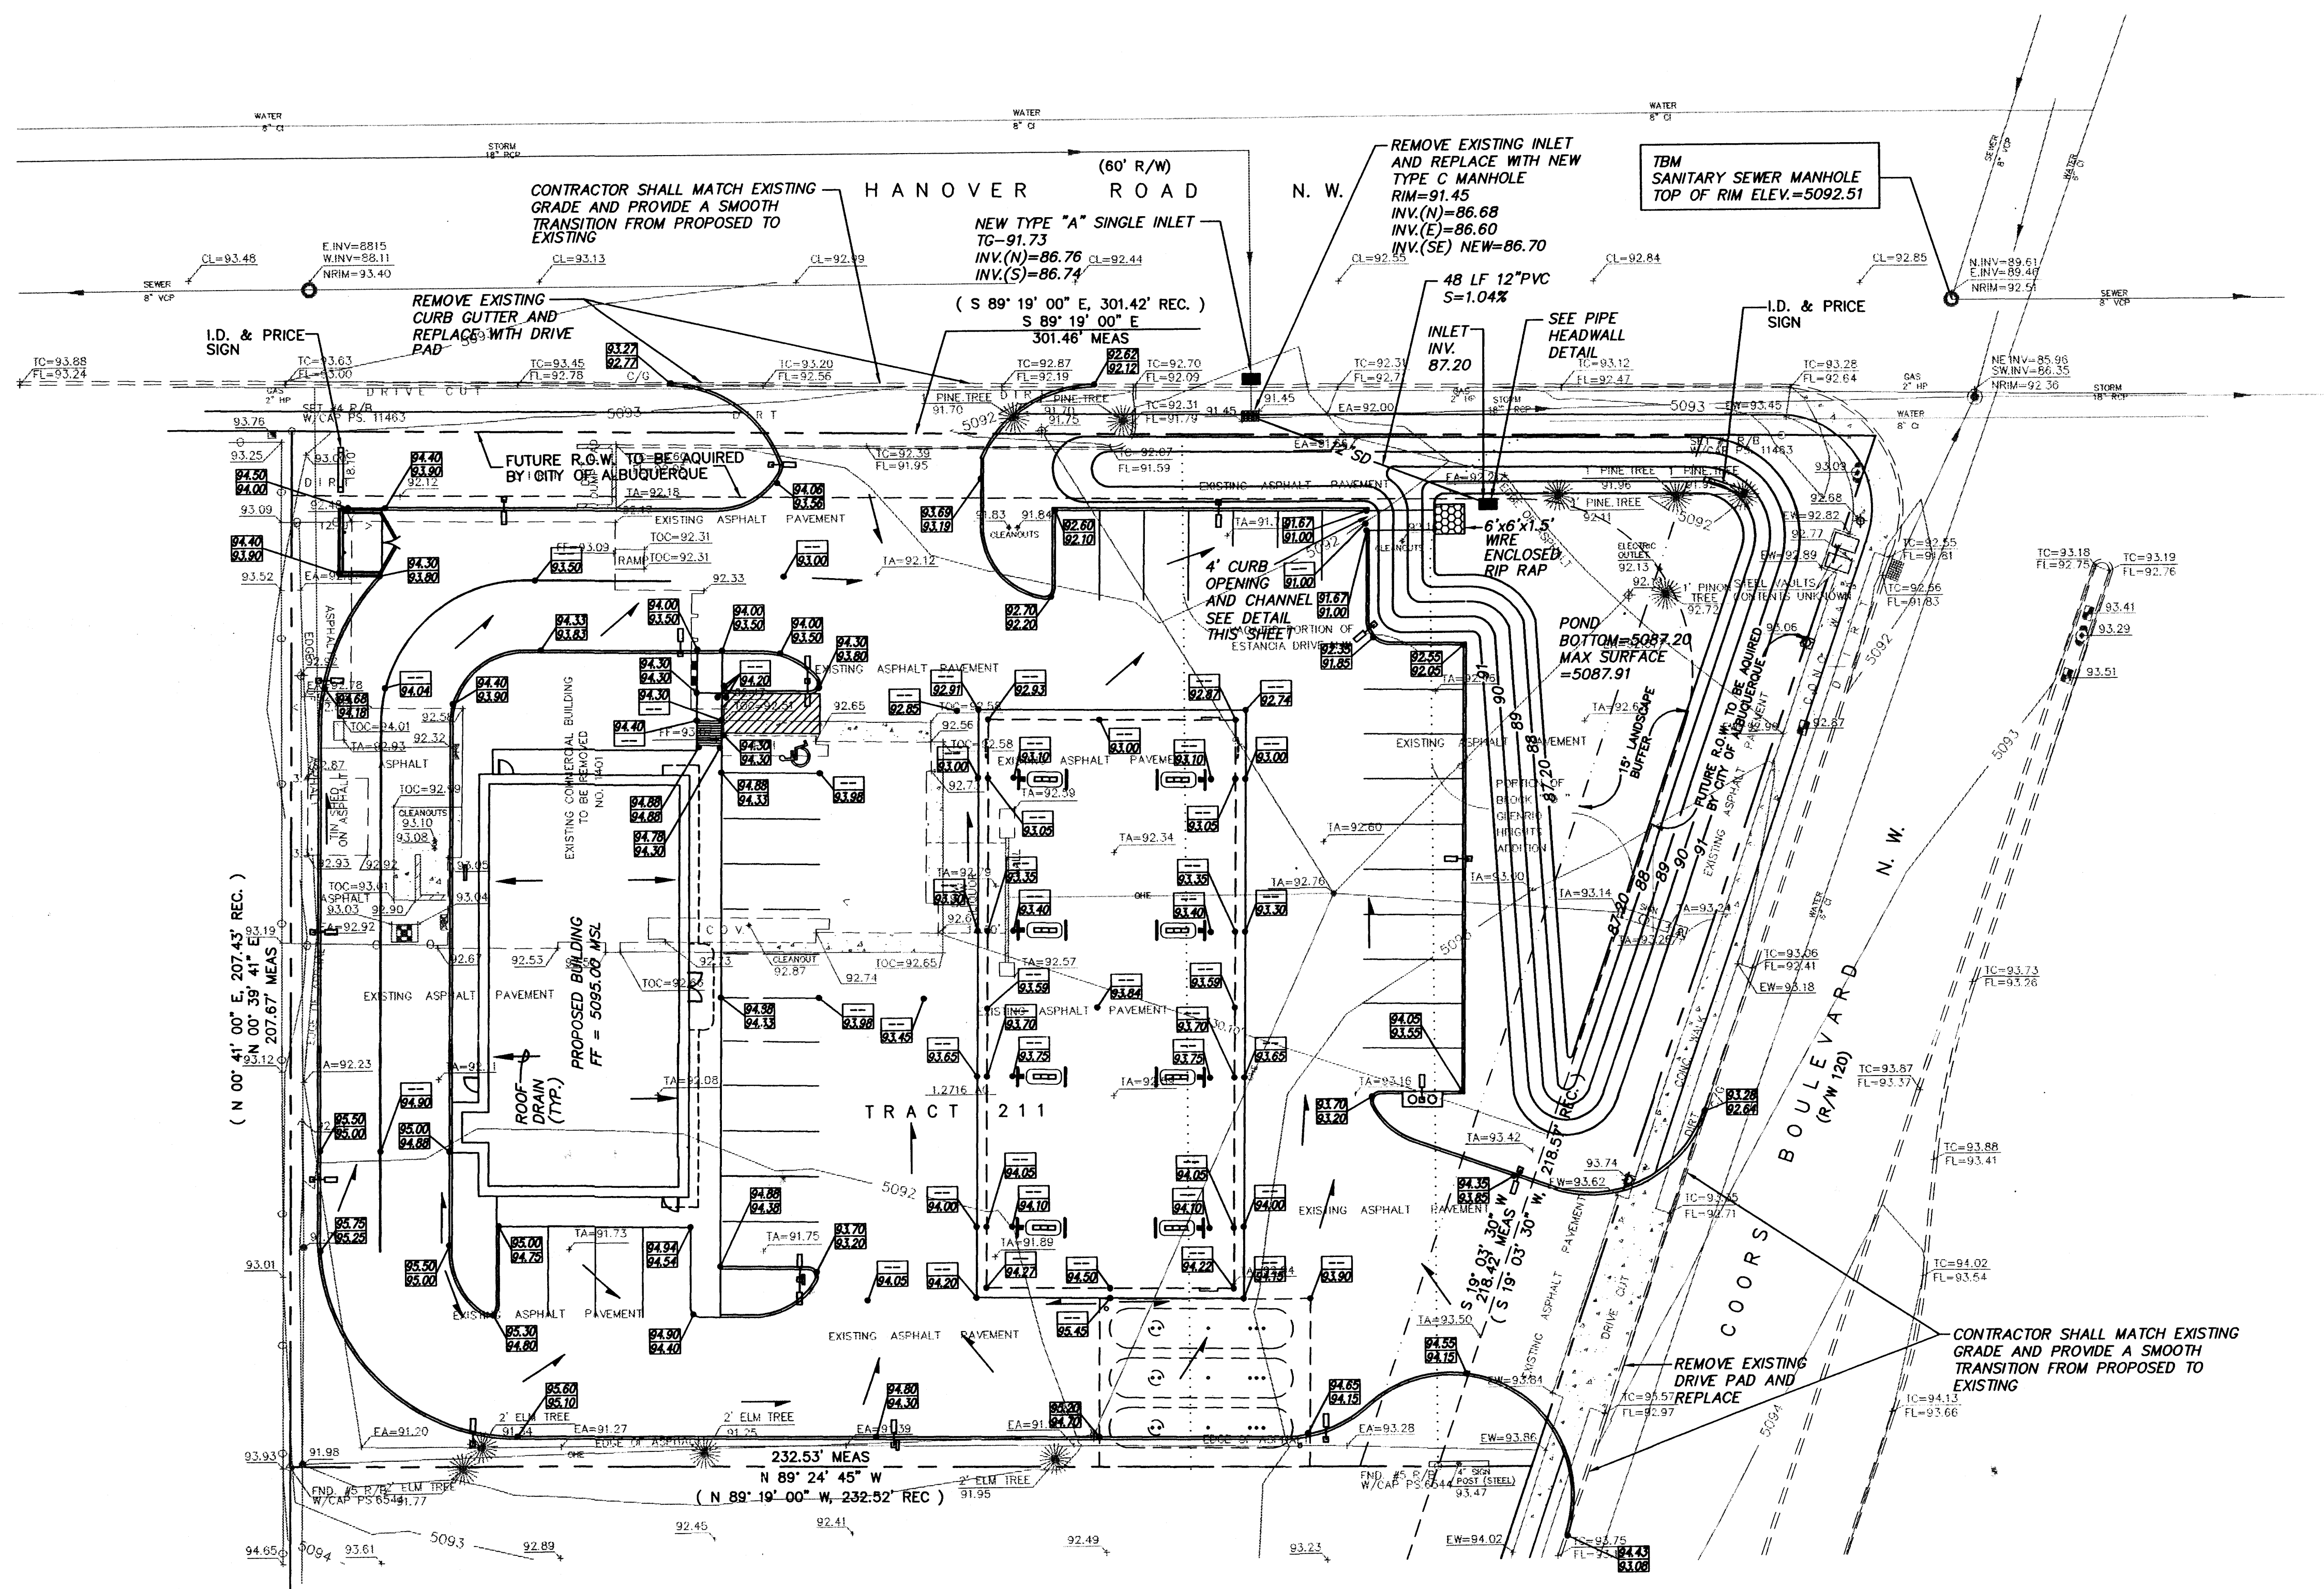

VICINITY MAP ZONE MAP: J-11-Z

TBM (TEMPORARY BENCHMARK)
AT INTERSECTION OF HANOVER ROAD AND COORS BOULEVARD
SANITARY SEWER MANHOLE TOP OF RIM ELEV.=5092.51





ACS BENCHMARK
LOCATED AT THE INTERSECTION OF HANOVER RD., AND 57TH STREET,
N.W. IN THE SOUTHEAST QUADRANT OF THE INTERSECTION. AN
"X" CHISEL ON TOP OF CONCRETE CURB AT THE ESE CURB RETURN.
ELEV.=5092.888

LEGAL DESCRIPTION
TRACT 211 CINELLI ADDITION, TOWN OF ATRISCO GRANT, CITY OF
ALBUQUERQUE, BERNALILLO COUNTY, NEW MEXICO.

NOTES
1. SITE LIES ENTIRELY WITHIN A 100 YEAR FLOOD ZONE.
ELEV.=5094.00 M.S.L.
2. INLET RELOCATION TO BE ACCOMPLISHED BY WORK ORDER.

LEGEND

	NEW TOP OF CURB AND FLOWLINE SPOT ELEVATION
	PROPERTY LINE
	EXISTING CURB
	NEW CURB
	EXISTING CONTOUR
	NEW CONTOUR
	FINISHED FLOOR ELEVATION
	NEW INLET
	NEW FLOW ARROW
	EXISTING SPOT ELEVATION
	EXISTING SANITARY SEWER MANHOLE
	EXISTING STORM DRAIN MANHOLE
	EXISTING INLET
	EXISTING LIGHT POLE
	EXISTING TRAFFIC SIGNAL BOX
	NEW LIGHT

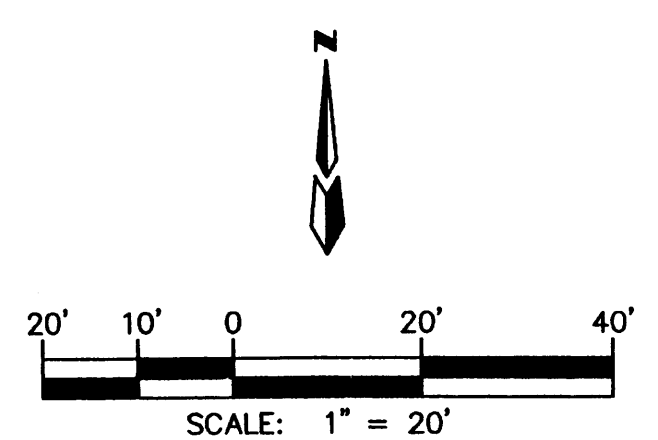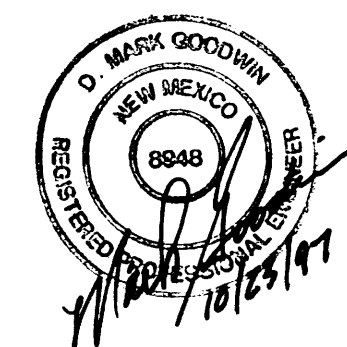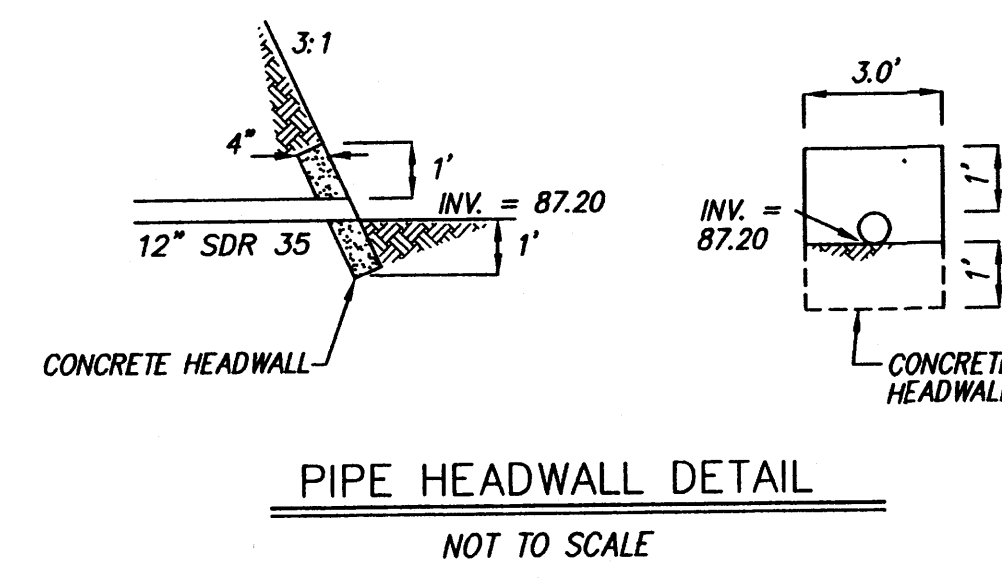
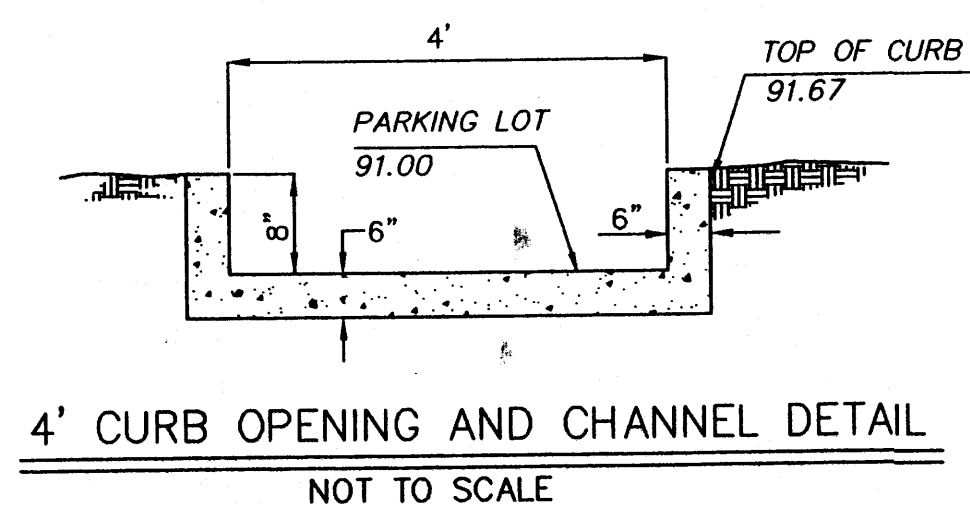


PHILLIPS 66 — HANOVER AND COORS
CONCEPTUAL GRADING AND DRAINAGE PLAN

dmg D. MARK GOODWIN & ASSOCIATES, P.A.
CONSULTING ENGINEERS & SURVEYORS
P.O. BOX 90606
ALBUQUERQUE, NEW MEXICO 87199
(505) 828-2200

Designed: DPS	Drawn: WLW	Checked: DMG	Sheet 1 of 1
Scale: 1" = 20'	Date: 09/97	Job: 97033	

7033PHIL/7033GD20/10-23-97

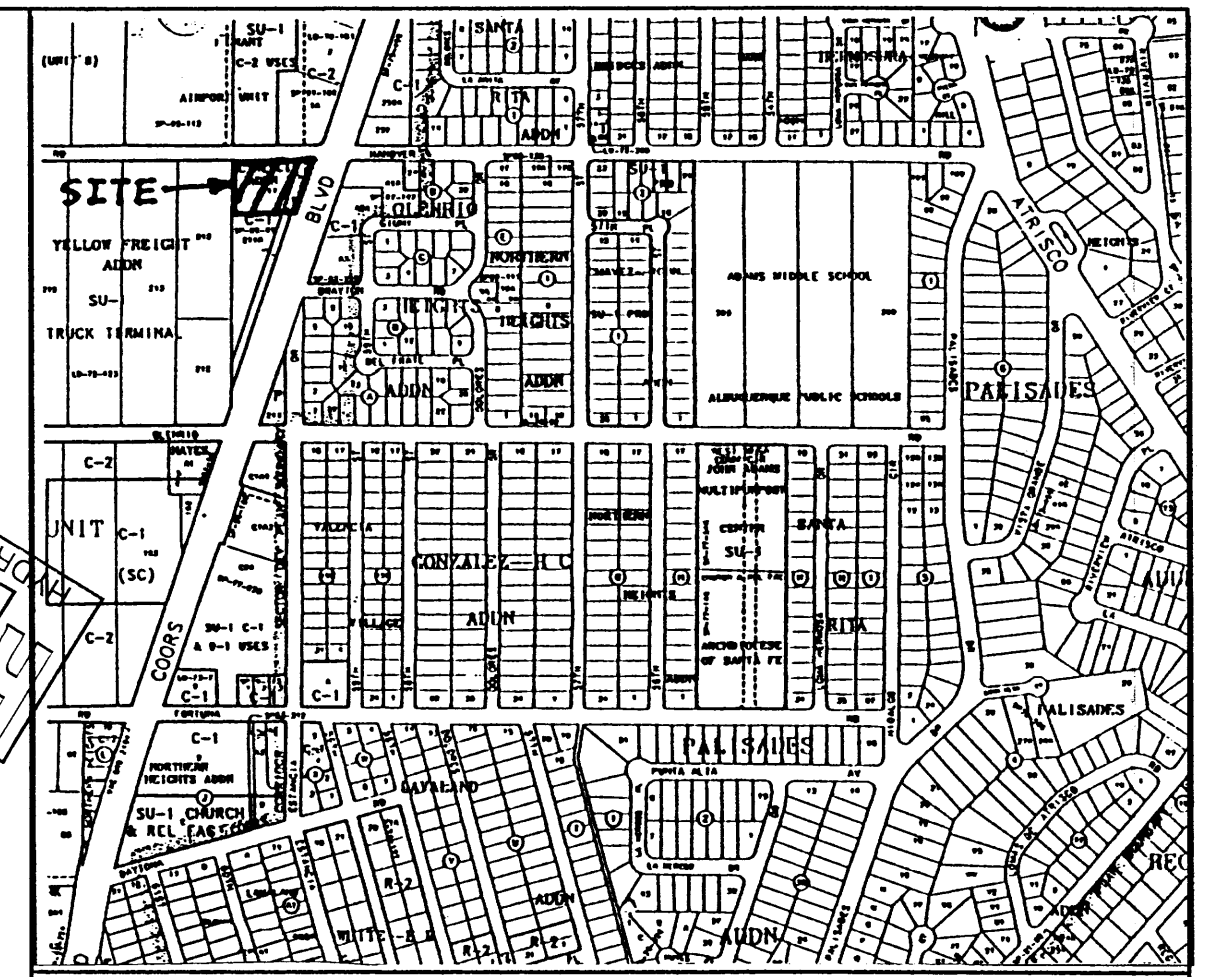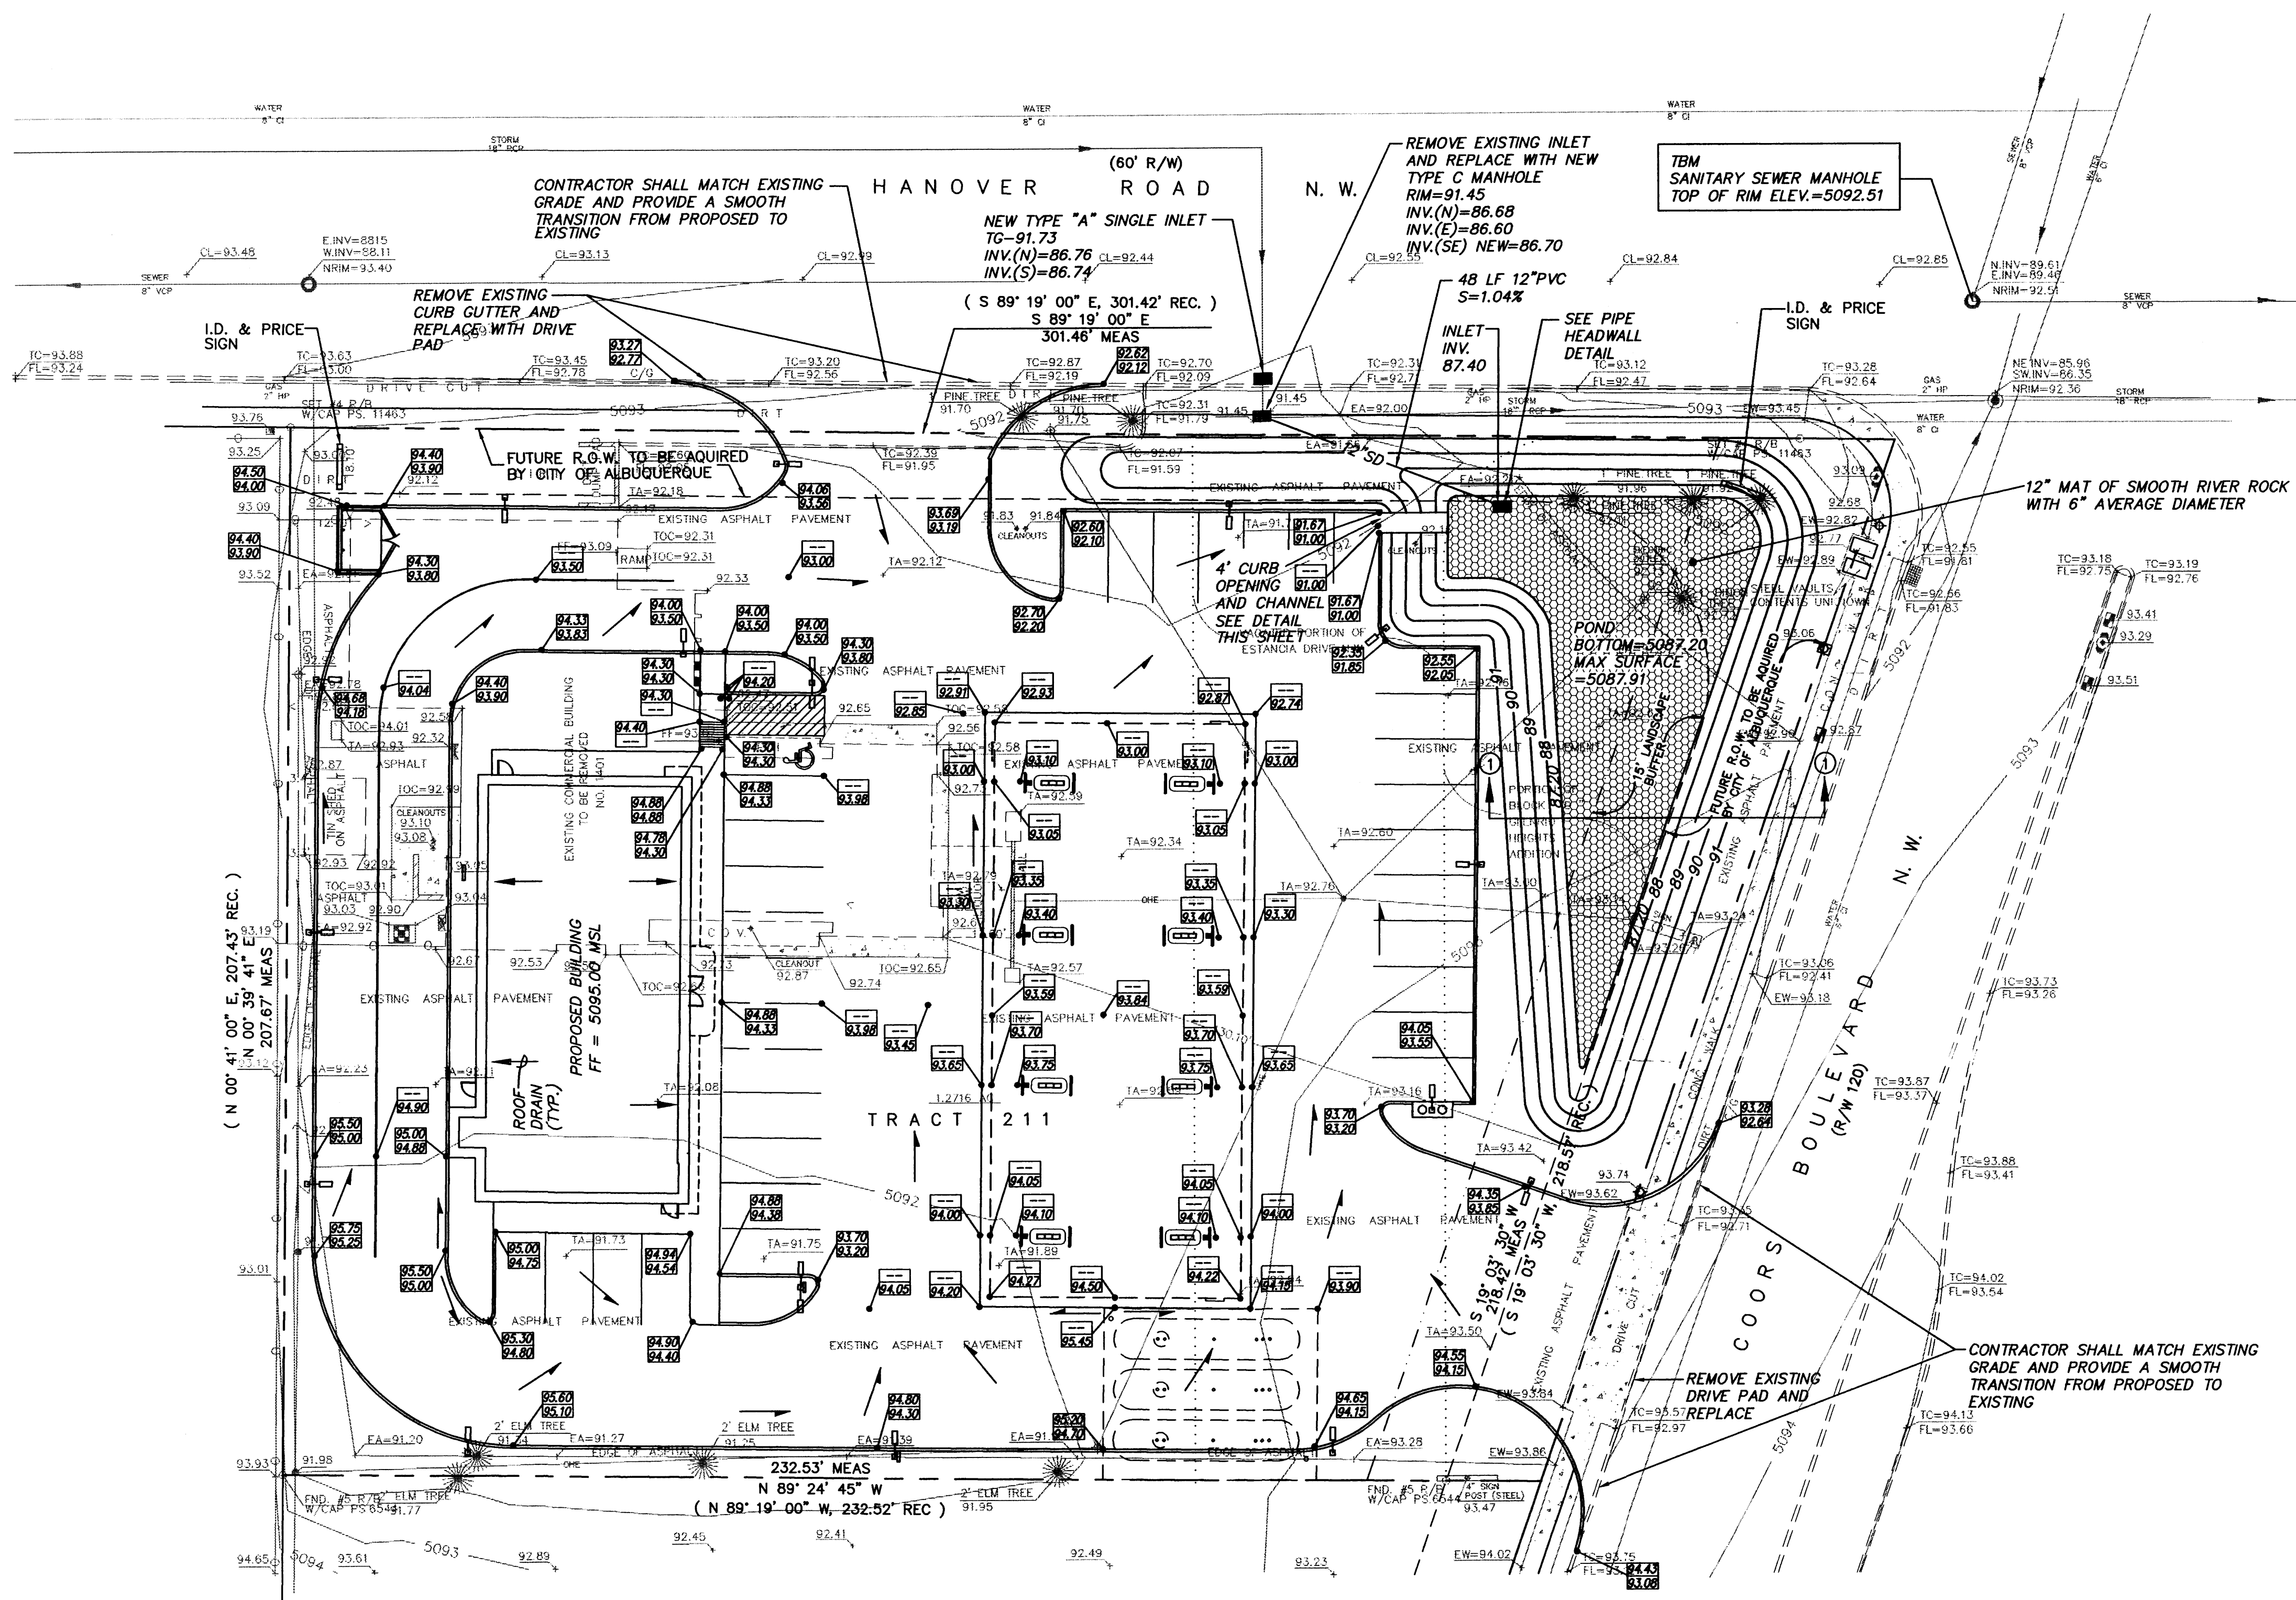

VICINITY MAP ZONE MAP: J-11-Z

TBM (TEMPORARY BENCHMARK)
AT INTERSECTION OF HANOVER ROAD AND COORS BOULEVARD
SANITARY SEWER MANHOLE TOP OF RIM ELEV.=5092.51

ACS BENCHMARK
LOCATED AT THE INTERSECTION OF HANOVER RD. AND 57TH STREET,
N.W. IN THE SOUTHEAST QUADRANT OF THE INTERSECTION. AN
"X" CHISELED ON TOP OF CONCRETE CURB AT THE ESE CURB RETURN.
ELEV.=5092.868

LEGAL DESCRIPTION
TRACT 211 CINELLI ADDITION, TOWN OF ATRISCO GRANT, CITY OF
ALBUQUERQUE, BERNALILLO COUNTY, NEW MEXICO.

NOTES
1. SITE LIES ENTIRELY WITHIN A 100 YEAR FLOOD ZONE.
ELEV.=5094.00 M.S.L.
2. INLET RELOCATION TO BE ACCOMPLISHED BY WORK ORDER.





LEGEND

	NEW TOP OF CURB AND FLOWLINE SPOT ELEVATION
	PROPERTY LINE
	EXISTING CURB
	NEW CURB
	EXISTING CONTOUR
	NEW CONTOUR
	FINISHED FLOOR ELEVATION
	NEW INLET
	NEW FLOW ARROW
	EXISTING SPOT ELEVATION
	EXISTING SANITARY SEWER MANHOLE
	EXISTING STORM DRAIN MANHOLE
	EXISTING INLET
	EXISTING LIGHT POLE
	EXISTING TRAFFIC SIGNAL BOX
	NEW LIGHT



PHILLIPS 66 – HANOVER AND COORS
GRADING AND DRAINAGE PLAN

MARK GOODWIN & ASSOCIATES, P.A.
CONSULTING ENGINEERS & SURVEYORS
P.O. BOX 90606
ALBUQUERQUE, NEW MEXICO 87199
(505) 828-2200

Designed: DPS Drawn: WLW Checked: DMG Sheet 1 of 1
Scale: 1" = 20' Date: 09/97 Job: 97033

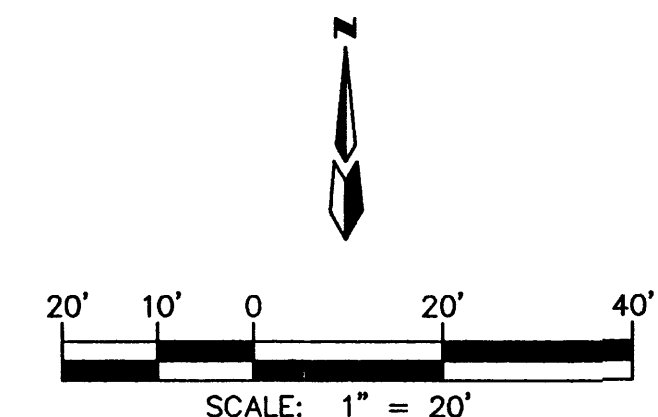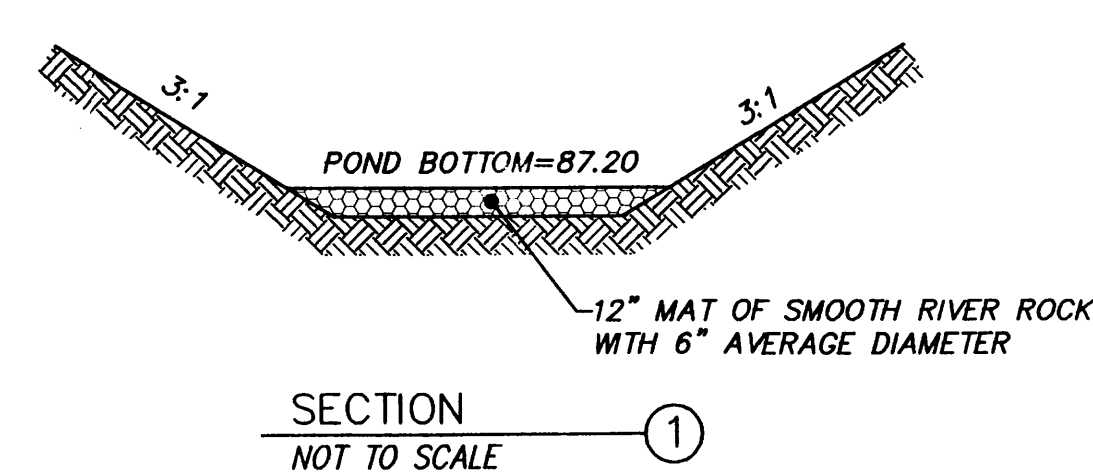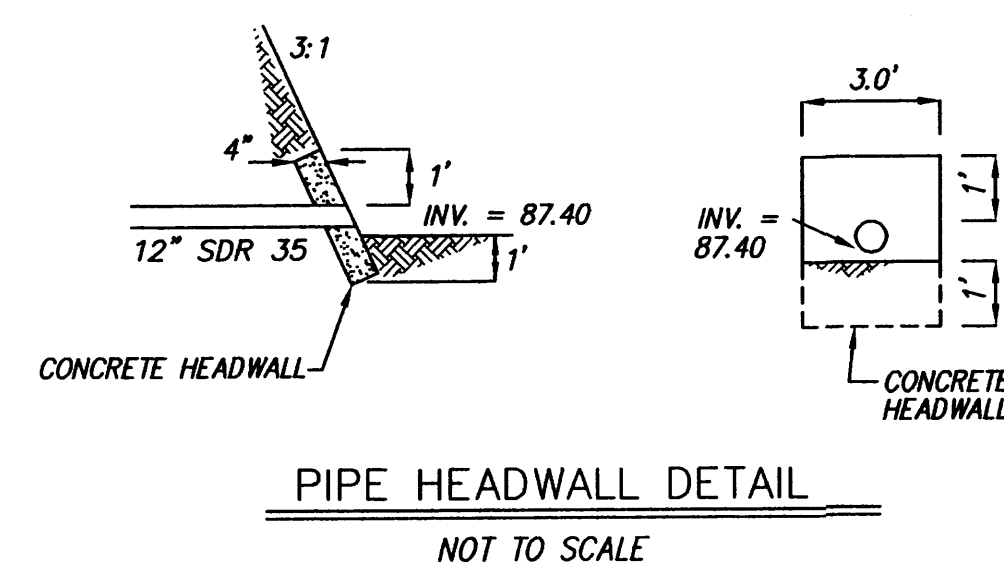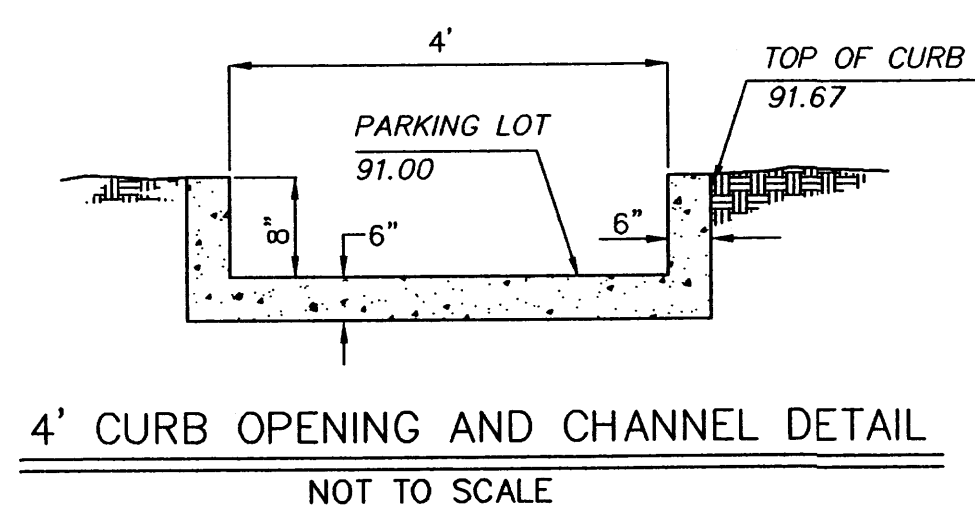

7033PHIL/7033GD20/03-30-98/WLV

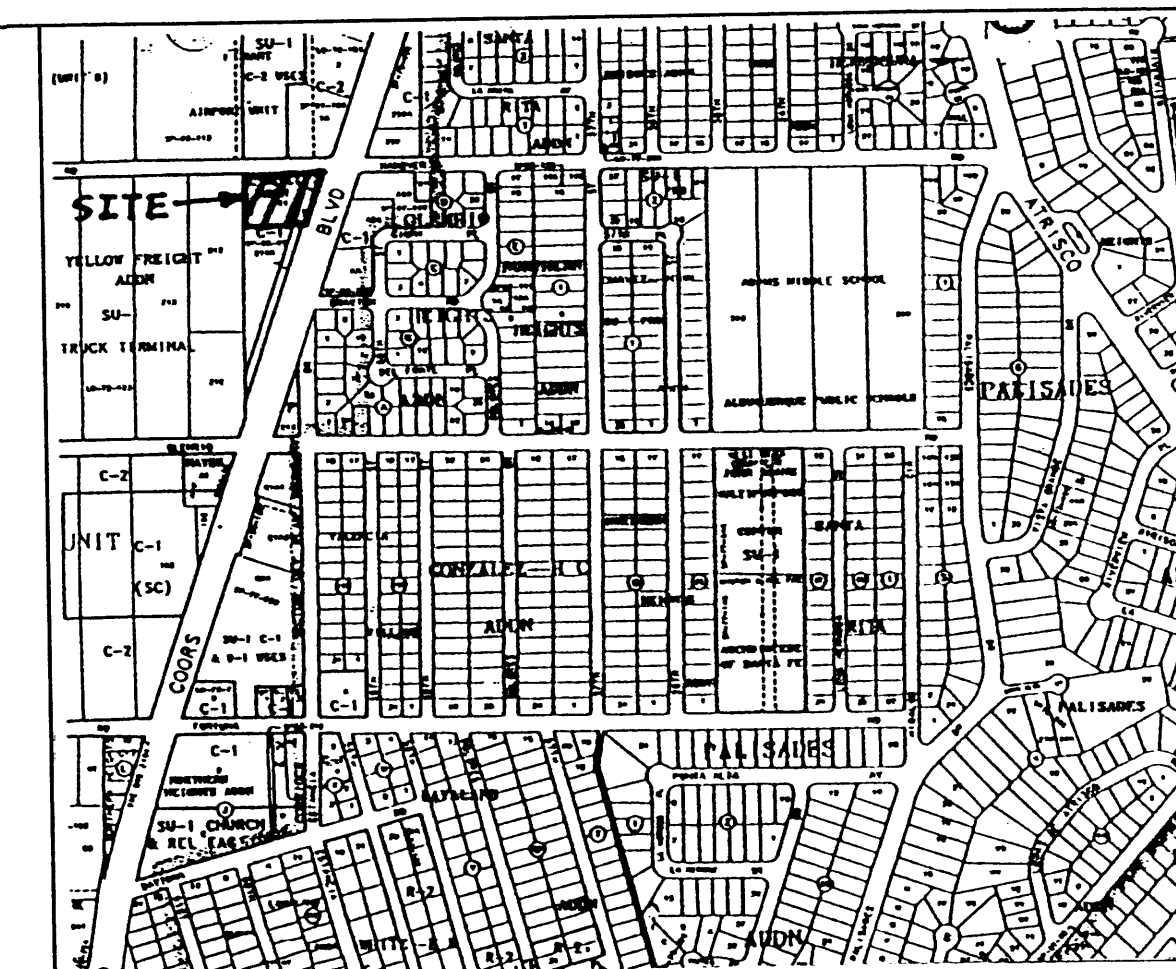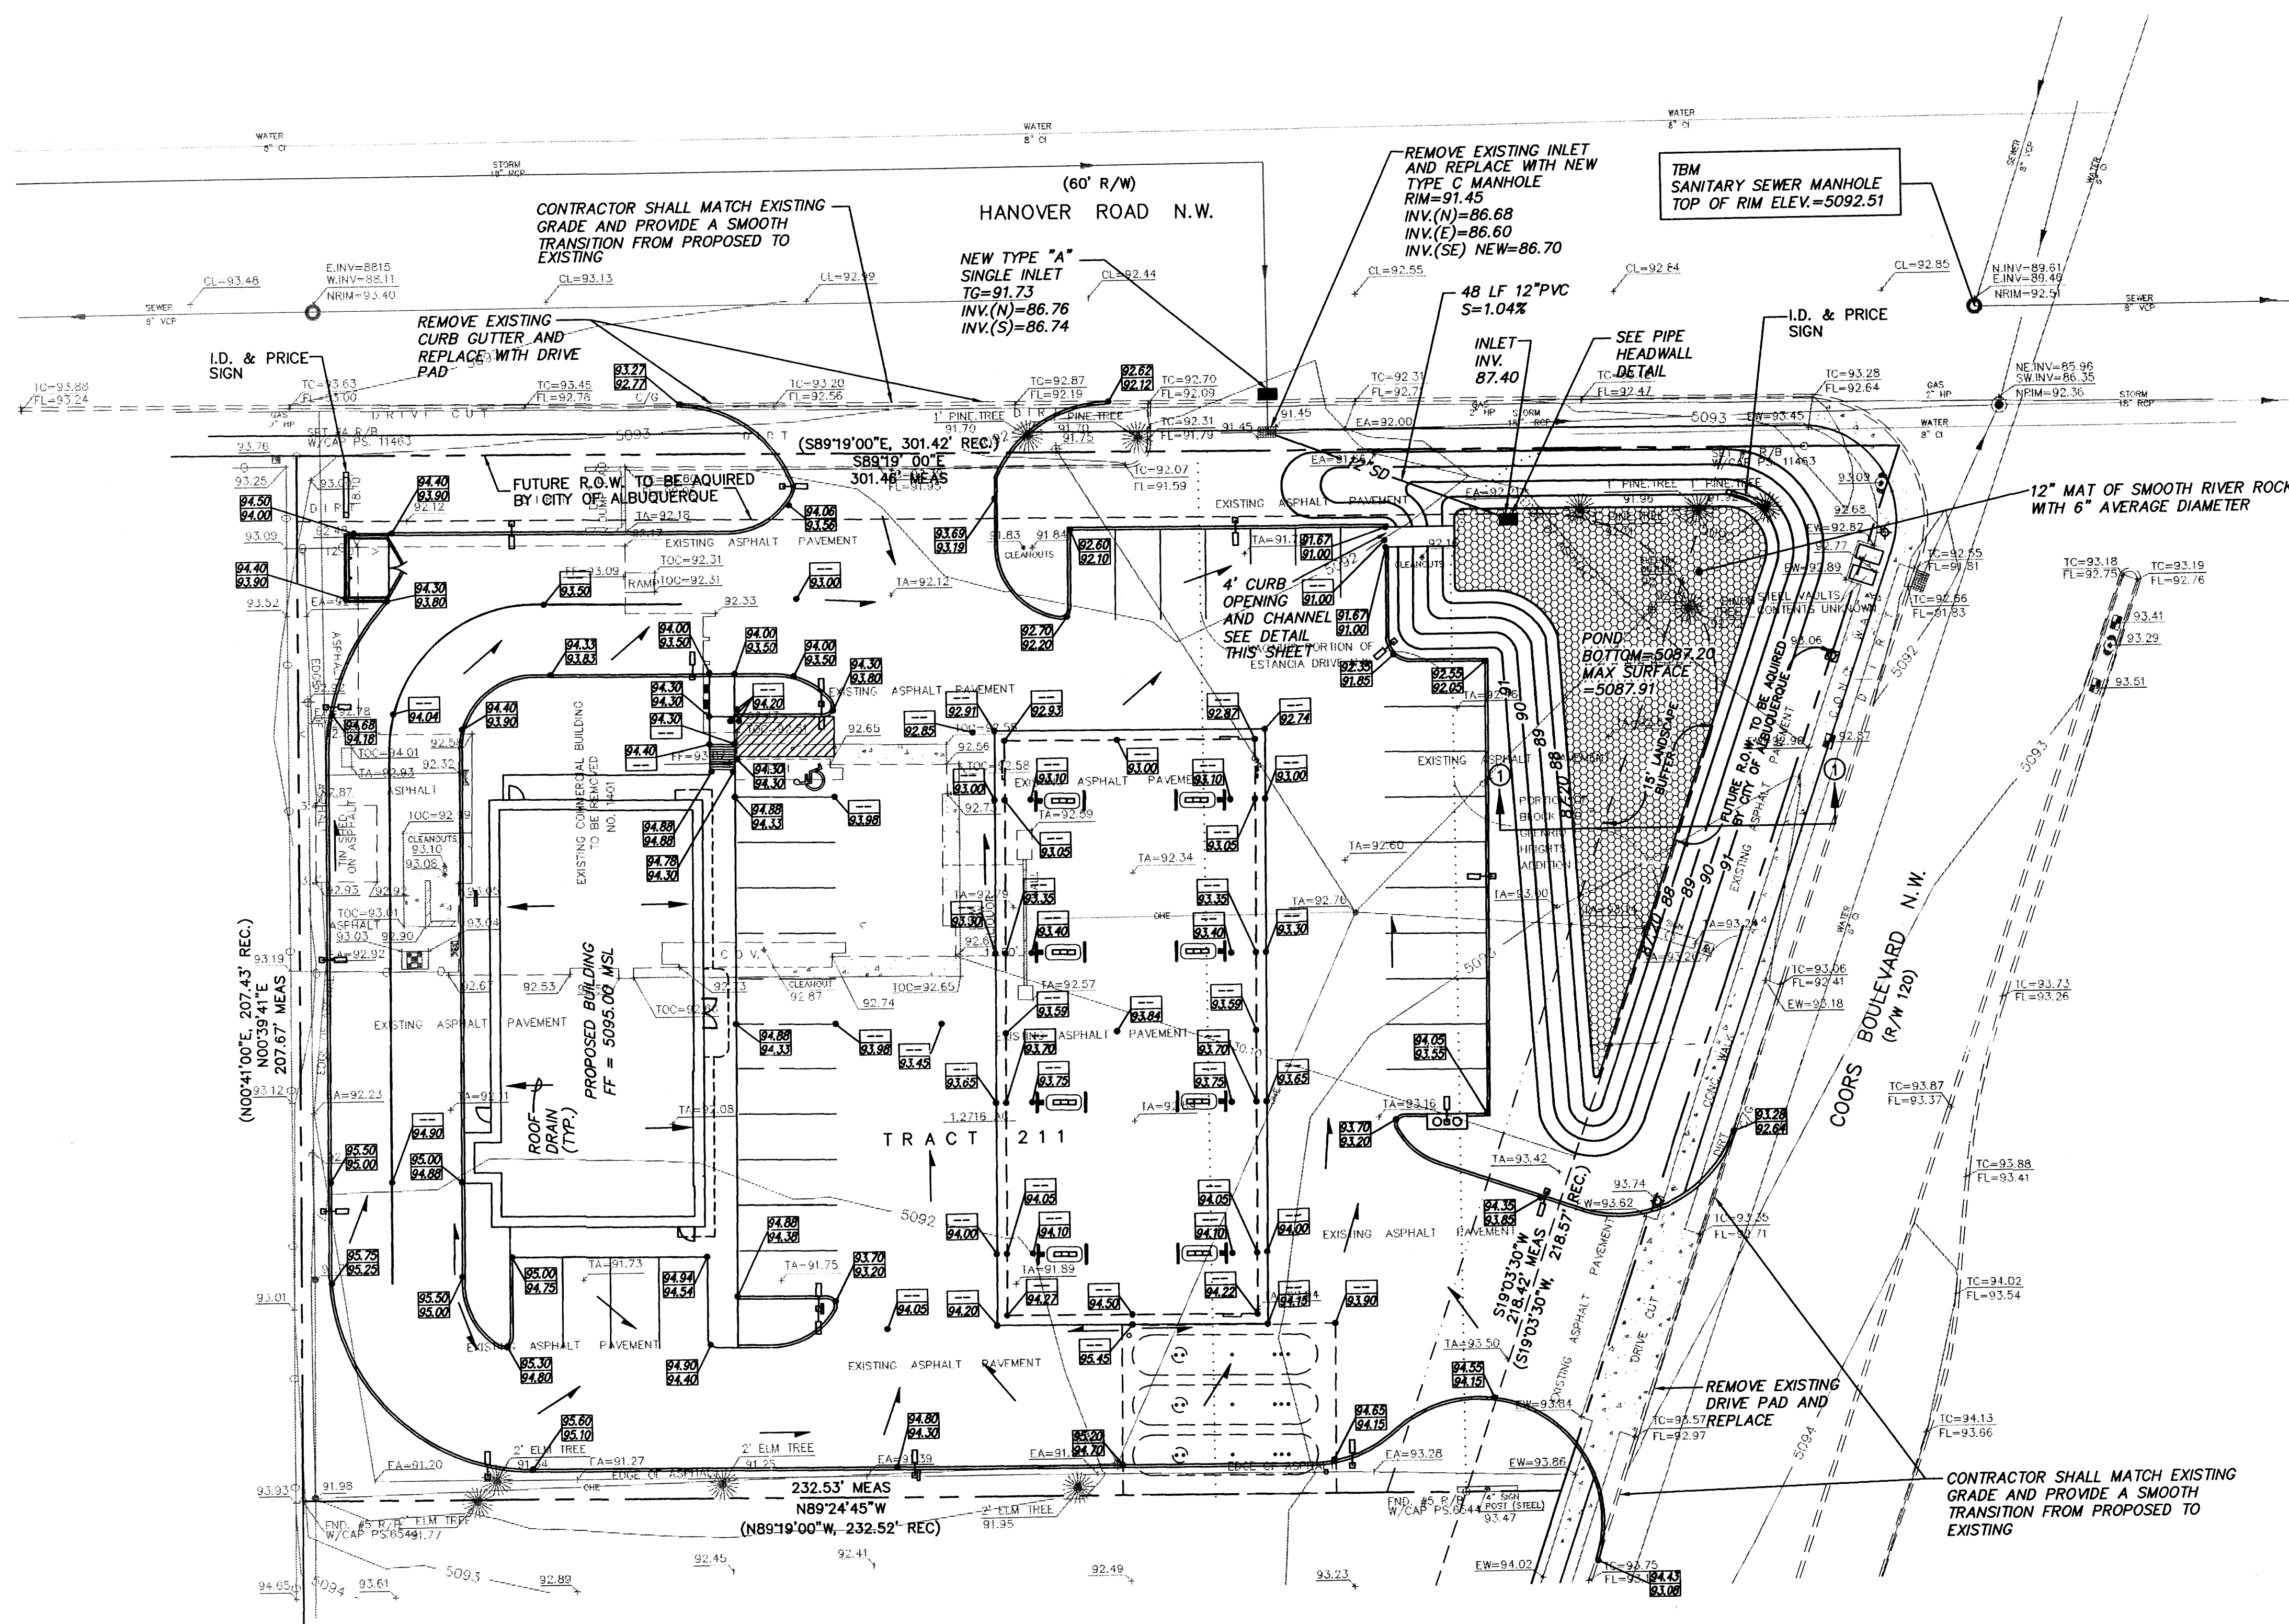

VICINITY MAP ZONE MAP: J-11-Z

TBM (TEMPORARY BENCHMARK)
AT INTERSECTION OF HANOVER ROAD AND COORS BOULEVARD
SANITARY SEWER MANHOLE TOP OF RIM ELEV.=5092.51

ACS BENCHMARK
LOCATED AT THE INTERSECTION OF HANOVER RD., AND 57TH STREET, N.W. IN THE SOUTHEAST QUADRANT OF THE INTERSECTION. AN AT CHASLED ON TOP OF CONCRETE CURB AT THE ESE CURB RETURN. ELEV.=5092.868


RECEIVED
MAY 01 1998
HYDROLOGY SECTION

LEGAL DESCRIPTION
TRACT 211 CINELLI ADDITION, TOWN OF ATRISCO GRANT, CITY OF ALBUQUERQUE, BERNALILLO COUNTY, NEW MEXICO.





NOTES
1. SITE LIES ENTIRELY WITHIN A 100 YEAR FLOOD ZONE. ELEV.=5094.00 M.S.L.
2. INLET RELOCATION TO BE ACCOMPLISHED BY WORK ORDER.

LEGEND

	NEW TOP OF CURB AND FLOWLINE SPOT ELEVATION
	PROPERTY LINE
	EXISTING CURB
	NEW CURB
	EXISTING CONTOUR
	NEW CONTOUR
	FINISHED FLOOR ELEVATION
	NEW INLET
	NEW FLOW ARROW
	EXISTING SPOT ELEVATION
	EXISTING SANITARY SEWER MANHOLE
	EXISTING STORM DRAIN MANHOLE
	EXISTING INLET
	EXISTING LIGHT POLE
	EXISTING TRAFFIC SIGNAL BOX
	NEW LIGHT

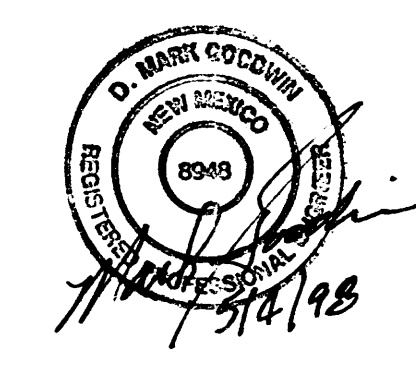

APPROVED STORM DRAIN MAINTENANCE

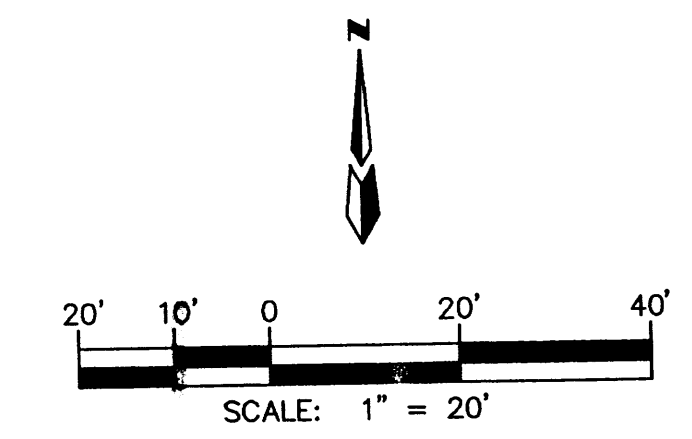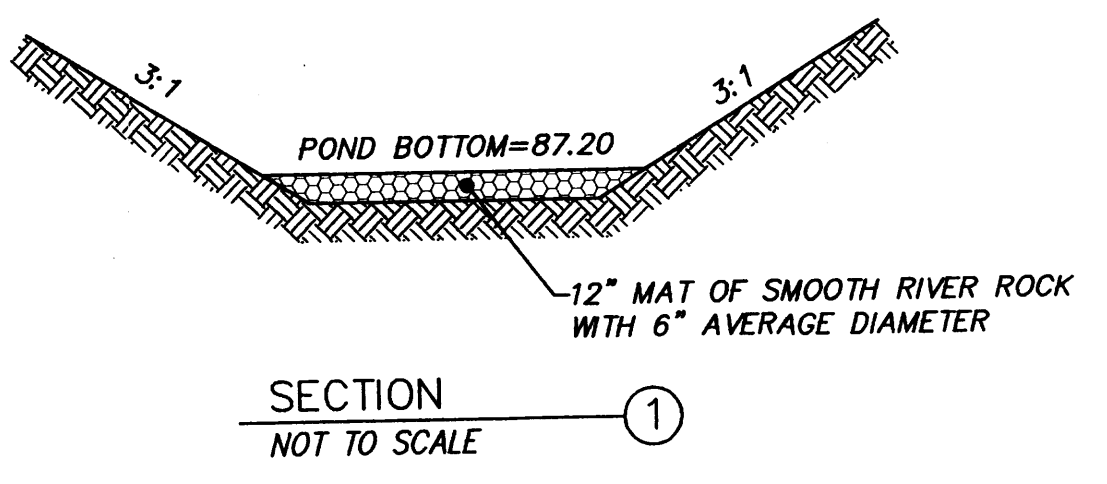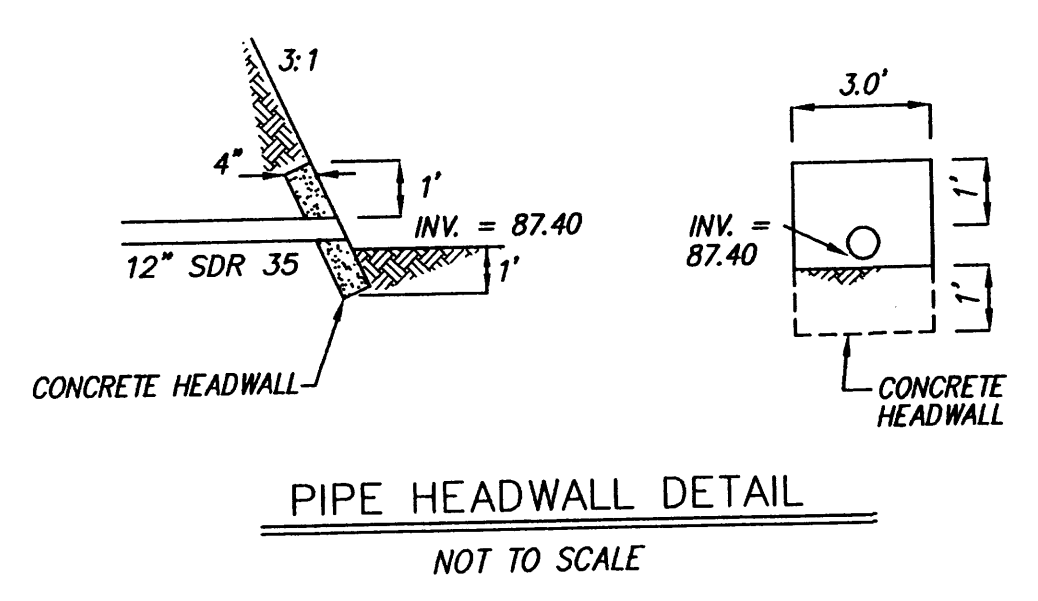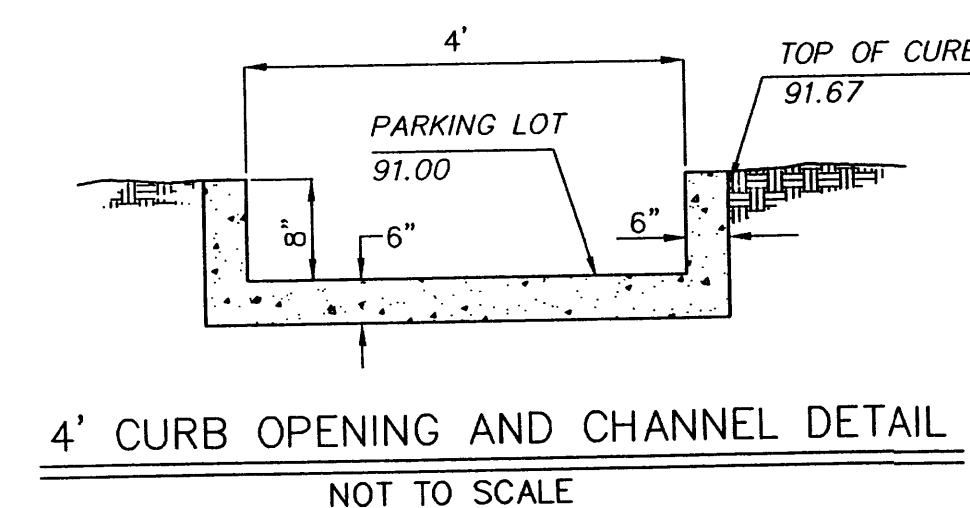

PHILLIPS 66 - HANOVER AND COORS
GRADING AND DRAINAGE PLAN

MARK GOODWIN & ASSOCIATES, P.A.
CONSULTING ENGINEERS
P.O. BOX 90606
ALBUQUERQUE, NEW MEXICO 87199
(505) 828-2200

Designed: DPS Drawn: WLW Checked: DMG
Scale: 1" = 20' Date: 09/97 Job: 97033 Sheet 1 of 1