


CITY OF ALBUQUERQUE

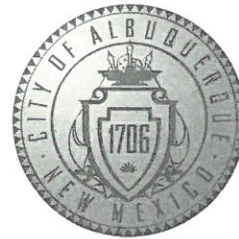

July 28, 2016

J. Graeme Means, PE
High Mesa Consulting Group
6010 -B Midway Park Blvd NE
Albuquerque, NM 87109

**Re: Reginald Chavez Elementary School
2700 Mountain Rd NW
Request Permanent C.O. - Accepted
Engineer's Stamp dated: 11/5/2014 (J12D009)
Certification dated: 7-26-16**

Dear Mr. Graeme,

PO Box 1293

Based on the Certification received 7/26/2016, the site is acceptable for release of Certificate of Occupancy by Hydrology.

Albuquerque

If you have any questions, you can contact me at 924-3695 or Totten Elliott at 924-3982.

New Mexico 87103 Sincerely,

www.cabq.gov

Rita Harmon, P.E.
Senior Engineer, Planning Dept.
Development Review Services

TE/RH

C: email,

Cordova, Camille C.; Miranda, Rachel; Sandoval, Darlene M.;
Lois Blocker

DRAINAGE PLAN

I. INTRODUCTION AND EXECUTIVE SUMMARY

THIS PROJECT, LOCATED WITHIN THE OLD TOWN AREA OF THE CITY OF ALBUQUERQUE, REPRESENTS A MODIFICATION TO AN EXISTING APS SCHOOL SITE WITHIN AN INFILL AREA. THE PROPOSED IMPROVEMENTS CONSIST OF A NEW CLASSROOM BUILDING WITH ASSOCIATED SITE WORK. UPON COMPLETION OF THE NEW BUILDING, TWO EXISTING BUILDINGS WILL BE DEMOLISHED AND REPLACED WITH COURTYARD IMPROVEMENTS. THIS SUBMITTAL IS PART OF A PHASED DEVELOPMENT DISCUSSED IN MORE DETAIL BELOW. THE DRAINAGE CONCEPT FOR THIS PROJECT IS CONSISTENT WITH THE APPROVED MASTER DRAINAGE PLAN (N12/0009) DATED 09-28-2007. BASIN A WILL CONTINUE TO FREE DISCHARGE TO THE ADJACENT CITY STREETS. BASIN B WILL DRAIN TO AN EXISTING ONSITE PRIVATE RETENTION POND SIZED FOR THE V-10 DAY RUNOFF VOLUME. THIS SUBMITTAL IS MADE IN SUPPORT OF BUILDING PERMIT APPROVAL WITHIN THE JURISDICTION OF THE CITY OF ALBUQUERQUE.

II. PROJECT DESCRIPTION

AS SHOWN BY THE VICINITY MAP, THE SCHOOL SITE IS LOCATED AT THE SOUTHWEST CORNER OF THE INTERSECTION OF MOUNTAIN AND MONTOTOA ROADS NW. THE SITE IS DEVELOPED AS AN APS ELEMENTARY SCHOOL. THE SURROUNDING AREA IS ALSO DEVELOPED AS A RESIDENTIAL AREA. THIS SUBMITTAL IS A MODIFICATION TO AN EXISTING SITE WITHIN AN INFILL AREA. THE CURRENT LEGAL DESCRIPTION IS UNPLATTED LANDS OF THE ALBUQUERQUE PUBLIC SCHOOLS, KNOWN AS REGINALD CHAVEZ ELEMENTARY SCHOOL, AS SHOWN BY PANEL 331 OF 825 OF THE NATIONAL FLOOD INSURANCE PROGRAM FLOOD INSURANCE RATE MAPS PUBLISHED BY FEMA FOR BERNALILLO COUNTY, NEW MEXICO, REVISED AUGUST 16, 2012. THIS SITE DOES NOT LIE WITHIN A DESIGNATED FLOOD HAZARD ZONE. FURTHER REVIEW OF THESE MAPS INDICATES THAT THIS SITE DOES NOT CONTRIBUTE RUNOFF TO A DOWNSTREAM DESIGNATED FLOOD HAZARD ZONE. THE PANEL ALSO IDENTIFIES THAT THE 1% ANNUAL CHANCE OR GREATER FLOOD HAZARD BY A LEVEE SYSTEM OVERTOPPING OR FAILURE OF ANY LEVEE SYSTEM IS POSSIBLE.

III. BACKGROUND DOCUMENTS

THE PREPARATION OF THIS PLAN RELIED UPON THE FOLLOWING DOCUMENTS AND ACTIVITIES:

- PREDESIGN CONFERENCE RECAP DATED 03-04-2014 CONDUCTED WITH HIGH MESA CONSULTING GROUP. THE RECAP ALLOWED FOR THE CONTINUATION OF FREE DISCHARGE OF DEVELOPED RUNOFF FROM BASIN 'A' TO THE PUBLIC RIGHT-OF-WAY AND MODIFICATIONS TO THE BASIN 'B' POND SHALL MAINTAIN EXISTING VOLUME (V-10 DAY) PLUS ANY INCREASE IN RUNOFF ASSOCIATED WITH THE PROPOSED BUILDING PERMIT IMPROVEMENTS.
- TOPOGRAPHIC SURVEY PREPARED BY HIGH MESA CONSULTING GROUP (NMPS 11184) DATED 11-07-2013. THIS REFERENCED SURVEY PROVIDES THE BASIS FOR THE EXISTING CONDITIONS OF THE PROJECT SITE.
- MASTER DRAINAGE PLAN (MDP) FOR REGINALD CHAVEZ ELEMENTARY SCHOOL PREPARED BY HIGH MESA CONSULTING GROUP (NMPE 8547) DATED 09-28-2007. THE MDP ESTABLISHED THE CONCEPT OF FREE DISCHARGE FROM BASIN 'A' TO THE ADJACENT CITY STREETS COMBINED WITH THE ONSITE RETENTION OF RUNOFF FOR BASIN 'B'. THE 2007 MDP ALSO ESTABLISHED THE EXISTING BASIN B RETENTION POND VOLUME IN THE EXISTING CONDITION.
- CONSTRUCTION PLANS FOR REGINALD CHAVEZ ELEMENTARY SCHOOL PLAYGROUND AND DRAINAGE MODIFICATIONS PREPARED BY HIGH MESA CONSULTING GROUP (NMPE 8547) DATED 09-10-2008 AND CERTIFIED 04-24-2009 OF THE FOUR (4) TASKS IDENTIFIED BY THESE REFERENCE CONSTRUCTION PLANS. TASKS 1 AND 2 ARE COMPLETED. TASK 3 LIES WITHIN THE FOOTPRINT OF THE NEW BUILDING ADDITION PROPOSED BY THIS SUBMITTAL AND AS SUCH IS NO LONGER APPLICABLE. THE COMPLETION OF TASKS 1 AND 2 WITH THE ASSOCIATED ENGINEER'S DRAINAGE CERTIFICATION INDICATES THAT THERE ARE NO OUTSTANDING DRAINAGE REQUIREMENTS FOR THIS SITE.
- CONSTRUCTION PLANS FOR REGINALD CHAVEZ PORTABLE CLASSROOM RELOCATIONS PREPARED BY HIGH MESA CONSULTING GROUP (NMPE 8547) DATED 08-04-2014. THE REFERENCED PLANS DEFINE THE FIRST PHASE OF THIS PHASED PROJECT. IN THE FIRST PHASE, THE EXISTING PORTABLE CLASSROOM BUILDINGS WILL BE REMOVED AND RELOCATED IN ADVANCE OF THE PERMANENT BUILDING PROJECT. THE DEMOLITION OF THE EXISTING IMPROVEMENTS WITHIN THE FOOTPRINT OF THE NEW BUILDING WILL BE UNDERTAKEN IN PHASE 1. PHASE 1 WILL ALSO TEMPORARILY RELOCATE THE APS PORTABLE CLASSROOM BUILDINGS. THE YDI PORTABLE BUILDING WILL BE RELOCATED BY SEPARATE PERMIT BY OTHERS (NOT APS) CONCURRENT WITH THE FIRST PHASE OF WORK. THIS PLAN IS APPROVED FOR GRADING, PAVING AND BUILDING PERMIT. A SUPPORTING EROSION AND SEDIMENT CONTROL PLAN (ESCP) IS CURRENTLY UNDER REVIEW.

IV. EXISTING CONDITIONS

THIS SITE IS DEVELOPED AS AN ELEMENTARY SCHOOL OWNED, OPERATED, AND MAINTAINED BY APS. THE SCHOOL SITE CONSISTS OF PERMANENT AND PORTABLE CLASSROOM BUILDINGS, PAVED PARKING AREAS AND WALKWAYS, LANDSCAPING, TURF GRASS FIELD AND OTHER SITE IMPROVEMENTS APPLICABLE TO AN ELEMENTARY SCHOOL SITE. THE SITE IS CHARACTERIZED BY TWO DRAINAGE BASINS, BASINS A AND B. BASIN A DRAINS NORTH TO MOUNTAIN ROAD NW AND EAST TO MONTOTOA ROAD NW WHILE BASIN B DRAINS SOUTH AND WEST TO AN ONSITE PRIVATE RETENTION POND AT THE SOUTHWEST CORNER OF THE SITE.

- BASIN A GENERALLY CONSISTS OF THE NORTH PORTION OF THE MAIN OFFICE AND CLASSROOM BUILDINGS (NO. 100 & 200), NORTHWEST AND NORTHEAST PAVED PARKING LOTS, PAVED BUS DROP-OFF LANE, AND MINOR AREAS OF BARE SOIL. THE RUNOFF GENERATED BY THIS BASIN FREELY DISCHARGES NORTH TO MOUNTAIN ROAD NW AND EAST TO MONTOTOA ROAD NW, BOTH FULLY DEVELOPED PUBLIC STREETS WITH CURB AND GUTTER AND PERMANENT PAVING. MOUNTAIN ROAD NW DRAINS TO THE EAST AND WEST DUE TO AN EXISTING HIGH-PROFILE MOUNTAIN ROAD NW PUBLIC STORM DRAIN SYSTEM WITH STREET RUNOFF COLLECTED VIA CURB INLETS. MONTOTOA ROAD NW DRAINS TO THE NORTH, WHERE RUNOFF IS ALSO COLLECTED VIA CURB INLETS INTO THE PUBLIC STORM DRAIN SYSTEM.
- BASIN B IS COMPRISED OF THE CENTRAL AND SOUTH HALF OF THE SITE CONSISTING OF THE SOUTH PORTION OF THE MAIN OFFICE AND CLASSROOM BUILDINGS (NO. 200, 300, & 400), PAVED PARKING AREAS, LANDSCAPING, TURF GRASS FIELD AT THE SOUTHWEST CORNER OF THE SITE. THIS PORTION OF THE SITE GENERALLY DRAINS TO THE SOUTH AND WEST WHERE RUNOFF IS CAPTURED WITHIN AN EXISTING ONSITE PRIVATE RETENTION POND AT THE SOUTHWEST CORNER OF THE SITE. THE EXISTING POND RETAINS IN EXCESS OF THE V-10 DAY RUNOFF VOLUME.

AS ESTABLISHED BY THE 2007 MDP, THERE ARE NEGLIGIBLE OFFSITE FLOWS DISCHARGING ONTO THE SITE FROM THE ADJACENT RESIDENTIAL LOTS TO THE SOUTH AND EAST OF THE SCHOOL SITE.

V. DEVELOPED CONDITIONS

THE PROPOSED CONSTRUCTION CONSISTS OF A NEW CLASSROOM BUILDING WITH ASSOCIATED SITE WORK IN BOTH DRAINAGE BASINS A AND B. UPON COMPLETION OF THE NEW CLASSROOM BUILDING, TWO SMALLER EXISTING CLASSROOM BUILDINGS, 300 & 400, WILL BE REMOVED (DEMOLISHED). IN ADDITION TO SITE WORK ASSOCIATED WITH THE NEW BUILDING, SITE WORK WILL ALSO INCLUDE REGRADING AND LANDSCAPING THE EXISTING POND IN BASIN B. THE MAJORITY OF THE PROPOSED CONSTRUCTION WILL OCCUR IN BASIN B.

THE PROPOSED WORK WITHIN BASIN A WILL BE LIMITED. THE NORTH END OF THE NEW BUILDING, THE LIBRARY, WILL GENERATE ROOF RUNOFF THAT WILL DISCHARGE INTO THE NORTHWEST PARKING LOT WHERE IT WILL BE ROUTED THROUGH AN EXISTING WATER HARVESTING POND PRIOR TO DISCHARGE NORTH INTO MOUNTAIN ROAD NW. THIS PORTION OF THE PROJECT IS NOT ANTICIPATED TO GENERATE A SIGNIFICANT INCREASE IN THE PEAK DISCHARGE OF RUNOFF TO MOUNTAIN ROAD NW. IN ADDITION, THE RUNOFF WILL ROUTE THROUGH AN EXISTING WATER HARVESTING POND.

THE MAJORITY OF THE PROPOSED CONSTRUCTION WILL OCCUR WITHIN BASIN B CONSISTING OF THE CLASSROOM PORTION OF THE NEW BUILDING, FIRE TRUCK ACCESS, COURTYARD AND PLAYGROUND IMPROVEMENTS, RELOCATED BASKETBALL COURTS, AND MODIFICATIONS TO THE EXISTING POND. THE SOUTH END OF THE NEW CLASSROOM WING ENCLOSES INTO THE V-10 DAY POND LIMITS. IN RESPONSE, A PORTION OF THE EXISTING POND WILL BE REGRADED BY FILL RUNOFF FROM THE EXISTING ONSITE PRIVATE STORM DRAIN WILL BE PIPED AROUND THE SOUTH END OF THE NEW BUILDING TO THE WEST END OF THE EXISTING POND. THE WEST END OF THE EXISTING POND WILL BE DEEPENED TO COMPENSATE FOR THE DISPLACED VOLUMES AND TO ENSURE THE V-10 DAY RUNOFF REMAINS CONTAINED ON THE SITE. ROOF RUNOFF FROM THE NEW CLASSROOM WING WILL BE COLLECTED VIA ROOF DRAINS AND DIRECTED VIA PRIVATE STORM DRAIN TO THE ONSITE PRIVATE RETENTION POND.

UPON COMPLETION OF THE NEW BUILDING TWO EXISTING CLASSROOM BUILDINGS, SOUTH OF THE MAIN OFFICE & CLASSROOM BUILDING, WILL BE REMOVED. THE OLD BUILDING FOOTPRINTS WILL BE REPLACED WITH TREE WELLS AND PERVIOUS PAVING. THE BASKETBALL COURTS WILL ALSO BE RELOCATED AND RECONSTRUCTED AT THE EAST EDGE OF THE SCHOOL SITE WITH THE EXISTING PLAYGROUND. THIS AREA WILL ALSO SURFACE DRAIN TO THE ONSITE PRIVATE RETENTION POND. IN ADDITION TO SITE LANDSCAPING, THE DEVELOPED POND WILL BE LANDSCAPED. IT WILL ALSO BE FENCED AS IT WILL BE DEEPER THAN 18 INCHES.

THE NEGLIGIBLE OFFSITE FLOWS ENTERING THE SITE FROM THE ADJACENT RESIDENTIAL PROPERTIES WILL NOT BE BLOCKED AND WILL CONTINUE TO BE ACCEPTED AND CONVEYED THROUGH THE SITE AS IN THE EXISTING CONDITION.

VI. PHASING

THIS PROJECT WILL BE CONSTRUCTED IN PHASES AS FOLLOWS:

- PHASE 1: REMOVE AND RELOCATE EXISTING PORTABLE CLASSROOM BUILDINGS INCLUDING THE DEMOLITION OF THE EXISTING IMPROVEMENTS WITHIN THE FOOTPRINT OF THE PROPOSED PERMANENT BUILDING. THE APS PORTABLE CLASSROOM BUILDINGS WILL TEMPORARILY BE LOCATED TO THE IMMEDIATE WEST OF THE NEW BUILDING IN THE PROXIMITY OF THE EXISTING BASKETBALL COURTS.
- PHASE 2A: CONSTRUCT NEW PERMANENT CLASSROOM BUILDING.
- PHASE 2B: DEMOLISH EXISTING BUILDINGS 300 AND 400 AND CONSTRUCT NEW COURTYARD IMPROVEMENTS
- PHASE 2C: REMOVE EXISTING APS PORTABLE CLASSROOM BUILDINGS FROM SITE.
- PHASE 2D: CONSTRUCT NEW PLAYGROUND IMPROVEMENTS FOR THE YDI PROGRAM (PORTABLE TO REMAIN) AND THE APS KINDERGARTEN CLASSROOMS (NEW BUILDING)
- PHASE 3: RELOCATE PORTABLE BUILDINGS FOR AFTER SCHOOL PROGRAMS TO EAST SIDE OF CAMPUS. THIS WILL COVERED BY SEPARATE PERMIT AND HENCE SEPARATE SUBMITTAL.

VI. GRADING PLAN

THE GRADING PLAN SHOWS THE 1) EXISTING AND PROPOSED GRADES INDICATED BY SPOT ELEVATIONS AND CONTOURS AT 1'-0" INTERVALS, 2) THE LIMIT OF THE EXISTING AND PROPOSED IMPROVEMENTS, AND 3) THE EXISTING AND PROPOSED GRADES OF BASIN A. THE LIMITS OF BASIN A WILL DECREASE SLIGHTLY IN RESPONSE TO THE NEW CLASSROOM BUILDING ROOF DRAINAGE. THE MAJORITY OF THE SITE AND THIS PROJECT LIES WITHIN BASIN B. THE DEVELOPED RUNOFF IN BASIN B ASSOCIATED WITH THE NEW CLASSROOM BUILDING, FIRE LANE DRIVE, PVIOUS PAVING IMPROVEMENTS, RELOCATED AND RECONSTRUCTED BASKETBALL COURTS WILL CONTINUE TO DRAIN TO AND BE CONTAINED WITHIN THE EXISTING RETENTION POND AT THE SOUTHWEST CORNER OF THE SITE.

VII. EROSION & SEDIMENT CONTROL AND LOW IMPACT DEVELOPMENT

DURING THE DEMOLITION, BUILDING, AND SITE CONSTRUCTION PHASES, BEST MANAGEMENT PRACTICES (BMPs) WILL BE IMPLEMENTED AND MAINTAINED FOR THE ENTIRE SITE UNTIL FINAL STABILIZATION MEASURES ARE INSTALLED. PREVENTION OF SEDIMENT DISCHARGE INTO THE PUBLIC RIGHT OF WAY AND/OR DOWNSTREAM INTO THE EXISTING STORM DRAIN SYSTEM IS REQUIRED BY THE CONSTRUCTION GENERAL PERMIT. A COMBINATION OF COMMON BMPs WILL PREVENT SEDIMENT DISCHARGE FROM THE SITE, SUCH AS: STABILIZED CONSTRUCTION ENTRANCE, STRAW MATS, PERMETER SILT FENCE, AND SEDIMENT DETENTION PONDING. PERMANENT STABILIZATION WILL BE ACHIEVED BY MEANS OF PERVIOUS AND IMPERVIOUS PAVING, NEW CLASSROOM BUILDING, LANDSCAPING (GRAVEL MULCH & PLANTINGS), AND SEDIMENT DETENTION PONDING WITHIN ONSITE PONDS. BASIN A INCLUDES AN EXISTING WATER HARVESTING AREA THAT WILL REMAIN. BASIN B INCLUDES AN ONSITE PRIVATE RETENTION POND THAT WILL BE DEEPENED AND IMPROVED IN CONJUNCTION WITH THIS PROJECT.

LOW IMPACT DEVELOPMENT IN BASIN A WILL BE ACHIEVED DUE TO THE MINOR DEVELOPMENT IT WILL RECEIVE. A SMALL VOLUME OF ROOF RUNOFF WILL DISCHARGE TO AN EXISTING SIDEWALK CULVERT AND COLLECT INTO AN EXISTING WATER HARVESTING POND. THE MAJORITY OF THE SUSPENDED SOLIDS WILL SETTLE BEFORE DISCHARGING INTO MOUNTAIN ROAD NW. THE LOW IMPACT NATURE OF BASIN B WILL BE MAINTAINED WHERE RUNOFF COLLECTS AND IS RETAINED IN THE EXISTING RETENTION POND. NEW PERVIOUS PAVING AND NEW LANDSCAPING WILL ALLOW RAINFALL TO INFILTRATE WITHIN THE SITE WHILE THE REMAINING RUNOFF WILL CONTINUE TO BE COLLECTED AND RETAINED WITHIN THE MODIFIED RETENTION POND.

VIII. CALCULATIONS

THE CALCULATIONS CONTAINED HEREON ANALYZE THE EXISTING AND DEVELOPED CONDITIONS FOR THE 100-YEAR, 6-HOUR RAINFALL EVENT. THE PROCEDURE FOR 40 ACRE AND SMALLER BASINS, AS SET FORTH IN THE REVISION OF SECTION 22.2, HYDROLOGY OF THE DEVELOPMENT PROCESS MANUAL, VOLUME 2, DESIGN CRITERIA, DATED JANUARY 1993, HAS BEEN USED TO QUANTIFY THE PEAK RATE OF DISCHARGE AND VOLUME OF RUNOFF GENERATED. AS DEMONSTRATED BY THESE CALCULATIONS, THE PROPOSED IMPROVEMENTS WILL RESULT IN AN INCREASE IN DEVELOPED RUNOFF GENERATED BY BASIN A, AND AN INCREASE IN THE DEVELOPED RUNOFF GENERATED BY BASIN B OF THE REGINALD CHAVEZ SCHOOL SITE. IN ADDITION, THE FIRST FLUSH WILL BE 100% RETAINED ONSITE IN THE DEVELOPED REGINALD CHAVEZ SCHOOL SITE WITHIN THEIR RESPECTIVE BASINS A & B. THE VOLUME OF THE EXISTING WATER HARVESTING POND IN BASIN A PROVIDES ADEQUATE CAPACITY TO RETAIN THE FIRST FLUSH RUNOFF GENERATED BY THE DEVELOPED BASIN A. SIMILARLY, THE REGRADED RETENTION POND WITHIN BASIN B WILL PROVIDE MORE THAN ENOUGH CAPACITY REQUIRED TO RETAIN THE FIRST FLUSH RUNOFF.

IX. CONCLUSIONS

THE FOLLOWING CONCLUSIONS HAVE BEEN ESTABLISHED AS A RESULT OF THE EVALUATIONS CONTAINED HEREIN:

- THE PROPOSED IMPROVEMENTS REPRESENT THE MODIFICATION OF AN EXISTING SITE WITHIN AN INFILL AREA.
- THE PROPOSED IMPROVEMENTS WILL MAINTAIN AND NOT ALTER THE EXISTING DRAINAGE PATTERNS OF THE SITE AND BE CONSISTENT WITH THE APPROVED MASTER DRAINAGE PLAN.
- THE PROPOSED IMPROVEMENTS WILL COMPLEMENT THE PORTABLE CLASSROOM RELOCATION PROJECT THAT WILL PRECEDE THE BUILDING PERMIT FOR THE PERMANENT BUILDING CONSTRUCTION AND IMPROVEMENTS PROPOSED HEREIN.
- THE FREE DISCHARGE OF DEVELOPED RUNOFF FROM BASIN A TO THE ADJACENT CITY STREETS IS CONSISTENT WITH THE MASTER DRAINAGE PLAN FOR THE SCHOOL SITE.
- THE PROPOSED IMPROVEMENTS WILL HAVE A MINOR INCREASE IN THE DEVELOPED RUNOFF, FREELY DISCHARGING TO MOUNTAIN ROAD NW, GENERATED BY BASIN A. THIS RUNOFF, HOWEVER, WILL BE ROUTED THROUGH AN EXISTING WATER HARVESTING AREA THAT WILL MITIGATE THE MINOR INCREASE.
- THE PROPOSED IMPROVEMENTS WILL RESULT IN A MINOR INCREASE IN THE DEVELOPED RUNOFF GENERATED FOR BASIN B; THIS INCREASE WILL BE MITIGATED VIA THE INCREASED STORAGE CAPACITY OF THE ONSITE RETENTION POND.
- THE PROPOSED IMPROVEMENTS WILL ENCLOSE UPON THE EXISTING ONSITE PRIVATE RETENTION POND. CAPACITY OF THE POND, HOWEVER, WILL BE PRESERVED BY REGRADING AND DEEPENING THE POND TO PROVIDE FOR ADEQUATE STORAGE VOLUME. THE DEEPER PORTIONS OF THE EXISTING POND WILL BE FENCED TO RESTRICT PUBLIC ACCESS.
- THE V-10 DAY RUNOFF VOLUME WILL CONTINUE TO BE CONTAINED ON SITE IN BASIN B, CONSISTENT WITH THE MASTER DRAINAGE PLAN.
- A GRAVEL INFILTRATION TRENCH WILL BE CONSTRUCTED AT THE BOTTOM OF THE ONSITE PRIVATE RETENTION POND IN BASIN B TO PROMOTE INFILTRATION.
- THE PROPOSED IMPROVEMENTS WILL NOT ADVERSELY IMPACT DOWNSTREAM PROPERTIES OR DOWNSTREAM DRAINAGE CONDITIONS.
- THE PROPOSED IMPROVEMENTS WILL NOT BLOCK OFFSITE FLOWS.
- THE FIRST FLUSH RUNOFF IN THE DEVELOPED PORTIONS OF BASINS A & B WILL BE CAPTURED AND MANAGED.

CALCULATIONS

I. SITE CHARACTERISTICS

A. PRECIPITATION ZONE = 2

B. $P_{100, 6 \text{ HR}} = P_{360 \text{ MIN}}$	2.35 IN
$P_{100, 10 \text{ DAY}} = P_{10 \text{ DAY}}$	3.95 IN
$P_{1440 \text{ MIN}}$	2.75 IN

C. LAND TREATMENTS & AREAS

1. TOTAL PROJECT AREA (A_T) = 390,300 SF (8.96 AC)

a. EXISTING LAND TREATMENT (FROM 2007 APPROVED MASTER DRAINAGE PLAN)

i. BASIN 'A'

TREATMENT	AREA (SF/AC)	%
A	0 / 0.00	
B	5,982 / 0.14	6
C	17,780 / 0.41	16
D	86,880 / 1.99	78
TOTAL	110,642 / 2.54	100

ii. BASIN 'B'

TREATMENT	AREA (SF/AC)	%
A	0 / 0.00	
B	61,420 / 1.41	22
C	135,472 / 3.11	48
D	82,764 / 1.90	30
TOTAL	279,656 / 6.42	100

b. DEVELOPED LAND TREATMENT

i. BASIN 'A'

TREATMENT	AREA (SF/AC)	%
A	0 / 0.00	
B	0 / 0.00	
C	18,644 / 0.43	18
D	85,480 / 1.96	82
TOTAL	104,124 / 2.39	100

ii. BASIN 'B'

TREATMENT	AREA (SF/AC)	%
A	0 / 0.00	
B	61,420 / 1.41	22
C	115,990 / 2.66	41
D	106,670 / 2.45	38
TOTAL	284,080 / 6.52	100

II. HYDROLOGY

A. EXISTING CONDITION (FROM 2007 APPROVED MDP)

1. BASIN 'A'

a. VOLUME

$$E_W = (E_A A_A + E_B A_B + E_C A_C + E_D A_D) / A_T$$
$$E_W = (0.53^*0.00) + (0.78^*0.14) + (1.13^*0.41) + (2.12^*1.99) / 2.54 = 1.89 \text{ IN}$$
$$V_{100, 6 \text{ HR}} = (E_W / 12) A_T = (1.89 / 12) 2.54 = 0.4000 \text{ AC-FT} = 17,430 \text{ CF}$$

b. PEAK DISCHARGE

$$Q_p = Q_{pA} A_A + Q_{pB} A_B + Q_{pC} A_C + Q_{pD} A_D$$
$$Q_p = Q_{100} = (1.56^*0.00) + (2.28^*0.14) + (3.14^*0.41) + (4.70^*1.99) = 11.0 \text{ CFS}$$

c. WATER HARVESTING (AVERAGE END AREA METHOD)

ELEV	AREA (SF)	VOL (CF)	ΣVOL (CF)
4956.7	530		190
4957	750		190
$V_{WH} = 190 \text{ CF} = 0.0043 \text{ AC-FT}$			

2. BASIN 'B'

a. VOLUME

$$E_W = (E_A A_A + E_B A_B + E_C A_C + E_D A_D) / A_T$$
$$E_W = (0.53^*0.00) + (0.78^*1.41) + (1.13^*3.11) + (2.12^*1.90) / 6.42 = 1.35 \text{ IN}$$
$$V_{100, 6 \text{ HR}} = (E_W / 12) A_T = (1.35 / 12) 6.42 = 0.7223 \text{ AC-FT} = 31,460 \text{ CF}$$

$$V_{10 \text{ DAY}} = V_{100, 6 \text{ HR}} * A_0 (P_{10} - P_{360}) / 12$$
$$V_{10 \text{ DAY}} = 0.7223 + 1.90 * (3.95 - 2.35) / 12 = 0.9756 \text{ AC-FT} = 42,500 \text{ CF}$$

b. PEAK DISCHARGE

$$Q_p = Q_{pA} A_A + Q_{pB} A_B + Q_{pC} A_C + Q_{pD} A_D$$
$$Q_p = Q_{100} = (1.56^*0.00) + (2.28^*1.41) + (3.14^*3.11) + (4.70^*1.90) = 21.9 \text{ CFS}$$

c. RETENTION POND (AVERAGE END AREA METHOD)

ELEV	AREA (SF)	VOL (CF)	ΣVOL (CF)
4953	1,180		4775
4954	8,370		13,925
4955	19,480		36,510
4956	53,540		55,210

$$V_{@4956} = 55,210 \text{ CF} = 1.27 \text{ AC-FT} > V_{10 \text{ DAY}} = 42,500 \text{ CF} \therefore V_{10 \text{ DAY}} \text{ WSL BETWEEN 4955 AND 4956; LET } V_{10 \text{ DAY}} \text{ WSL} = 4955.5$$

B. DEVELOPED CONDITION

1. BASIN 'A'

a. VOLUME

$$E_W = (E_A A_A + E_B A_B + E_C A_C + E_D A_D) / A_T$$
$$E_W = (0.53^*0.00) + (0.78^*0.00) + (1.13^*0.43) + (2.12^*1.96) / 2.39 = 1.94 \text{ IN}$$
$$V_{100, 6 \text{ HR}} = (E_W / 12) A_T = (1.94 / 12) 2.39 = 0.3864 \text{ AC-FT} = 16,830 \text{ CF}$$

b. PEAK DISCHARGE

$$Q_p = Q_{pA} A_A + Q_{pB} A_B + Q_{pC} A_C + Q_{pD} A_D$$
$$Q_p = Q_{100} = (1.56^*0.00) + (2.28^*0.00) + (3.14^*0.43) + (4.70^*1.96) = 10.6 \text{ CFS}$$

c. WATER HARVESTING - NO CHANGE

d. FIRST FLUSH (REQ'D FOR INCREASED IMPERVIOUS AREA)

$$E_W = (E_{FF} A_0) / A_0$$
$$E_{FF} = 0.44 \text{ IN}$$
$$A_0 = A_0, \text{ DEV} - A_0, \text{ EXIST} = 1.96 \text{ AC} - 1.99 \text{ AC}$$
$$A_0 = -0.03 \text{ AC} = \text{DECREASE IN IMPERVIOUS AREA}$$

THEREFORE: NO FIRST FLUSH CALCULATIONS ARE REQ'D

2. BASIN 'B'

a. VOLUME

$$E_W = (E_A A_A + E_B A_B + E_C A_C + E_D A_D) / A_T$$
$$E_W = (0.53^*0.00) + (0.78^*1.41) + (1.13^*2.66) + (2.12^*2.45) / 6.52 = 1.43 \text{ IN}$$
$$V_{100, 6 \text{ HR}} = (E_W / 12) A_T = (1.43 / 12) 6.52 = 0.7772 \text{ AC-FT} = 33,850 \text{ CF}$$
$$V_{10 \text{ DAY}} = V_{100, 6 \text{ HR}} * A_0 (P_{10} - P_{360}) / 12$$
$$V_{10 \text{ DAY}} = 0.7772 + 2.45 * (3.95 - 2.35) / 12 = 1.1037 \text{ AC-FT} = 48,080 \text{ CF}$$

b. PEAK DISCHARGE

$$Q_p = Q_{pA} A_A + Q_{pB} A_B + Q_{pC} A_C + Q_{pD} A_D$$
$$Q_p = Q_{100} = (1.56^*0.00) + (2.28^*1.41) + (3.14^*2.66) + (4.70^*2.45) = 23.1 \text{ CFS}$$

C. RETENTION POND (AVERAGE END AREA METHOD)

ELEV	AREA (SF)	VOL (CF)	ΣVOL (CF)
4951	2,560		3,350
4952	4,140		3,350
4953	5,920		5,030
4954	9,900		7,910
4955	16,350		13,125
4956	39,300		27,825
			57,240

$$V_{@4956} = 57,240 \text{ CF} >> V_{10 \text{ DAY}} = 46,730 \text{ CF} \therefore \text{OK}$$

d. FIRST FLUSH (REQ'D FOR INCREASED IMPERVIOUS AREA)

$$E_W = (E_{FF} A_0) / A_0$$
$$E_{FF} = 0.44 \text{ IN}$$
$$A_0 = A_0, \text{ DEV} - A_0, \text{ EXIST} = 2.45 \text{ AC} - 1.90 \text{ AC}$$
$$A_0 = 0.55 \text{ AC} = \text{INCREASE IN IMPERVIOUS AREA}$$
$$E_W = (0.44^*0.55) / 0.55 = 0.44 \text{ IN}$$
$$V_{FF} = (E_W / 12) A_T = (0.44 / 12) 0.55 = 0.0202 \text{ AC-FT} = 880 \text{ CF}$$
$$V_{FF} = 880 \text{ CF} < V_{@4956} = 57,240 \text{ CF} \therefore \text{OK}$$

C. COMPARISON

1. BASIN 'A'

$$\Delta V_{100, 6 \text{ HR}} = 16,830 - 17,430 - 190 = -790 \text{ CF} \quad (\text{DECREASE})$$

b. PEAK DISCHARGE ($P_{DEV} - P_{EXIST}$)

$$\Delta Q_{100} = 10.6 - 11.0 = -0.4 \text{ CFS} \quad (\text{DECREASE})$$

c. FIRST FLUSH (V_{FF} vs V_{WH})

NO FIRST FLUSH CALCULATIONS AS IMPERVIOUS AREA IN BASIN DECREASED

2. BASIN 'B'

a. Δ VOLUME GENERATED ($V_{DEV} - V_{EXIST}$)

$$\Delta V_{100, 6 \text{ HR}} = 33,850 - 31,460 = 2,390 \text{ CF} \quad (\text{INCREASE})$$
$$\Delta V_{10 \text{ DAY}} = 48,080 - 42,500 = 5,580 \text{ CF} \quad (\text{INCREASE})$$

b. DEVELOPED VOLUME GENERATED vs PONDING (RETENTION @ WSL = 4956)

$$V_{DEV 100, 6 \text{ HR}} = 33,850 \text{ CF} < V_{@4956} = 57,240 \text{ CF} \therefore \text{OK}$$
$$V_{DEV 10 \text{ DAY}} = 48,080 \text{ CF} < V_{@4956} = 57,240 \text{ CF} \therefore \text{OK}$$

c. PEAK DISCHARGE ($P_{DEV} - P_{EXIST}$)

$$\Delta Q_{100} = 23.1 - 21.9 = 1.2 \text{ CFS} \quad (\text{INCREASE})$$

△	RECORD DRAWING LEGEND
CONSTRUCT	RECORD INFORMATION (VERIFIED BY ENGINEER)
✓	AS-CONSTRUCTED = AS-DESIGNED (VERIFIED BY AS-BUILT SURVEY)
38' 42"	RECORD INFORMATION FROM AS-BUILT SURVEY
+25.2	RECORD INFORMATION FROM AS-BUILT SURVEY
● 28.98/42	RECORD INFORMATION FROM AS-BUILT SURVEY

CONSTRUCTION NOTES:

- TWO (2) WORKING DAYS PRIOR TO ANY EXCAVATION, CONTRACTOR MUST CONTACT NEW MEXICO ONE CALL SYSTEM 260-1990 FOR DESIGNATION (LINE-SPOTTING) OF EXISTING PUBLIC UTILITIES AND EXISTING UTILITIES OWNED AND OPERATED BY ALBUQUERQUE PUBLIC SCHOOLS.
- PRIOR TO CONSTRUCTION, THE CONTRACTOR SHALL EXCAVATE AND VERIFY THE HORIZONTAL AND VERTICAL LOCATION OF ALL POTENTIAL OBSTRUCTIONS. SHOULD A CONFLICT EXIST, THE CONTRACTOR SHALL NOTIFY THE ENGINEER IN WRITING SO THAT THE CONFLICT CAN BE RESOLVED WITH A MINIMUM AMOUNT OF DELAY. THE CONTRACTOR SHALL BE RESPONSIBLE FOR ALL INTERPRETATIONS IT MAKES WITHOUT FIRST CONTACTING THE ENGINEER AS REQUIRED ABOVE.
- ALL WORK ON THIS PROJECT SHALL BE PERFORMED IN ACCORDANCE WITH APPLICABLE FEDERAL, STATE AND LOCAL LAWS, RULES AND REGULATIONS CONCERNING CONSTRUCTION SAFETY AND HEALTH.
- ALL CONSTRUCTION WITHIN PUBLIC RIGHT-OF-WAY SHALL BE PERFORMED IN ACCORDANCE WITH APPLICABLE CITY OF ALBUQUERQUE STANDARDS AND PROCEDURES.
- IF ANY UTILITY LINES, PIPELINES, OR UNDERGROUND UTILITY LINES ARE SHOWN ON THESE DRAWINGS, THEY ARE SHOWN IN AN APPROXIMATE MANNER ONLY, AND SUCH LINES MAY EXIST WHERE NONE ARE SHOWN. IF ANY SUCH EXISTING LINES ARE SHOWN, THE LOCATION IS BASED UPON INFORMATION PROVIDED BY THE OWNER OF SAID UTILITY AND THE INFORMATION MAY BE INCOMPLETE, OR MAY BE OBSOLETE BY THE TIME CONSTRUCTION COMMENCES. THE ENGINEER HAS CONDUCTED ONLY PRELIMINARY INVESTIGATION OF THE LOCATION, DEPTH, SIZE, OR TYPE OF EXISTING UTILITY LINES, PIPELINES, OR UNDERGROUND UTILITY LINES. THIS INVESTIGATION IS NOT CONCLUSIVE, AND MAY NOT BE COMPLETE. THEREFORE, MAKES NO REPRESENTATION PERTAINING THERETO, AND ASSUMES NO RESPONSIBILITY OR LIABILITY THEREFOR. THE CONTRACTOR SHALL INFORM ITSELF OF THE LOCATION OF ANY UTILITY LINE, PIPELINE, OR UNDERGROUND UTILITY LINE IN OR NEAR THE AREA OF THE WORK IN ADVANCE OF AND DURING EXCAVATION WORK. THE CONTRACTOR IS FULLY RESPONSIBLE FOR ANY AND ALL DAMAGE CAUSED BY ITS FAILURE TO LOCATE, IDENTIFY AND PRESERVE ANY AND ALL EXISTING UTILITIES, PIPELINES, AND UNDERGROUND UTILITY LINES. IN PLANNING AND CONDUCTING EXCAVATION, THE CONTRACTOR SHALL COMPLY WITH STATE STATUTES, MUNICIPAL AND LOCAL ORDINANCES, RULES AND REGULATIONS, IF ANY, PERTAINING TO THE LOCATION OF THESE LINES AND FACILITIES.
- THE DESIGN OF PLANTERS AND LANDSCAPED AREAS IS NOT PART OF THIS PLAN. ALL PLANTERS AND LANDSCAPED AREAS ADJACENT TO THE BUILDING(S) SHALL BE PROVIDED WITH POSITIVE DRAINAGE TO AVOID ANY PONDING ADJACENT TO THE STRUCTURE. FOR CONSTRUCTION DETAILS, REFER TO LANDSCAPING PLAN.

EROSION CONTROL MEASURES:

- THE CONTRACTOR SHALL ENSURE THAT NO SOIL ERODES FROM THE SITE INTO PUBLIC RIGHT-OF-WAY OR ONTO PRIVATE PROPERTY.
- THE CONTRACTOR SHALL PROMPTLY CLEAN UP ANY MATERIAL EXCAVATED WITHIN THE PUBLIC RIGHT-OF-WAY SO THAT THE EXCAVATED MATERIAL IS NOT SUSCEPTIBLE TO BEING WASHED DOWN THE STREET.
- WHEN APPLICABLE, CONTRACTOR SHALL SECURE "TOPSOIL DISTURBANCE PERMIT" FROM THE CITY AND/OR FILE A NOTICE OF INTENT (N.O.I.) WITH THE EPA PRIOR TO BEGINNING CONSTRUCTION.

PHASING

THIS PROJECT WILL BE CONSTRUCTED IN PHASES AS FOLLOWS:

PHASE 1: REMOVE AND RELOCATE EXISTING PORTABLE CLASSROOM BUILDINGS INCLUDING THE DEMOLITION OF THE EXISTING IMPROVEMENTS WITHIN THE FOOTPRINT OF THE PROPOSED PERMANENT BUILDING. THE APS PORTABLE CLASSROOM BUILDINGS WILL TEMPORARILY BE LOCATED TO THE IMMEDIATE WEST OF THE NEW BUILDING IN THE PROXIMITY OF THE EXISTING BASKETBALL COURTS. THIS WORK BY SEPARATE SUBMITTAL AND PERMIT (N.I.C.)

PHASE 2A: CONSTRUCT NEW PERMANENT CLASSROOM BUILDING.

PHASE 2B: DEMOLISH EXISTING BUILDINGS 300 AND 400 AND CONSTRUCT NEW COURTYARD IMPROVEMENTS BY SEPARATE PERMIT (N.I.C.)

PHASE 2C: REMOVE EXISTING APS PORTABLE CLASSROOM BUILDINGS FROM SITE (N.I.C.)

PHASE 2D: CONSTRUCT NEW PLAYGROUND IMPROVEMENTS FOR YDI AND KINDERGARTEN.

DESIGN GRADING LEGEND:

INV	INVERT
TA	TOP OF ASPHALT PAVEMENT
TC	TOP OF CURB
TG	TOP OF GRATE
+ 20.05	EXISTING SPOT ELEVATION
● 14.00	PROPOSED SPOT ELEVATION
---	EXISTING FLOWLINE
---	PROPOSED FLOWLINE
-4920-	EXISTING CONTOUR
-20-	PROPOSED CONTOUR
---	EXISTING DIRECTION OF FLOW
---	PROPOSED DIRECTION OF FLOW
---	PROPERTY LINE
---	EXISTING DRAINAGE BASIN BOUNDARY
---	PROPOSED DRAINAGE BASIN BOUNDARY
---	HIGH POINT / DIVIDE
---	PROPOSED CONCRETE
---	PROPOSED ASPHALT PAVING
---	PROPOSED SYNTHETIC TURF
---	GRAVEL BASE COURSE


CHERRY/SEE/REAMES ARCHITECTS, PC
220 gold avenue sw albuquerque, nm 87102
505-842-1278 fax 505-766-9269

HIGH MESA Consulting Group
4010-B MIDWAY PARK BLVD. NE
ALBUQUERQUE, NEW MEXICO 87109
PHONE: 505.345.4250 FAX: 505.345.4254
www.highmesacg.com

THIS DOCUMENT WAS
ORIGINALLY ISSUED AND SEALED
BY JEFFREY G. MORTENSEN
N.M.P.E. #5547 ON 11-05-2014

07-26-2016

**REGINALD CHAVEZ
ELEMENTARY SCHOOL
2700 Mountain Road NW
Albuquerque, NM 87104**

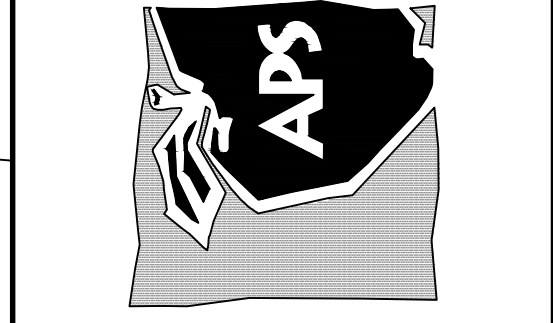


△	07/16	RECORD DWS.
MARK	DATE	DESCRIPTION
ISSUE:		
MANAGEMENT BLOCK		
PROJECT NO:	REGINALD CHAVEZ	
DWG FILE:		
DRAWN BY:		
CHECKED BY:		
COPYRIGHT:	Cherry/See/Reames PC	

**GRADING
PLAN
NORTH**

C-102

MATCH LINE - FOR CONTINUATION SEE SHEET C-103

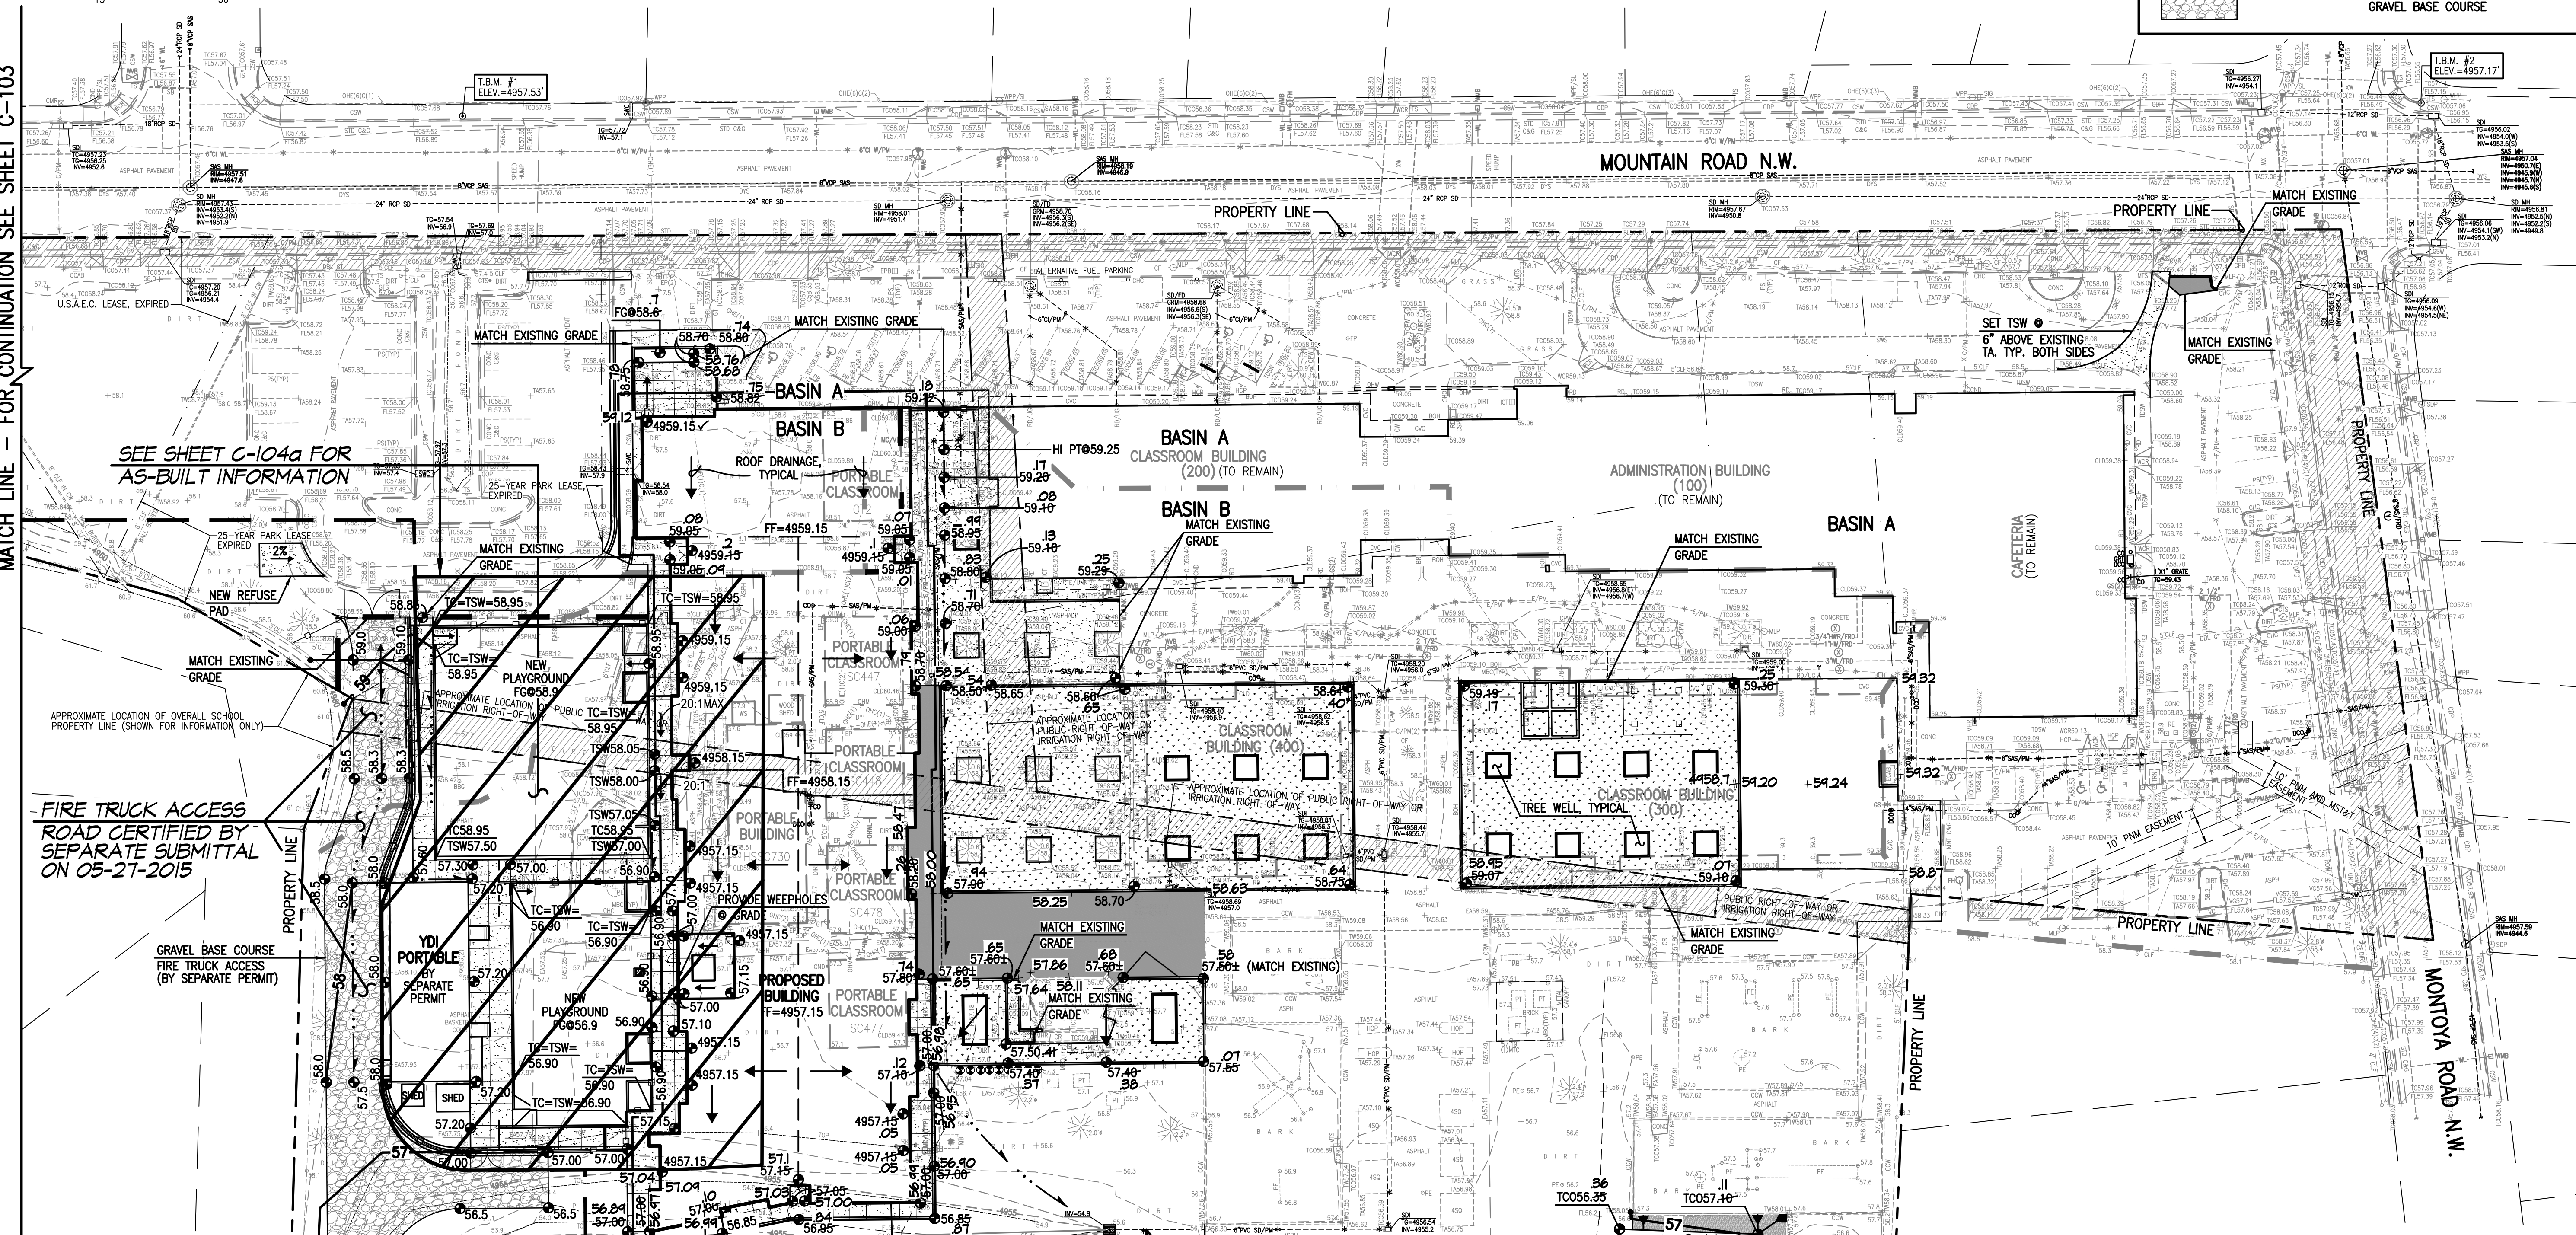

SURVEY NOTE:

THIS IS NOT A BOUNDARY SURVEY; DATA IS SHOWN FOR ORIENTATION ONLY. THE BOUNDARY INFORMATION DEPICTED BY THIS PLAN IS BASED UPON A PRELIMINARY PROPERTY INVESTIGATION CONDUCTED BY HIGH MESA CONSULTING GROUP (N.M.P.S. 11184), OCTOBER 2006. A TOPOGRAPHIC AND UTILITY SURVEY CONDUCTED BY HIGH MESA CONSULTING GROUP (N.M.P.S. 11184), DATED 11-7-2013. SCHOOL IMPROVEMENTS ENCRATCH ONTO PROPERTIES NOT OWNED BY APS AND PUBLIC UTILITY, ROADWAY AND RELATED IMPROVEMENTS ENCRATCH ONTO APS OWNED PROPERTIES AND GRAPHICALLY DEPICTED BY

MATCH LINE - FOR CONTINUATION SEE SHEET C-103


CONSTRUCT SINGLE 'D'
STORM INLET
TG @ 56.00 55.91
INV IN @ 54.6 54.77
INV OUT @ 54.70 54.67


**RECORD DRAWING
FOR CERTIFICATION, SEE SHEET C-103**

2015.185.3
2013.001.1

File Path: P:\DATA\2015\151653\151653.DWG | Plot Date: 07-26-2016
File Name: 151653_C-103_REC.DWG | Plot Time: 09:53 am

SURVEY NOTE:

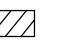THIS IS NOT A BOUNDARY SURVEY; DATA IS SHOWN FOR ORIENTATION ONLY. THE BOUNDARY INFORMATION DEPICTED BY THIS PLAN IS BASED UPON A PRELIMINARY PROPERTY INVESTIGATION CONDUCTED BY HIGH MESA CONSULTING GROUP (NMPS 11184), OCTOBER 2006. A TOPOGRAPHIC AND UTILITY SURVEY CONDUCTED BY HIGH MESA CONSULTING GROUP (NMPS 11184), DATED 11-7-2013. SCHOOL IMPROVEMENTS ENCR OACH ONTO PROPERTIES NOT OWNED BY APS AND PUBLIC UTILITY, ROADWAY AND RELATED IMPROVEMENTS ENCR OACH ONTO APS OWNED PROPERTIES AND GRAPHICALLY DEPICTED BY 

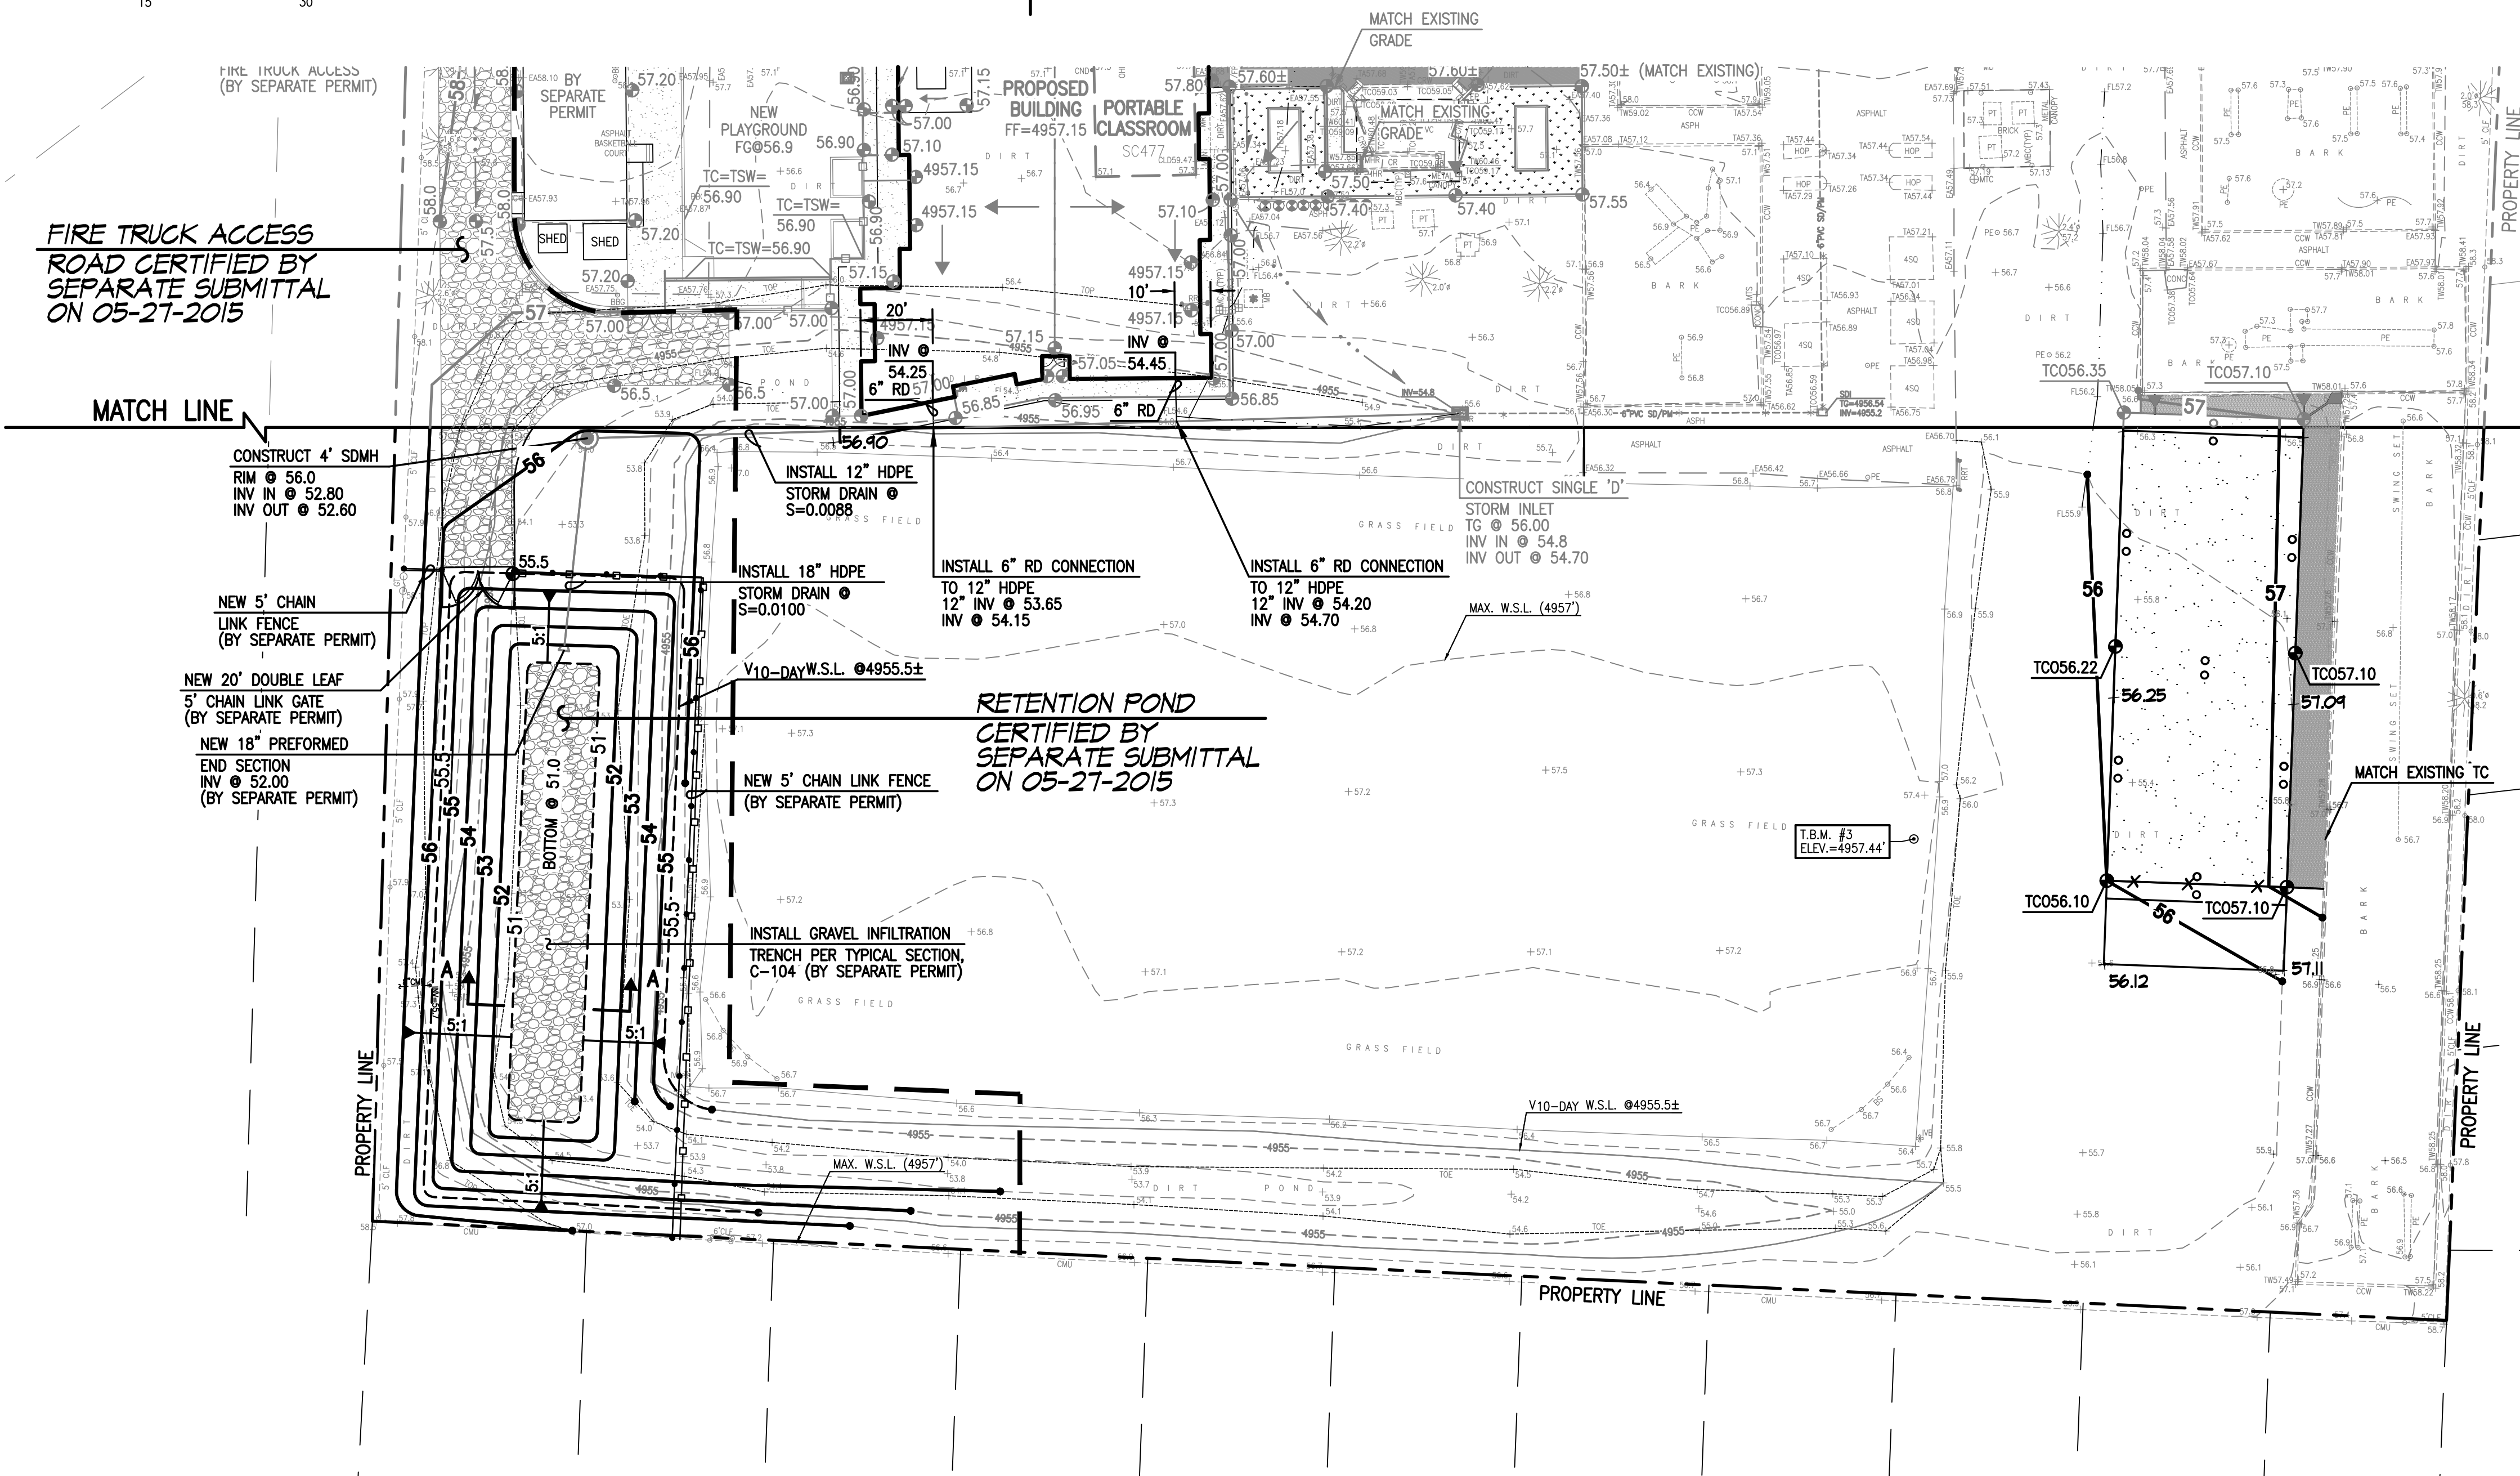

FIRE TRUCK ACCESS
ROAD CERTIFIED BY
SEPARATE SUBMITTAL
ON 05-27-2015

RETENTION POND
CERTIFIED BY
SEPARATE SUBMITTAL
ON 05-27-2015

FOR CONTINUATION, SEE SHEET C-102

CONSTRUCTION NOTES:

- TWO (2) WORKING DAYS PRIOR TO ANY EXCAVATION, CONTRACTOR MUST CONTACT NEW MEXICO ONE CALL SYSTEM 260-1990 FOR DESIGNATION (LINE-SPOTTING) OF EXISTING PUBLIC UTILITIES AND EXISTING UTILITIES OWNED AND OPERATED BY ALBUQUERQUE PUBLIC SCHOOLS.
- PRIOR TO CONSTRUCTION, THE CONTRACTOR SHALL EXCAVATE AND VERIFY THE HORIZONTAL AND VERTICAL LOCATION OF ALL POTENTIAL OBSTRUCTIONS. SHOULD A CONFLICT EXIST, THE CONTRACTOR SHALL NOTIFY THE ENGINEER IN WRITING SO THAT THE CONFLICT CAN BE RESOLVED WITH A MINIMUM AMOUNT OF DELAY. THE CONTRACTOR SHALL BE RESPONSIBLE FOR ALL INTERPRETATIONS IT MAKES WITHOUT FIRST CONTACTING THE ENGINEER AS REQUIRED ABOVE.
- ALL WORK ON THIS PROJECT SHALL BE PERFORMED IN ACCORDANCE WITH APPLICABLE FEDERAL, STATE AND LOCAL LAWS, RULES AND REGULATIONS CONCERNING CONSTRUCTION SAFETY AND HEALTH.
- ALL CONSTRUCTION WITHIN PUBLIC RIGHT-OF-WAY SHALL BE PERFORMED IN ACCORDANCE WITH APPLICABLE CITY OF ALBUQUERQUE STANDARDS AND PROCEDURES.
- IF ANY UTILITY LINES, PIPELINES, OR UNDERGROUND UTILITY LINES ARE SHOWN ON THESE DRAWINGS, THEY ARE SHOWN IN AN APPROXIMATE MANNER ONLY, AND SUCH LINES MAY EXIST WHERE NONE ARE SHOWN. IF ANY SUCH EXISTING LINES ARE SHOWN, THE LOCATION IS BASED UPON INFORMATION PROVIDED BY THE OWNER OF SAID UTILITY, AND THE INFORMATION MAY BE INCOMPLETE, OR MAY BE OBSOLETE BY THE TIME CONSTRUCTION COMMENCES. THE ENGINEER HAS CONDUCTED ONLY PRELIMINARY INVESTIGATION OF THE LOCATION, DEPTH, SIZE, OR TYPE OF EXISTING UTILITY LINES, PIPELINES, OR UNDERGROUND UTILITY LINES. THIS INVESTIGATION IS NOT CONCLUSIVE, AND MAY NOT BE COMPLETE. THEREFORE, MAKES NO REPRESENTATION PERTAINING THERETO, AND ASSUMES NO RESPONSIBILITY OR LIABILITY THEREOF. THE CONTRACTOR SHALL INFORM ITSELF OF THE LOCATION OF ANY UTILITY LINE, PIPELINE, OR UNDERGROUND UTILITY LINE IN OR NEAR THE AREA OF THE WORK IN ADVANCE OF AND DURING EXCAVATION WORK. THE CONTRACTOR IS FULLY RESPONSIBLE FOR ANY AND ALL DAMAGE CAUSED BY ITS FAILURE TO LOCATE, IDENTIFY AND PRESERVE ANY AND ALL EXISTING UTILITIES, PIPELINES, AND UNDERGROUND UTILITY LINES. IN PLANNING AND CONDUCTING EXCAVATION, THE CONTRACTOR SHALL COMPLY WITH STATE STATUTES, MUNICIPAL AND LOCAL ORDINANCES, RULES AND REGULATIONS, IF ANY, PERTAINING TO THE LOCATION OF THESE LINES AND FACILITIES.
- THE DESIGN OF PLANTERS AND LANDSCAPED AREAS IS NOT PART OF THIS PLAN. ALL PLANTERS AND LANDSCAPED AREAS ADJACENT TO THE BUILDING(S) SHALL BE PROVIDED WITH POSITIVE DRAINAGE TO AVOID ANY PONDING ADJACENT TO THE STRUCTURE. FOR CONSTRUCTION DETAILS, REFER TO LANDSCAPING PLAN.

EROSION CONTROL MEASURES:

- THE CONTRACTOR SHALL ENSURE THAT NO SOIL ERODES FROM THE SITE INTO PUBLIC RIGHT-OF-WAY OR ONTO PRIVATE PROPERTY.
- THE CONTRACTOR SHALL PROMPTLY CLEAN UP ANY MATERIAL EXCAVATED WITHIN THE PUBLIC RIGHT-OF-WAY SO THAT THE EXCAVATED MATERIAL IS NOT SUSCEPTIBLE TO BEING WASHED DOWN THE STREET.
- WHEN APPLICABLE, CONTRACTOR SHALL SECURE "TOPSOIL DISTURBANCE PERMIT" FROM THE CITY AND/OR FILE A NOTICE OF INTENT (N.O.I.) WITH THE EPA PRIOR TO BEGINNING CONSTRUCTION.

PHASING

THIS PROJECT WILL BE CONSTRUCTED IN PHASES AS FOLLOWS:

PHASE 1: REMOVE AND RELOCATE EXISTING PORTABLE CLASSROOM BUILDINGS INCLUDING THE DEMOLITION OF THE EXISTING IMPROVEMENTS WITHIN THE FOOTPRINT OF THE PROPOSED PERMANENT BUILDING. THE APS PORTABLE CLASSROOM BUILDINGS WILL TEMPORARILY BE LOCATED TO THE IMMEDIATE WEST OF THE NEW BUILDING IN THE PROXIMITY OF THE EXISTING BASKETBALL COURTS. THIS WORK BY SEPARATE SUBMITTAL AND PERMIT (N.I.C.)

PHASE 2A: CONSTRUCT NEW PERMANENT CLASSROOM BUILDING.

PHASE 2B: DEMOLISH EXISTING BUILDINGS 300 AND 400 AND CONSTRUCT NEW COURTYARD IMPROVEMENTS BY SEPARATE PERMIT (N.I.C.)

PHASE 2C: REMOVE EXISTING APS PORTABLE CLASSROOM BUILDINGS FROM SITE (N.I.C.)

PHASE 2D: CONSTRUCT NEW PLAYGROUND IMPROVEMENTS FOR YDI AND KINDERGARTEN.

DESIGN GRADING LEGEND:

INV	INVERT
TA	TOP OF ASPHALT PAVEMENT
TC	TOP OF CURB
TG	TOP OF GRATE
+ 20.05	EXISTING SPOT ELEVATION
14.00	PROPOSED SPOT ELEVATION
---	EXISTING FLOWLINE
---	PROPOSED FLOWLINE
-4920-	EXISTING CONTOUR
20-	PROPOSED CONTOUR
---	EXISTING DIRECTION OF FLOW
---	PROPOSED DIRECTION OF FLOW
---	RIGHT OF WAY LINE
---	EXISTING BASIN BOUNDARY
---	HIGH POINT / DIVIDE
---	PROPOSED CONCRETE
---	PROPOSED ASPHALT PAVING




RECORD DRAWING LEGEND

CONSTRUCT	RECORD INFORMATION (VERIFIED BY ENGINEER)
✓	AS-CONSTRUCTED = AS-DESIGNED (VERIFIED BY AS-BUILT SURVEY)
38' 42"	RECORD INFORMATION FROM AS-BUILT SURVEY
+25.2	RECORD INFORMATION FROM AS-BUILT SURVEY
28.38' 42"	RECORD INFORMATION FROM AS-BUILT SURVEY

ENGINEER'S DRAINAGE CERTIFICATION

I, J. GRAEME MEANS, NMPE 13676, OF THE FIRM HIGH MESA CONSULTING GROUP HEREBY CERTIFY THAT THIS PROJECT HAS BEEN GRADED AND DRAINED IN SUBSTANTIAL COMPLIANCE WITH AND IN ACCORDANCE WITH THE DESIGN INTENT OF THE APPROVED PLAN DATED 11-05-2014. THE RECORD INFORMATION EDITED ONTO THE ORIGINAL DESIGN DOCUMENT WAS OBTAINED 7/19/2016 BY HIGH MESA CONSULTING GROUP UNDER THE DIRECTION OF CHARLES G. CALA, JR, NMPS 11184, AND IS TRUE AND CORRECT TO THE BEST OF MY KNOWLEDGE AND BELIEF.

THIS CERTIFICATION IS SUBMITTED TO SUPPORT A RECOMMENDATION FOR PERMANENT CERTIFICATE OF OCCUPANCY FOR THE NEW KINDERGARTEN BUILDING AND PLAYGROUND, AND TO DOCUMENT COMPLETION OF THE IMPROVEMENTS FOR THE OWNER. THE RECORD INFORMATION PRESENTED HEREON IS NOT NECESSARILY COMPLETE AND INTENDED ONLY TO VERIFY SUBSTANTIAL COMPLIANCE OF THE GRADING AND DRAINAGE ASPECTS OF THIS PROJECT. THIS CERTIFICATION DOES NOT ADDRESS ADA COMPLIANCE WHICH IS BEYOND THE SCOPE OF GRADING AND DRAINAGE. THOSE RELYING ON THIS RECORD DOCUMENT ARE ADVISED TO OBTAIN INDEPENDENT VERIFICATION OF ITS ACCURACY BEFORE USING IT FOR ANY OTHER PURPOSE.


J. GRAEME MEANS, NMPE 13676


07-26-2016
DATE



RECORD DRAWING



REGINALD CHAVEZ
ELEMENTARY SCHOOL
2700 Mountain Road NW
Albuquerque, NM 87104

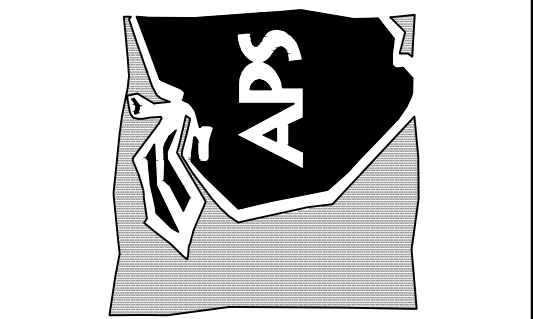

07/16 RECORD DWS. 1
CERTIFICATION

MARK	DATE	DESCRIPTION
------	------	-------------

ISSUE:

MANAGEMENT BLOCK

PROJECT NO: REGINALD CHAVEZ

DWG FILE:

DRAWN BY:


CHECKED BY:

COPYRIGHT: Cherry/See/Reames PC

GRADING
PLAN
SOUTH


C-103

2015.185.3
2013.001.1

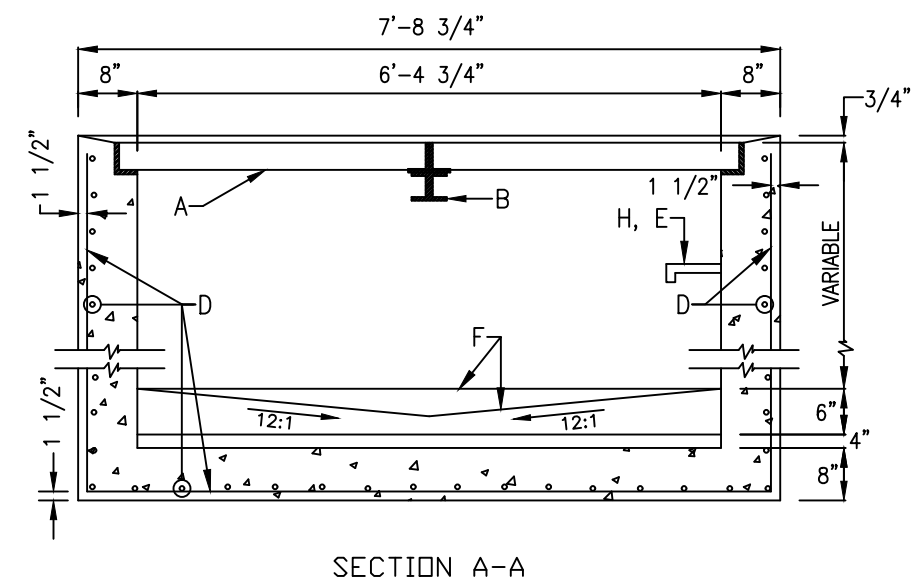


- CONSTRUCTION NOTES:**
- A. FRAME & GRATE
 - B. CENTER SUPPORT ASSEMBLY. (NOT REQUIRED).
 - C. CUT ONE HORIZONTAL AND ONE VERTICAL BAR MAX. AT PIPE OPENING.
 - D. NO. 4 BARS AT 6" O.C. EACH WAY.
 - E. STEPS NOT REQUIRED.
 - F. CONCRETE FILL 3000 PSI.
 - G. INVERT ELEVATION PER DESIGN.

DWG. 2206

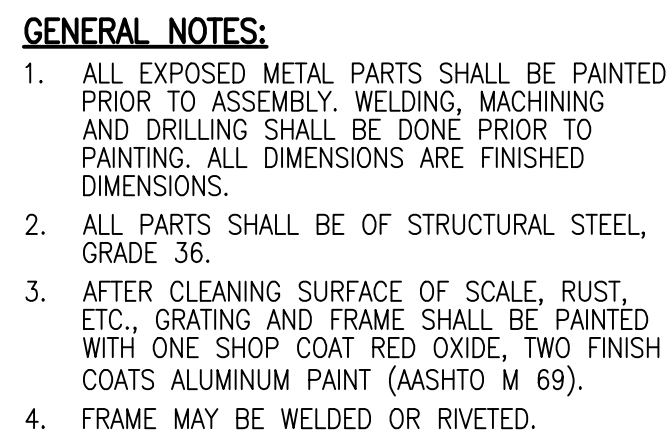

- CONSTRUCTION NOTES:**
- A. 4" X 3" X 1/2" X 3' - 1/2" L.
 - B. 2 - 3/8" RIVETS AT EACH CORNER, SEE GENERAL NOTE NO. 5.
 - C. 4 - 1/2" X 8" BOLTS WITH SQUARE HEAD & NUT AT EACH CORNER FOR ANCHORING FRAME INTO CONCRETE WALL.
 - D. 3 - 1/2" X 3" X 3/8" X 3' - 4 - 3/8" L.

DWG. 2216

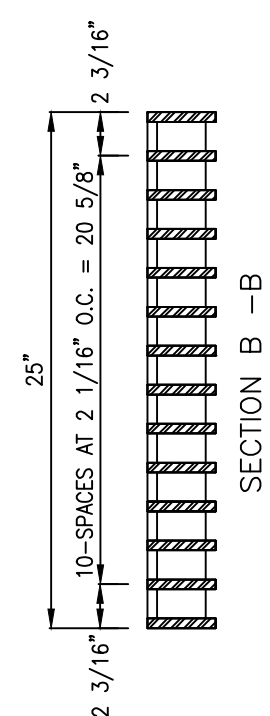

- ### GENERAL NOTES:
1. ALL BARS SHALL BE STRUCTURAL GRADE STEEL, GRADE A36.
 2. THE GRATE SHALL BE WELDED WITH 1/8" FILLET WELD AROUND BOTH SIDES OF CROSS BARS. 1/4" FILLET WELDS BOTH SIDES OF BEARING BARS TO END BARS.
 3. AFTER CLEANING SURFACE OF SCALE, RUST, OILS, ETC., PAINT GRATE WITH ONE SHOT COAT RED OXIDE, TWO FINISH COATS OF ALUMINUM PAINT (ASHTO M 69).
 4. TOP OF CROSS BARS SHALL BE FLUSH WITH TOP OF GRATE.
 5. GRIND WELDS FLUSH WITH BEARING BARS.
 6. WHEN INSTALLED IN FRAME, PUSH TIGHT TO ONE SIDE. OTHER SIDE SHALL HAVE 1/2" MAX. OPENING. SPACES WELDED TO FRAME MAY BE USED IF REQUIRED TO FRAME 1/2" SPACE OR LESS.

- CONSTRUCTION NOTES:**
- A. BEARING BARS. (13) $1\frac{1}{2}$ " X 3 $1\frac{1}{2}$ " X 39".
 - B. END BARS (2) $1\frac{1}{2}$ " X 3" X 25".
 - C. CROSS BARS, (7) $1\frac{1}{2}$ " DIA. X 24".


DWG. 2220



- ### GENERAL NOTES
1. ALL MANHOLES 20" DEEP OR DEEPER WILL REQUIRE AN INTERMEDIATE LANDING IN THE MANHOLE BARREL. TYPE "C" MANHOLE COVERS SHALL BE USED AS INTERMEDIATE LANDINGS.
 2. INTERMEDIATE LANDINGS SHALL BE LOCATED AT THE MID POINT + OR - 2 FEET OF THE HEIGHT OF THE MANHOLE. AT NO TIME SHALL A INTERMEDIATE LANDING OR A SIZE ADJUSTMENT TOP BE INSTALLED CLOSER THAN 8' UP FROM THE INVERT OF THE MANHOLE.


- ### CONSTRUCTION NOTES
- A. PRECAST REINFORCED CONCRETE MANHOLE COVER.
 - B. ALL BARS TO HAVE 1-1/2" MIN. COVER.
 - C. 1" PIPE SLEEVE VERTICALLY THROUGH COVER.
 - D. TOP MAT NO. 4 BARS 6" O.C. EA. WAY FOR 4, 6, AND 8 FT. I.D. MANHOLES.
 - E. NO. 4 BARS.
 - F. BOTTOM MAT NO. 4 BARS 6" O.C. EA. WAY FOR 4 AND 6 FT. I.D. MANHOLES, NO. 8 BARS 8" O.C. EA. WAY FOR 8 FT. I.D. MANHOLES.
 - G. NO. 4 BARS FOR 4 AND 6 FT. I.D. MANHOLES.
 - H. WHEN PRECAST MANHOLE SECTIONS ARE USED, COVER SHALL BE MODIFIED TO SHAPE OF APPROPRIATE SIZE I AND J JOINT.
 - I. CONCRETE, SEE SECTION 101, NIMAWP.

DWG. 2107

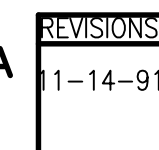

- GENERAL NOTES**
1. STANDARD CAST IRON M.H. FRAME AND COVER WEIGHTS: COVER = 180 LBS., FRAME = 145 LBS. TOTAL = 325 LBS. (TOLERANCE = $\pm 5\%$)
 2. REFERENCE SPEC. SECTION 130.

- ### **CONSTRUCTION NOTES**
- A. MACHINED OR GROUND BEARING SURFACES.
 - B. "SEWER", "WATER", OR "STORM", CAST ON COVER TO IDENTIFY SANITARY SEWER, WATER OR STORM DRAINAGE SYSTEMS RESPECTIVELY.
 - C. LETTER SIZE TO BE 1" MIN. IN HEIGHT.
 - D. VENT HOLE REQUIRED.
 - E. MONOLITHIC CAST IRON OR STEEL ROD INSERTS AT MANUFACTURER'S OPTION. IF INSERT IS PROVIDED IT MUST HAVE 3/16" MIN. COVER AND 3/4" END EMBEDMENT IN CASTING.
 - F. GUSSETS OPTIONAL IF REQUIRED BY MANUFACTURER.

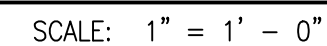

- | | |
|---------------------------------------------|-----------------------|
| File Path: P:\DATA\2015 APS\2015.185.3\ENG\ | Plot Date: 07-26-2016 |
| File Name: 151853_C-104_REC.DWG | Plot Time: 09:21 am |