

GENERAL NOTES:

1. CONTOUR INTERVAL IS ONE (1) FOOT.
2. ELEVATIONS ARE BASED ON CITY OF ALBUQUERQUE STATION NO. "14-J-13", HAVING AN ELEVATION OF 4954.71.
3. UTILITIES SHOWN HEREON ARE IN THEIR APPROXIMATE LOCATION BASED ONLY ON ABOVE GROUND EVIDENCE FOUND IN THE FIELD AND AS-BUILT INFORMATION PROVIDED BY THE CLIENT. UTILITIES SHOWN HEREON, WHETHER INDICATED AS ABANDONED OR NOT, SHALL BE VERIFIED BY OTHERS FOR EXACT LOCATION AND/OR DEPTH PRIOR TO EXCAVATION OR DESIGN CONSIDERATIONS.
5. THIS IS NOT A BOUNDARY SURVEY. BEARINGS AND DISTANCES SHOWN HEREON ARE FOR REFERENCE ONLY.

LEGEND


- 54.00 EXISTING SPOT ELEVATIONS
- 5000 EXISTING CONTOURS
- CONCRETE
- ED EDGE OF ALAMEDA DRAIN
- G GROUND
- EXISTING FENCING
- AS-BUILT EL. PT.
- BOC 54.02 BACK OF CURB EL. AS-BUILT
- G 54.36 GROUND EL. AS-BUILT
- CRB 55.00 HEADER CURB EL. AS-BUILT
- TOP 55.00 TOP HEADER CURB EL. PROPOSED

DRAINAGE PLAN GRADING CERTIFICATION


SHOWN ON THIS DRAWING ARE THE AS-BUILT LOCATION AND ELEVATIONS OF THE HEADER CURB REQUIRED FOR APPROVAL ON THE INFRASTRUCTURE LIST FOR DRB 1001011.

C. A. COONCE N.M.P.E. #2934

OCTOBER 1, 2002
DATE

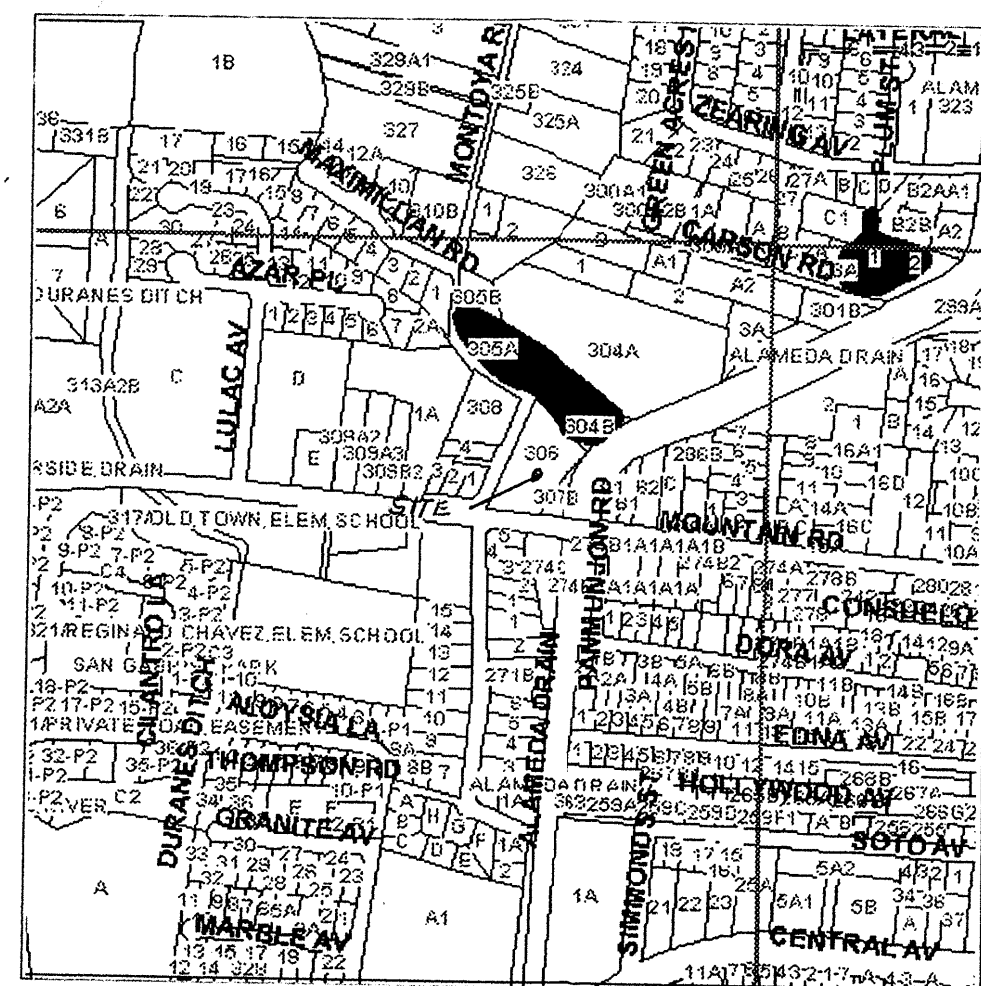

FLOOD INSURANCE RATE MAP
PANEL NO. 35001C0331 D

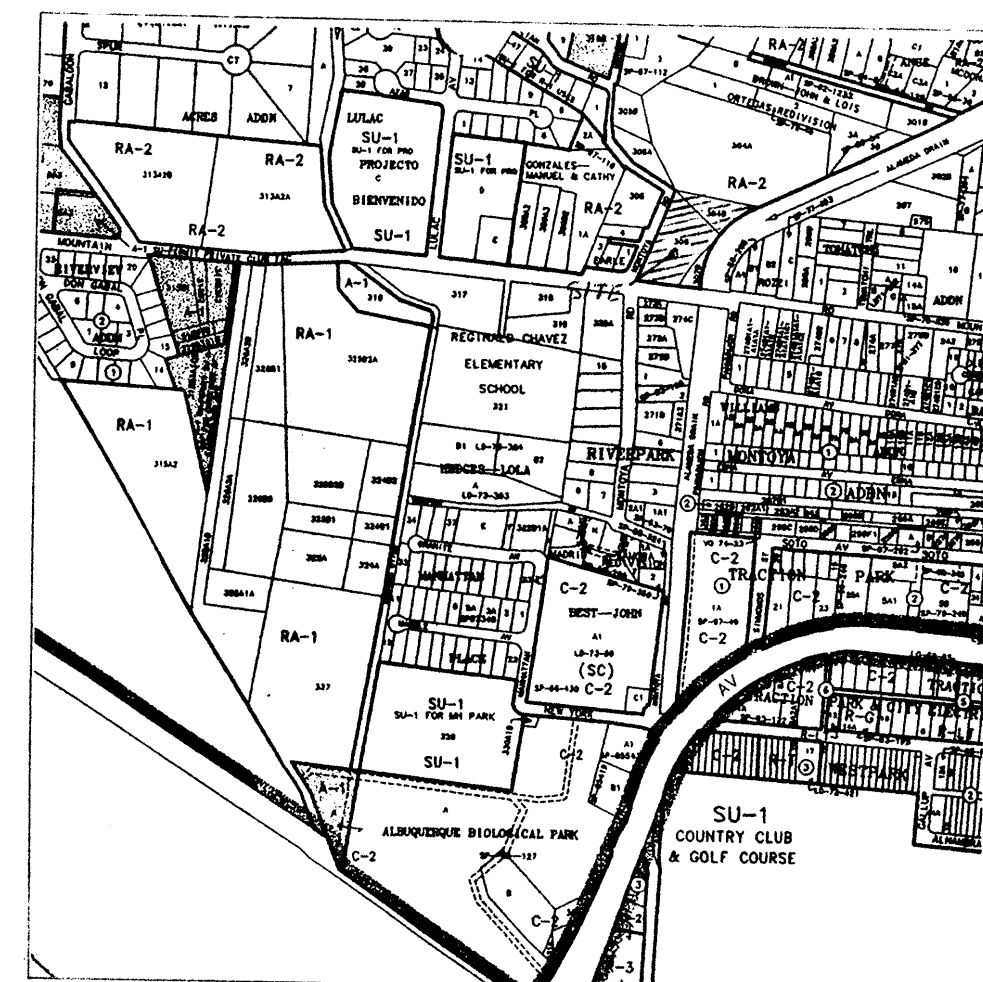

LOCATION MAP J-12-Z
LEGAL DESCRIPTION: TRACT 306, M.R.G.C.D. NO. 38
BERNALILLO COUNTY, NEW MEXICO
ADDRESS: N.E. CORNER MOUNTAIN RD. & MONTAÑA RD., N.W.

GENERAL:

THIS TRACT OF LAND, TR. 306 MRGCD MAP NO. 38, IS AN INFILL PROJECT WEST OF OLD TOWN ON THE N.E. CORNER OF MOUNTAIN RD. AND MONTAÑA RD. THE LOT CONTAINS 1.7139 ACRES AFTER FLOTING AND PROVIDING EXTRA R-O-W FOR MOUNTAIN ROAD AND MONTAÑA ROAD. THE TRACT IS TO BE SUBDIVIDED INTO SIX (6) LOTS OF 0.25+ ACRES EACH. MOUNTAIN ROAD HAS A 60' R-O-W, BUT IS CONSTRUCTED ON THE NORTHERN PORTION OF THE R-O-W AND ALBUQUERQUE CITY TRAFFIC HAS REQUESTED NINE (9) FT. FROM THE FACE OF CURB TO THE PROPERTY LINE. THE MOST RECENT USE HAS BEEN AS A HORSE CORRAL, AND CONSEQUENTLY THE SOIL IS VERY PACKED AND VOID OF MOST VEGETATION. THERE IS ALSO EVIDENCE OF AUTOS BEING DRIVEN OVER IT IN PLACES.

EXISTING INFRASTRUCTURE:

MOUNTAIN ROAD HAS CURB, GUTTER, SIDEWALK AND PAVING. IT ALSO HAS SANITARY SEWER, STORM SEWER AND INLETS, WATER, ELECTRICITY, GAS, TELEPHONE, AND CABLE LINES IN PLACE. MONTAÑA ROAD IS PAVED AND DOES NOT HAVE STORM SEWERS. STORM WATERS ARE CONVEYED TO THE ALAMEDA DRAIN ONE LOT TO THE WEST OF THIS TRACT VIA MOUNTAIN ROAD. MONTAÑA ROAD DRAINS SOUTHWARD TO MOUNTAIN ROAD AND THROUGH THE MOUNTAIN ROAD DRAINAGE SYSTEM TO THE ALAMEDA DRAIN.

EXISTING DRAINAGE:

THE TRACT TO THE NORTH (MRGCD TR 304-A) IS A LARGE APPROXIMATELY SIX (6) ACRE TRACT WHICH CONTAINS THE KABO RADIO TRANSMISSION TOWER AND IS ZONED RA-2. IT IS UNDEVELOPED AND WELL VEGETATED FROM YEARS OF LYING FALLOW. IT CONTAINS A CLOSED SUMP AREA AT AN ELEVATION OF 4957' WITH A MIN. ELEVATION OF 4952.57'. TRACT 304-A DRAINS NEAR THE N.E. CORNER OF THIS TRACT INTO THE ALAMEDA DRAIN. THE N.E. PORTION OF THIS TRACT (TR 306) ALSO DRAINS INTO THE ALAMEDA DRAIN.

SOME OF THE EASTERN PORTION OF THIS TRACT (306) DRAINS ACROSS THE ADJACENT TR 307-B AND INTO THE ALAMEDA DRAIN ON MOUNTAIN ROAD. THE REMAINDER OF THIS TRACT (306), WESTERN AND SOUTHERN, DRAINS INTO MONTAÑA ROAD AND MOUNTAIN ROAD AND THE DRAINAGE IS CONVEYED TO THE ALAMEDA DRAIN.

PROPOSED DRAINAGE PLAN:

THIS DRAINAGE PLAN IS NOT A BUILDING DRAINAGE AND GRADING PLAN FOR OBTAINING A BUILDING PERMIT. IT IS A SUBDIVISION DRAINAGE PLAN TO ASSESS THE ADEQUACY OF THE GRADING PLAN WHEN A SITE SPECIFIC STRUCTURE IS PROPOSED FOR A BUILDING PERMIT. THE DEVELOPER IS NOT A BUILDER, AND THE LOTS WILL BE SOLD TO INDIVIDUALS AND/OR BUILDERS.

THE BASIC SCHEME IS THAT THE LOTS FRONTING ON MONTAÑA ROAD AND MOUNTAIN ROAD, LOTS A, C, E, AND F WILL DRAIN TO THE EXISTING DRAINAGE SYSTEM ON MONTAÑA ROAD AND MOUNTAIN ROADS. THE INTERIOR LOT B AND D, WHICH ARE ACCESSED BY AN ACCESS AND UTILITY EASEMENT, WILL ADHERE TO THE FLAT GRADING SCHEME.

DRAINAGE CALCULATIONS:

FOR PURPOSES OF ESTIMATING FLOWS AND VOLUMES, THE FOLLOWING ASSUMPTIONS WERE MADE:

1. THE DWELLING UNIT WILL BE 2,000 S.F. AND THE DRIVEWAY 500 S.F., GIVING A TOTAL OF 2500 S.F. OF IMPERVIOUS AREA, AND
2. THE REMAINDER OF THE LOT WILL BE LAND TREATMENT B.

THE FOUR LOTS A, C, E, AND F, DRAINING TO MONTAÑA AND MOUNTAIN ROADS

CONTAIN A TOTAL AREA OF 1.0954 AC. AND THE TOTAL IMPERVIOUS AREAS (4 X 2500 S.F.) CONTAIN 0.2295 AC. THE LOCATION IS IN PRECIPITATION ZONE 2 AND Q P100 = 3.28 CFS/ AC. TREATMENT B AND 4.70 CFS/ AC. TREATMENT D.

$$Q P100 = A B Q P B + A D Q P D$$
$$= (0.2295) (4.70) + (1.0954 - 0.2295) (3.28)$$
$$= 3.0528 \text{ CFS FOR ALL FOUR LOTS.}$$

THE EXISTING RUNOFF IS ESTIMATED BY Q P = 3.14 CFS/ AC. TREATMENT C, OR

$$Q P100 = (1.0954) (3.14) = 3.44 \text{ CFS FOR ALL FOUR LOTS.}$$

THEREFORE THE EXISTING AND PROPOSED DRAINAGE ARE APPROXIMATELY THE SAME.

LOTS B AND D FLAT GRADING:

LOT B E 6 HR. 100 YR. TREAT. B = 0.78 IN. AND TREAT D = 2.12 IN.

$$V \text{ HR. 100 YR.} = A B E D / 12 + A D E D / 12$$
$$= [(43560) (0.3200) - 2500] 0.78 / 12 + (2500) (2.12 / 12)$$
$$= 743.55 + 441.67 = 1185.22 \text{ CF}$$

V 10 DAY

$$= V360 + A D (P10 \text{ DAY} - P360)$$
$$= 1185.22 + (2500) (3.95 - 2.20) / 12$$
$$= 1185.22 + 364.58 = 1549.80 \text{ CF}$$

AVERAGE DEPTH PERVIOUS AREA = V / A

$$= (1549.80 / 11439.2) (12)$$
$$= 1.63 \text{ IN.}$$

LOT D E 6 HR. 100 YR. TREAT. B = 0.78 IN. AND TREAT D = 2.12 IN.

$$V \text{ HR. 100 YR.} = A B E D / 12 + A D E D / 12$$
$$= [(43560) (0.2985) - 2500] 0.78 / 12 + (2500) (2.12 / 12)$$
$$= 682.64 + 441.67 = 1124.34 \text{ CF}$$

V 10 DAY


$$= V360 + A D (P10 \text{ DAY} - P360) / 12$$
$$= 1124.34 + 364.58$$
$$= 1488.92 \text{ CF}$$

AVERAGE DEPTH PERVIOUS AREA = V / A

$$= (1488.92 / 10502.66) (12)$$
$$= 1.70 \text{ IN.}$$

FLOOD HAZARD:

FIRM MAP PANEL 331 OF 825 SHOWS A FLOOD PLAIN TOUCHING THE N P/L OF THIS TRACT WITH AN AH ZONE OF EL. 4955. SINCE THIS MUST BE HONORED OR CHANGED, NO FINISH FLOOR ELEVATIONS OF DWELLING UNITS ON THE SUBDIVISION SHOULD BE LESS THAN 4956. IN ORDER TO INSURE THAT THIS DRAINAGE PLAN IS ADHERED TO, A HEADER CURB OF EL. 4955 SHOULD BE CONSTRUCTED AT THE NORTH AND EAST PROPERTY LINE AS SHOWN. THIS WILL INSURE THAT THE DRAINAGE TO THE TWO SURROUNDING TRACTS WILL BE ELIMINATED, AND THE RUNOFF WILL BE TO THE INTENDED AREAS.

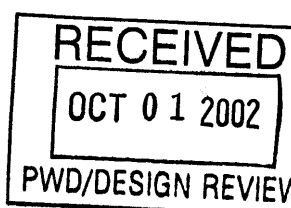

C.A. COONCE & ASSOC., INC.




ENVIRONMENTAL, WATER RESOURCES, & SANITARY CONSULTING ENGINEERS
12324 PINERIDGE N.E. ALBUQUERQUE, N.M. 87112
PH (505) 298-1056 FAX (505) 298-0478

TITLE DRAINAGE PLAN

PROJECT TR. 306, MRGCD MAP NO. 38

DATE 10/10/01 REVISED 10/01/02
DRAWN LSC
CHECKED CAC

SHEET 1 of 1

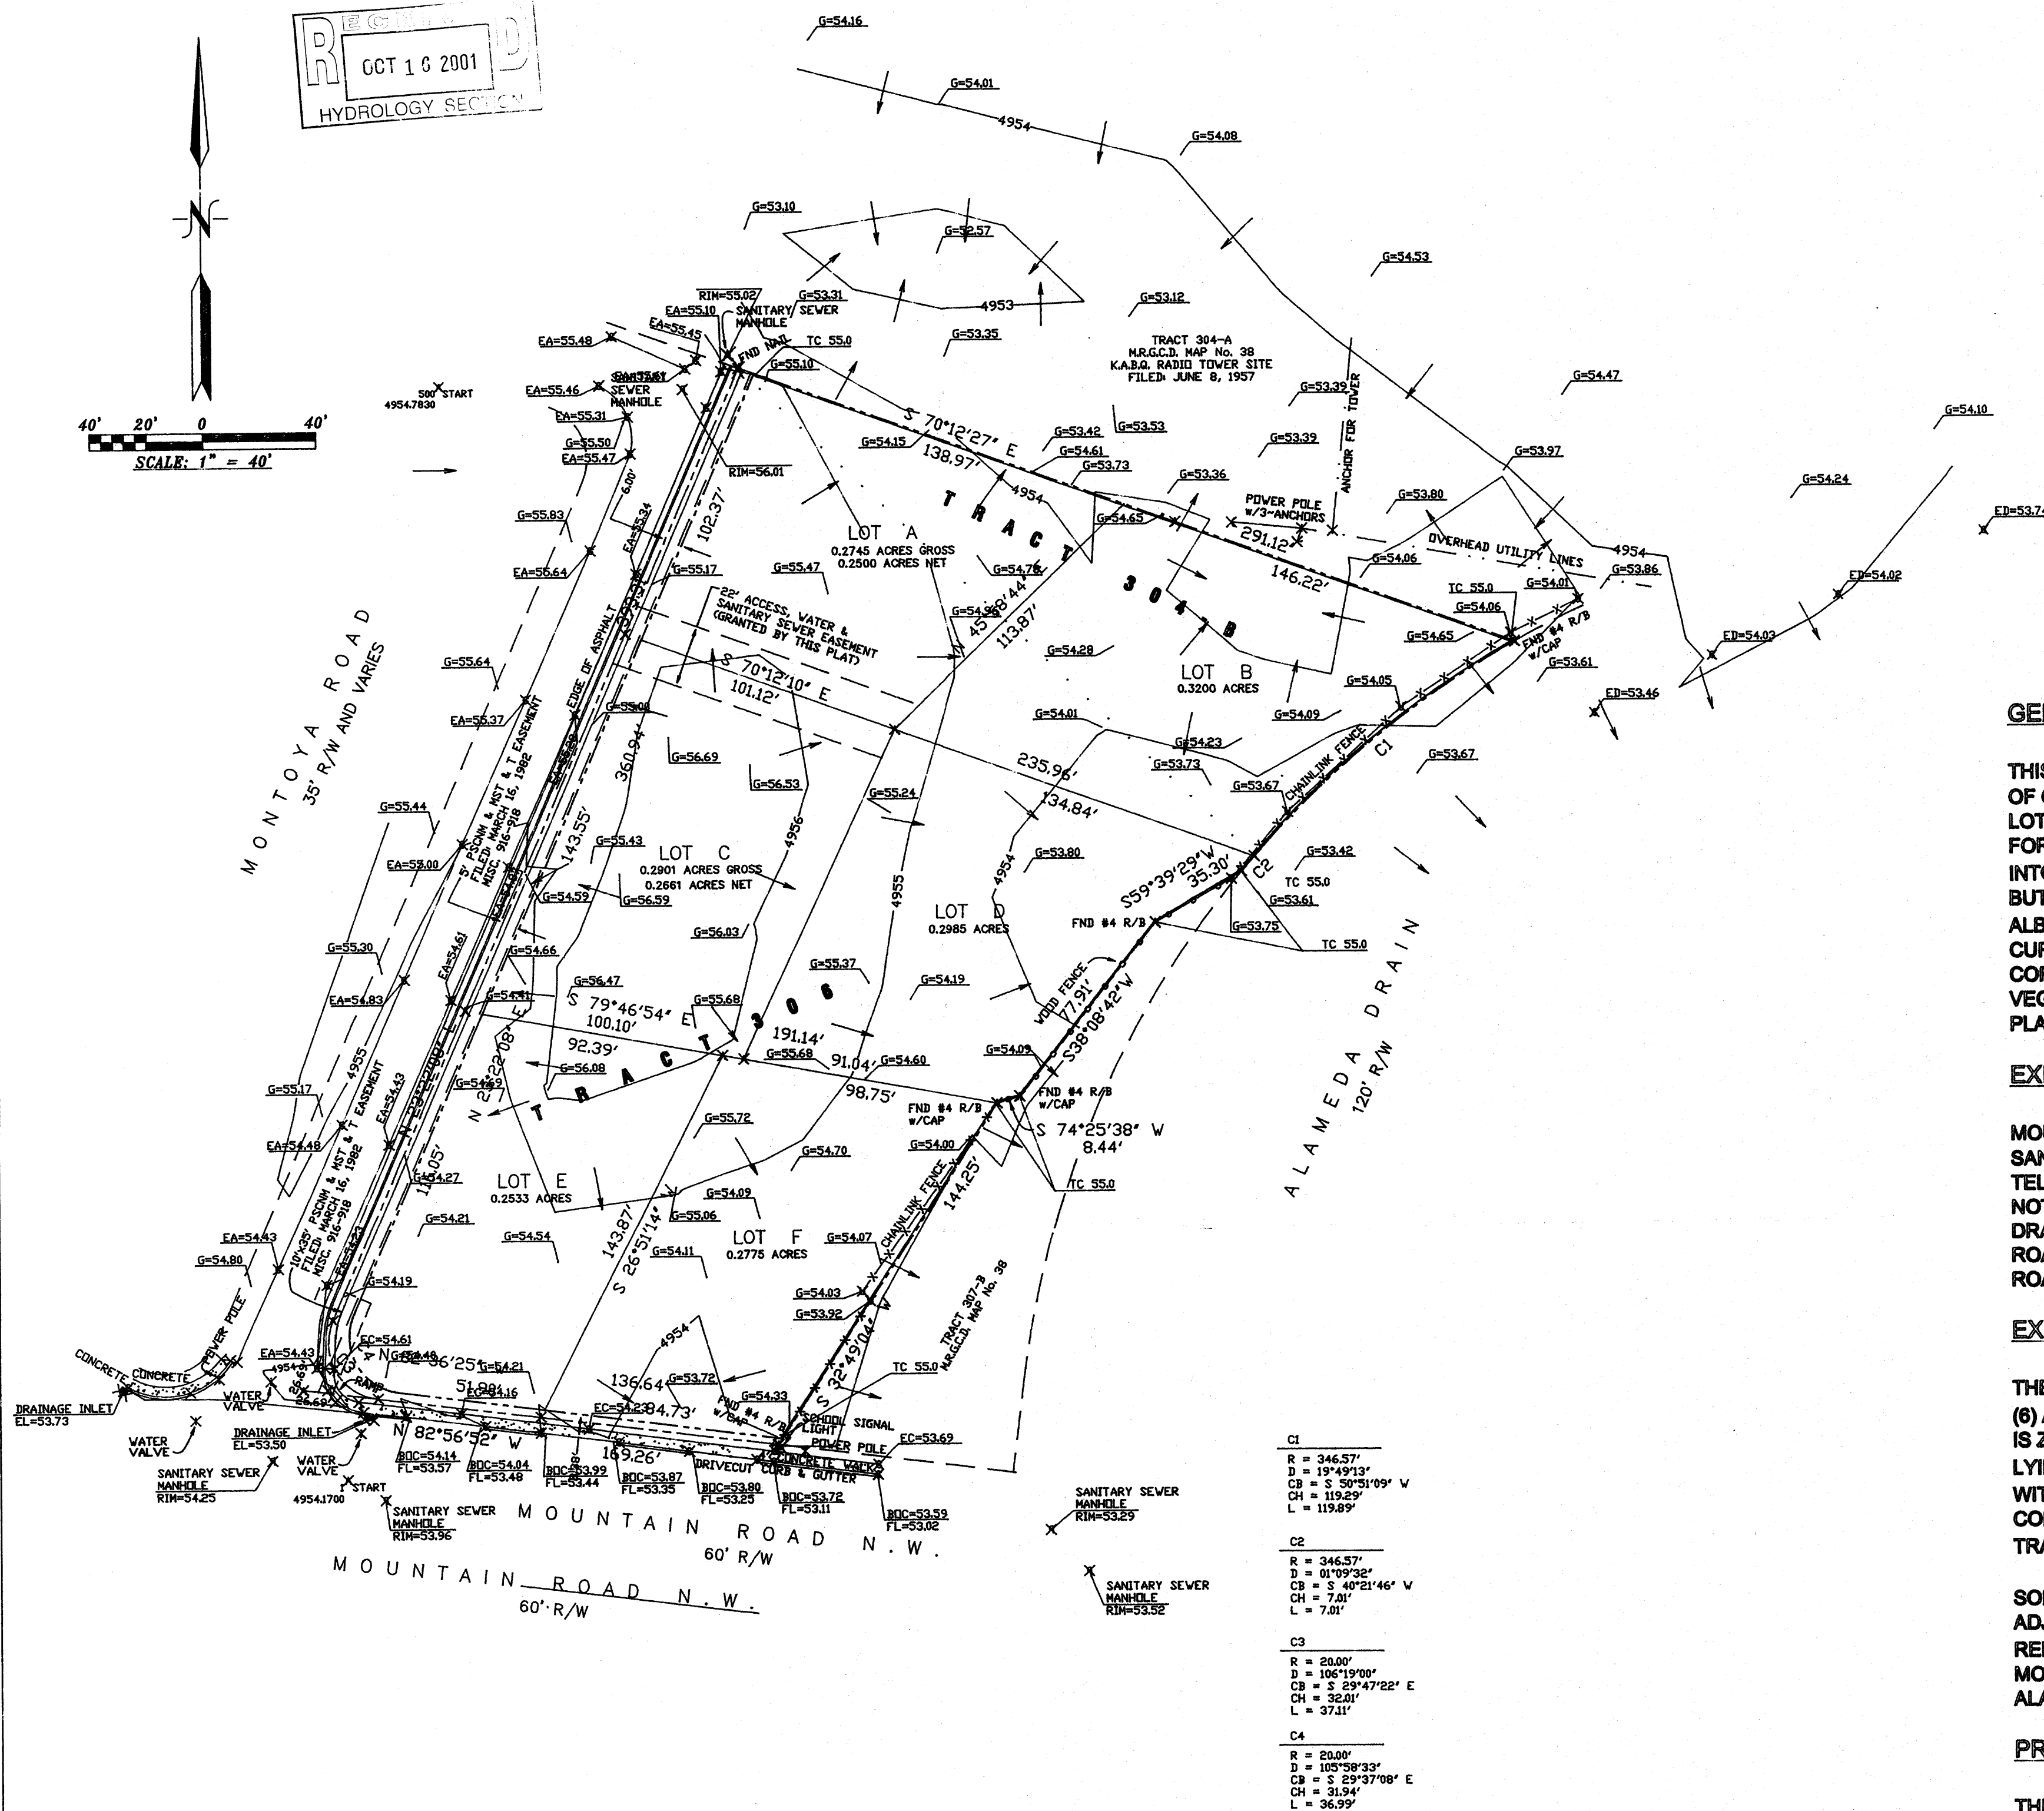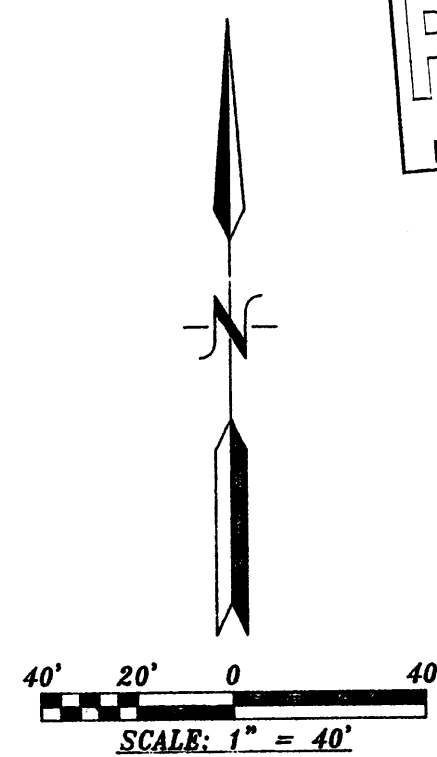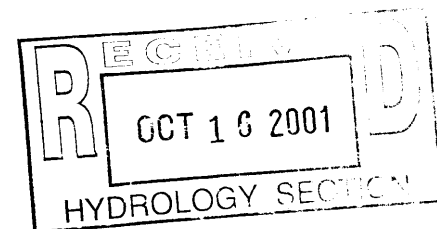

C1	R = 346.57'
	D = 19'49'13"
	CB = S 30°51'09" W
	CH = 119.89'
	L = 7.01'
C2	R = 346.57'
	D = 01°09'32"
	CB = S 40°21'46" W
	CH = 7.01'
	L = 7.01'
C3	R = 20.00'
	D = 106°19'00"
	CB = S 29°47'22" E
	CH = 32.01'
	L = 37.11'
C4	R = 20.00'
	D = 100°59'33"
	CB = S 29°37'08" E
	CH = 31.94'
	L = 36.99'

GENERAL NOTES:

1. CONTOUR INTERVAL IS ONE (1) FOOT.
2. ELEVATIONS ARE BASED ON CITY OF ALBUQUERQUE STATION No. "14-J-13", HAVING AN ELEVATION OF 4954.71.
3. UTILITIES SHOWN HEREON ARE IN THEIR APPROXIMATE LOCATION BASED ONLY ON ABOVE GROUND EVIDENCE FOUND IN THE FIELD AND AS-BUILT INFORMATION PROVIDED BY THE CLIENT. UTILITIES SHOWN HEREON, WHETHER INDICATED AS ABANDONED OR NOT, SHALL BE VERIFIED BY OTHERS FOR EXACT LOCATION AND/OR DEPTH PRIOR TO EXCAVATION OR DESIGN CONSIDERATIONS.
5. THIS IS NOT A BOUNDARY SURVEY. BEARINGS AND DISTANCES SHOWN HEREON ARE FOR REFERENCE ONLY.

LEGEND

- 54.00 EXISTING SPOT ELEVATIONS
- 5000 EXISTING CONTOURS
- CONCRETE
- ED EDGE OF ALAMEDA DRAIN
- G GROUND
- EXISTING FENCING

GENERAL:

THIS TRACT OF LAND, TR 306 MRGCD MAP NO. 38, IS AN INFILL PROJECT WEST OF OLD TOWN ON THE N.E. CORNER OF MOUNTAIN RD. AND MONTOYA RD. THE LOT CONTAINS 1.7139 ACRES AFTER PLOTTING AND PROVIDING EXTRA R-O-W FOR MOUNTAIN ROAD AND MONTOYA ROAD. THE TRACT IS TO BE SUBDIVIDED INTO SIX (6) LOTS OF 0.25+ ACRES EACH. MOUNTAIN ROAD HAS A 60' R-O-W, BUT IS CONSTRUCTED ON THE NORTHERN PORTION OF THE R-O-W AND ALBUQUERQUE CITY TRAFFIC HAS REQUESTED NINE (9) FT. FROM THE FACE OF CURB TO THE PROPERTY LINE. THE MOST RECENT USE HAS BEEN AS A HORSE CORRAL, AND CONSEQUENTLY THE SOIL IS VERY PACKED AND VOID OF MOST VEGETATION. THERE IS ALSO EVIDENCE OF AUTOS BEING DRIVEN OVER IT IN PLACES.

EXISTING INFRASTRUCTURE:

MOUNTAIN ROAD HAS CURB, GUTTER, SIDEWALK AND PAVING. IT ALSO HAS SANITARY SEWER, STORM SEWER AND INLETS, WATER, ELECTRICITY, GAS, TELEPHONE, AND CABLE LINES IN PLACE. MONTOYA ROAD IS PAVED AND DOES NOT HAVE STORM SEWERS. STORM WATERS ARE CONVEYED TO THE ALAMEDA DRAIN ONE LOT TO THE WEST OF THIS TRACT VIA MOUNTAIN ROAD. MONTOYA ROAD DRAINS SOUTHWARD TO MOUNTAIN ROAD AND THROUGH THE MOUNTAIN ROAD DRAINAGE SYSTEM TO THE ALAMEDA DRAIN.

EXISTING DRAINAGE:

THE TRACT TO THE NORTH (MRGCD TR 304-A) IS A LARGE APPROXIMATELY SIX (6) ACRE TRACT WHICH CONTAINS THE KABQ RADIO TRANSMISSION TOWER AND IS ZONED RA-2. IT IS UNDEVELOPED AND WELL VEGETATED FROM YEARS OF LYING FALLOW. IT CONTAINS A CLOSED SUMP AREA AT AN ELEVATION OF 4953' WITH A MIN. ELEVATION OF 4952.57'. TRACT 304-A DRAINS NEAR THE N.E. CORNER OF THIS TRACT INTO THE ALAMEDA DRAIN. THE N.E. PORTION OF THIS TRACT (TR 306) ALSO DRAINS INTO THE ALAMEDA DRAIN.

SOME OF THE EASTERN PORTION OF THIS TRACT (306) DRAINS ACROSS THE ADJACENT TR 307-B AND INTO THE ALAMEDA DRAIN ON MOUNTAIN ROAD. THE REMAINDER OF THIS TRACT (306), WESTERN AND SOUTHERN, DRAINS INTO MONTOYA ROAD AND MOUNTAIN ROAD AND THE DRAINAGE IS CONVEYED TO THE ALAMEDA DRAIN.

PROPOSED DRAINAGE PLAN:


THIS DRAINAGE PLAN IS NOT A BUILDING DRAINAGE AND GRADING PLAN FOR OBTAINING A BUILDING PERMIT. IT IS A SUBDIVISION DRAINAGE PLAN TO ASSESS THE ADEQUACY OF THE GRADING PLAN WHEN A SITE SPECIFIC STRUCTURE IS PROPOSED FOR A BUILDING PERMIT. THE DEVELOPER IS NOT A BUILDER, AND THE LOTS WILL BE SOLD TO INDIVIDUALS AND/OR BUILDERS.

THE BASIC SCHEME IS THAT THE LOTS FRONTING ON MONTOYA ROAD AND MOUNTAIN ROAD, LOTS A, C, E, AND F WILL DRAIN TO THE EXISTING DRAINAGE SYSTEM ON MONTOYA AND MOUNTAIN ROADS. THE INTERIOR LOT B AND D, WHICH ARE ACCESSED BY AN ACCESS AND UTILITY EASEMENT, WILL ADHERE TO THE FLAT GRADING SCHEME.


DRAINAGE CALCULATIONS:

FOR PURPOSES OF ESTIMATING FLOWS AND VOLUMES, THE FOLLOWING ASSUMPTIONS WERE MADE:

1. THE DWELLING UNIT WILL BE 2,000 S.F. AND THE DRIVEWAY 500 S.F., GIVING A TOTAL OF 2500 S.F. OF IMPERVIOUS AREA, AND
 2. THE REMAINDER OF THE LOT WILL BE LAND TREATMENT B.
- THE FOUR LOTS A, C, E, AND F, DRAINING TO MONTOYA AND MOUNTAIN ROADS

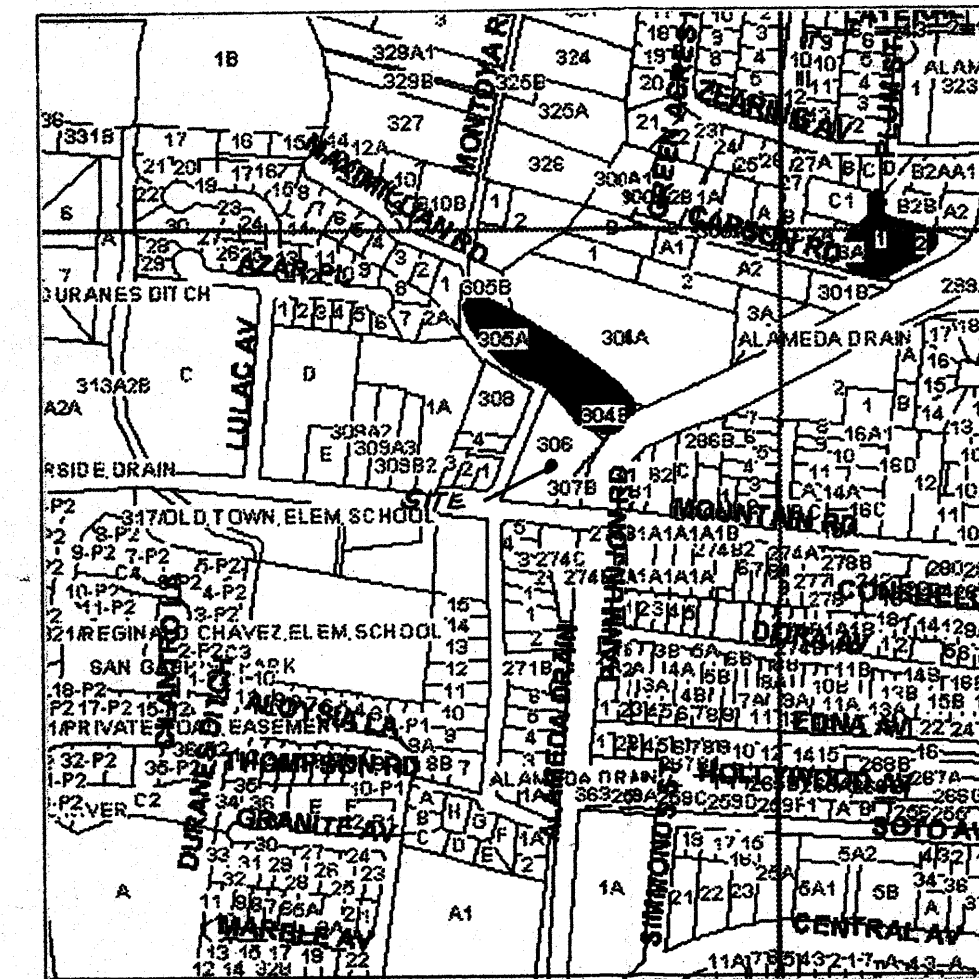

FLOOD INSURANCE RATE MAP
PANEL NO. 35001C0331 D

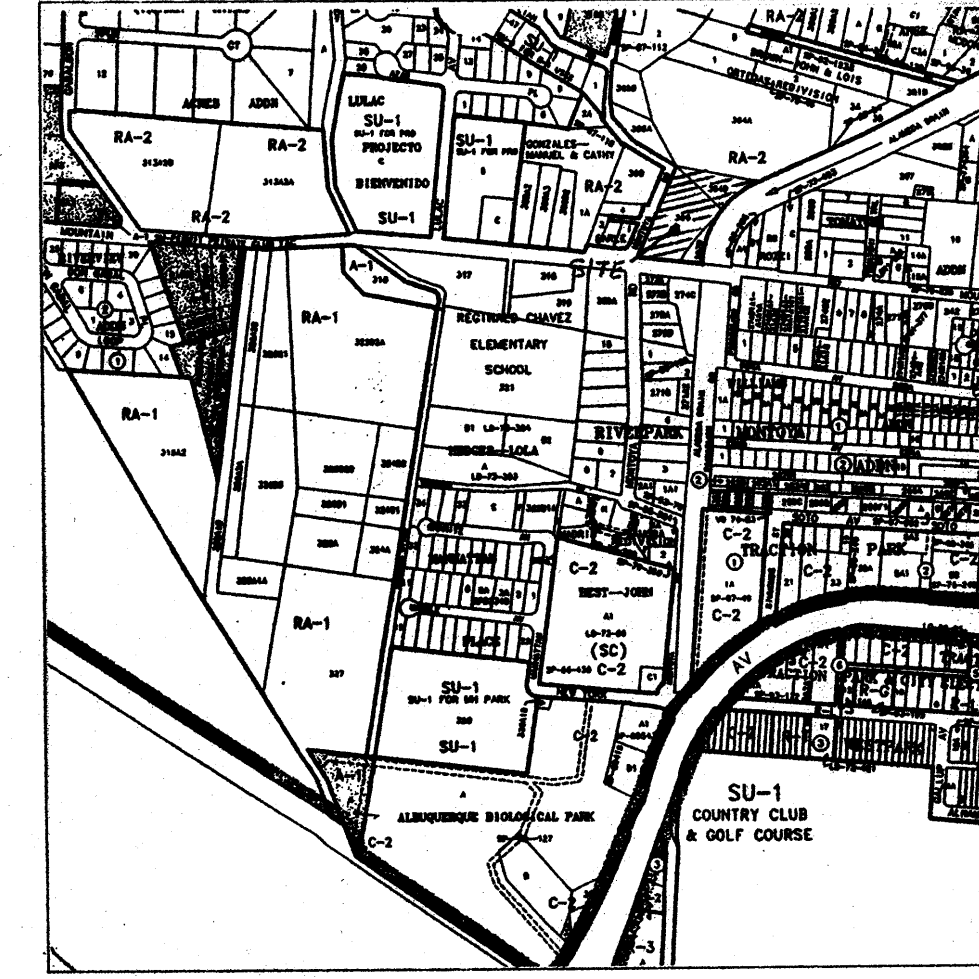

LOCATION MAP J-12-Z
LEGAL DESCRIPTION: TRACT 306, M.R.G.C.D. NO. 38
BERNALILLO COUNTY, NEW MEXICO
ADDRESS: N.E. CORNER MOUNTAIN RD. & MONTOYA RD., N.W.

CONTAIN A TOTAL AREA OF 1.0954 AC. AND THE TOTAL IMPERVIOUS AREAS (4 X 2500 S.F.) CONTAIN 0.2295 AC. THE LOCATION IS IN PRECIPITATION ZONE 2 AND Q P100 = 2.28 CFS/ AC. TREATMENT B AND 4.70 CFS/ AC. TREATMENT D.

$$Q P100 = A B Q P B + A d Q P D$$
$$= (0.2295) (4.70) + (1.0954 - 0.2295) (2.28)$$
$$= 3.0528 \text{ CFS FOR ALL FOUR LOTS.}$$

THE EXISTING RUNOFF IS ESTIMATED BY Q P = 3.14 CFS/ AC. TREATMENT C, OR

$$Q P100 = (1.0954) (3.14) = 3.44 \text{ CFS FOR ALL FOUR LOTS.}$$

THEREFORE THE EXISTING AND PROPOSED DRAINAGE ARE APPROXIMATELY THE SAME.

LOTS B AND D FLAT GRADING:

LOT B E 6 HR. 100 YR. TREAT. B = 0.78 IN. AND TREAT D = 2.12 IN.

$$V \text{ @ } 100 \text{ YR} = A B E B / 12 + A d E D / 12$$
$$= [(43580) (0.3200) - 2500] (0.78 / 12 + (2500) (2.12 / 12)$$
$$= 743.55 + 441.67 = 1185.22 \text{ CF}$$

$$V_{10 \text{ DAY}} = V_{360} + A d (P_{10 \text{ DAY}} - P_{360})$$
$$= 1185.22 + (2500) (3.95 - 2.20) / 12$$
$$= 1185.22 + 364.58 = 1549.80 \text{ CF}$$

AVERAGE DEPTH PERVIOUS AREA = V / A

$$= (1549.80 / 11439.2) (12)$$
$$= 1.63 \text{ IN.}$$

LOT D E 6 HR. 100 YR. TREAT. B = 0.78 IN. AND TREAT D = 2.12 IN.

$$V \text{ @ } 100 \text{ YR} = A B E B / 12 + A d E D / 12$$
$$= [(43580) (0.2985 - 2500) (0.78 / 12 + (2500) (2.12 / 12)$$
$$= 682.64 + 441.7 = 1124.34 \text{ CF}$$


$$V_{10 \text{ DAY}} = V_{360} + A d (P_{10 \text{ DAY}} - P_{360}) / 12$$
$$= 1124.34 + 364.58$$
$$= 1488.92 \text{ CF}$$

AVERAGE DEPTH PERVIOUS AREA = V / A

$$= (1488.92 / 10502.66) (12)$$
$$= 1.70 \text{ IN.}$$

FLOOD HAZARD:

FIRM MAP PANEL 331 OF 825 SHOWS A FLOOD PLAIN TOUCHING THE N P/L OF THIS TRACT WITH AN AH ZONE OF EL. 4955. SINCE THIS MUST BE HONORED OR CHANGED, NO FINISH FLOOR ELEVATIONS OF DWELLING UNITS ON THE SUBDIVISION SHOULD BE LESS THAN 4956. IN ORDER TO INSURE THAT THIS DRAINAGE PLAN IS ADHERED TO, A HEADER CURB OF EL. 4955 SHOULD BE CONSTRUCTED AT THE NORTH AND EAST PROPERTY LINE AS SHOWN. THIS WILL INSURE THAT THE DRAINAGE TO THE TWO SURROUNDING TRACTS WILL BE ELIMINATED, AND THE RUNOFF WILL BE TO THE INTENDED AREAS.

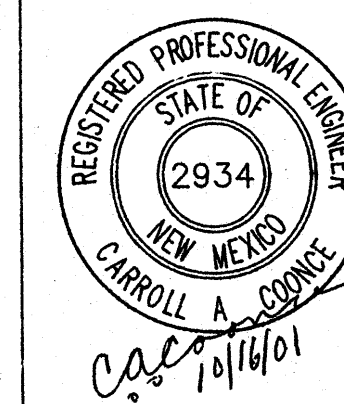

C.A. COONCE & ASSOC., INC.




ENVIRONMENTAL, WATER RESOURCES, & SANITARY CONSULTING ENGINEERS
12324 PINERIDGE N.E. ALBUQUERQUE, N.M. 87112
PH (505) 298-1056 FAX (505) 298-0478

TITLE DRAINAGE PLAN

PROJECT TR. 306, MRGCD MAP NO. 38

DATE	10/10/01	REVISED	
DRAWN	LSC		
CHECKED	CAC		

SHEET 1 of 1

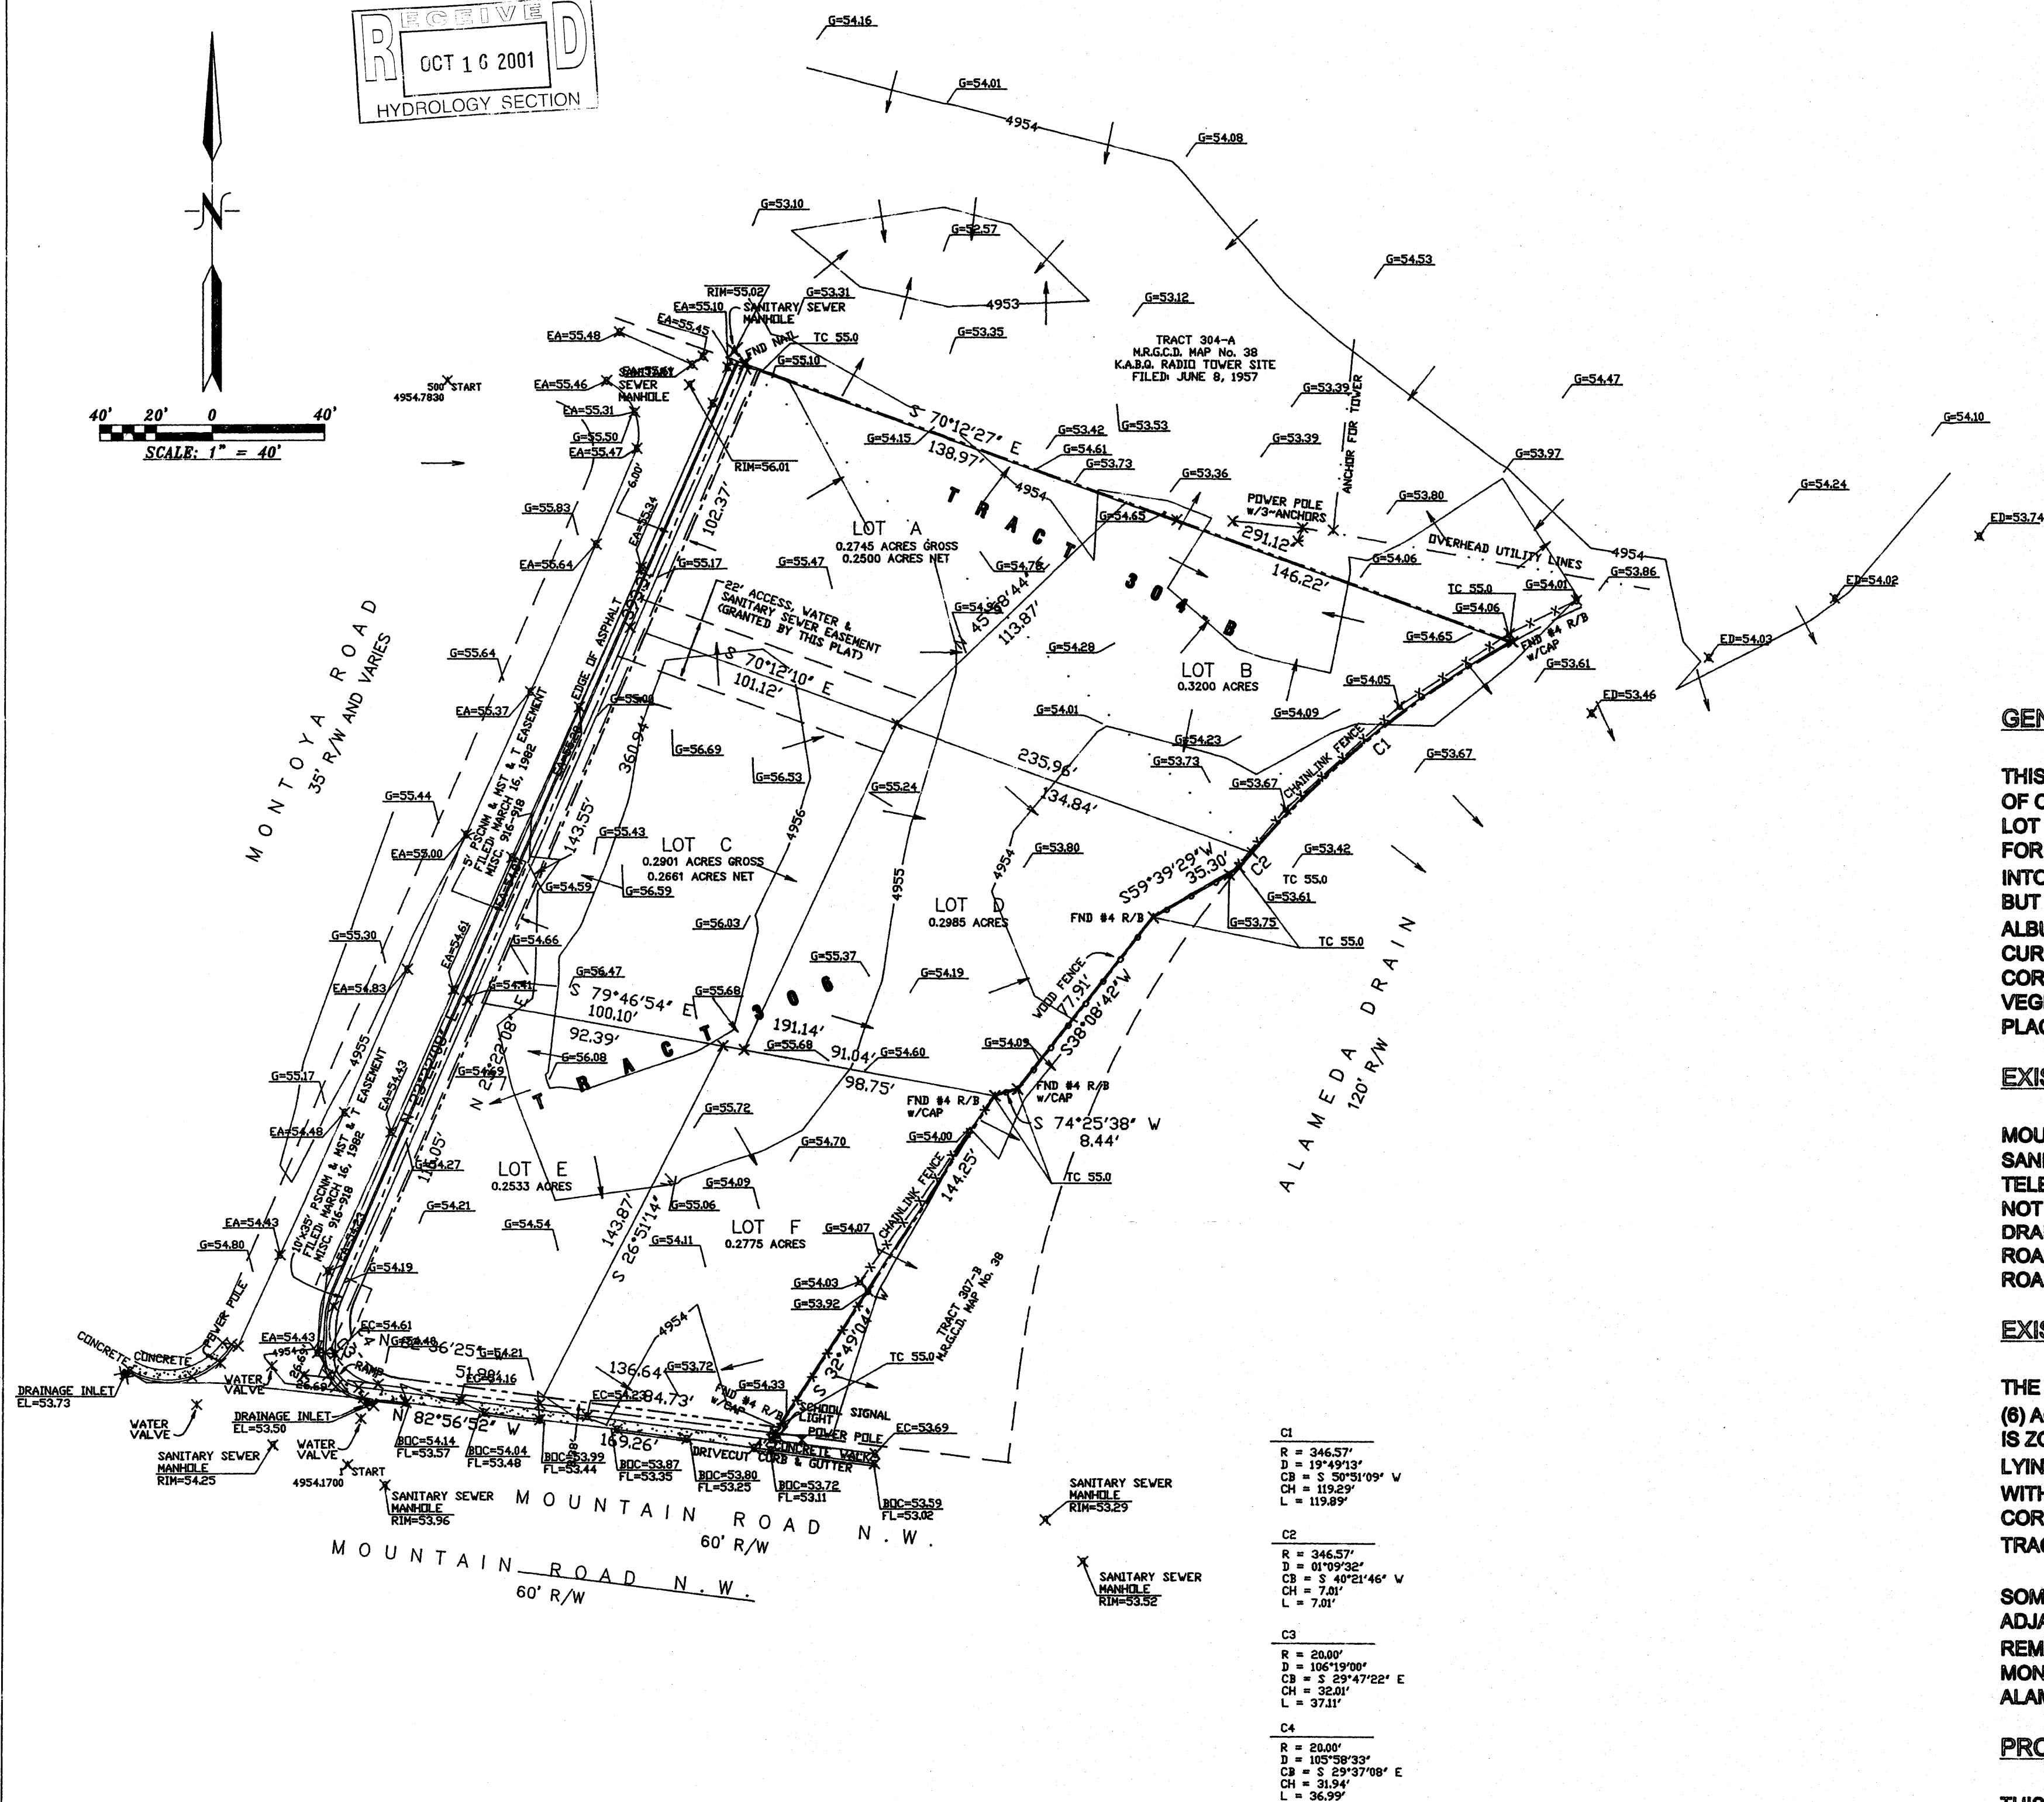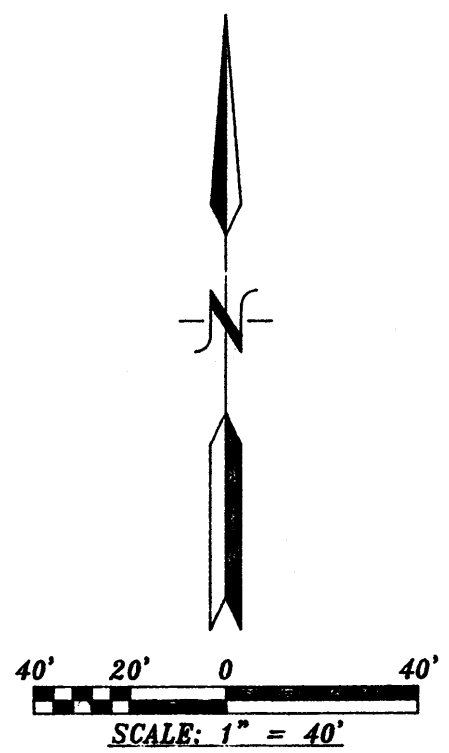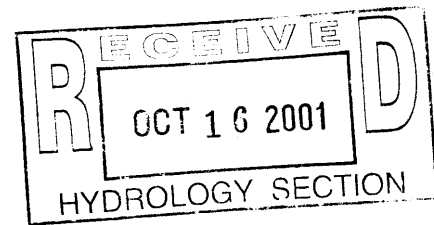

GENERAL NOTES:

1. CONTOUR INTERVAL IS ONE (1) FOOT.
2. ELEVATIONS ARE BASED ON CITY OF ALBUQUERQUE STATION No. "14-J-13", HAVING AN ELEVATION OF 4954.71.
3. UTILITIES SHOWN HEREON ARE IN THEIR APPROXIMATE LOCATION BASED ONLY ON ABOVE GROUND EVIDENCE FOUND IN THE FIELD AND AS-BUILT INFORMATION PROVIDED BY THE CLIENT. UTILITIES SHOWN HEREON, WHETHER INDICATED AS ABANDONED OR NOT, SHALL BE VERIFIED BY OTHERS FOR EXACT LOCATION AND/OR DEPTH PRIOR TO EXCAVATION OR DESIGN CONSIDERATIONS.
5. THIS IS NOT A BOUNDARY SURVEY. BEARINGS AND DISTANCES SHOWN HEREON ARE FOR REFERENCE ONLY.

LEGEND

- 54.00 EXISTING SPOT ELEVATIONS
- 5000 EXISTING CONTOURS
- CONCRETE
- ED EDGE OF ALAMEDA DRAIN
- G GROUND
- EXISTING FENCING

GENERAL:

THIS TRACT OF LAND, TR 306 MRGCD MAP NO. 38, IS AN INFILL PROJECT WEST OF OLD TOWN ON THE N.E. CORNER OF MOUNTAIN RD. AND MONTOYA RD. THE LOT CONTAINS 1.7139 ACRES AFTER PLOTTING AND PROVIDING EXTRA R-O-W FOR MOUNTAIN ROAD AND MONTOYA ROAD. THE TRACT IS TO BE SUBDIVIDED INTO SIX (6) LOTS OF 0.25+ ACRES EACH. MOUNTAIN ROAD HAS A 60' R-O-W, BUT IS CONSTRUCTED ON THE NORTHERN PORTION OF THE R-O-W AND ALBUQUERQUE CITY TRAFFIC HAS REQUESTED NINE (9) FT. FROM THE FACE OF CURB TO THE PROPERTY LINE. THE MOST RECENT USE HAS BEEN AS A HORSE CORRAL, AND CONSEQUENTLY THE SOIL IS VERY PACKED AND VOID OF MOST VEGETATION. THERE IS ALSO EVIDENCE OF AUTOS BEING DRIVEN OVER IT IN PLACES.

EXISTING INFRASTRUCTURE:

MOUNTAIN ROAD HAS CURB, GUTTER, SIDEWALK AND PAVING. IT ALSO HAS SANITARY SEWER, STORM SEWER AND INLETS, WATER, ELECTRICITY, GAS, TELEPHONE, AND CABLE LINES IN PLACE. MONTOYA ROAD IS PAVED AND DOES NOT HAVE STORM SEWERS. STORM WATERS ARE CONVEYED TO THE ALAMEDA DRAIN ONE LOT TO THE WEST OF THIS TRACT VIA MOUNTAIN ROAD. MONTOYA ROAD DRAINS SOUTHWARD TO MOUNTAIN ROAD AND THROUGH THE MOUNTAIN ROAD DRAINAGE SYSTEM TO THE ALAMEDA DRAIN.

EXISTING DRAINAGE:

THE TRACT TO THE NORTH (MRGCD TR 304-A) IS A LARGE APPROXIMATELY SIX (6) ACRE TRACT WHICH CONTAINS THE KABQ RADIO TRANSMISSION TOWER AND IS ZONED RA-2. IT IS UNDEVELOPED AND WELL VEGETATED FROM YEARS OF LYING FALLOW. IT CONTAINS A CLOSED SUMP AREA AT AN ELEVATION OF 4953' WITH A MIN. ELEVATION OF 4952.57'. TRACT 304-A DRAINS NEAR THE N.E. CORNER OF THIS TRACT INTO THE ALAMEDA DRAIN. THE N.E. PORTION OF THIS TRACT (TR 306) ALSO DRAINS INTO THE ALAMEDA DRAIN.

SOME OF THE EASTERN PORTION OF THIS TRACT (306) DRAINS ACROSS THE ADJACENT TR 307-B AND INTO THE ALAMEDA DRAIN ON MOUNTAIN ROAD. THE REMAINDER OF THIS TRACT (306), WESTERN AND SOUTHERN, DRAINS INTO MONTOYA ROAD AND MOUNTAIN ROAD AND THE DRAINAGE IS CONVEYED TO THE ALAMEDA DRAIN.


PROPOSED DRAINAGE PLAN:

THIS DRAINAGE PLAN IS NOT A BUILDING DRAINAGE AND GRADING PLAN FOR OBTAINING A BUILDING PERMIT. IT IS A SUBDIVISION DRAINAGE PLAN TO ASSESS THE ADEQUACY OF THE GRADING PLAN WHEN A SITE SPECIFIC STRUCTURE IS PROPOSED FOR A BUILDING PERMIT. THE DEVELOPER IS NOT A BUILDER, AND THE LOTS WILL BE SOLD TO INDIVIDUALS AND/OR BUILDERS.

THE BASIC SCHEME IS THAT THE LOTS FRONTING ON MONTOYA ROAD AND MOUNTAIN ROAD, LOTS A, C, E, AND F WILL DRAIN TO THE EXISTING DRAINAGE SYSTEM ON MONTOYA AND MOUNTAIN ROADS. THE INTERIOR LOT B AND D, WHICH ARE ACCESSED BY AN ACCESS AND UTILITY EASEMENT, WILL ADHERE TO THE FLAT GRADING SCHEME.

DRAINAGE CALCULATIONS:

FOR PURPOSES OF ESTIMATING FLOWS AND VOLUMES, THE FOLLOWING ASSUMPTIONS WERE MADE:
1. THE DWELLING UNIT WILL BE 2,000 S.F. AND THE DRIVEWAY 500 S.F., GIVING A TOTAL OF 2500 S.F. OF IMPERVIOUS AREA, AND
2. THE REMAINDER OF THE LOT WILL BE LAND TREATMENT B.
THE FOUR LOTS A, C, E, AND F, DRAINING TO MONTOYA AND MOUNTAIN ROADS

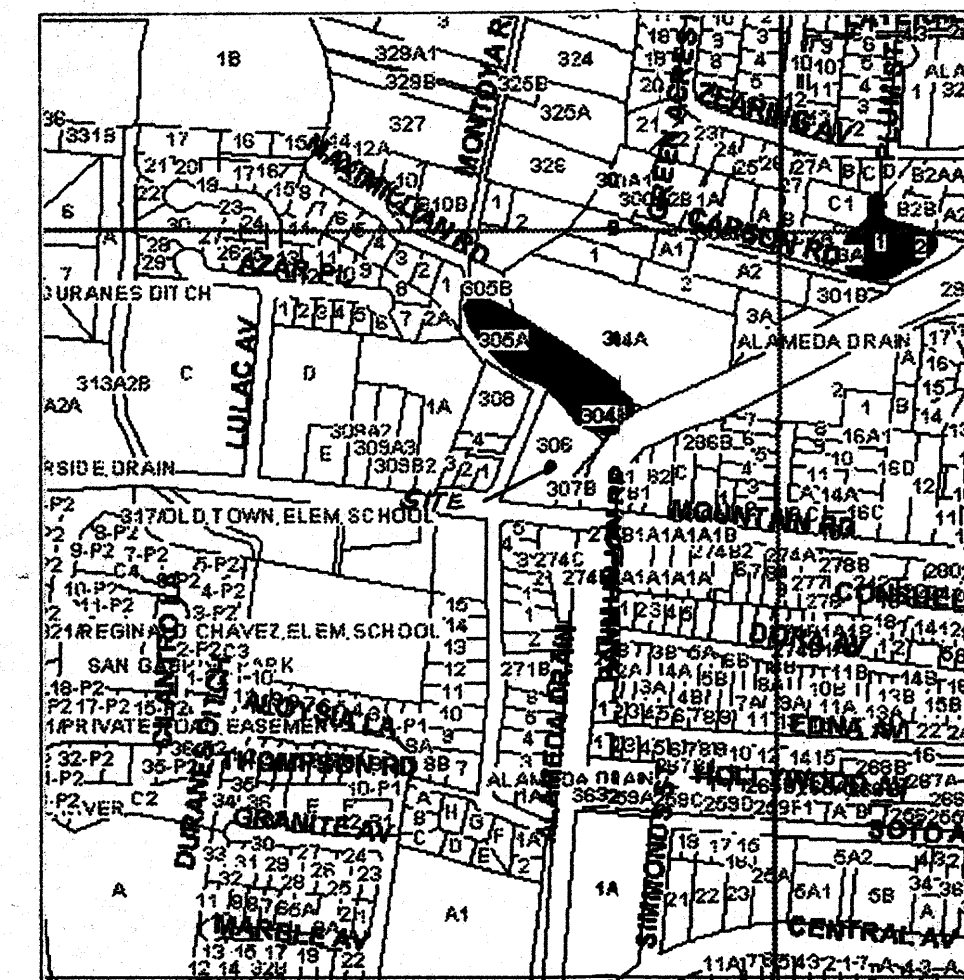

FLOOD INSURANCE RATE MAP
PANEL NO. 35001C0331 D



LOCATION MAP J-12-Z
LEGAL DESCRIPTION: TRACT 306, M.R.G.C.D. NO. 38
BERNALILLO COUNTY, NEW MEXICO
ADDRESS: N.E. CORNER MOUNTAIN RD. & MONTOYA RD., N.W.

CONTAIN A TOTAL AREA OF 1.0954 AC. AND THE TOTAL IMPERVIOUS AREAS (4 X 2500 S.F.) CONTAIN 0.2295 AC. THE LOCATION IS IN PRECIPITATION ZONE 2 AND Q P100 = 2.28 CFS/ AC. TREATMENT B AND 4.70 CFS/ AC. TREATMENT D.

$$Q P100 = A B Q P B + A d Q P D \\ = (0.2295) (4.70) + (1.0954 - 0.2295) (2.28) \\ = 3.0528 \text{ CFS FOR ALL FOUR LOTS.}$$

THE EXISTING RUNOFF IS ESTIMATED BY Q P = 3.14 CFS/ AC.

$$\text{TREATMENT C, OR} \\ Q P100 = (1.0954) (3.14) = 3.44 \text{ CFS FOR ALL FOUR LOTS.}$$

THEREFORE THE EXISTING AND PROPOSED DRAINAGE ARE APPROXIMATELY THE SAME.

LOTS B AND D FLAT GRADING:

$$\text{LOT B E 6 HR. 100 YR. TREAT. B} = 0.78 \text{ IN. AND TREAT D} = 2.12 \text{ IN.} \\ V_{6 \text{ HR. 100 YR}} A B E B / 12 + A d E D / 12 \\ = [(43560) (0.3200) - 2500] 0.78 / 12 + (2500) (2.12 / 12) \\ = 743.55 + 441.67 = 1185.22 \text{ CF}$$

$$V_{10 \text{ DAY}} = V_{360} + A d (P_{10 \text{ DAY}} - P_{360}) \\ = 1185.22 + (2500) (3.95 - 2.20) / 12 \\ = 1185.22 + 364.58 = 1549.80 \text{ CF}$$

$$\text{AVERAGE DEPTH PERVIOUS AREA} = V / A \\ = (1549.80 / 11439.2) (12) \\ = 1.63 \text{ IN.}$$


$$\text{LOT D E 6 HR. 100 YR. TREAT. B} = 0.78 \text{ IN. AND TREAT D} = 2.12 \text{ IN.} \\ V_{6 \text{ HR. 100 YR}} A B E B / 12 + A d E D / 12 \\ = [(43560) (0.2985 - 2500) 0.78 / 12 + (2500) (2.12 / 12) \\ = 682.64 + 441.7 = 1124.34 \text{ CF}$$

$$V_{10 \text{ DAY}} = V_{360} + A d (P_{10 \text{ DAY}} - P_{360}) / 12 \\ = 1124.34 + 364.58 \\ = 1488.92 \text{ CF}$$



$$\text{AVERAGE DEPTH PERVIOUS AREA} = V / A \\ = (1488.92 / 10502.66) (12) \\ = 1.70 \text{ IN.}$$

FLOOD HAZARD:

FIRM MAP PANEL 331 OF 825 SHOWS A FLOOD PLAIN TOUCHING THE N.P.L. OF THIS TRACT WITH AN AH ZONE OF EL. 4955. SINCE THIS MUST BE HONORED OR CHANGED, NO FINISH FLOOR ELEVATIONS OF DWELLING UNITS ON THE SUBDIVISION SHOULD BE LESS THAN 4956. IN ORDER TO INSURE THAT THIS DRAINAGE PLAN IS ADHERED TO, A HEADER CURB OF EL. 4956 SHOULD BE CONSTRUCTED AT THE NORTH AND EAST PROPERTY LINE AS SHOWN. THIS WILL INSURE THAT THE DRAINAGE TO THE TWO SURROUNDING TRACTS WILL BE ELIMINATED, AND THE RUNOFF WILL BE TO THE INTENDED AREAS.

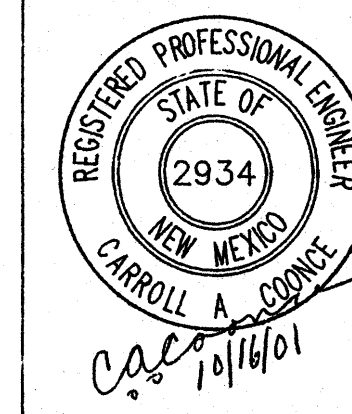

C.A. COONCE & ASSOC., INC.	
ENVIRONMENTAL, WATER RESOURCES, & SANITARY CONSULTING ENGINEERS	
12324 PINERIDGE N.E. ALBUQUERQUE, N.M. 87112	
PH (505) 298-1056 FAX (505) 298-0478	
TITLE DRAINAGE PLAN	
PROJECT TR. 306, MRGCD MAP NO. 38	
DATE	10/10/01
DRAWN	LSC
CHECKED	CAC
SHEET 1 of 1	

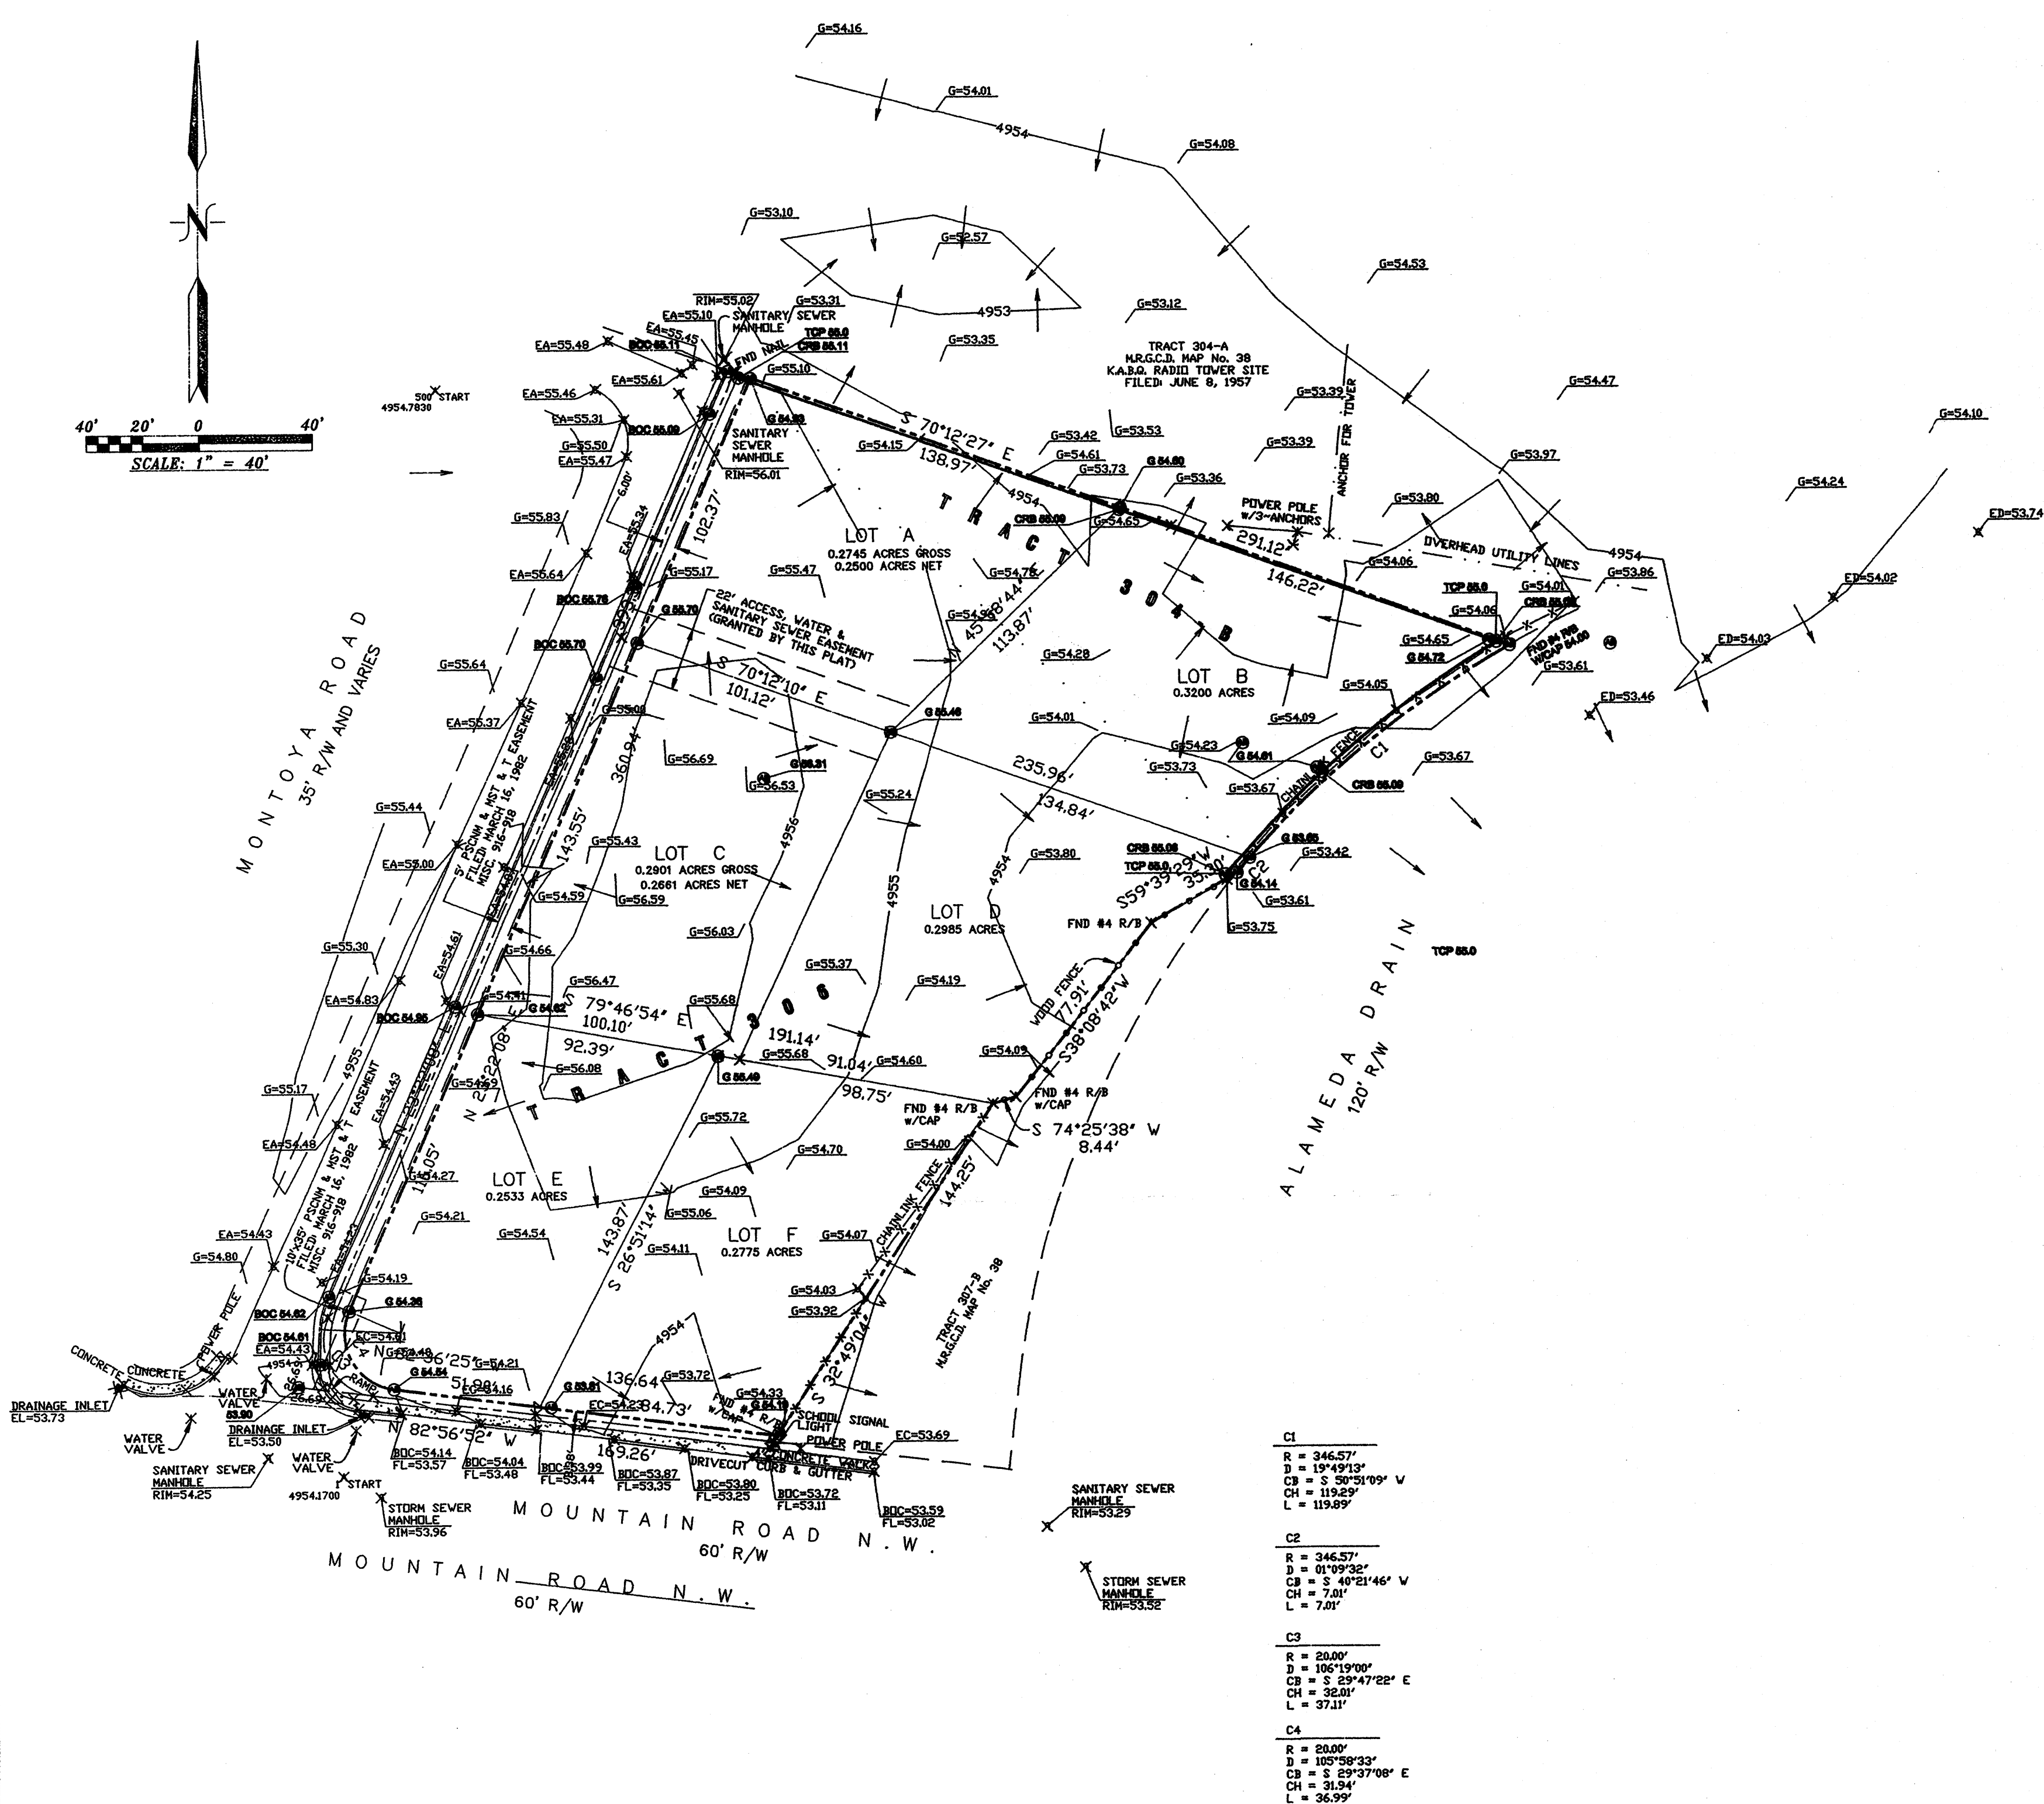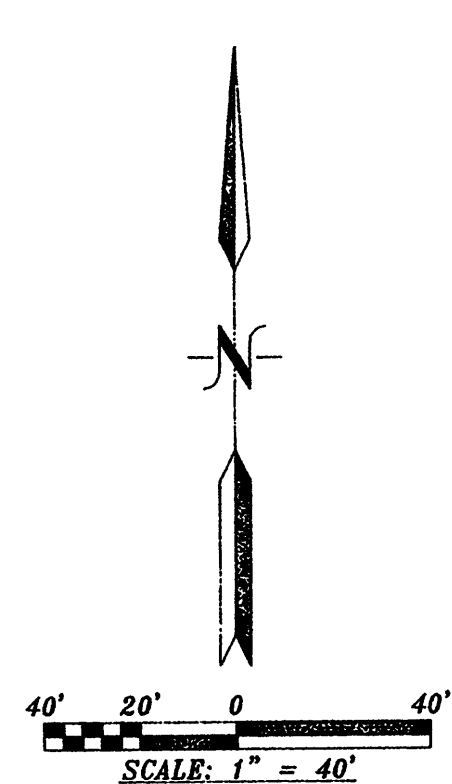

C1	R = 346.57'
	D = 19°47'13"
	CH = S 50°51'09" W
	L = 119.29'
	L = 119.29'
C2	R = 346.57'
	D = 01°09'32"
	CH = S 40°21'46" W
	L = 7.01'
	L = 7.01'
C3	R = 20.00'
	D = 100°19'00"
	CH = S 59°47'22" E
	L = 32.01'
	L = 32.01'
C4	R = 20.00'
	D = 105°58'33"
	CH = S 59°37'00" E
	L = 31.94'
	L = 36.99'

- GENERAL NOTES:
- 1: CONTOUR INTERVAL IS ONE (1) FOOT.
 - 2: ELEVATIONS ARE BASED ON CITY OF ALBUQUERQUE STATION No. "14-J-13", HAVING AN ELEVATION OF 4954.71.
 - 3: UTILITIES SHOWN HEREON ARE IN THEIR APPROXIMATE LOCATION BASED ONLY ON ABOVE GROUND EVIDENCE FOUND IN THE FIELD AND AS-BUILT INFORMATION PROVIDED BY THE CLIENT. UTILITIES SHOWN HEREON, WHETHER INDICATED AS ABANDONED OR NOT, SHALL BE VERIFIED BY OTHERS FOR EXACT LOCATION AND/OR DEPTH PRIOR TO EXCAVATION OR DESIGN CONSIDERATIONS.
 - 5: THIS IS NOT A BOUNDARY SURVEY. BEARINGS AND DISTANCES SHOWN HEREON ARE FOR REFERENCE ONLY.

- LEGEND
- 54.00 EXISTING SPOT ELEVATIONS
 - 5000 EXISTING CONTOURS
 - RD CONCRETE
 - ED EDGE OF ALAMEDA DRAIN
 - G GROUND
 - EXISTING FENCING
 - AS-BUILT EL. PT.
 - BACK OF CURB EL. AS-BUILT
 - GROUND EL. AS-BUILT
 - HEADER CURB EL. AS-BUILT
 - TOP HEADER CURB EL. PROPOSED


DRAINAGE PLAN GRADING CERTIFICATION

SHOWN ON THIS DRAWING ARE THE AS-BUILT LOCATION AND ELEVATIONS OF THE HEADER CURB REQUIRED FOR APPROVAL ON THE INFRASTRUCTURE LIST FOR DRB 1001011. THIS SUBDIVISION IS IN SUBSTANTIAL COMPLIANCE WITH THE APPROVED GRADING PLAN.


C.A. Coonce

C. A. COONCE N.M.P.E. #2934

OCTOBER 2, 2002
DATE

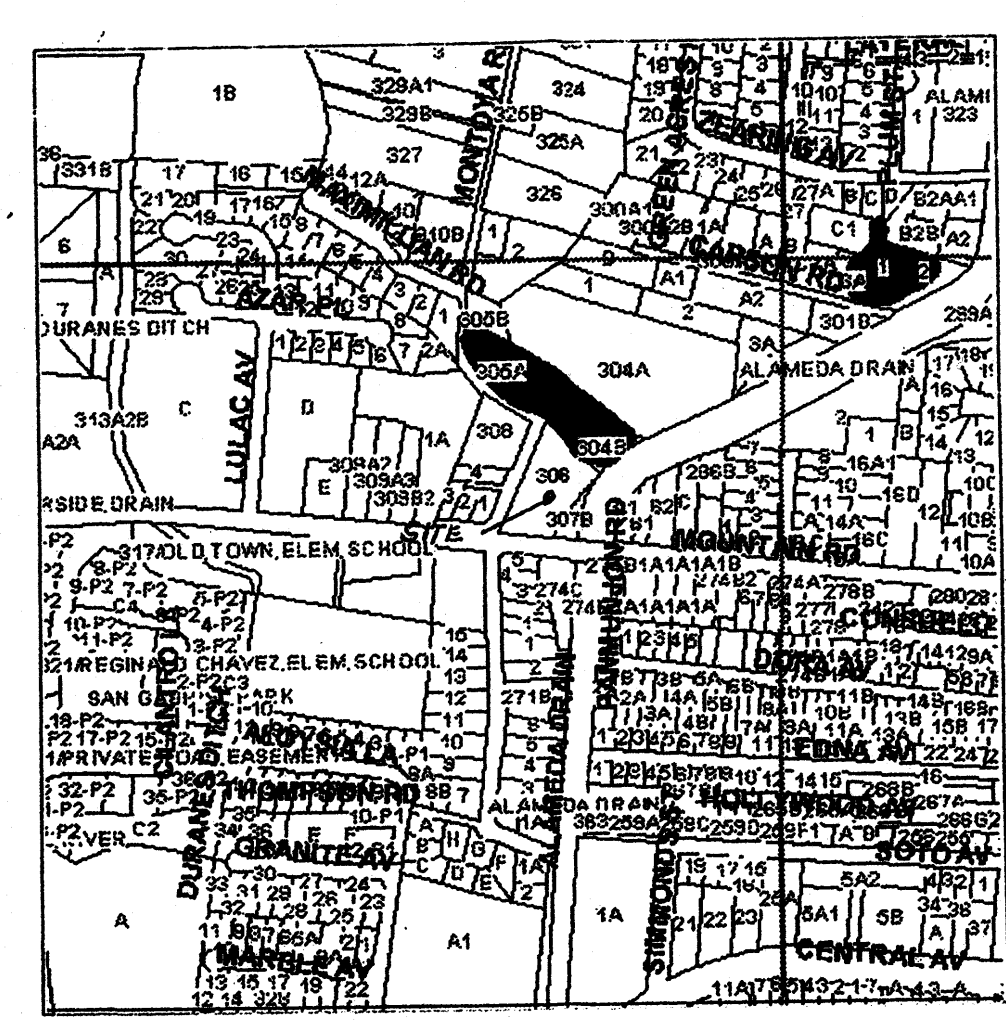

FLOOD INSURANCE RATE MAP
PANEL NO. 35001C0331 D

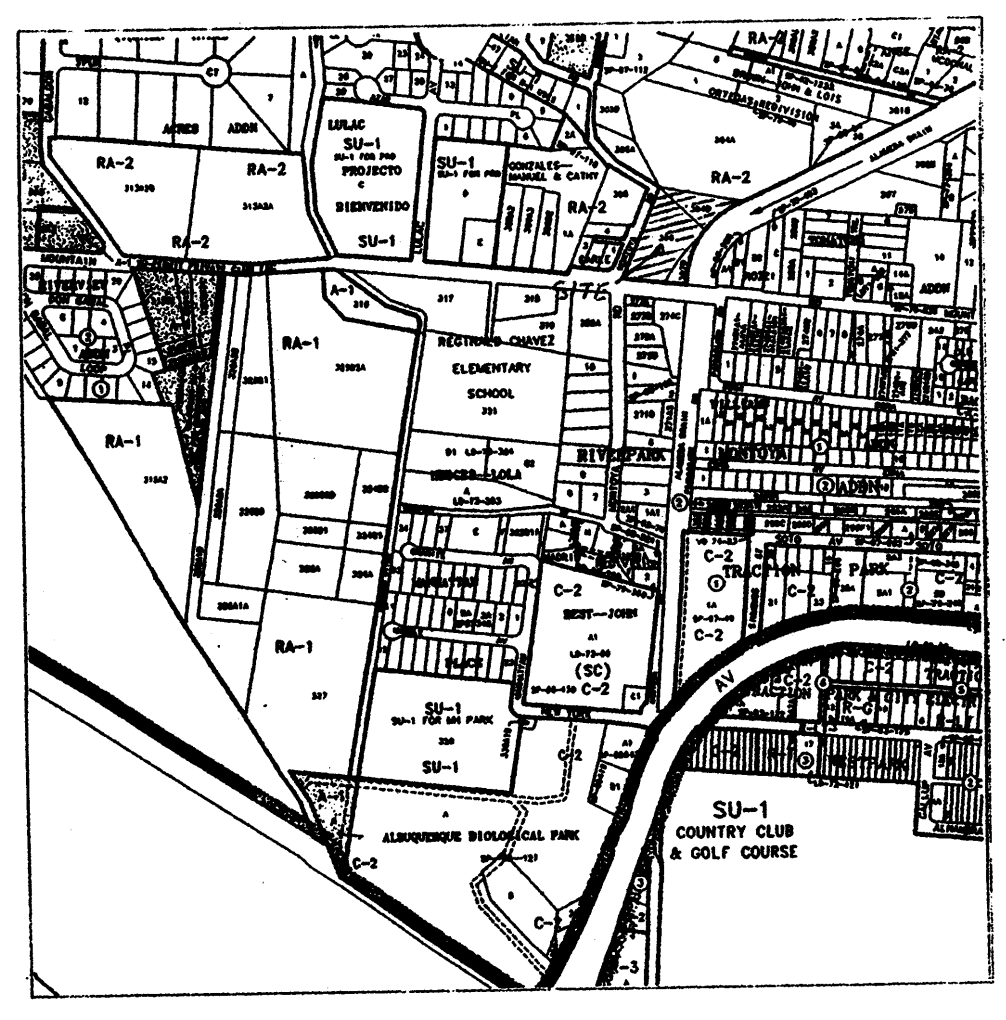

LOCATION MAP J-12-Z
LEGAL DESCRIPTION: TRACT 306, M.R.G.C.D. NO. 38
BERNALILLO COUNTY, NEW MEXICO
ADDRESS: N.E. CORNER MOUNTAIN RD. & MONTOYA RD., N.W.

GENERAL:

THIS TRACT OF LAND, TR 306 MRGCD MAP NO. 38, IS AN INFILL PROJECT WEST OF OLD TOWN ON THE N.E. CORNER OF MOUNTAIN RD. AND MONTOYA RD. THE LOT CONTAINS 1.7139 ACRES AFTER PLOTTING AND PROVIDING EXTRA R-O-W FOR MOUNTAIN ROAD AND MONTOYA ROAD. THE TRACT IS TO BE SUBDIVIDED INTO SIX (6) LOTS OF 0.25+ ACRES EACH. MOUNTAIN ROAD HAS A 60' R-O-W, BUT IS CONSTRUCTED ON THE NORTHERN PORTION OF THE R-O-W AND ALBUQUERQUE CITY TRAFFIC HAS REQUESTED NINE (9) FT. FROM THE FACE OF CURB TO THE PROPERTY LINE. THE MOST RECENT USE HAS BEEN AS A HORSE CORRAL, AND CONSEQUENTLY THE SOIL IS VERY PACKED AND VOID OF MOST VEGETATION. THERE IS ALSO EVIDENCE OF AUTOS BEING DRIVEN OVER IT IN PLACES.

EXISTING INFRASTRUCTURE:

MOUNTAIN ROAD HAS CURB, GUTTER, SIDEWALK AND PAVING. IT ALSO HAS SANITARY SEWER, STORM SEWER AND INLETS, WATER, ELECTRICITY, GAS, TELEPHONE, AND CABLE LINES IN PLACE. MONTOYA ROAD IS PAVED AND DOES NOT HAVE STORM SEWERS. STORM WATERS ARE CONVEYED TO THE ALAMEDA DRAIN ONE LOT TO THE WEST OF THIS TRACT VIA MOUNTAIN ROAD. MONTOYA ROAD DRAINS SOUTHWARD TO MOUNTAIN ROAD AND THROUGH THE MOUNTAIN ROAD DRAINAGE SYSTEM TO THE ALAMEDA DRAIN.

EXISTING DRAINAGE:

THE TRACT TO THE NORTH (MRGCD TR 304-A) IS A LARGE APPROXIMATELY SIX (6) ACRE TRACT WHICH CONTAINS THE KABQ RADIO TRANSMISSION TOWER AND IS ZONED RA-2. IT IS UNDEVELOPED AND WELL VEGETATED FROM YEARS OF LYING FALLOW. IT CONTAINS A CLOSED SWAMP AREA AT AN ELEVATION OF 4953' WITH A MIN. ELEVATION OF 4952.57'. TRACT 304-A DRAINS NEAR THE N.E. CORNER OF THIS TRACT INTO THE ALAMEDA DRAIN. THE N.E. PORTION OF THIS TRACT (TR 306) ALSO DRAINS INTO THE ALAMEDA DRAIN.

SOME OF THE EASTERN PORTION OF THIS TRACT (306) DRAINS ACROSS THE ADJACENT TR 307-B AND INTO THE ALAMEDA DRAIN ON MOUNTAIN ROAD. THE REMAINDER OF THIS TRACT (306), WESTERN AND SOUTHERN, DRAINS INTO MONTOYA ROAD AND MOUNTAIN ROAD AND THE DRAINAGE IS CONVEYED TO THE ALAMEDA DRAIN.

PROPOSED DRAINAGE PLAN:

THIS DRAINAGE PLAN IS NOT A BUILDING DRAINAGE AND GRADING PLAN FOR OBTAINING A BUILDING PERMIT. IT IS A SUBDIVISION DRAINAGE PLAN TO ASSESS THE ADEQUACY OF THE GRADING PLAN WHEN A SITE SPECIFIC STRUCTURE IS PROPOSED FOR A BUILDING PERMIT. THE DEVELOPER IS NOT A BUILDER, AND THE LOTS WILL BE SOLD TO INDIVIDUALS AND/OR BUILDERS.

THE BASIC SCHEME IS THAT THE LOTS FRONTING ON MONTOYA ROAD AND MOUNTAIN ROAD, LOTS A, C, E, AND F WILL DRAIN TO THE EXISTING DRAINAGE SYSTEM ON MONTOYA AND MOUNTAIN ROADS. THE INTERIOR LOT B AND D, WHICH ARE ACCESSED BY AN ACCESS AND UTILITY EASEMENT, WILL ADHERE TO THE FLAT GRADING SCHEME.

DRAINAGE CALCULATIONS:

FOR PURPOSES OF ESTIMATING FLOWS AND VOLUMES, THE FOLLOWING ASSUMPTIONS WERE MADE:

1. THE DWELLING UNIT WILL BE 2,000 S.F. AND THE DRIVEWAY 500 S.F., GIVING A TOTAL OF 2500 S.F. OF IMPERVIOUS AREA, AND
2. THE REMAINDER OF THE LOT WILL BE LAND TREATMENT B.

THE FOUR LOTS A, C, E, AND F, DRAINING TO MONTOYA AND MOUNTAIN ROADS

CONTAIN A TOTAL AREA OF 1.0954 AC. AND THE TOTAL IMPERVIOUS AREAS (4 X 2500 S.F.) CONTAIN 0.2285 AC. THE LOCATION IS IN PRECIPITATION ZONE 2 AND Q P100 = 2.28 CFS/ AC. TREATMENT B AND 4.70 CFS/ AC. TREATMENT D.

$Q_{P100} = A \cdot B \cdot C + D \cdot C \cdot D$

$= (0.2285) (4.70) + (1.0954 - 0.2285) (2.28)$

$= 3.6528 \text{ CFS FOR ALL FOUR LOTS.}$

THE EXISTING RUNOFF IS ESTIMATED BY $Q_{P100} = 3.14 \text{ CFS/ AC.}$

TREATMENT C, OR

$Q_{P100} = (1.0954) (3.14) = 3.44 \text{ CFS FOR ALL FOUR LOTS.}$

THEREFORE THE EXISTING AND PROPOSED DRAINAGE ARE APPROXIMATELY THE SAME.

LOTS B AND D FLAT GRADING:

LOT B E 6 HR. 100 YR. TREAT. B = 0.78 IN. AND TREAT D = 2.12 IN.

$V_{6HR, 100 YR.} = A \cdot B \cdot E / 12 + A \cdot D \cdot E / 12$

$= [(43560) (0.3200) - 2500] 0.78 / 12 + (2500) (2.12 / 12)$

$= 743.55 + 441.67 = 1185.22 \text{ CF}$

$V_{10 DAY} = V_{360} + A \cdot D \cdot (P_{10 DAY} - P_{360})$

$= 1185.22 + (2500) (3.85 - 2.20) / 12$

$= 1185.22 + 364.58 = 1549.80 \text{ CF}$

AVERAGE DEPTH PERVIOUS AREA = V / A

$= (1549.80 / 11439.2) (12)$

$= 1.63 \text{ IN.}$

LOT D E 6 HR. 100 YR. TREAT. B = 0.78 IN. AND TREAT D = 2.12 IN.

$V_{6HR, 100 YR.} = A \cdot B \cdot E / 12 + A \cdot D \cdot E / 12$

$= [(43560) (0.2285) - 2500] 0.78 / 12 + (2500) (2.12 / 12)$

$= 682.64 + 441.67 = 1124.34 \text{ CF}$

$V_{10 DAY} = V_{360} + A \cdot D \cdot (P_{10 DAY} - P_{360}) / 12$

$= 1124.34 + 364.58$

$= 1488.92 \text{ CF}$


AVERAGE DEPTH PERVIOUS AREA = V / A

$= (1488.92 / 10502.66) (12)$

$= 1.70 \text{ IN.}$

FLOOD HAZARD:

FIRM MAP PANEL 531 OF 825 SHOWS A FLOOD PLAN TOUCHING THE N.P.L. OF THIS TRACT WITH AN AH ZONE OF EL. 4955. SINCE THIS MUST BE HONORED OR CHANGED, NO FINISH FLOOR ELEVATIONS OF DWELLING UNITS ON THE SUBDIVISION SHOULD BE LESS THAN 4955. IN ORDER TO INSURE THAT THIS DRAINAGE PLAN IS ADHERED TO, A HEADER CURB OF EL. 4955 SHOULD BE CONSTRUCTED AT THE NORTH AND EAST PROPERTY LINE AS SHOWN. THIS WILL INSURE THAT THE DRAINAGE TO THE TWO SURROUNDING TRACTS WILL BE ELIMINATED, AND THE RUNOFF WILL BE TO THE INTENDED AREAS.

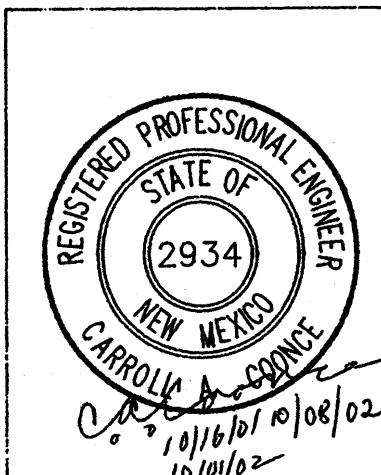

C.A. COONCE & ASSOC., INC.

ENVIRONMENTAL, WATER RESOURCES, & SANITARY CONSULTING ENGINEERS

12324 PINERIDGE N.E. ALBUQUERQUE, N.M. 87112

PH (505) 298-1056 FAX (505) 298-0478

TITLE **DRAINAGE PLAN**

PROJECT **TR. 306, MRGCD MAP NO. 38**

DATE 10/10/01
DRAWN LSC
CHECKED CAC

REVISED 10/01/02
10/08/02

SHEET 1 of 1