CITY OF ALBUQUERQUE



Planning Department Transportation Development Services

June 11, 2015

Doug Heller, AIA Mullen Heller Architecture, P.C. 924 Park Ave., SW Albuquerque, NM 87102

Re: Country Club Plaza – Commercial Building 1 1718 Central Ave., SW Certificate of Occupancy – Transportation Development Engineer's/Architect's Stamp dated 3-28-14 (J13-D010) Certification dated 6-10-15

Dear Mr. Heller,

PO Box 1293

Based upon the information provided in your submittal received 6-10-15, Transportation Development has no objection to the issuance of a <u>Permanent</u> <u>Certificate of Occupancy</u>. This letter serves as a "green tag" from Transportation Development for a <u>Permanent Certificate of Occupancy</u> to be issued by the Building and Safety Division.

Albuquerque

If you have any questions, please contact me at (505)924-3924.

New Mexico 87103 Sincerely,

www.cabq.gov

Jeanne Wolfenbarger, P.E. Senior Engineer, Planning Dept. Development Review Services

c: File CO Clerk



City of Albuquerque

Planning Department

Development & Building Services Division

DRAINAGE AND TRANSPORTATION INFORMATION SHEET

(REV 02/2013)

DRB#; EPC#; Work Order#; Legal Description: Lof d Country Club Plaza Subdivision City Address: 1918 Central Avenue SW, Abaquerque, NM 87104 Engineering Firm: Mark Goodwin & Associates, P.A Contact: Mark Goodwin agineers.com Owner: Rembe Country Club LLC. Contact: Jay Rembe Address: 1916 Entral SW, Suite A. Abuquerque, NM 87104	Project Title: Country Club Plaza – Commercial Bu	uilding 1 Building P	ermit #: T201492581 City Drainage #:
City Address: 1118 Contral Avenue SW, Albuquerque, NM. 87104 Engineering Firm: Mark Goodwin & Associates, P.A Contact: Mark Goodwin Address: 1816-8 Adams Street, NE, Albuquerque, NM. 87113 E-mail: mark@goodwinengineers.com Owner: Rembe Country Club LLC. Contact:: Jay Rembe Address: 1716 Contral SW, Sulte A, Albuquerque, NM. 87104 Contact:: Jay Rembe@rembedesign.com Phone#: 505-6453-7164 Fax#: E-mail: rembe@rembedesign.com Architect: Multen Heller Architecture P.C Contact:: Joug@mullenheller.com Surveyor: Construction Survey Technologies, INC. Contact:: Joug@mullenheller.com Surveyor: Construction Survey Technologies, INC. Contact:: Joug@mullenheller.com Contractor: Insight Construction Contact::	DRB#:	EPC#:	Work Order#:
Figurecring Firm: Mark Goodwin & Associates, P.A Contact: Mark Goodwin Address: 8916-B Adams Street, NE, Abuquerque, NM 87113 E-mail: mark@goodwinengineers.com Owner: Fear#: E-mail: mark@goodwinengineers.com Owner: Rembe Country Club LLC. Contact: Jay Rembe Address: 1718 Central SW, Suite A, Albuquerque, NM 87104 Phone#: Fear#: E-mail: rembe@rembedesign.com Architect: Mulen Heller Architecture P.C Contact: Doug Heller Address: 924 Park Avenue SW, Suite B Albuquerque, NM 87102 Phone#: 505-286-4144 Fax#: E-mail: doug@mullenheller.com Surveyor: Construction Survey Technologies, INC. Contact: John Gailegoes Address: 9206 248-144 Fax#: E-mail: doug@mullenheller.com Surveyor: Construction Contact: John Gailegoes Address: 9209 12h Street, Albuquerque, NM 87103 Phone#: 50-548-7827 Phone#: 505-488-7827 Fax#: E-mail: damian@insightm.com Contact: Isinght Construction Contact: John Sailegoes	Legal Description: Lot 4 of Country Club Plaza Su	ubdivision	
Address: 8916-B.Adams Street, NE, Albuquerque, NM 87113 Phone#: 605-828-2200 Fax#: Contact: Jay Rembe Address: 1718 Central SW, Suite A, Albuquerque, NM 87104 Phone#: 505-453-7164 Fax#: Contact: Jay Rembe Address: 254-853-7164 Fax#: E-mail: remb@grembedesign.com Architect: Mulen Heller Architecture P.C Contact: Contract: Soug Heller Address: 254-864-144 Fax#: Surveyor: Construction Survey Technologies, INC. Contact: Surveyor: Construction Contact: Sof-268-4144 Fax#: E-mail: Sof-268-4144 Fax#: E-mail: Surveyor: Construction Contact: Address: 906-917-8921 Fax#: Contract: Jamina Chimenil Address: 909-12h Street, Abuquerque, NM 87107 Phone#: 505-888-7927 Fax#: DRAINAGE REPORT SIA/FINANCIAL GUARANTER ELEASE DRAINAGE PLAN Ist SUBMITTAL SLEV PLAN FOR SUB/D APROVAL	City Address: 1718 Central Avenue SW., Albuquer	rque, NM. 87104	
Phone#: 505-828-2200 Fax#: E-nail: mark@goodwinengineers.com Owner: Rembe Country Club LLC. Contact: Jay Rembe Address: 1718 Contral SW. Suite A. Albuquerque, NM. 87104 Fax#: E-mail: rembe@rembedesign.com Architect: Mulen Heller Architecture P.C Contact: Doug Heller Address: 924 Park Avenue SW, Suite B. Albuquerque, NM 87102 Phone#: 505-268-4144 Fax#: E-mail: doug@mullenheller.com Surveyor: Construction Survey Technologies, INC. Contact: John Gallegos Address: P.o. Box 65395 Albuquerque, NM 87103 Phone#: 505-917-8221 Fax#: E-mail: johndgallegos73@gmail.com Contractor: Insight Construction Contact: Damian Chimenti Address: 3090 12th Street, Albuquerque, NM 87107 Phone#: 505-688-7927 Fax#: E-mail: demine@insightm.com TYPE OF SUBMITTAL: CHECK TYPE OF APPROVAL/ACCEPTANCE SOUGHT: SIA/FINANCIAL GUARANTEE RELEASE DRAINAGE PLAN IST SUBMITTAL SDEV. PLAN PROVAL SDEV. PLAN PROVAL DRAINAGE PLAN RESUBMITTAL SDEV. PCAN PROTVAL SDEV. PCAN PROVAL SDECTOR PLAN APPROVAL SDE	Engineering Firm: Mark Goodwin & Associates	5, P.A	Contact: Mark Goodwin
Owner: Rembe Country Club LLC. Contact: Jay Rembe Address: 1718 Central SW, Suite A, Abbuquerque, NM. 87104 Fax#; E-mail: rembe@rembedesign.com Architect: Mulen Heller Architecture P.C Contact: Doug Heller Address: 924 Park Avenue SW, Suite B Abbuquerque, NM 87102 Phone#: 505-288-4144 Fax#; E-mail: doug@mullenheller.com Surveyr: Construction Survey Technologies, INC. Contact: John Gallegos Address: 305-288-4144 Fax#; E-mail: doug@mullenheller.com Surveyr: Construction Survey Technologies, INC. Contact: John Gallegos Address: John Gallegos Address: 3009 12h Street, Albuquerque, NM 87103 Phone#: 505-888-7927 Fax#; E-mail: damian@insightm.com TYPE OF SUBMITTAL: Contact: DarkinAcGE PLAN N 87107 Phone#: SixAFINANCIAL GUARANTEE RELEASE DRAINAGE PLAN NES UBMITTAL SixELIMINARY PLAT APPROVAL/ACCEPTANCE SOUGHT: SIAFINANCIAL GUARANTEE RELEASE DRAINAGE PLAN RESUBMITTAL SixECTOR PLAN APROVAL Six DEV. PLAN FOR SUBd APPROVAL GRADING PLAN	Address: 8916-B Adams Street, NE., Albuquerque	e, NM 87113	
Address: 1718 Central SW, Suite A, Abuquerque, NM, 87104 Phone#; 505453-7164 Fax#; E-mail: rembe@rembedesign.com Architect: Mulen Heller Architecture P.C Contact: Doug Heller Address: 924 Park Avenue SW, Suite B Abuquerque, NM 87102 E-mail: doug@mullenheller.com Surveyor: Construction Survey Technologies, INC. Contact: John Gallegos Address: 924 Park Avenue SW, Suite B Abuquerque, NM 87102 Contact: John Gallegos Surveyor: Construction Survey Technologies, INC. Contact: John Gallegos Address: 3909 12th Street, Albuquerque, NM 87107 Contact: Damian Chimenti Address: 3909 12th Street, Albuquerque, NM 87107 E-mail: demian@insightm.com Phone#: 505-888-7927 Fax#: E-mail: demian@insightm.com TYPE OF SUBMITTAL: CHECK TYPE OF APPROVAL/ACCEPTANCE SOUGHT: SIA/FINANCIA L GURANTEE RELEASE DRAINAGE PLAN Is SUBMITTAL S. DEV. PLAN FOR SUB@ APPROVAL	Phone#: 505-828-2200	Fax#:	E-mail: mark@goodwinengineers.com
Phone#: 505-453-7184 Fax#: E-mail: rembe@rembedesign.com Architect: Mullen Heller Architecture P.C Contact: Doug Heller Address: 924 Park Avenue SW, Suite B Albuquerque, NM 87102 E-mail: doug@mullenheller.com Surveyor: Construction Survey Technologies, INC. Contact: John Gallegos Address: P.0. Box 65395 Albuquerque, NM 87103 E-mail: johndgalegos73@gmail.com Phone#: 505-917-8921 Fax#: E-mail: johndgalegos73@gmail.com Contractor: Insight Construction Contact: Damian Chimenti Address: 3909 12th Street, Albuquerque, NM 87107 Fax#: E-mail: damian@insightm.com TYPE OF SUBMITTAL: Contact: Damian Chimenti Address: 3009 12th Street, Albuquerque, NM 87107 Phone#: 505-888-7927 Fax#: E-mail: damian@insightm.com TYPE OF SUBMITTAL: Check TYPE OF APPROVAL/ACCEPTANCE SOUGHT: SIA/FINANCIAL GUARANTER RELEASE DRAINAGE PLAN Ist SUBMITTAL S. DEV. PLAN POR VALUE DA PPROVAL GRADING PLAN S. DEV. PLAN APROVAL ScCTOR PLAN APPROVAL GRADING PLAN ScECTOR PLAN APPROVAL	Owner: Rembe Country Club LLC.		Contact: Jay Rembe
Architect: Mullen Heller Architecture P.C Contact: Doug Heller Address: 924 Park Avenue SW, Suite B Albuguerque, NM 87102 E-mail: doug@mullenheller.com Phone#: 505-268-4144 Fax#: E-mail: doug@mullenheller.com Surveyor: Construction Survey Technologies, INC. Contact: John Gallegos Address: P.o. Box 65395 Albuguerque, NM 87193 E-mail: johndgallegos73@gmail.com Contractor: Insight Construction Contact: Damian Chimenti Address: 3909 12th Street, Albuguerque, NM 87107 E-mail: damian@insightnm.com Phone#: 505-888-7927 Fax#: E-mail: damian@insightnm.com TYPE OF SUBMITTAL: CHECK TYPE OF APPROVAL/ACCEPTANCE SOUGHT: SIA/FINANCIAL GUARANTEE RELEASE DRAINAGE PLAN Ist SUBMITTAL PRELIMINARY PLAT APPROVAL ConceptuaL G & D PLAN S. DEV. FOR SUB.do APPROVAL GRADING PLAN S. DEV. PLAN FOR SUB.do APPROVAL S. DEV. FOR SUB.do APPROVAL EROSION & SEDIMENT CONTROL PLAN (ESC) FINAL PLAT APPROVAL ENGINEER& CERT (HYDROLOGY) X CERTIFICATE OF OCCUPANCY (TCL TEMP) TRAFFIC CIRCULATION REAVELY (TCL) FOUNDATION PERMIT APPROVAL ENGINEER& CERT (CAL)	Address: 1718 Central SW, Suite A, Albuquerque,	NM. 87104	
Address: 924 Park Avenue SW, Suite B Albuquerque, NM 87102 Phone#: 505-268-4144 Fax#: E-mail: doug@mullenheller.com Surveyor: Construction Survey Technologies, INC. Contract: John Gallegos Address: P.o. Box 65395 Albuquerque, NM 87193 E-mail: johndgallegos73@gmail.com Phone#: 505-917-8921 Fax#: E-mail: johndgallegos73@gmail.com Contractor: Insight Construction Contract: Damian Chimenti Address: 3909 12th Street, Albuquerque, NM 87107 Phone#: 505-888-7927 Fax#: E-mail: damian@insightm.com TYPE OF SUBMITTAL: CHECK TYPE OF APPROVAL/ACCEPTANCE SOUGHT: SIA/FINANCIAL GUARANTEE RELEASE PRELIMINARY PLAT APPROVAL DRAINAGE PLAN Ist SUBMITTAL S. DEV. FOR BLDG. PERMIT APPROVAL S. DEV. PLAN FOR SUBd APPROVAL GRADING PLAN S. DEV. FOR BLDG. PERMIT APPROVAL SECTOR PLAN APPROVAL SECTOR PLAN APPROVAL ENGINEER& CERT (HYDROLOGY) X CERTIFICATE OF OCCUPANCY (PERM) CERTIFICATE OF OCCUPANCY (PERM) CLOMR/LOMR CERTIFICATE OF OCCUPANCY (TCL TEMP) TRAFFIC CIRCULATION LAYOUT (TCL) BUILDING PERMIT APPROVAL ENGINEER& CERT (DRD SITE PLAN) GRADING PERMIT	Phone#: 505-453-7164	Fax#:	E-mail: rembe@rembedesign.com
Phone#: 505-288-4144 Fax#: E-mail: doug@mullenheller.com Surveyor: Construction Survey Technologies, INC. Contact: John Gallegos Address: P.o. Box 65395 Albuquerque, NM 87193 E-mail: john Gallegos73@gmail.com Phone#: 505-917-8921 Fax#: E-mail: john Gallegos73@gmail.com Contractor: Insight Construction Contact: Damian Chimenti Address: 3909 12h Street, Albuquerque, NM 87107 Phone#: 505-888-7927 Fax#: E-mail: damian@insightmm.com TYPE OF SUBMITTAL: CHECK TYPE OF APPROVAL/ACCEPTANCE SOUGHT: SIA/FINANCIAL GUARANTEE RELEASE DRAINAGE PLAN 1st SUBMITTAL SIA/FINANCIAL GUARANTEE RELEASE DRAINAGE PLAN Ist SUBMITTAL S. DEV. PLAN FOR SUB&Ø APPROVAL SDEV. FOR BLDG. PERMIT APPROVAL GRADING PLAN S. DEV. FOR BLDG. PERMIT APPROVAL SDECTOR PLAN APPROVAL EROSION & SEDIMENT CONTROL PLAN (ESC) FINAL PLAT APPROVAL EROSION & SEDIMENT CONTROL PLAN (ESC) ENGINEER& CERT (HYDROLOGY) X CERTIFICATE OF OCCUPANCY (PERM) CLOMR/LOMR CERTIFICATE OF OCCUPANCY (PERM) CLOMR/LOMR CERTIFICATE OF OCCUPANCY (PERM) GRADING PERMIT APPROVAL ESC PERMIT APPROVAL ENGI	Architect: Mullen Heller Architecture P.C		Contact: Doug Heller
Surveyor: Construction Survey Technologies, INC. Contact: John Gailegos Address: P.o. Box 65395 Albuquerque, NM 87193 P.o. Box 65395 Albuquerque, NM 87193 P.o. Box 65395 Albuquerque, NM 87193 Phone#: 505-917-8921 Fax#; E-mail: johndgailegos73@gmail.com Contractor: Insight Construction Contact: Damin Chimenti Address: 3909 12th Street, Albuquerque, NM 87107 Phone#: 505-888-7927 Fax#; E-mail: damian@insightmm.com TYPE OF SUBMITTAL: CHECK TYPE OF APPROVAL/ACCEPTANCE SOUGHT: SIA/FINANCIAL GUARANTEE RELEASE DRAINAGE PLAN 1st SUBMITTAL PRELIMINARY PLAT APPROVAL DRAINAGE PLAN RESUBMITTAL S. DEV. PLAN FOR SUB@ APPROVAL S. DEV. FOR BLGB, PERMIT APPROVAL GRADING PLAN S. DEV. FOR BLGB, PERMIT APPROVAL SECTOR PLAN APPROVAL GRADING PLAN SECTOR PLAN APPROVAL SECTOR PLAN APPROVAL ENGINEER¢S CERT (HYDROLOGY) X CERTIFICATE OF OCCUPANCY (PERM) CLOMR/LOMR CERTIFICATE OF OCCUPANCY (PERM) CLOMR/LOMR CERTIFICATE OF OCCUPANCY (PERM) ENGINEER¢S CERT (DR B SITE PLAN) BUILDING PERMIT APPROVAL ENGINEER¢S CERT (DR SITE PLAN) GRADING PERMIT APPROVAL ESC PERMIT	Address: 924 Park Avenue SW, Suite B Albuquero	que, NM 87102	
Address: P.o. Box 65395 Albuquerque, NM 87193 Phone#: 505-917-8921 Fax#: E-mail: johndgallegos73@gmail.com Contractor: Insight Construction Address: 3909 12th Street, Albuquerque, NM 87107 Phone#: 505-887-7927 Fax#: E-mail: damian@insightm.com TYPE OF SUBMITTAL: CHECK TYPE OF APPROVAL/ACCEPTANCE SOUGHT: DRAINAGE REPORT SIA/FINANCIAL GUARANTEE RELEASE DRAINAGE PLAN 1st SUBMITTAL PRELIMINARY PLAT APPROVAL CONCEPTUAL G & D PLAN S. DEV. PLAN FOR SUB@ APPROVAL GRADING PLAN S. DEV. FOR BLDG. PERMIT APPROVAL EROSION & SEDIMENT CONTROL PLAN (ESC) FINAL PLAT APPROVAL EROSION & SEDIMENT CONTROL PLAN (ESC) FINAL PLAT APPROVAL ENGINEER@ CERT (HYDROLOGY) X CERTIFICATE OF OCCUPANCY (PERM) CLOMR/LOMR CERTIFICATE OF OCCUPANCY (TCL TEMP) TRAFFIC CIRCULATION LAYOUT (TCL) FOUNDATION PERMIT APPROVAL ENGINEER@ CERT (DRB SITE PLAN) GRADING PERMIT APPROVAL SO-19 APPROVAL X ENGINEER@ CERT (DRB SITE PLAN) GRADING PERMIT APPROVAL ESC PERMIT APPROVAL SO-19 WORK ORDER APPROVAL ESC CERT. ACCEPTANCE SO-19	Phone#: 505-268-4144	Fax#:	E-mail: doug@mullenheller.com
Phone#: 505-917-8921 Fax#: E-mail: johndgallegos73@gmail.com Contractor: Insight Construction Contact: Damian Chimenti Address: 3909 12th Street, Albuquerque, NM 87107 E-mail: damian@insightm.com Phone#: 505-888-7927 Fax#: E-mail: damian@insightm.com TYPE OF SUBMITTAL: CHECK TYPE OF APPROVAL/ACCEPTANCE SOUGHT: DRAINAGE PLAN 1st SUBMITTAL SIA/FINANCIAL GUARANTEE RELEASE DRAINAGE PLAN RESUBMITTAL S. DEV. PLAN FOR SUBd DAPPROVAL CONCEPTUAL G & D PLAN S. DEV. FOR BLDG. PERMIT APPROVAL GRADING PLAN S. DEV. FOR BLDG. PERMIT APPROVAL EROSION & SEDIMENT CONTROL PLAN (ESC) FINAL PLAT APPROVAL ENGINEER& CERT (HYDROLOGY) X CERTIFICATE OF OCCUPANCY (TCL TEMP) CLOMR/LOMR CERTIFICATE OF OCCUPANCY (TCL TEMP) TAAFIC CIRCULATION LAYOUT (TCL) FOUNDATION PERMIT APPROVAL ENGINEER& CERT (DRB SITE PLAN) GRADING PERMIT APPROVAL SO-19 APPROVAL X ENGINEER& CERT (ESC) PAVING PERMIT APPROVAL ESC CERT. ACCEPTANCE SO-19 WORK ORDER APPROVAL ESC CERT. ACCEPTANCE OTHER (SPECIFY) GRADING CERTIFICATION OTHER (SPECIFY)	Surveyor: Construction Survey Technologies, INC	с.	Contact: John Gallegos
Contractor: Insight Construction Contact: Damian Chimenti Address: 3909 12th Street, Albuquerque, NM 87107 E-mail: damian@insightnm.com Phone#: 505-888-7927 Fax#: E-mail: damian@insightnm.com TYPE OF SUBMITTAL: CHECK TYPE OF APPROVAL/ACCEPTANCE SOUGHT: DRAINAGE REPORT SIA/FINANCIAL GUARANTEE RELEASE DRAINAGE PLAN 1st SUBMITTAL PRELIMINARY PLAT APPROVAL CONCEPTUAL G & D PLAN S. DEV. FOR BLDG. PERMIT APPROVAL GRADING PLAN SECTOR PLAN APPROVAL ENGINEER4S CERT (HYDROLOGY) X CERTIFICATE OF OCCUPANCY (PERM) CLOMR/LOMR CERTIFICATE OF OCCUPANCY (TCL TEMP) TRAFFIC CIRCULATION LAYOUT (TCL) FOUNDATION PERMIT APPROVAL ENGINEER4S CERT (DRB SITE PLAN) GRADING PERMIT APPROVAL SO-19 BUILDING PERMIT APPROVAL SO-19 PAVING PERMIT APPROVAL ENGINEER4S CERT (ESC) PAVING PERMIT APPROVAL SO-19 WORK ORDER APPROVAL ESC PERMIT APPROVAL SO	Address: P.o. Box 65395 Albuquerque, NM 87193	5	
Address: 3909 12th Street, Albuquerque, NM 87107 Phone#: 505-888-7927 Fax#: E-mail: damian@insightm.com TYPE OF SUBMITTAL: CHECK TYPE OF APPROVAL/ACCEPTANCE SOUGHT: DRAINAGE PLAN Ist SUBMITTAL SIA/FINANCIAL GUARANTEE RELEASE DRAINAGE PLAN RESUBMITTAL SIA/FINANCIAL GUARANTEE RELEASE DRAINAGE PLAN RESUBMITTAL S. DEV. PLAN FOR SUB¢D APPROVAL CONCEPTUAL G & D PLAN S. DEV. FOR BLDG. PERMIT APPROVAL GRADING PLAN S. DEV. FOR BLDG. PERMIT APPROVAL EROSION & SEDIMENT CONTROL PLAN (ESC) FINAL PLAT APPROVAL ENGINEER¢S CERT (HYDROLOGY) × CERTIFICATE OF OCCUPANCY (PERM) CLOMR/LOMR CERTIFICATE OF OCCUPANCY (TCL TEMP) TRAFFIC CIRCULATION LAYOUT (TCL) FOUNDATION PERMIT APPROVAL ENGINEER¢S CERT (DRB SITE PLAN) GRADING PERMIT APPROVAL SO-19 WORK ORDER APPROVAL SO-19 APPROVAL MORK ORDER APPROVAL ESC CERT. ACCEPTANCE MORK ORDER APPROVAL GRADING CERTIFICATION WAS A PRE-DESIGN CONFERENCE ATTENDED: Yes X	Phone#: 505-917-8921	Fax#:	E-mail: johndgallegos73@gmail.com
Phone#: 505-888-7927 Fax#: E-mail: damian@insightm.com TYPE OF SUBMITTAL: CHECK TYPE OF APPROVAL/ACCEPTANCE SOUGHT: DRAINAGE REPORT SIA/FINANCIAL GUARANTEE RELEASE DRAINAGE PLAN 1st SUBMITTAL PRELIMINARY PLAT APPROVAL CONCEPTUAL G & D PLAN S. DEV. PLAN FOR SUB@D APPROVAL CONCEPTUAL G & D PLAN S. DEV. FOR BLDG. PERMIT APPROVAL GRADING PLAN S. DEV. FOR PLAN APPROVAL EROSION & SEDIMENT CONTROL PLAN (ESC) FINAL PLAT APPROVAL ENGINEER@S CERT (HYDROLOGY) X CERTIFICATE OF OCCUPANCY (PERM) CLOMR/LOMR CERTIFICATE OF OCCUPANCY (TCL TEMP) TRAFFIC CIRCULATION LAYOUT (TCL) FOUNDATION PERMIT APPROVAL ENGINEER@S CERT (DRB SITE PLAN) GRADING PERMIT APPROVAL ENGINEER@S CERT (ESC) PAVING PERMIT APPROVAL SO-19 WORK ORDER APPROVAL ESC CERT. ACCEPTANCE OTHER (SPECIFY) GRADING CERTIFICATION OTHER (SPECIFY)	Contractor: Insight Construction		Contact: Damian Chimenti
TYPE OF SUBMITTAL: CHECK TYPE OF APPROVAL/ACCEPTANCE SOUGHT: DRAINAGE REPORT SIA/FINANCIAL GUARANTEE RELEASE DRAINAGE PLAN 1st SUBMITTAL PRELIMINARY PLAT APPROVAL DRAINAGE PLAN RESUBMITTAL S. DEV. PLAN FOR SUB@ APPROVAL CONCEPTUAL G & D PLAN S. DEV. FOR BLDG. PERMIT APPROVAL GRADING PLAN S. DEV. FOR BLDG. PERMIT APPROVAL GRADING PLAN S. DEV. FOR BLDG. PERMIT APPROVAL EROSION & SEDIMENT CONTROL PLAN (ESC) FINAL PLAT APPROVAL ENGINEER\$ CERTIFICATE OF OCCUPANCY (PERM) CLOMR/LOMR CERTIFICATE OF OCCUPANCY (TCL TEMP) TRAFFIC CIRCULATION LAYOUT (TCL) FOUNDATION PERMIT APPROVAL ENGINEER\$ CERT (ICL) X ENGINEER\$ CERT (DB SITE PLAN) ENGINEER\$ GRADING PERMIT APPROVAL SO-19 APPROVAL X ENGINEER\$ CERT (ESC) PAVING PERMIT APPROVAL X ENGINEER\$ CERT (ESC) PAVING PERMIT APPROVAL ESC PERMIT APPROVAL SO-19 WORK ORDER APPROVAL ESC CERT. ACCEPTANCE OTHER (SPECIFY) GRADING CERTIFICATION OTHER (SPECIFY)	Address: 3909 12th Street, Albuquerque, NM 8710	07	
DRAINAGE REPORTSIA/FINANCIAL GUARANTEE RELEASEDRAINAGE PLAN 1st SUBMITTALPRELIMINARY PLAT APPROVALDRAINAGE PLAN RESUBMITTALS. DEV. PLAN FOR SUB¢D APPROVALCONCEPTUAL G & D PLANS. DEV. FOR BLDG. PERMIT APPROVALGRADING PLANS. DEV. FOR BLDG. PERMIT APPROVALEROSION & SEDIMENT CONTROL PLAN (ESC)FINAL PLAT APPROVALENGINEER¢S CERT (HYDROLOGY)X CERTIFICATE OF OCCUPANCY (PERM)CLOMR/LOMRCERTIFICATE OF OCCUPANCY (TCL TEMP)TRAFFIC CIRCULATION LAYOUT (TCL)FOUNDATION PERMIT APPROVALENGINEER¢S CERT (DRB SITE PLAN)GRADING PERMIT APPROVALX ENGINEER¢S CERT (ESC)PAVING PERMIT APPROVALSO-19WORK ORDER APPROVALSO-19GRADING CERTIFICATIONOTHER (SPECIFY)GRADING CERTIFICATIONWAS A PRE-DESIGN CONFERENCE ATTENDED:Yes X NoCopy ProvidedCopy Provided	Phone#: 505-888-7927	Fax#:	E-mail: damian@insightnm.com
DRAINAGE PLAN 1st SUBMITTALPRELIMINARY PLAT APPROVALDRAINAGE PLAN RESUBMITTALS. DEV. PLAN FOR SUB¢D APPROVALCONCEPTUAL G & D PLANS. DEV. FOR BLDG. PERMIT APPROVALGRADING PLANS. DEV. FOR BLDG. PERMIT APPROVALEROSION & SEDIMENT CONTROL PLAN (ESC)FINAL PLAT APPROVALENGINEER¢S CERT (HYDROLOGY)X CERTIFICATE OF OCCUPANCY (PERM)CLOMR/LOMRCERTIFICATE OF OCCUPANCY (TCL TEMP)TRAFFIC CIRCULATION LAYOUT (TCL)FOUNDATION PERMIT APPROVALENGINEER¢S CERT (DRB SITE PLAN)GRADING PERMIT APPROVALENGINEER¢S CERT (ESC)PAVING PERMIT APPROVALSO-19WORK ORDER APPROVALOTHER (SPECIFY)GRADING CERTIFICATIONWAS A PRE-DESIGN CONFERENCE ATTENDED:YesYesXNoCopy Provided	TYPE OF SUBMITTAL:	CHECK TYPE OF A	APPROVAL/ACCEPTANCE SOUGHT:
DRAINAGE PLAN RESUBMITTALS. DEV. PLAN FOR SUB¢D APPROVALCONCEPTUAL G & D PLANS. DEV. FOR BLDG. PERMIT APPROVALGRADING PLANSECTOR PLAN APPROVALEROSION & SEDIMENT CONTROL PLAN (ESC)FINAL PLAT APPROVALENGINEER¢S CERT (HYDROLOGY)X CERTIFICATE OF OCCUPANCY (PERM)CLOMR/LOMRCERTIFICATE OF OCCUPANCY (TCL TEMP)TRAFFIC CIRCULATION LAYOUT (TCL)FOUNDATION PERMIT APPROVALENGINEER¢S CERT (DRB SITE PLAN)GRADING PERMIT APPROVALENGINEER¢S CERT (ESC)PAVING PERMIT APPROVALSO-19WORK ORDER APPROVALSO-19WORK ORDER APPROVALOTHER (SPECIFY)YesWAS A PRE-DESIGN CONFERENCE ATTENDED:YesYesXNoCopy Provided	DRAINAGE REPORT	SIA/FINANCIAL G	UARANTEE RELEASE
CONCEPTUAL G & D PLANS. DEV. FOR BLDG. PERMIT APPROVALGRADING PLANSECTOR PLAN APPROVALEROSION & SEDIMENT CONTROL PLAN (ESC)FINAL PLAT APPROVALENGINEER¢S CERT (HYDROLOGY)X CERTIFICATE OF OCCUPANCY (PERM)CLOMR/LOMRCERTIFICATE OF OCCUPANCY (TCL TEMP)TRAFFIC CIRCULATION LAYOUT (TCL)FOUNDATION PERMIT APPROVALENGINEER¢S CERT (TCL)BUILDING PERMIT APPROVALX ENGINEER¢S CERT (DRB SITE PLAN)GRADING PERMIT APPROVALSO-19WORK ORDER APPROVALESC PERMIT APPROVALSO-19WORK ORDER APPROVALESC CERT. ACCEPTANCEOTHER (SPECIFY)YesX NoCopy Provided	DRAINAGE PLAN 1st SUBMITTAL	PRELIMINARY PL	AT APPROVAL
GRADING PLANSECTOR PLAN APPROVALEROSION & SEDIMENT CONTROL PLAN (ESC)FINAL PLAT APPROVALENGINEER¢S CERT (HYDROLOGY)X CERTIFICATE OF OCCUPANCY (PERM)CLOMR/LOMRCERTIFICATE OF OCCUPANCY (TCL TEMP)TRAFFIC CIRCULATION LAYOUT (TCL)FOUNDATION PERMIT APPROVALENGINEER¢S CERT (TCL)BUILDING PERMIT APPROVALX ENGINEER¢S CERT (DRB SITE PLAN)GRADING PERMIT APPROVALENGINEER¢S CERT (ESC)PAVING PERMIT APPROVALSO-19WORK ORDER APPROVALOTHER (SPECIFY)GRADING CERTIFICATIONWAS A PRE-DESIGN CONFERENCE ATTENDED:YesX ENGINEER¢S CENT (ESC)YesX ENGING CONFERENCE ATTENDED:YesX ENGLOTHER (SPECIFY)	DRAINAGE PLAN RESUBMITTAL	S. DEV. PLAN FOR	R SUB¢D APPROVAL
EROSION & SEDIMENT CONTROL PLAN (ESC)FINAL PLAT APPROVALENGINEER¢S CERT (HYDROLOGY)XCERTIFICATE OF OCCUPANCY (PERM)CLOMR/LOMRCERTIFICATE OF OCCUPANCY (TCL TEMP)TRAFFIC CIRCULATION LAYOUT (TCL)FOUNDATION PERMIT APPROVALENGINEER¢S CERT (TCL)BUILDING PERMIT APPROVALXENGINEER¢S CERT (DRB SITE PLAN)ENGINEER¢S CERT (ESC)PAVING PERMIT APPROVALSO-19WORK ORDER APPROVALSO-19WORK ORDER APPROVALOTHER (SPECIFY)YesWAS A PRE-DESIGN CONFERENCE ATTENDED:YesXNoCopy Provided	CONCEPTUAL G & D PLAN	S. DEV. FOR BLDO	G. PERMIT APPROVAL
ENGINEER&S CERT (HYDROLOGY)XCERTIFICATE OF OCCUPANCY (PERM)CLOMR/LOMRCERTIFICATE OF OCCUPANCY (TCL TEMP)TRAFFIC CIRCULATION LAYOUT (TCL)FOUNDATION PERMIT APPROVALENGINEER& CERT (TCL)BUILDING PERMIT APPROVALXENGINEER& CERT (DRB SITE PLAN)ENGINEER& CERT (ESC)PAVING PERMIT APPROVALSO-19WORK ORDER APPROVALSO-19WORK ORDER APPROVALOTHER (SPECIFY)GRADING CERTIFICATIONWAS A PRE-DESIGN CONFERENCE ATTENDED:YesXNoCopy Provided	GRADING PLAN	SECTOR PLAN AP	PROVAL
CLOMR/LOMRCERTIFICATE OF OCCUPANCY (TCL TEMP)TRAFFIC CIRCULATION LAYOUT (TCL)FOUNDATION PERMIT APPROVALENGINEER¢S CERT (TCL)BUILDING PERMIT APPROVALX ENGINEER¢S CERT (DRB SITE PLAN)GRADING PERMIT APPROVALENGINEER¢S CERT (ESC)PAVING PERMIT APPROVALSO-19WORK ORDER APPROVALOTHER (SPECIFY)GRADING CERTIFICATIONWAS A PRE-DESIGN CONFERENCE ATTENDED:YesX ENGINER¢S CERT (ESC)YesX ENGINER¢S CERT (ESC)YesX ENGINER¢S CERT (ESC)YesYesX NoCopy ProvidedCopy ProvidedCopy Provided	EROSION & SEDIMENT CONTROL P	PLAN (ESC) FINAL PLAT APPR	ROVAL
TRAFFIC CIRCULATION LAYOUT (TCL) FOUNDATION PERMIT APPROVAL ENGINEER & CERT (TCL) BUILDING PERMIT APPROVAL X ENGINEER & CERT (DRB SITE PLAN) GRADING PERMIT APPROVAL ENGINEER & CERT (ESC) PAVING PERMIT APPROVAL SO-19 WORK ORDER APPROVAL OTHER (SPECIFY) GRADING CERTIFICATION WAS A PRE-DESIGN CONFERENCE ATTENDED: Yes	ENGINEER & CERT (HYDROLOGY)	× CERTIFICATE OF	OCCUPANCY (PERM)
TRAFFIC CIRCULATION LAYOUT (TCL) FOUNDATION PERMIT APPROVAL ENGINEER & CERT (TCL) BUILDING PERMIT APPROVAL X ENGINEER & CERT (DRB SITE PLAN) GRADING PERMIT APPROVAL ENGINEER & CERT (ESC) PAVING PERMIT APPROVAL SO-19 WORK ORDER APPROVAL OTHER (SPECIFY) GRADING CERTIFICATION WAS A PRE-DESIGN CONFERENCE ATTENDED: Yes			
ENGINEER¢S CERT (TCL) BUILDING PERMIT APPROVAL X ENGINEER¢S CERT (DRB SITE PLAN) GRADING PERMIT APPROVAL SO-19 APPROVAL ENGINEER¢S CERT (ESC) PAVING PERMIT APPROVAL ESC PERMIT APPROVAL SO-19 WORK ORDER APPROVAL ESC CERT. ACCEPTANCE OTHER (SPECIFY) GRADING CERTIFICATION OTHER (SPECIFY)			
X ENGINEER¢S CERT (DRB SITE PLAN) GRADING PERMIT APPROVAL SO-19 APPROVAL ENGINEER¢S CERT (ESC) PAVING PERMIT APPROVAL ESC PERMIT APPROVAL SO-19 WORK ORDER APPROVAL ESC CERT. ACCEPTANCE OTHER (SPECIFY) GRADING CERTIFICATION OTHER (SPECIFY) WAS A PRE-DESIGN CONFERENCE ATTENDED: Yes X No Copy Provided			T APPROVAL
ENGINEER@S CERT (ESC) PAVING PERMIT APPROVAL ESC PERMIT APPROVAL SO-19 WORK ORDER APPROVAL ESC CERT. ACCEPTANCE OTHER (SPECIFY) GRADING CERTIFICATION OTHER (SPECIFY) WAS A PRE-DESIGN CONFERENCE ATTENDED: Yes X No Copy Provided			
SO-19 WORK ORDER APPROVAL ESC CERT. ACCEPTANCE OTHER (SPECIFY) GRADING CERTIFICATION OTHER (SPECIFY) WAS A PRE-DESIGN CONFERENCE ATTENDED: Yes X No Copy Provided			
OTHER (SPECIFY) GRADING CERTIFICATION OTHER (SPECIFY) WAS A PRE-DESIGN CONFERENCE ATTENDED: Yes X No Copy Provided			
D:6000			
D:6000	WAS A PRE-DESIGN CONFERENCE ATTE	NDED: Yes X No	Copy Provided
	DATE SUBMITTED: June 10, 2015	By: Doug Heller	Disting

Requests for approvals of Site Development Plans and/or Subdivision Plats shall be accompanied by a drainage submittal. The particular nature, location, and scope to the proposed development defines the degree of drainage detail. One or more of the following levels of submittal may be required based on the following

1. Conceptual Grading and Drainage Plan: Required for approval of Site Development Plans greater than five (5) acres and Sector Plans

2. Drainage Plans: Required for building permits, grading permits, paving permits and site plans less than five (5) acres

3. Drainage Report: Required for subdivision containing more than ten (10) lots or constituting five (5) acres or more

4. Erosion and Sediment Control Plan: Required for any new development and redevelopment site with 1-acre or more of land disturbing area, including project less than 1-acre than are part of a larger common plan of development

June 10, 2015

Racquel Michel, P.E., Transportation Development Planning Department Development and Building Services Division City of Albuquerque 600 2nd Street NW. Albuquerque, NM 87102

Re: Permanent Certificate of Occupancy for Country Club Plaza – Commercial Building 1 Address: 1718 Central Avenue SW., Albuquerque, NM. 87104

Dear Ms. Racquel Michel:

I, Douglas Heller, NMRA of Mullen Heller Architecture P.C., hereby certify that this project is in substantial compliance with and in accordance with the design intent of Approved EPC/DRB Site Development Plan approved October 10, 2013 (Project #1004677). The attached Site Development Plan also shows "redlined" the revised phase line on the south side parking of Building One (1) on Lot 4 of Country Club Plaza Subdivision.

This certification pertains only to Building One (1) of this development, as approved by the EPC/DRB and as "redlined" on attached Site Development Plan for Building Permit. I further certify that I have personally visited the project site on June 10, 2015 and have determined by visual inspection that the survey data provided is representative of actual site conditions and is true and correct to the best of my knowledge and belief. This certification is submitted in support of a request for Engineer's Certification (DRB Site Plan) for Permanent Certificate of Occupancy.


The record information presented herein is not necessarily complete and intended only to verify substantial compliance of the traffic aspects of this project. Those relying on the record document are advised to obtain independent verification of its accuracy before using it for any other purpose.

Please feel free to contact me if you have any questions.

Sincerely, Mullen Heller Architecture PC



Douglas Heller, AIA Attachment: Approved EPC/DRB Site Development Plan for Building Permit (with redlines)

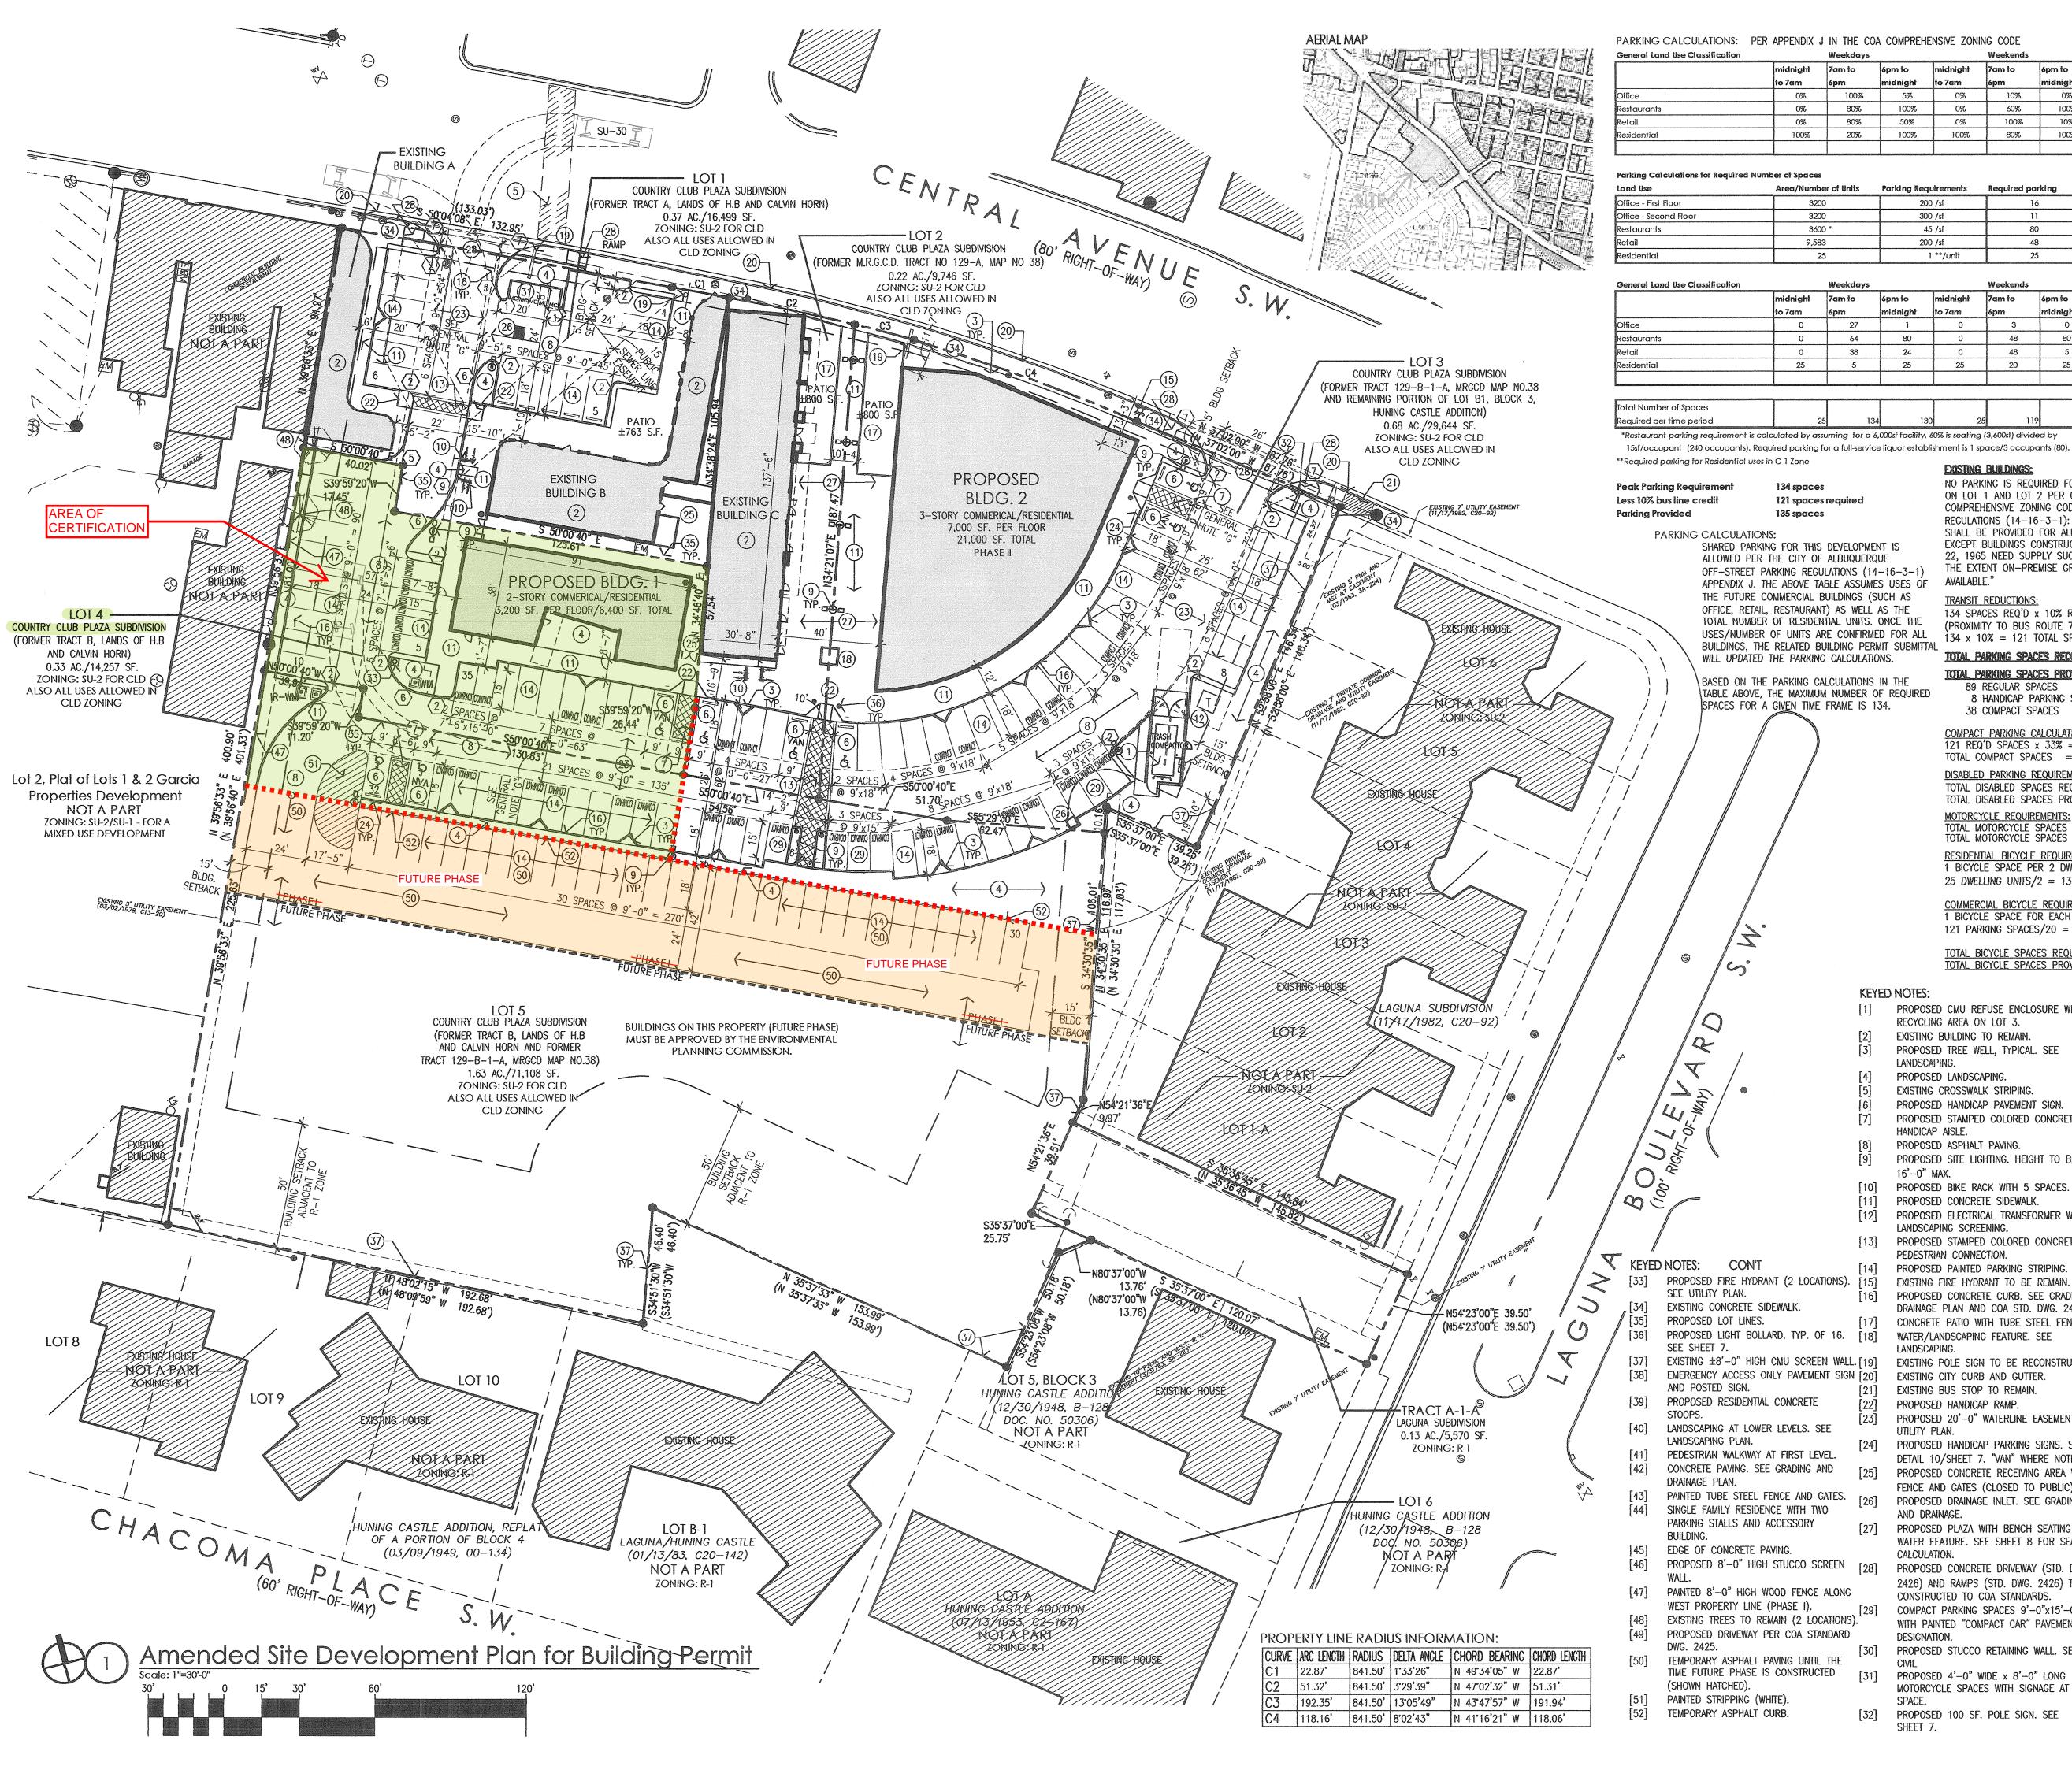

ı to	6pm to	midnight	7am to	6pm to
ł	midnight	to 7am	6pm	midnight
100%	5%	0%	10%	0%
80%	100%	0%	60%	100%
80%	50%	0%	100%	10%
20%	100%	100%	80%	100%

Weekends

Units	Parking Requirements	Required parking	
	200 /sf	16	
	300 /sf	11	
	45 /sf	80	
	200 /sf	48	
	1 **/unit	25	

ekdays			Weekends	
n to n	6pm to midnight	midnight to 7am	7am to 6pm	6pm to midnight
27	1	0	3	0
64	80	0	48	80
38	24	0	48	5
5	25	25	20	25
		1	1	1

EXISTING BUILDINGS:

NO PARKING IS REQUIRED FOR EXISTING BUILDINGS ON LOT 1 AND LOT 2 PER CITY OF ALBUQUERQUE COMPREHENSIVE ZONING CODE OFF-STREET PARKING REGULATIONS (14-16-3-1): "OFF- STREET PARKING SHALL BE PROVIDED FOR ALL USES AND BUILDINGS, EXCEPT BUILDINGS CONSTRUCTED BEFORE OCTOBER 22, 1965 NEED SUPPLY SUCH PARKING ONLY TO THE EXTENT ON-PREMISE GROUND SPACE IS AVAILABLE.' TRANSIT REDUCTIONS: 134 SPACES REQ'D x 10% REDUCTION = (PROXIMITY TO BUS ROUTE 766 AND 66) $134 \times 10\% = 121$ TOTAL SPACES REQUIRED

- TOTAL PARKING SPACES REQUIRED: = 121 SPACES TOTAL PARKING SPACES PROVIDED: = 135 SPACES 89 REGULAR SPACES 8 HANDICAP PARKING SPACES 38 COMPACT SPACES

COMPACT PARKING CALCULATION

- 121 REQ'D SPACES x 33% = 40 SPACES ALLOWED TOTAL COMPACT SPACES = 38 SPACES PROVIDED DISABLED PARKING REQUIREMENTS: TOTAL DISABLED SPACES REQUIRED = 8 SPACES TOTAL DISABLED SPACES PROVIDED = 8 SPACES MOTORCYCLE REQUIREMENTS:
- TOTAL MOTORCYCLE SPACES REQUIRED = 5 SPACES TOTAL MOTORCYCLE SPACES PROVIDED = 5 SPACES **RESIDENTIAL BICYCLE REQUIREMENTS:**
- 1 BICYCLE SPACE PER 2 DWELLING UNITS = 25 DWELLING UNITS/2 = 13 TOTAL SPACES REQUIRED

COMMERCIAL BICYCLE REQUIREMENTS: 1 BICYCLE SPACE FOR EACH 20 PARKING SPACES =

- 121 PARKING SPACES/20 = 6 TOTAL SPACES REQUIRED^{LE]}
- TOTAL BICYCLE SPACES REQUIRED: = 19 SPACES TOTAL BICYCLE SPACES PROVIDED: = 20 SPACES

KEYED NOTES:

- [1] PROPOSED CMU REFUSE ENCLOSURE WITH
- RECYCLING AREA ON LOT 3.
- EXISTING BUILDING TO REMAIN. PROPOSED TREE WELL, TYPICAL, SEE
- LANDSCAPING.
- PROPOSED LANDSCAPING.
- EXISTING CROSSWALK STRIPING.
- PROPOSED HANDICAP PAVEMENT SIGN. PROPOSED STAMPED COLORED CONCRETE
- HANDICAP AISLE.
- PROPOSED ASPHALT PAVING.
- PROPOSED SITE LIGHTING. HEIGHT TO BE 16'-0" MAX.
- PROPOSED BIKE RACK WITH 5 SPACES.
- PROPOSED CONCRETE SIDEWALK. PROPOSED ELECTRICAL TRANSFORMER WITH
- LANDSCAPING SCREENING. PROPOSED STAMPED COLORED CONCRETE
- PEDESTRIAN CONNECTION. PROPOSED PAINTED PARKING STRIPING
- EXISTING FIRE HYDRANT TO BE REMAIN.
- PROPOSED CONCRETE CURB. SEE GRADING & DRAINAGE PLAN AND COA STD. DWG. 2415A. CONCRETE PATIO WITH TUBE STEEL FENCING.
- WATER/LANDSCAPING FEATURE. SEE LANDSCAPING. EXISTING POLE SIGN TO BE RECONSTRUC
- EXISTING CITY CURB AND GUTTER.
- EXISTING BUS STOP TO REMAIN. PROPOSED HANDICAP RAMP.
- UTILITY PLAN. PROPOSED HANDICAP PARKING SIGNS. SEE
- DETAIL 10/SHEET 7. "VAN" WHERE NOTED. [25] PROPOSED CONCRETE RECEIVING AREA WITH
- FENCE AND GATES (CLOSED TO PUBLIC). PROPOSED DRAINAGE INLET. SEE GRADING [26]
- AND DRAINAGE. PROPOSED PLAZA WITH BENCH SEATING AND
- WATER FEATURE. SEE SHEET 8 FOR SEATING CALCULATION.
- PROPOSED CONCRETE DRIVEWAY (STD. DWG. 2426) AND RAMPS (STD. DWG. 2426) TO BE
- CONSTRUCTED TO COA STANDARDS. COMPACT PARKING SPACES 9'-0"x15'-0" WITH PAINTED "COMPACT CAR" PAVEMENT
- DESIGNATION. [30] PROPOSED STUCCO RETAINING WALL. SEE
- [31] PROPOSED 4'-O" WIDE x 8'-O" LONG MOTORCYCLE SPACES WITH SIGNAGE AT EACH SOLID WASTE MANAGEMENT
- SPACE. [32] PROPOSED 100 SF. POLE SIGN. SEE SHEET 7.

- SITE DEVELOPMENT DATA: PROPOSED LEGAL DESCRIPTION: LOTS 1 THRU 5, COUNTRY CLUB PLAZA SUBDIVISION AND TRACT A-1-A LAGUNA SUBDIVISION, ALBUQUERQUE, BERNALILLO COUNTY, NEW MEXICO **BUILDING ADDRESSES:** BLDG. A AND B (EXISTING): BLDG. C (EXISTING): 1710 CENTRAL AVE., S.W. 1720 CENTRAL AVE., S.W. ALBUQUERQUE, N.M. ALBUQUERQUE, N.M. LAND AREA: 3.37 ACRES (146,975 SQ. FT.) **CURRENT ZONING:** SU-2/CLD (HUNING CASTLE AND RAYNOLDS ADDITION NEIGHBORHOOD SECTOR DEVELOPMENT PLAN) FOR LOTS 1 THRU 5. R-1 (HUNING CASTLE AND RAYNOLDS ADDITION
 - NEIGHBORHOOD SECTOR DEVELOPMENT PLAN) FOR TRACT A-1-A. ZONE ATLAS PAGE:
 - J-13-Z
 - **DEVELOPMENT PHASING:**

<u>PHASE I:</u> PHASE I WILL INCLUDE THE RENOVATION OF THE EXISTING BUILDINGS A, B & C, THE PARKING LOT ON LOT 1, THE CONSTRUCTION OF PROPOSED BUILDING 1 AND THE MAIN DRIVE AISLE AND RELATED PARKING FROM THE SOUTH SIDE OF LOT 1 OUT TO CENTRAL AVENUE ON THE EAST SIDE OF LOT 3.

PHASES_II:

- PHASE II WILL INCLUDE THE CONSTRUCTION OF BUILDING 2.
- FUTURE PHASE:

CONSTRUCTION OF BUILDINGS ON LOT 5 ONCE APPROVED BY THE ENVIRONMENTAL PLANNING COMMISSION.

- **PROPOSED USES:** - ALL USES PERMITTED IN THE CLD ZONES
- FOR LOTS 1 THRU 5 - ALL USES PERMITTED IN THE R-1 ZONES
- **BUILDING AREAS:** EXISTING BUILDING A 1.467 SF. EXISTING BUILDING B 2,900 SF. EXISTING BUILDING C 4,216 SF. **PROPOSED BUILDING 1** 6,400 SF. TOTAL PROPOSED BUILDING 2 21,000 SF. TOTAL
- TOTAL BUILDING AREA = 35,983 SF. TOTAL PROPOSED
- 25 TOTAL UNITS RESIDENTIAL UNITS: SITE DEVELOPMENT GENERAL NOTES:
- [A] THE DESIGN STANDARDS INCLUDED IN THE AMENDED SITE DEVELOPMENT PLAN FOR SUBDIVISION FOR THIS PROJECT SHALL GOVERN ALL EXISTING AND NEW BUILDINGS FOR LOTS 1 THRU 5 OF THIS DEVELOPMENT.
- [B] RECIPROCAL PARKING, INGRESS/EGRESS, ACCESS AND DRAINAGE EASEMENT FOR THE BENEFIT AND USE BY THE OWNERS OF LOTS 1 THRU 5, COUNTRY CLUB PLAZA AND TRACT A-1-A, LAGUNA SUBDIVISION, SAID EASEMENT TO BE MAINTAINED BY THE OWNER OF EACH LOT FOR THE BENEFIT OF ALL LOTS. THIS WILL BE GRANTED WITH REPLAT OF ALL LOTS.
- [C] THE PARKING LOT DIMENSIONS ARE FROM FACE OF CURB FO FACE OF CURB. [D] LANDSCAPING AND SIGNING WILL NOT INTERFERE WITH
- CLEAR SIGHT REQUIREMENTS. THEREFORE, SIGNS. WALLS, TREES, AND SHRUBBERY BETWEEN 3 AND 8 FEET TALL (AS MEASURED FROM THE GUTTER PAN) WILL NOT BE ACCEPTABLE IN THIS AREA.
- ANY ENCROACHMENT OR OVERHANG INTO THE ROW FROM SIGNS, FENCES, CANOPY, ROOF LINES, ETC. WILL REQUIRE AN ANNUAL REVOCABLE ENCROACHMENT PERMIT. F] ALL ABANDONED DRIVEPADS IN THE COA-ROW SHALL BE
- REMOVED AND REPLACED WITH COA STANDARD SIDEWALK CURB AND GUTTER. [G] EASEMENT NOTE: 25' PRIVATE ACCESS AND DRAINAGE
- EASEMENT TOGETHER WITH 25' PUBLIC UTILITY. PUBLIC WATERLINE, PUBLIC SANITARY SEWER EASEMENT, SAID EASEMENT TO BE MAINTAINED BY THE OWNER OF EACH LOT FOR THE BENEFIT OF ALL LOTS. TO BE GRANTED WITH REPLAT OF ALL LOTS.

SITE DEVELOPMENT SITE LIGHTING NOTES:

- [A] THE LOCATION OF THE LIGHTING FIXTURES TOGETHER WITH ITS CUT-OFF ANGLE SHALL BE SUCH THAT IT DOES NOT DIRECTLY SHINE ON ANY PUBLIC RIGHT-OF-WAY OR ADJACENT RESIDENTIAL PROPERTY.
- [B] THE MAXIMUM HEIGHT OF A LIGHT POLE MEASURED FROM THE FINISH GRADE TO THE TOP OF THE POLE SHALL BE <u>16'-0" MAX.</u> TO MATCH EXISTING.
- [C] LIGHTING TO BE PROVIDED ON COMMERCIAL BUILDING
- FACADES SHALL BE MOUNTED AT 12 FEET MAXIMUM. [D] SITE LIGHTING SHALL BE FULLY SHIELDED, AND HIGH-PRESSURE SODIUM LIGHTING AND UN-SHIELDED UPLIGHTING SHALL BE PROHIBITED.
- **RADIUS INFORMATION:** $\langle 1 \rangle = 2' - 0"$ $\langle 5 \rangle = 10' - 0"$ $\langle 9 \rangle = 35' - 0"$
- $\langle 2 \rangle = 3' 0'' \langle 6 \rangle = 15' 0'' \langle 10 \rangle = 40' 0''$ $\overline{\langle 3 \rangle} = 4' - 0"$ $\overline{\langle 7 \rangle} = 25' - 0"$ $\overline{\langle 11 \rangle} = 46' - 0"$
- $\overline{\langle 4 \rangle} = 5' 0"$ $\overline{\langle 8 \rangle} = 30' 0"$ PROJECT NUMBER: 1004677 APPLICATION NUMBER: 13EPC-40139

THIS PLAN IS CONSISTANT WITH THE SPECIFIC SITE DEVELOPMENT PLAN APPROVE by the environmental planning commission (EPC) dated: October 10, 201 AND THE FINDINGS AND CONDITIONS IN THE OFFICIAL NOTIFICATION OF DECISION ARE SATISFIED.

IS AN INFRASTRUCTURE LIST REQUIRED? (X) YES () NO IF YES, THEN A PROPOSED 20'-0" WATERLINE EASEMENT. SEE SET OF APPROVED DRC PLANS WITH A WORK ORDER IS REQUIRED FOR ANY CONSTRUCTION WITHIN PUBLIC RIGHT-OF-WAY OR FOR CONSTRUCTION OF PUBLIC IMPROVEMENTS. DRB SITE DEVELOPMENT PLAN SIGNOFF APPROVAL:

1525	12-18-13
TRAFFIC ENGINEER, TRANSPORTATION DIVISION	Date
allenter	12/18/13
UTILITIES DEVELOPMENT	Date
Carol S. Dumont	12-18-13
PARKS AND RECREATION DEPARTMENT	Date

ENVIRONMENTAL HEALTH DEPARTMENT (CONDITIONAL)

aut & chus

1 Martin

DRB CHAIRPERSON. PLANNING DEPARTMENT

XITY ENGINEER

NA

400 ()

Gal

12-18-13 Date 2-11-14 Date NA Date 17-17-1 Date

3-28-1

Date

of 7

t title OUNTRY CIUB Plaza of Central Avenue and Laguna Boulevard querque, New Mexico 87102 title	job number 12-11 drawn by SJ, MWS, AV project manager Doug Heller, AIA.	Mullen HelArchitecture924 Park AvenueSuite BAlbuquerque505 268 4144[p]505 268 4244 [f]	rev date	Vd [13 swm	revision Per DRB Comments (11/6/13)
nended Site Dev't Plan for Building Permit	date 09/26/2013	P.C.		'13 mws	Per EPC Notice of Decision