

WORKSHOP  
ARCHITECTS


811 12TH ST. NW  
ALBUQUERQUE, NEW MEXICO  
87102

PH. 505.246.9608


tredeign@earthlink.net

Mountain Road Town Homes


MOUNTAIN ROAD  
ALBUQUERQUE, NEW MEXICO 87102

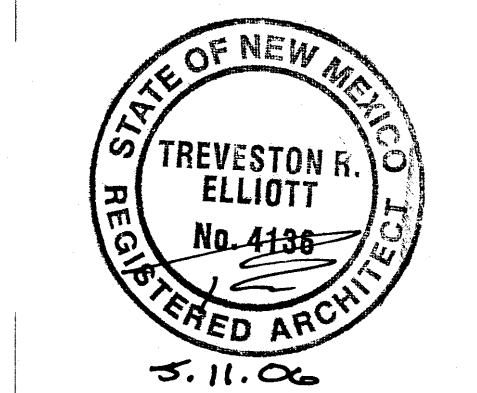


Date:  
May 11, 2006  
Sheet:  
TCL PLAN

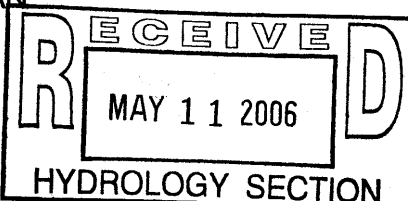


A-083

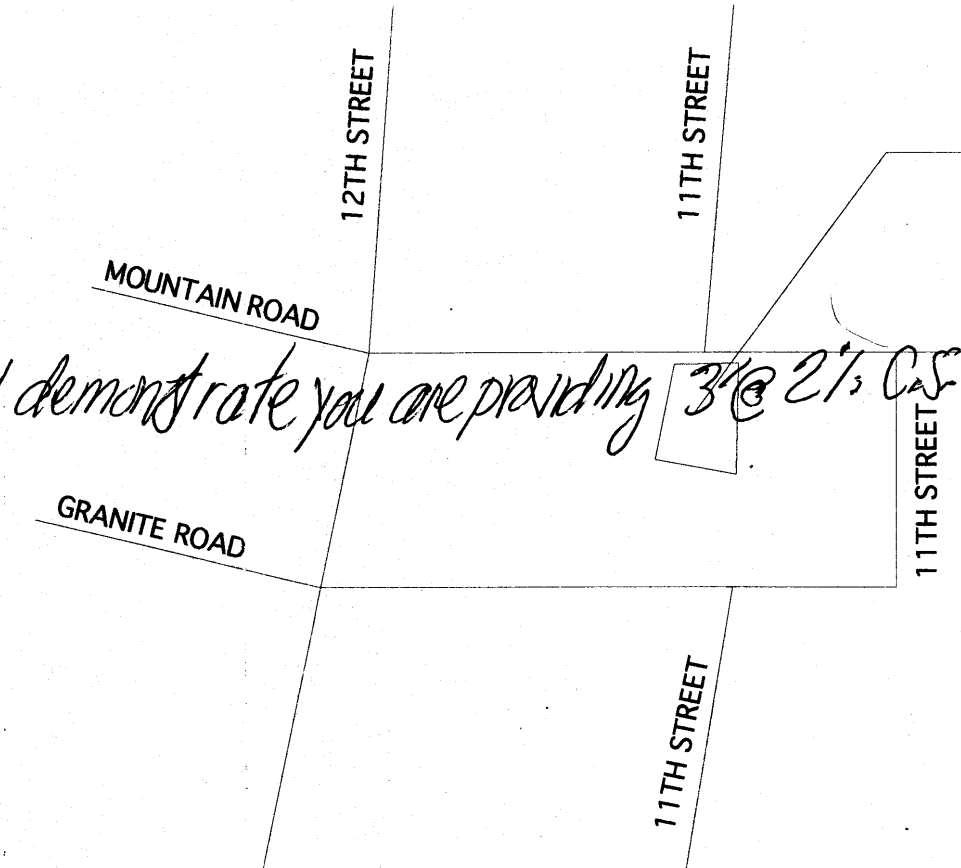

VICINITY PLAN  
NTS

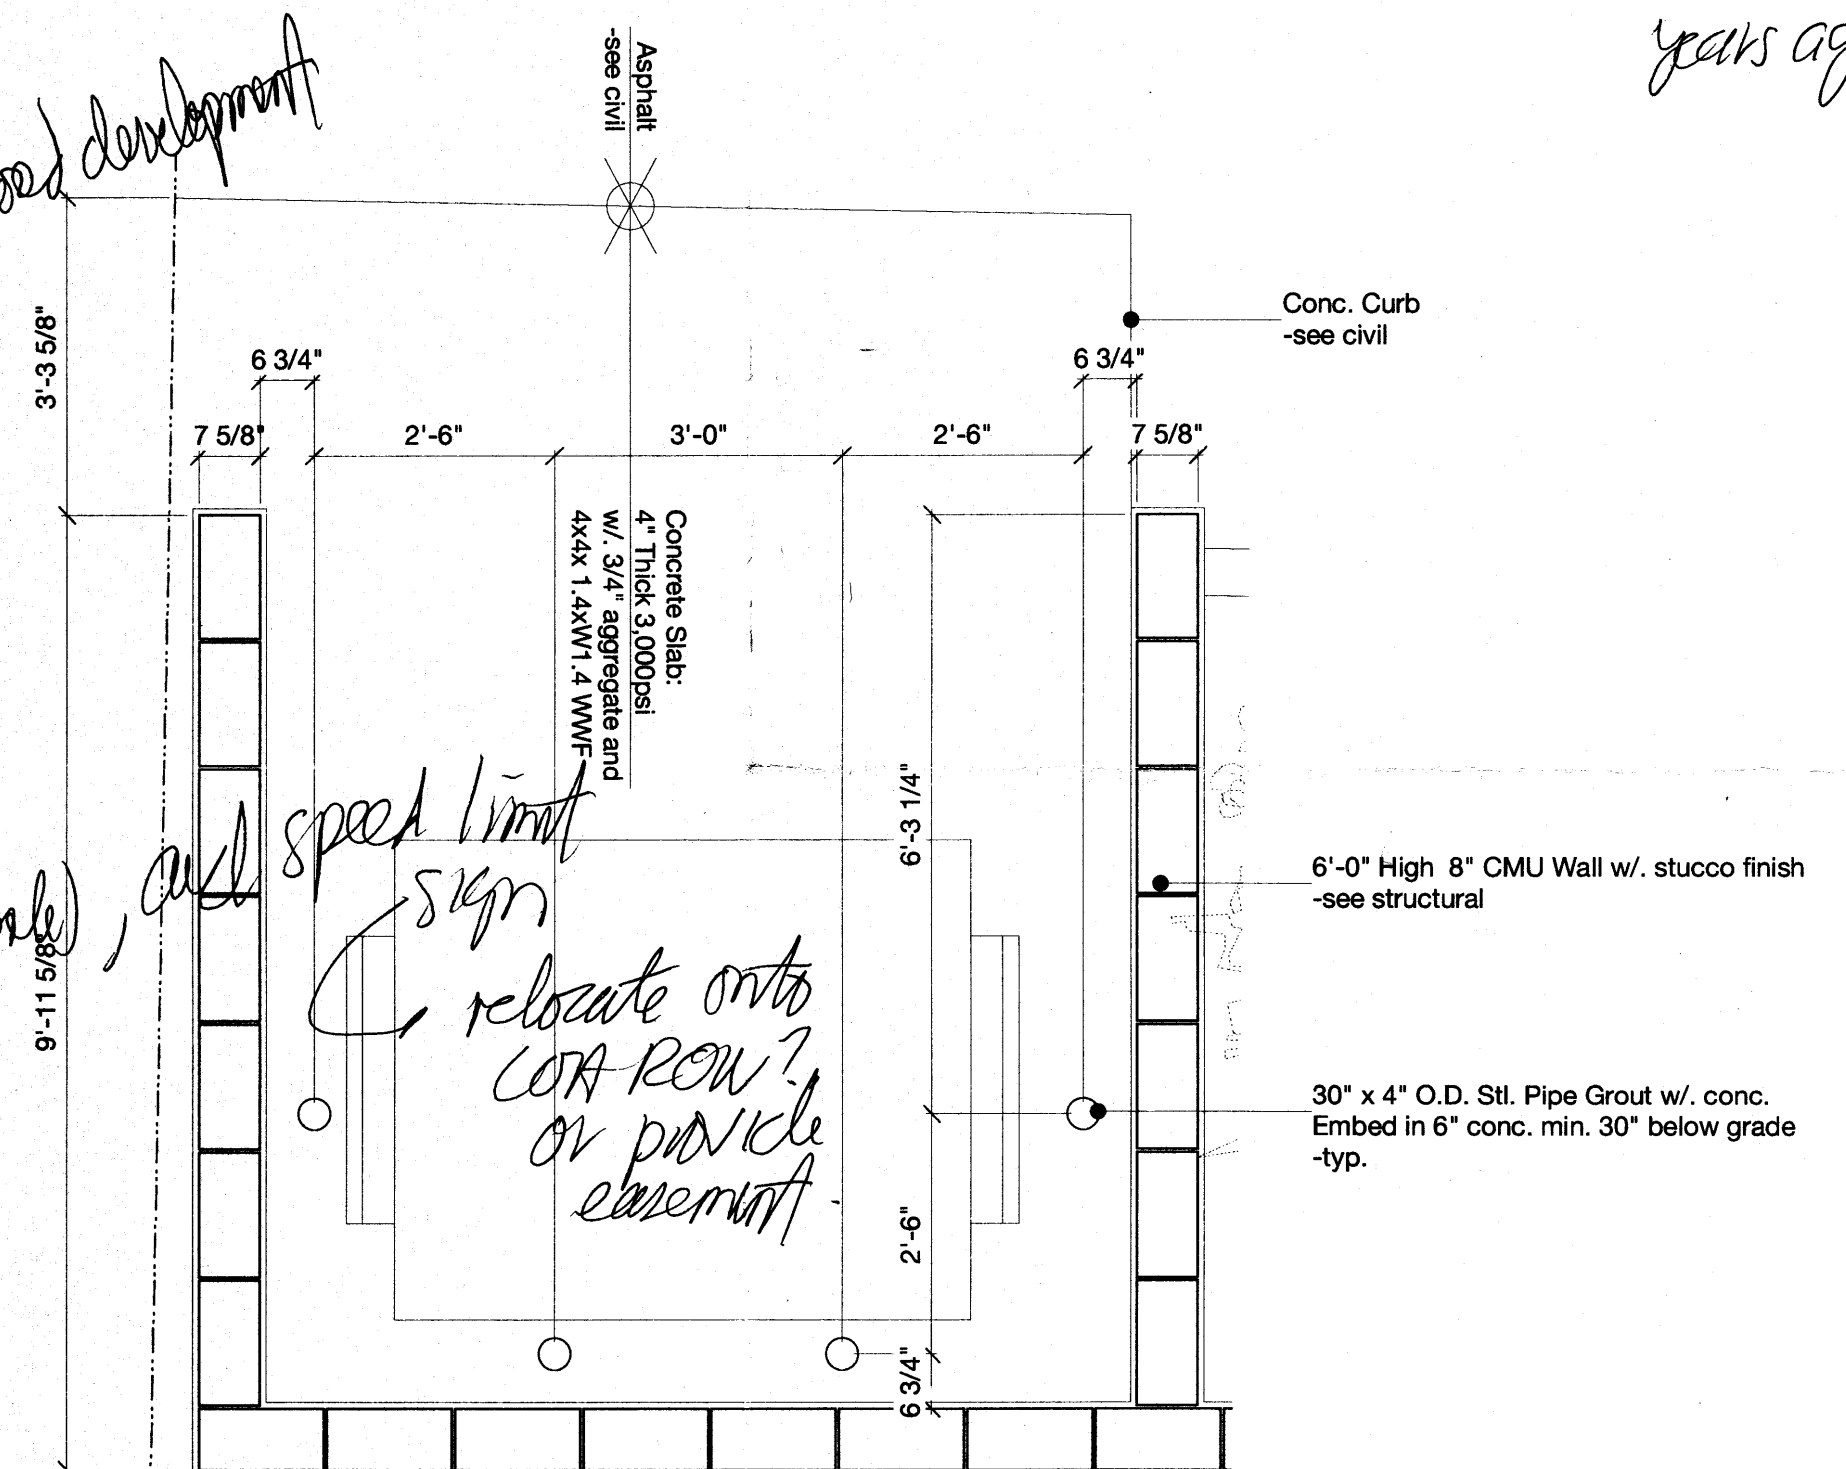

1 Refuse Bin Enclosure  
Scale 1/2" = 1'-0"

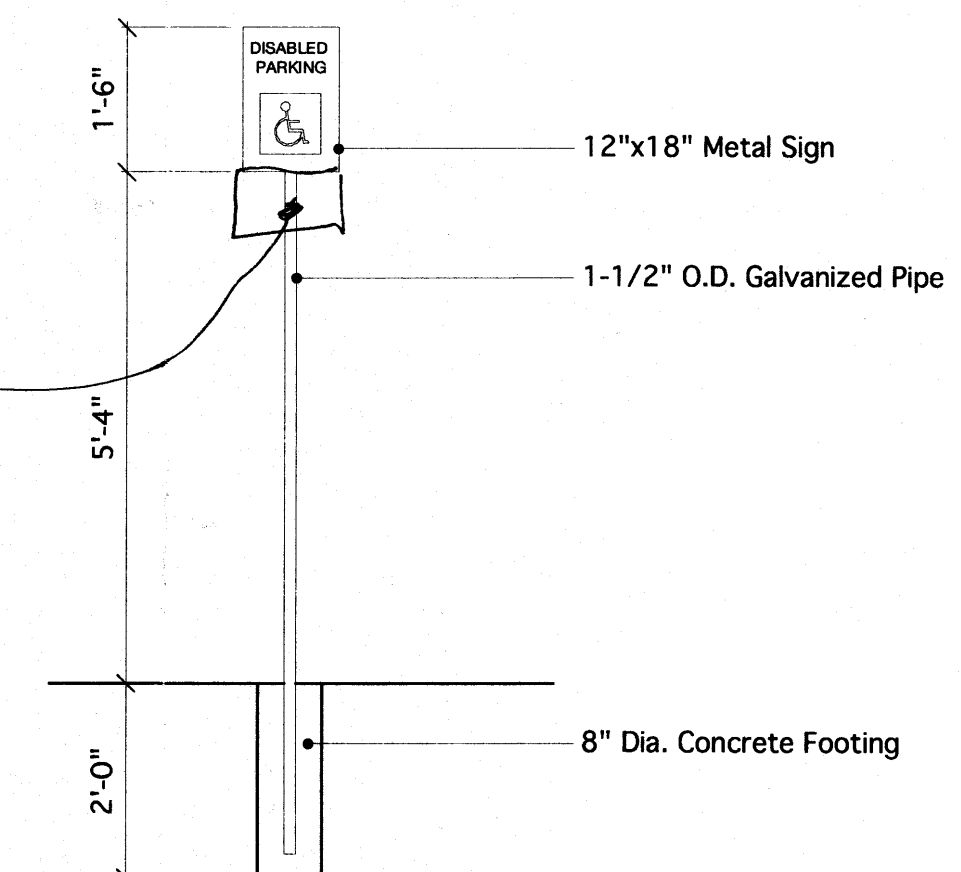

2 HC Sign Detail  
Scale 1/2" = 1'-0"

CODE DATA  
city of albuquerque

Location: Downtown Neighborhood  
Albuquerque, New Mexico  
SU-1 C-1  
w/ conditional use of 100% Dwelling  
J-13-2  
0'-0" Front  
0'-0" Side 5'-0" Side Adjacent to R-1  
0'-0" Back 15'-0" Rear Adjacent to R-1  
26 Feet  
1 space per Bath  
Total 7 spaces

I.B.C.

Occupancy Classification:  
Construction Type:  
Separation:

Allowable Area:  
Usable Open Space:  
Allowable Height:  
Sprinkler:

R-2  
Type Vb  
0 Exterior >10'-0"  
1 Hour Exterior <10'-0"  
1 Hour Between Units  
2 Stories 7,000 sq.ft.  
400sq.ft. / 1-Bed Room Unit  
500sq.ft. / 2-Bed Room Unit  
2 Stories  
NA

show existing  
SW transition  
& connection

New driveway per 2425  
(Provide detail of driveway and demonstrate you are providing 3' @ 2' CS for ADA access at driveway entrance)

- General Note:
1. Remove existing sidewalk and driveway entrance's. Replace with new Conc. Sidewalk and driveway entrance. Patch Curb and Gutter where required. Conform to city Specs. Paving Sidewalk Details DWG 2430 Curb Type Sidewalk
  2. Conform to city Specs. Paving Sidewalk Details DWG 2415A Standard Curb and Gutter
  3. Conform to ICC/ANSI standards 406 Curb Ramps

Sorry but std c/g 8"

One lot existing?  
or two?  
Explain w/ proposed development

Block adjacent to  
PD? on  
future parking  
area? &

(pull box)  
PB & pole (power pole)  
are within  
your property,  
you'll need  
to relocate  
provide note  
to relocate or  
provide easement  
for PP & PB

Mountain Road  
(ROW Varies)

Fire Hydrant Located  
Directly Across Mountain Road  
@ NW Corner of Mt. Rd. and 11th St.

Mark  
Any driveway  
closure  
Refer 2430 SW  
2415A C&G (include)

(SW)  
Need sidewalk easement

No!  
Move  
to (P)  
property line

Need 6'  
sidewalk

or curbing  
(conc.)

Cross  
Access  
easement

provide  
documents

Approx. 6" Curb  
-see civil for exact grades  
-see note: 2

Asphalt  
Parking  
Lot  
-see civil

Conc. Parking  
Bumper  
71"x8"x5"  
typ.

Conc.  
Pad  
-see dtl.  
1-this shd.

MC Ramp  
-see note: 3

Traffic Control Layout  
Scale 1/8" = 1'-0"

provide van accessible  
stall (add 8' refuge stall)



Not acceptable design (per DPM)  
Ramp will need to be  
located at sidewalk

Need 5' Keyway per DPM  
(NOT NEEDED BECAUSE YOU'LL  
BE ADDING REFUGE STALL)


What is  
existing  
here?  
wall?  
extra parking?  
Explain

36  
112  
49


24  
12  
36

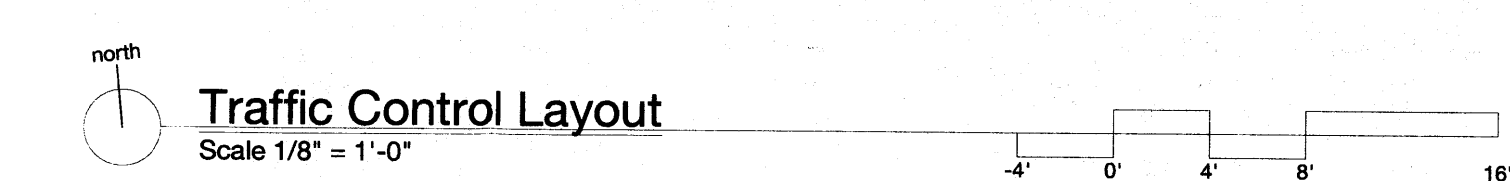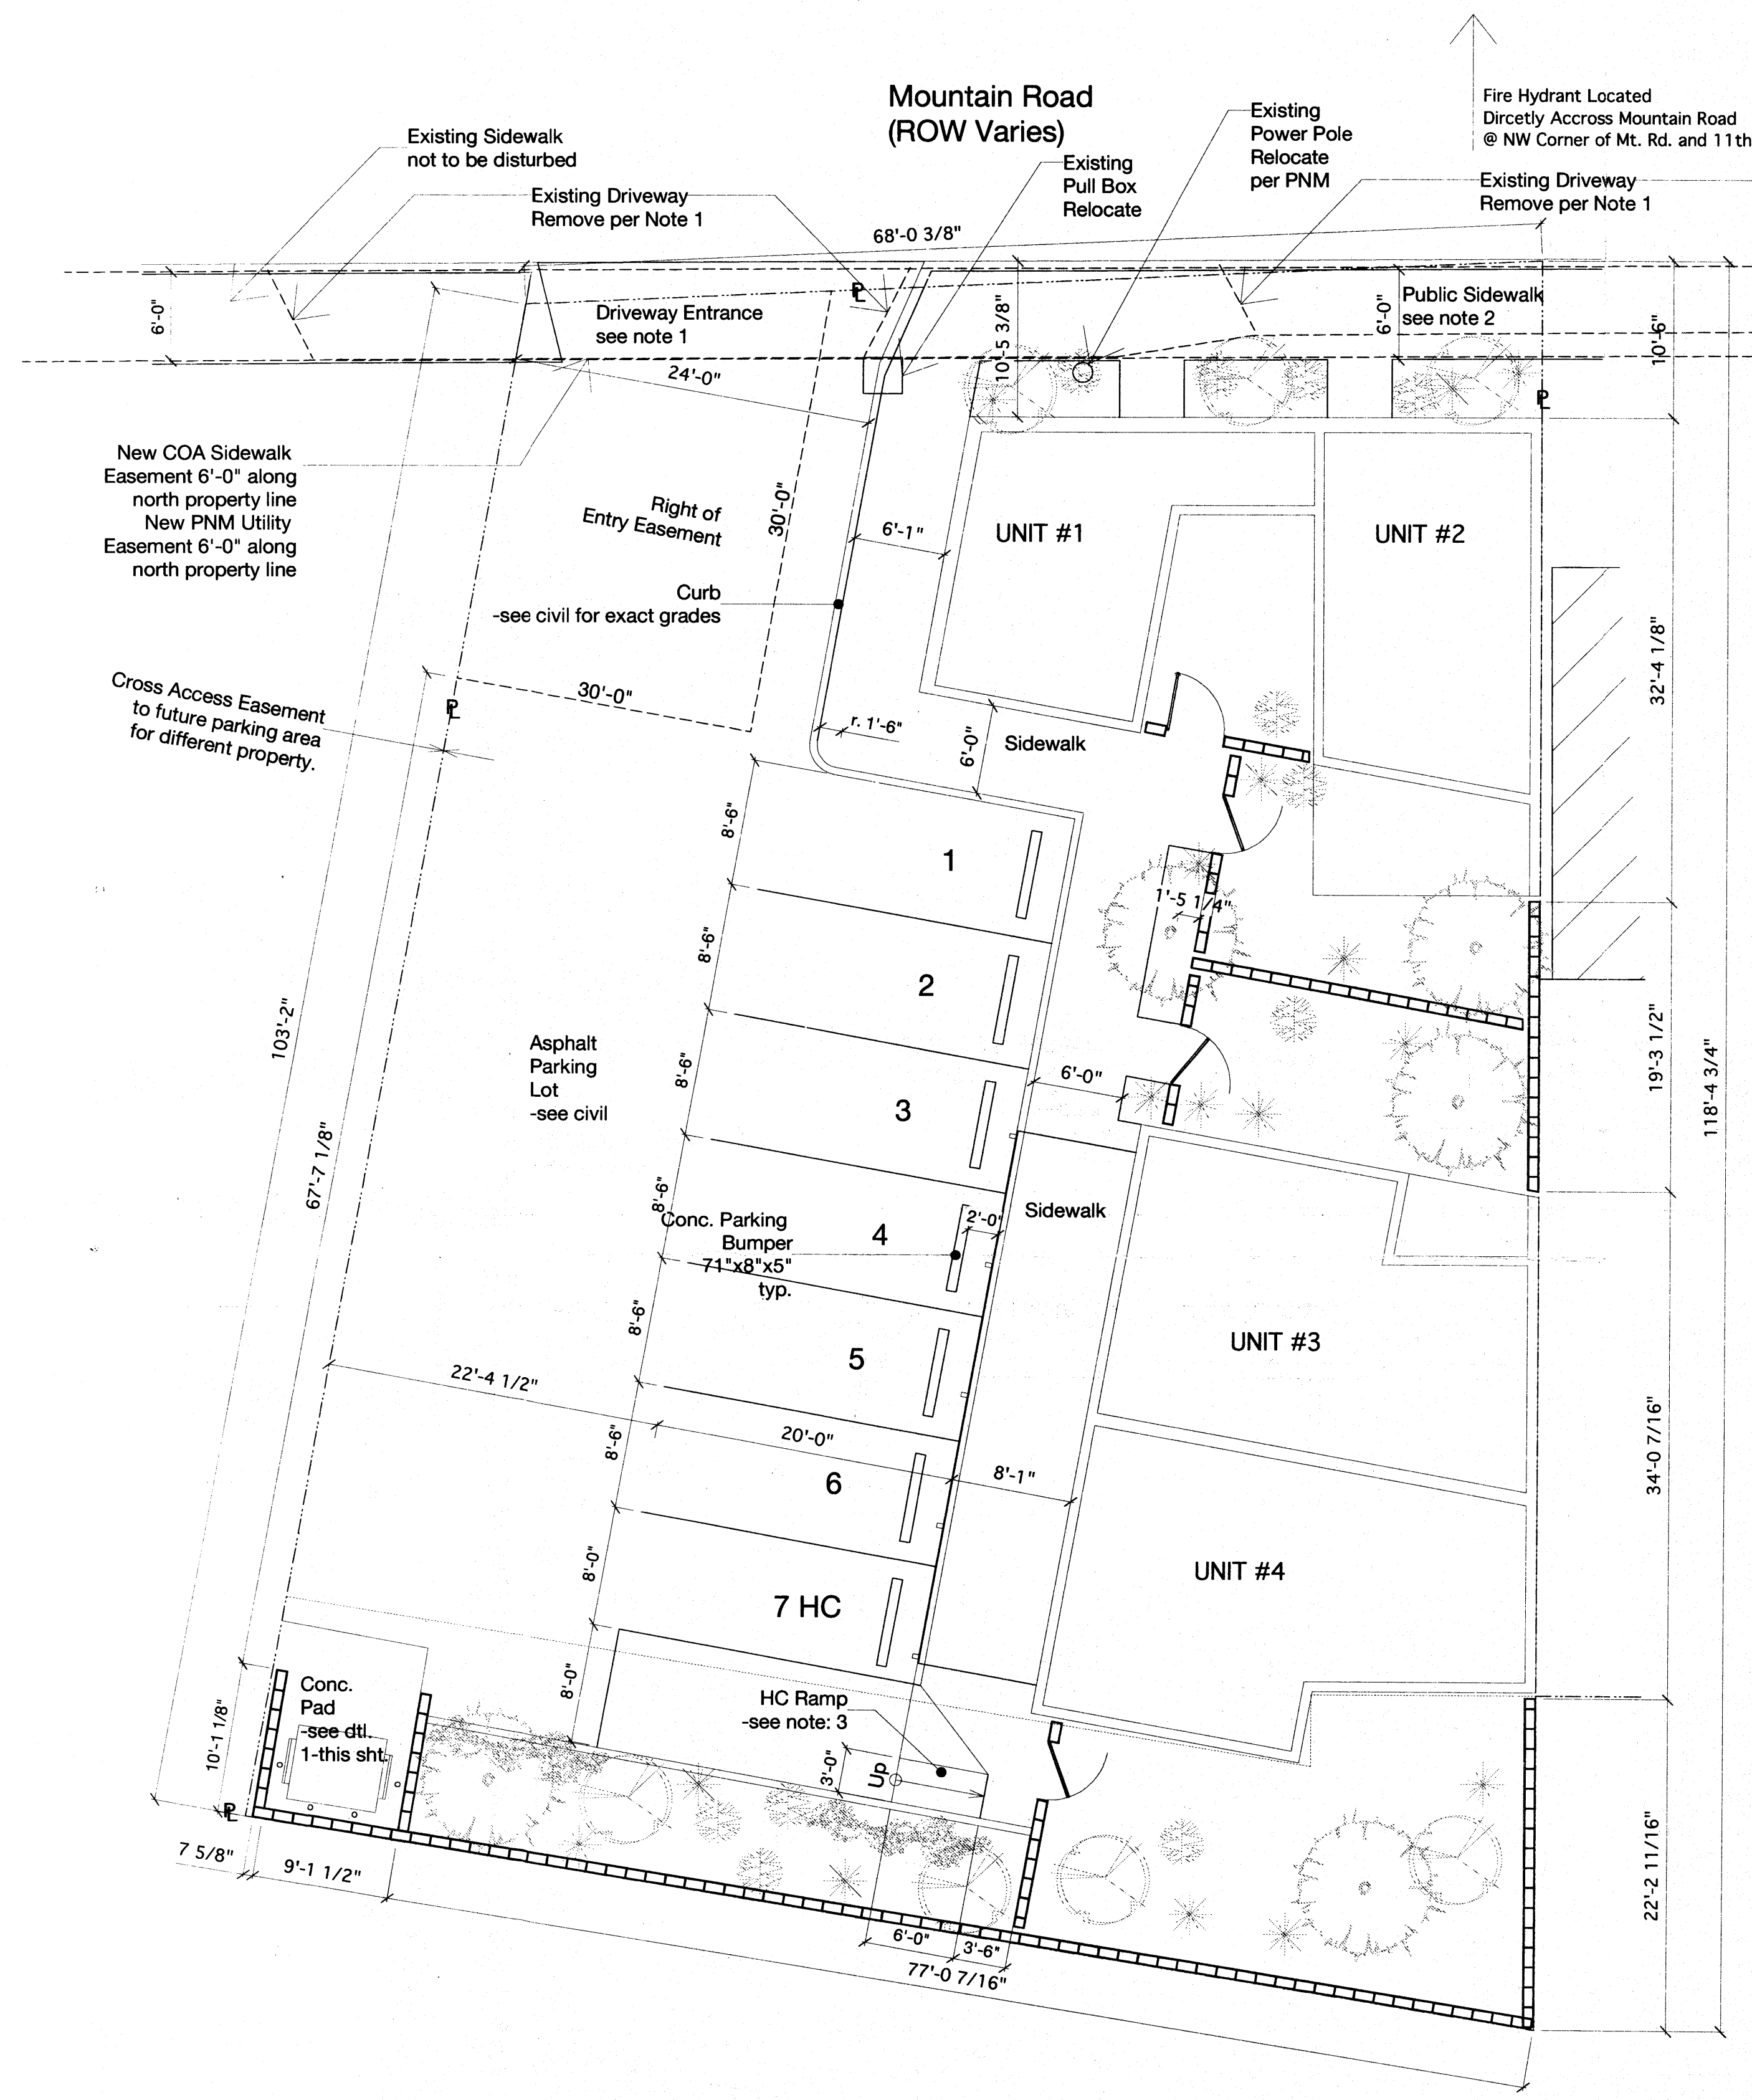

- General Note:
1. Remove existing sidewalk and driveway entrance's. Replace with new Conc. Sidewalk and driveway entrance. Patch Curb and Gutter where required. Conform to city Specs. Paving Sidewalk Details DWG 2430 Curb Type Sidewalk
  2. Conform to City Specs. Paving and Sidewalk Details DWG 2415A Standard 8" Curb and Gutter
  3. Conform to City Standards.
  4. New Driveway to conform to City Specs. DWG 2425 w/ 3'-0" sidewalk entrance apron @2" for ADA access.
  5. Contractor is responsible for coordinating all site utility relocations and is responsible for providing all required placement and clearances.
  6. This is a single lot.

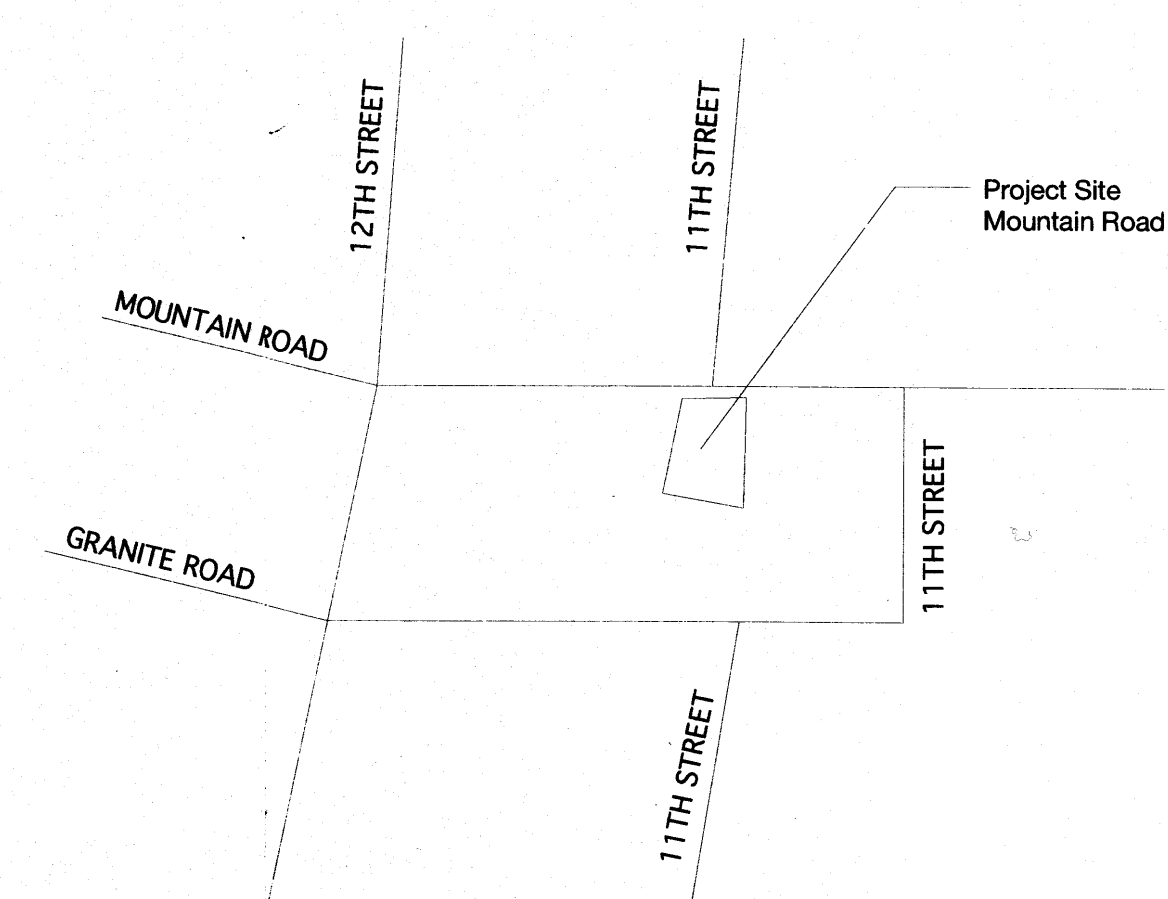

**VICINITY PLAN**  
NTS

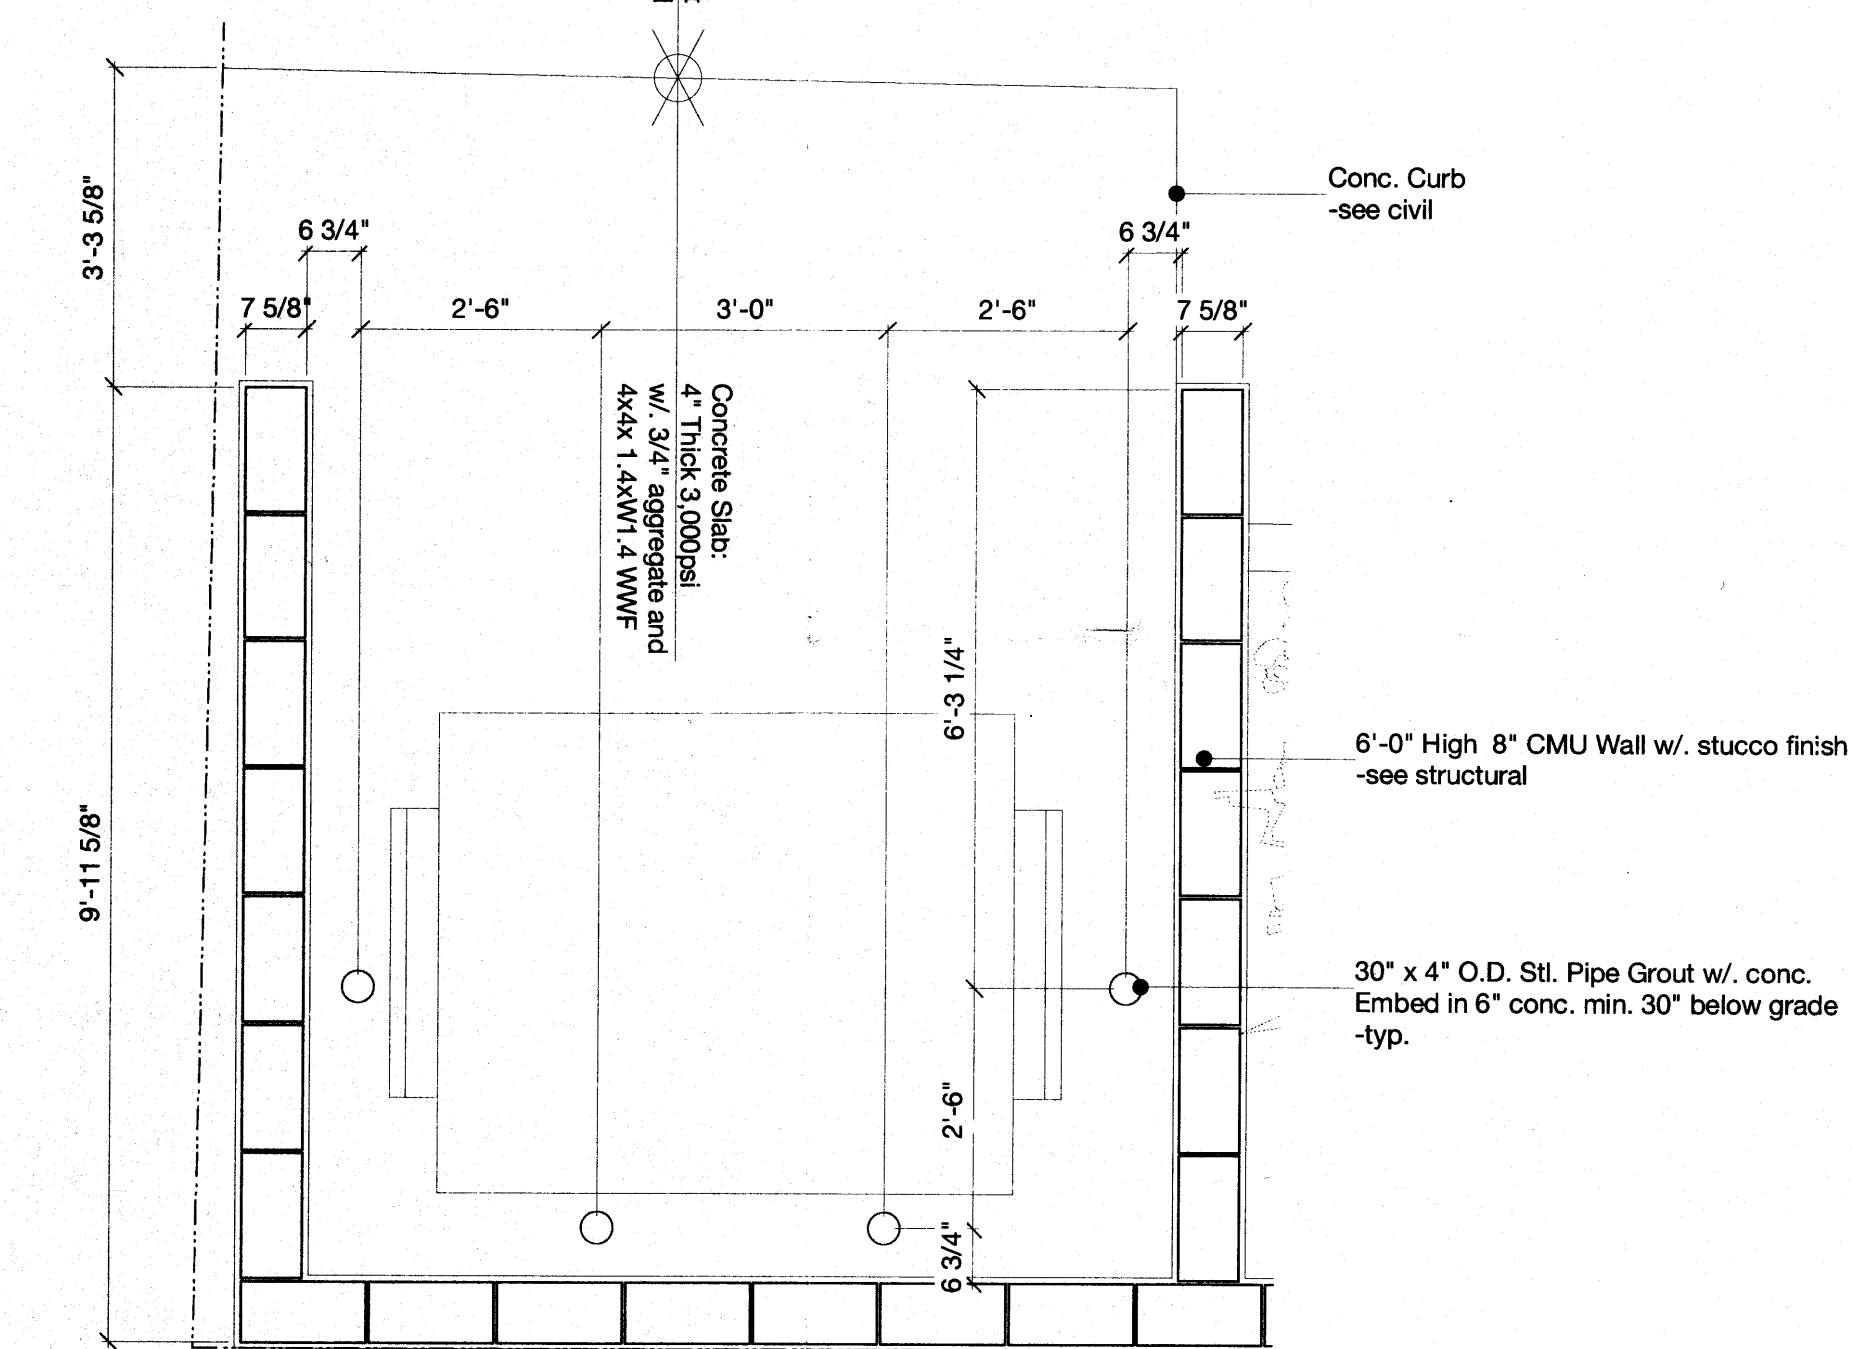

**1 Refuse Bin Enclosure**  
Scale 1/2" = 1'-0"

**CODE DATA**  
city of albuquerque


Location: Downtown Neighborhood  
Albuquerque, New Mexico  
SU-2 C-1  
w/ conditional use of 100% Dwelling  
J-13-Z  
0'-0" Front  
0'-0" Side 5'-0" Side Adjacent to R-1  
0'-0" Back 15'-0" Rear Adjacent to R-1  
26 Feet  
1 space per Bath  
Total 7 spaces

**I.B.C.**

Occupancy Classification:  
Construction Type:  
Separation:

Allowable Area:  
Usable Open Space:  
Allowable Height:  
Sprinkler:

R-2  
Type Vb  
0 Exterior >10'-0"  
1 Hour Exterior <10'-0"  
1 Hour Between Units  
2 Stories 7,000 sq.ft.  
400sq.ft. / 1-Bed Room Unit  
500sq.ft. / 2-Bed Room Unit  
2 Stories  
NA

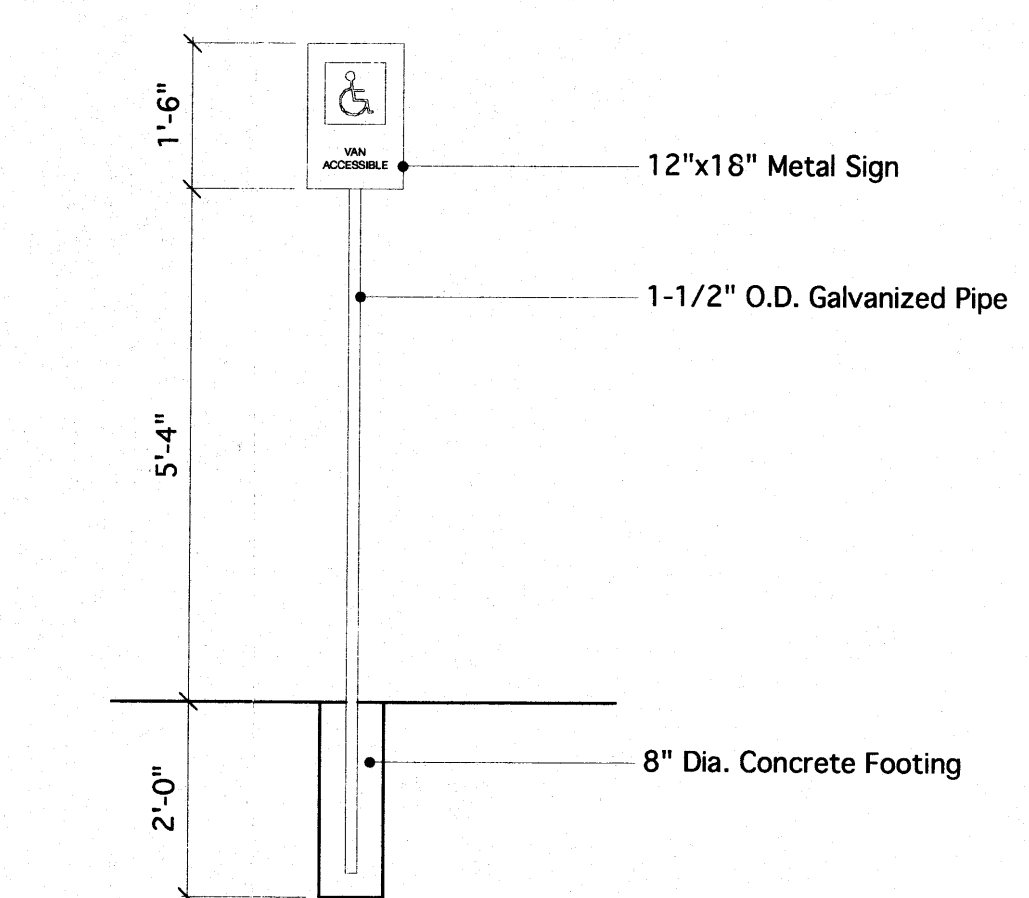

**2 HC Sign Detail**  
Scale 1/2" = 1'-0"

**WORKSHOP ARCHITECTS**

811 12TH ST. NW  
ALBUQUERQUE, NEW MEXICO  
87102


PH. 505.246.9608

tredeign@earthlink.net

**Mountain Road Town Homes**  
MOUNTAIN ROAD  
ALBUQUERQUE, NEW MEXICO 87102



Date:  
June 20, 2006  
Sheet:  
TCL PLAN

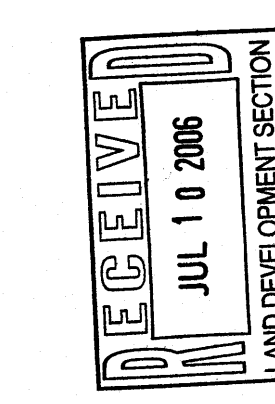




WORKSHOP  
ARCHITECTS

811 12TH ST. NW  
ALBUQUERQUE, NEW MEXICO  
87102

PH. 505.246.9608


treedesign@earthlink.net

Mountain Road Town Homes  
MOUNTAIN ROAD  
ALBUQUERQUE, NEW MEXICO 87102

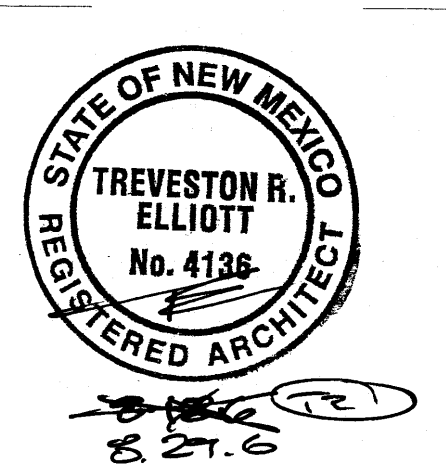


Date:  
August 21, 2006  
Sheet:  
TCL PLAN

A-083


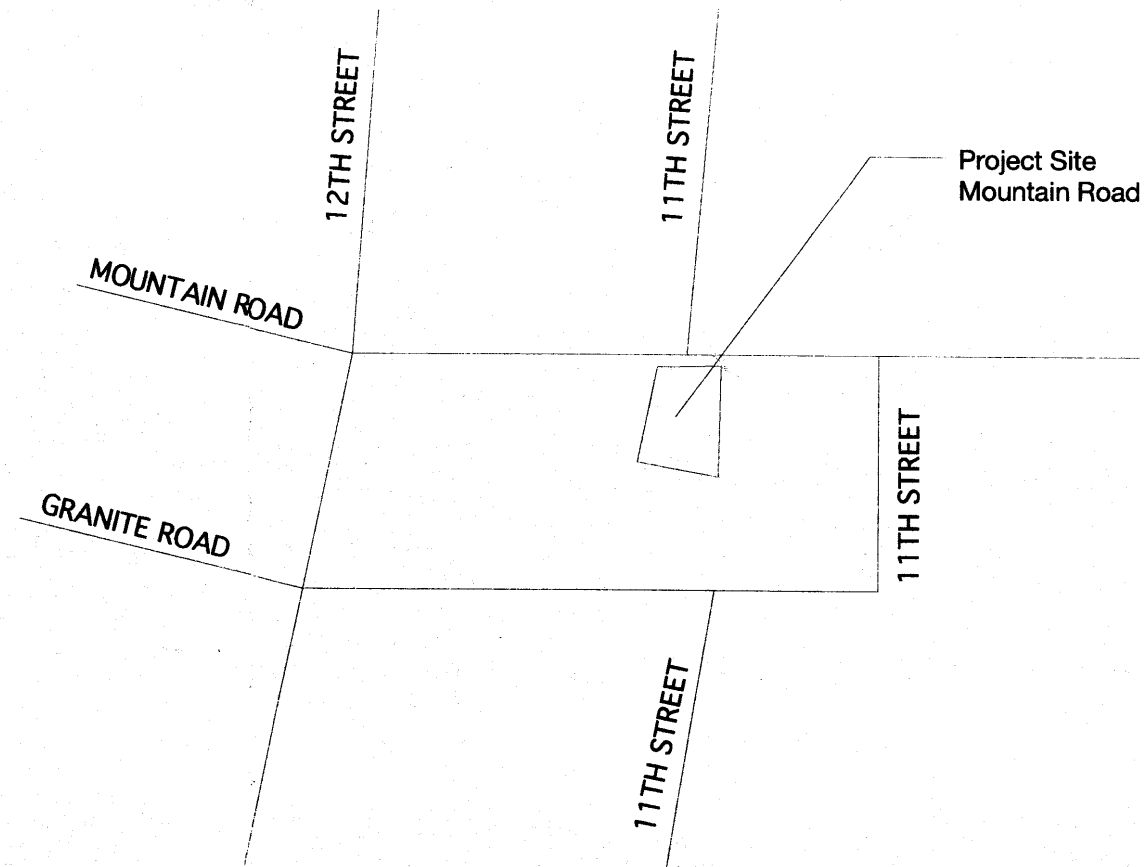


VICINITY PLAN

NTS

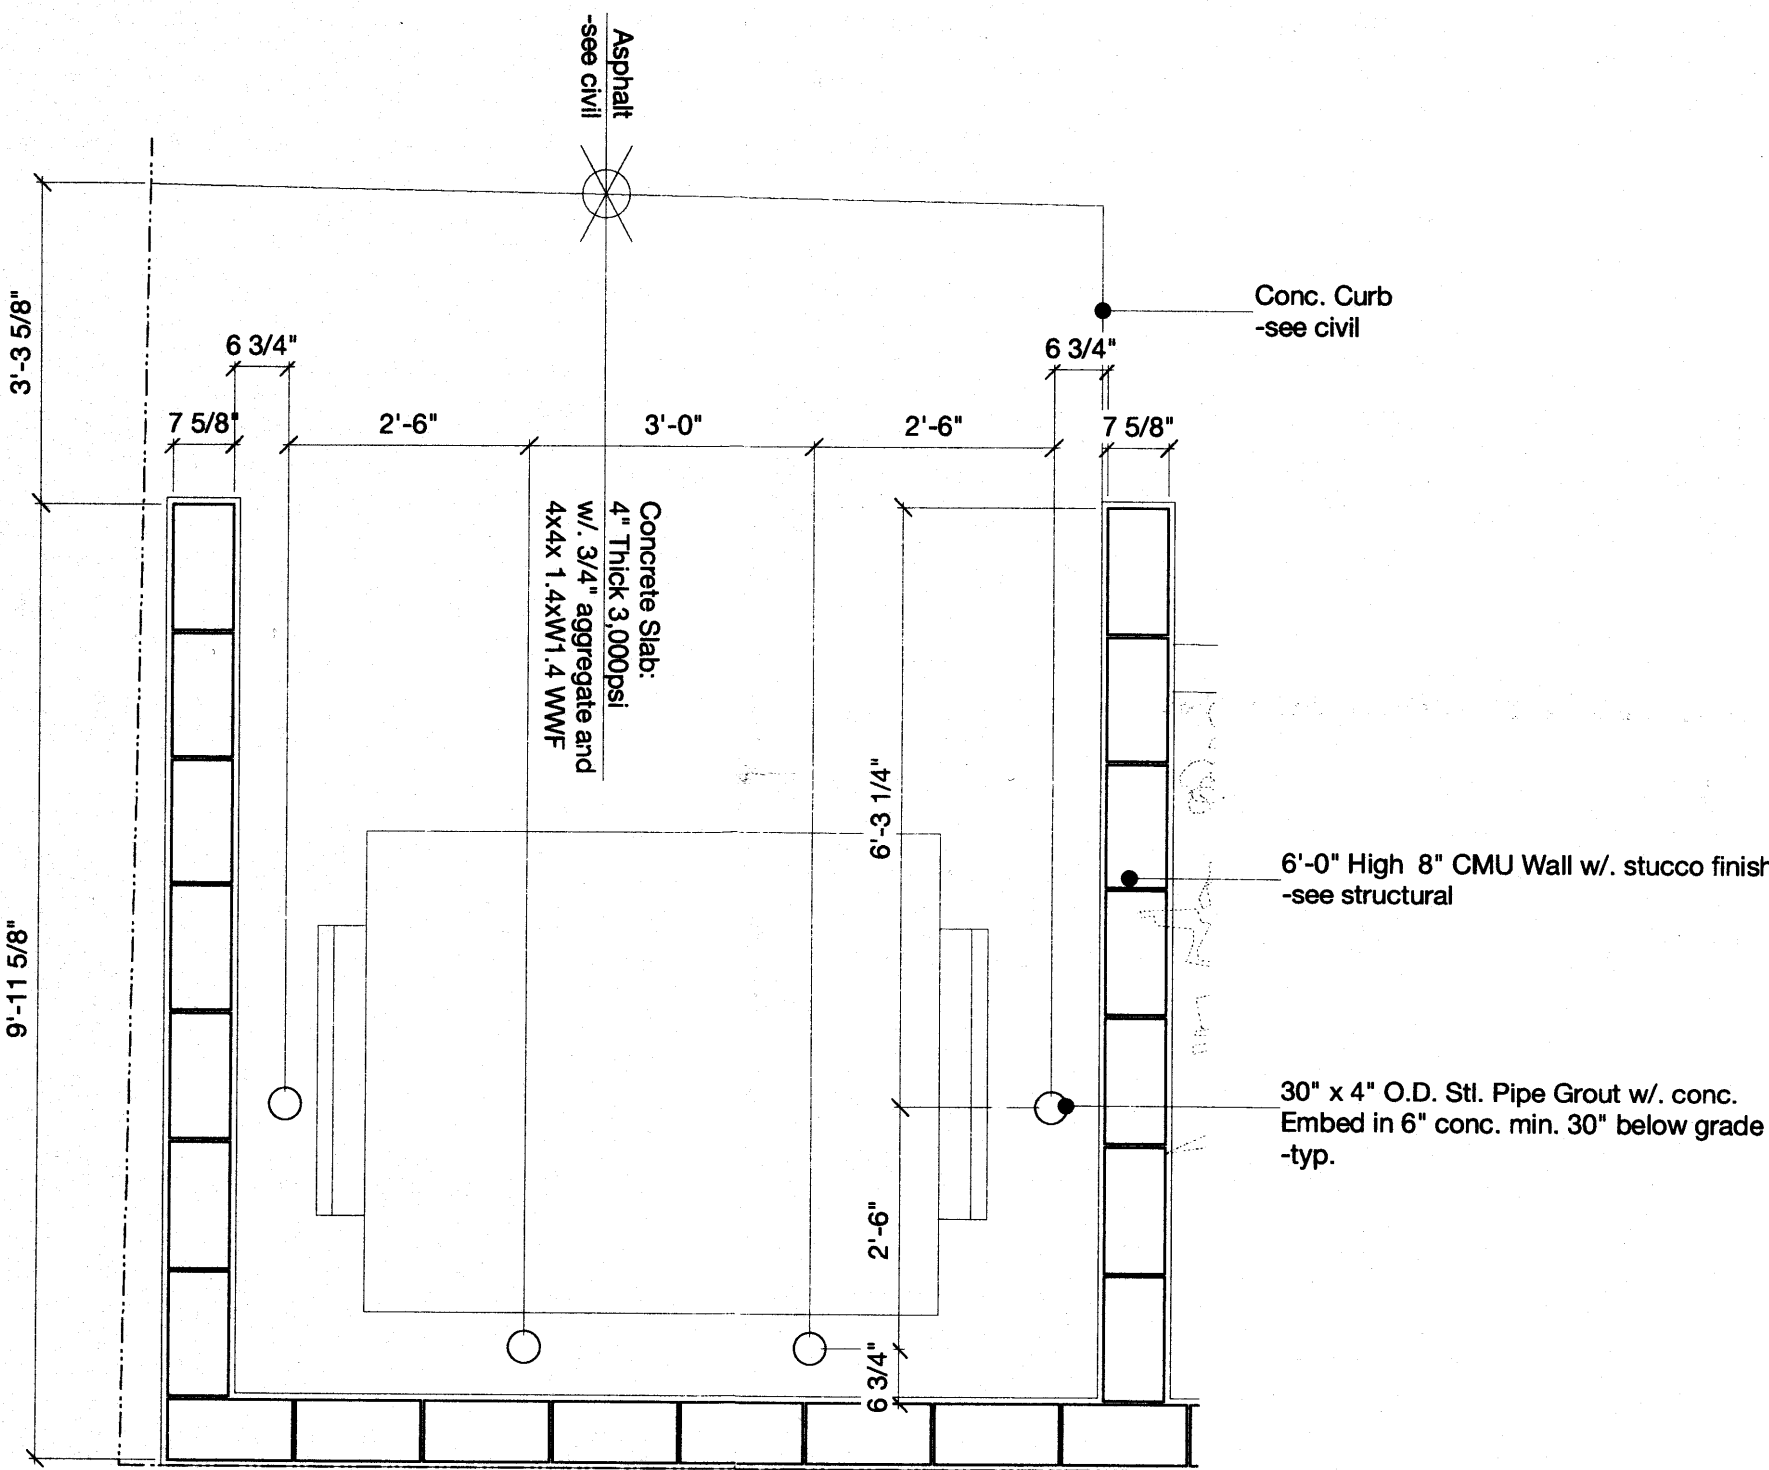

- General Note:
1. Remove existing sidewalk and driveway entrance's. Replace with new Conc. Sidewalk and driveway entrance. Patch Curb and Gutter where required. Conform to city Specs. Paving Sidewalk Details DWG 2430 Curb Type Sidewalk
  2. Conform to City Specs. Paving and Sidewalk Details DWG 2415A Standard 8" Curb and Gutter
  3. Conform to City Standards.
  4. New Driveway to conform to City Specs. DWG 2425 w/ 3'-0" sidewalk entrance apron @2" for ADA access.
  5. Contractor is responsible for coordinating all site utility relocations and is responsible for providing all required placement and clearances.
  6. This is a single lot.

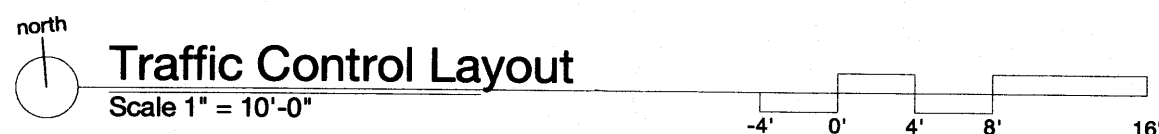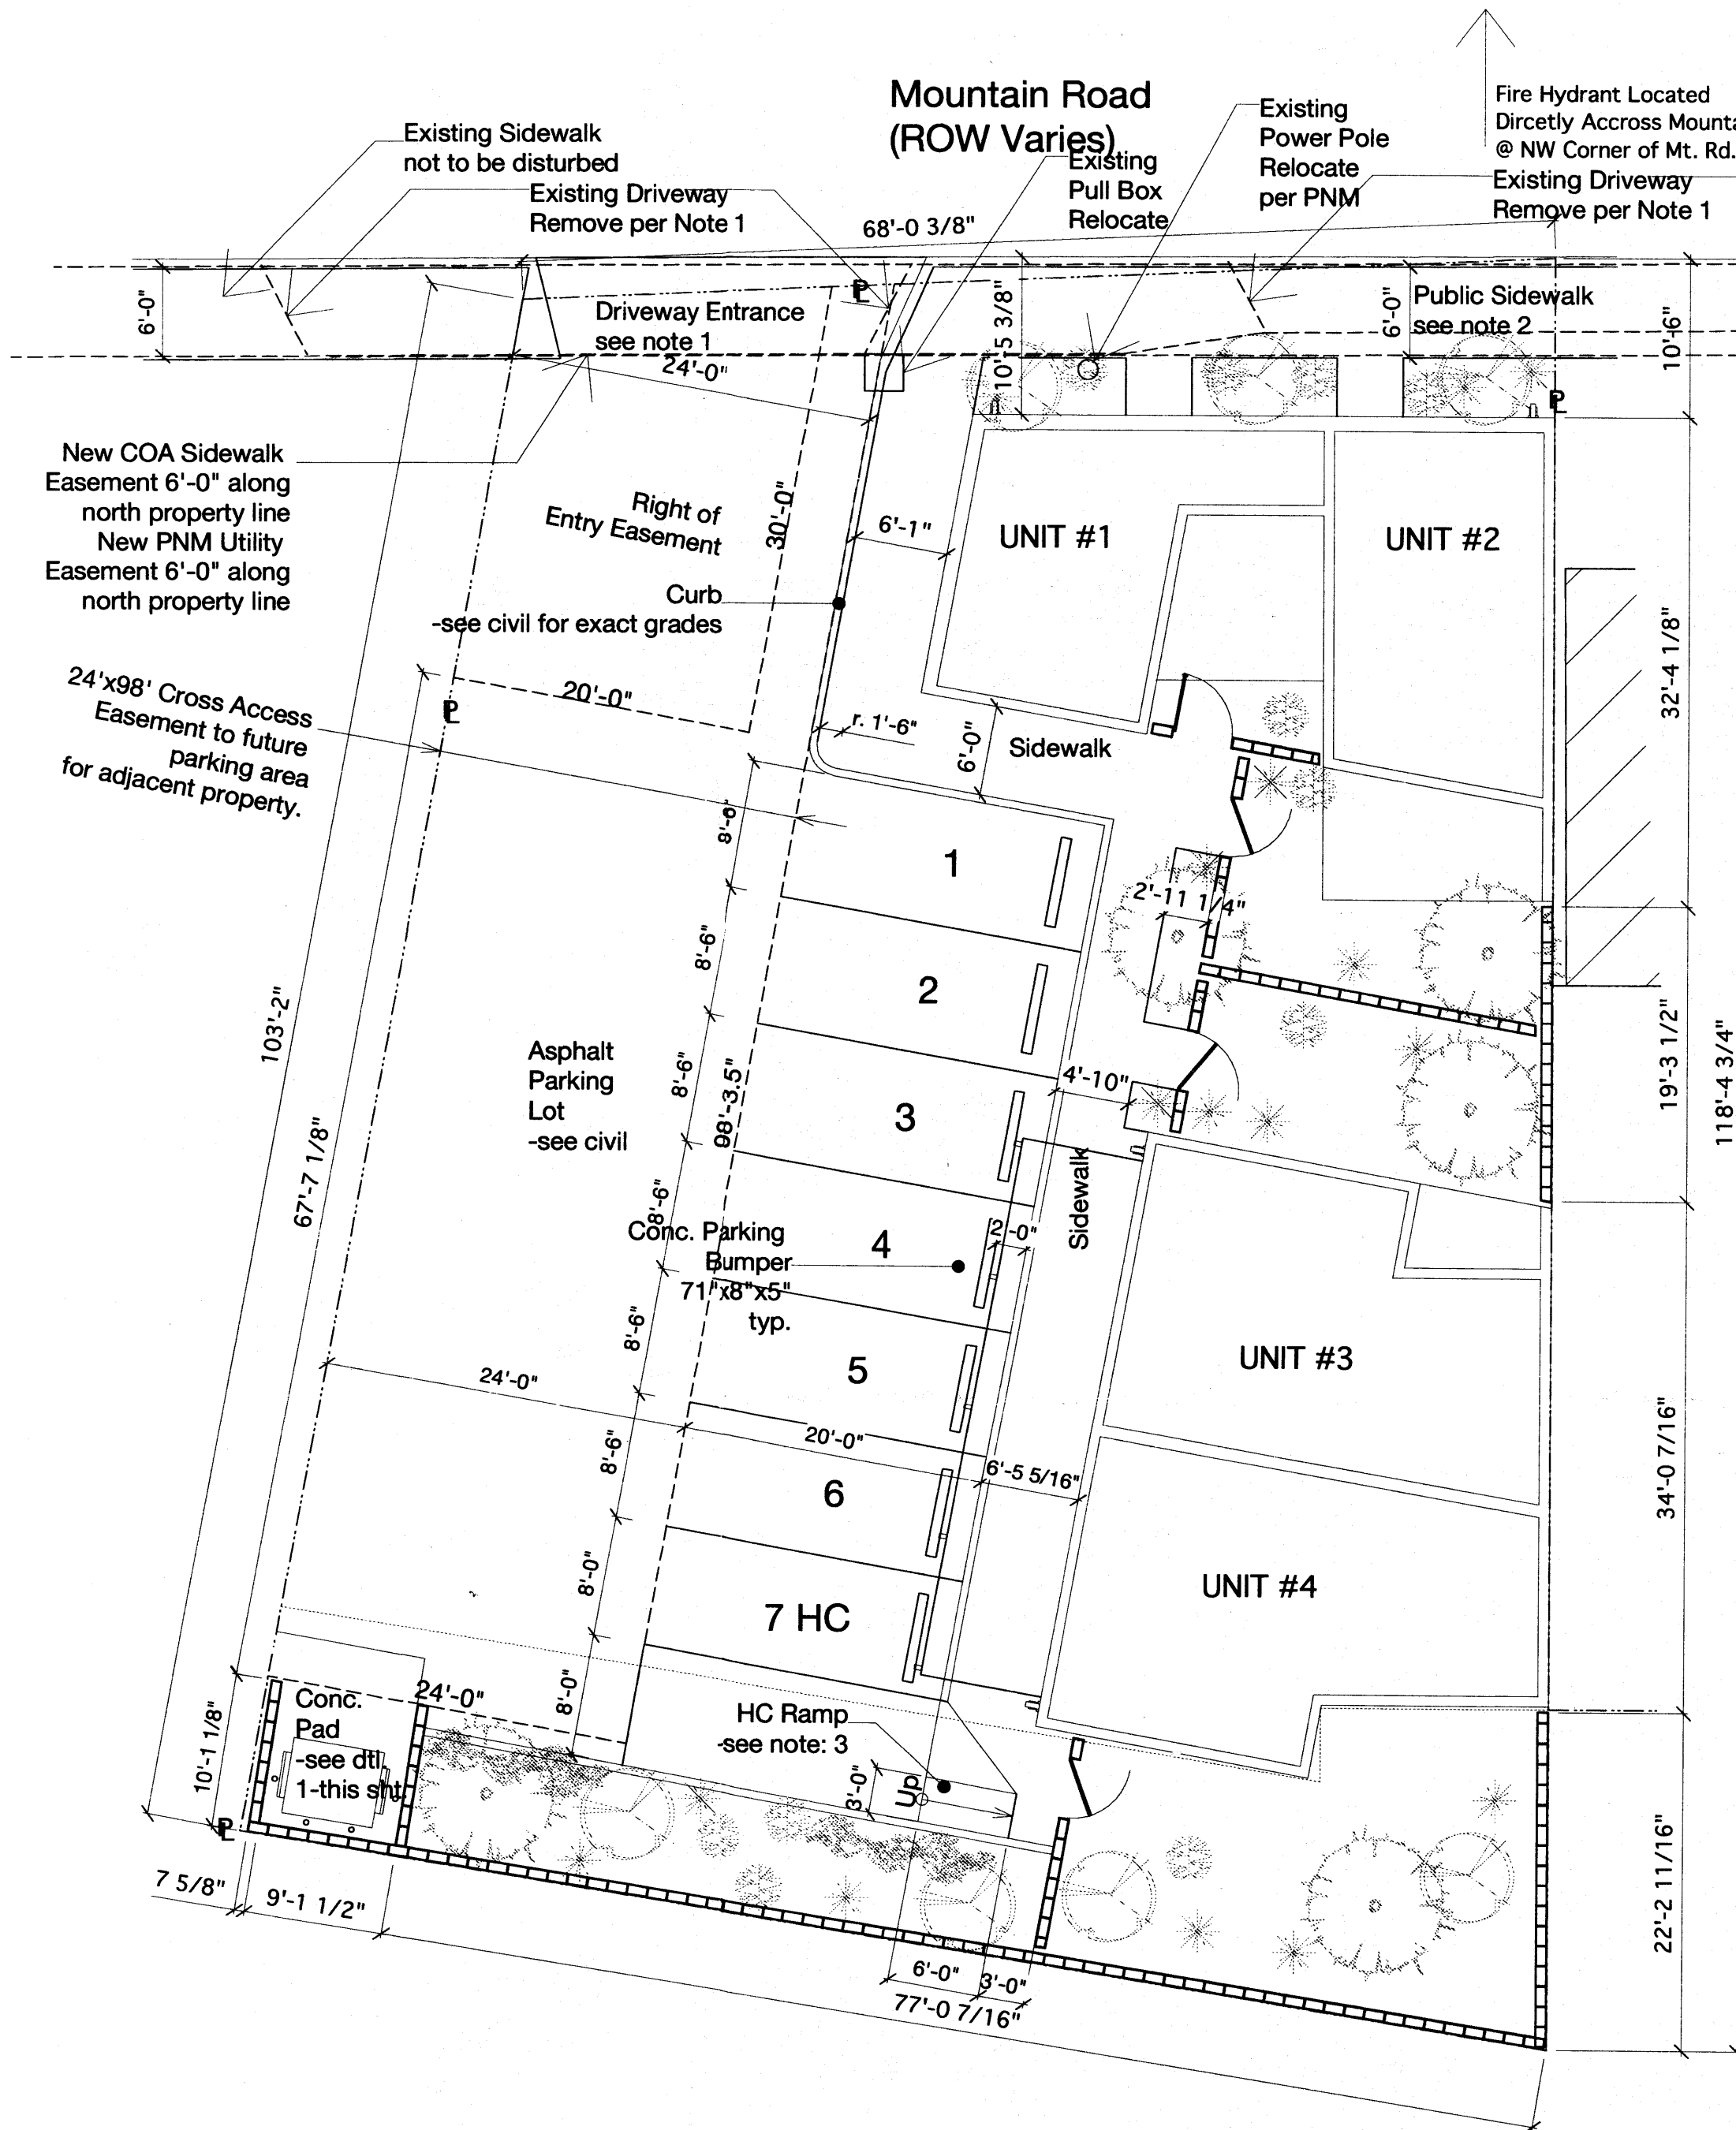

1 Refuse Bin Enclosure  
Scale 1/2" = 1'-0"

CODE DATA  
city of albuquerque



Location: Downtown Neighborhood  
Albuquerque, New Mexico  
SU-2 C-1  
w/ conditional use of 100% Dwelling  
J-13-Z  
0'-0" Front  
0'-0" Side 5'-0" Side Adjacent to R-1  
0'-0" Back 15'-0" Rear Adjacent to R-1  
26 Feet  
1 space per Bath  
Total 7 spaces

I.B.C.

Occupancy Classification:  
Construction Type:  
Separation:

Allowable Area:  
Usable Open Space:  
Allowable Height:  
Sprinkler:

R-2  
Type Vb  
0 Exterior >10'-0"  
1 Hour Exterior <10'-0"  
1 Hour Between Units  
2 Stories 7,000 sq.ft.  
400sq.ft. / 1-Bed Room Unit  
500sq.ft. / 2-Bed Room Unit  
2 Stories  
NFP 13r

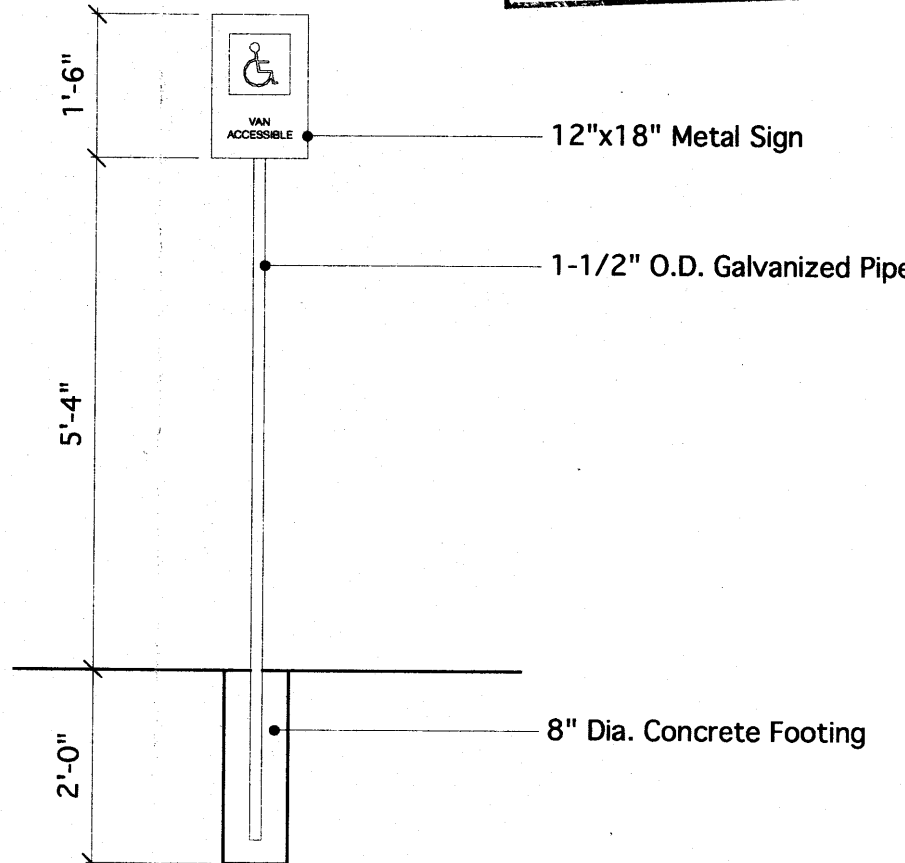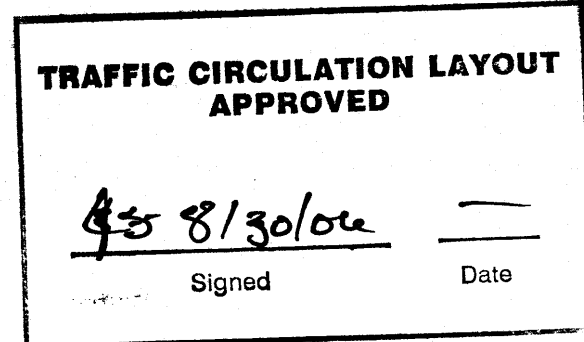



2 HC Sign Detail  
Scale 1/2" = 1'-0"







1. MOUNTAIN ROAD N.W.  
RIGHT-OF-WAY VARIES

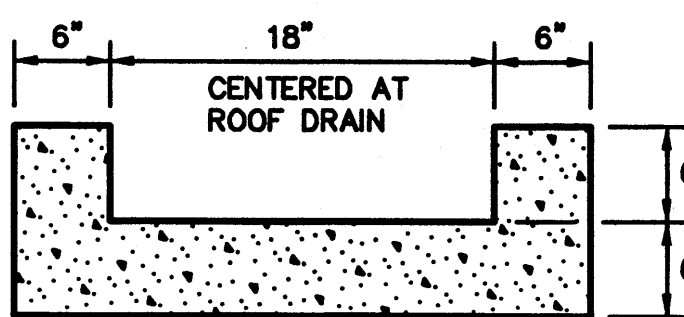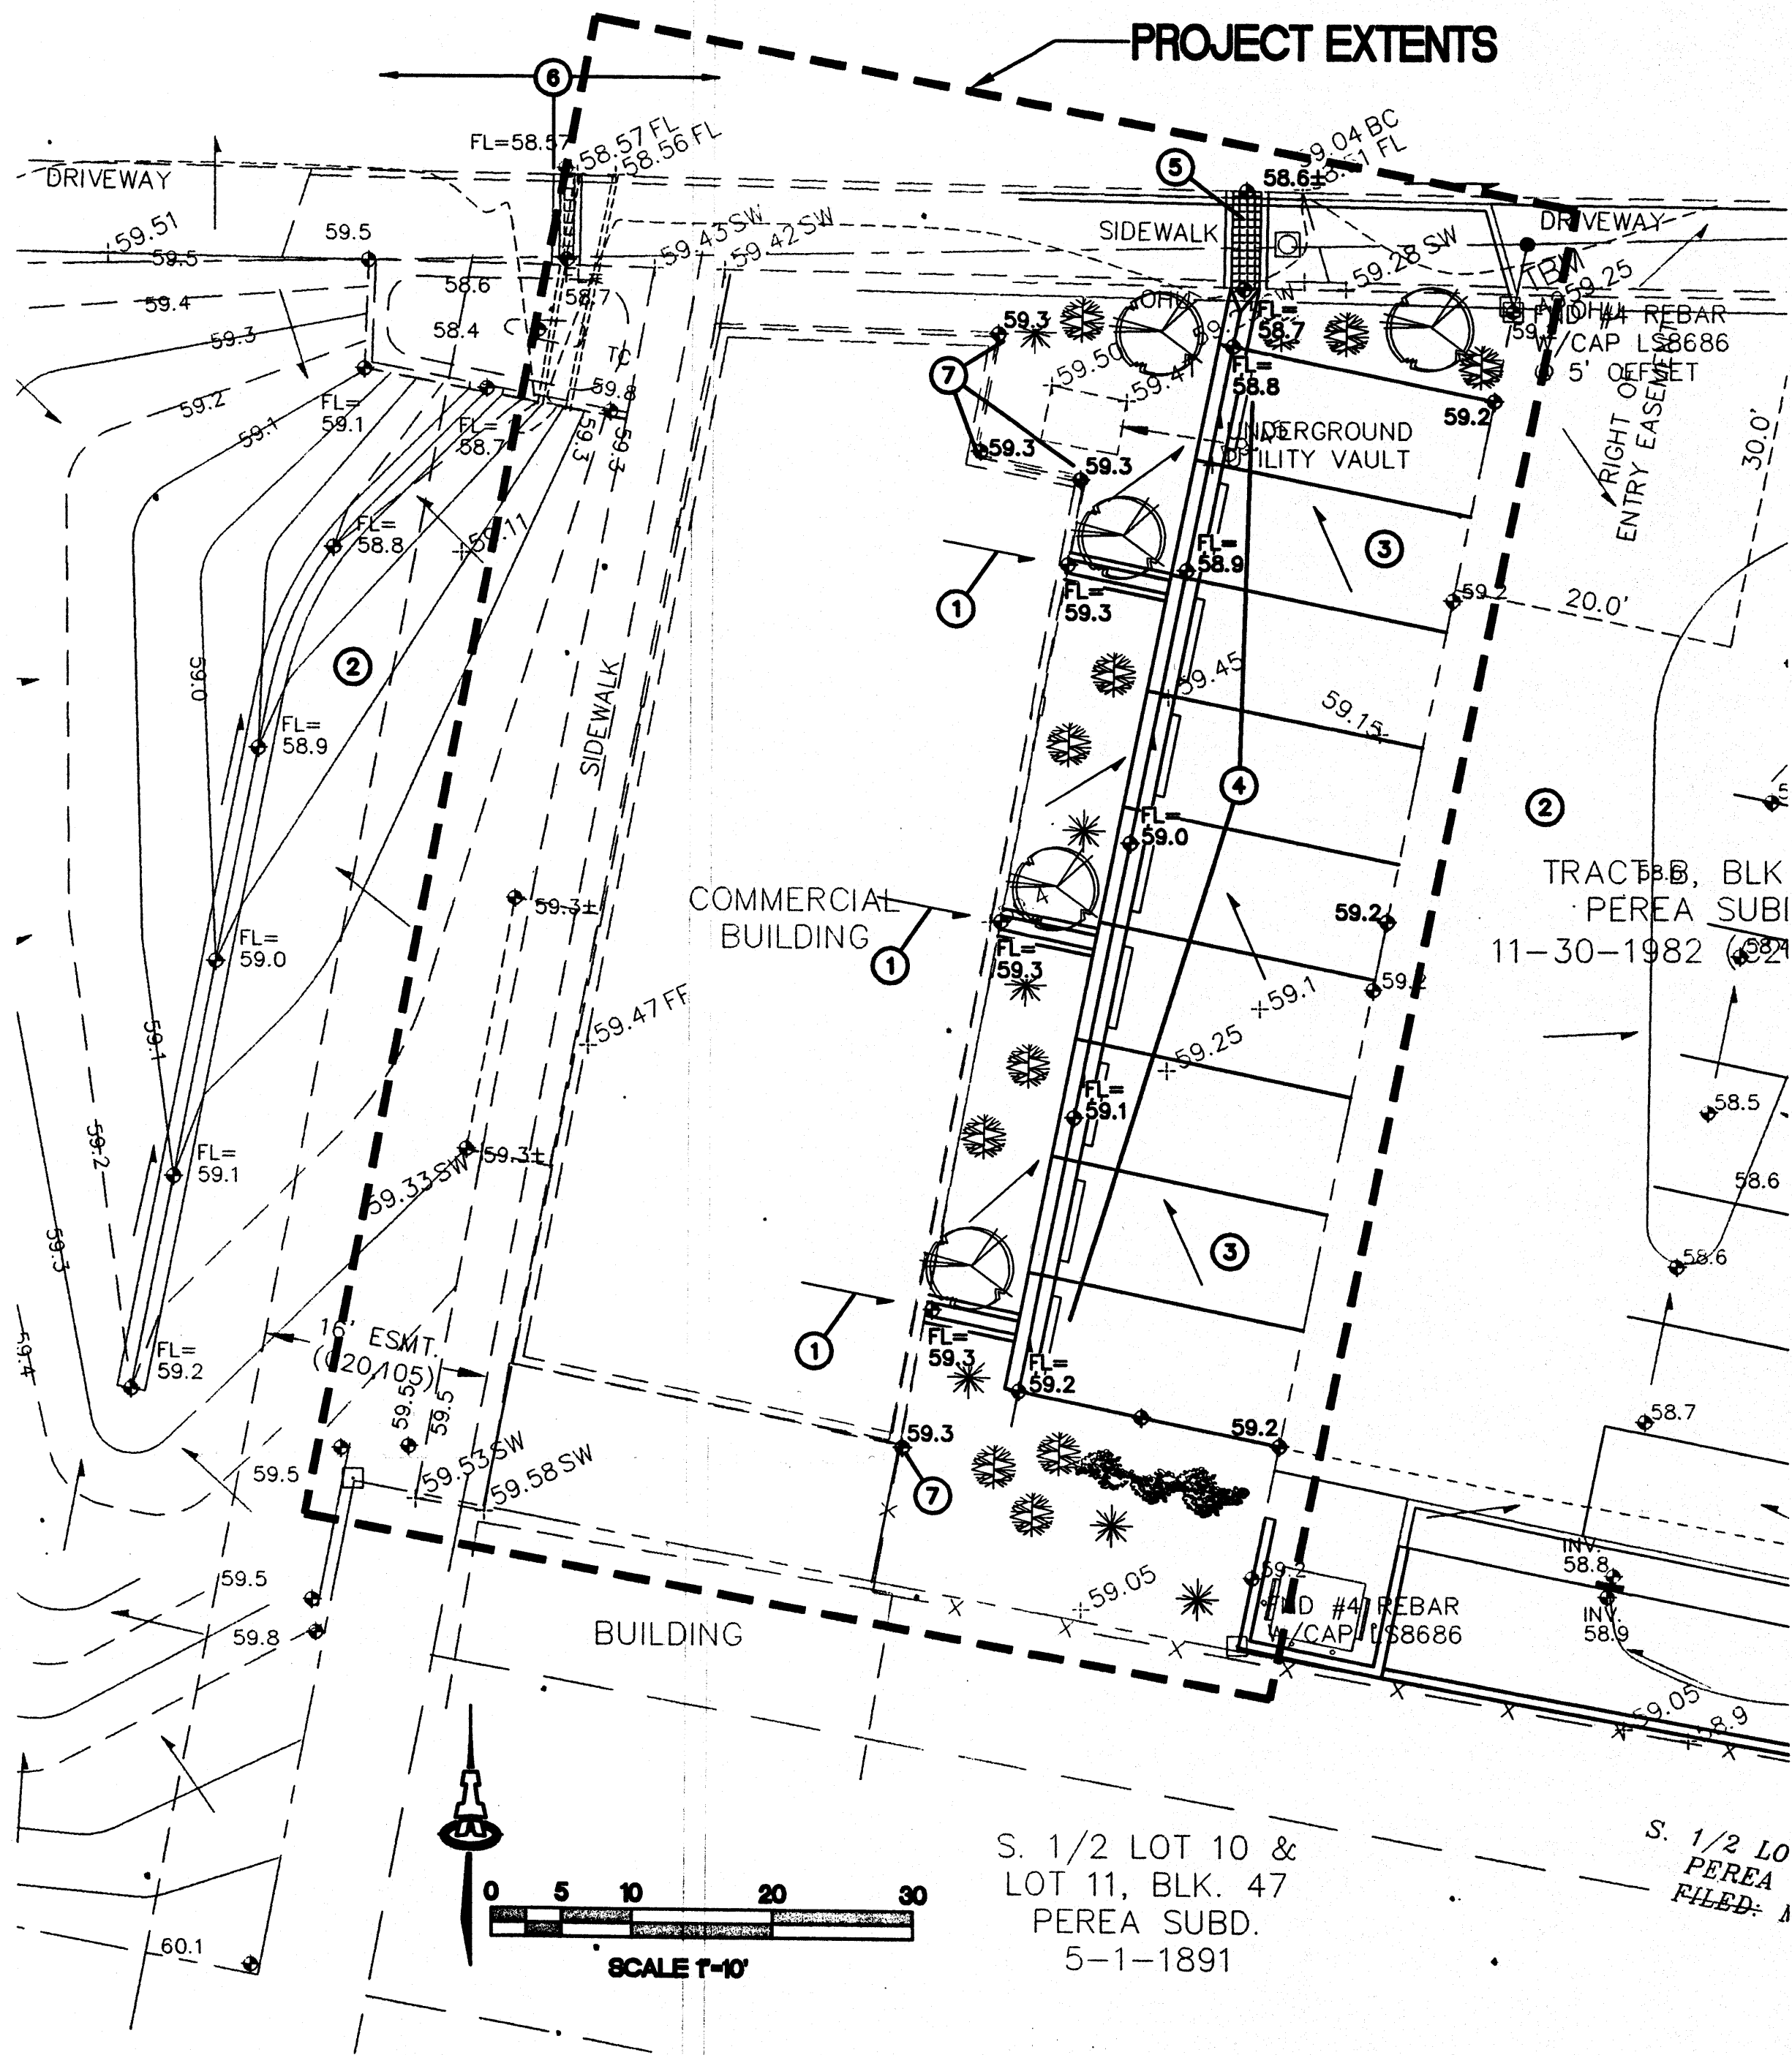


GENERAL NOTES

1. PROVIDE CONST CONTROL JOINTS @ 7' O.C. MAX.
2. EDGES SHOULD BE REMOVED WITH 3/8" EDGING TOOL.

'U' SHAPED CONC. CHANNEL

N.T.S.

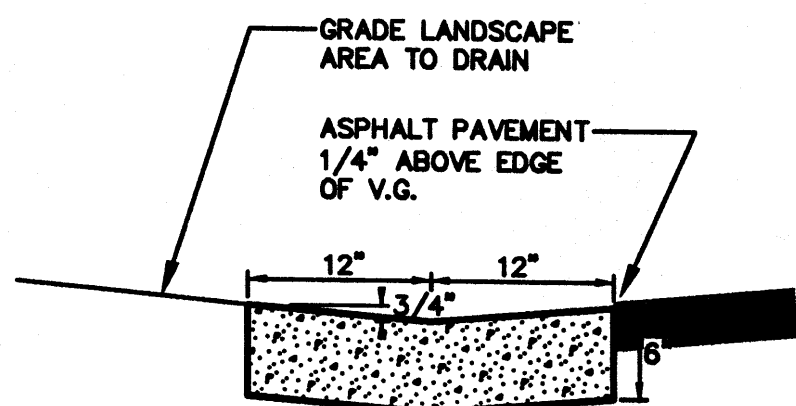

GENERAL NOTES

1. PROVIDE CONST CONTROL JOINTS @ 7' O.C. MAX.
2. EDGES SHOULD BE REMOVED WITH 3/8" EDGING TOOL.

CONCRETE ALLEY GUTTER

N.T.S.

CALCULATIONS: Mountain Road Laundry Paving : June 18, 2007			
Based on Drainage Design Criteria for City of Albuquerque Section 22.2, DPM, Vol 2, dated Jan., 1993			
ON-SITE			
AREA OF SITE:	6150	SF	= 0.1 Ac.
HISTORIC FLOWS:			
On-Site Historic Land Condition	Area a = 0 SF	Area b = 0 SF	Area c = 615 SF
	Area d = 5335 SF	Area e = 923 SF	Area f = 5228 SF
Total Area =	6150 SF	Total Area =	6150 SF
DEVELOPED FLOWS:			
On-Site Developed Land Condition	Area a = 0 SF	Area b = 0 SF	Area c = 923 SF
	Area d = 5228 SF	Area e = 923 SF	Area f = 5228 SF
Total Area =	6150 SF	Total Area =	6150 SF
EXCESS PRECIP:			
Precip. Zone	2	Ea = 0.53	Eb = 0.78
		Ec = 1.13	Ed = 2.12
On-Site Weighted Excess Precipitation (100-Year, 6-Hour Storm)			
Weighted E =	EaAa + EbAb + EcAc + EdAd		
	Aa + Ab + Ac + Ad		
Historic E =	2.02 in.	Developed E =	1.97 in.
On-Site Volume of Runoff: V360 = E*A / 12			
Historic V360 =	1036 CF	Developed V360 =	1010 CF
On-Site Peak Discharge Rate: Qp = QpaAa + QpbAb + QpcAc + QpdAd / 43,560			
For Precipitation Zone 2			
Qpa = 1.56	Qpc = 3.14	Qpb = 2.28	Qpd = 4.70
Historic Qp =	0.64 CFS	Developed Qp =	0.63 CFS

GENERAL NOTES

- COORDINATE WORK WITH SITE PLAN, DEMOLITION PLAN AND LANDSCAPE PLAN.
- IT IS THE CONTRACTOR'S RESPONSIBILITY TO FIELD VERIFY EXISTING CONDITIONS PRIOR TO CONSTRUCTION. REPORT ALL DISCREPANCIES TO THE ARCHITECT AND VERIFY THE ARCHITECT'S INTENT BEFORE PROCEEDING.
- ADJUST RIMS OF EXISTING UTILITY FEATURES AS NECESSARY TO MATCH NEW GRADES. TYPICAL CONTRACTOR TO FIELD VERIFY AND PROTECT ALL EXISTING UTILITIES WITHIN AREA TO BE IMPROVED.
- ALL NEW PAVEMENT SURFACES SHALL BE CONSTRUCTED WITH POSITIVE SLOPE AWAY FROM BUILDINGS AND POSITIVE SLOPE TOWARD EXISTING / PROPOSED DRAINAGE PATHS. WHERE NEW GRADES ARE SHOWN AS '±', TRANSITION TO EXISTING SHALL BE SMOOTH AND LEVEL.
- WATER SHALL NOT POND ON PAVED AREAS. WHERE NEW/EXIST. GRADES ARE SHOWN AS 'MATCH', TRANSITION SHALL BE SMOOTH AND LEVEL.
- FINAL GRADES SHOWN REPRESENT TOP OF FINISH MATERIAL (I.E. TOP OF CONCRETE, TOP OF CONCRETE BUILDING PAD, TOP OF PAVEMENT MATERIAL, TOP OF LANDSCAPING MATERIAL, ETC.). CONTRACTOR SHALL GRADE, COMPACT SUBGRADE AND DETERMINE EARTHWORK ESTIMATES BASED ON ELEVATIONS SHOWN MINUS MATERIAL THICKNESSES.

PROJECT DATA

THE PROPOSED IMPROVEMENTS INCLUDE REMOVAL / REPLACEMENT OF EXISTING ASPHALT PAVING AND ASSOCIATED SITE LANDSCAPING.

THE SITE IS LOCATED ON SOUTH SIDE OF MOUNTAIN ROAD WEST OF 12TH STREET. (VICINITY MAP J-13). MOUNTAIN ROAD BORDERS THE PROPERTY TO THE NORTH, DEVELOPED COMMERCIAL TO THE EAST AND WEST (SAME OWNER BOTH SIDES), AND DEVELOPED RESIDENTIAL TO THE SOUTH. THE SURROUNDING AREA IS FULLY DEVELOPED.

THE PRESENT SITE IS A DEVELOPED COMMERCIAL PROPERTY WITH EXISTING STRUCTURES, ASPHALT PAVEMENT AND COMPACTED EARTH THROUGHOUT.

THE INTENT OF THIS PLAN IS TO SHOW:

- GRADING RELATIONSHIPS BETWEEN THE EXISTING GROUND ELEVATIONS AND PROPOSED FINISHED ELEVATIONS IN ORDER TO FACILITATE POSITIVE DRAINAGE TO DESIGNATED DISCHARGE POINTS.
- THE EXTENT OF PROPOSED SITE IMPROVEMENTS, INCLUDING BUILDINGS, WALKS AND PAVEMENT.
- THE FLOW RATE/VOLUME OF RAINFALL RUNOFF ACROSS OR AROUND THESE IMPROVEMENTS AND METHODS OF HANDLING THESE FLOWS TO MEET CITY OF ALBUQUERQUE REQUIREMENTS FOR DRAINAGE MANAGEMENT.
- THE RELATIONSHIP OF ON-SITE IMPROVEMENTS WITH EXISTING NEIGHBORING PROPERTY TO INSURE AN ORDERLY TRANSITION BETWEEN PROPOSED AND SURROUNDING GRADES.

DRAINAGE PLAN CONCEPT:

THE SITE HISTORICALLY FREE DISCHARGES TO MOUNTAIN ROAD WHERE FLOW ENTERS THE PUBLIC STORM SEWER SYSTEM. THE PROPOSED IMPROVEMENTS WILL GENERATE NO ADDITIONAL DISCHARGE DURING THE 100-YEAR, 6-HOUR STORM EVENT (SEE CALCULATIONS THIS SHEET) AND WILL CONTINUE TO FREE DISCHARGE TO MOUNTAIN ROAD.

LEGAL: TRACT A-1, BLOCK 47, PEREA ADDITION, ALBUQUERQUE, BERNALILLO COUNTY, NEW MEXICO

BENCHMARK: THE BASIS OF ELEVATIONS FOR THIS SURVEY IS ACS BENCHMARK 18-J13. THE PUBLISHED ELEVATION OF WHICH IS 4957.09 (BAYD88). BENCHMARK IS LOCATED IN THE SOUTHWEST QUADRANT OF THE INTERSECTION OF LOMAS BLVD. NW AND ELEVENTH ST. NW.

FLOODZONE: PER FIRM MAP 331, THE SITE IS NOT LOCATED WITHIN A FLOODZONE 100 YEAR FLOOD ZONE.


EROSION CONTROL: THE CONTRACTOR IS RESPONSIBLE FOR RETAINING ON-SITE ALL SEDIMENT GENERATED DURING CONSTRUCTION BY MEANS OF TEMPORARY EARTH BERMS OR SILT FENCES AND THE PREPARATION OF AND COMPLIANCE WITH SWPPP AS REQUIRED BY ENVIRONMENTAL PROTECTION AGENCY.

S.O.19 : NOTICE TO CONTRACTORS

- AN EXCAVATION / CONSTRUCTION PERMIT WILL BE REQUIRED BEFORE BEGINNING ANY WORK WITHIN THE CITY RIGHT-OF-WAY.
- ALL WORK DETAILED ON THESE PLANS TO BE PERFORMED, EXCEPT AS OTHERWISE STATED OR PROVIDED FOR HEREON, SHALL BE CONSTRUCTED IN ACCORDANCE WITH THE CITY OF ALBUQUERQUE STANDARD SPECIFICATIONS FOR PUBLIC WORKS CONSTRUCTION, 1986 EDITION AS REVISED THROUGH UPDATE #7 AMENDMENT 1.
- TWO WORKING DAYS PRIOR TO ANY EXCAVATION, THE CONTRACTOR MUST CONTACT NEW MEXICO ONE CALL SYSTEM (260-1990) FOR LOCATION OF EXISTING UTILITIES.
- PRIOR TO CONSTRUCTION, THE CONTRACTOR SHALL EXCAVATE AND VERIFY THE HORIZONTAL AND VERTICAL LOCATIONS OF ALL CONSTRUCTIONS. SHOULD A CONFLICT EXIST, THE CONTRACTOR SHALL NOTIFY THE ENGINEER SO THAT THE CONFLICT CAN BE RESOLVED WITH A MINIMUM AMOUNT OF DELAY.
- BACKFILL COMPACTION SHALL BE ACCORDING TO TRAFFIC / STREET USE.
- MAINTENANCE OF THESE FACILITIES SHALL BE THE RESPONSIBILITY OF THE OWNER OF THE PROPERTY SERVED.
- WORK ON ARTERIAL STREETS SHALL BE PERFORMED ON A 24-HOUR BASIS.

APPROVAL	NAME	DATE
INSPECTOR		

VICINITY MAP J-13

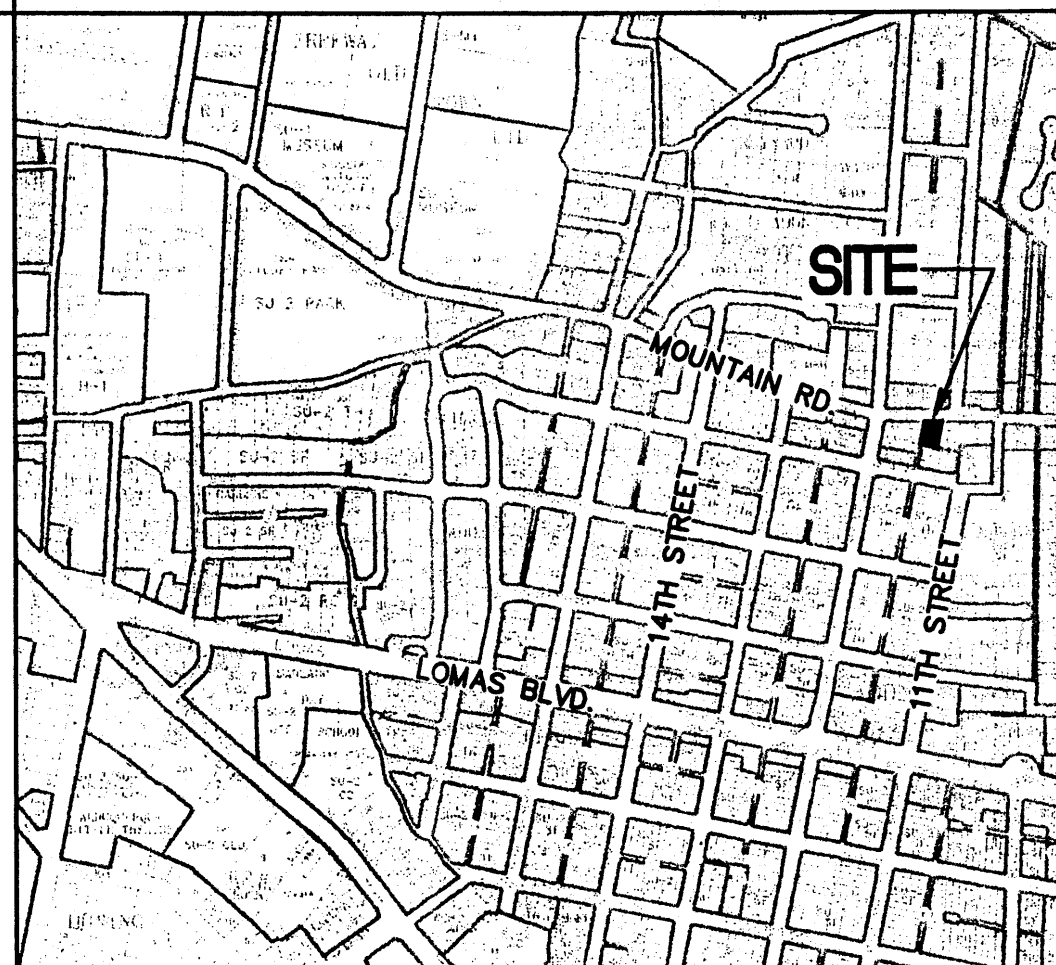

KEYED NOTES

- CONSTRUCT 18" WIDE (BOTTOM WIDTH) 'U' SHAPED CONCRETE CHANNEL TO DRAIN ROOF DISCHARGE FROM EDGE OF BUILDING TO CONCRETE ALLEY GUTTER. PROVIDE SMOOTH TRANSITION TO PASS FLOW.
- ADJACENT PROPERTIES EAST AND WEST - SAME OWNER. PAVING FOR ALL THREE PROPERTIES TO OCCUR SIMULTANEOUSLY (ADJACENT PROPERTIES CURRENTLY UNDER CONSTRUCTION).
- CONSTRUCT ASPHALT PAVING AT ELEVATIONS SHOWN. SEE SITE PLAN FOR PARKING LAYOUT.
- CONSTRUCT 2' WIDE CONCRETE ALLEY GUTTER AT ELEVATIONS SHOWN. SLOPE = 0.5% FIELD ADJUST USING MOUNTAIN ROAD GUTTER FLOWLINE AS BASE FLOWLINE ELEVATION. TOP OF ADJACENT ASPHALT TO BE 1/2" ABOVE EDGE OF ALLEY GUTTER TO ENSURE DRAINAGE. SEE DETAIL THIS SHEET.
- CONSTRUCT 2' WIDE (BOTTOM WIDTH) COVERED SIDEWALK CULVERT PER C.O.A. STD. DWG. 2236 AT ELEVATIONS SHOWN TO PASS FLOW TO MOUNTAIN ROAD. NOTE: PROVIDE FLUSH (NO CROWN) TRANSITION BETWEEN ALLEY GUTTER AND SIDEWALK CULVERT.
- BASED ON SITE INSPECTION AND TOPOGRAPHIC SURVEY, MOUNTAIN ROAD HIGH POINT THIS AREA. FLOWS DIRECTED EAST AND WEST.
- TOP OF GRADE ADJACENT TO BUILDING TO BE 0.2' MIN. BELOW F.F. ELEVATION. FINE GRADE LANDSCAPING TO PROVIDE POSITIVE DRAINAGE AWAY FROM BUILDING.



LEGEND

+65.7	EXISTING SPOT ELEVATION
-20	EXISTING CONTOUR
±55.5	PROPOSED SPOT ELEVATION
-58	PROPOSED CONTOUR
→	SURFACE FLOW DIRECTION
RIM	INLET RIM ELEVATION
INV.	INVERT ELEVATION
TC	TOP OF CURB
FL	FLOW LINE
F.F.	FINISHED FLOOR

**ISAACSON & ARFMAN, P.A.**  
Consulting Engineering Associates  
128 Monroe Street N.E.  
Albuquerque, New Mexico 87108  
Ph: 505-268-8828 Fax: 505-268-2632  
1516.1GRD.dwg Jun 19, 2007

This design, calculations, and concepts are owned by and remain the property of Isaacson & Arfman, P.A. and no part thereof shall be utilized by any person, firm or corporation for any purpose whatsoever except with the written permission of Isaacson & Arfman, P.A. ©

MOUNTAIN ROAD  
TOWN HOMES

WORKSHOP ARCHITECTS


DRAINAGE AND GRADING PLAN

Date:	No. Revisions:	Date:	Job No.
06-18-07			1516.1
Drawn By:			C-01
Ckd By:			SH OF
FCA			



\*\*PIPE LENGTHS  
SHOWN ARE  
APPROXIMATE

4" BOTTOM OUTLET,  
4" BEND, 4"x8" ADAPTER.  
INV.=53.9

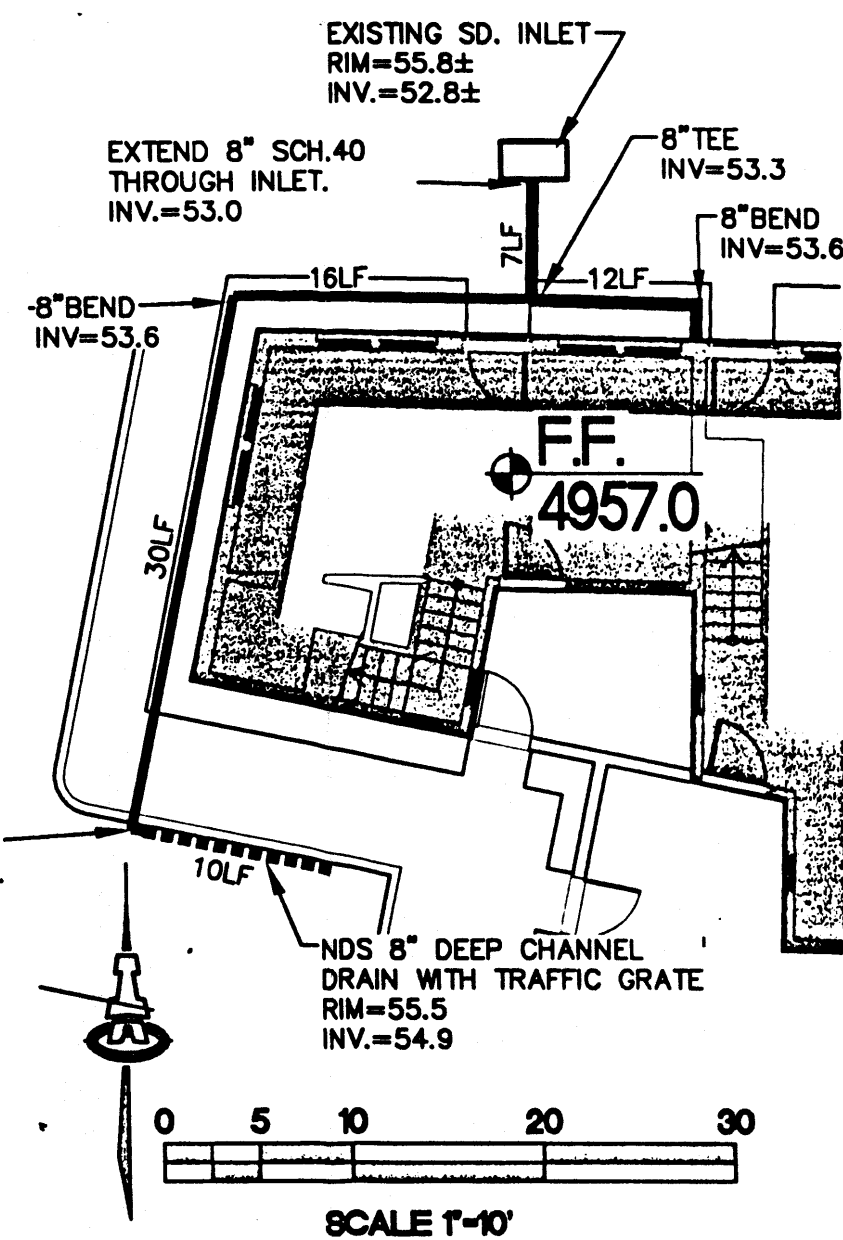


SCALE 1"=10'  
**STORM DRAIN DETAIL**


I, Fred C. Arfman, NMPE No. 7322 of the firm Isaacson & Arfman, P.A. hereby certify that this project has been graded and will drain in substantial compliance with and in accordance with the design intent of the approved plan dated 03-23-06. The record information edited onto the original design document has been obtained by Isaacson & Arfman, P.A. on 03-21-08. I further certify that I or a member of my firm under my direct supervision have visited the project site on 03-17-08 and have determined by visual inspection that the survey data provided is representative of actual site conditions and is true and correct to the best of my knowledge and belief. This certification is submitted in support of a request for permanent Certificate of Occupancy.

The record information presented hereon is not necessarily complete and is intended only to verify substantial compliance of the grading and drainage aspects of this project. Those relying on this record document are advised to obtain independent verification of its accuracy before using it for any other purpose.

FRED C. ARFMAN, NMPE#7322  
DATE: 03-21-08

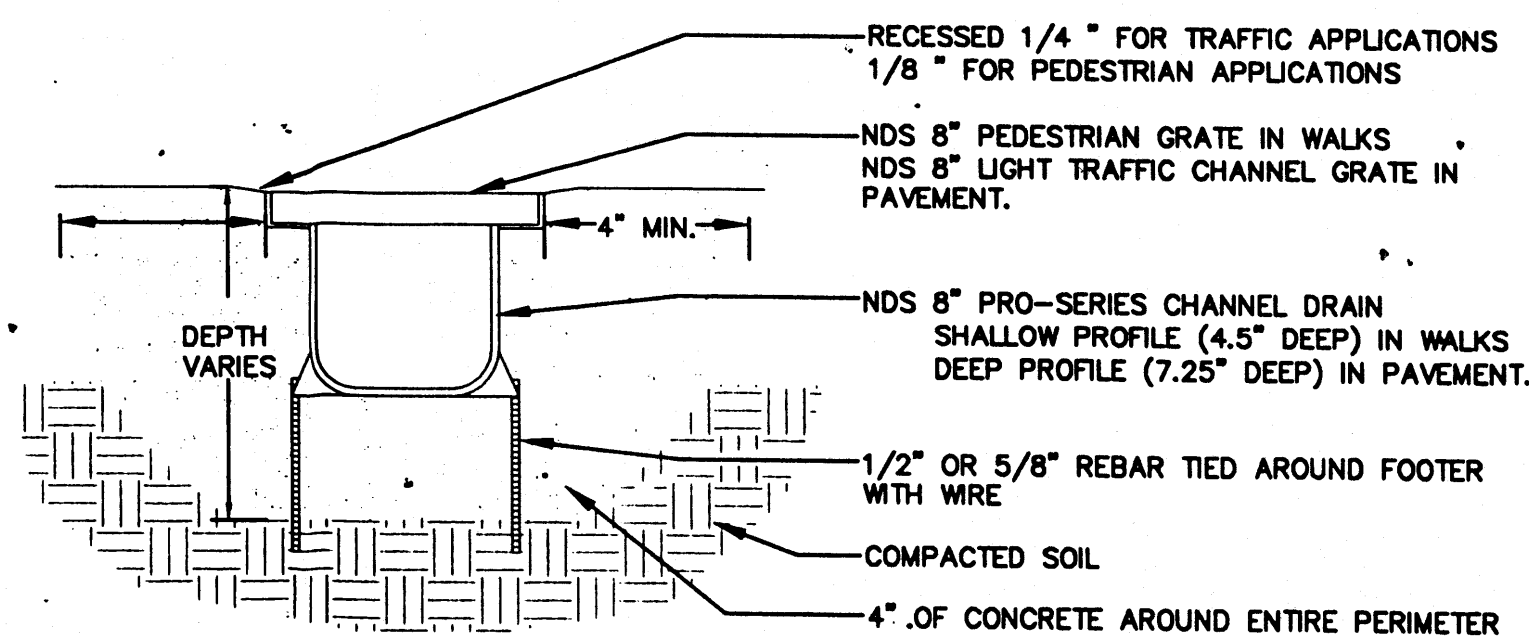

**NDS MODULAR PRO-SERIES CHANNEL INSTALLATION**  
NOT TO SCALE  
(1/4" RECESS TRAFFIC APPLICATION)  
(1/8" RECESS PEDESTRIAN APPLICATION)

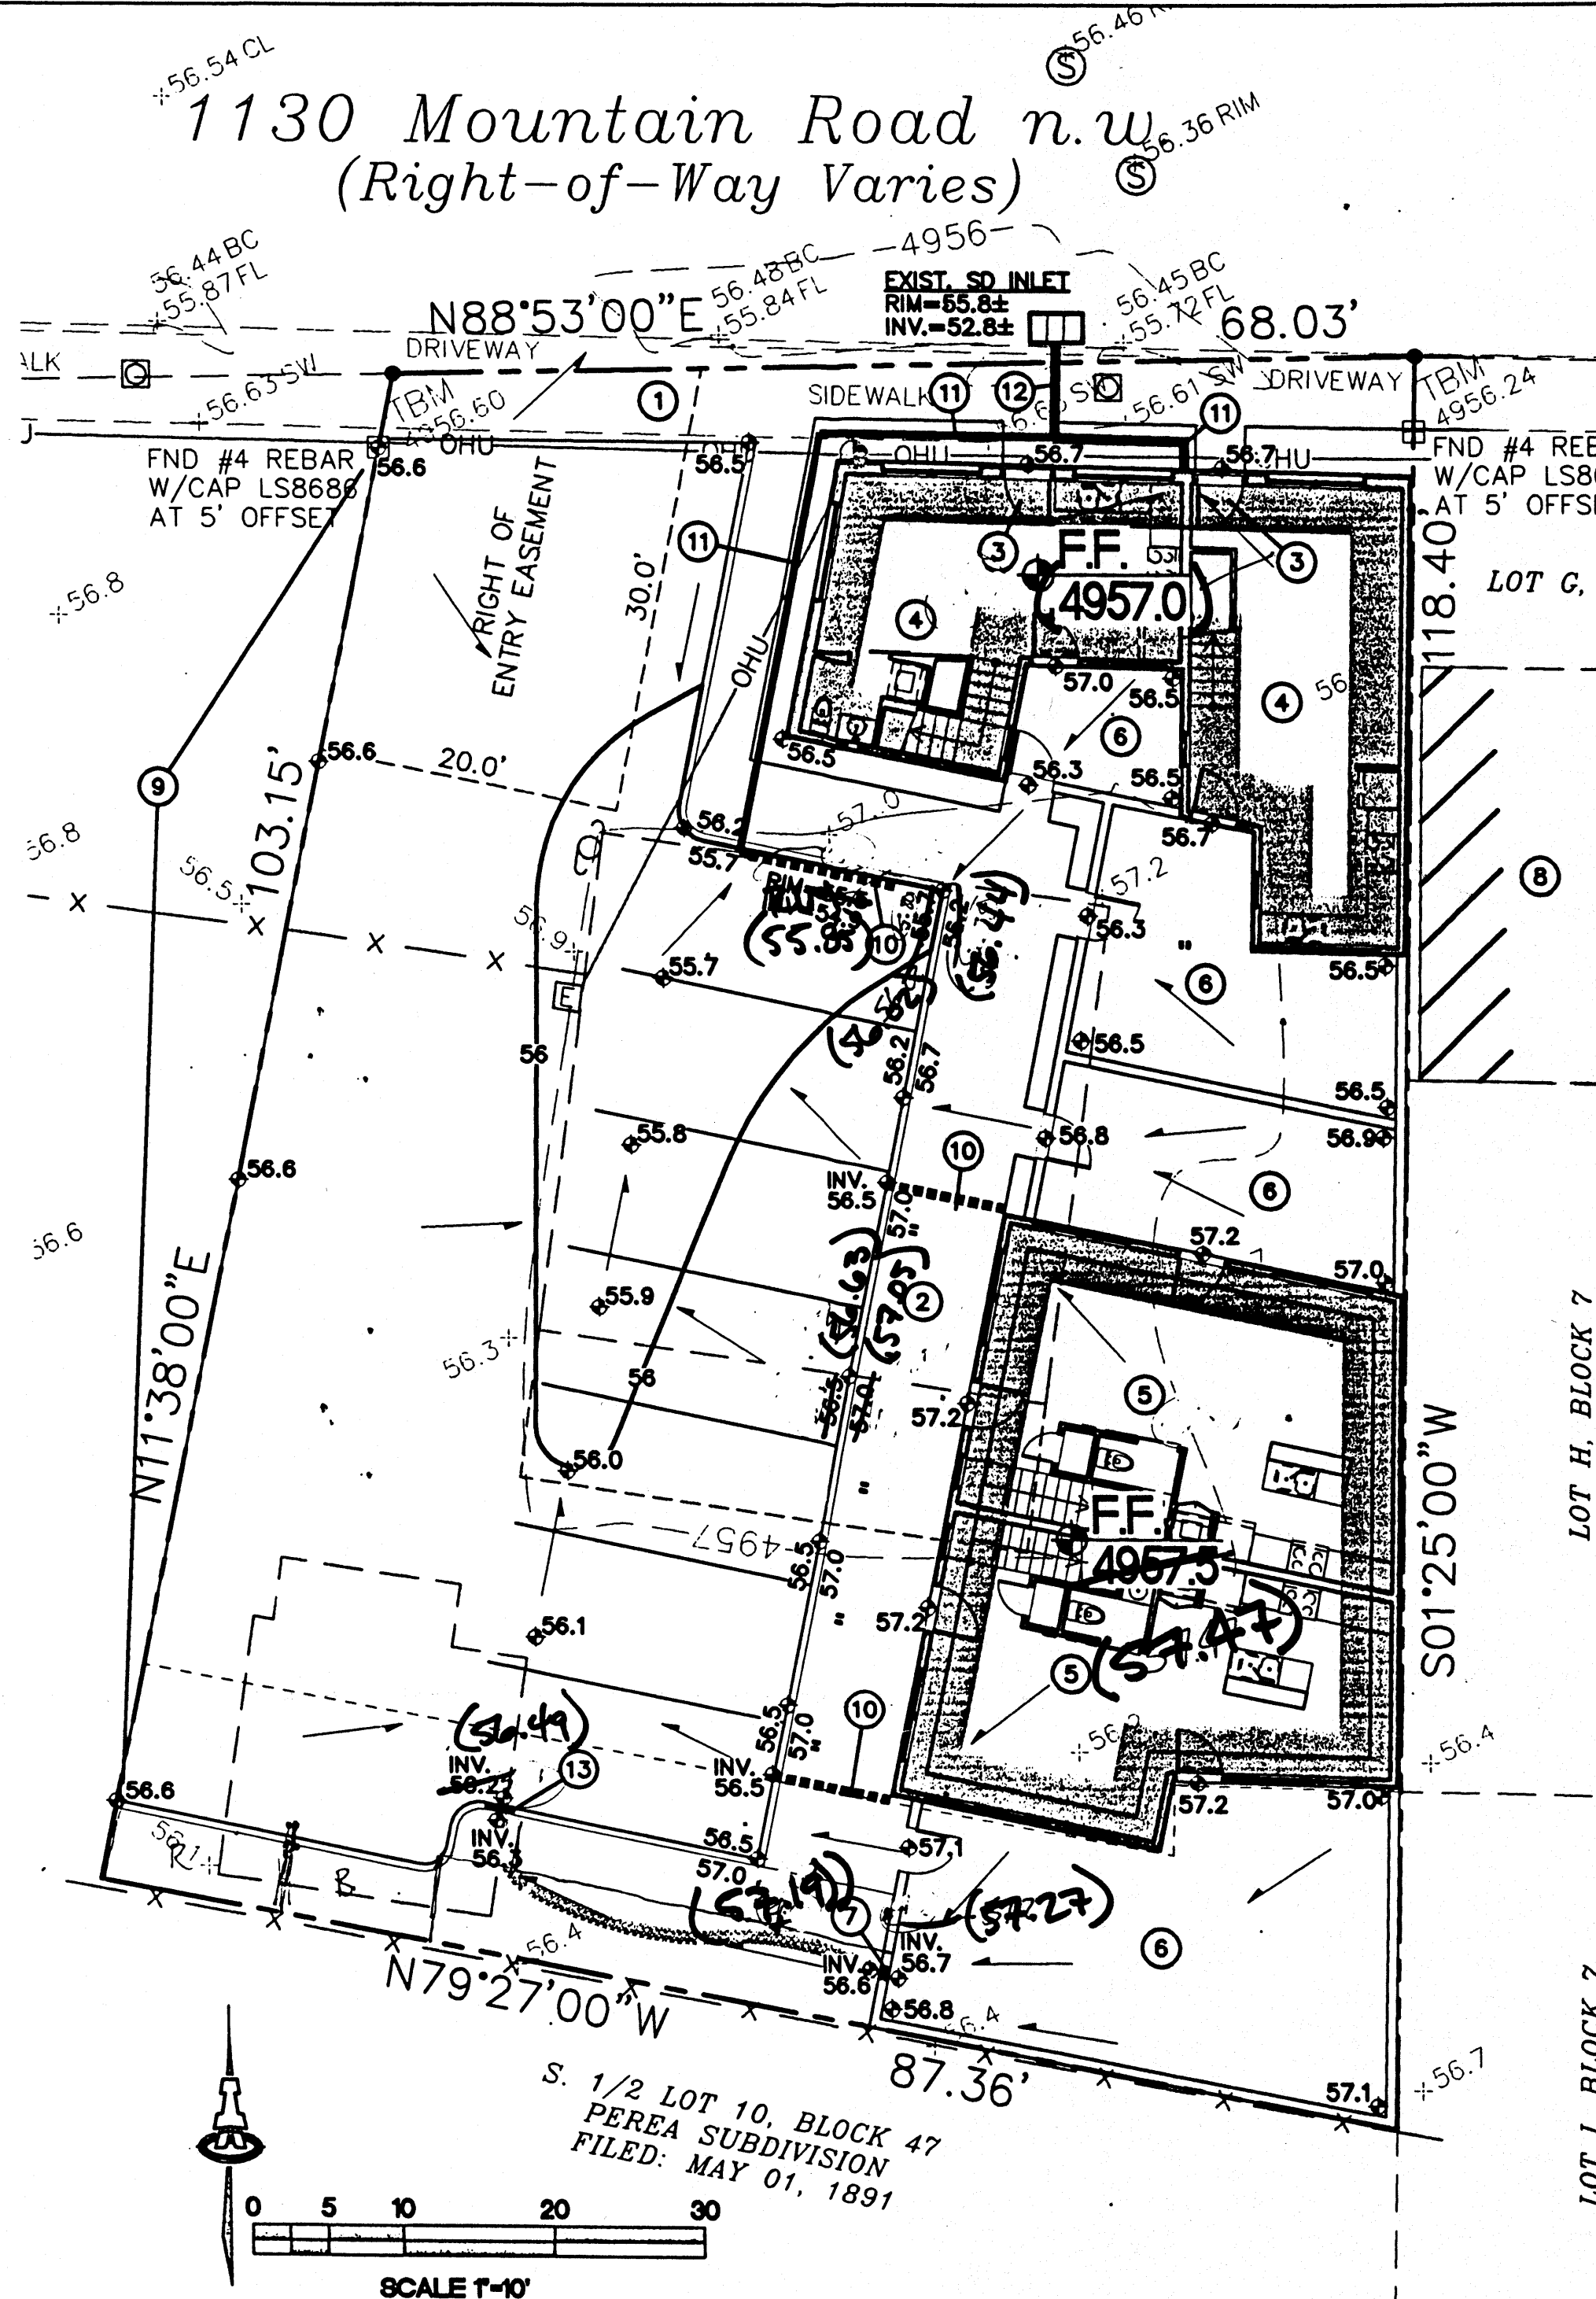

CALCULATIONS: Mountain Road Townhomes : March 20, 2006

Based on Drainage Design Criteria for City of Albuquerque Section 22.2, DPM, Vol 2, dated Jan., 1993

ON-SITE			
AREA OF SITE:	8529 SF	=	0.2 Ac.
HISTORIC FLOWS:	DEVELOPED FLOWS:		
On-Site Historic Land Condition	Area a = 0 SF	Area a = 0 SF	Ea = 0.53
Area b = 0 SF	Area b = 853 SF	Area b = 853 SF	Eb = 0.78
Area c = 5779 SF	Area c = 853 SF	Area c = 853 SF	Ec = 1.13
Area d = 2750 SF	Area d = 6823 SF	Area d = 6823 SF	Ed = 2.12
Total Area = 8529 SF	Total Area = 8529 SF		

On-Site Weighted Excess Precipitation (100-Year, 6-Hour Storm)

Weighted E =  $\frac{EaAa + EbAb + EcAc + EdAd}{Aa + Ab + Ac + Ad}$

Historic E = 1.45 in.	Developed E = 1.89 in.
-----------------------	------------------------

On-Site Volume of Runoff:  $V_{360} = \frac{E \cdot A}{12}$

Historic $V_{360} = 1030$ CF	Developed $V_{360} = 1341$ CF
------------------------------	-------------------------------

On-Site Peak Discharge Rate:  $Q_p = Q_{pAa} + Q_{pAb} + Q_{pAc} + Q_{pAd} / 43,560$


For Precipitation Zone 2			
$Q_{pa} = 1.56$	$Q_{pb} = 3.14$	$Q_{pc} = 4.70$	
$Q_{pb} = 2.28$	$Q_{pd} = 4.70$		
Historic $Q_p = 0.71$ CFS	Developed $Q_p = 0.84$ CFS		

The overall site consists of 0.2 acre(s) located in Zone 2. The 100-year, 6-hour historic discharge is 0.71 cfs. The proposed developed discharge is 0.84 cfs. The property is located in an area that is fully developed. The increase of 0.13 cfs represents

## GENERAL NOTES

- COORDINATE WORK WITH SITE DEVELOPMENT PLAN, DEMOLITION PLAN, UTILITIES PLANS AND DETAILS.
- CONTRACTOR TO ADJUST EXISTING UTILITIES AS REQUIRED TO MATCH NEW GRADES / PAVING AT ALL AREAS TO RECEIVE NEW PAVING (TYPICAL).
- FINISH GRADING AND PAVEMENT SURFACES SHALL MAINTAIN POSITIVE SLOPE AWAY FROM ALL BUILDINGS AND POSITIVE SLOPE TOWARD EXIST. AND PROPOSED LINES OF DRAINAGE, SWALES, INLETS, ETC. WATER SHALL NOT POND ON PAVED AREAS. WHERE NEW/EXIST. GRADES ARE SHOWN AS 'MATCH', TRANSITION SHALL BE SMOOTH AND LEVEL.
- PROVIDE SMOOTH, LEVEL TRANSITION BETWEEN NEW AND EXISTING CONCRETE AND SITEWORK. ALL LOCATIONS.
- GRADES SHOWN WITHIN LANDSCAPED AREAS INDICATE TOP OF LANDSCAPE MATERIAL SUBGRADE TO BE GRADED TO ELEVATION SHOWN MINUS LANDSCAPE MATERIAL THICKNESS.

## VICINITY MAP J-13

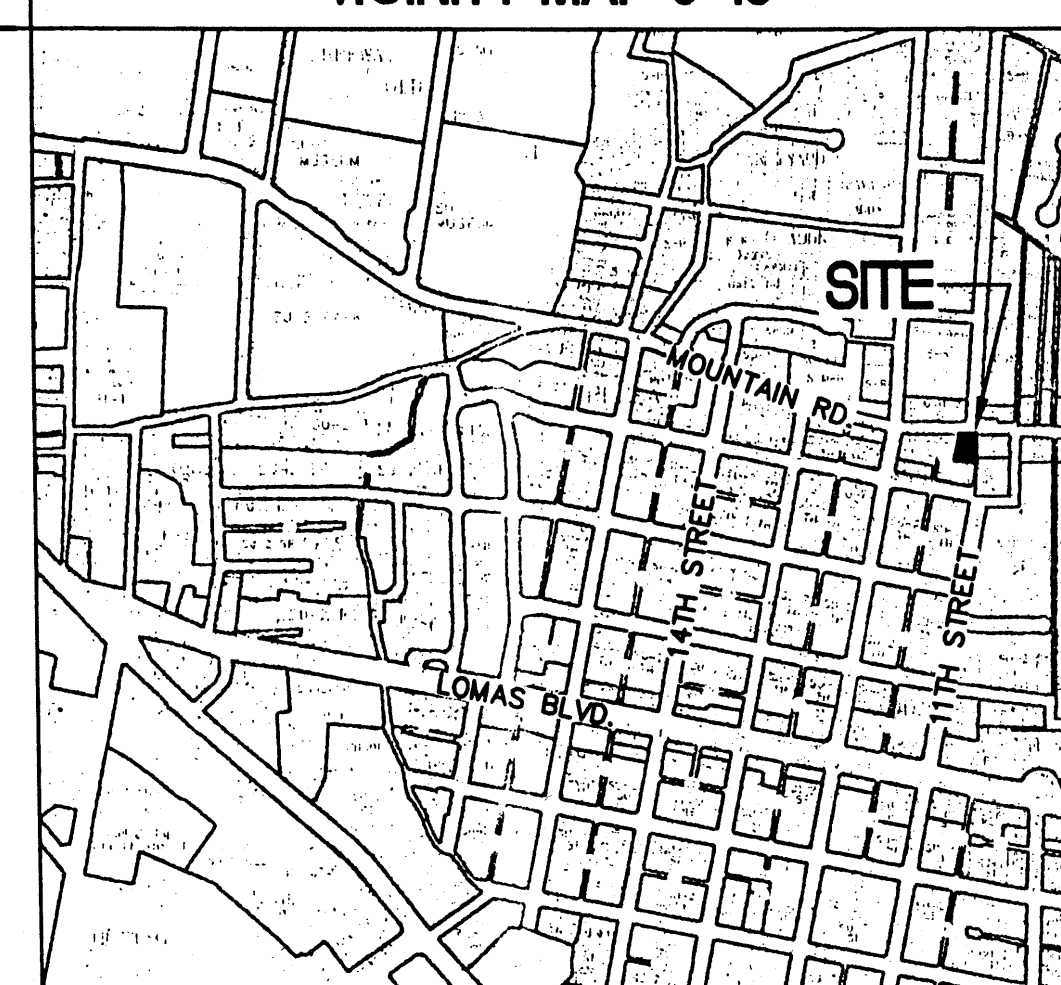

## PROJECT DATA

THE PROPOSED IMPROVEMENTS INCLUDE DEMOLITION OF EXISTING STRUCTURES AND CONSTRUCTION OF FOUR TOWNHOMES WITH NEW ASPHALT PAVED ACCESS AND PARKING AND ASSOCIATED SITE LANDSCAPING.

THE SITE IS LOCATED ON SOUTH SIDE OF MOUNTAIN ROAD WEST OF 12TH STREET. (VICINITY MAP J-13). MOUNTAIN ROAD BORDERS THE PROPERTY TO THE NORTH, DEVELOPED COMMERCIAL TO THE EAST AND WEST, AND DEVELOPED RESIDENTIAL TO THE SOUTH. THE SURROUNDING AREA IS FULLY DEVELOPED.

THE PRESENT SITE IS A DEVELOPED COMMERCIAL PROPERTY WITH EXISTING STRUCTURES, ASPHALT PAVEMENT AND COMPACTED EARTH THROUGHOUT.

THE INTENT OF THIS PLAN IS TO SHOW:

- GRADING RELATIONSHIPS BETWEEN THE EXISTING GROUND ELEVATIONS AND PROPOSED FINISHED ELEVATIONS IN ORDER TO FACILITATE POSITIVE DRAINAGE TO DESIGNATED DISCHARGE POINTS.
- THE EXTENT OF PROPOSED SITE IMPROVEMENTS, INCLUDING BUILDINGS, WALKS AND PAVEMENT.
- THE FLOW RATE/VOLUME OF RAINFALL RUNOFF ACROSS OR AROUND THESE IMPROVEMENTS AND METHODS OF HANDLING THESE FLOWS TO MEET CITY OF ALBUQUERQUE REQUIREMENTS FOR DRAINAGE MANAGEMENT.
- THE RELATIONSHIP OF ON-SITE IMPROVEMENTS WITH EXISTING NEIGHBORING PROPERTY TO INSURE AN ORDERLY TRANSITION BETWEEN PROPOSED AND SURROUNDING GRADES.

DRAINAGE PLAN CONCEPT:

THE SITE HISTORICALLY FREE DISCHARGES TO MOUNTAIN ROAD WHERE FLOW IMMEDIATELY ENTERS THE PUBLIC STORM SEWER SYSTEM. THE PROPOSED IMPROVEMENTS WILL GENERATE APPROXIMATELY 0.1 CFS OF ADDITIONAL DISCHARGE DURING THE 100-YEAR, 6-HOUR STORM EVENT (SEE CALCULATIONS THIS SHEET) AND WILL CONTINUE TO FREE DISCHARGE TO MOUNTAIN ROAD.

LEGAL: LOT B, BLOCK 47, PEREA ADDITION, ALBUQUERQUE, BERNALILLO COUNTY, NEW MEXICO

BENCHMARK: THE BASIS OF ELEVATIONS FOR THIS SURVEY IS ACS BENCHMARK 18-J13, THE PUBLISHED ELEVATION OF WHICH IS 4954.442. BENCHMARK IS LOCATED IN THE SOUTHWEST QUADRANT OF THE INTERSECTION OF LOMAS BLVD. NW AND ELEVENTH ST. NW.

FLOODZONE: PER FIRM MAP 331, THE SITE IS NOT LOCATED WITHIN A FLOODZONE 100 YEAR FLOOD ZONE.

EROSION CONTROL: THE CONTRACTOR IS RESPONSIBLE FOR RETAINING ON-SITE ALL SEDIMENT GENERATED DURING CONSTRUCTION BY MEANS OF TEMPORARY EARTH BERM, SILT FENCES AND THE PREPARATION OF AND COMPLY WITH SWPPP AS REQUIRED BY ENVIRONMENTAL PROTECTION AGENCY.

## S.O.19 NOTICE TO CONTRACTORS

- AN EXCAVATION/CONSTRUCTION PERMIT WILL BE REQUIRED BEFORE BEGINNING ANY WORK WITHIN CITY RIGHT-OF-WAY.
- ALL WORK DETAILED ON THESE PLANS TO BE PERFORMED, EXCEPT AS OTHERWISE STATED OR PROVIDED HEREON, SHALL BE CONSTRUCTED IN ACCORDANCE WITH CITY OF ALBUQUERQUE INTERIM STANDARD SPECIFICATIONS FOR PUBLIC WORKS CONSTRUCTION, 1985.
- TWO WORKING DAYS PRIOR TO ANY EXCAVATION, CONTRACTOR MUST CONTACT LINE LOCATING SERVICE, 765-1234, FOR LOCATION OF EXISTING UTILITIES.
- PRIOR TO CONSTRUCTION, THE CONTRACTOR SHALL EXCAVATE AND VERIFY THE HORIZONTAL AND VERTICAL LOCATIONS OF ALL CONSTRUCTIONS. SHOULD A CONFLICT EXIST, THE CONTRACTOR SHALL NOTIFY THE ENGINEER SO THAT THE CONFLICT CAN BE RESOLVED WITH A MINIMUM AMOUNT OF DELAY.
- BACK FILL COMPACTION SHALL BE ACCORDING TO TRAFFIC/STREET USE.
- MAINTENANCE OF THESE FACILITIES SHALL BE THE RESPONSIBILITY OF THE OWNER OF THE PROPERTY SERVED.
- WORK ON ARTERIAL STREETS SHALL BE PERFORMED ON A 24-HOUR BASIS.

APPROVAL	NAME	DATE
INSPECTOR		

## LEGEND

+ 65.7	EXISTING SPOT ELEVATION
- 20	EXISTING CONTOUR
55.5	PROPOSED SPOT ELEVATION
58	PROPOSED CONTOUR
→	SURFACE FLOW DIRECTION
○	INLET RIM ELEVATION
○	INVERT ELEVATION
○	TOP OF CURB
○	FLOW LINE
○	FINISHED FLOOR
(55.5)	AS-BUILT INFORMATION

**ISAACSON & ARFMAN, P.A.**  
Consulting Engineering Associates  
128 Monroe Street N.E.  
Albuquerque, New Mexico 87108  
Ph: 505-268-8828 Fax: 505-268-2632  
1516GRD.DWG/BJB 03.23.06

This design, calculations, and concepts are owned by and remain the property of Isaacson & Arfman, P.A. and no part thereof shall be utilized by any person, firm or corporation for any purpose whatsoever except with the written permission of Isaacson & Arfman, P.A. ©

## MOUNTAIN ROAD TOWN HOMES WORKSHOP ARCHITECTS

## DRAINAGE AND GRADING PLAN

Date:	No.	Revision:	Date:	Job No.
03.23.06				1516
Drawn By:				C-01
Ckd By:				SH OF



MOUNTAIN ROAD N.W.  
RIGHT-OF-WAY VARIES




DRAINAGE CERTIFICATION

I, FRED C. ARFMAN, P.E., NMPE 7322, OF THE FIRM ISAACSON & ARFMAN, P.A., HEREBY CERTIFY THAT THIS PROJECT HAS BEEN GRADED AND WILL DRAIN IN SUBSTANTIAL COMPLIANCE WITH AND IN ACCORDANCE WITH THE DESIGN INTENT OF THE APPROVED PLAN DATED 06/19/07. THE RECORD INFORMATION EDITED ONTO THE ORIGINAL DESIGN DOCUMENT HAS BEEN OBTAINED BY ME OR UNDER MY DIRECT SUPERVISION AND IS TRUE AND CORRECT TO THE BEST OF MY KNOWLEDGE AND BELIEF. THIS CERTIFICATION IS SUBMITTED IN SUPPORT OF A REQUEST FOR PAVING AND GRADING CERTIFICATION.

THE RECORD INFORMATION PRESENTED HEREON IS NOT NECESSARILY COMPLETE AND INTENDED ONLY TO VERIFY SUBSTANTIAL COMPLIANCE OF THE GRADING AND DRAINAGE ASPECTS OF THIS PROJECT. THOSE RELYING ON THIS RECORD DOCUMENT ARE ADVISED TO OBTAIN INDEPENDENT VERIFICATION OF ITS ACCURACY BEFORE USING IT FOR ANY OTHER PURPOSE.


FRED C. ARFMAN, P.E.  
NMPE 7322  
DATE 03-28-08

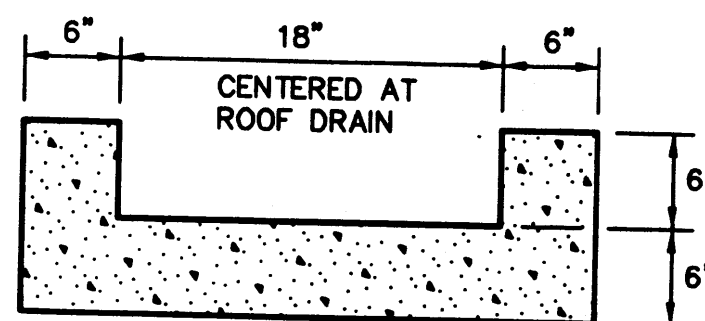

GENERAL NOTES

1. PROVIDE CONST CONTROL JOINTS @ 7' O.C. MAX.
2. EDGES SHOULD BE REMOVED WITH 3/8" EDGING TOOL.

'U' SHAPED CONC. CHANNEL  
N.T.S.

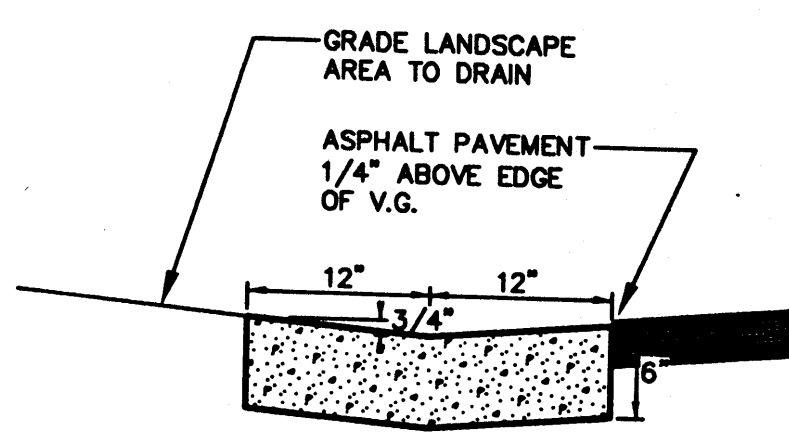

GENERAL NOTES

1. PROVIDE CONST CONTROL JOINTS @ 7' O.C. MAX.
2. EDGES SHOULD BE REMOVED WITH 3/8" EDGING TOOL.

CONCRETE ALLEY GUTTER  
N.T.S.

CALCULATIONS: Mountain Road Laundry Paving : June 18, 2007				
Based on Drainage Design Criteria for City of Albuquerque Section 22.2, DPM, Vol 2, dated Jan., 1993				
ON-SITE				
AREA OF SITE:	6150	SF	=	0.1 Ac.
HISTORIC FLOWS:		DEVELOPED FLOWS:		EXCESS PRECIP:
On-Site Historic Land Condition		On-Site Developed Land Condition		Precip. Zone 2
Area a =	0 SF	Area a =	0 SF	Ea = 0.53
Area b =	0 SF	Area b =	0 SF	Eb = 0.78
Area c =	615 SF	Area c =	923 SF	Ec = 1.13
Area d =	5535 SF	Area d =	5228 SF	Ed = 2.12
Total Area =	6150 SF	Total Area =	6150 SF	
On-Site Weighted Excess Precipitation (100-Year, 6-Hour Storm)				
Weighted E =		$\frac{EaAa + EbAb + EcAc + EdAd}{Aa + Ab + Ac + Ad}$		
Historic E =	2.02 in.	Developed E =	1.97 in.	
On-Site Volume of Runoff: $V_{360} = \frac{E \cdot A}{12}$				
Historic $V_{360} =$	1036 CF	Developed $V_{360} =$	1010 CF	
On-Site Peak Discharge Rate: $Q_p = Q_{pa}A_a + Q_{pb}A_b + Q_{pc}A_c + Q_{pd}A_d / 43.560$				
For Precipitation Zone 2				
Q <sub>pa</sub> =	1.56	Q <sub>pc</sub> =	3.14	
Q <sub>pb</sub> =	2.28	Q <sub>pd</sub> =	4.70	
Historic Q <sub>p</sub> =	0.64 CFS	Developed Q <sub>p</sub> =	0.63 CFS	

GENERAL NOTES

- A. COORDINATE WORK WITH SITE PLAN, DEMOLITION PLAN AND LANDSCAPE PLAN.
- B. IT IS THE CONTRACTOR'S RESPONSIBILITY TO FIELD VERIFY EXISTING CONDITIONS PRIOR TO CONSTRUCTION. REPORT ALL DISCREPANCIES TO THE ARCHITECT AND VERIFY THE ARCHITECT'S INTENT BEFORE PROCEEDING.
- C. ADJUST RIMS OF EXISTING UTILITY FEATURES AS NECESSARY TO MATCH NEW GRADES. TYPICAL CONTRACTOR TO FIELD VERIFY AND PROTECT ALL EXISTING UTILITIES WITHIN AREA TO BE IMPROVED.
- D. ALL NEW PAVEMENT SURFACES SHALL BE CONSTRUCTED WITH POSITIVE SLOPE AWAY FROM BUILDINGS AND POSITIVE SLOPE TOWARD EXISTING / PROPOSED DRAINAGE PATHS. WHERE NEW GRADES ARE SHOWN AS  $\pm$ , TRANSITION TO EXISTING SHALL BE SMOOTH AND LEVEL.
- E. WATER SHALL NOT POND ON PAVED AREAS. WHERE NEW/EXIST. GRADES ARE SHOWN AS 'MATCH', TRANSITION SHALL BE SMOOTH AND LEVEL.
- F. FINAL GRADES SHOWN REPRESENT TOP OF FINISH MATERIAL (I.E. TOP OF CONCRETE, TOP OF CONCRETE BUILDING PAD, TOP OF PAVEMENT MATERIAL, TOP OF LANDSCAPING MATERIAL, ETC.). CONTRACTOR SHALL GRADE, COMPACT SUBGRADE AND DETERMINE EARTHWORK ESTIMATES BASED ON ELEVATIONS SHOWN MINUS MATERIAL THICKNESSES.

PROJECT DATA

THE PROPOSED IMPROVEMENTS INCLUDE REMOVAL / REPLACEMENT OF EXISTING ASPHALT PAVING AND ASSOCIATED SITE LANDSCAPING.

THE SITE IS LOCATED ON SOUTH SIDE OF MOUNTAIN ROAD WEST OF 12TH STREET. (VICINITY MAP J-13). MOUNTAIN ROAD BORDERS THE PROPERTY TO THE NORTH, DEVELOPED COMMERCIAL TO THE EAST AND WEST (SAME OWNER BOTH SIDES), AND DEVELOPED RESIDENTIAL TO THE SOUTH. THE SURROUNDING AREA IS FULLY DEVELOPED.

THE PRESENT SITE IS A DEVELOPED COMMERCIAL PROPERTY WITH EXISTING STRUCTURES, ASPHALT PAVEMENT AND COMPACTED EARTH THROUGHOUT.

THE INTENT OF THIS PLAN IS TO SHOW:

- \* GRADING RELATIONSHIPS BETWEEN THE EXISTING GROUND ELEVATIONS AND PROPOSED FINISHED ELEVATIONS IN ORDER TO FACILITATE POSITIVE DRAINAGE TO DESIGNATED DISCHARGE POINTS.
- \* THE EXTENT OF PROPOSED SITE IMPROVEMENTS, INCLUDING BUILDINGS, WALKS AND PAVEMENT.
- \* THE FLOW RATE/VOLUME OF RAINFALL RUNOFF ACROSS OR AROUND THESE IMPROVEMENTS AND METHODS OF HANDLING THESE FLOWS TO MEET CITY OF ALBUQUERQUE REQUIREMENTS FOR DRAINAGE MANAGEMENT.
- \* THE RELATIONSHIP OF ON-SITE IMPROVEMENTS WITH EXISTING NEIGHBORING PROPERTY TO INSURE AN ORDERLY TRANSITION BETWEEN PROPOSED AND SURROUNDING GRADES.

DRAINAGE PLAN CONCEPT:

THE SITE HISTORICALLY FREE DISCHARGES TO MOUNTAIN ROAD WHERE FLOW ENTERS THE PUBLIC STORM SEWER SYSTEM. THE PROPOSED IMPROVEMENTS WILL GENERATE NO ADDITIONAL DISCHARGE DURING THE 100-YEAR, 6-HOUR STORM EVENT (SEE CALCULATIONS THIS SHEET) AND WILL CONTINUE TO FREE DISCHARGE TO MOUNTAIN ROAD.

LEGAL: TRACT A-1, BLOCK 47, PEREA ADDITION, ALBUQUERQUE, BERNALILLO COUNTY, NEW MEXICO

BENCHMARK: THE BASIS OF ELEVATIONS FOR THIS SURVEY IS ACS BENCHMARK 18-J13, THE PUBLISHED ELEVATION OF WHICH IS 4957.09 (BAVD88). BENCHMARK IS LOCATED IN THE SOUTHWEST QUADRANT OF THE INTERSECTION OF LOMAS BLVD. NW AND ELEVENTH ST. NW.

FLOODZONE: PER FIRM MAP 331, THE SITE IS NOT LOCATED WITHIN A FLOODZONE 100 YEAR FLOOD ZONE.


EROSION CONTROL: THE CONTRACTOR IS RESPONSIBLE FOR RETAINING ON-SITE ALL SEDIMENT GENERATED DURING CONSTRUCTION BY MEANS OF TEMPORARY EARTH BERMS OR SILT FENCES AND THE PREPARATION OF AND COMPLIANCE WITH SWPPP AS REQUIRED BY ENVIRONMENTAL PROTECTION AGENCY.

S.O.19 : NOTICE TO CONTRACTORS

1. AN EXCAVATION / CONSTRUCTION PERMIT WILL BE REQUIRED BEFORE BEGINNING ANY WORK WITHIN THE CITY RIGHT-OF-WAY.
2. ALL WORK DETAILED ON THESE PLANS TO BE PERFORMED, EXCEPT AS OTHERWISE STATED OR PROVIDED FOR HEREON, SHALL BE CONSTRUCTED IN ACCORDANCE WITH THE CITY OF ALBUQUERQUE STANDARD SPECIFICATIONS FOR PUBLIC WORKS CONSTRUCTION, 1986 EDITION AS REVISED THROUGH UPDATE #7 AMENDMENT 1.
3. TWO WORKING DAYS PRIOR TO ANY EXCAVATION, THE CONTRACTOR MUST CONTACT NEW MEXICO ONE CALL SYSTEM (260-1990) FOR LOCATION OF EXISTING UTILITIES.
4. PRIOR TO CONSTRUCTION, THE CONTRACTOR SHALL EXCAVATE AND VERIFY THE HORIZONTAL AND VERTICAL LOCATIONS OF ALL CONSTRUCTIONS. SHOULD A CONFLICT EXIST, THE CONTRACTOR SHALL NOTIFY THE ENGINEER SO THAT THE CONFLICT CAN BE RESOLVED WITH A MINIMUM AMOUNT OF DELAY.
5. BACKFILL COMPACTION SHALL BE ACCORDING TO TRAFFIC / STREET USE.
6. MAINTENANCE OF THESE FACILITIES SHALL BE THE RESPONSIBILITY OF THE OWNER OF THE PROPERTY SERVED.
7. WORK ON ARTERIAL STREETS SHALL BE PERFORMED ON A 24-HOUR BASIS.

APPROVAL NAME DATE  
INSPECTOR

VICINITY MAP J-13

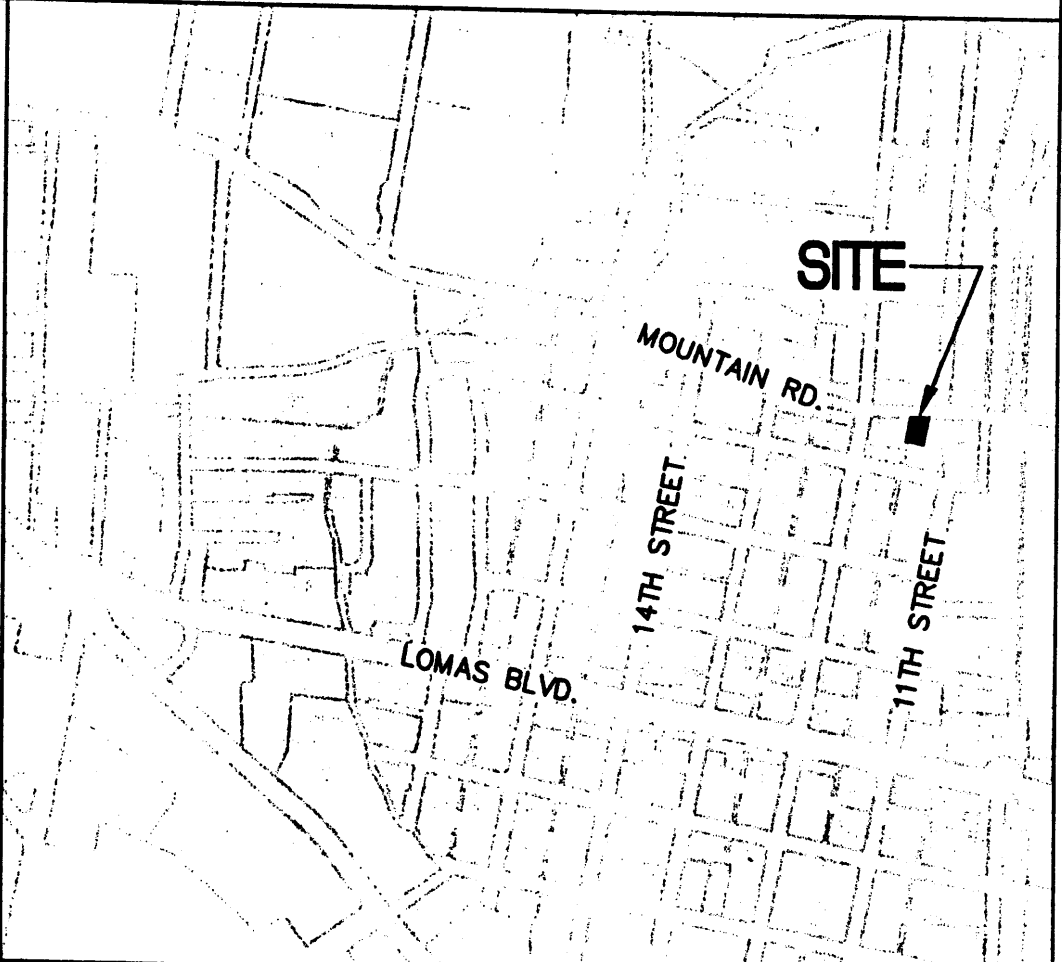

KEYED NOTES

1. CONSTRUCT 18" WIDE (BOTTOM WIDTH) 'U' SHAPED CONCRETE CHANNEL TO DRAIN ROOF DISCHARGE FROM EDGE OF BUILDING TO CONCRETE ALLEY GUTTER. PROVIDE SMOOTH TRANSITION TO PASS FLOW.
2. ADJACENT PROPERTIES EAST AND WEST - SAME OWNER. PAVING FOR ALL THREE PROPERTIES TO OCCUR SIMULTANEOUSLY (ADJACENT PROPERTIES CURRENTLY UNDER CONSTRUCTION).
3. CONSTRUCT ASPHALT PAVING AT ELEVATIONS SHOWN. SEE SITE PLAN FOR PARKING LAYOUT.
4. CONSTRUCT 2' WIDE CONCRETE ALLEY GUTTER AT ELEVATIONS SHOWN. SLOPE = 0.5%. FIELD ADJUST USING MOUNTAIN ROAD GUTTER FLOWLINE AS BASE FLOWLINE ELEVATION. TOP OF ADJACENT ASPHALT TO BE 1/8" ABOVE EDGE OF ALLEY GUTTER TO ENSURE DRAINAGE. SEE DETAIL THIS SHEET.
5. CONSTRUCT 2' WIDE (BOTTOM WIDTH) COVERED SIDEWALK CULVERT PER C.O.A. STD. DWG. 2236 AT ELEVATIONS SHOWN TO PASS FLOW TO MOUNTAIN ROAD. NOTE: PROVIDE FLUSH (NO CROWN) TRANSITION BETWEEN ALLEY GUTTER AND SIDEWALK CULVERT.
6. BASED ON SITE INSPECTION AND TOPOGRAPHIC SURVEY, MOUNTAIN ROAD HIGH POINT THIS AREA. FLOWS DIRECTED EAST AND WEST.
7. TOP OF GRADE ADJACENT TO BUILDING TO BE 0.2" MIN. BELOW F.F. ELEVATION. FINE GRADE LANDSCAPING TO PROVIDE POSITIVE DRAINAGE AWAY FROM BUILDING.

LEGEND

- +65.7 EXISTING SPOT ELEVATION
- 20 EXISTING CONTOUR
- 55.5 PROPOSED SPOT ELEVATION
- 58 PROPOSED CONTOUR
- SURFACE FLOW DIRECTION
- RIM INLET ELEVATION
- INV. INVERT ELEVATION
- TC TOP OF CURB
- FL FLOW LINE
- F.F. FINISHED FLOOR

ISAACSON & ARFMAN, P.A.  
Consulting Engineering Associates  
128 Monroe Street N.E.  
Albuquerque, New Mexico 87108  
Ph. 505-268-8828 Fax. 505-268-2632  
1516.1GRD.dwg Jun 19, 2007




This design, calculations, and concepts are owned by and remain the property of Isaacson & Arfman, P.A. and no part thereof shall be utilized by any person or entity for any purpose whatsoever except with the written permission of Isaacson & Arfman, P.A.

MOUNTAIN ROAD TOWN HOMES  
WORKSHOP ARCHITECTS  
HYDROLOGY SECTION

DRAINAGE AND GRADING PLAN

Date: 06-18-07 No. Revision Date Job No. 1516.1  
Drawn By: BJB  
Ckd By: FCA  
C-01  
SH. OF



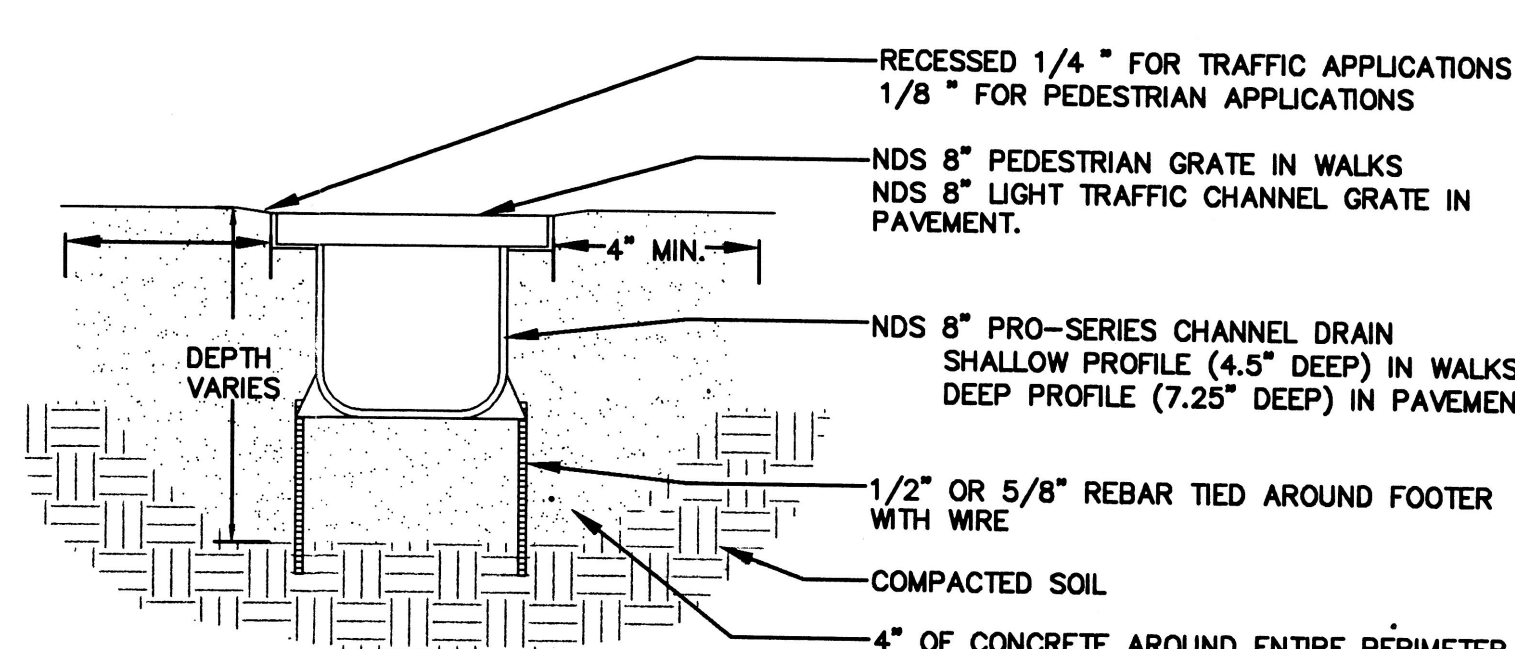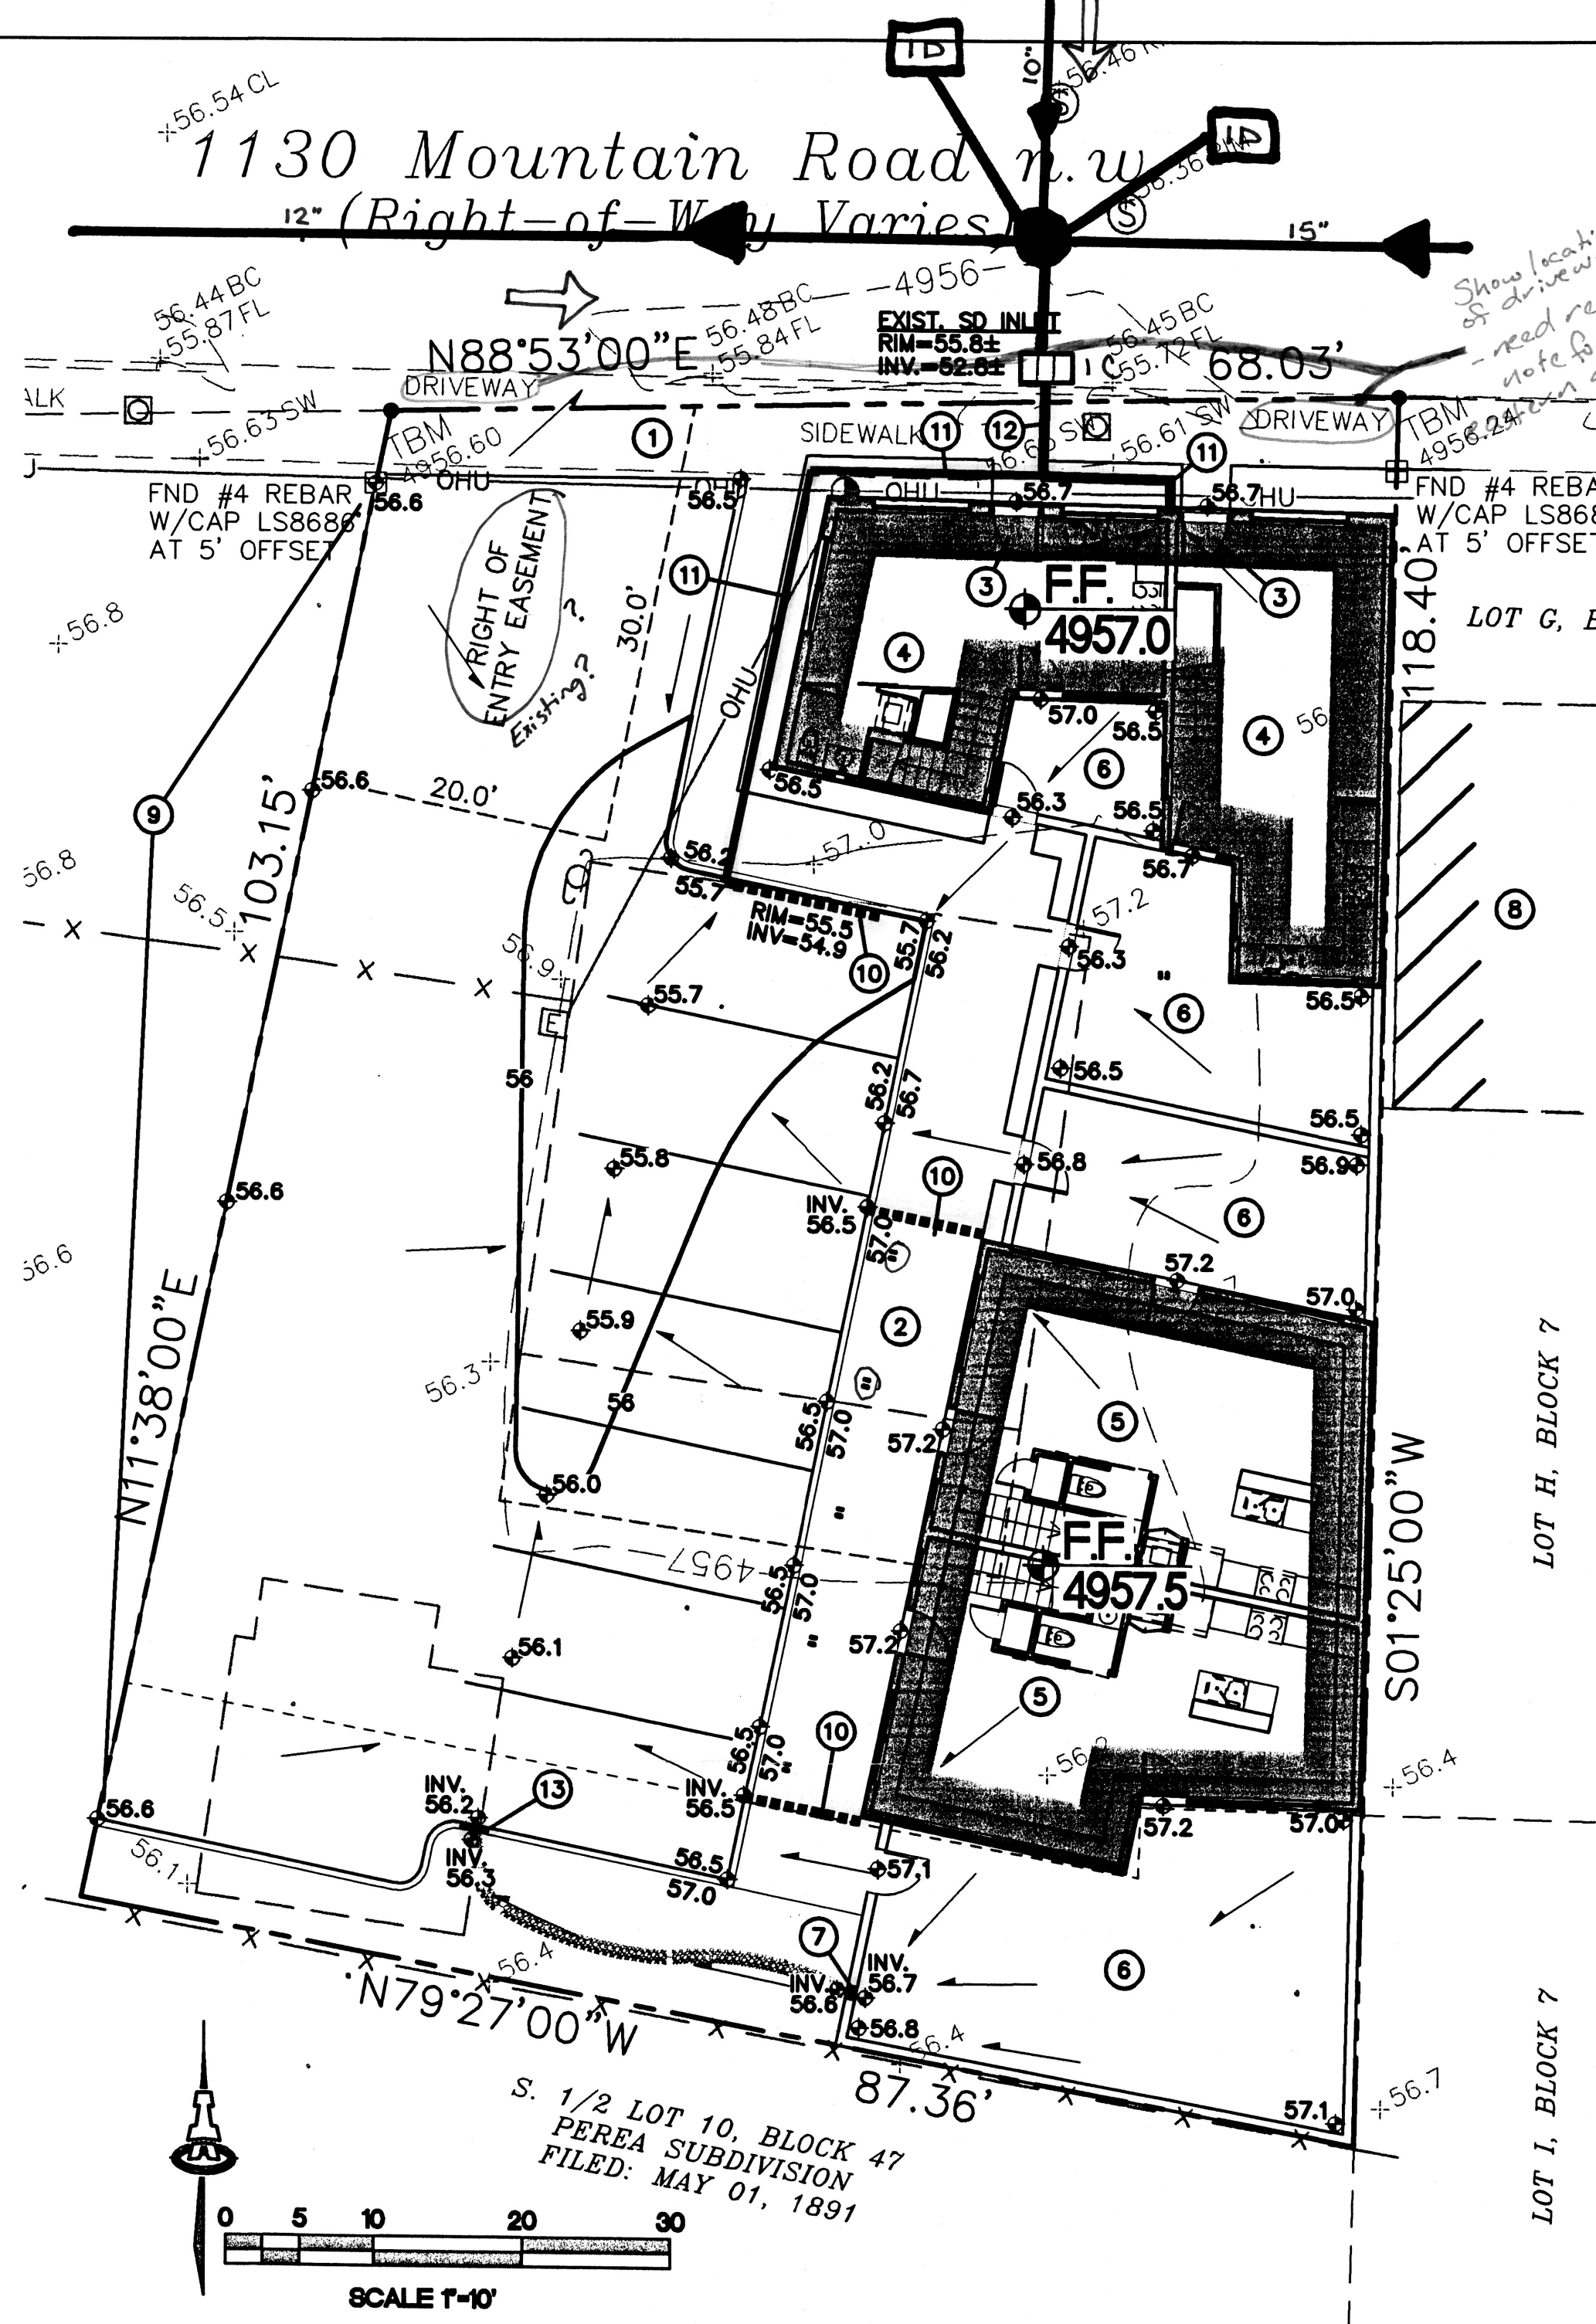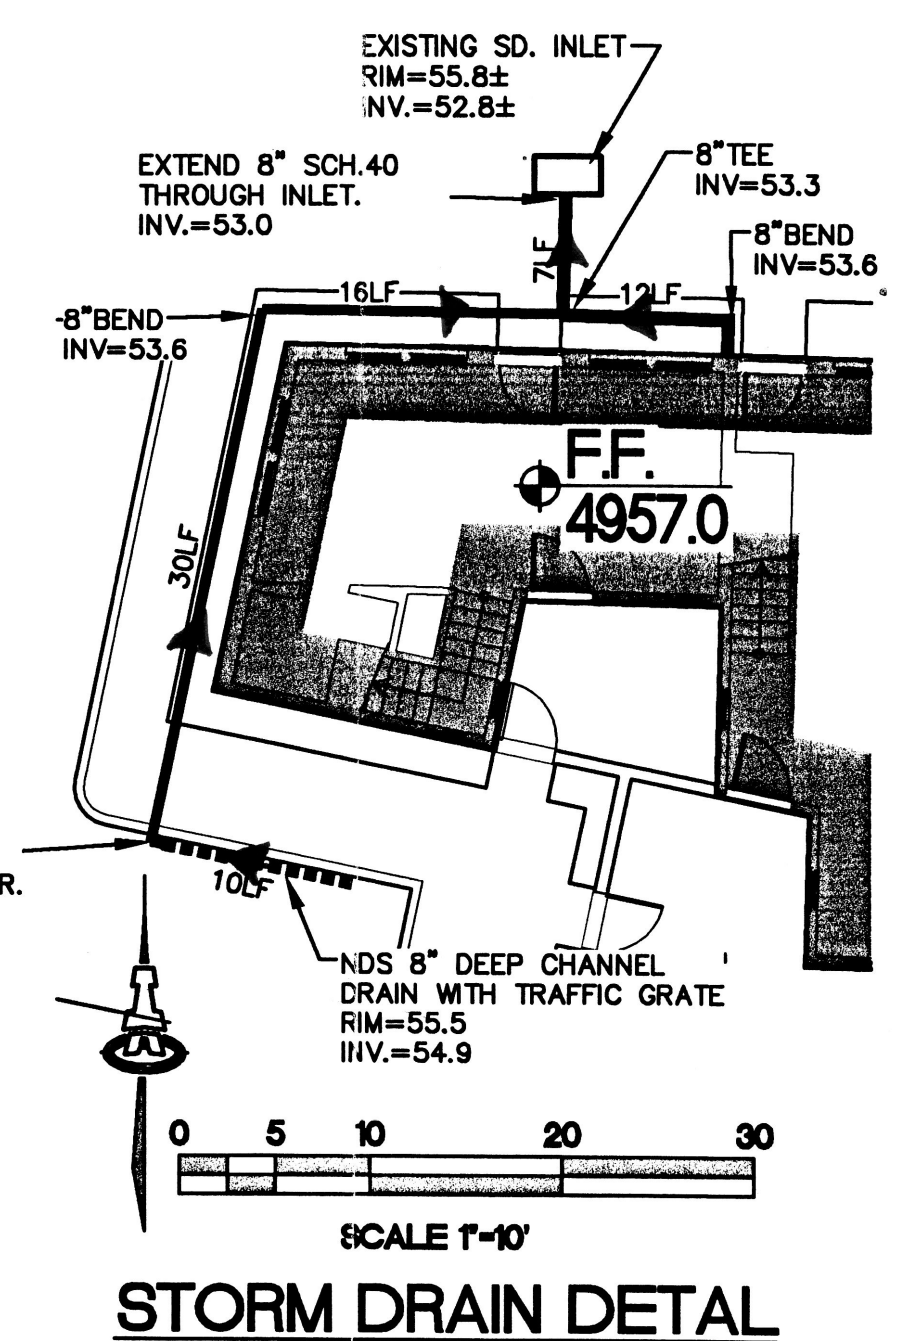

CALCULATIONS: Mountain Road Townhomes : March 20, 2006			
Based on Drainage Design Criteria for City of Albuquerque Section 22.2, DPM, Vol 2, dated Jan., 1993			
ON-SITE			
AREA OF SITE:	8529	SF	= 0.2 Ac.
HISTORIC FLOWS:			
On-Site Historic Land Condition	Area a = 0% 0 SF	Area b = 0% 0 SF	Area c = 68% 5779 SF
	Area d = 32% 2750 SF	Area e = 80% 6823 SF	Total Area = 8529 SF
DEVELOPED FLOWS:			
On-Site Developed Land Condition	Area a = 6% 513 SF	Area b = 10% 853 SF	Area c = 10% 853 SF
	Area d = 80% 6823 SF	Area e = 80% 6823 SF	Total Area = 8529 SF
EXCESS PRECIP:			
Precip. Zone	Ea = 0.53	Eb = 0.78	Ec = 1.13
	Ed = 2.12		
On-Site Weighted Excess Precipitation (100-Year, 6-Hour Storm)			
Weighted E =	EaAa + EbAb + EcAc + EdAd / Aa + Ab + Ac + Ad		
Historic E =	1.45 in.	Developed E =	1.89 in.
On-Site Volume of Runoff: V360 = E*A / 12			
Historic V360 =	1030 CF	Developed V360 =	1341 CF
On-Site Peak Discharge Rate: Qp = QpaAa + QpbAb + QpcAc + QpdAd / 43,560			
For Precipitation Zone 2	Qpa = 1.56	Qpb = 2.28	Qpc = 3.14
	Qpd = 4.70	Historic Qp =	0.71 CFS
Developed Qp =	0.84 CFS		


The overall site consists of 0.2 acre(s) located in Zone 2. The 100-year, 6-hour historic discharge is 0.71 cfs. The proposed developed discharge is 0.84 cfs. The property is located in an area that is fully developed. The increase of 0.13 cfs represents

- ### GENERAL NOTES
- COORDINATE WORK WITH SITE DEVELOPMENT PLAN, DEMOLITION PLAN, UTILITIES PLANS AND DETAILS.
  - CONTRACTOR TO ADJUST EXISTING UTILITIES AS REQUIRED TO MATCH NEW GRADES / PAVING AT ALL AREAS TO RECEIVE NEW PAVING (TYPICAL).
  - FINISH GRADING AND PAVEMENT SURFACES SHALL MAINTAIN POSITIVE SLOPE AWAY FROM ALL BUILDINGS AND POSITIVE SLOPE TOWARD EXIST. AND PROPOSED LINES OF DRAINAGE, SWALES, INLETS, ETC. WATER SHALL NOT POND ON PAVED AREAS. WHERE NEW/EXIST. GRADES ARE SHOWN AS "MATCH", TRANSITION SHALL BE SMOOTH AND LEVEL.
  - PROVIDE SMOOTH, LEVEL TRANSITION BETWEEN NEW AND EXISTING CONCRETE AND SITEWORK. ALL LOCATIONS.
  - GRADES SHOWN WITHIN LANDSCAPED AREAS INDICATE TOP OF LANDSCAPE MATERIAL. SUBGRADE TO BE GRADED TO ELEVATION SHOWN MINUS LANDSCAPE MATERIAL THICKNESS.
- DEFINE OFFSITE FLOW

- ### PROJECT DATA
- THE PROPOSED IMPROVEMENTS INCLUDE DEMOLITION OF EXISTING STRUCTURES AND CONSTRUCTION OF FOUR TOWNHOMES WITH NEW ASPHALT PAVED ACCESS AND PARKING AND ASSOCIATED SITE LANDSCAPING.
- THE SITE IS LOCATED ON SOUTH SIDE OF MOUNTAIN ROAD WEST OF 12TH STREET. (VICINITY MAP J-13). MOUNTAIN ROAD BORDERS THE PROPERTY TO THE NORTH, DEVELOPED COMMERCIAL TO THE EAST AND WEST, AND DEVELOPED RESIDENTIAL TO THE SOUTH. THE SURROUNDING AREA IS FULLY DEVELOPED.
- THE PRESENT SITE IS A DEVELOPED COMMERCIAL PROPERTY WITH EXISTING STRUCTURES, ASPHALT PAVEMENT AND COMPACTED EARTH THROUGHOUT.
- THE INTENT OF THIS PLAN IS TO SHOW:
- GRADING RELATIONSHIPS BETWEEN THE EXISTING GROUND ELEVATIONS AND PROPOSED FINISHED ELEVATIONS IN ORDER TO FACILITATE POSITIVE DRAINAGE TO DESIGNATED DISCHARGE POINTS.
  - THE EXTENT OF PROPOSED SITE IMPROVEMENTS, INCLUDING BUILDINGS, WALKS AND PAVEMENT.
  - THE FLOW RATE/VOLUME OF RAINFALL RUNOFF ACROSS OR AROUND THESE IMPROVEMENTS AND METHODS OF HANDLING THESE FLOWS TO MEET CITY OF ALBUQUERQUE REQUIREMENTS FOR DRAINAGE MANAGEMENT.
  - THE RELATIONSHIP OF ON-SITE IMPROVEMENTS WITH EXISTING NEIGHBORING PROPERTY TO INSURE AN ORDERLY TRANSITION BETWEEN PROPOSED AND SURROUNDING GRADES.
- DRAINAGE PLAN CONCEPT:
- THE SITE HISTORICALLY FREE DISCHARGES TO MOUNTAIN ROAD WHERE FLOW IMMEDIATELY ENTERS THE PUBLIC STORM SEWER SYSTEM. THE PROPOSED IMPROVEMENTS WILL GENERATE APPROXIMATELY 0.1 CFS OF ADDITIONAL DISCHARGE DURING THE 100-YEAR, 6-HOUR STORM EVENT (SEE CALCULATIONS THIS SHEET) AND WILL CONTINUE TO FREE DISCHARGE TO MOUNTAIN ROAD.
- LEGAL: LOT B, BLOCK 47, PEREA ADDITION, ALBUQUERQUE, BERNALILLO COUNTY, NEW MEXICO
- BENCHMARK: THE BASIS OF ELEVATIONS FOR THIS SURVEY IS ACS BENCHMARK 18-J13, THE PUBLISHED ELEVATION OF WHICH IS 4954.442. BENCHMARK IS LOCATED IN THE SOUTHWEST QUADRANT OF THE INTERSECTION OF LOMAS BLVD. NW AND ELEVENTH ST. NW.
- FLOODZONE: PER FIRM MAP 331, THE SITE IS NOT LOCATED WITHIN A FLOODZONE 100 YEAR FLOOD ZONE.
- EROSION CONTROL: THE CONTRACTOR IS RESPONSIBLE FOR RETAINING ON-SITE ALL SEDIMENT GENERATED DURING CONSTRUCTION BY MEANS OF TEMPORARY EARTH BERMS OR SILT FENCES AND THE PREPARATION OF AND COMPLIANCE WITH SWPPP AS REQUIRED BY ENVIRONMENTAL PROTECTION AGENCY.

- ### S.O.19 NOTICE TO CONTRACTORS
- AN EXCAVATION/CONSTRUCTION PERMIT WILL BE REQUIRED BEFORE BEGINNING ANY WORK WITHIN CITY RIGHT-OF-WAY.
  - ALL WORK DETAILED ON THESE PLANS TO BE PERFORMED, EXCEPT AS OTHERWISE STATED OR PROVIDED HEREON, SHALL BE CONSTRUCTED IN ACCORDANCE WITH CITY OF ALBUQUERQUE STANDARD SPECIFICATIONS FOR PUBLIC WORKS CONSTRUCTION, 1986 EDITION, AS REVISED THROUGH UPDATES TO 1997.
  - TWO WORKING DAYS PRIOR TO ANY EXCAVATION, CONTRACTOR MUST CONTACT LINE LOCATING SERVICE, 788-1234, FOR LOCATION OF EXISTING UTILITIES.
  - PRIOR TO CONSTRUCTION, THE CONTRACTOR SHALL EXCAVATE AND VERIFY THE HORIZONTAL AND VERTICAL LOCATIONS OF ALL CONSTRUCTIONS. SHOULD A CONFLICT EXIST, THE CONTRACTOR SHALL NOTIFY THE ENGINEER SO THAT THE CONFLICT CAN BE RESOLVED WITH A MINIMUM AMOUNT OF DELAY.
  - BACK FILL COMPACTION SHALL BE ACCORDING TO TRAFFIC/STREET USE.
  - MAINTENANCE OF THESE FACILITIES SHALL BE THE RESPONSIBILITY OF THE OWNER OF THE PROPERTY SERVED.
  - WORK ON ARTERIAL STREETS SHALL BE PERFORMED ON A 24-HOUR BASIS.

APPROVAL	NAME	DATE
INSPECTOR		

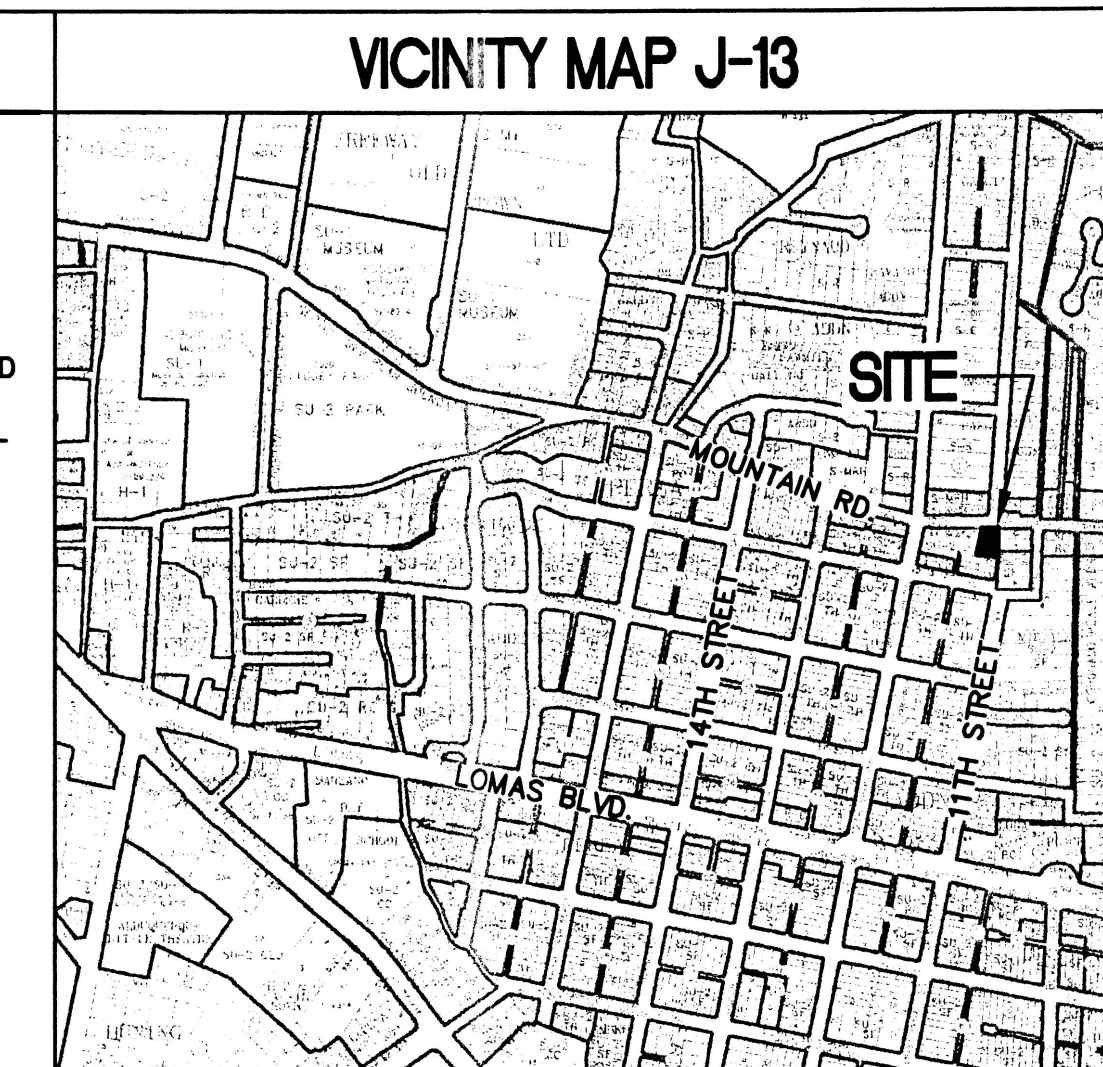

- ### KEYED NOTES
- SEE ARCHITECTURAL FOR INFORMATION REGARDING EXISTING CONCRETE DRIVEPAD AND PUBLIC SIDEWALK ALONG MOUNTAIN ROAD.
  - CONSTRUCT ON-SITE CONCRETE SITE WALK WITH TURNED DOWN EDGE ELEVATIONS SHOWN. MAX. SLOPE = 5% SEE ARCHITECTURAL.
  - MAKE CONNECTION FROM NEW DOOR STOOP (4"± BELOW F.F.) TO EXISTING SIDEWALK. ADJUST STOOP AS NECESSARY TO MAINTAIN POSITIVE DRAINAGE AWAY FROM BUILDING AT SLOPE BETWEEN 1% AND 5% TYPICAL.
  - NORTH BUILDING ROOF DRAINAGE TO BE PIPED DIRECTLY TO PROPOSED ON-SITE STORM DRAIN SYSTEM. SEE DETAIL THIS SHEET FOR INVERTS. SEE ARCHITECTURAL FOR ADDITIONAL INFORMATION.
  - SOUTH BUILDING ROOF DRAINAGE TO BE PIPED INTO SIDEWALK TRENCH DRAIN AND PASSED DIRECTLY TO PAVED PARKING AREA.
  - INTERIOR COURTYARD GRADES SHOWN FOR GENERAL INFORMATION TO INDICATE POSITIVE DRAINAGE AWAY FROM BUILDING. FINAL LANDSCAPING TO MAINTAIN DRAINAGE AWAY FROM BUILDING.
  - PROVIDE TWO 6" DIA. PIPES THROUGH WALL AT INVERT ELEVATIONS SHOWN TO PASS MINOR COURTYARD FLOW. CONSTRUCT GRADED SWALE INTEGRATED WITH LANDSCAPING TO MAINTAIN POSITIVE DRAINAGE TO CURB OPENING.
  - ADJACENT PROPERTY BLDG. - SEE ARCHITECTURAL FOR ADDITIONAL INFORMATION.
  - PROVIDE 8" DEEP X 12" WIDE THICKENED EDGE TO ASPHALT ALONG WEST PROPERTY LINE.
  - INSTALL NDS CHANNEL DRAIN WITH PEDESTRIAN GRATE (ACROSS WALKS) OR TRAFFIC GRATE (IN PAVEMENT) AND 4" DIA. BOTTOM OUTLET AT RIM / INVERT ELEVATIONS SHOWN.
  - INSTALL 4"x8" ADAPTER AND 8" DIA. STORM DRAIN WITH FITTINGS AS REQUIRED AT INVERT ELEVATIONS SHOWN.
  - INSTALL 8" STORM DRAIN TO 8" SCH.40 ADAPTER AND EXTEND 8" SCH.40 THROUGH BACK OF EXISTING STORM DRAIN INLET PER C.O.A. STD. DWG. 2237. REMOVE / REPLACE PCC SIDEWALK AS NECESSARY. NOTE: CONSTRUCTION WITHIN THE CITY OF ALBUQUERQUE R.O.W. REQUIRES A SEPARATE PERMIT. SEE S.O.19 CONSTRUCTION NOTES THIS SHEET FOR ADDITIONAL INFORMATION.
  - PROVIDE 1' WIDE CURB OPENING TO PASS FLOW TO PAVEMENT.
- ### LEGEND
- |        |                         |
|--------|-------------------------|
| + 65.7 | EXISTING SPOT ELEVATION |
| - 20   | EXISTING CONTOUR        |
| ± 55.5 | PROPOSED SPOT ELEVATION |
| - 58   | PROPOSED CONTOUR        |
| →      | SURFACE FLOW DIRECTION  |
| RIM    | INLET RIM ELEVATION     |
| INV.   | INVERT ELEVATION        |
| TC     | TOP OF CURB             |
| FL     | FLOW LINE               |
| F.F.   | FINISHED FLOOR          |

**ISAACSON & ARFMAN, P.A.**  
Consulting Engineering Associates  
128 Monroe Street N.E.  
Albuquerque, New Mexico 87108  
Ph: 505-268-8828 Fax: 505-268-2632  
1516GRD.DWG/BJB 03.23.06

**MOUNTAIN ROAD TOWN HOMES**  
WORKSHOP ARCHITECTS

**DRAINAGE AND GRADING PLAN**

Date: 03.23.06  
Drawn By: BJB  
Ckd By: FCA

No. 1516  
Revision: 1  
Date: 03.23.06  
Job No. 1516

**C-01**  
SH. OF


RECEIVED  
MAR 24 2006  
HYDROLOGY SECTION




811 12TH ST. NW  
ALBUQUERQUE, NEW MEXICO  
87102

PH. 505.246.9608

[tredesign@earthlink.net](mailto:tredesign@earthlink.net)

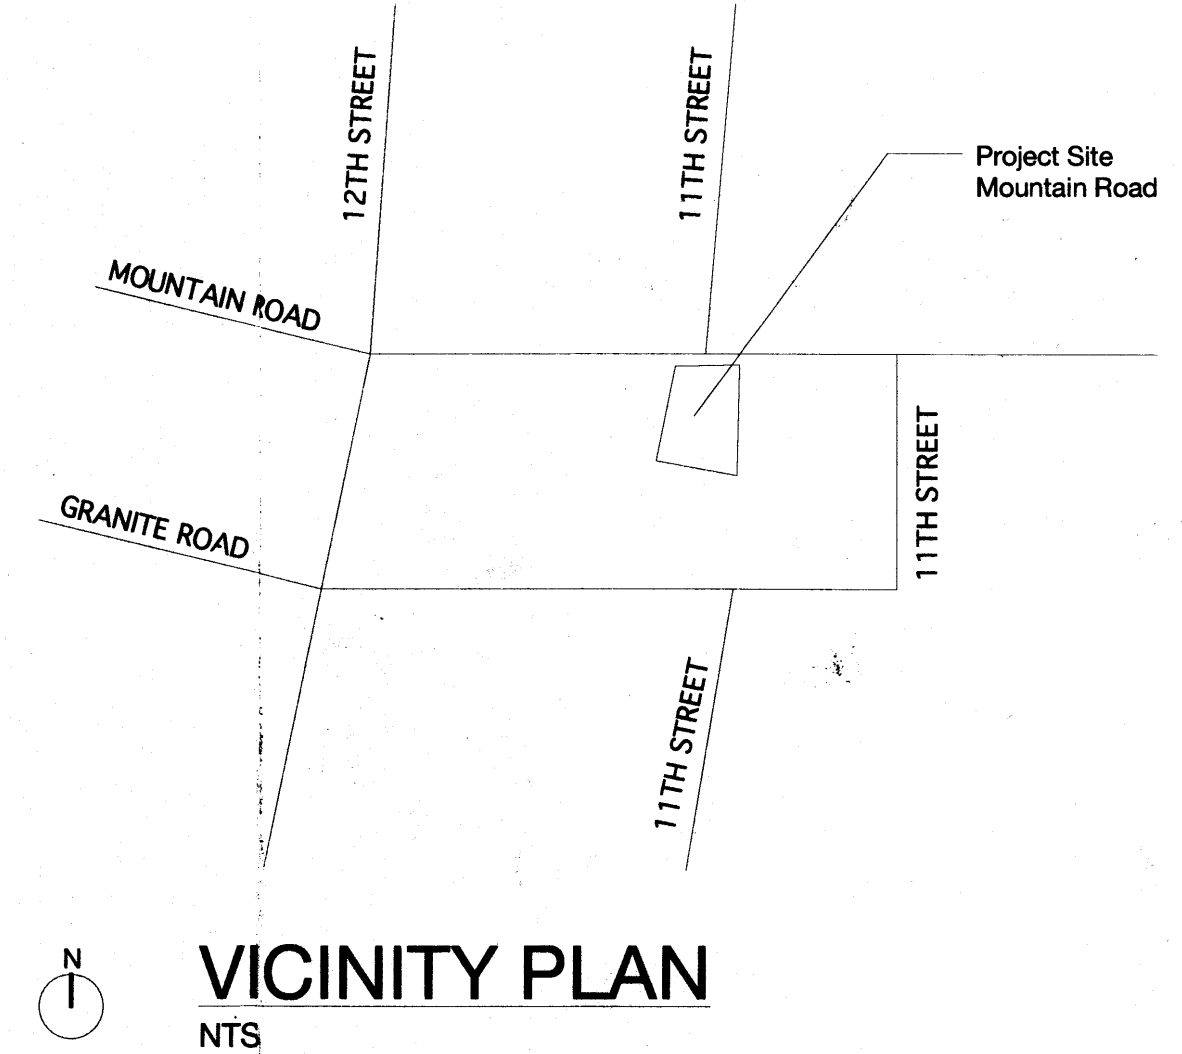

## NTS

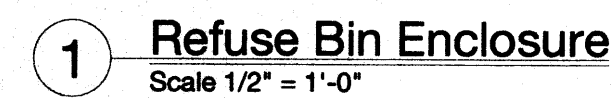

**Location:**

### Downtown Neighborhood

R-2  
Type Vb  
0 Exterior >10'-0"  
1 Hour Exterior <10'-0"  
1 Hour Between Units  
2 Stories 7,000 sq.ft.  
400sq.ft. / 1-Bed Room Unit  
500sq.ft. / 2-Bed Room Unit  
2 Stories  
NFP 13r



**RECEIVED**  
MAY 01 2008  
HYDROLOGY  
SECTION

**A-083**