

# CITY OF ALBUQUERQUE



July 7, 2017

J. Graeme Means, PE  
High Mesa Consulting Group  
6010 -B Midway Park Blvd NE  
Albuquerque, NM 87109

**Re: Hotel Chaco**  
**2000 Bellamah Ave NW**  
**Request Permanent C.O. - Accepted**  
**Engineer's Stamp dated: 9/23/2016 (J13D66)**  
**Certification dated: 6-11-17**

Dear Mr. Means,

Based on the Certification received 6/12/2017, the site is acceptable for release of Certificate of Occupancy by Hydrology.

If you have any questions, you can contact me at 924-3986 or Totten Elliott at 924-3982.

Sincerely,

James D. Hughes, P.E.  
Principal Engineer, Planning Dept.  
Development and Review Services









TE/JH  
C: email,

Serna, Yvette M.; Fox, Debi; Tena, Victoria C.; Sandoval,  
Darlene M.







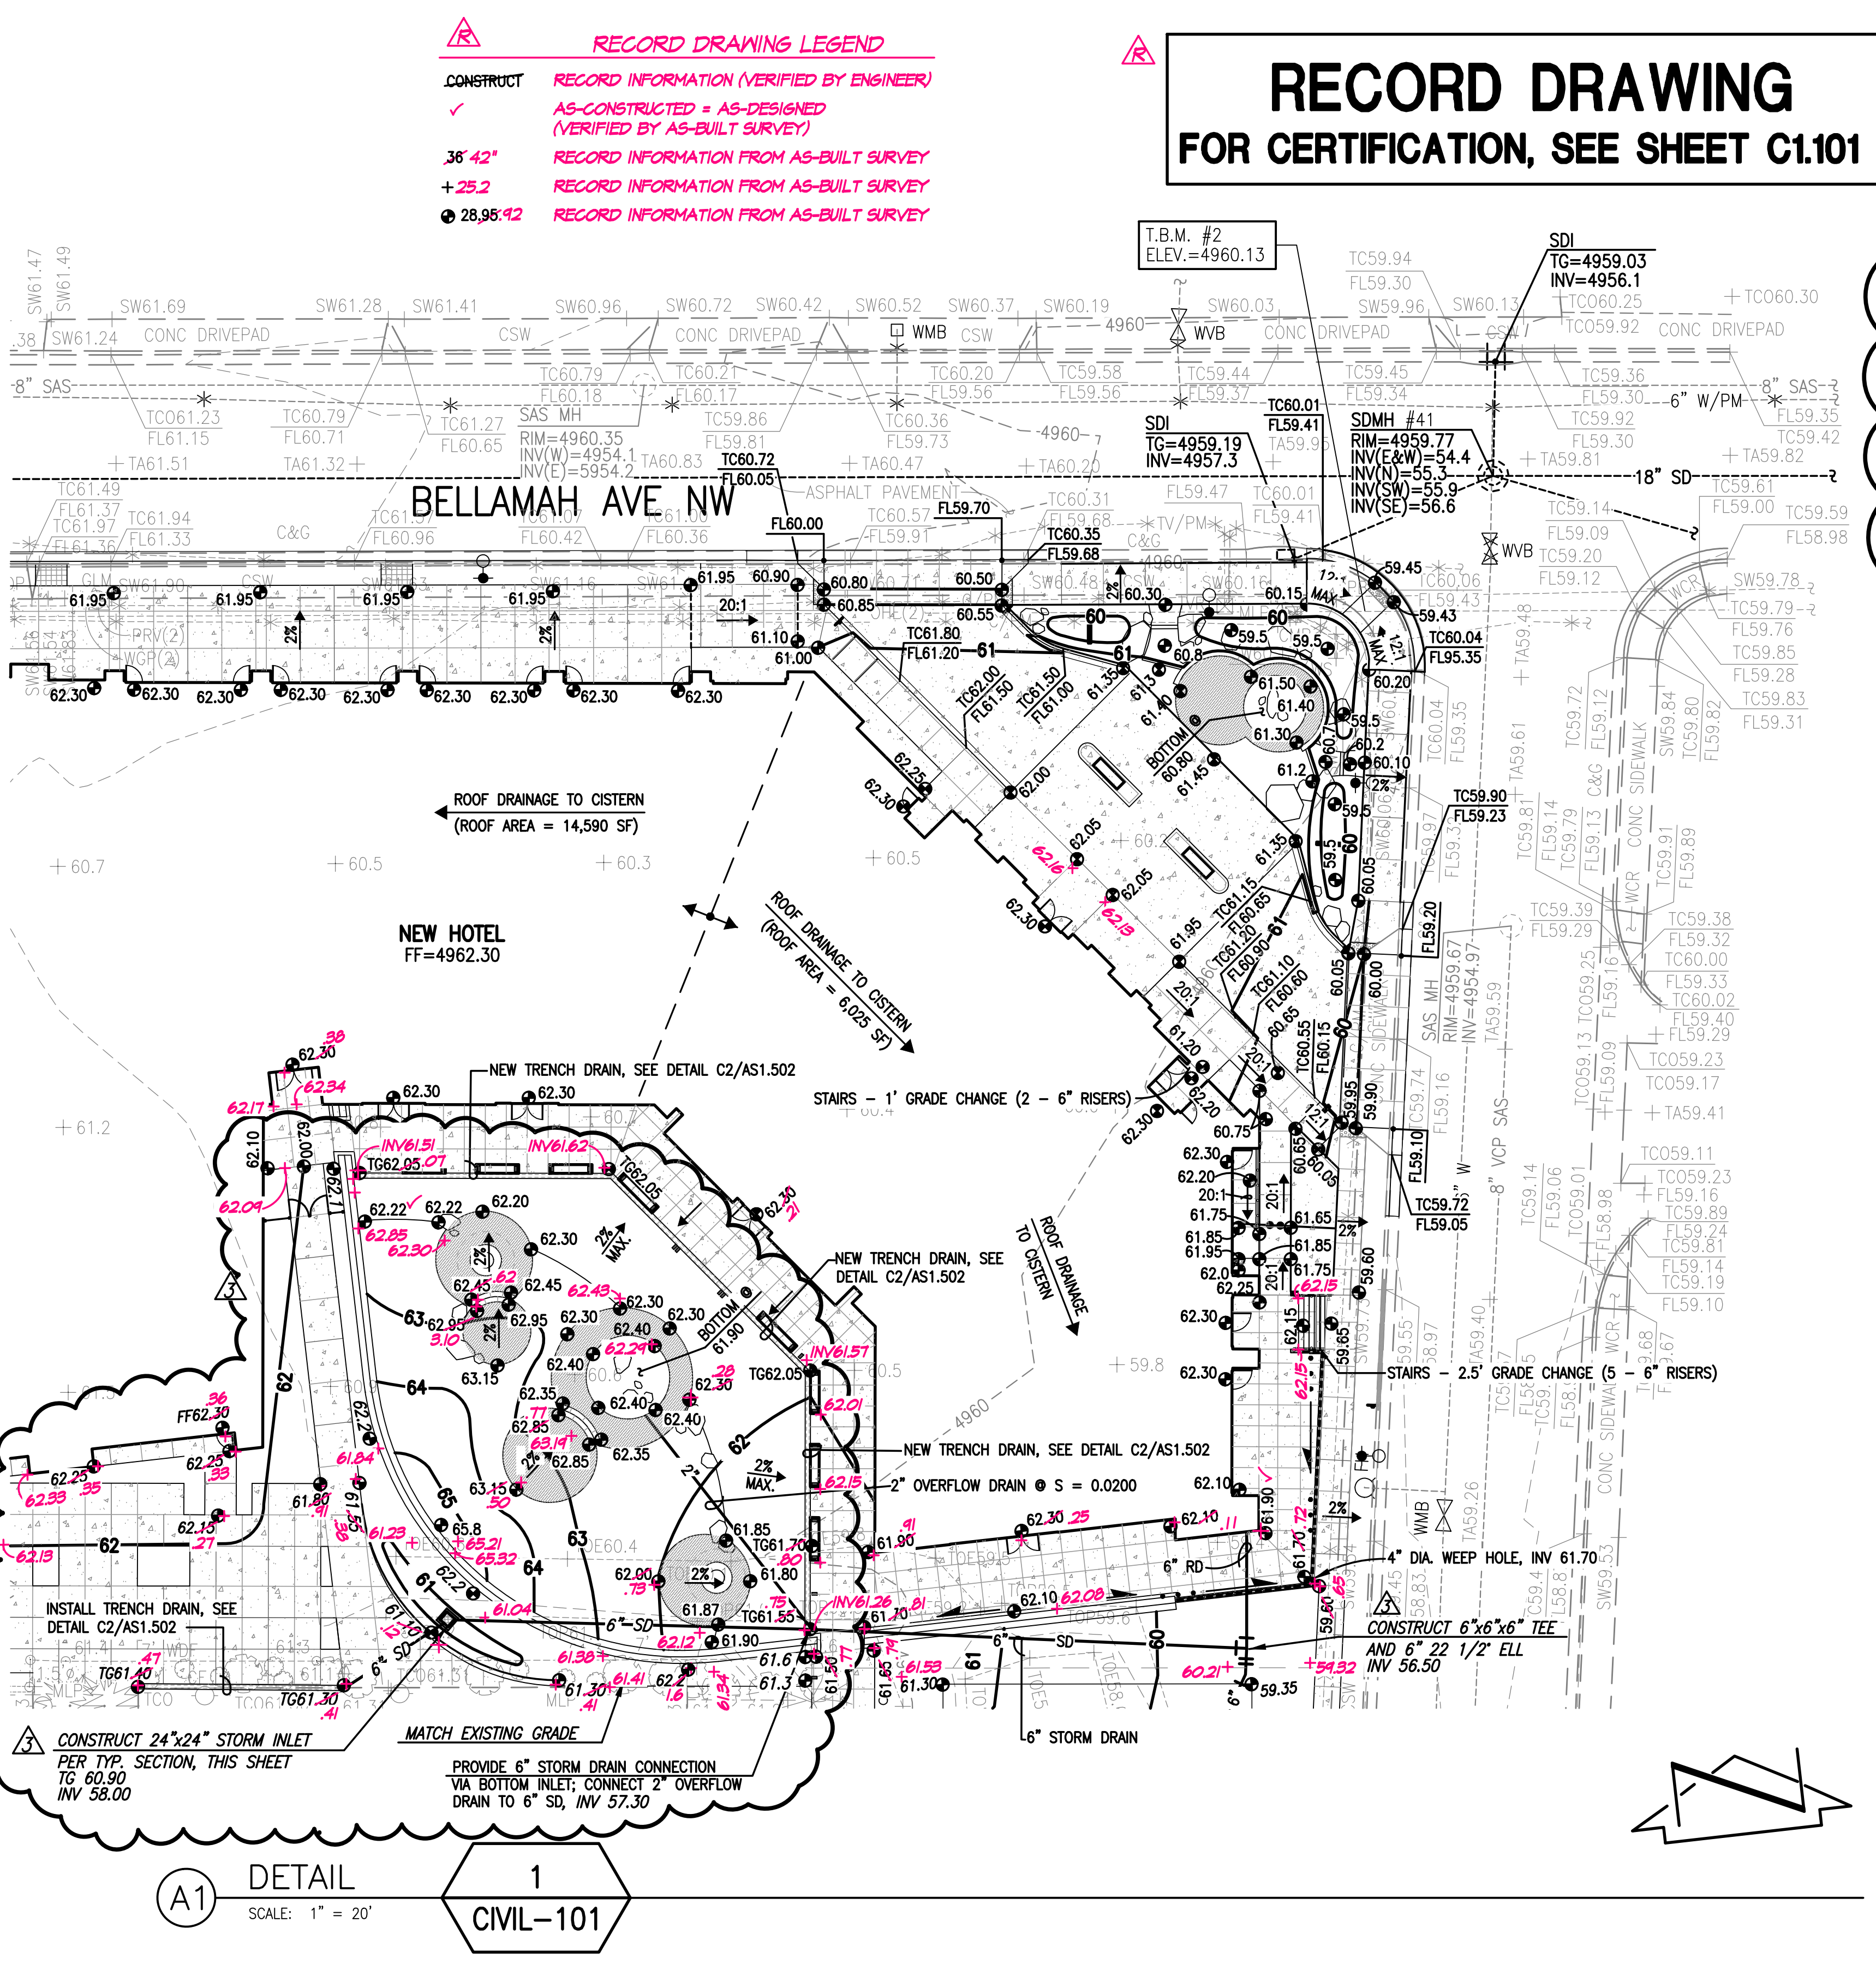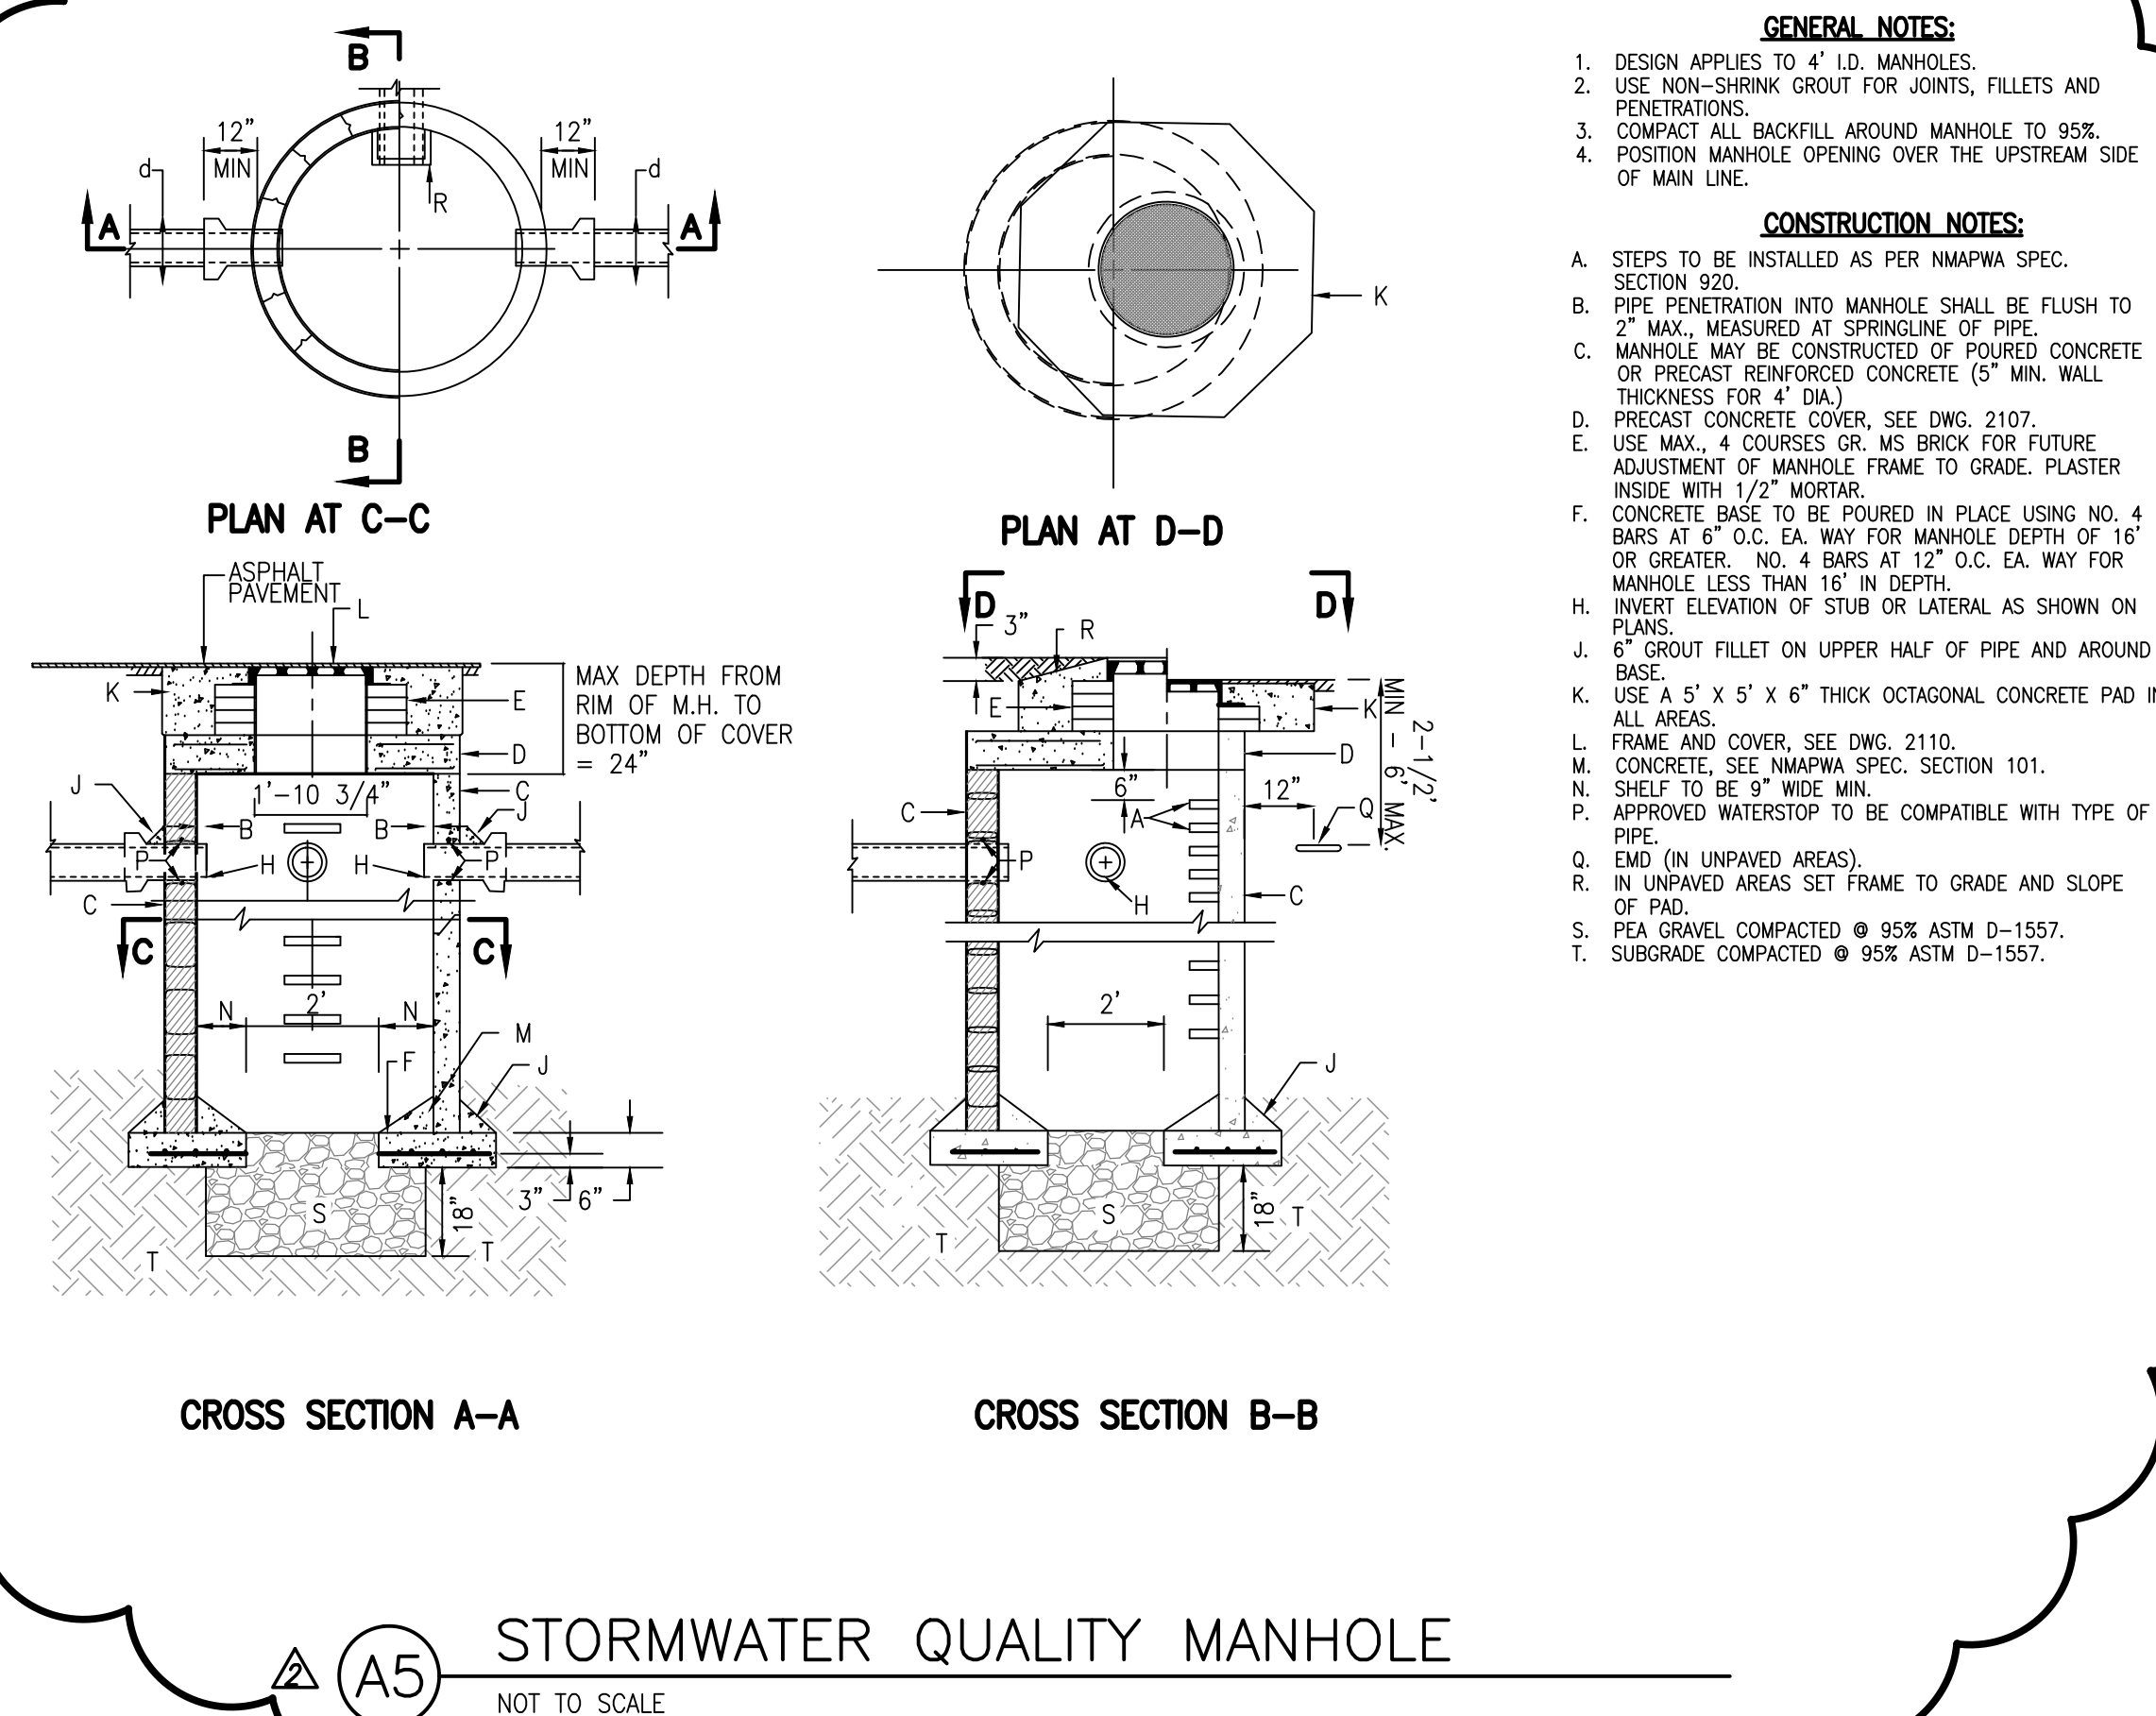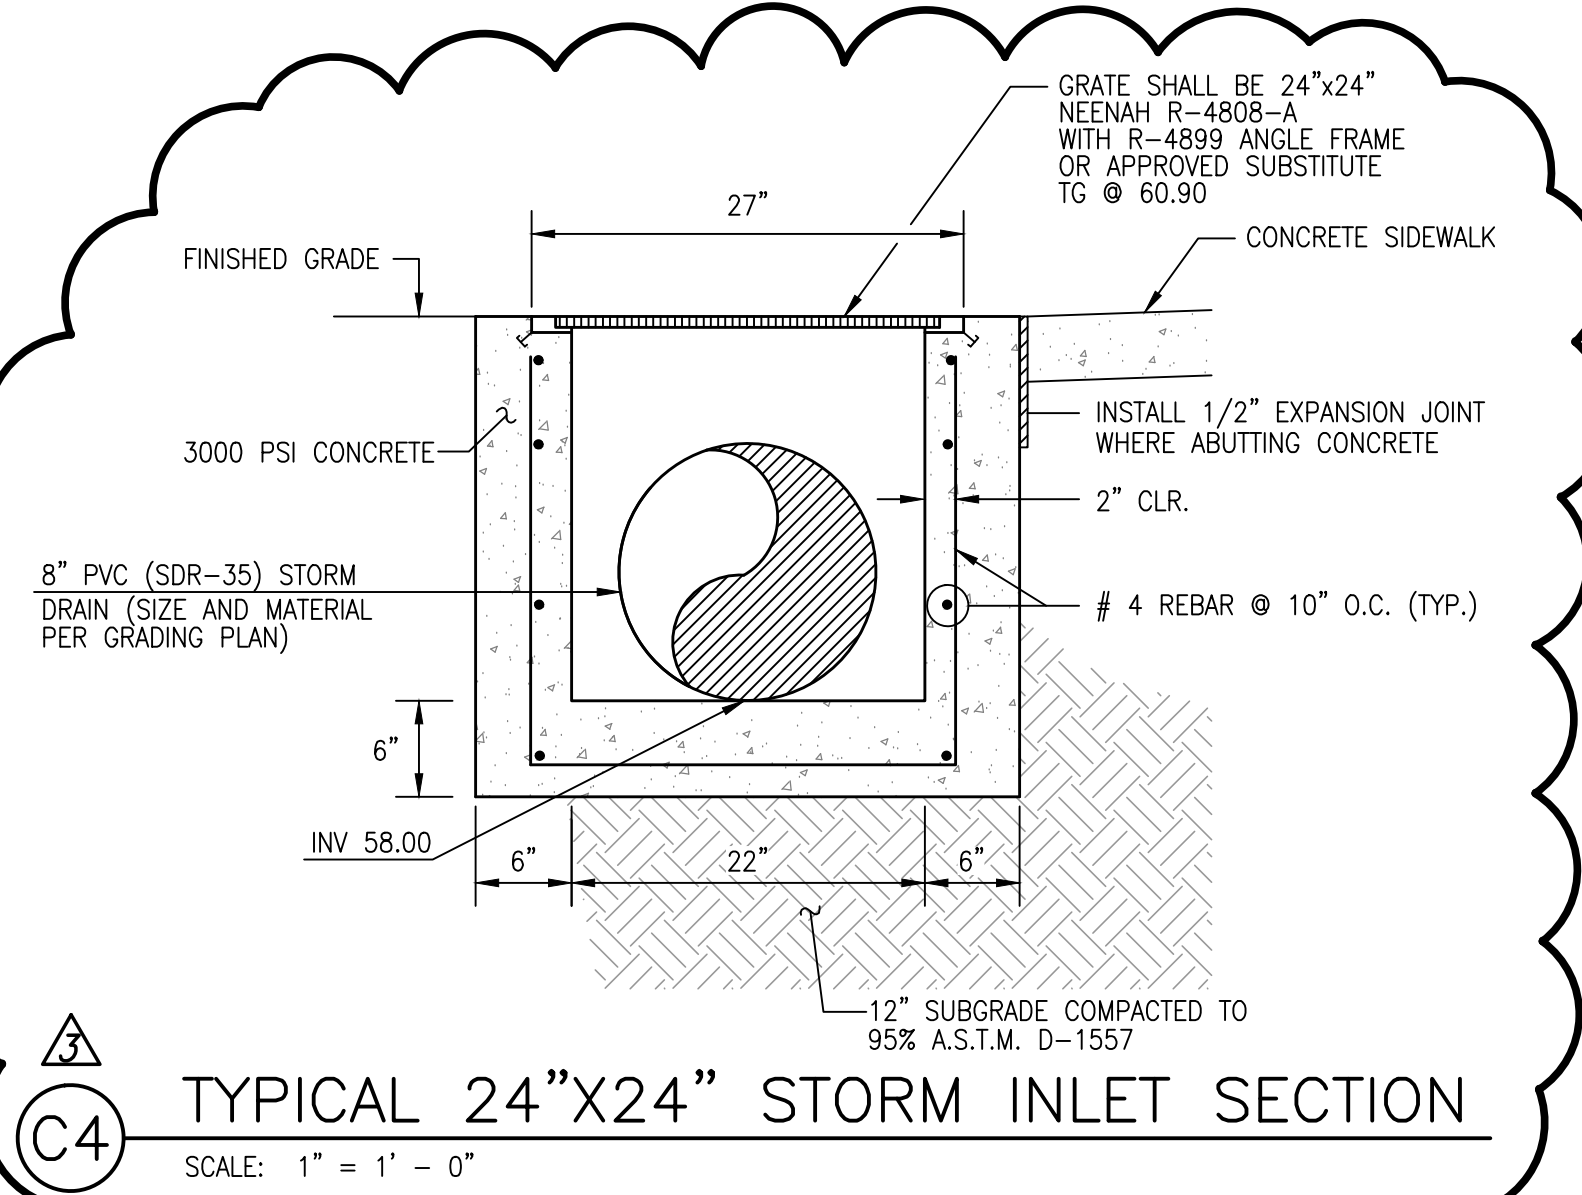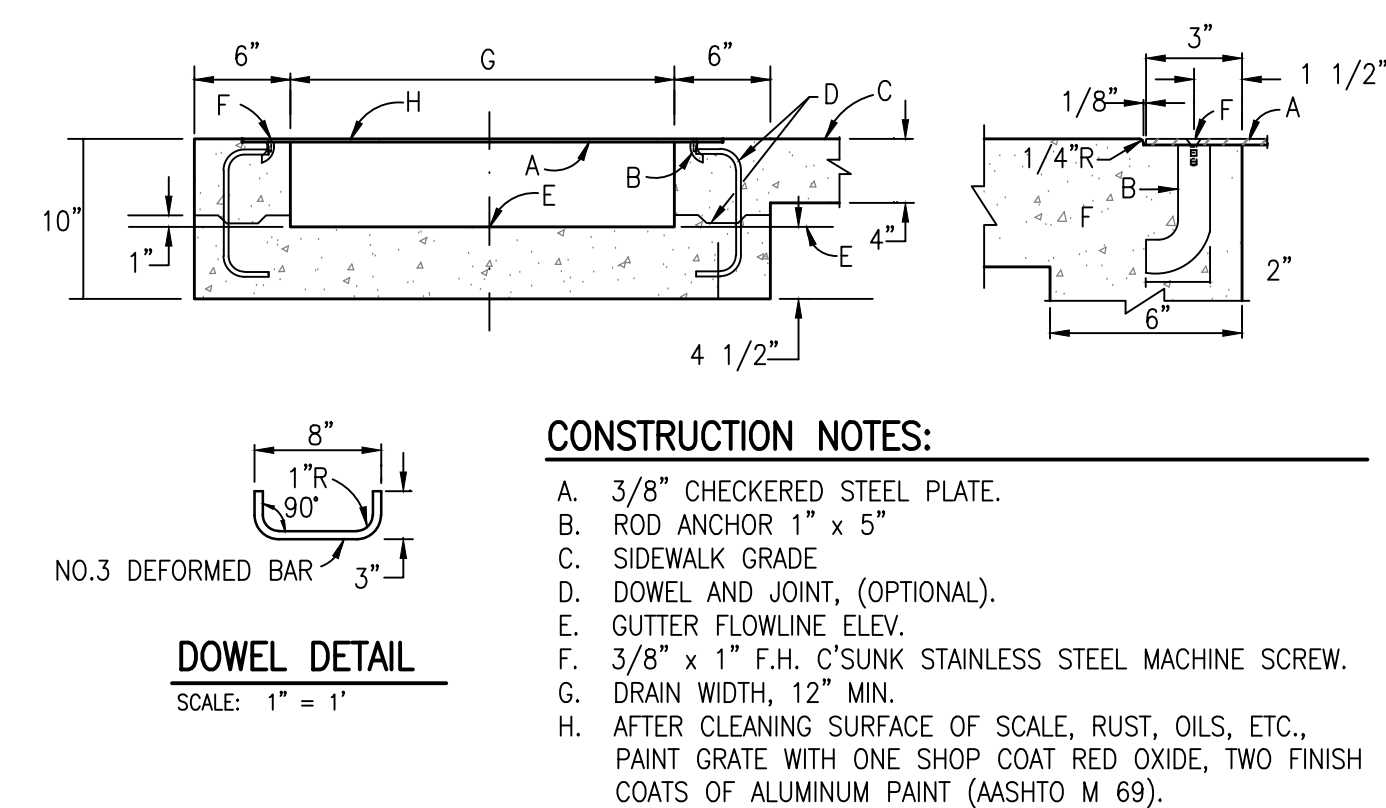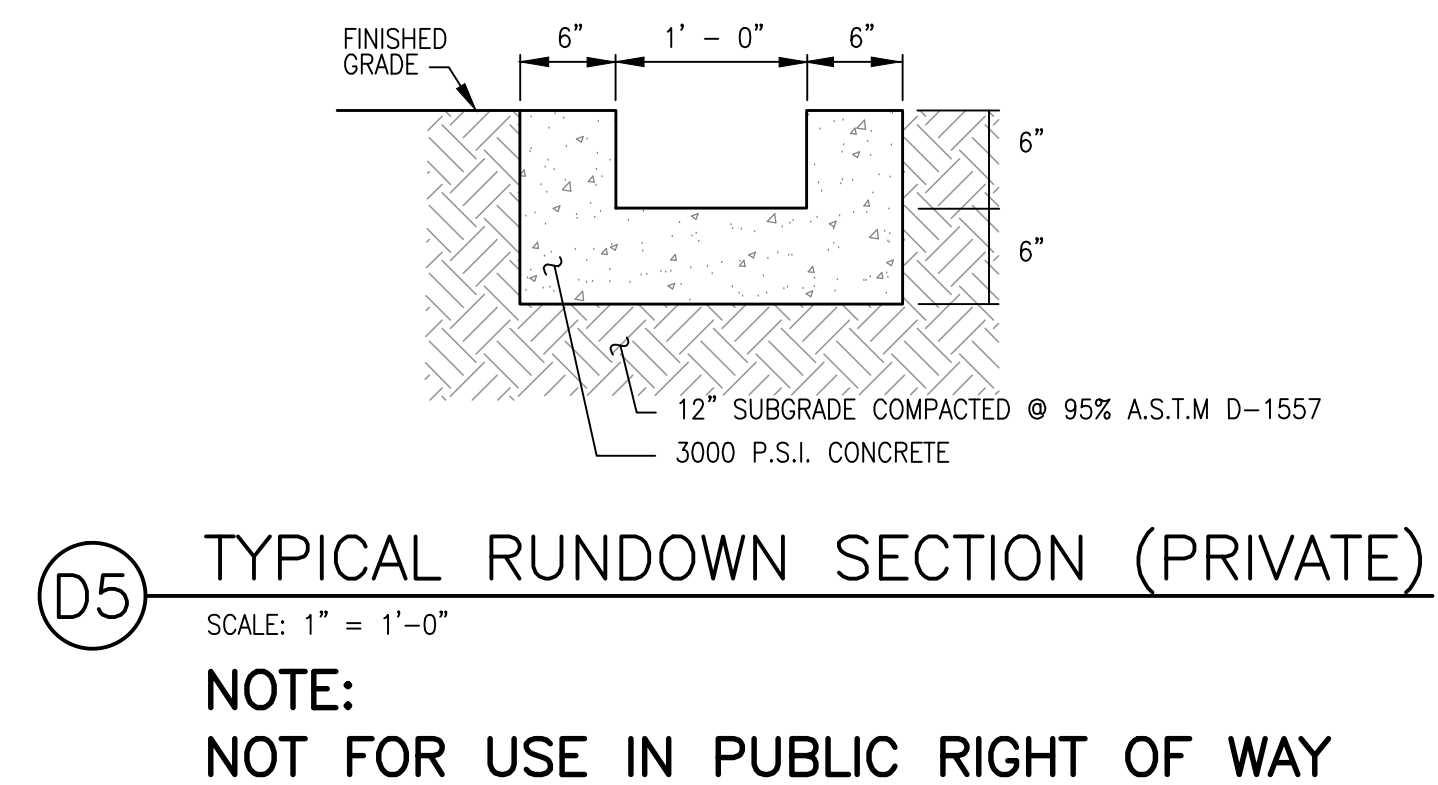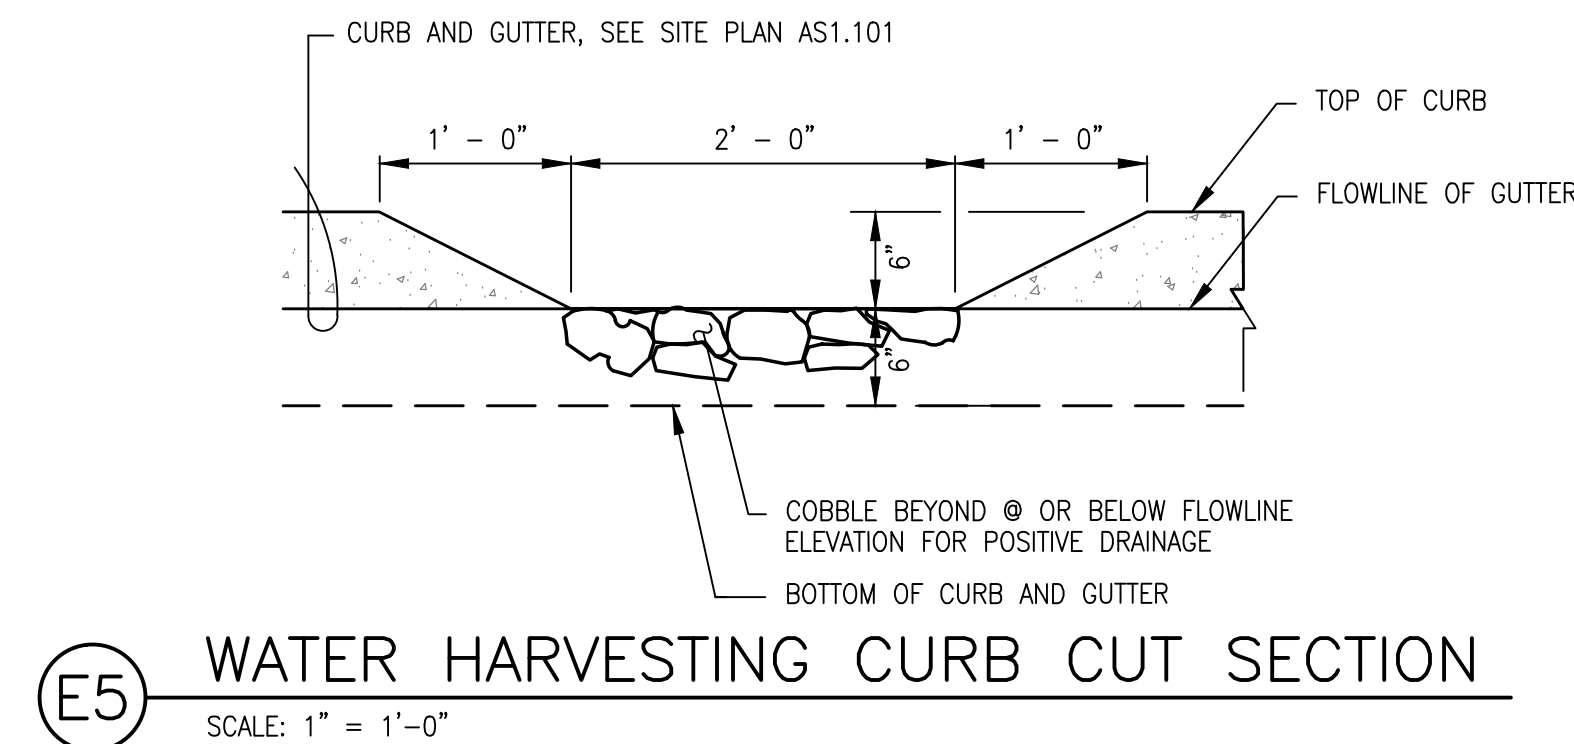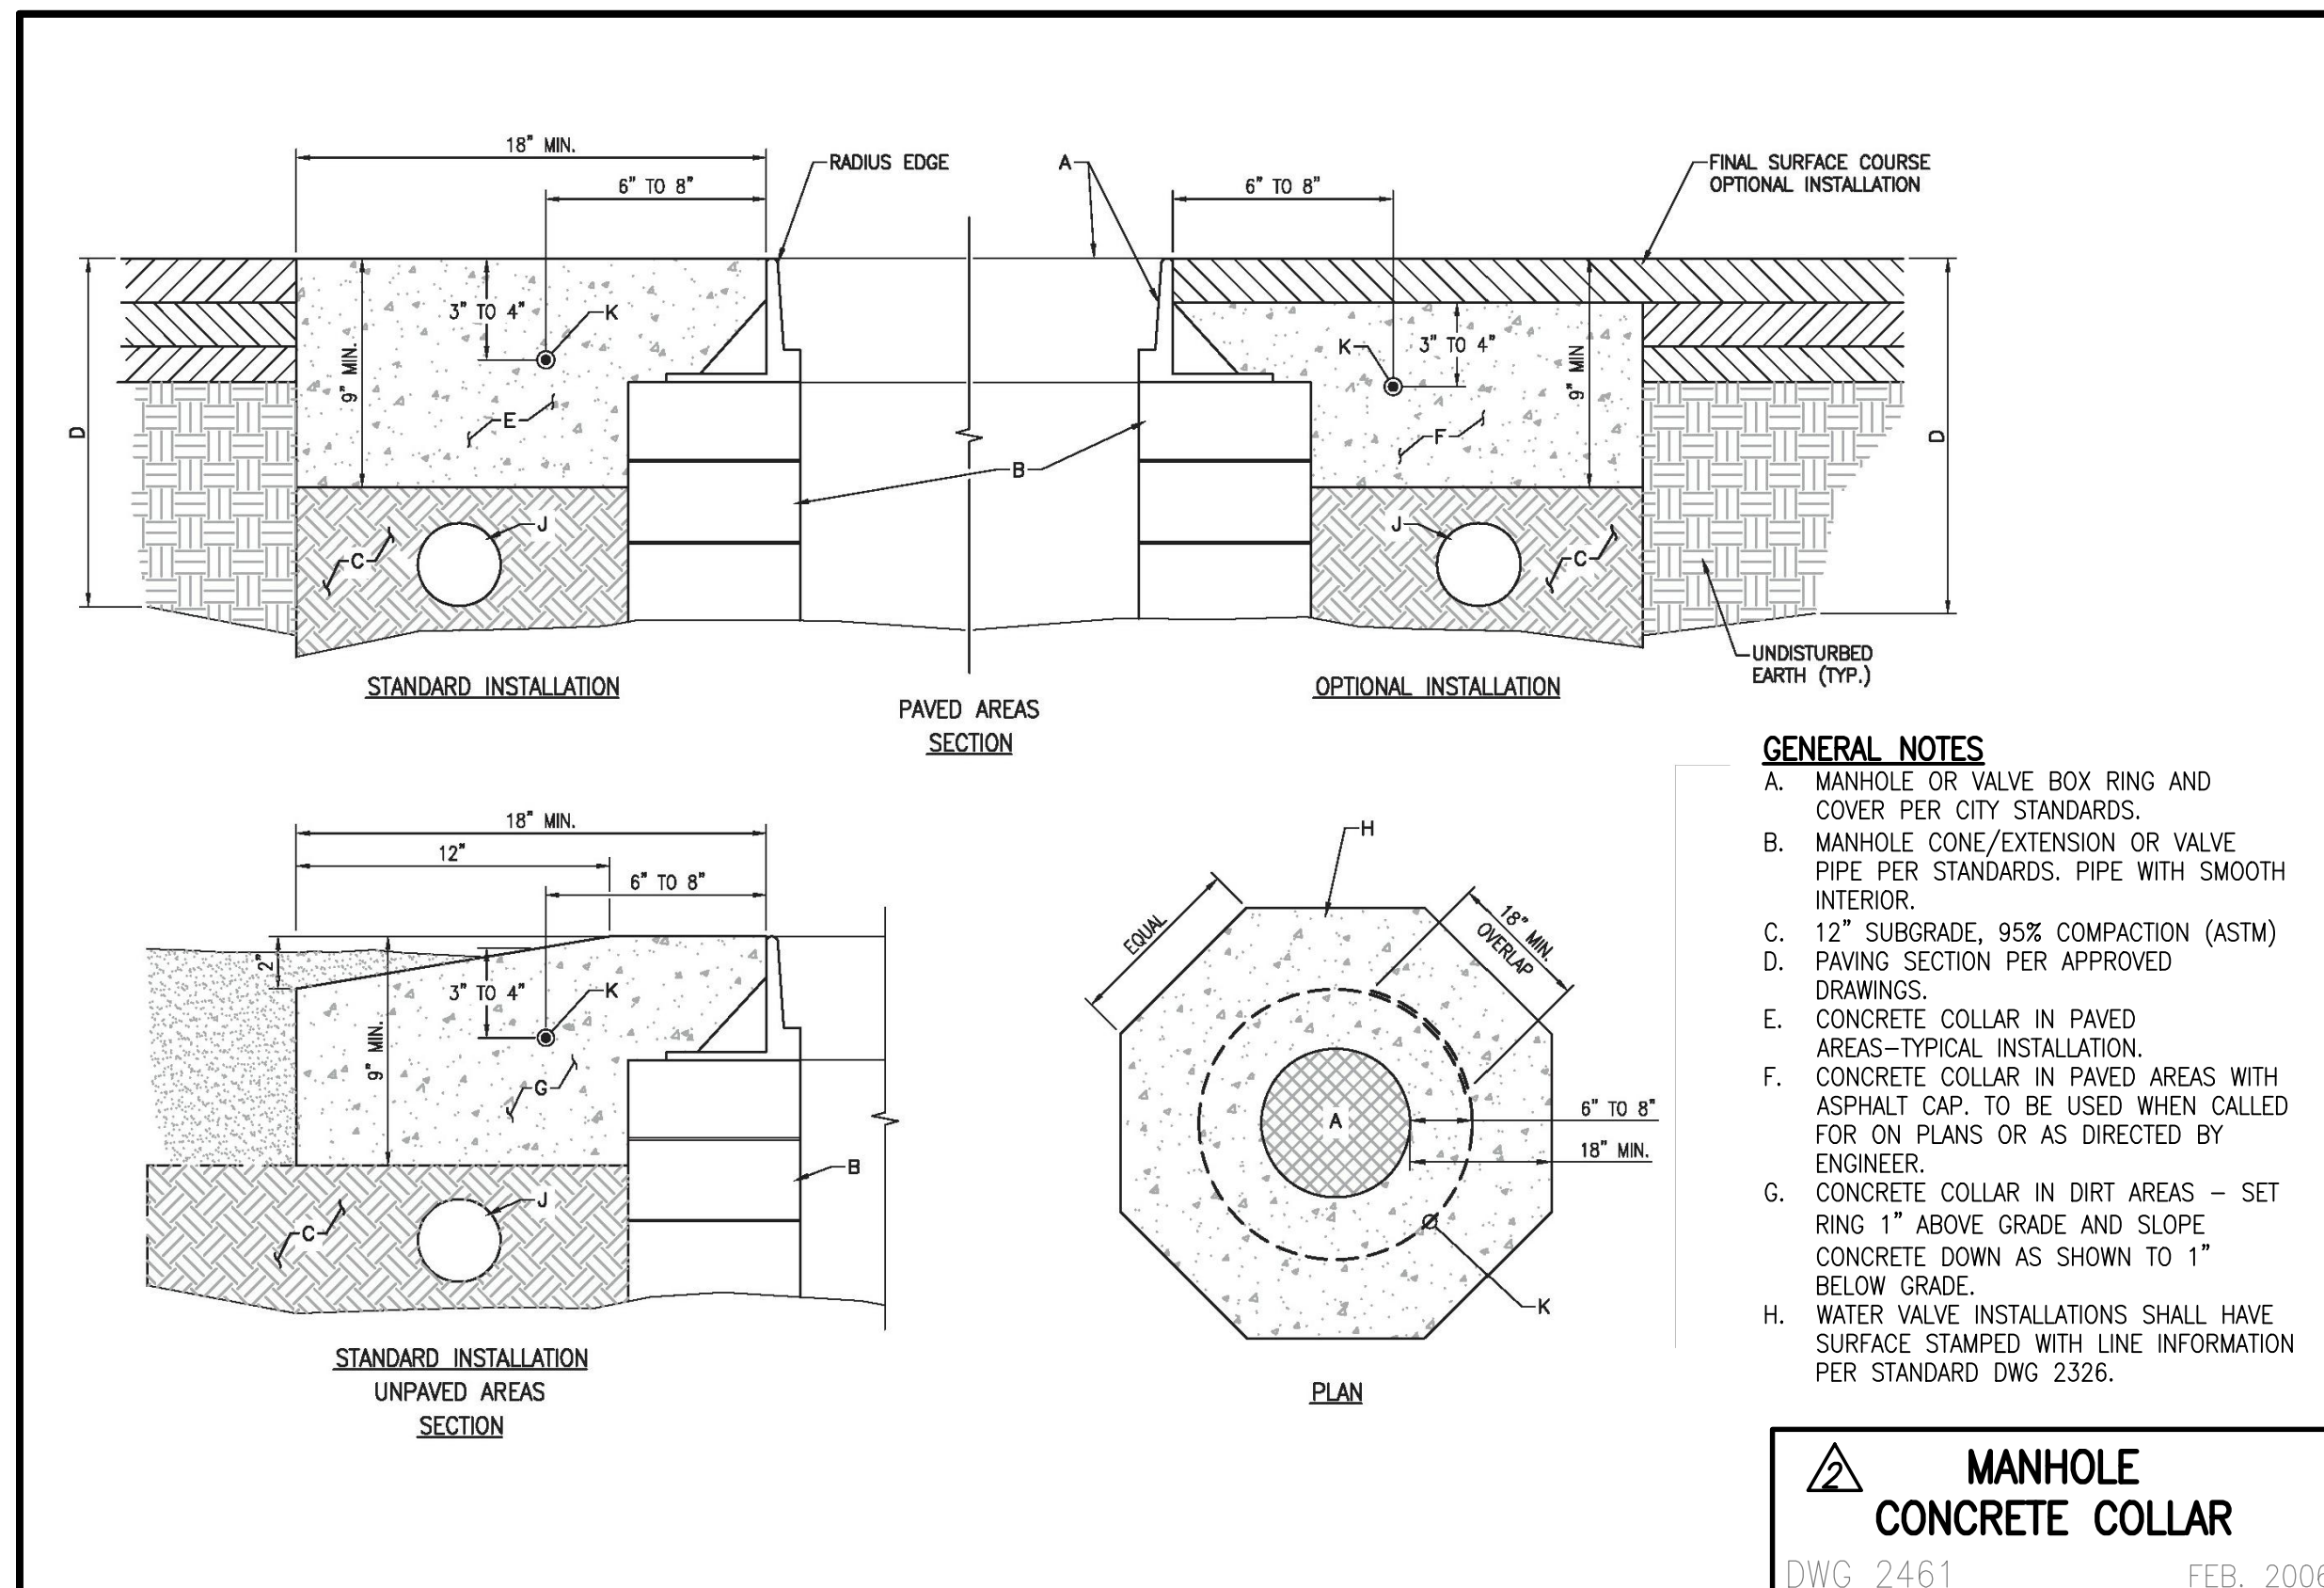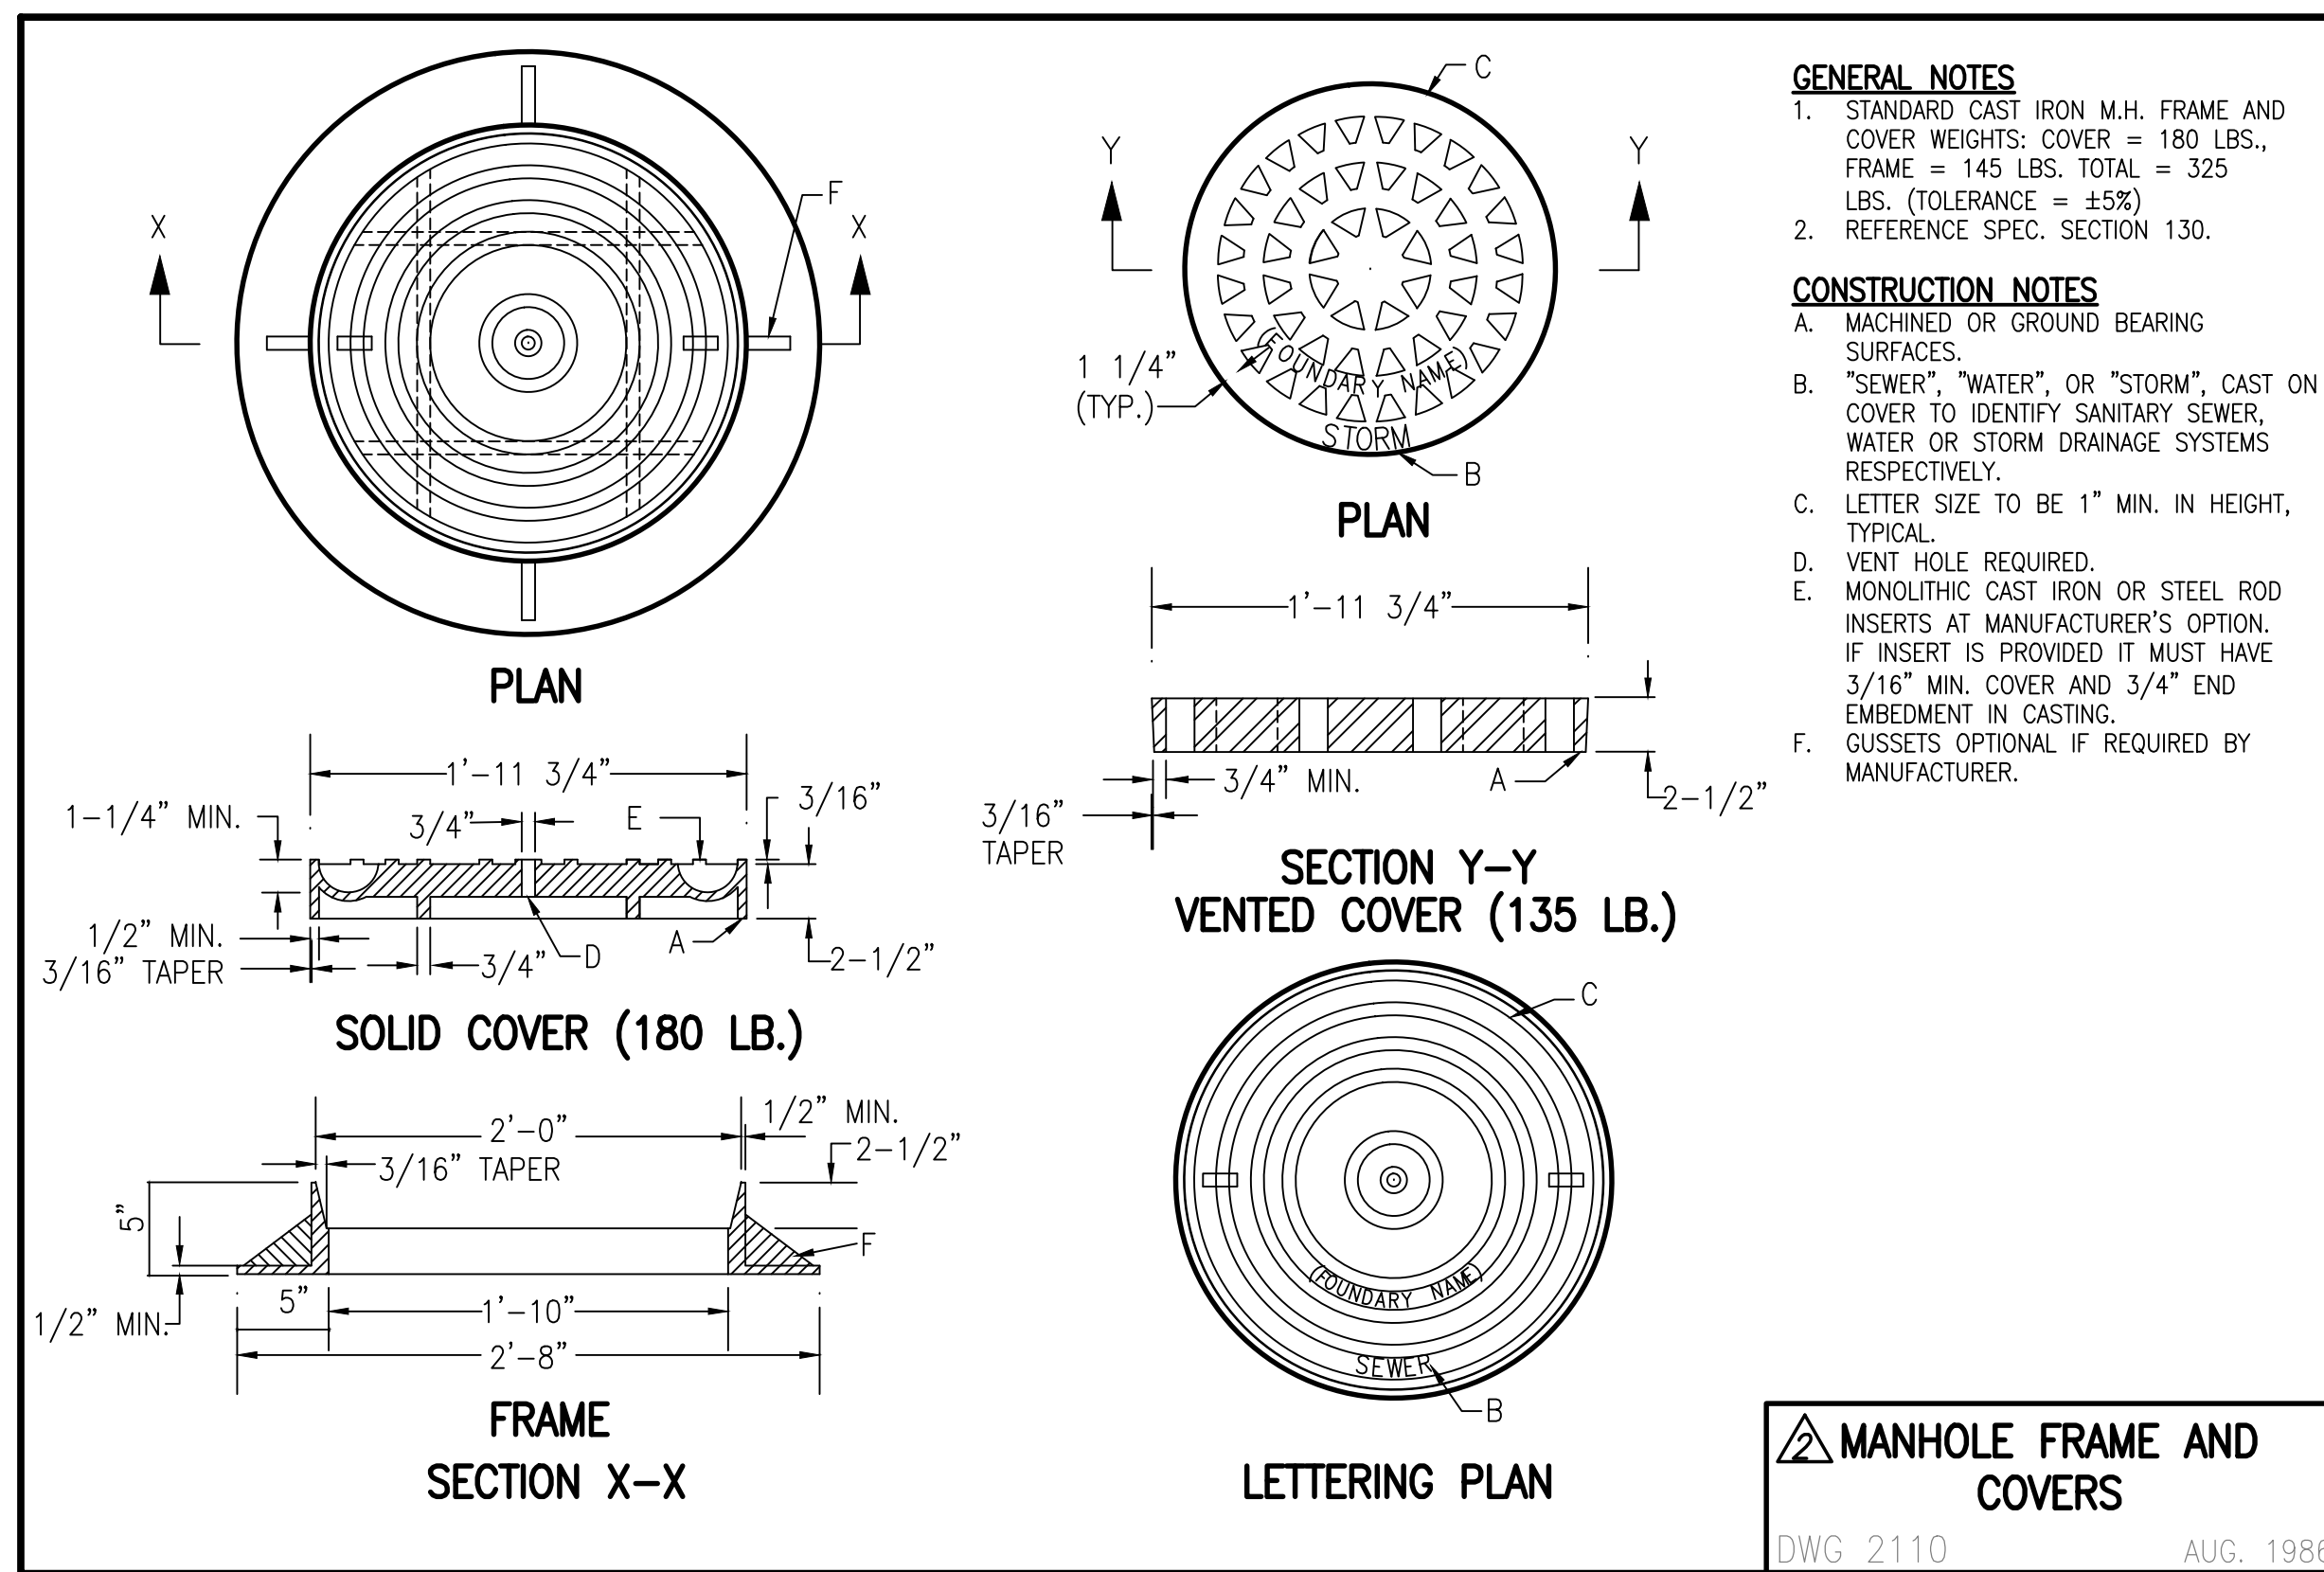

# HERITAGE HOTELS & RESORTS

2000 Bellamah Ave. NW, Albuquerque, NM 87104

Gensler

DEKKER PERICH SABATINI ARCHITECTURE / DESIGN / INSPIRATION

**HIGH MESA**  
Consulting Group

4010-8 MIDWAY PARK BLVD. NE  
ALBUQUERQUE, NEW MEXICO 87109  
PHONE: 505.345.4250 FAX: 505.345.4254  
www.highmesacg.com

Issue	Date & Issue Description	By	Check
1	10.29.14	JDS	JGM
6/16	REPLACE CISTERN W/ WATER QUALITY MH's	J.D.S.	G.M.
9/16	COURTYARD SITE PLAN ADJUSTMENTS	J.D.S.	G.M.
04/17	RECORD DRAWINGS AND TEMPORARY CERTIFICATION	J.D.S.	G.M.
05/17	PERMANENT CERTIFICATION	J.D.S.	G.M.

Seal/Signature

THIS DOCUMENT WAS ORIGINALLY ISSUED AND SEALED BY JEFFREY G. MORTENSEN, NMPE #8547 ON 10/28/2014.

Project Name: HOTEL OLD TOWN

Project Number: 13-0020

Description: DRAINAGE SECTIONS AND DETAILS

Scale

**C1.102**

©2014 Gensler

2014.032.1



## DRAINAGE PLAN

### I. INTRODUCTION AND EXECUTIVE SUMMARY

THIS PROJECT, LOCATED WITHIN THE OLD TOWN AREA OF ALBUQUERQUE, REPRESENTS A MODIFICATION TO AN EXISTING SITE WITHIN AN INFILL AREA. THE EXISTING SITE IS DEVELOPED AS THE SHERATON OLD TOWN COMPLEX THAT INCLUDES THE EXISTING HOTEL BUILDING AND ASSOCIATED SITE IMPROVEMENTS. A NEW HOTEL BUILDING WITH ASSOCIATED LANDSCAPED AND PAVING IMPROVEMENTS IS PROPOSED IN THE NORTHEAST CORNER OF THE SITE. THE DRAINAGE CONCEPT FOR THIS PROJECT WILL BE TO LIMIT DISCHARGE FROM THE SITE TO THE ALLOWABLE DISCHARGE RATE AS DEFINED IN THE APPROVED 2014 DRAINAGE MASTER PLAN, AS WELL AS CAPTURE, ONSITE, THE FIRST FLUSH OF RUNOFF FROM THE NEW IMPERVIOUS IMPROVEMENTS. THIS WILL BE DONE VIA ONSITE WATER HARVESTING, DETENTION PONDING, AND INSTALLATION OF CISTERNS TO CAPTURE ROOF RUNOFF FROM THE NEW HOTEL.

THIS SUBMITTAL IS MADE IN SUPPORT OF BUILDING PERMIT APPROVAL WITHIN THE JURISDICTION OF THE CITY OF ALBUQUERQUE.

### II. PROJECT DESCRIPTION

AS SHOWN BY THE VICINITY MAP, THE SITE IS LOCATED AT THE SOUTHEAST CORNER OF THE INTERSECTION OF RIO GRANDE BLVD NW AND BELLAMAH AVE NW. THE SITE IS DEVELOPED AS A HOTEL WITH CONVENTION SPACE, ASSOCIATED PAVED PARKING AND LANDSCAPING. THE NORTHEAST CORNER OF THE SITE IS CURRENTLY VACANT, WITH DEVELOPMENT PROPOSED AT THIS TIME. THE CURRENT LEGAL DESCRIPTION IS TRACTS A, B AND D, SHERATON OLD TOWN INN COMPLEX. AS SHOWN BY PANEL 331 OF 825 OF THE NATIONAL FLOOD INSURANCE PROGRAM FLOOD INSURANCE RATE MAPS PUBLISHED BY FEMA FOR BERNALILLO COUNTY, NEW MEXICO, REVISED AUGUST 15, 2011, THE SOUTHEAST CORNER OF THE SITE LIES WITHIN A DESIGNATED FLOOD HAZARD ZONE. THE FLOOD HAZARD ZONE HAS BEEN IDENTIFIED AS AN AH ZONE WITH A CORRESPONDING FLOOD ELEVATION OF 4958 FEET TO THE FLOODPLAIN. THE PROPOSED HOTEL BUILDING AND ALL SUBSEQUENT OCCUPIED STRUCTURES WILL BE ESTABLISHED AT A MINIMUM OF ONE FOOT ABOVE THE CORRESPONDING FLOOD ELEVATION.

### III. BACKGROUND CONDITIONS

THE PREPARATION OF THIS PLAN RELIED UPON THE FOLLOWING DOCUMENTS AND ACTIVITIES:

- DRAINAGE MASTER PLAN FOR SHERATON OLD TOWN PREPARED BY HIGH MESA CONSULTING GROUP, NMPE 8547, DATED 06-23-2014. THE 2014 DMP ESTABLISHED THE DRAINAGE BASINS FOR THE PROPOSED DEVELOPMENT OF THE SITE, AS WELL AS DRAINAGE AND STORMWATER CONTROL GUIDELINES AND CRITERIA FOR PROPOSED DEVELOPMENT OF THE SITE.
- TOPOGRAPHIC SURVEY PREPARED BY HIGH MESA CONSULTING GROUP (NMPS 11184) DATED 11-06-2013. THIS REFERENCED SURVEY PROVIDES THE BASIS FOR THE EXISTING CONDITIONS OF THE PROJECT SITE (TRACTS A, B AND D).

### IV. EXISTING CONDITIONS

THE PROJECT SITE CONSISTS OF THE NORTHEASTERN PORTION OF THE HOTEL SITE. WITH A LARGE MAJORITY OF THE PROJECT SITE IS VACANT, WITH MINIMAL VEGETATION. THE DEVELOPED PORTIONS OF THE SITE CONSIST OF AN OUTDOOR POOL, AND DECK, ALONG WITH THE EAST END OF THE PAVED PARKING LOT NORTH OF THE HOTEL. THE PROJECT SITE IS CHARACTERIZED BY 3 DRAINAGE BASINS, BASINS B, E, AND F.

A. BASIN B IS GENERALLY CHARACTERIZED BY THE CENTRAL PORTION OF THE OVERALL SITE. THIS BASIN CONSISTS OF THE HOTEL COURTYARD, SWIMMING POOL AND DECK AREA, AND UNDEVELOPED VACANT AREA IMMEDIATELY ADJACENT TO THE POOL. THE BASIN GENERALLY DRAINS WEST TO EAST, FLOWING TO AN EXISTING DETENTION POND THAT DISCHARGES VIA 4" DIAMETER CURB PENETRATION TO 20TH STREET NW. THE EXISTING DETENTION POND AND CURB PENETRATION HAVE MINIMAL CAPACITY COMPARED TO THE BASIN RUNOFF GENERATED, AND APPEAR TO PROVIDE NEGLIGIBLE PONDING AND CONTROL OF DISCHARGE TO 20TH STREET NW. THE EXISTING PEAK RATE OF DISCHARGE GENERATED BY THIS BASIN IS 3.7 CFS/A.

B. BASIN E IS CHARACTERIZED BY THE NORTHWEST PORTION OF THE SITE. THE PORTION OF THIS BASIN THAT THE PROPOSED PROJECT WILL IMPACT IS DESIGNATED AS SUB-BASIN E-1. SUB-BASIN E-1 CONSISTS OF THE EASTERN PORTION OF THE PARKING LOT IMMEDIATELY NORTH OF THE EXISTING HOTEL BUILDING. RUNOFF FROM THE PARKING LOT SHEETFLOWS SOUTH TO NORTH TO A LANDSCAPED BUFFER ALONG THE NORTH EDGE OF THE SITE. EXCESS RUNOFF THAT IS NOT CAPTURED BY THE BUFFER SHEETFLOWS INTO BELLAMAH AVE NW. A FULLY DEVELOPED PUBLIC STREET, THERE IS NO CONCENTRATED POINT OF DISCHARGE FOR THIS SUB-BASIN. THE EXISTING PEAK RATE OF DISCHARGE GENERATED BY THIS SUB-BASIN IS 4.3 CFS/A.

C. BASIN F IS CHARACTERIZED BY THE NORTHEAST PORTION OF THE SITE. THIS BASIN CONSISTS OF THE EXISTING UNDEVELOPED VACANT LAND AT THE NORTHEAST CORNER OF THE SITE. RUNOFF FROM THIS BASIN SHEETFLOWS FROM WEST TO EAST ACROSS THE BASIN AND INTO 20TH STREET NW, A FULLY DEVELOPED PUBLIC STREET. THERE IS NO CONCENTRATED POINT OF DISCHARGE FOR THIS BASIN; RUNOFF SHEETFLOWS INTO THE FRONTING STREET. THE EXISTING PEAK RATE OF DISCHARGE GENERATED BY THIS BASIN IS 3.4 CFS/A.

THERE ARE NO SIGNIFICANT OFFSITE FLOWS ENTERING THE SITE. THE PAVED PARKING LOT SOUTH OF THE SITE DRAINS SOUTH, AWAY FROM THE PROJECT SITE. THE EXISTING PARKING LOT AND HOTEL BUILDING LOCATED WEST OF THE PROJECT SITE GENERALLY DRAIN WEST AND NORTH, AWAY FROM THE PROJECT. BELLAMAH AVENUE NW TO THE NORTH IS TOPOGRAPHICALLY LOWER THAN THE SITE AND THEREFORE CONTRIBUTES NO OFFSITE FLOWS. 20TH STREET NW TO THE EAST IS TOPOGRAPHICALLY LOWER THAN THE SITE, HOWEVER, THE STREET IS ASSOCIATED WITH A DESIGNATED FLOOD HAZARD ZONE ON THE PROPERTY. A CORRESPONDING ELEVATION OF 4958 HAS BEEN IDENTIFIED FOR THIS FLOOD HAZARD ZONE. ALL BUILDINGS ON THE SITE ARE CONSTRUCTED WITH A FINISHED FLOOR ELEVATION A MINIMUM OF ONE FOOT ABOVE THE CORRESPONDING FLOOD HAZARD ZONE.

### V. DEVELOPED CONDITIONS

THE DEVELOPED CONDITIONS FOR EACH DRAINAGE BASIN THAT MAKES UP THE PROJECT SITE (B, E AND F) AND THE RESPECTIVE DEVELOPED SUB-BASINS ARE DISCUSSED BELOW:

A. THE PROPOSED CONSTRUCTION WITHIN BASIN B WILL CONSIST OF A PAVED PARKING LOT EXPANSION IMMEDIATELY SOUTH OF THE SWIMMING POOL, AND LANDSCAPED IMPROVEMENTS EAST OF THE POOL. THIS BASIN WILL BE DIVIDED INTO FOUR SUB-BASINS.

SUB-BASIN B.1 CONSISTS OF THE EXISTING SWIMMING POOL AND DECK. THIS SUB-BASIN IS ENCLOSED BY A NEW WALL. ALL RUNOFF GENERATED BY THE EXISTING IMPROVEMENTS IS CONTAINED WITHIN THE WALLED POOL AREA AND DRAINS TO NEW AND EXISTING LANDSCAPED AREAS THAT MANAGE THE RUNOFF FROM THIS SUB-BASIN.

SUB-BASIN B.2 CONSISTS OF THE LANDSCAPED AREA IMMEDIATELY EAST OF THE POOL AREA. THIS SUB-BASIN WILL DRAIN WEST TO EAST TO A SHALLOW (< 12" DEPTH) LANDSCAPED DEPRESSION, WITH OVERFLOW DISCHARGING TO 20TH STREET NW.

A CISTERN RECEIVING ROOF RUNOFF FROM THE NEW HOTEL WILL BE INSTALLED BELOW GRADE IN SUB-BASIN B-2. THE CISTERN WILL BE SIZED TO RETAIN BOTH THE FIRST ⅓ OF RUNOFF GENERATED FROM THE EAST PORTION OF THE NEW STAND-ALONE HOTEL BUILDING (DESIGNATED AS SUB-BASIN F.4) AS WELL AS THE DEVELOPED RUNOFF GENERATED BY THE NEW HOTEL COURTYARD (DESIGNATED AS SUB-BASIN F.5). OVERFLOW FROM THE CISTERN WILL BE DISCHARGED VIA 4" PVC CURB PENETRATION TO 20TH STREET NW.

SUB-BASIN B.3 CONSISTS OF THE PAVED PARKING LOT EXPANSION IMMEDIATELY SOUTH OF THE SWIMMING POOL. RUNOFF GENERATED BY SUB-BASIN B.3 WILL SHEETFLOW FROM WEST TO EAST ACROSS THE PARKING LOT. SEVERAL LANDSCAPED ISLANDS WITHIN THE PARKING LOT WILL ACT AS WATER HARVESTING AREAS TO CAPTURE (TO THE MAXIMUM EXTENT PRACTICABLE) THE FIRST FLUSH OF RUNOFF GENERATED BY SUB-BASIN B.3. RUNOFF THAT IS NOT CAPTURED BY THE WATER HARVESTING AREAS WILL DISCHARGE VIA SIDEWALK CULVERT INTO 20TH STREET NW. A 4" CURB OPENING AT THE UPSTREAM END OF THE CULVERT IS SIZED TO NOT EXCEED THE ALLOWABLE DISCHARGE RATE FOR THIS SUB-BASIN OF 2.75 CFS/A. AS DEMONSTRATED BY THE CALCULATIONS REFERENCED IN SECTION VI, THE PARKING LOT WILL ACT AS A DETENTION POND SIZED TO CONTAIN THE DETAINED RUNOFF RESULTING FROM CONTROLLED DISCHARGE FROM THE SUB-BASIN.

SUB-BASIN B.4 CONSISTS OF THE REMAINDER OF BASIN B THAT INCLUDES THE CENTRAL PORTION OF THE EXISTING HOTEL AND COURTYARD THAT ARE UPSTREAM OF SUB-BASIN B.3. THIS AREA IS OUTSIDE THE LIMITS OF THE PROPOSED DEVELOPMENT FOR THE PROJECT SITE, THEREFORE NO CHANGE IN HYDROLOGY IS PROPOSED OR ANTICIPATED. EXISTING RUNOFF FROM SUB-BASIN B.4 WILL BE ALLOWED TO FREELY FLOW THROUGH SUB-BASIN B.3 TO ULTIMATELY DISCHARGE TO 20TH STREET NW.

B. THE PROPOSED CONSTRUCTION WITHIN BASIN E WILL CONSIST OF THE MODIFICATION OF A PORTION OF THE EXISTING PARKING LOT WEST OF THE NEW STAND-ALONE HOTEL BUILDING. THIS BASIN IS DIVIDED INTO TWO SUB-BASINS.

SUB-BASIN E.1 WILL CONSIST OF THE PROPOSED PARKING LOT MODIFICATIONS, INCLUDING THE ELIMINATION OF ELEVEN PARKING SPACES AND THE ADDITION OF NEW CURBS AND LANDSCAPED WATER HARVESTING AREAS. THE WATER HARVESTING AREAS WILL BE SIZED TO CAPTURE THE FIRST FLUSH GENERATED BY SUB-BASIN E.1 TO THE MAXIMUM EXTENT PRACTICABLE. RUNOFF WILL EVENTUALLY SHEETFLOW THROUGH A NEW TRENCH DRAIN, DRAINING THROUGH A NEW RUNOFF AND SIDEWALK CULVERT INTO SUB-BASIN E.2, AND ULTIMATELY DISCHARGING TO BELLAMAH AVE NW. THE PROPOSED IMPROVEMENTS WILL RESULT IN A DECREASE IN IMPERVIOUS AREA, CREATING A DECREASE IN RUNOFF GENERATED IN THE DEVELOPED CONDITION.

SUB-BASIN E.2 CONSISTS OF THE REMAINDER OF BASIN E BEYOND THE PROJECT LIMITS, INCLUDING THE EXISTING HOTEL AND THE NORTH AND WEST PARKING LOTS. NO DEVELOPMENT IS CURRENTLY PLANNED FOR SUB-BASIN E-2, THEREFORE NO CHANGE IN HYDROLOGY IS PROPOSED OR ANTICIPATED.

C. THE PROPOSED CONSTRUCTION WITHIN BASIN F WILL CONSIST OF A NEW STAND-ALONE HOTEL BUILDING, COURTYARD, ASSOCIATED PAVED SIDEWALKS AND LANDSCAPING. THIS BASIN WILL BE DIVIDED INTO SEVEN SUB-BASINS.

SUB-BASIN F.1 CONSISTS OF THE PAVED PARKING AND LANDSCAPED IMPROVEMENTS IMMEDIATELY WEST OF THE NEW HOTEL BUILDING. IN ADDITION, A NEW CISTERN WILL BE LOCATED IN THIS BASIN THAT WILL RETAIN THE FIRST ⅓ OF RUNOFF GENERATED BY THE WEST PORTION OF THE HOTEL ROOF AREA (DESIGNATED AS SUB-BASIN F.3). SUB-BASIN F.1 DRAINS FROM SOUTH TO NORTH TO DISCHARGE INTO BELLAMAH AVE NW VIA NEW RUNDOWN AND SIDEWALK CULVERT. LANDSCAPED IMPROVEMENTS WILL BE GRADED TO ACT AS DEPRESSIONED WATER HARVESTING AREAS WHERE PRACTICABLE. AS A RESULT OF AN INCREASE IN LANDSCAPED LAND TREATMENT, THE RUNOFF GENERATED FROM THIS SUB-BASIN WILL BE DECREASED FROM THE EXISTING CONDITION.

SUB-BASIN F.2 CONSISTS OF THE NEW PAVED SERVICE AREA IMMEDIATELY WEST OF THE NEW HOTEL BUILDING. TO AVOID RUNOFF FROM THE REFUSE COMPACTOR IN THIS SERVICE DRIVING TO THE ADJACENT PUBLIC STREET, THIS SUB-BASIN WILL DISCHARGE ALL DEVELOPED RUNOFF TO THE EXISTING PRIVATE SANITARY SEWER SYSTEM VIA A NEW SANITARY SEWER MANHOLE WITH GRATED LID. THEREFORE, NO RUNOFF FROM THIS SUB-BASIN WILL DISCHARGE TO BELLAMAH AVE NW IN THE DEVELOPED CONDITION.

SUB-BASIN F.3 CONSISTS OF THE WEST PORTION OF THE NEW HOTEL BUILDING. RUNOFF GENERATED BY THE HOTEL ROOF AREA WILL BE CONVEYED VIA ROOF DRAIN TO A NEW CISTERN INSTALLED IN SUB-BASIN F.1; THE CISTERN IS SIZED TO RETAIN THE FIRST ⅓ OF ROOF RUNOFF. A 4" PVC CURB PENETRATION WILL DISCHARGE OVERFLOW FROM THE CISTERN NORTH TO BELLAMAH AVE NW.

SUB-BASIN F.4 CONSISTS OF THE EAST PORTION OF THE NEW HOTEL BUILDING. RUNOFF GENERATED BY THE HOTEL ROOF AREA WILL BE CONVEYED VIA ROOF DRAIN TO A NEW CISTERN INSTALLED IN SUB-BASIN B.2; THE CISTERN IS SIZED TO RETAIN THE FIRST ⅓ OF ROOF RUNOFF. A 4" PVC CURB PENETRATION WILL DISCHARGE OVERFLOW FROM THE CISTERN EAST TO 20TH STREET NW.

SUB-BASIN F.5 CONSISTS OF THE NEW HOTEL COURTYARD. RUNOFF FROM THIS BASIN WILL DRAIN TO A NEW TRENCH DRAIN. FROM THIS POINT, RUNOFF WILL BE CONVEYED VIA PRIVATE STORM DRAIN TO THE NEW CISTERN IN SUB-BASIN B.2 REFERENCED ABOVE. AS PREVIOUSLY MENTIONED (SEE SUB-BASIN B.2), THE CISTERN WILL BE SIZED TO CAPTURE THE DEVELOPED RUNOFF GENERATED BY SUB-BASIN F.5. A 4" PVC CURB PENETRATION WILL DISCHARGE OVERFLOW FROM THE CISTERN EAST TO 20TH STREET NW.

SUB-BASIN F.6 CONSISTS OF THE PAVED SIDEWALKS, VALET DROPPOFF AND LANDSCAPED BUFFERS NORTH AND NORTHEAST OF THE NEW HOTEL BUILDING. RUNOFF WILL DRAIN ACROSS THE PAVED IMPROVEMENTS INTO THE LANDSCAPED BUFFERS. THE LANDSCAPED BUFFERS WILL CAPTURE THE FIRST FLUSH OF RUNOFF GENERATED BY SUB-BASIN F.6 TO THE MAXIMUM EXTENT PRACTICABLE. EXCESS RUNOFF THAT IS NOT CAPTURED WITHIN THE LANDSCAPED BUFFERS WILL SHEETFLOW INTO BELLAMAH AVE NW. DEVELOPED IMPROVEMENTS WILL RESULT IN A NEGLIGIBLE INCREASE IN RUNOFF GENERATED BY THE SUB-BASIN (0.1 CFS), AND A NEGLIGIBLE FIRST FLUSH VOLUME (110 CF).

SUB-BASIN F.7 CONSISTS OF THE PAVED RESTAURANT PAUL, SIDEWALKS, VALET DROPPOFF AND LANDSCAPED BUFFERS EAST OF THE NEW HOTEL BUILDING. RUNOFF WILL SHEET FLOW ACROSS THE PAVED IMPROVEMENTS, WITH LANDSCAPED BUFFERS CAPTURING RUNOFF TO THE MAXIMUM EXTENT PRACTICABLE. THE LANDSCAPED BUFFERS WILL CAPTURE FIRST FLUSH FLOWS GENERATED BY SUB-BASIN F.7 TO THE MAXIMUM EXTENT PRACTICABLE. EXCESS RUNOFF THAT IS NOT CAPTURED WITHIN THE LANDSCAPED BUFFERS SHEETFLOWS TO 20TH STREET NW. THE DEVELOPED IMPROVEMENTS WILL RESULT IN A NEGLIGIBLE INCREASE IN RUNOFF GENERATED BY THE SUB-BASIN (0.1 CFS), AND A NEGLIGIBLE FIRST FLUSH VOLUME (110 CF).

### VI. CALCULATIONS

THE CALCULATIONS CONTAINED HEREIN ANALYZE THE EXISTING AND DEVELOPED CONDITIONS FOR THE 100-YEAR, 6-HOUR RAINFALL EVENT. THE PROCEDURE FOR 40 ACRES AND SMALLER BASINS, AS SET FORTH IN THE REVISION OF SECTION 22.2, HYDROLOGY OF THE DEVELOPMENT PROCESS MANUAL, VOLUME 2, DESIGN CRITERIA, DATED JANUARY 1983, HAS BEEN USED TO QUANTIFY THE PEAK RATE OF DISCHARGE AND VOLUME OF RUNOFF GENERATED. THE CALCULATIONS FOR EACH BASIN WITHIN THE PROJECT SITE (B, E AND F) ARE SUMMARIZED AS FOLLOWS:

A. BASIN B: THE PROJECT SITE IMPROVEMENTS WILL RESULT IN A MINOR REDUCTION (1.9 CFS) IN DEVELOPED RUNOFF GENERATED BY BASIN B. THE ALLOWABLE (EXISTING) DISCHARGE RATE OF 10.4 CFS (3.7 CFS/A) IS MAINTAINED AS A RESULT OF THE PROPOSED DEVELOPMENT.

RUNOFF FROM SUB-BASIN B-1 IS SELF-CONTAINED AND THEREFORE WILL RESULT IN A DECREASE IN DISCHARGE TO THE FRONTING PUBLIC STREETS OF 1.7 CFS.

RUNOFF FROM SUB-BASIN B-2 WILL DRAIN WEST TO EAST TO A DEPRESSION, LANDSCAPED AREA THAT WILL MANAGE THE FIRST FLUSH. FIRST FLUSH CALCULATIONS DEMONSTRATE A VOLUME OF 20 CF DUE TO NEW IMPERVIOUS AREA.

A HYDROGRAPH FOR SUB-BASIN B.3 WAS USED TO CALCULATE THE DETENTION PONDING REQUIRED IN THE NEW PARKING LOT TO MAINTAIN THE ALLOWABLE (EXISTING) DISCHARGE RATE FROM SUB-BASIN B.3 OF 2.25 CFS.

THE AVERAGE END AREA METHOD WAS USED TO DEMONSTRATE ADEQUATE DETENTION PONDING CAPACITY IN THE SUB-BASIN B.3 PARKING LOT.

B. BASIN E: THE CURRENT PLANNED IMPROVEMENTS WITHIN SUB-BASIN E-1 (PORTION WITHIN PROJECT SITE) WILL RESULT IN A REDUCTION (0.1 CFS) IN DEVELOPED RUNOFF AS A RESULT OF A DECREASE IN IMPERVIOUS AREA. THE ALLOWABLE (EXISTING) DISCHARGE RATE OF 4.3 CFS/A IS MAINTAINED.

THE AVERAGE END AREA METHOD WAS USED TO DEMONSTRATE A WATER HARVESTING CAPACITY OF 125 CF.

AS THE PROPOSED IMPROVEMENTS REMOVE AND REPLACE EXISTING IMPERVIOUS PAVING WITH PERVIOUS WATER HARVESTING AREAS, WITH NO NEW IMPERVIOUS AREA, FIRST FLUSH CALCULATIONS ARE NOT REQUIRED.

C. BASIN F: THE CURRENT PLANNED IMPROVEMENTS WILL RESULT IN A NEGLIGIBLE INCREASE (0.1 CFS) IN DEVELOPED RUNOFF DISCHARGED FROM BASIN F. THE DEVELOPED DISCHARGE RATE FROM BASIN F IS 1.8 CFS/A, MEETING THE ALLOWABLE (EXISTING) DISCHARGE RATE OF 3.4 CFS/A.

THE INCREASE IN IMPERVIOUS AREA RUNOFF IN BASIN F WILL BE MITIGATED THROUGH THE RETENTION OF THE FIRST ONE-HALF INCH OF RUNOFF FROM THE NEW HOTEL BUILDING IN NEW CISTERS PROPOSED ONSITE. IN ADDITION, THE IMPROVEMENTS INTENDED TO CAPTURE THE FIRST FLUSH OF RUNOFF GENERATED TO THE MAXIMUM EXTENT PRACTICABLE. FIRST FLUSH CALCULATIONS DEMONSTRATE A FIRST FLUSH VOLUME OF 70 CF FROM SUB-BASIN F.1, 540 CF FROM SUB-BASIN F.3, 310 CF FROM SUB-BASIN F.4, 80 CF FROM SUB-BASIN F.5, 120 CF FROM SUB-BASIN F.6, AND 110 CF FROM SUB-BASIN F.7. THE COMBINED FIRST FLUSH FROM BASIN F THAT MUST BE MANAGED IS 1,230 CF.

THE AVERAGE END AREA METHOD WAS USED TO DEMONSTRATE A WATER HARVESTING CAPACITY OF 170 CF IN SUB-BASIN F.1 AND 220 CF IN SUB-BASIN F.6.

RUNOFF FROM SUB-BASIN F.2 WILL DRAIN TO THE EXISTING PRIVATE SANITARY SEWER SYSTEM AND THEREFORE WILL RESULT IN A DECREASE IN DISCHARGE TO THE FRONTING PUBLIC STREETS OF 0.3 CFS (THE EXISTING PEAK DISCHARGE RATE FOR THIS SUB-BASIN).

⅓ RUNOFF CALCULATIONS WERE USED TO DEMONSTRATE THE RUNOFF GENERATED BY THE NEW HOTEL BUILDING (800 CF FROM SUB-BASIN F.3 AND 460 CF FROM SUB-BASIN F.4) THAT MUST BE CAPTURED IN THE NEW ONSITE CISTERS.

THE COMBINED RETENTION OF RUNOFF VIA CISTERS AND WATER HARVESTING IS 1650 CF, GREATER THAN THE REQUIRED FIRST FLUSH OF 1230 CF THAT MUST BE MANAGED.

### VII. CONCLUSIONS

THE FOLLOWING CONCLUSIONS HAVE BEEN ESTABLISHED AS A RESULT OF EVALUATIONS CONTAINED HEREIN:

- BASIN B
- PROPOSED HOTEL DEVELOPMENT WILL SUBDUDE THIS BASIN INTO FOUR (4) SUB-BASINS, B.1, B.2, B.3 AND B.4.
- THE PROPOSED IMPROVEMENTS TO THE COMPOSITE BASIN WILL RESULT IN A NEGLIGIBLE DECREASE (0.1 CFS) IN DEVELOPED RUNOFF DISCHARGED FROM THE SITE. SUB-BASIN SPECIFIC IMPROVEMENTS ARE AS FOLLOWS:
  - SUB-BASIN B.1: THIS SUB-BASIN IS SELF-CONTAINED; THE RUNOFF GENERATED WILL RESULT IN AND BE MANAGED BY EXISTING AND PROPOSED LANDSCAPED IMPROVEMENTS, WITH OVERFLOW CONTAINED BY THE NEW WALL BOUNDING THE POOL AREA.
  - SUB-BASIN B.2: THE PROPOSED LANDSCAPED IMPROVEMENTS WILL RESULT IN A DECREASE IN Q100 AND V100 RUNOFF GENERATED. THE NEGLIGIBLE FIRST FLUSH OF DEVELOPED RUNOFF GENERATED (20 CF) WILL BE CAPTURED ONSITE WITHIN A DEPRESSION LANDSCAPED WATER HARVESTING AREA. OVERFLOW FROM THIS AREA WILL SHEETFLOW TO 20TH STREET NW.
  - SUB-BASIN B.3: THE PROPOSED IMPROVEMENTS WILL RESULT IN AN INCREASE IN Q100 AND V100 RUNOFF GENERATED. TO MITIGATE THIS INCREASE, THE DISCHARGE RATE FROM THIS SUB-BASIN TO THE PUBLIC STREET WILL BE RESTRAINED TO THE EXISTING Q100 RATE FOR THIS SUB-BASIN; THIS WILL BE DONE BY CONTROLLING DISCHARGE TO 20TH STREET NW VIA A CULVERT WITH 4" CURB OPENING AT THE UPSTREAM END. THE SUBSEQUENT DETENTION PONDING TO BE CAPTURED IN THE NEW PARKING LOT; CALCULATIONS DEMONSTRATE THE NEW PARKING LOT HAS CAPACITY TO CONTAIN THE DETAINED RUNOFF VOLUME FROM SUB-BASIN B.3

o SUB-BASIN B.4: THIS SUB-BASIN CONSISTS OF THE REMAINING PORTION OF BASIN B BEYOND THE PROJECT LIMITS. NO DEVELOPMENT IS PLANNED FOR THIS SUB-BASIN. AS SUCH, EXISTING RUNOFF FROM THE SUB-BASIN WILL CONTINUE TO FLOW EAST THROUGH SUB-BASIN B.3 TO ULTIMATELY DISCHARGE THROUGH THE EXISTING PARKING LOT NORTH DRIVEPAV TO 20TH STREET NW.

- THE PROPOSED DEVELOPMENT OF BASIN B WILL DISCHARGE 7.75 CFS (2.75 CFS/A) TO 20TH STREET, LESS THAN THE ALLOWABLE (EXISTING) DISCHARGE RATE OF 10.4 CFS (3.7 CFS/A) TO 20TH STREET NW ESTABLISHED IN THE 2014 DMP. THE FIRST FLUSH FROM THIS BASIN B IMPERVIOUS AREA WILL BE CONTROLLED TO THE MAXIMUM EXTENT PRACTICABLE VIA THE USE OF WATER HARVESTING AREAS AND CISTERS. PROPOSED AREAS ARE INCLUDED TO SHOW THAT THE WATER HARVESTING AREAS AND CISTERS PROPOSED ARE SUFFICIENT TO MANAGE THE FIRST FLUSH GENERATED.

- BASIN E
  - PROPOSED HOTEL DEVELOPMENT WILL SUBDUDE THIS BASIN INTO TWO (2) SUB-BASINS, E.1 AND E.2.
  - THE PROPOSED IMPROVEMENTS TO THE COMPOSITE BASIN WILL RESULT IN A NEGLIGIBLE DECREASE (0.1 CFS) IN DEVELOPED RUNOFF DISCHARGED FROM THE SITE. SUB-BASIN SPECIFIC IMPROVEMENTS ARE AS FOLLOWS:
    - SUB-BASIN E.1: THE PROPOSED IMPROVEMENTS WILL RESULT IN A DECREASE IN Q100 AND V100 RUNOFF GENERATED. DUE TO A DECREASE IN IMPERVIOUS AREA, RUNOFF FROM THIS SUB-BASIN WILL DISCHARGE DIRECTLY TO BELLAMAH AVE NW VIA RUNDOWN AND SIDEWALK CULVERT. PROPOSED WATER HARVESTING AREAS WILL INCREASE THE CAPACITY FOR MANAGEMENT AND CONTROL OF FIRST FLUSH FROM THE OVERALL SITE.
    - SUB-BASIN E.2: THIS SUB-BASIN IS BEYOND THE PROJECT LIMITS, WITH NO DEVELOPMENT CURRENTLY PLANNED IN THIS SUB-BASIN. THEREFORE, NO CHANGE IN HYDROLOGY IS PROPOSED OR ANTICIPATED.
  - THE PROPOSED DEVELOPMENT OF BASIN E WILL RESULT IN A DECREASE OF PEAK DISCHARGE RATE (2.4 CFS) TO BELLAMAH AVENUE; THEREFORE THE ALLOWABLE (EXISTING) DISCHARGE RATE OF 17.5 CFS (4.3 CFS/A) TO THE FRONTING STREETS ESTABLISHED IN THE 2014 DMP IS MAINTAINED. NO NEW IMPERVIOUS AREA IS PROPOSED IN THIS BASIN; WATER HARVESTING AREA IMPROVEMENTS WILL DECREASE THE TOTAL IMPERVIOUS AREA, THEREFORE FIRST FLUSH CALCULATIONS ARE NOT REQUIRED FOR THIS BASIN.

- BASIN F
  - PROPOSED HOTEL DEVELOPMENT WILL SUBDUDE THIS BASIN INTO SEVEN (7) SUB-BASINS, F.1, F.2, F.3, F.4, F.5, F.6 AND F.7.
  - THE PROPOSED IMPROVEMENTS TO THE COMPOSITE BASIN WILL RESULT IN A NEGLIGIBLE INCREASE (0.1 CFS) IN DEVELOPED RUNOFF DISCHARGED FROM THE SITE. SUB-BASIN SPECIFIC IMPROVEMENTS ARE AS FOLLOWS:
    - SUB-BASIN E.1: THE PROPOSED IMPROVEMENTS WILL RESULT IN A DECREASE IN Q100 AND V100 RUNOFF GENERATED. DUE TO A DECREASE IN IMPERVIOUS AREA, RUNOFF FROM THIS SUB-BASIN WILL DISCHARGE DIRECTLY TO BELLAMAH AVE NW VIA RUNDOWN AND SIDEWALK CULVERT. PROPOSED WATER HARVESTING AREAS WILL INCREASE THE CAPACITY FOR MANAGEMENT AND CONTROL OF FIRST FLUSH FROM THE OVERALL SITE.
    - SUB-BASIN F.2: THIS SUB-BASIN WILL INCREASE THE CAPACITY FOR MANAGEMENT AND CONTROL OF FIRST FLUSH FROM THE OVERALL SITE.
    - SUB-BASIN F.3: THE PROPOSED IMPROVEMENTS TO THIS SUB-BASIN (WEST PORTION OF THE NEW HOTEL BUILDING) WILL RESULT IN AN INCREASE IN Q100 AND V100 RUNOFF GENERATED. TO MITIGATE THIS INCREASE, ROOF RUNOFF WILL BE ROUTED THROUGH A NEW CISTERN DESIGNED TO CAPTURE THE FIRST ⅓ OF DEVELOPED RUNOFF; OVERFLOW FROM THE CISTERN WILL DISCHARGE VIA 4" PVC CURB PENETRATION TO BELLAMAH AVE NW. THIS CISTERN WILL SERVE TO MANAGE AND CONTROL THE FIRST FLUSH OF RUNOFF FROM THIS SUB-BASIN.
    - SUB-BASIN F.4: THE PROPOSED IMPROVEMENTS TO THIS SUB-BASIN (EAST PORTION OF THE NEW HOTEL BUILDING) WILL RESULT IN AN INCREASE IN Q100 AND V100 RUNOFF GENERATED. TO MITIGATE THIS INCREASE, ROOF RUNOFF WILL BE ROUTED THROUGH A NEW CISTERN DESIGNED TO CAPTURE THE FIRST ⅓ OF DEVELOPED RUNOFF; OVERFLOW FROM THE CISTERN WILL DISCHARGE VIA 4" PVC CURB PENETRATION TO 20TH STREET NW. THIS CISTERN WILL SERVE TO MANAGE AND CONTROL THE FIRST FLUSH OF RUNOFF FROM THIS SUB-BASIN.
    - SUB-BASIN F.5: THE PROPOSED COURTYARD IMPROVEMENTS WILL RESULT IN A DECREASE IN Q100 AND V100 RUNOFF GENERATED. DUE TO IMPROVED LAND TREATMENT, RUNOFF FROM THE SUB-BASIN WILL BE ROUTED VIA TRENCH DRAIN AND PRIVATE STORM DRAIN TO A CISTERN DESIGNED TO CAPTURE THE RUNOFF GENERATED FROM SUB-BASIN F.5, OVERFLOW FROM THE CISTERN WILL DISCHARGE VIA 4" PVC CURB PENETRATION TO 20TH STREET NW.
    - SUB-BASIN F.6: THE PROPOSED IMPROVEMENTS WILL RESULT IN A NEGLIGIBLE INCREASE IN Q100 AND V100 RUNOFF GENERATED (0.1 CFS) DUE TO INCREASED IMPERVIOUS AREA. THIS INCREASE WILL BE MITIGATED BY LANDSCAPED BUFFERS DESIGNED TO MANAGE THE FIRST FLUSH OF RUNOFF TO THE MAXIMUM EXTENT PRACTICABLE. EXCESS RUNOFF WILL SHEETFLOW TO THE FRONTING STREET OF 20TH STREET NW.
    - SUB-BASIN F.7: THE PROPOSED IMPROVEMENTS WILL RESULT IN A NEGLIGIBLE INCREASE IN Q100 AND V100 RUNOFF GENERATED (0.1 CFS) DUE TO INCREASED IMPERVIOUS AREA. THIS INCREASE WILL BE MITIGATED BY LANDSCAPED BUFFERS DESIGNED TO MANAGE THE FIRST FLUSH OF RUNOFF TO THE MAXIMUM EXTENT PRACTICABLE. EXCESS RUNOFF WILL SHEETFLOW TO THE FRONTING STREET OF 20TH STREET NW.

- THE PROPOSED DEVELOPMENT OF BASIN F WILL RESULT IN AN INCREASE IN PEAK DISCHARGE RATE AND VOLUME GENERATED. HOWEVER, THIS INCREASE WILL BE MITIGATED BY ROUTING THE RUNOFF THROUGH CISTERS AND WATER HARVESTING AREAS, THEREBY MAINTAINING THE ALLOWABLE (EXISTING) DISCHARGE RATE OF 3.4 CFS/A TO THE FRONTING PUBLIC STREETS. CALCULATIONS ARE INCLUDED TO SHOW THAT THE WATER HARVESTING AREAS AND CISTERS WITHIN THE OVERALL SITE ARE SUFFICIENT TO MANAGE THE FIRST FLUSH GENERATED BY THIS BASIN.

## CALCULATIONS

### I. SITE CHARACTERISTICS

- PRECIPITATION ZONE = 2.35
- $P_{TOTAL} = P_{WET} + P_{DRY}$  = 533.170 SFT
- PAVE AREA (A) = 12.24 AC

### II. LAND TREATMENTS

#### 1. EXISTING LAND TREATMENT

	TREATMENT				
	A	B	C	D	TOTAL
BASIN	AREA (AC)	% AREA (AC)	% AREA (AC)	% AREA (AC)	% AREA (AC)
B	0.08	13.25	4.62	0.00	17.87
B-1	0.0	0.00	0.08	0.19	0.27
B-2	0.0	0.00	0.00	0.00	0.00
B-3	0.0	0.00	0.00	0.00	0.00
B-4	0.0	0.00	0.00	0.00	0.00
E	0.06	17.7	0.0	0.00	17.7
E-1	0.0	0.00	0.04	7.0	0.04
E-2	0.0	0.00	0.06	17.7	0.06
F	2.21	0.0	0.0	0.0	2.21
F-1	0.0	0.00	0.00	0.00	0.00
F-2	0.0	0.00	0.00	0.00	0.00
F-3	0.0	0.00	0.00	0.00	0.00
F-4	0.0	0.00	0.00	0.00	0.00
F-5	0.0	0.00	0.00	0.00	0.00
F-6	0.0	0.00	0.00	0.00	0.00
F-7	0.0	0.00	0.00	0.00	0.00

\* USE PROPOSED SUB-BASIN LIMITS FOR COMPARISON TO DEVELOPED CONDITION

### 2. DEVELOPED LAND TREATMENT

	TREATMENT				
	A	B	C	D	TOTAL
BASIN	AREA (AC)	% AREA (AC)	% AREA (AC)	% AREA (AC)	% AREA (AC)
B	0.08	13.25	4.62	0.00	17.87
B-1	0.0	0.00	0.08	0.19	0.27
B-2	0.0	0.00	0.00	0.00	0.00
B-3	0.0	0.00	0.00	0.00	0.00
B-4	0.0	0.00	0.00	0.00	0.00
E	0.06	17.7	0.0	0.00	17.7
E-1	0.0	0.00	0.07	12.0	0.04
E-2	0.0	0.00	0.06	17.7	0.06
F	2.21	0.0	0.0	0.0	2.21
F-1	0.0	0.00	0.08	0.0	0.00
F-2	0.0	0.00	0.00	0.00	0.00
F-3	0.0	0.00	0.00	0.00	0.00
F-4	0.0	0.00	0.00	0.00	0.00
F-5	0.0	0.00	0.00	0.00	0.00
F-6	0.0	0.00	0.00	0.00	0.00
F-7	0.0	0.00	0.00	0.00	0.00

### 3. REMAINDER OF BASIN LOCATED OUTSIDE PROJECT AREA

### II. HYDROLOGY

#### A. EXISTING CONDITION

- BASIN B
  - SUB-BASIN B.1 (PROPOSED SUB-BASIN LIMITS USED FOR COMPARISON PURPOSES)
    - VOLUME
      - $E_{100} = (E_{A1} + E_{A2} + E_{A3} + E_{A4} + E_{A5})/A_1$
      - $E_{100} = (0.537000) + (0.787008) + (1.137013) + (2.$





# City of Albuquerque

Planning Department

Development & Building Services Division

## DRAINAGE AND TRANSPORTATION INFORMATION SHEET (REV 09/2015)

**Project Title:** \_\_\_\_\_ **Building Permit #:** \_\_\_\_\_ **City Drainage #:** \_\_\_\_\_

**DRB#:** \_\_\_\_\_ **EPC#:** \_\_\_\_\_ **Work Order#:** \_\_\_\_\_

**Legal Description:** \_\_\_\_\_

**City Address:** \_\_\_\_\_

**Engineering Firm:** \_\_\_\_\_ **Contact:** \_\_\_\_\_

**Address:** \_\_\_\_\_

**Phone#:** \_\_\_\_\_ **Fax#:** \_\_\_\_\_ **E-mail:** \_\_\_\_\_

**Owner:** \_\_\_\_\_ **Contact:** \_\_\_\_\_

**Address:** \_\_\_\_\_

**Phone#:** \_\_\_\_\_ **Fax#:** \_\_\_\_\_ **E-mail:** \_\_\_\_\_

**Architect:** \_\_\_\_\_ **Contact:** \_\_\_\_\_

**Address:** \_\_\_\_\_

**Phone#:** \_\_\_\_\_ **Fax#:** \_\_\_\_\_ **E-mail:** \_\_\_\_\_

**Other Contact:** \_\_\_\_\_ **Contact:** \_\_\_\_\_

**Address:** \_\_\_\_\_

**Phone#:** \_\_\_\_\_ **Fax#:** \_\_\_\_\_ **E-mail:** \_\_\_\_\_

Check all that Apply:

**DEPARTMENT:**

- ☐ HYDROLOGY/ DRAINAGE  
☐ TRAFFIC/ TRANSPORTATION  
☐ MS4/ EROSION & SEDIMENT CONTROL

**TYPE OF SUBMITTAL:**

- ☐ ENGINEER/ ARCHITECT CERTIFICATION
- ☐ CONCEPTUAL G & D PLAN  
☐ GRADING PLAN  
☐ DRAINAGE MASTER PLAN  
☐ DRAINAGE REPORT  
☐ CLOMR/LOMR
- ☐ TRAFFIC CIRCULATION LAYOUT (TCL)  
☐ TRAFFIC IMPACT STUDY (TIS)  
☐ EROSION & SEDIMENT CONTROL PLAN (ESC)
- ☐ OTHER (SPECIFY) \_\_\_\_\_

**CHECK TYPE OF APPROVAL/ACCEPTANCE SOUGHT:**

- ☐ BUILDING PERMIT APPROVAL  
☐ CERTIFICATE OF OCCUPANCY (PERMANENT)
- ☐ PRELIMINARY PLAT APPROVAL  
☐ SITE PLAN FOR SUB'D APPROVAL  
☐ SITE PLAN FOR BLDG. PERMIT APPROVAL  
☐ FINAL PLAT APPROVAL  
☐ SIA/ RELEASE OF FINANCIAL GUARANTEE  
☐ FOUNDATION PERMIT APPROVAL  
☐ GRADING PERMIT APPROVAL  
☐ SO-19 APPROVAL  
☐ PAVING PERMIT APPROVAL  
☐ GRADING/ PAD CERTIFICATION  
☐ WORK ORDER APPROVAL  
☐ CLOMR/LOMR
- ☐ PRE-DESIGN MEETING  
☐ OTHER (SPECIFY) \_\_\_\_\_

IS THIS A RESUBMITTAL?: ☐ Yes ☐ No

**DATE SUBMITTED:** \_\_\_\_\_ **By:** \_\_\_\_\_

COA STAFF: \_\_\_\_\_ ELECTRONIC SUBMITTAL RECEIVED: \_\_\_\_\_