

APPENDIX 2.8 –

MANHOLE STORM DRAIN AS-BUILTS

FOR:

Edith Blvd. and Lomas Blvd.

Manhole # 5 Location Fract + Edith

Date 6-7-10

Notes N.W. Intersection

COA MH # 29178

SWMM50-441'

COA 26630-194'

INV 4961.05

0.25 concrete in pipe

N ↑

945
30 RCP

389
36 RCP

COA 29178
RIM 4966.23
MH INV 4956.78

489
36 RCP

1 of 2

36
RCP

Depth



36
RCP

118

Sediment

Manhole # 12400 Location Comas + Edith Date 5-17-11
Notes West Bound Center Lane


COA MH # 7870

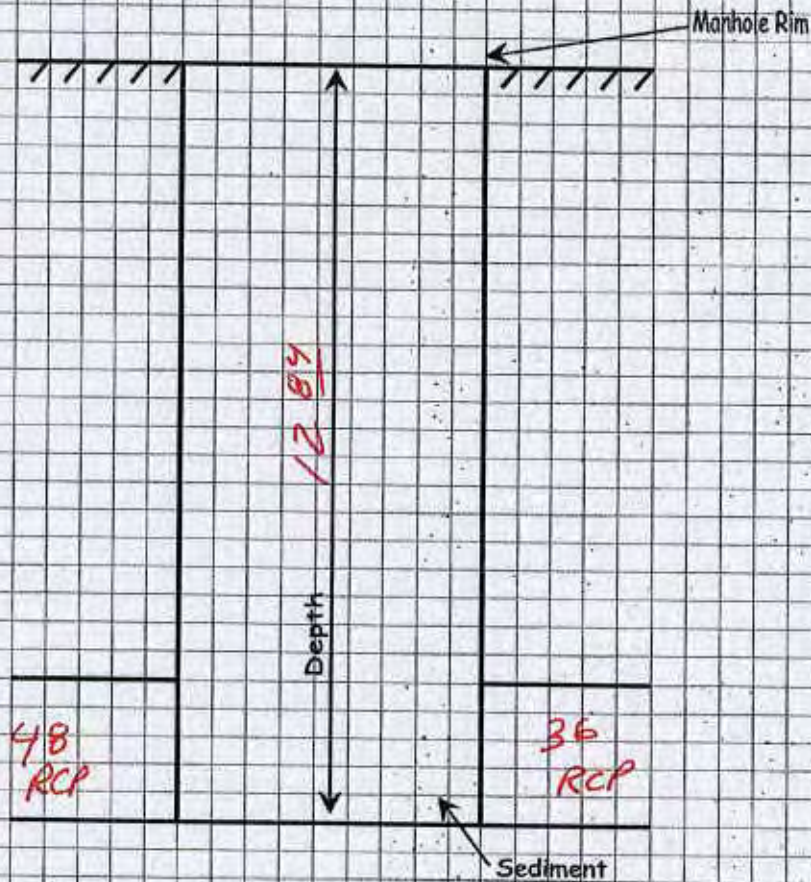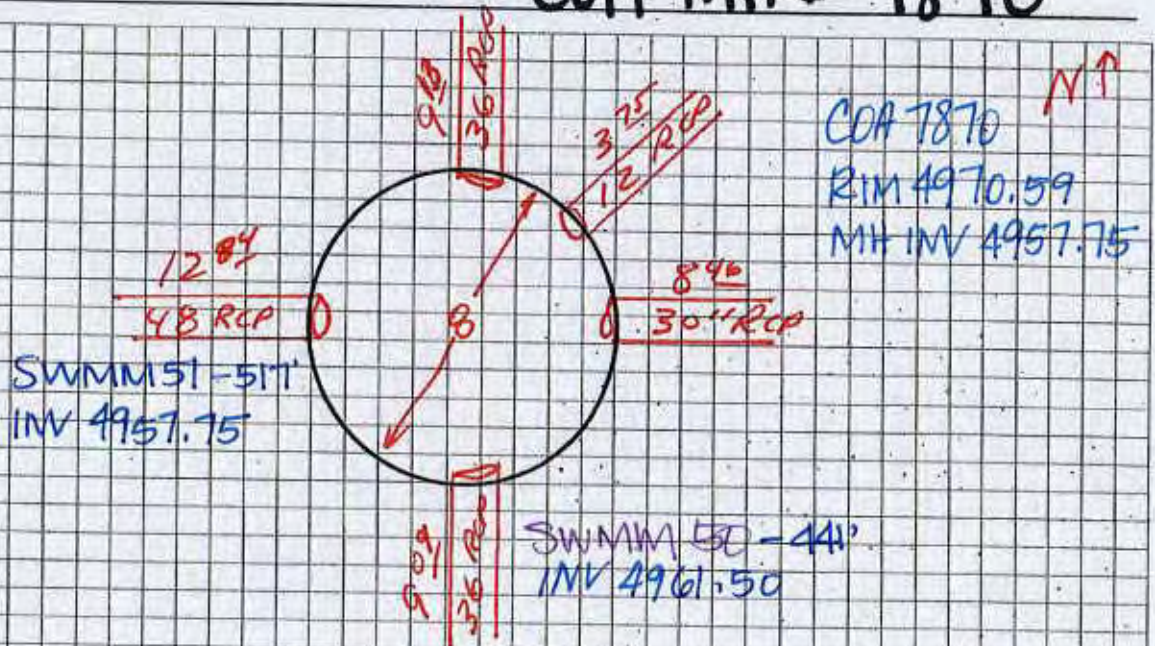

1 of 2

120


7870

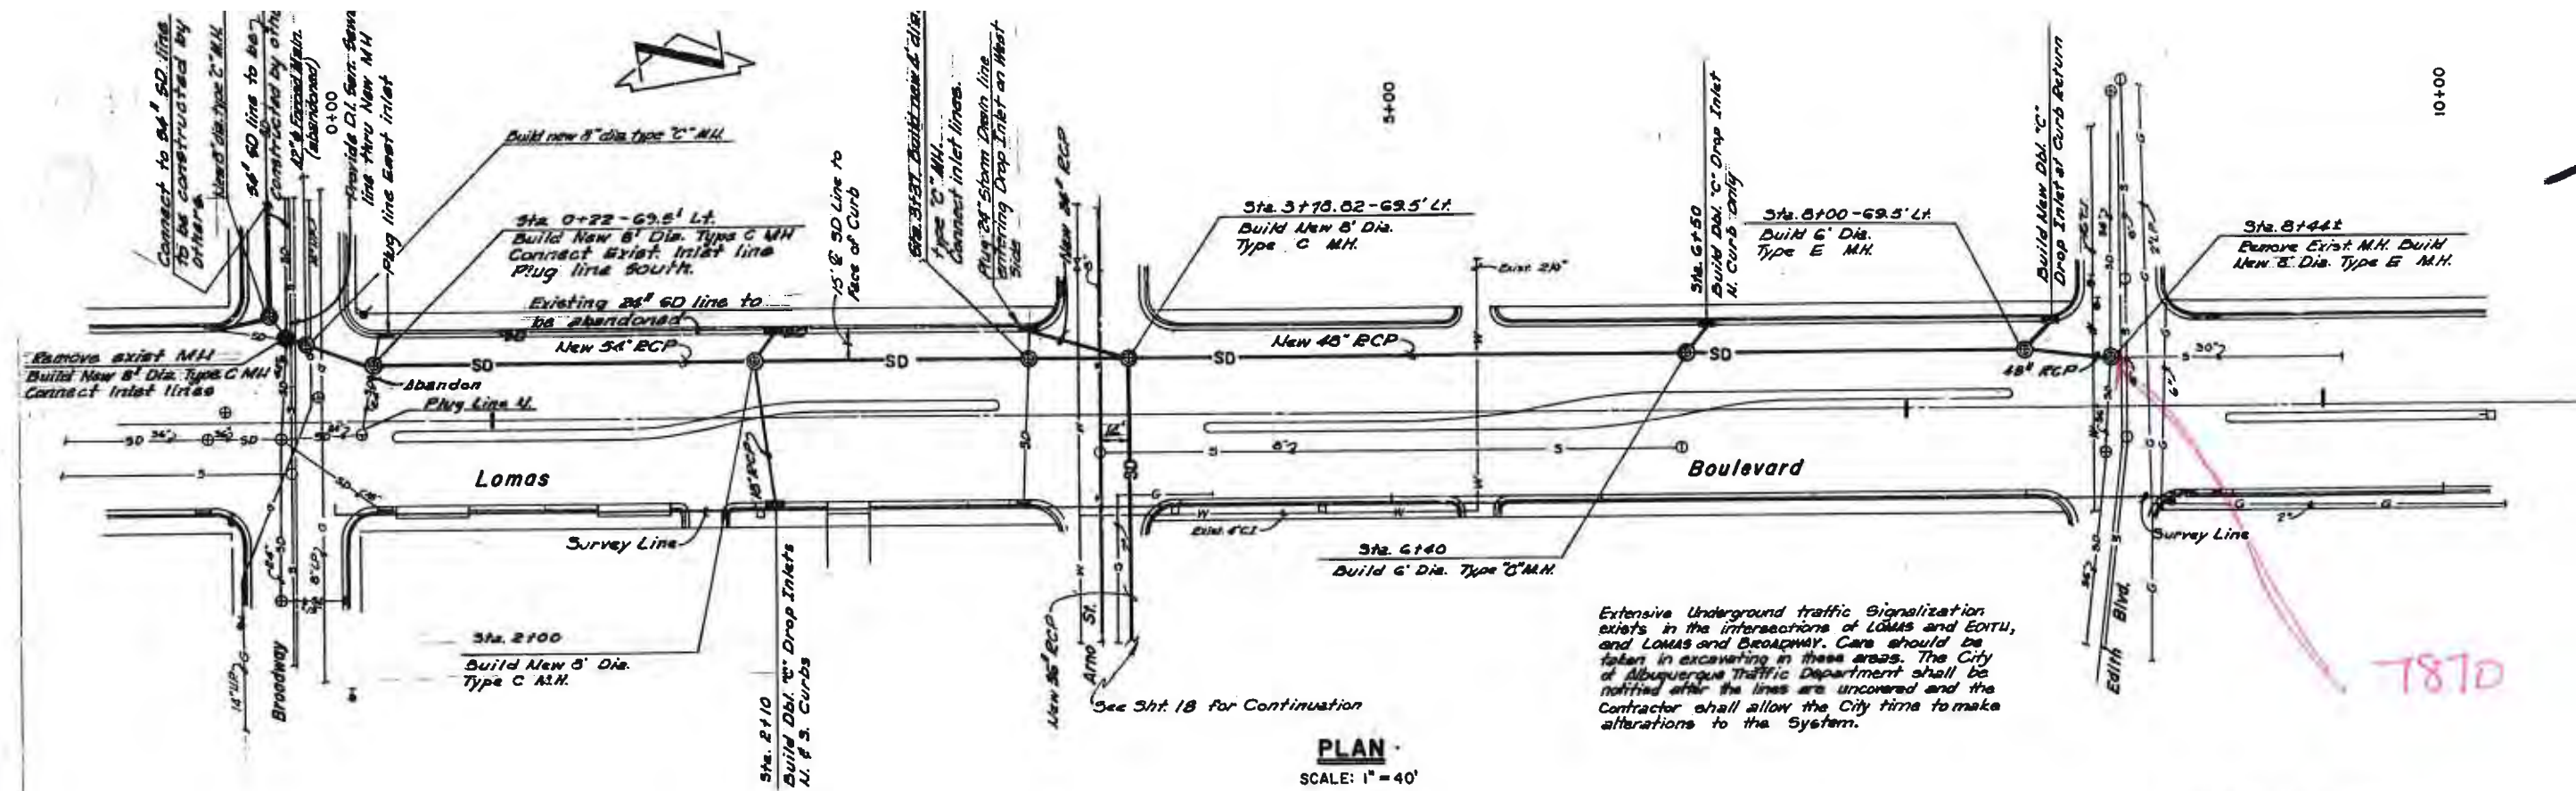

PLAN
SCALE: 1" = 40'

10 000 2474

AS BUILT

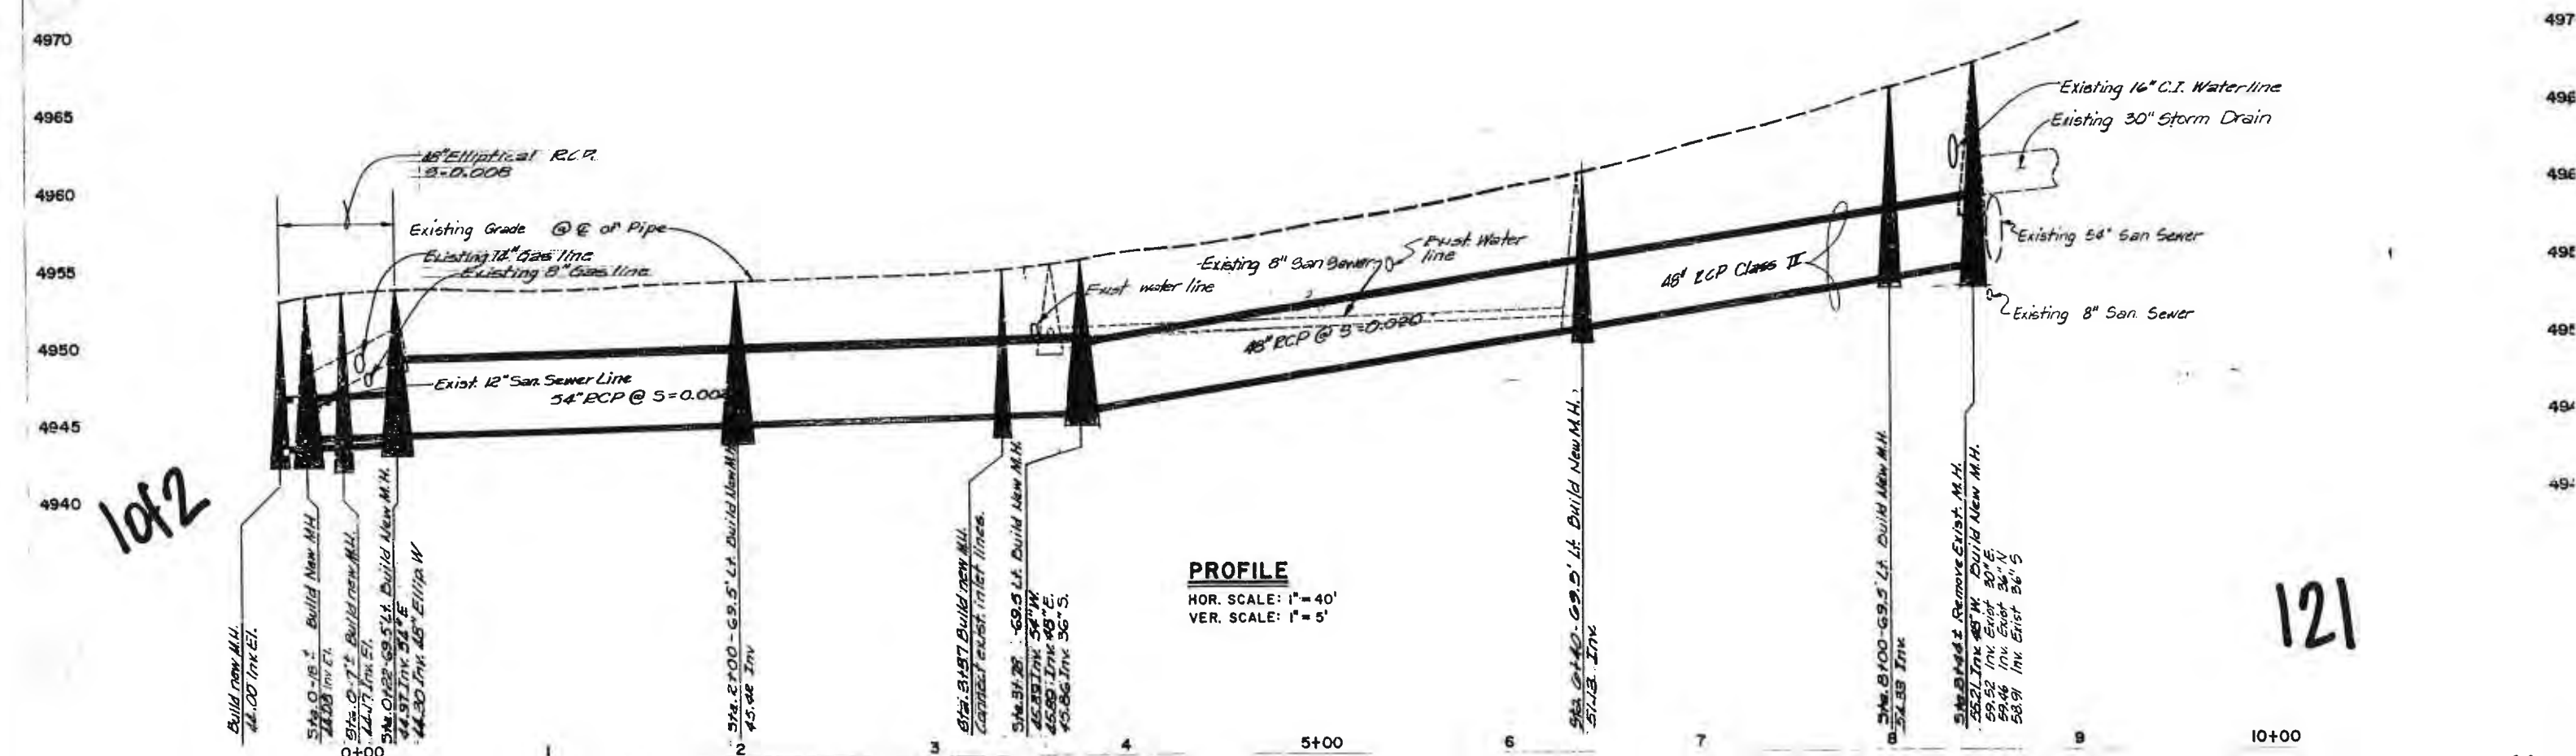

PROFILE
HOR. SCALE: 1" = 40'
VER. SCALE: 1" = 5'

121


Manhole # 12401

Location ARNO + COMAS

Date 5-17-11

Notes N.E. Intersection

COA MH # 7861

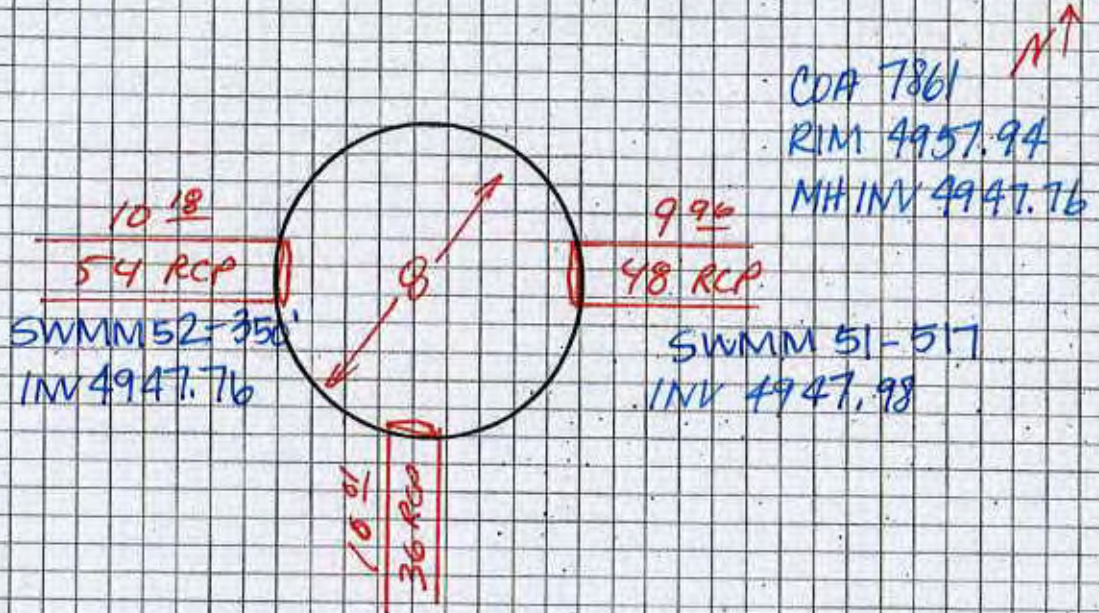


1 of 2



122

7861

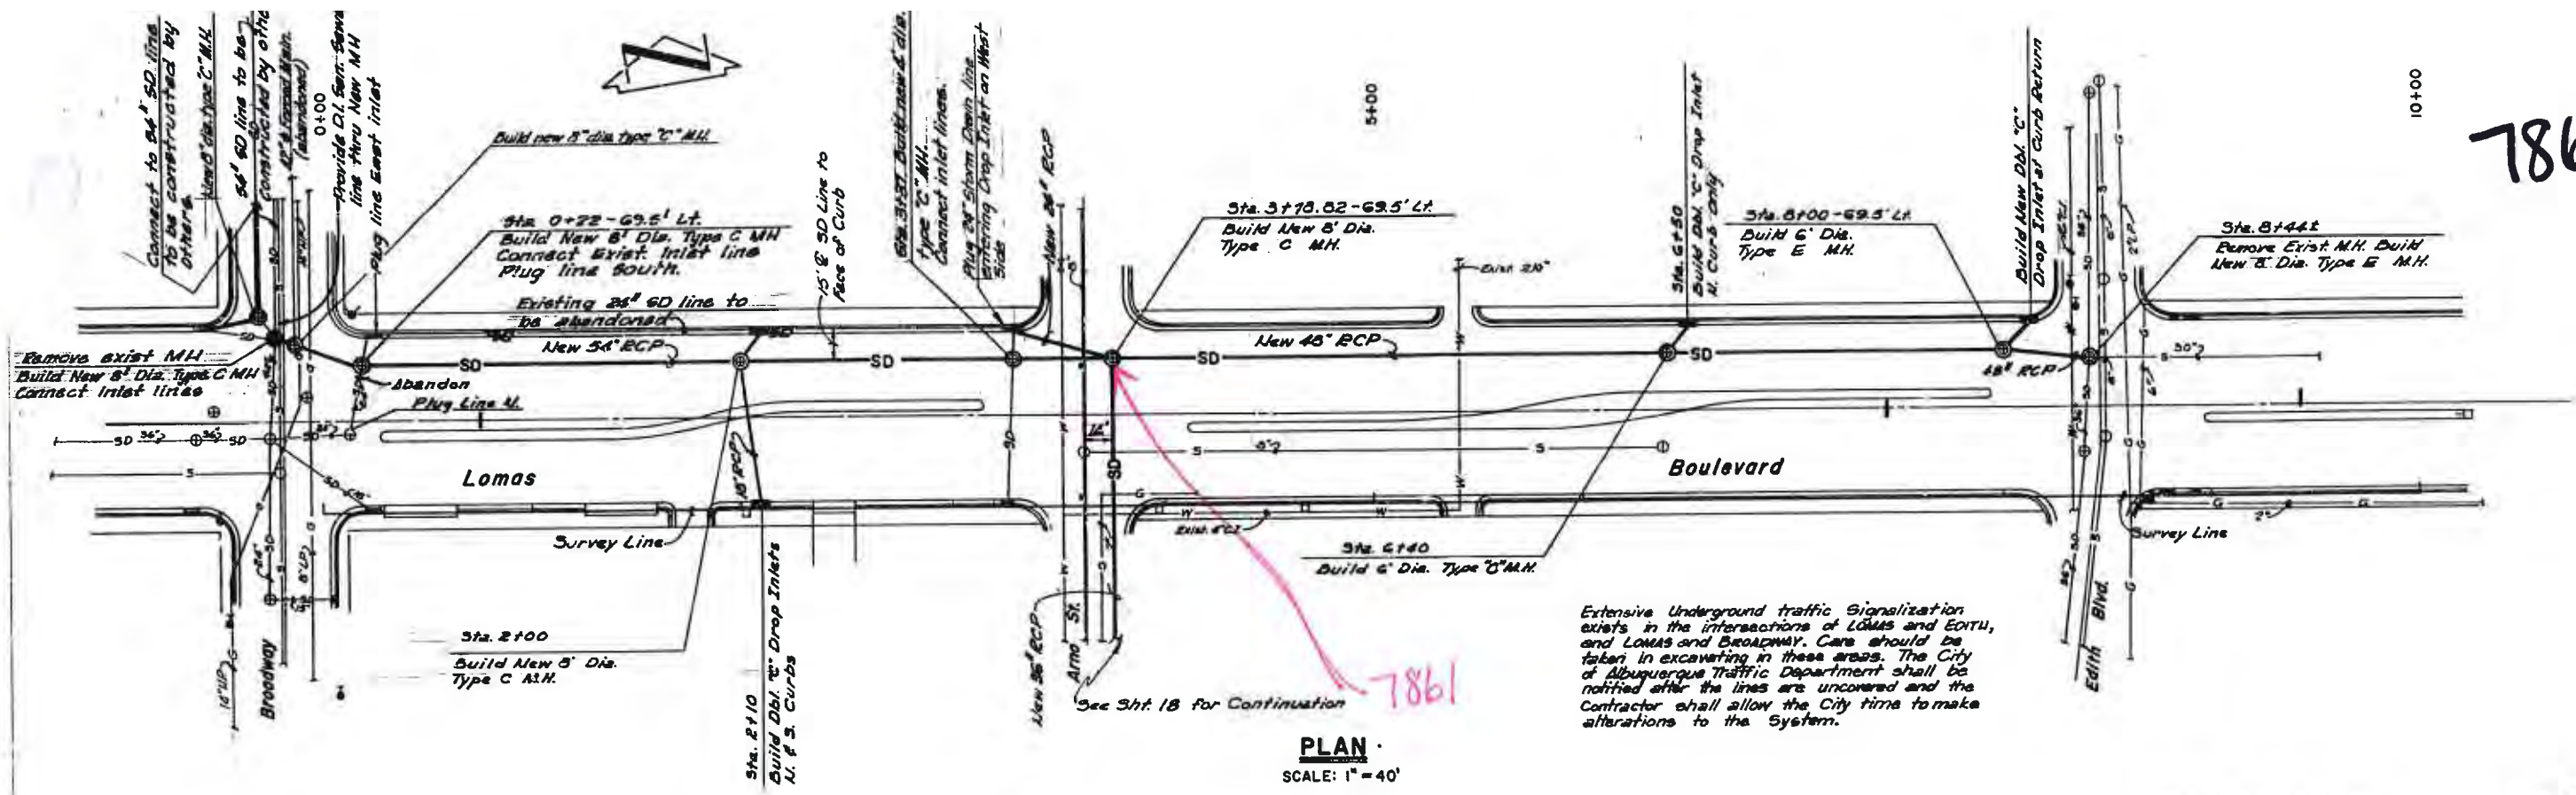


PLAN
SCALE: 1" = 40'

Extensive Underground traffic Signalization exists in the intersections of LOMAS and EDITH, and LOMAS and BROADWAY. Care should be taken in excavating in these areas. The City of Albuquerque Traffic Department shall be notified after the lines are uncovered and the Contractor shall allow the City time to make alterations to the System.

10.002 2474

AS BUILT

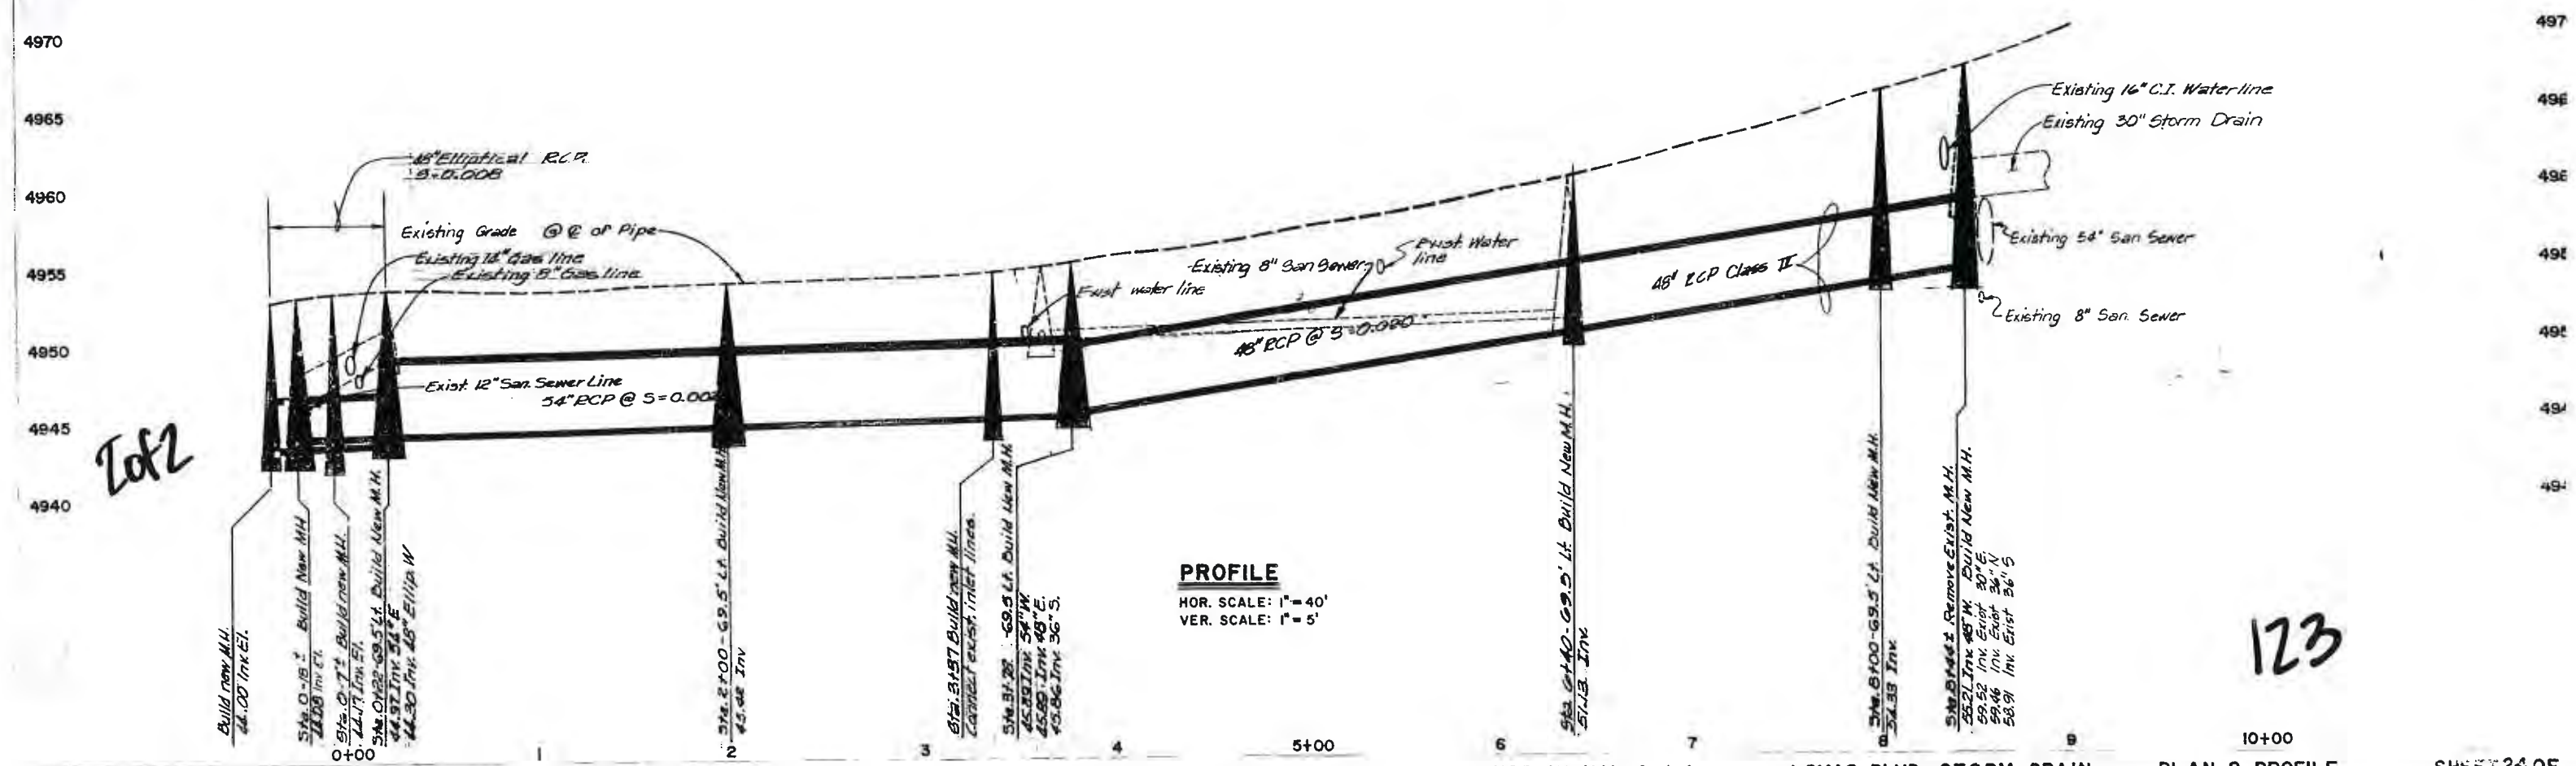

PROFILE
HOR. SCALE: 1" = 40'
VER. SCALE: 1" = 5'

123

Manhole #

2

Location

LOMAS

&

BROADWAY

Notes Northwest Intersection SB Lane.

COA MH #32878

COA 32878
RIM 4955.76
MH INV 4946.60

SWMM 132-60

COA 31423-40

INV 4946.60

N

SWMM 52-350

COA 19440-23

INV 4946.80

SWMM 53

COA 19443

INV 4947.35

3.88
18" RCP

8.96
52" RCP

2.68
slope

Depth 9.10

52" RCP East


54" RCP North

124

Sediment 3" silt

72" not
plugged all the
way & from
top is open
concrete well
8.41

1 of 2

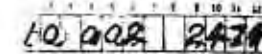

AS BUILT



Manhole # 12 Location Commas + John ST.


Date 4-20-10

Notes North Center Inter Section

COA MH #7848

COA 7848
RIM 4956.38
MH INV 4947.67

N ↑

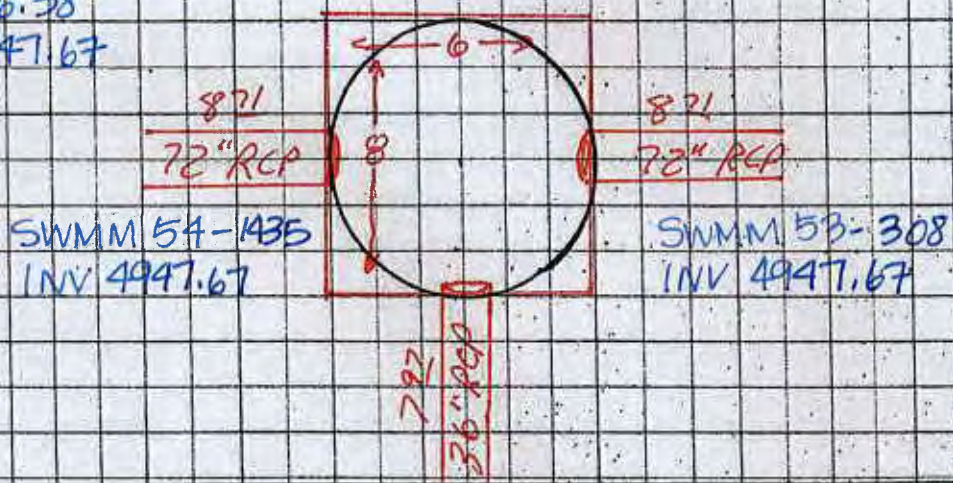

Fiber

W-5

8'

Depth

72" RCP

72" RCP

126

Sediment


1 of 2

PROJECT: LOMAS BLVD. STORM DRAIN - PHASE II PLAN B. PROFILE - STA 30+00 TO STA 35+00		DATE: 10/15/03 DRAWN BY: [Signature] CHECKED BY: [Signature] DESIGNED BY: [Signature]
SHEET NO. 127 TOTAL SHEETS: 127	PROJECT NO. 7848 DRAWING NO. 127	SCALE: 1" = 20' HORIZ. 1" = 2' VERT.

7848

Handwritten notes and signatures in the top right corner.

7848

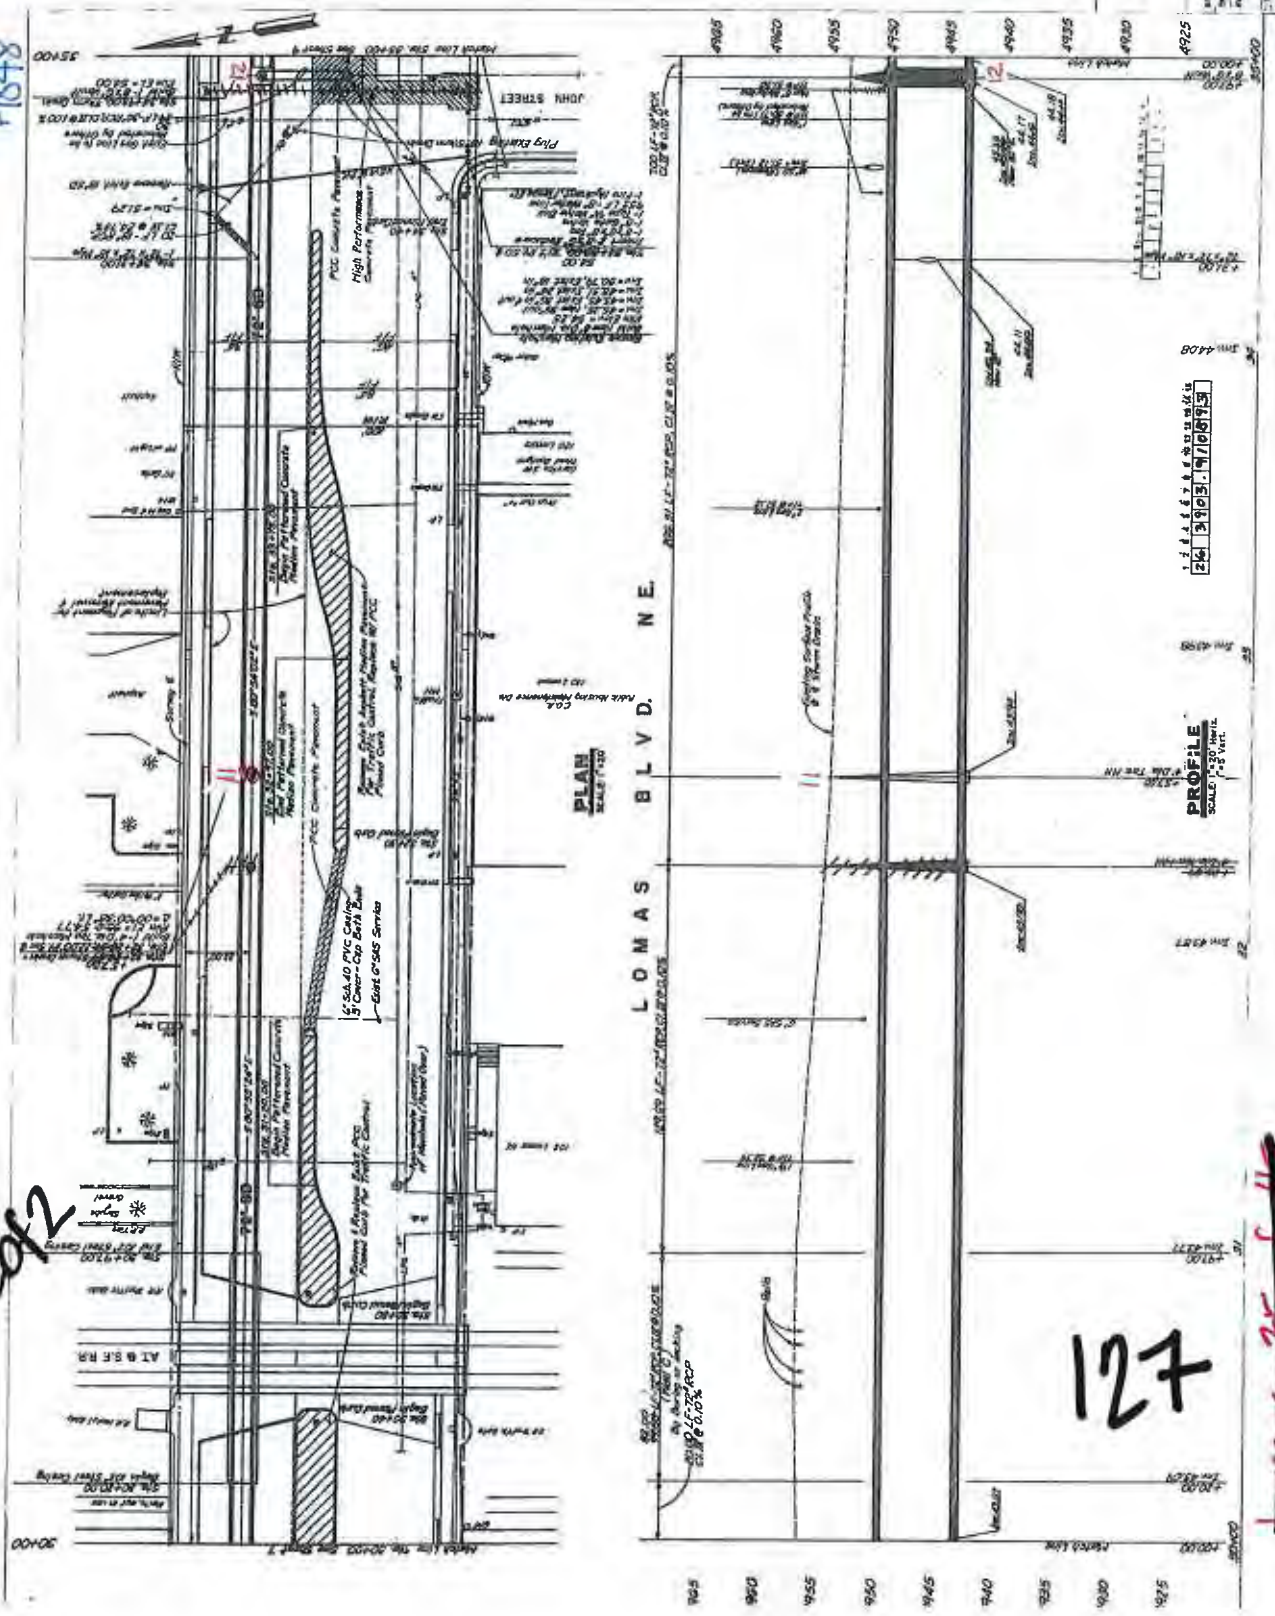

2012

127

Lomas 35 of 41

Manhole # 8 Location Commas + 3RD Date 4-20-10

Notes N.E. Inter Section

COA MH #7830

