

CITY OF ALBUQUERQUE



Richard J. Berry, Mayor

November 6, 2017

David Soule, P.E.
Rio Grande Engineering
P.O. Box 93924
Albuquerque, NM, 87199

**RE: Casas Devine
2312 Mountain Road NW & 2308 Mountain Road NW
Request for Permanent C.O. – Accepted for the following:
Building Permits – 2017-2306245 & 2017-06252
Engineer's Certification Dated 10/30/17
Hydrology File: J13D204**

PO Box 1293

Dear Mr. Soule:

Albuquerque

Based on the Certification received 10/31/17 and site visit on 11/02/17, the site is acceptable for a Permanent Certificate of Occupancy by Hydrology for 2312 Mountain Road NW & 2308 Mountain Road NW.

NM 87103

If you have any questions, please contact me at 924-3995 or rbrissette@cabq.gov.

www.cabq.gov

Sincerely,

Renée C. Brissette

Renée C. Brissette, P.E. CFM
Senior Engineer, Hydrology
Planning Department



City of Albuquerque

Planning Department

Development & Building Services Division

DRAINAGE AND TRANSPORTATION INFORMATION SHEET (REV 09/2015)

Project Title: _____ **Building Permit #:** _____ **City Drainage #:** _____

DRB#: _____ **EPC#:** _____ **Work Order#:** _____

Legal Description: _____

City Address: _____

Engineering Firm: _____ **Contact:** _____

Address: _____

Phone#: _____ **Fax#:** _____ **E-mail:** _____

Owner: _____ **Contact:** _____

Address: _____

Phone#: _____ **Fax#:** _____ **E-mail:** _____

Architect: _____ **Contact:** _____

Address: _____

Phone#: _____ **Fax#:** _____ **E-mail:** _____

Other Contact: _____ **Contact:** _____

Address: _____

Phone#: _____ **Fax#:** _____ **E-mail:** _____

Check all that Apply:

DEPARTMENT:

- ☐ HYDROLOGY/ DRAINAGE
☐ TRAFFIC/ TRANSPORTATION
☐ MS4/ EROSION & SEDIMENT CONTROL

TYPE OF SUBMITTAL:

- ☐ ENGINEER/ ARCHITECT CERTIFICATION
- ☐ CONCEPTUAL G & D PLAN
☐ GRADING PLAN
☐ DRAINAGE MASTER PLAN
☐ DRAINAGE REPORT
☐ CLOMR/LOMR
- ☐ TRAFFIC CIRCULATION LAYOUT (TCL)
☐ TRAFFIC IMPACT STUDY (TIS)
☐ EROSION & SEDIMENT CONTROL PLAN (ESC)
- ☐ OTHER (SPECIFY) _____

CHECK TYPE OF APPROVAL/ACCEPTANCE SOUGHT:

- ☐ BUILDING PERMIT APPROVAL
☐ CERTIFICATE OF OCCUPANCY
- ☐ PRELIMINARY PLAT APPROVAL
☐ SITE PLAN FOR SUB'D APPROVAL
☐ SITE PLAN FOR BLDG. PERMIT APPROVAL
☐ FINAL PLAT APPROVAL
☐ SIA/ RELEASE OF FINANCIAL GUARANTEE
☐ FOUNDATION PERMIT APPROVAL
☐ GRADING PERMIT APPROVAL
☐ SO-19 APPROVAL
☐ PAVING PERMIT APPROVAL
☐ GRADING/ PAD CERTIFICATION
☐ WORK ORDER APPROVAL
☐ CLOMR/LOMR
- ☐ PRE-DESIGN MEETING
☐ OTHER (SPECIFY) _____

IS THIS A RESUBMITTAL?: ☐ Yes ☐ No

DATE SUBMITTED: _____ **By:** _____

COA STAFF: _____ ELECTRONIC SUBMITTAL RECEIVED: _____

STANDARD GRADING NOTE: THE MAXIMUM GRADED SIDE SLOPE SHALL NOT EXCEED 3 FEET (HORIZONTALLY) TO 1 FOOT (VERTICALLY). AREAS DISTURBED BY GRADING WHICH WILL NOT BE TREATED WITH LANDSCAPING SHALL BE SEEDDED.

I David Soule, NMPE 14522, of the firm Rio Grande Engineering, hereby certify that this project has been graded and will drain in substantial compliance with and in accordance with the design intend of the approved plan dated 1/9/17 The record information edited on the original design document has performed by me or under my direct supervision and is true and correct to the best of my knowledge and belief. The as-built survey was provided Chris Dehler NMPLS#7923. The certification is submitted in support of a request for PERMANENT CERTIFICATE OF OCCUPANCY. The record information presented heron is not necessarily complete and intended only to verify substantial compliance of the grading and drainage aspects of this project. Those relying on this record document are advised to obtain independent verification of its accuracy before using it for any other purpose.



Exceptions:

Lots 1, 2 only



10/30/17

FIRST FLUSH PONDS:
VOL > 37 CF **required volume provided**
ALL STORM WATER RUNOFF FROM DRIVEWAYS AND ROOF AREAS SHALL PASS THROUGH FIRST FLUSH PONDS BEFORE OVERFLOW
TOP OF POND ELEV = 4959.0 60.2
BOTTOM OF POND ELEV = 4958.5 59.4

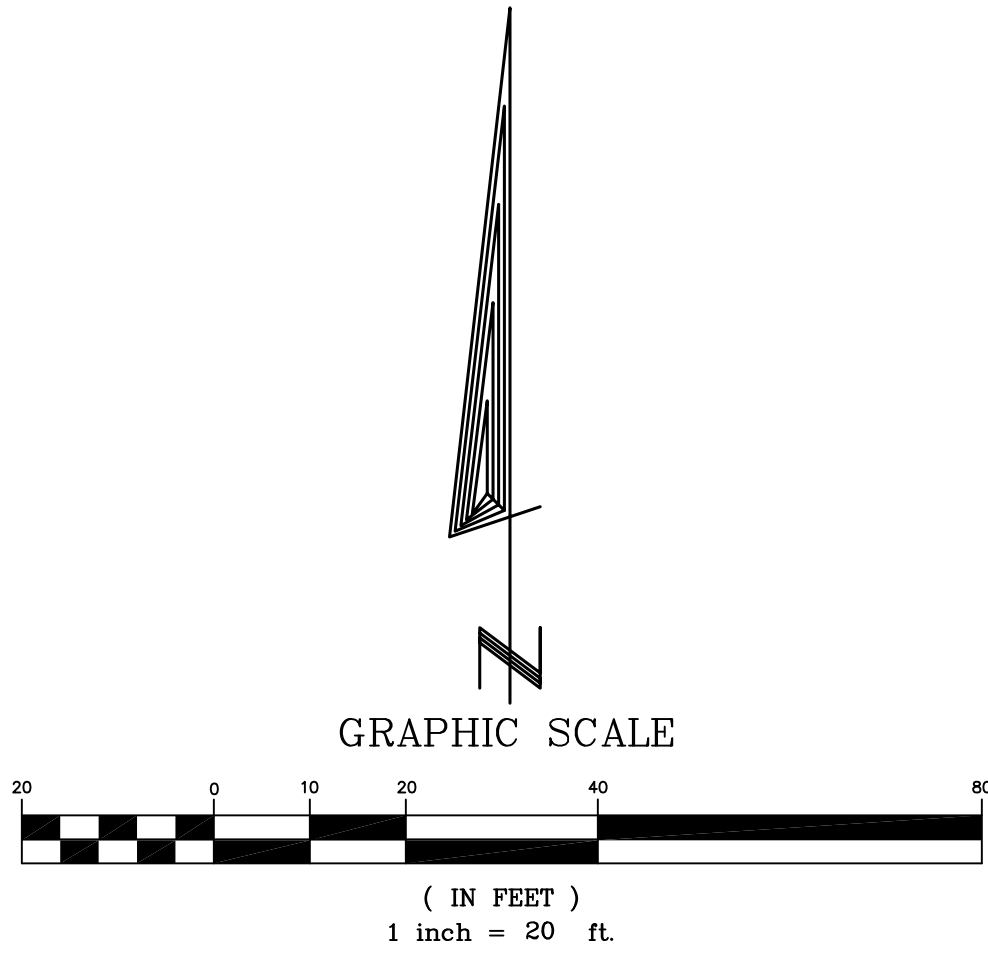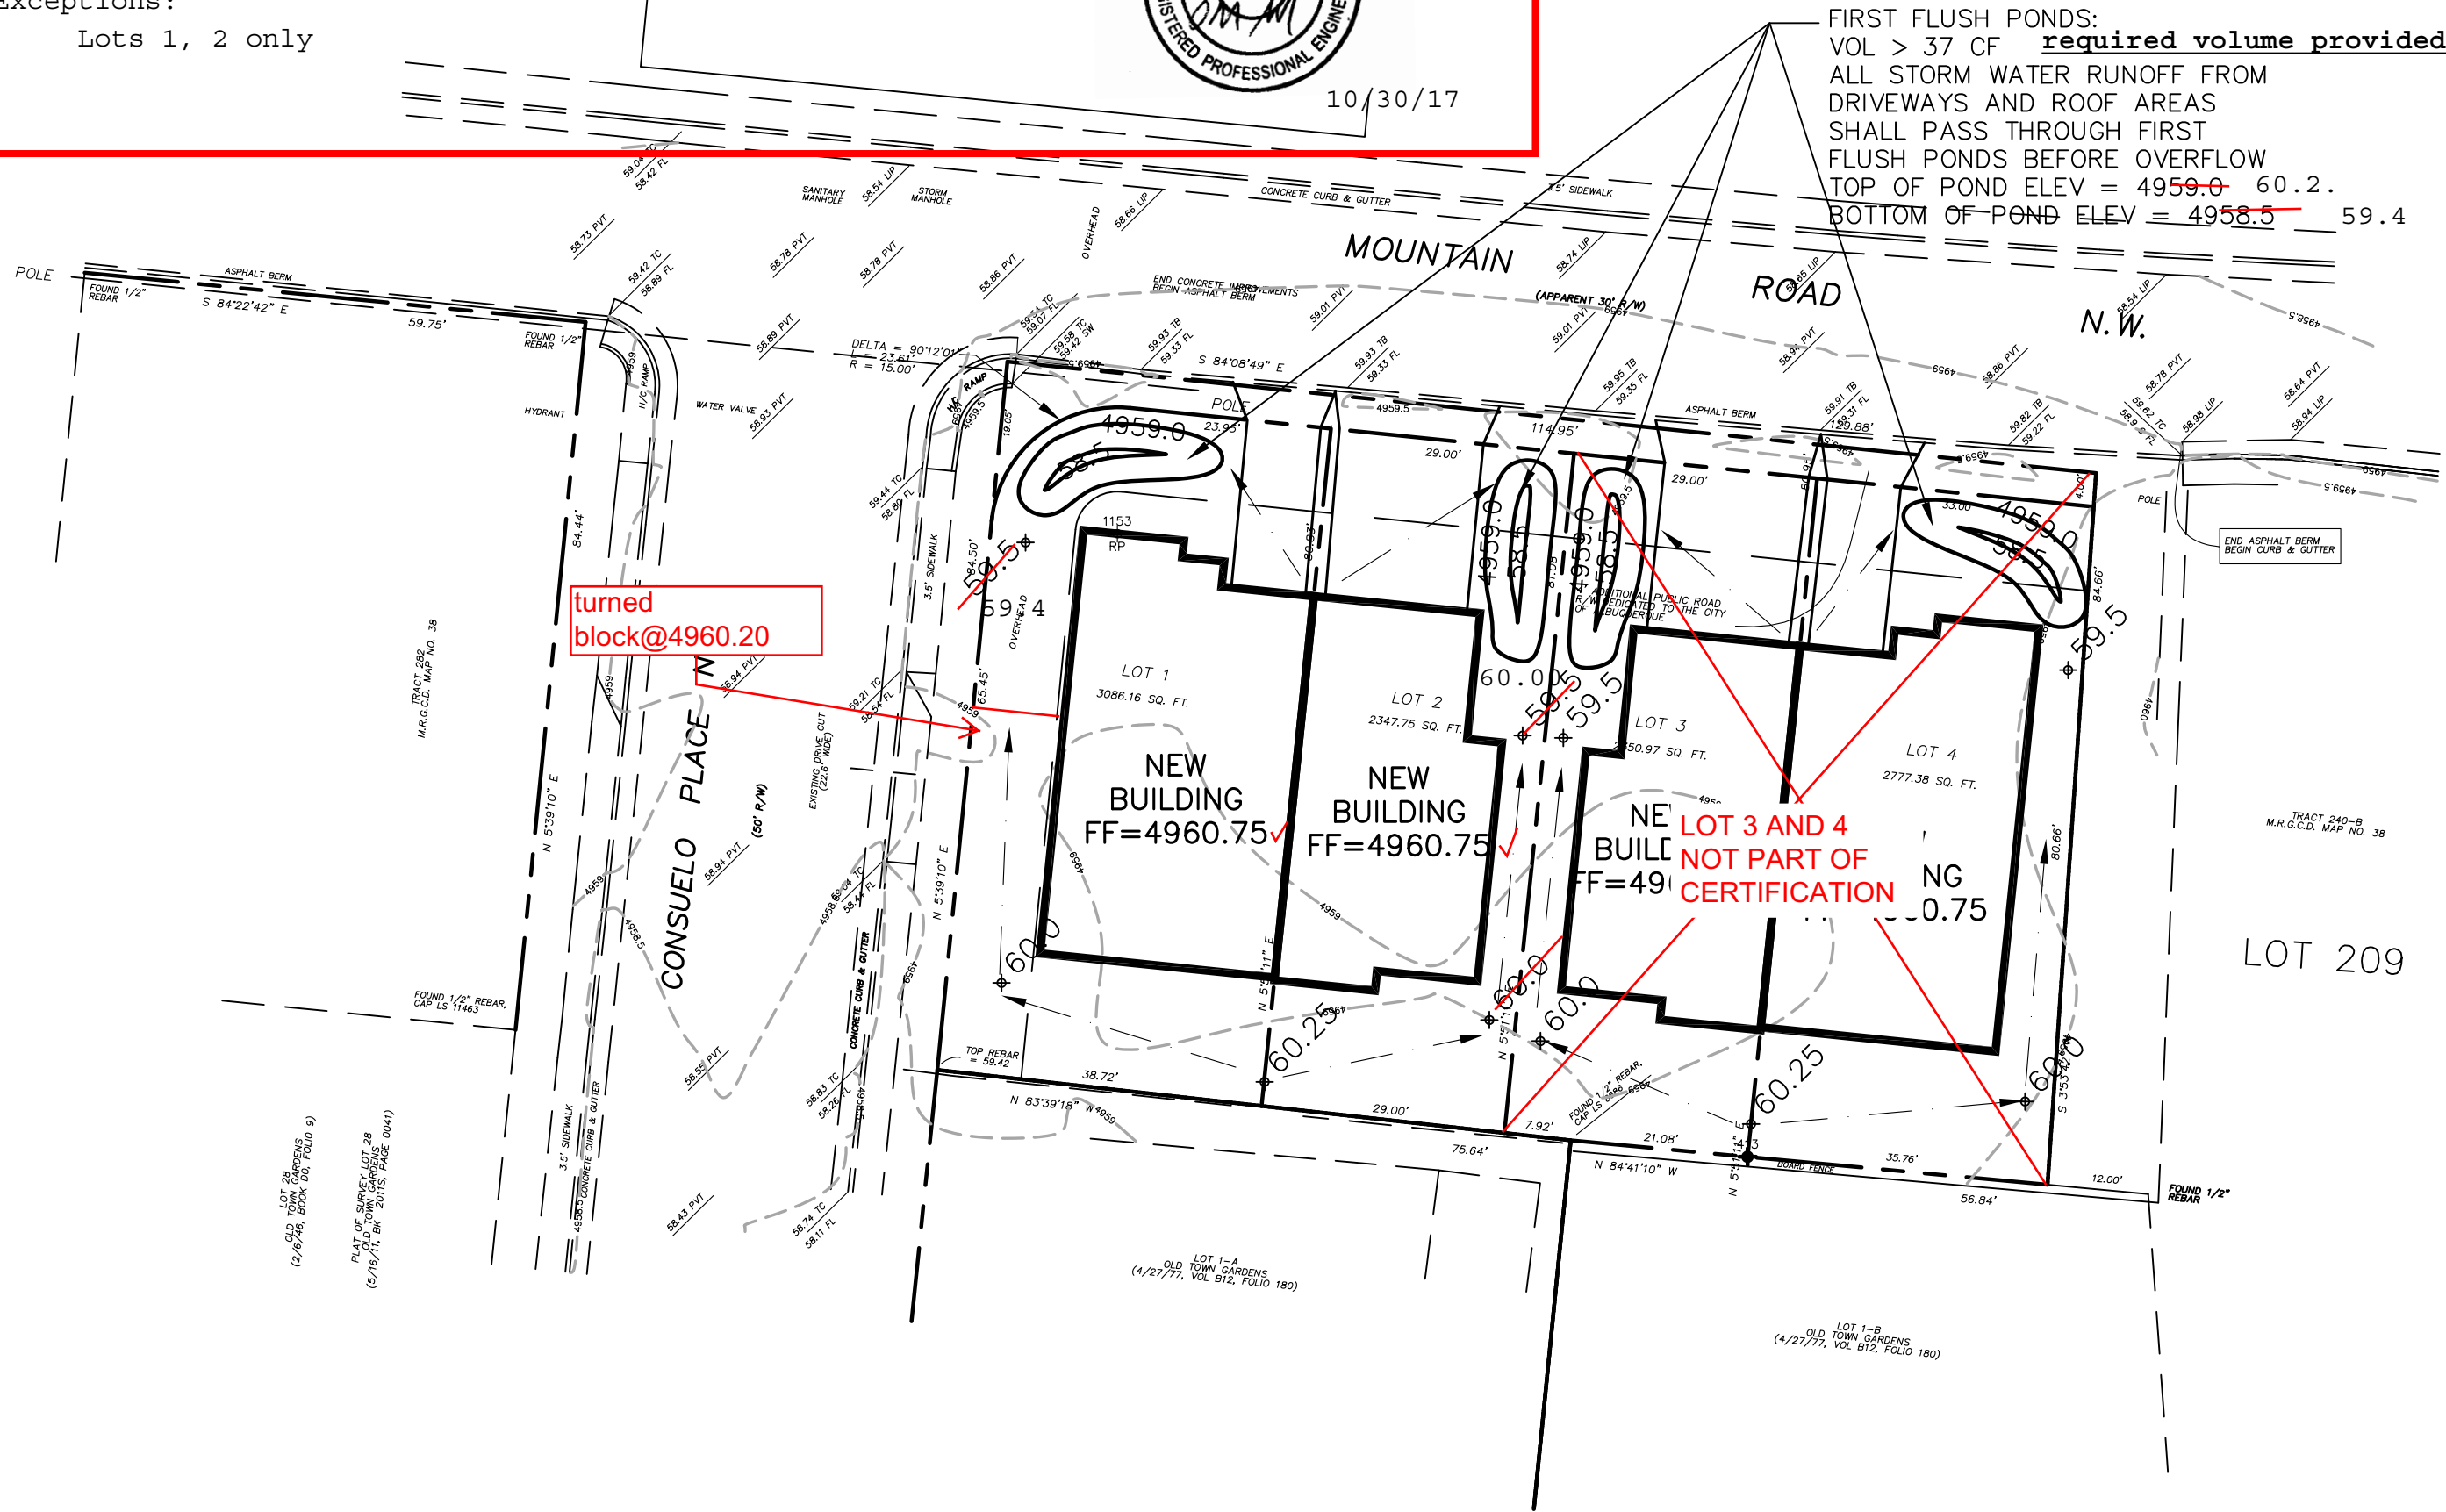

ALBUQUERQUE CONTROL STATION 5.07138
N = 491218.277' E = 1019633.327
DISTANCE = 1000.000' ANGLE = 90.000°
ELEVATION = 4960.450' ABOVE SEA LEVEL
1002 4960.450' FIELD SURFACE

DRAINAGE PLAN

SCOPE:

Pursuant to the latest City of Albuquerque and Bernalillo County Ordinances, the Drainage Plan shown hereon outlines the drainage management criteria for controlling developed runoff on and exiting the project site. Four townhomes are proposed with associated parking, access, landscaping, and utility improvements.

EXISTING CONDITIONS:

Presently, the 0.25 acre site was previously historically developed with a large building and hard packed gravel/dirt parking surrounding the building. The site is bounded on the east and south by private property, on the north by Mountain Rd. NW, and on the west by Consuelo Pl NW. The site is relatively level with sand and gravel. Site topography slopes from gently to the east along Mountain Rd. As shown on FEMA Panel #331H, the site is not located in a 100 year flood plain.

PROPOSED CONDITIONS:

As shown by the plan, the buildings are located in the center of the lots. No off-site flows enter the site. On site flows will drain around the structure via swales, and flow to the north to first flush retention ponds. All roof drainage will discharge from the roof to the lot and be directed around the structure to the drainage paths and ponds. Access will be taken from Mountain Rd. NW.

Supplemental calculations are shown as part of this Grading and Drainage plan.

CALCULATIONS:

The calculations shown hereon define the 100 year-6 hour design storm falling within the project area under existing and developed conditions. The Hydrology is per "Section 22.2, Hydrology of the Development Process Manual, Volume 2, Design Criteria, for the City of Albuquerque, New Mexico in cooperation with Bernalillo County, New Mexico and the Albuquerque Metropolitan Arroyo Flood Control Authority.

PROPERTY ADDRESS:


2304 Mountain Rd. NW

TOPOGRAPHY:

Topographic information provided by Mike Shook dated January, 2017.

GENERAL DRAINAGE PLAN NOTES:

- It is recommended that the Owner obtain a Geotechnical Evaluation of the on-site soils prior to foundation/structural design.
- This plan recommends positive drainage away from all structures to prohibit ponding of runoff adjacent to the structure. Future alterations of the grades next to the structures are not recommended.
- Irrigation within 10 feet of any proposed structure is not recommended. Irrigation water adjacent to the structures could cause settlement.
- This plan establishes on-site drainage and assumes no responsibility for subsurface analysis, foundation or structural design, or utility design.
- Local codes may require all footings to be placed in natural undisturbed soil. If the contractor plans to place footings on engineered fill, a certification by a registered Professional Engineer is recommended.
- It is recommended that the Owner obtain the services of a Geotechnical Engineer to test and inspect all earthwork aspects of the project.
- The property boundary shown on this plan is given for information only to describe the project limits. Property boundary information shown hereon does not constitute a boundary survey.
- All work shall be constructed in accordance with the City of Albuquerque Standard Specifications for Public Works Constructions with updates.
- All work on this project shall be performed in accordance with applicable Federal, State, and Local laws, rules, and regulations concerning construction safety and health.
- Contacto shall ensure that no site soils/sediment or silt enters the right-of-ways during construction.
- Areas disturbed due to construction shall be restored per City of Albuquerque Spec. 1012 native seed mix.

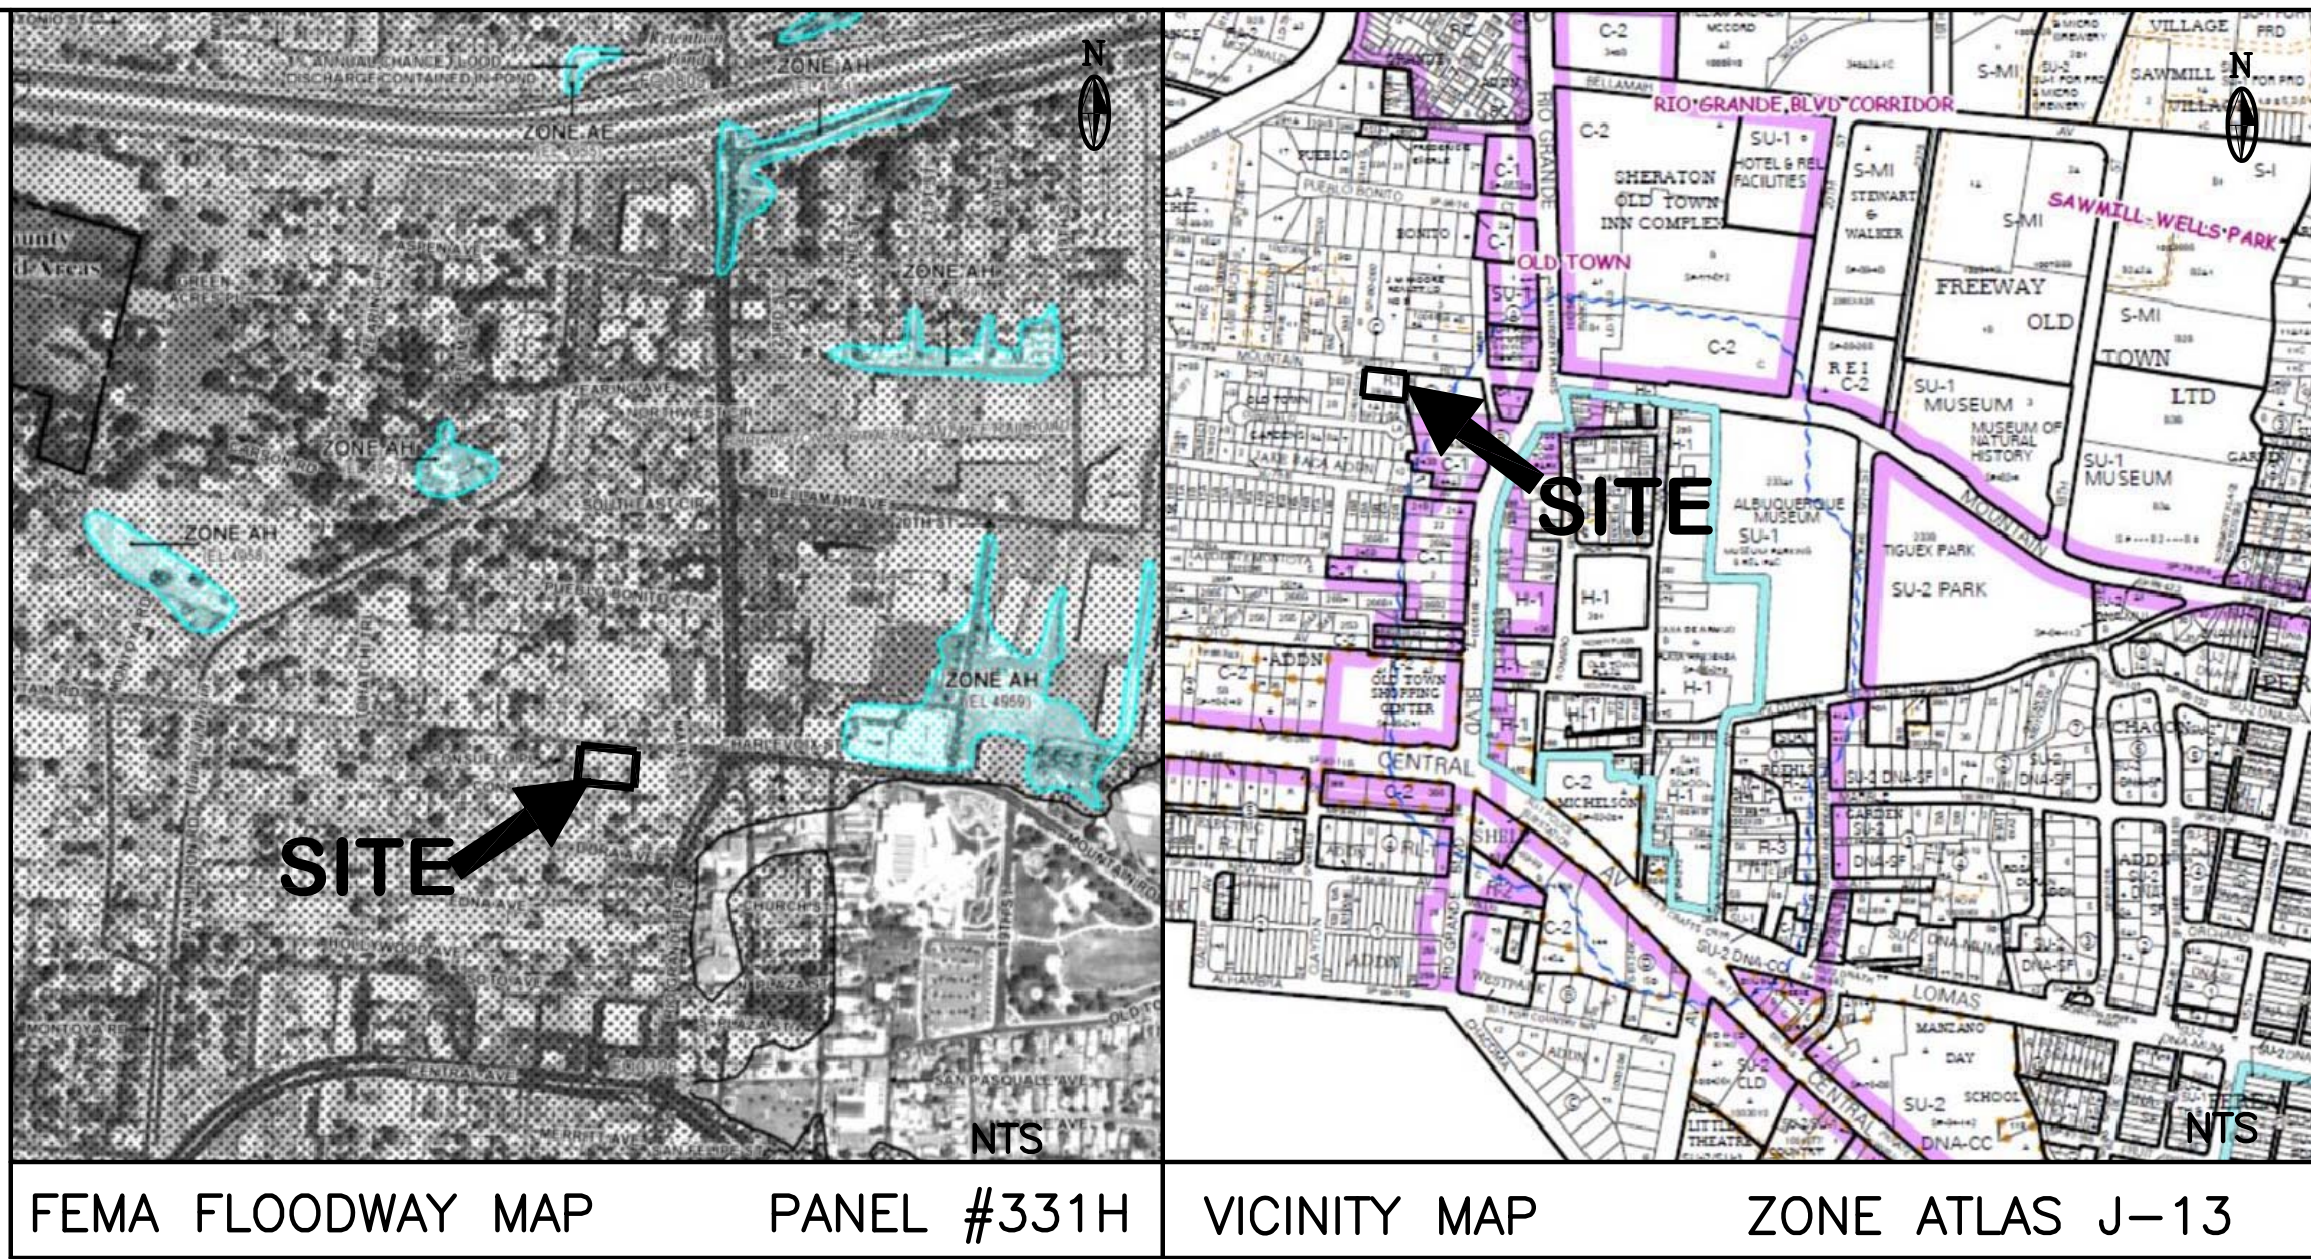

LEGEND

EXISTING PROPOSED

CONTOUR 6045 6045

PROPERTY LINE

ROAD

SETBACK

WALL

SPOT ELEVATION

LOTS 1, 2, 3, & 4

WITHIN

CASAS DEVINE

PROJECTED SECTION 18, T 10 N, R 3 E, NMPM

TOWN OF ALBUQUERQUE GRANT

ALBUQUERQUE, BERNALILLO COUNTY, NEW MEXICO

2304 MOUNTAIN RD. NW

FIRST FLUSH REQUIRED POND VOLUME:		
LOT NO.	IMP. AREA (AC)	0.34" POND VOL. (CF)
1	0.03	37
2	0.03	37
3	0.03	37
4	0.03	37

LOTS 1 & 4			LOTS 2 & 3		
POND VOLUME PROVIDED:			POND VOLUME PROVIDED:		
ELEV.	AREA	VOL. (CF)	ELEV.	AREA	VOL. (CF)
4959	154	41.75	4959	158	44.5
4958.5	13		4958.5	20	

LOT 1							LOT 2 & 3							LOT 4						
Areas: (acres)							Areas: (acres)							Areas: (acres)						
	Existing	Proposed		Existing	Proposed			Existing	Proposed		Existing	Proposed			Existing	Proposed		Existing	Proposed	
Treatment A	0.00	0.00		0.00	0.00		Treatment A	0.00	0.00		0.00	0.00		Treatment A	0.00	0.00		0.00	0.00	
Treatment B	0.00	0.04		0.00	0.04		Treatment B	0.00	0.02		0.00	0.02		Treatment B	0.00	0.02		0.00	0.02	
Treatment C	0.05	0.00		0.05	0.00		Treatment C	0.05	0.00		0.05	0.00		Treatment C	0.04	0.00		0.04	0.00	
Treatment D	0.02	0.03		0.02	0.03		Treatment D	0.02	0.03		0.02	0.03		Treatment D	0.02	0.03		0.02	0.03	
Total (acres) =	0.07	0.07		0.07	0.07		Total (acres) =	0.05	0.05		0.05	0.05		Total (acres) =	0.06	0.06		0.06	0.06	
Volume							Volume							Volume						
	100 year Existing	100 year Proposed	10 year Existing	10 year Proposed	2 year Existing	2 year Proposed		100 year Existing	100 year Proposed	10 year Existing	10 year Proposed	2 year Existing	2 year Proposed		100 year Existing	100 year Proposed	10 year Existing	10 year Proposed	2 year Existing	2 year Proposed
Volume (acre-feet) =	0.007	0.007	0.004	0.004	0.002	0.002	Volume (acre-feet) =	0.006	0.006	0.003	0.003	0.002	0.002	Volume (acre-feet) =	0.007	0.007	0.004	0.004	0.002	0.002
Treatment C	0.14	0.00	0.07	0.00	0.02	0.00	Treatment C	0.09	0.00	0.04	0.00	0.01	0.00	Treatment C	0.11	0.00	0.06	0.00	0.02	0.00
Treatment D	0.09	0.13	0.06	0.09	0.03	0.05	Treatment D	0.09	0.13	0.06	0.09	0.03	0.05	Treatment D	0.09	0.13	0.06	0.09	0.03	0.05
Total Q (cfs) =	0.23	0.21	0.13	0.12	0.06	0.05	Total Q (cfs) =	0.17	0.17	0.10	0.10	0.06	0.05	Total Q (cfs) =	0.29	0.19	0.12	0.11	0.05	0.05

Jackie S. McDowell
REGISTERED PROFESSIONAL ENGINEER
1-9-17

ENGINEER'S CERTIFICATION:

I, Jackie S. McDowell, hereby certify that I personally inspected the site shown on this plan on January 4, 2017 and as of that date it appeared that no filling, grading, or excavation had occurred thereon since completion of the topographic survey used to prepare this plan.

BERNALILLO COUNTY				NEW MEXICO							
LOTS 1, 2, 3, & 4 CASAS DEVINE											
JOHN JONES — CASAS DEVINE TOWNHOMES — GRADING & DRAINAGE PLAN											
McDowell Engineering, Inc.											
7820 BEVERLY HILLS AVE. NE • ALBUQUERQUE, NM 87122											
TELE: 505-828-2430 • FAX: 505-821-4857											
Designed	JSM	Drawn	STAFF	Checked	JSM	Sheet	of				
File	JON0116L	Date	JANUARY, 2017			1	1				

GRADING

1:2=20-16

1=20

JON0116L