


CITY OF ALBUQUERQUE

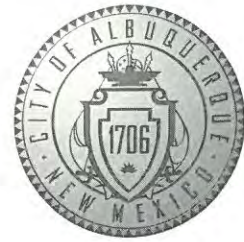

Timothy M. Keller, Mayor

January 10, 2018

J. Graeme Means, P.E.
High Mesa Consulting Group
6010 B Midway Park Blvd NE
Albuquerque, NM, 87109

**RE: NM Mutual Home Office
Grading Plan
Engineer's Stamp Date: 09/28/17
Hydrology File: J13D206**

Dear Mr. Means:

PO Box 1293

Albuquerque

NM 87103

www.cabq.gov

Based upon the information provided in your submittal received 01/04/2018, the Grading Plan **is not** approved for Grading Permit and Paving Permit. The following comments need to be addressed for approval of the above referenced project:


1. Please provide a cross section longitudinal along the proposed drive within the retention pond. Please show the slope of the drive (it appears that it goes from South to North) on the cross section and the slope of the 48-inch storm pipe.
2. How is the proposed drive's drainage getting to the retention pond? An example, providing a valley gutter at the connection between the existing paving and the proposed drive with a swale that directs the drainage to the pond?

If you have any questions, please contact me at 924-3995 or rbrissette@cabq.gov.



Sincerely,

Renée C. Brissette

Renée C. Brissette, P.E. CFM
Senior Engineer, Hydrology
Planning Department

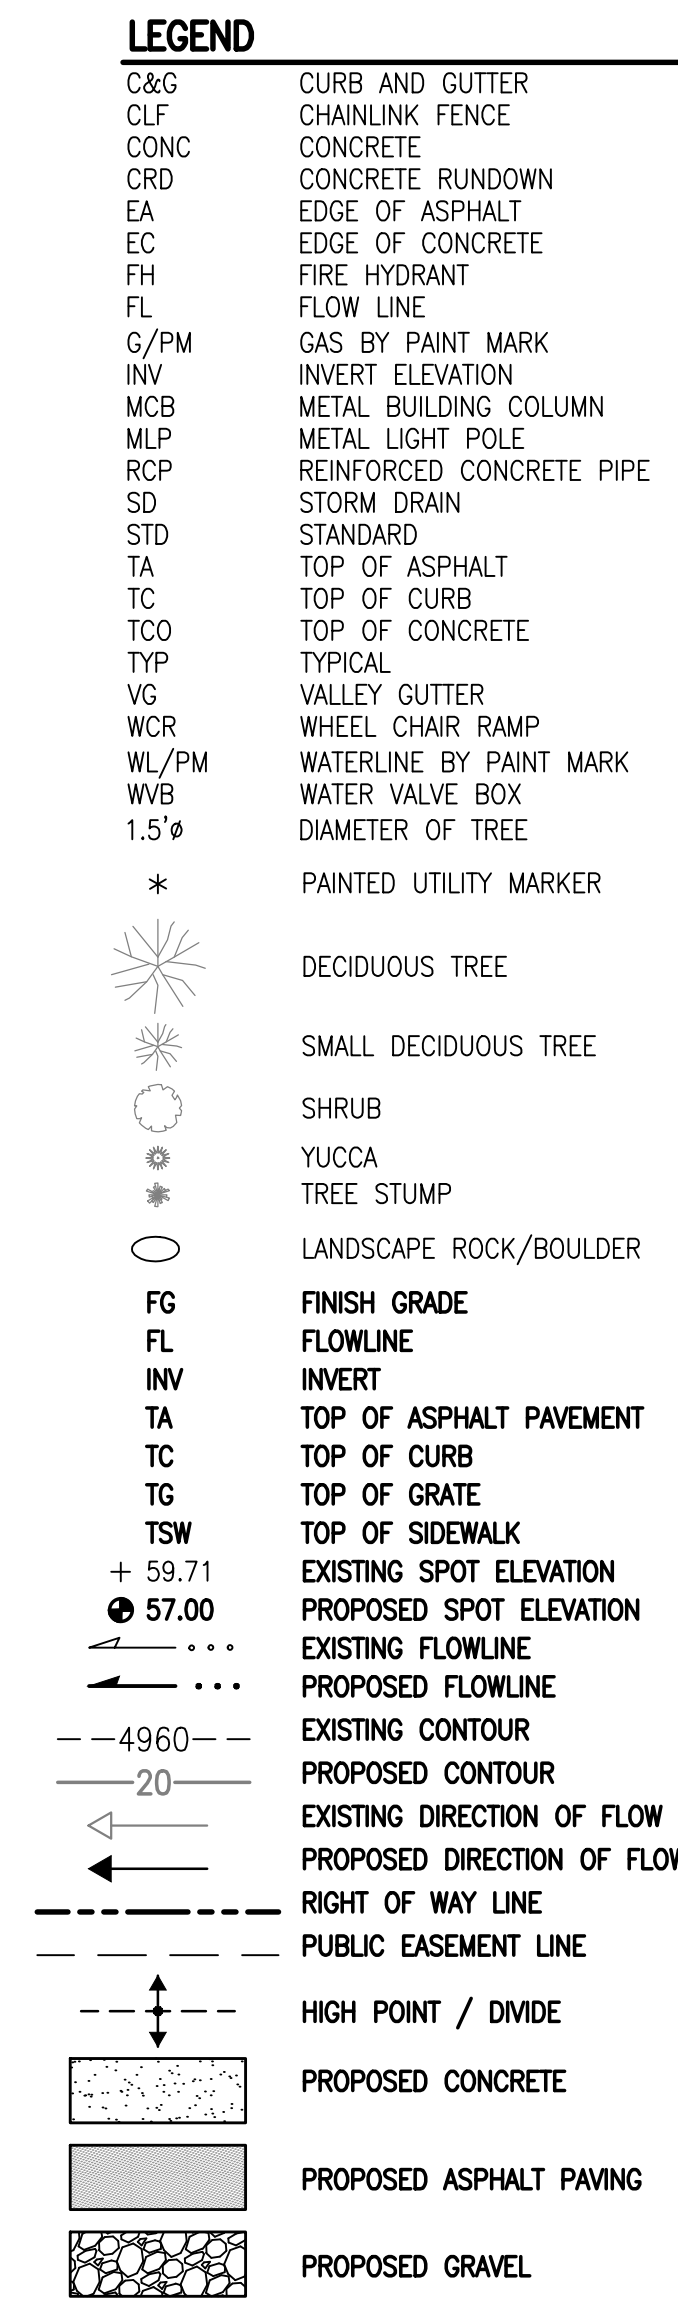

1. TWO (2) WORKING DAYS PRIOR TO ANY EXCAVATION, CONTRACTOR MUST CONTACT NEW MEXICO ONE CALL SYSTEM, 811, FOR DESIGNATION (LINE-SPOTTING) OF EXISTING UTILITIES.
2. PRIOR TO CONSTRUCTION, THE CONTRACTOR SHALL EXCAVATE AND VERIFY THE HORIZONTAL AND VERTICAL LOCATION OF ALL POTENTIAL OBSTRUCTIONS. SHOULD A CONFLICT EXIST, THE CONTRACTOR SHALL IMMEDIATELY EXCAVATE TO THE DEPTH OF THE OBSTRUCTION, AND BE RESOLVED WITH A MINIMUM AMOUNT OF DELAY. THE CONTRACTOR SHALL BE RESPONSIBLE FOR ALL INTERPRETATIONS IT MAKES WITHOUT FIRST CONTACTING THE ENGINEER AS REQUIRED ABOVE.
3. ALL WORK ON THIS PROJECT SHALL BE PERFORMED IN ACCORDANCE WITH APPLICABLE FEDERAL, STATE AND LOCAL LAWS, RULES AND REGULATIONS CONCERNING CONSTRUCTION AND PUBLIC HEALTH.
4. ALL CONSTRUCTION WITHIN PUBLIC RIGHT-OF-WAY SHALL BE PERFORMED IN ACCORDANCE WITH APPLICABLE CITY OF ALBUQUERQUE STANDARDS AND PROCEDURES.
5. UTILITY INFORMATION SHOWN HEREON IS BASED UPON ONSITE SURFACE EVIDENCE, AND LINE SPOTS FROM UNKNOWN SOURCE. UNDERGROUND LINES SHOWN ARE NOT GUARANTEED TO BE IN APPROXIMATE MANNER ONLY AND SUCH LINES MAY EXIST WHERE NONE ARE SHOWN. IF ANY SUCH EXISTING LINES ARE SHOWN, THE LOCATION IS BASED UPON INFORMATION PROVIDED BY THE OWNER OF SAID UTILITY, AND THE INFORMATION MAY BE INCOMPLETE, OR MAY BE INCOMPLETE TO THE POINT OF CONSTRUCTION COMMENCING. THE CONTRACTOR HAS CONDUCTED ONLY PRELIMINARY INVESTIGATION OF THE LOCATION, DEPTH, SIZE, OR TYPE OF EXISTING UTILITY LINES, PIPELINES, OR UNDERGROUND UTILITY LINES. THIS INVESTIGATION IS NOT CONCLUSIVE AND NOT TO BE USED FOR ANY DESIGN OR CONSTRUCTION REPRESENTATION PERTAINING THERETO, AND ASSUMES NO RESPONSIBILITY OR LIABILITY THEREFOR. THE PROPERTY OWNER, DEVELOPER, OR CONTRACTOR SHALL INFORM ITSELF OF THE LOCATION OF ANY UTILITY LINE, OR UNDERGROUND UTILITY LINE, OR NEAR BY REPRESENTATION OF THE WORK IN ADVANCE OF AND DURING EXCAVATION WORK. THE PROPERTY OWNER, DEVELOPER, OR CONTRACTOR IS FULLY RESPONSIBLE FOR ANY AND ALL DAMAGE CAUSED BY ITS FAILURE TO INVESTIGATE AND LOCATE ALL EXISTING UTILITY LINES, PIPELINES, AND UNDERGROUND UTILITY LINES, IN PLANNING AND CONDUCTING EXCAVATION. THE CONTRACTOR SHALL COMPLY WITH STATE STATUTES, MUNICIPAL AND LOCAL ORDINANCES, RULES AND REGULATIONS, IF ANY, PERTAINING TO THE LOCATION OF THESE LINES AND UTILITIES.
6. THE GRADES INDICATED ON THIS PLAN ARE FINISHED GRADES UNLESS OTHERWISE INDICATED. THE CONTRACTOR SHALL BE RESPONSIBLE FOR LEAVING SUBGRADE AT ELEVATIONS THAT SHALL ACCOMMODATE PROPOSED IMPROVEMENTS AS INDICATED ON THE PLANS INCLUDING BUT NOT LIMITED TO SURFACE DRAINAGE STRUCTURES, PAVING AND LANDSCAPING SURFACING.

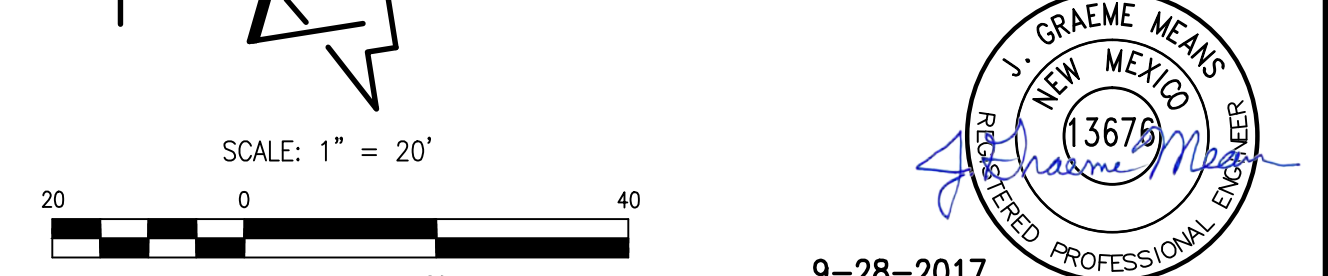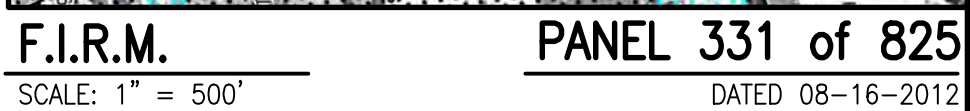

SITE GRADING PLAN

EXPLORA SURPLUS PROPERTY DRIVEPAD

DESIGNED BY	J.D.S.	NO.	DATE	BY	REVISIONS	JOB NO.	2017.024.1
DRAWN BY	J.Y.R., S.C.C.					DATE	09-2017
APPROVED BY	G.M.					SHEET	1 OF 2

CALCULATIONS

DISPLACED RETENTION PONDING VOLUME

- OVERFLOW WSL = 60.8± (AT SOUTHWEST CORNER OF PROPERTY)
- PONDING VOLUME
- AREA OF EXISTING POND DISPLACED BY NEW DRIVEWAY = 2,650 (USING AVERAGE END-AREA METHOD)
- CULVERT VOLUME CAPACITY
- VOLUME OF 2-48" DIA. HDPE @ 38 LF = 955 CF
- TOTAL VOLUME DISPLACED = 2,650 - 955 = 1,695 CF

DEVELOPED RETENTION PONDING VOLUME

- 78 SF = EXISTING CROSS-SECTIONAL AREA OF DITCH TO BE REGRADED
- 107 SF = DEVELOPED CROSS-SECTIONAL AREA OF DITCH AFTER REGRADED
- 75 LF = LENGTH OF DITCH TO BE REGRADED
- EXISTING CAPACITY = 78 SF * 75 LF = 5,850 CF
- DEVELOPED CAPACITY = 107 SF * 75 LF = 8,025 CF
- ADDITIONAL CAPACITY = 8025 - 5850 = 2,175 CF INCREASED CAPACITY > 1,695 CF DISPLACED THEREFORE OK.


DRAINAGE PLAN

THE PROJECT SITE IS A NEW ENTRANCE TO AN EXISTING DEVELOPED PAVED SITE COMMERCIAL SITE WITHIN AN INFILL AREA. THE SITE IS LOCATED NEAR THE INTERSECTION OF 18TH STREET NW AND BELLAMAH AVE NW. THE PROPOSED PROJECT SCOPE IS TO CREATE A NEW DRIVEPAD ENTRANCE FROM 18TH STREET, ACROSS AN EXISTING PRIVATE RETENTION POND, TO SERVE THE EXISTING SITE. IN PREPARATION OF THIS PROJECT, THE 1977 PLAN OF RECORD FOR THE SITE WAS REVIEWED AND IT WAS NOTED THAT THIS PLAN DID NOT INCLUDE A DRAINAGE PLAN OR CALCULATIONS ESTABLISHING THE VOLUME OF THE RETENTION POND. PRELIMINARY DISCUSSIONS WITH CITY HYDROLOGY DURING PROJECT DESIGN DETERMINED THAT ABSENT OF A SET CRITERIA FROM THE 1977 PLAN, THE DRAINAGE INTENT FOR THIS PROJECT SHALL BE TO OFFSET ANY DISPLACED VOLUME SO AS TO MAINTAIN THE EXISTING RETENTION PONDING CAPACITY OF THE SITE.

THE NEW DRIVEPAD ENTRANCE WILL RESULT IN INFILL OF AN EXISTING RETENTION POND IN ORDER TO PROVIDE ACCESS TO THE SITE. IN ORDER TO OFFSET THIS INFILL OF THE EXISTING POND, TWO NEW 48" CULVERT PIPES WILL BE INSTALLED BENEATH THE NEW ENTRANCE AND THE EXISTING RETENTION POND WILL BE REGRADED TO THE NORTH AND SOUTH OF THE NEW ENTRANCE. THE INCREASED CAPACITY FROM THE NEW CULVERTS AND THE REGRADED POND WILL OFFSET THE RETENTION VOLUME LOST BY THE CONSTRUCTION OF THE NEW ENTRANCE, THEREBY MAINTAINING THE EXISTING SITE RETENTION CAPACITY


CALCULATIONS FOR THE MODIFIED RETENTION POND WERE PERFORMED USING THE AVERAGE END-AREA METHOD; THE RETENTION CAPACITY OF THE NEW CULVERTS WAS BASED ON THE EQUATION FOR VOLUME OF A CYLINDRICAL PIPE.

THIS SUBMITTAL IS MADE IN SUPPORT OF GRADING AND DRAINAGE PERMIT APPROVAL.

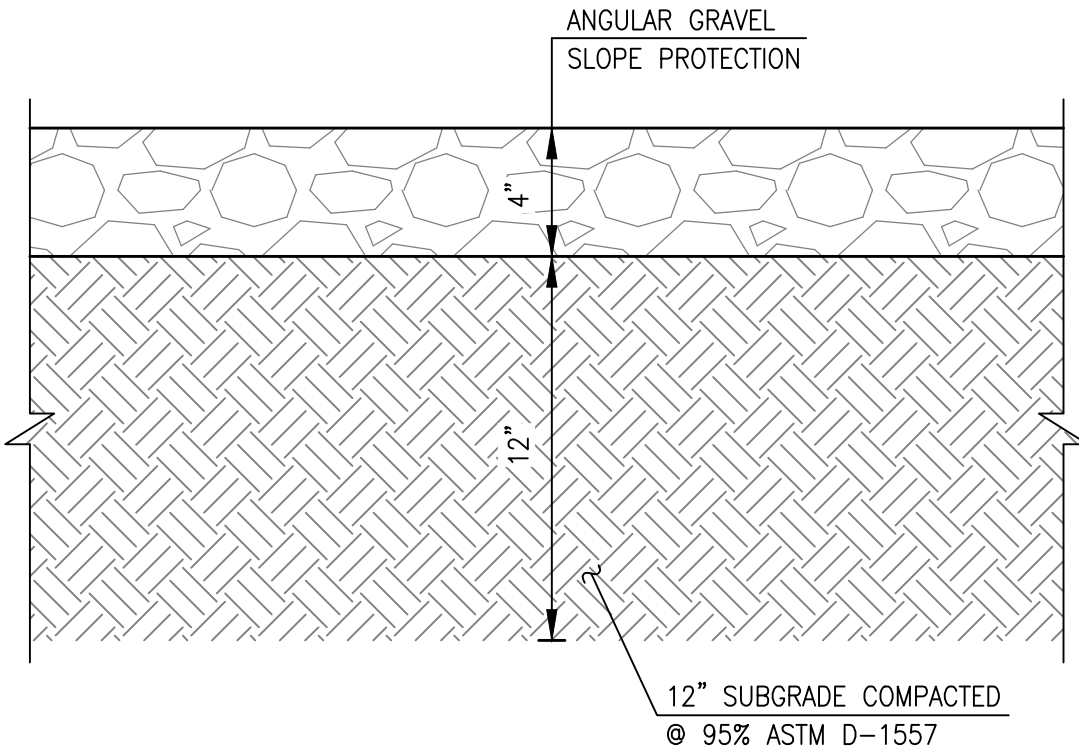

TYPICAL ANGULAR GRAVEL SLOPE PROTECTION SECTION

SCALE: 1" = 6"

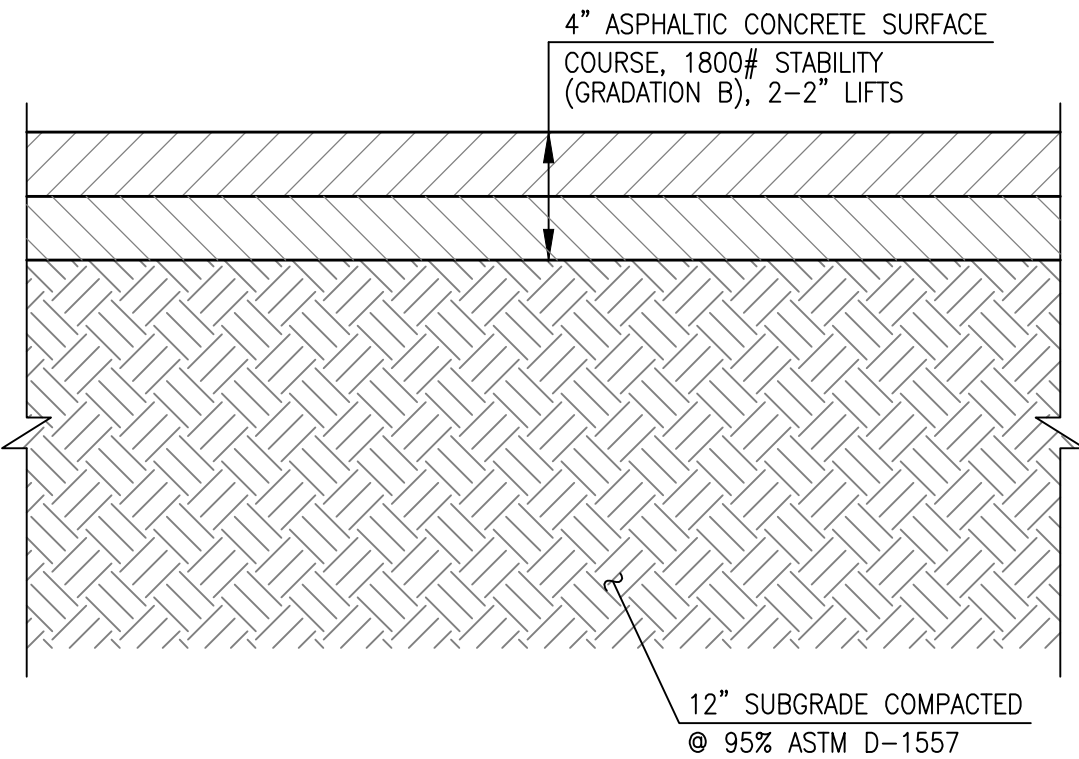


TYPICAL 4" ASPHALT PAVING SECTION

SCALE: 1" = 6" (VEHICULAR TRAFFIC AREAS)


ROAD SECTION NOTE:

CONTRACTOR SHALL TEST SUBGRADE R-VALUE PRIOR TO CONSTRUCTION. IN THE EVENT THE R-VALUE IS LESS THAN 50, CONTRACTOR SHALL REMOVE 2 FT. OF SUBGRADE MATERIAL AND IMPORT SUITABLE MATERIAL WITH R-VALUE 50 OR GREATER.

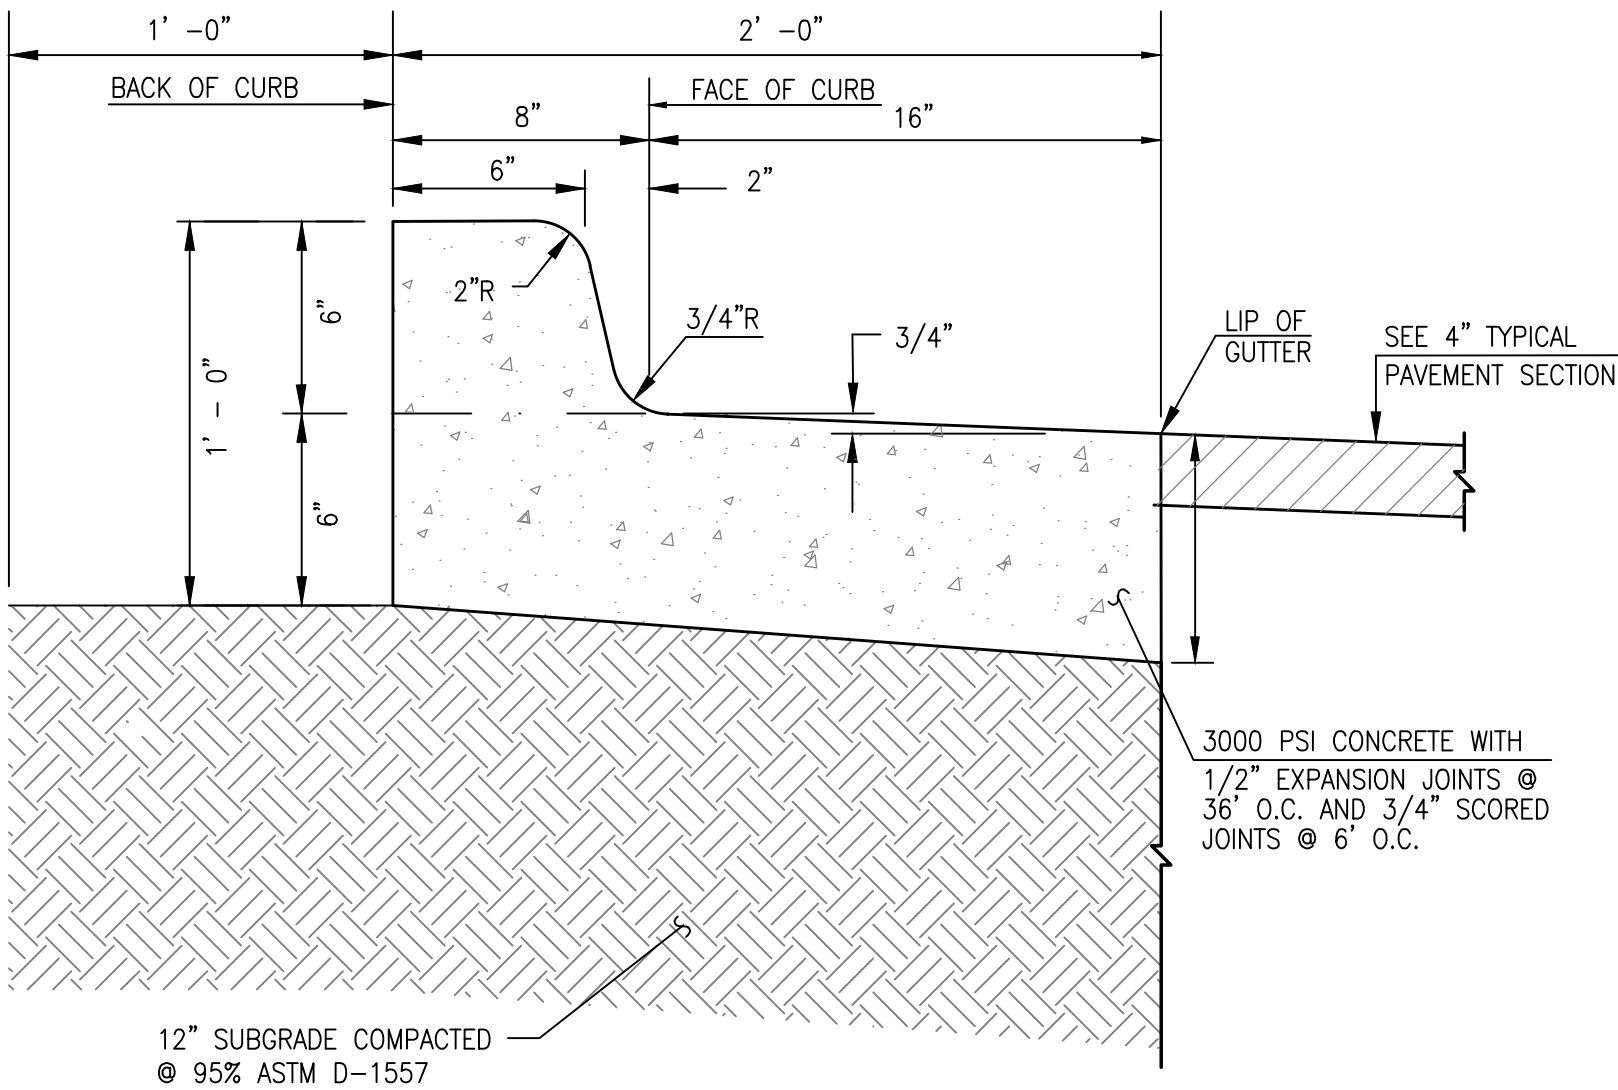


TYPICAL SIX-INCH DEPRESSED CURB & GUTTER

SCALE: 1" = 0'-6" NOTE: USE THIS SECTION FOR CASES WHERE PAVING SLOPES AWAY FROM FACE OF CURB

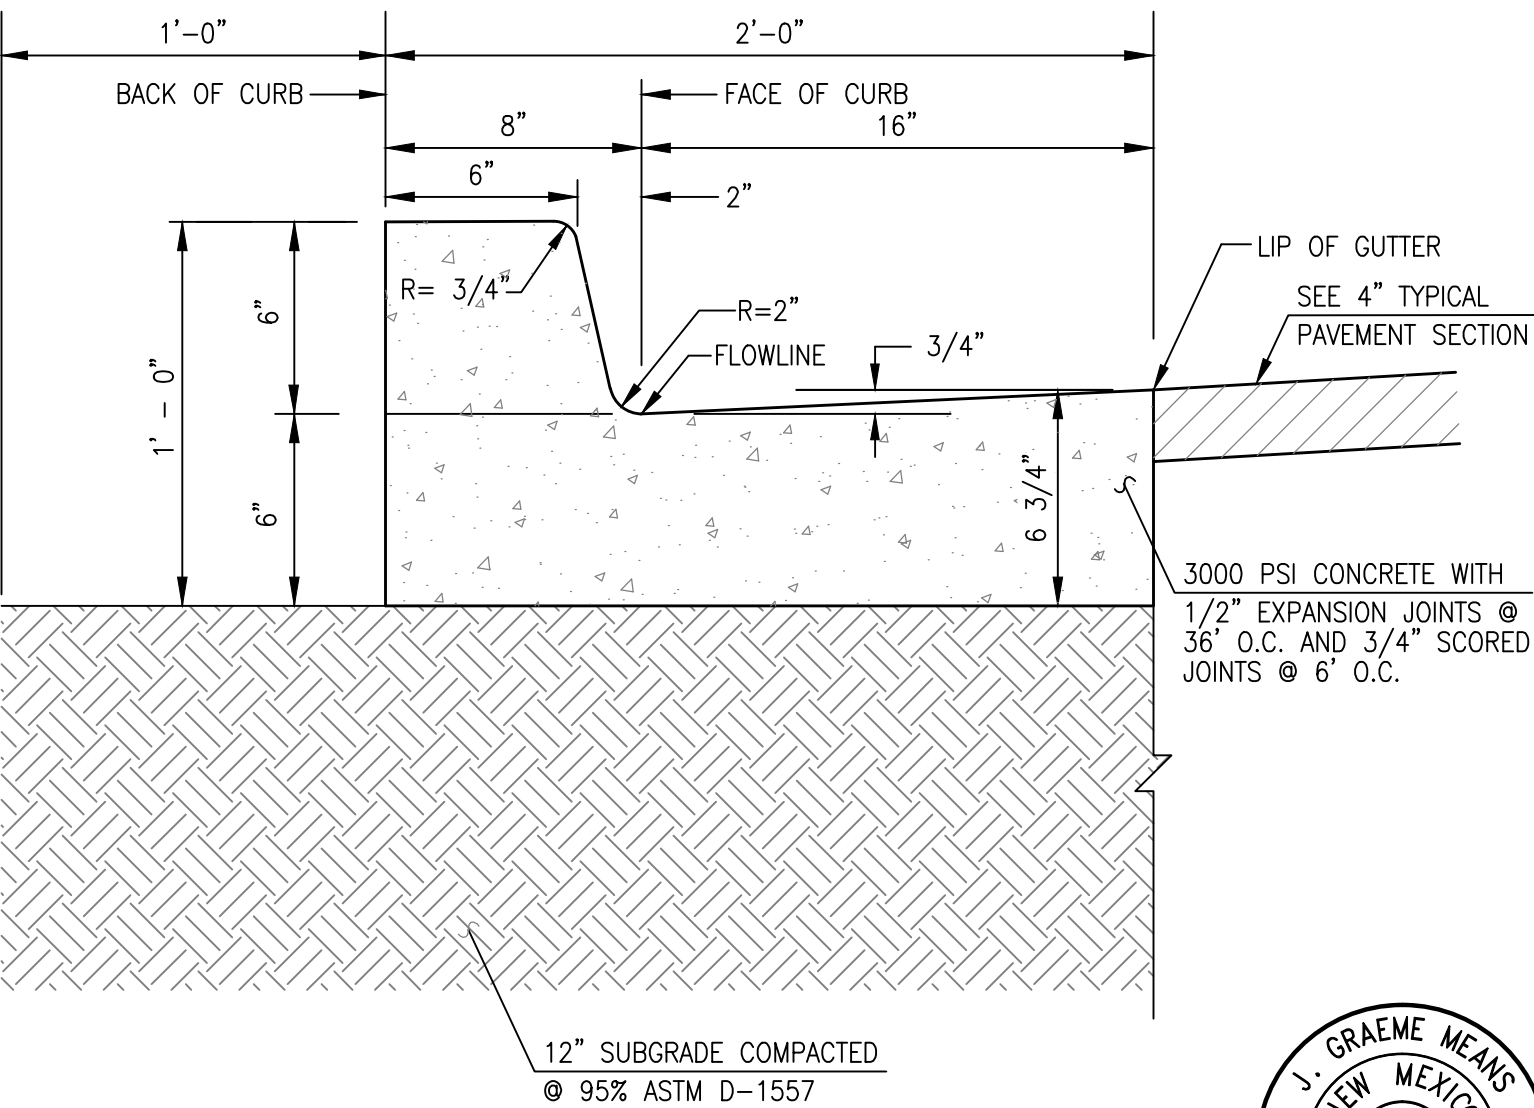

TYPICAL SIX-INCH CURB & GUTTER

SCALE: 1" = 0'-6"

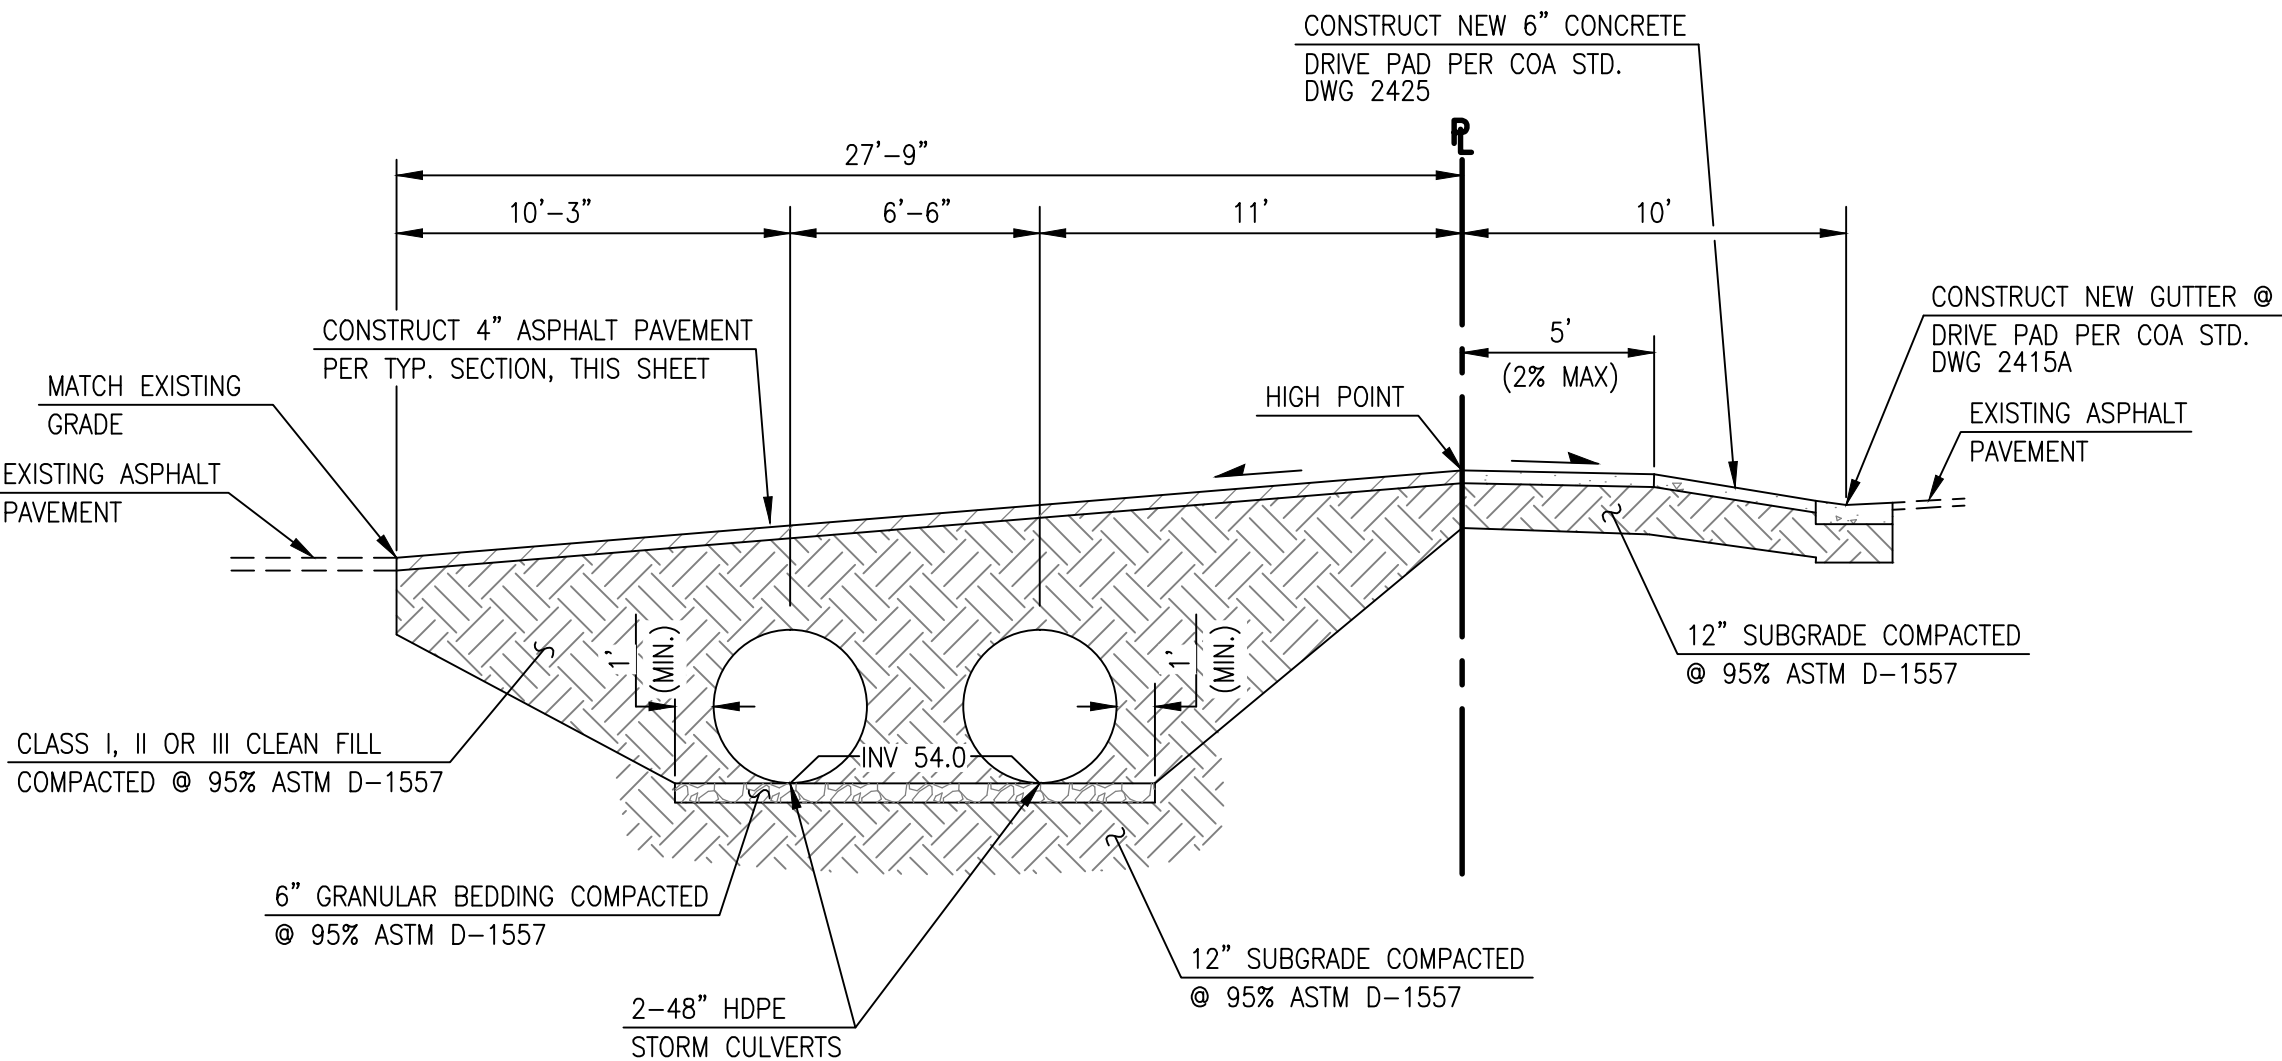

SECTION A-A

SCALE: 1" = 5'

File Path: P:\DMA\2017\2017.024.1\DWG\ Plot Date: 09-28-2017
File Name: 20170241_S42.DWG Plot Time: 12:15 pm

HIGH MESA Consulting Group
Engineers, Surveyors & Sustainable Utility Consultants

8010-B Midway Park Blvd. NE • Albuquerque, New Mexico 87109
Phone: 505.345.4250 • Fax: 505.345.4254 • www.highmesacg.com

SECTIONS, DETAILS AND CALCULATIONS
EXPLORA SURPLUS PROPERTY DRIVEPAD

DESIGNED BY J.D.S.

DRAWN BY J.Y.R., S.C.C.

APPROVED BY G.M.

NO.	DATE	BY	REVISIONS

JOB NO.	2017.024.1
DATE	09-2017
SHEET	2 OF 2

09-28-2017

