

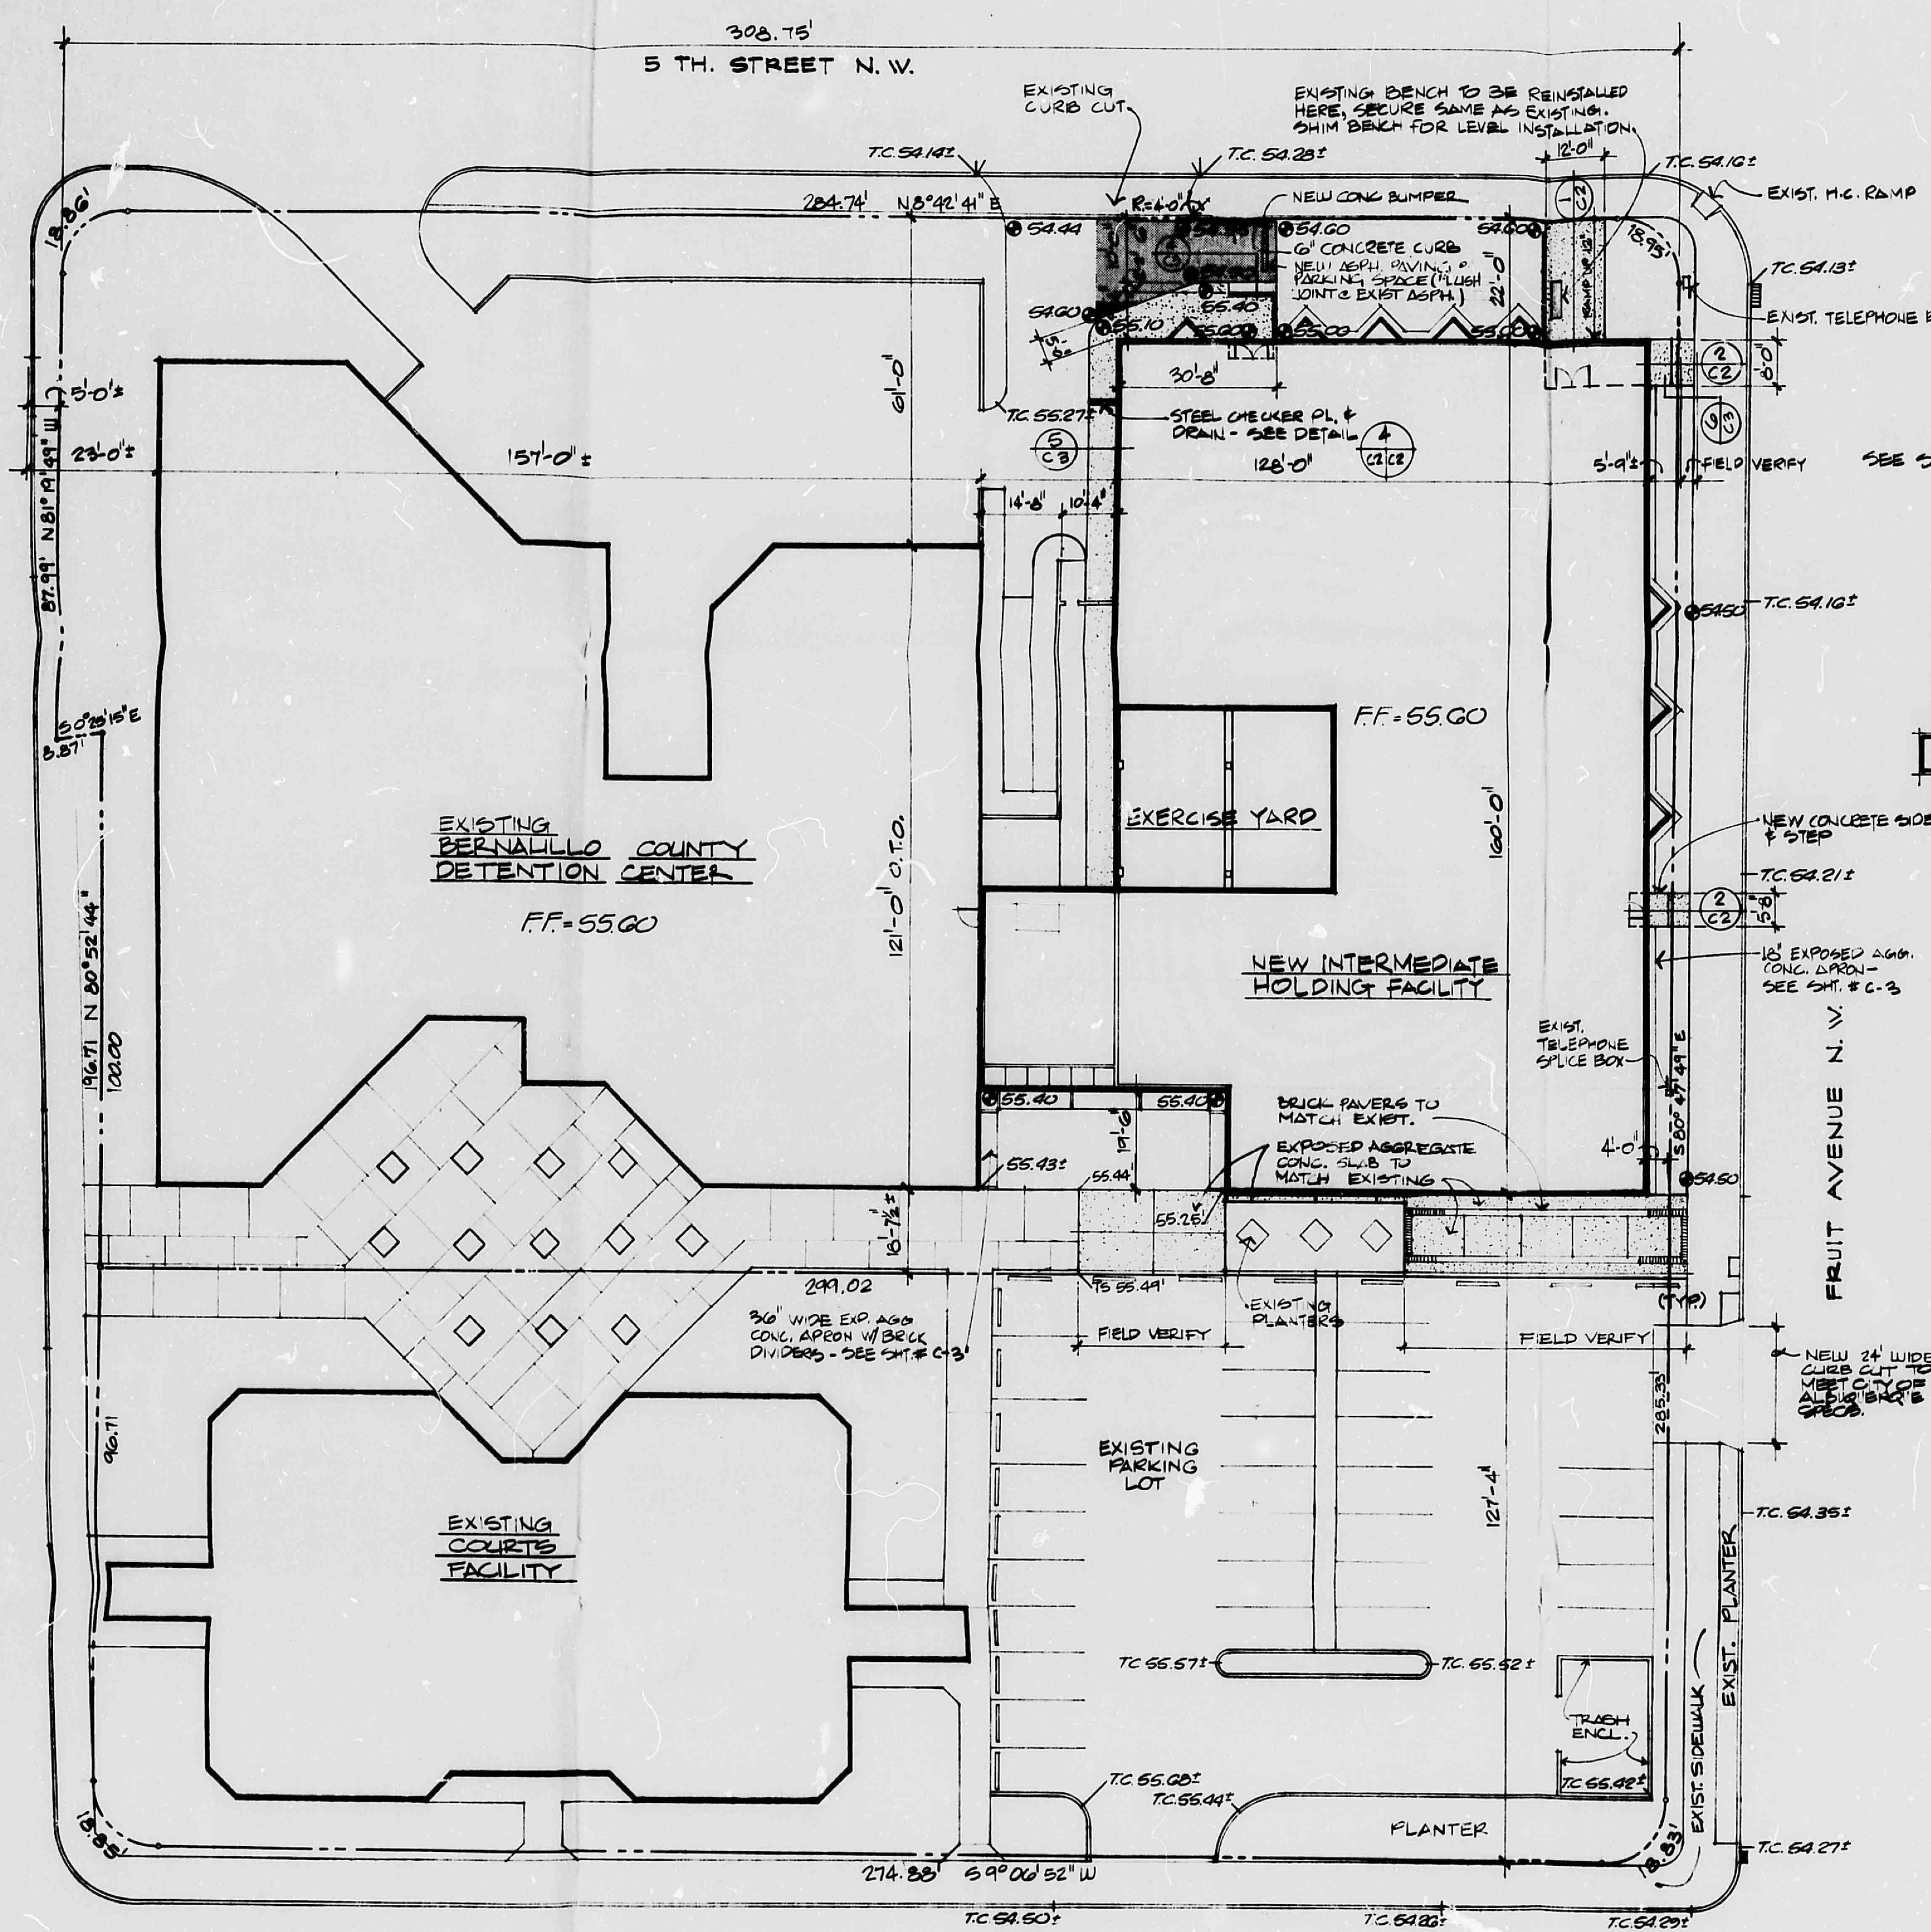
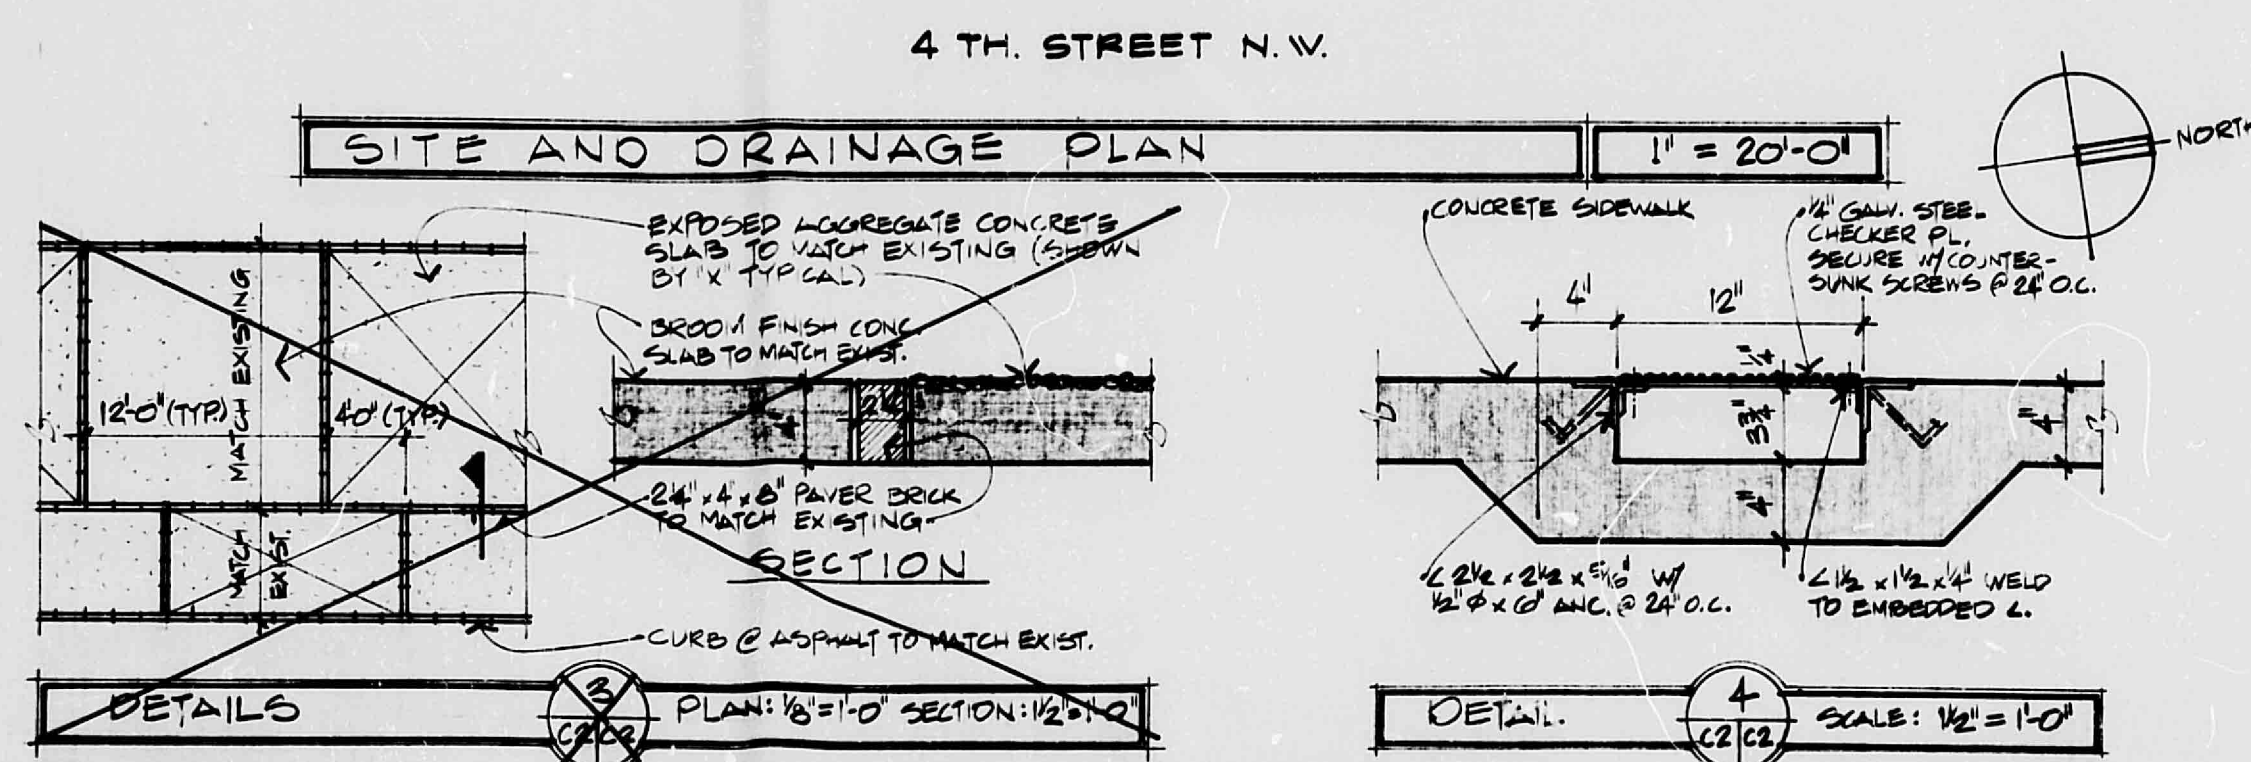


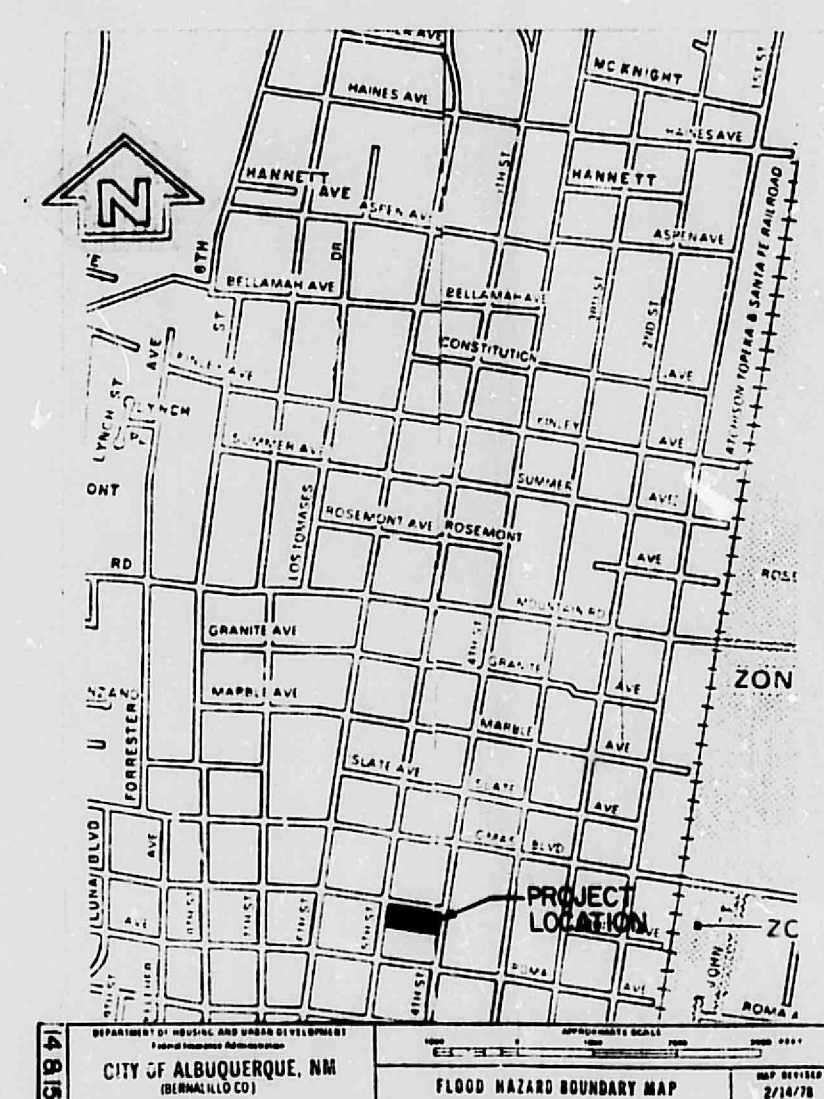

DRAINAGE PLAN

THE SITE FOR THE PROPOSED BUILDING IS CURRENTLY AN ASPHALT PARKING LOT. THEREFORE THE ADDITION OF A BUILDING WILL NOT INCREASE THE IMPERVIOUS AREA OR RUNOFF. SEE ATTACHED LETTER.

LEGAL DESCRIPTION
MUNICIPAL ADDITION #12, BLOCK 15 OF THE PERFECTO ARMO & BROS
ADDITION AND BLOCK 'G' OF MANDELL'S BUSINESS AND RESIDENCE
ADDITION.

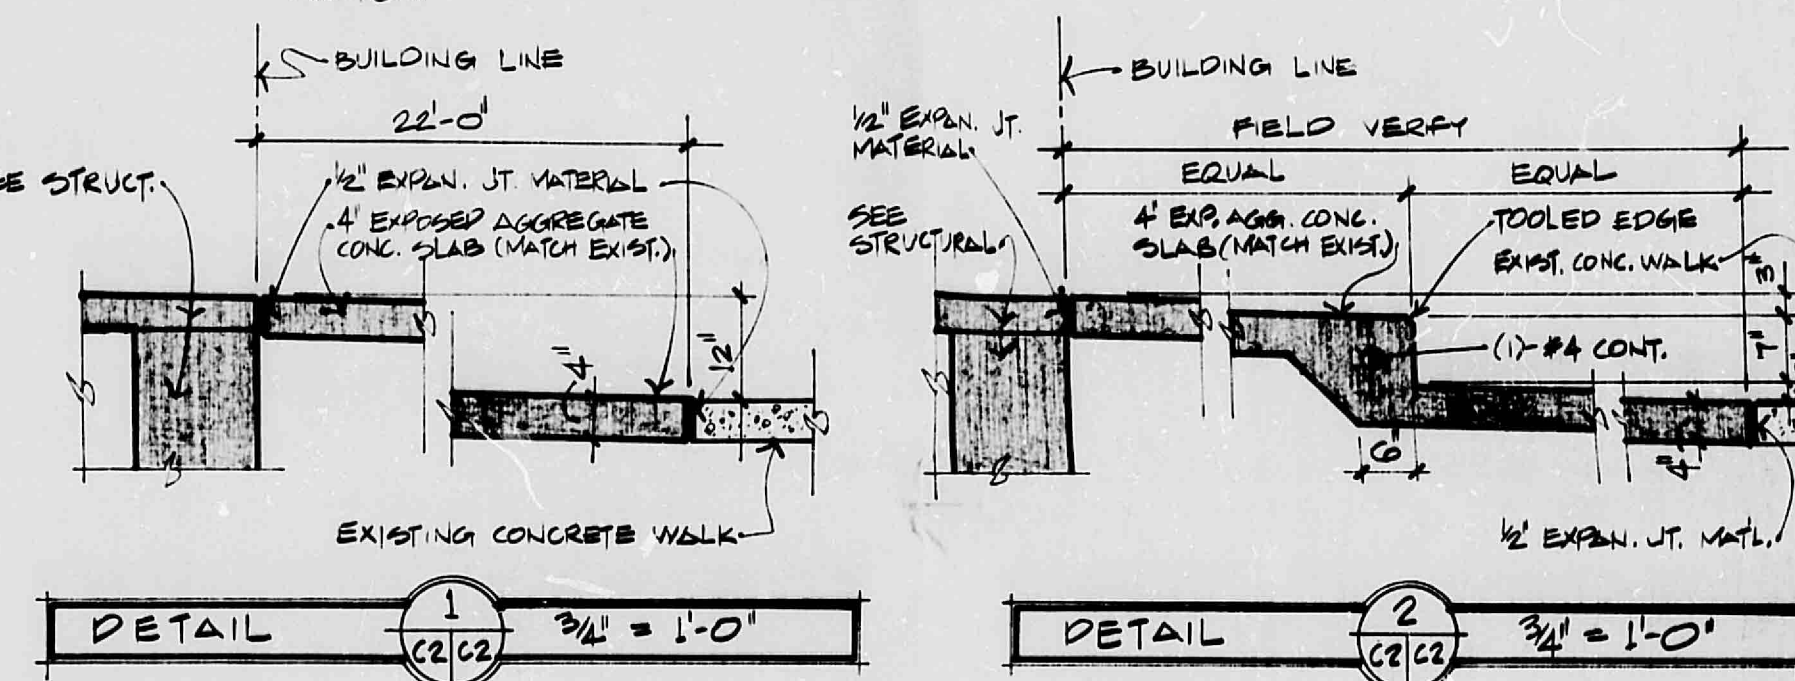

STATE OF NEW MEXICO
 W. L. BURNS
 NO. 774
 R. L. PETERS
 NO. 789
 ALBUQUERQUE
 N.M.
 REGISTERED ARCHITECTS

Architect

Engineer

INTERMEDIATE
HOLDING
FACILITY

STURKS/PETERS GROUP ARCHITECTS
RECORD DRAWING
DATE 10/14/04



the
new
breed

THE BURNS/PETERS GROUP
Architects & Planners
8000 Pennsylvania Circle NE
Albuquerque, New Mexico
8, 119 505 265 3645

Date SEPT 11, 1979

C2
Sheet No.

CITY OF ALBUQUERQUE

C

