



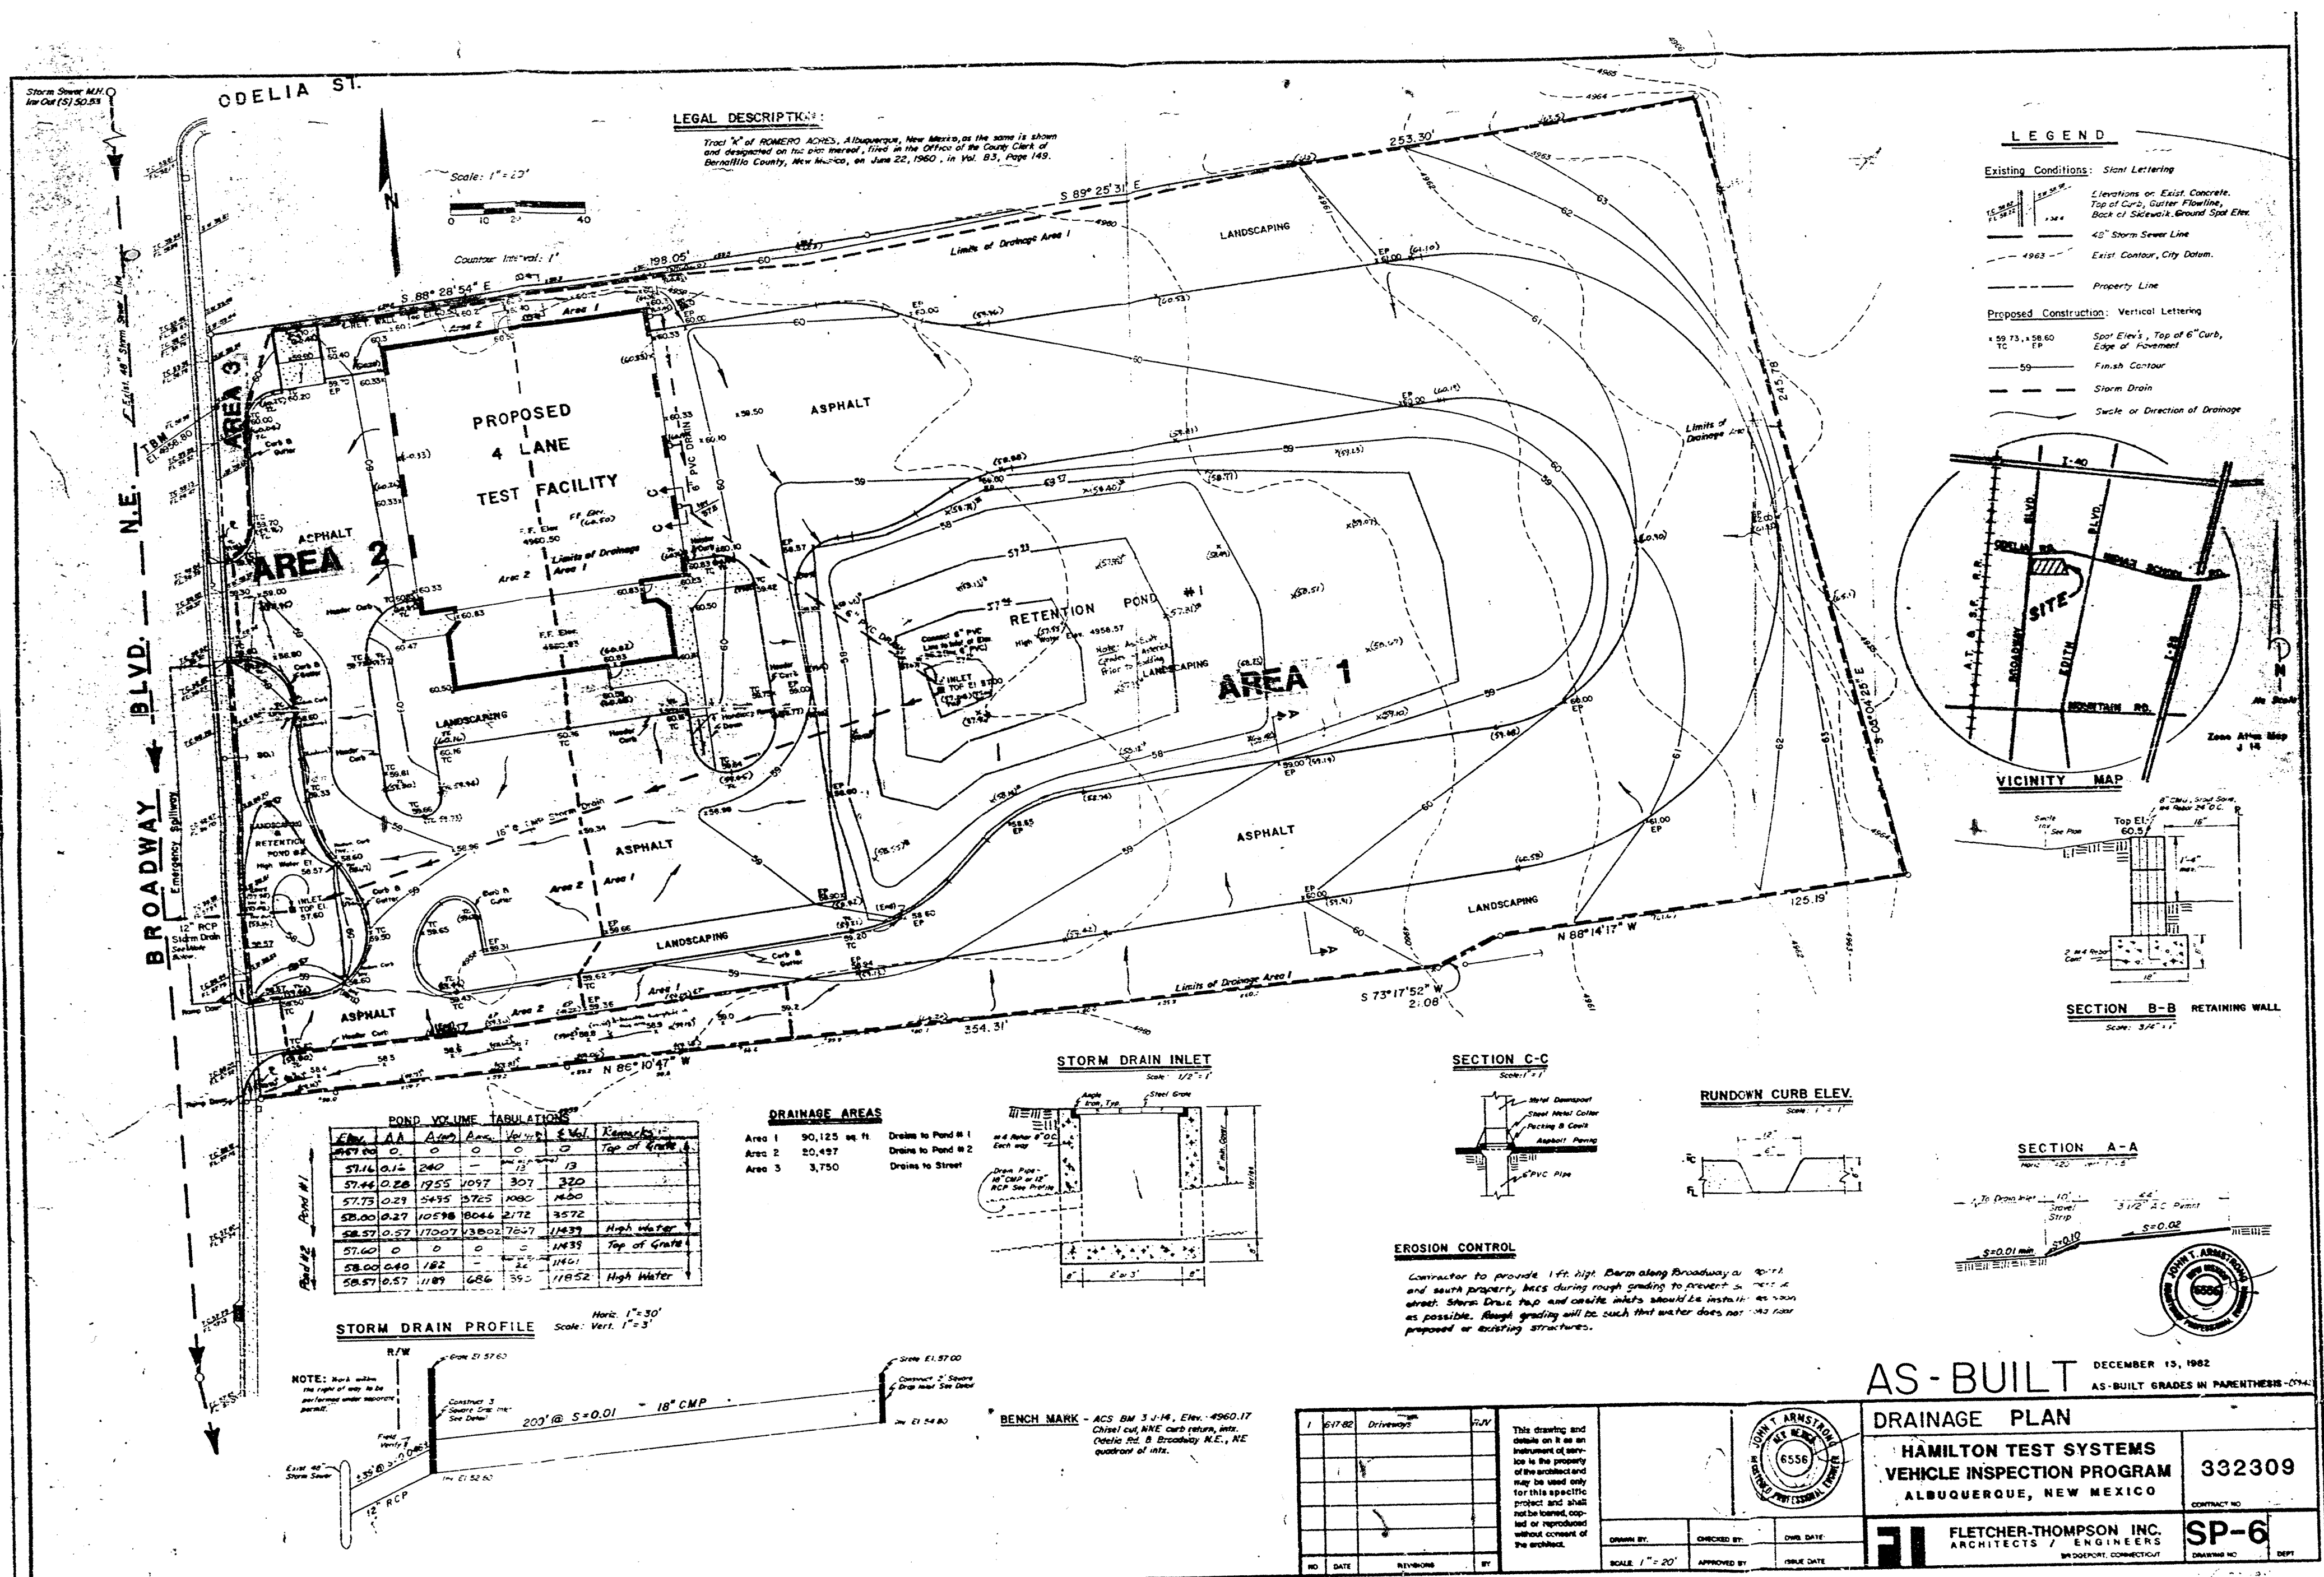

- LEGEND**
- Existing Conditions: Slant Lettering
- 15.00' 15.00' 15.00' Elevations on Exist. Concrete, Top of Curb, Gutter Flowline, Back of Sidewalk, Ground Spot Elev.
 - 40" Storm Sewer Line
 - 4963 - Exist. Contour, City Datum.
 - Property Line
- Proposed Construction: Vertical Lettering
- 59.73, 58.60 Spot Elev's, Top of 6" Curb, Edge of Pavement
 - 59 - Finish Contour
 - Storm Drain
 - Swale or Direction of Drainage

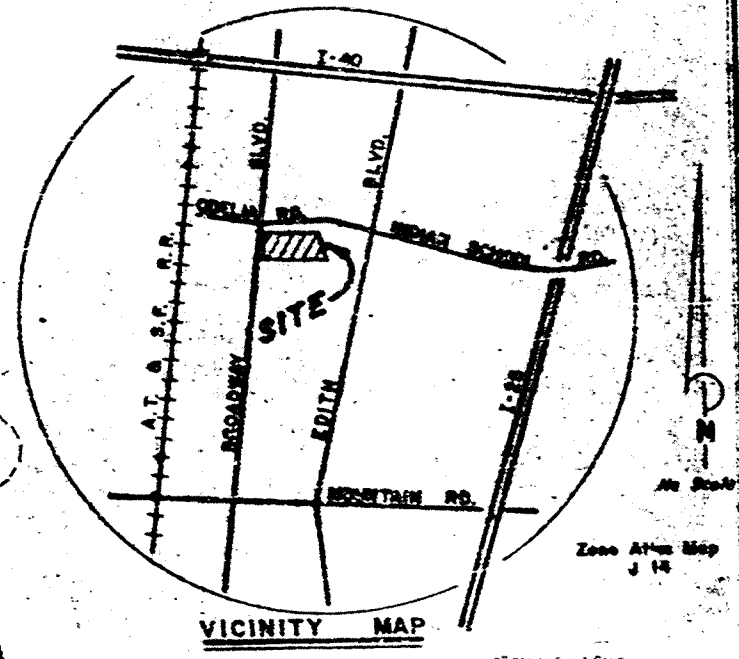


POND VOLUME TABULATIONS

Elev.	AA	Area	Area	Volume	Remarks
59.73	0.00	0	0	0	Top of Grade
59.74	0.16	240	0	13	
59.75	0.28	1955	1097	307	
59.76	0.29	5495	5765	1000	
59.77	0.27	10598	8044	2172	
59.78	0.27	17007	13802	7647	High water
59.79	0.27	17007	13802	7647	Top of Grade
59.80	0.27	17007	13802	7647	High water
59.81	0.27	17007	13802	7647	High water

DRAINAGE AREAS

Area	Area	Area	Area
Area 1	90,125 sq. ft.	Drains to Pond #1	
Area 2	20,497	Drains to Pond #2	
Area 3	3,750	Drains to Street	

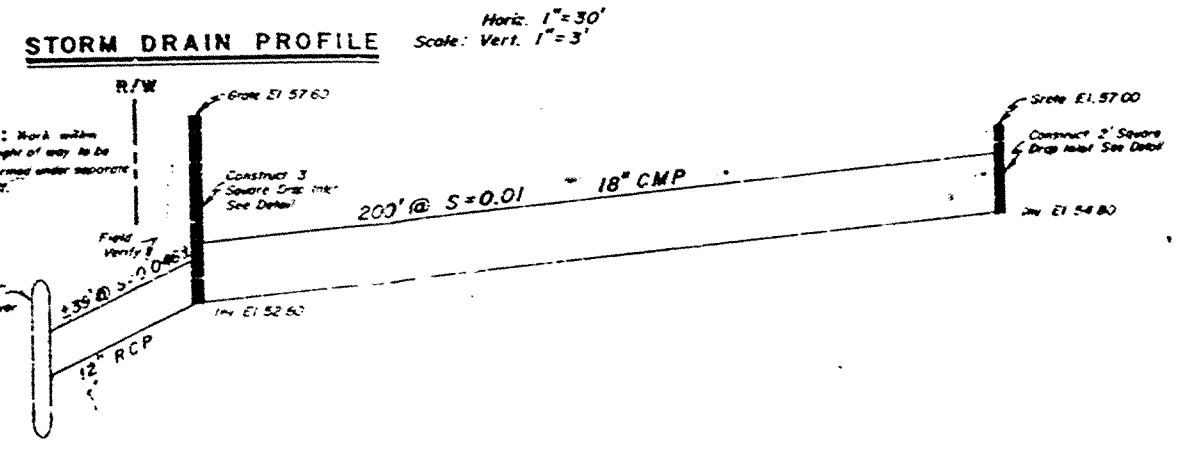

AS-BUILT DECEMBER 13, 1982 AS-BUILT GRADES IN PARENTHESES ONLY		DRAINAGE PLAN HAMILTON TEST SYSTEMS VEHICLE INSPECTION PROGRAM ALBUQUERQUE, NEW MEXICO		332309
SP-6		FLETCHER-THOMPSON INC. ARCHITECTS / ENGINEERS BRIDGEPORT, CONNECTICUT		SP-6

DRAWN BY: [] CHECKED BY: [] DATE: []
 SCALE: 1" = 20' APPROVED BY: [] DATE: []

This drawing and details on it as an instrument of service to the property of the architect and may be used only for this specific project and shall not be loaned, copied or reproduced without consent of the architect.