


(THIS AS-BUILT PLAN SUBSTANTIALLY
COMPLIES WITH THE APPROVED
GRADING & DRAINAGE PLAN.)




SCALE: 1"=20'

SYMBOL	NOTES	AS BUILT
PROPERTY LINE	---	---
CELESTIAL LINE	---	---
BUILDING	---	---
CURB & GUTTER	---	---
CONC. WALK	---	---
LIGHT POLE	---	---
FIRE HYDRANT	---	---
SPOT ELEVATION	---	---
CONTOUR	---	---



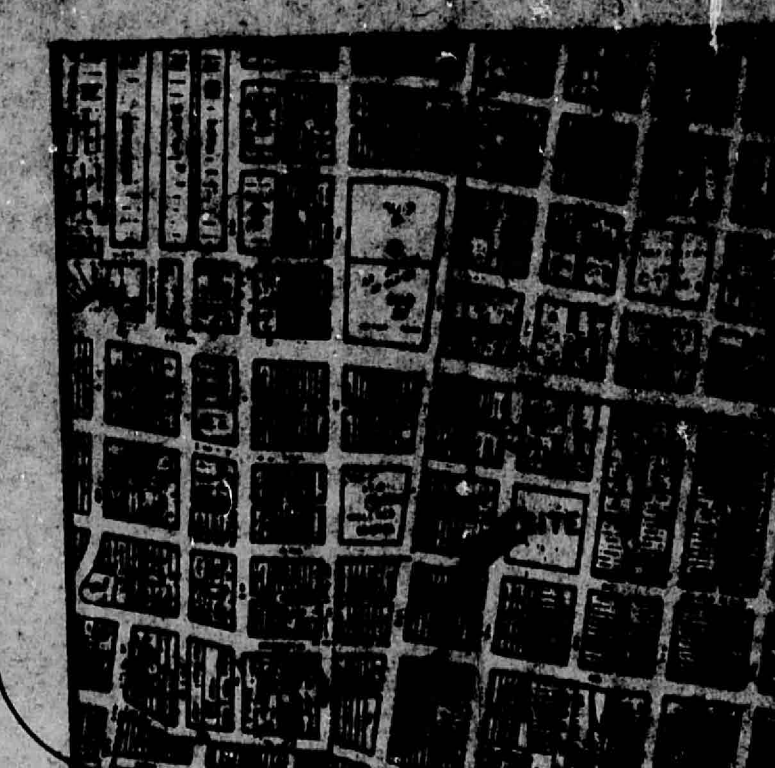


LOCATION MAP

J-14-2 FLOOD HAZARD BOUNDARY MAP

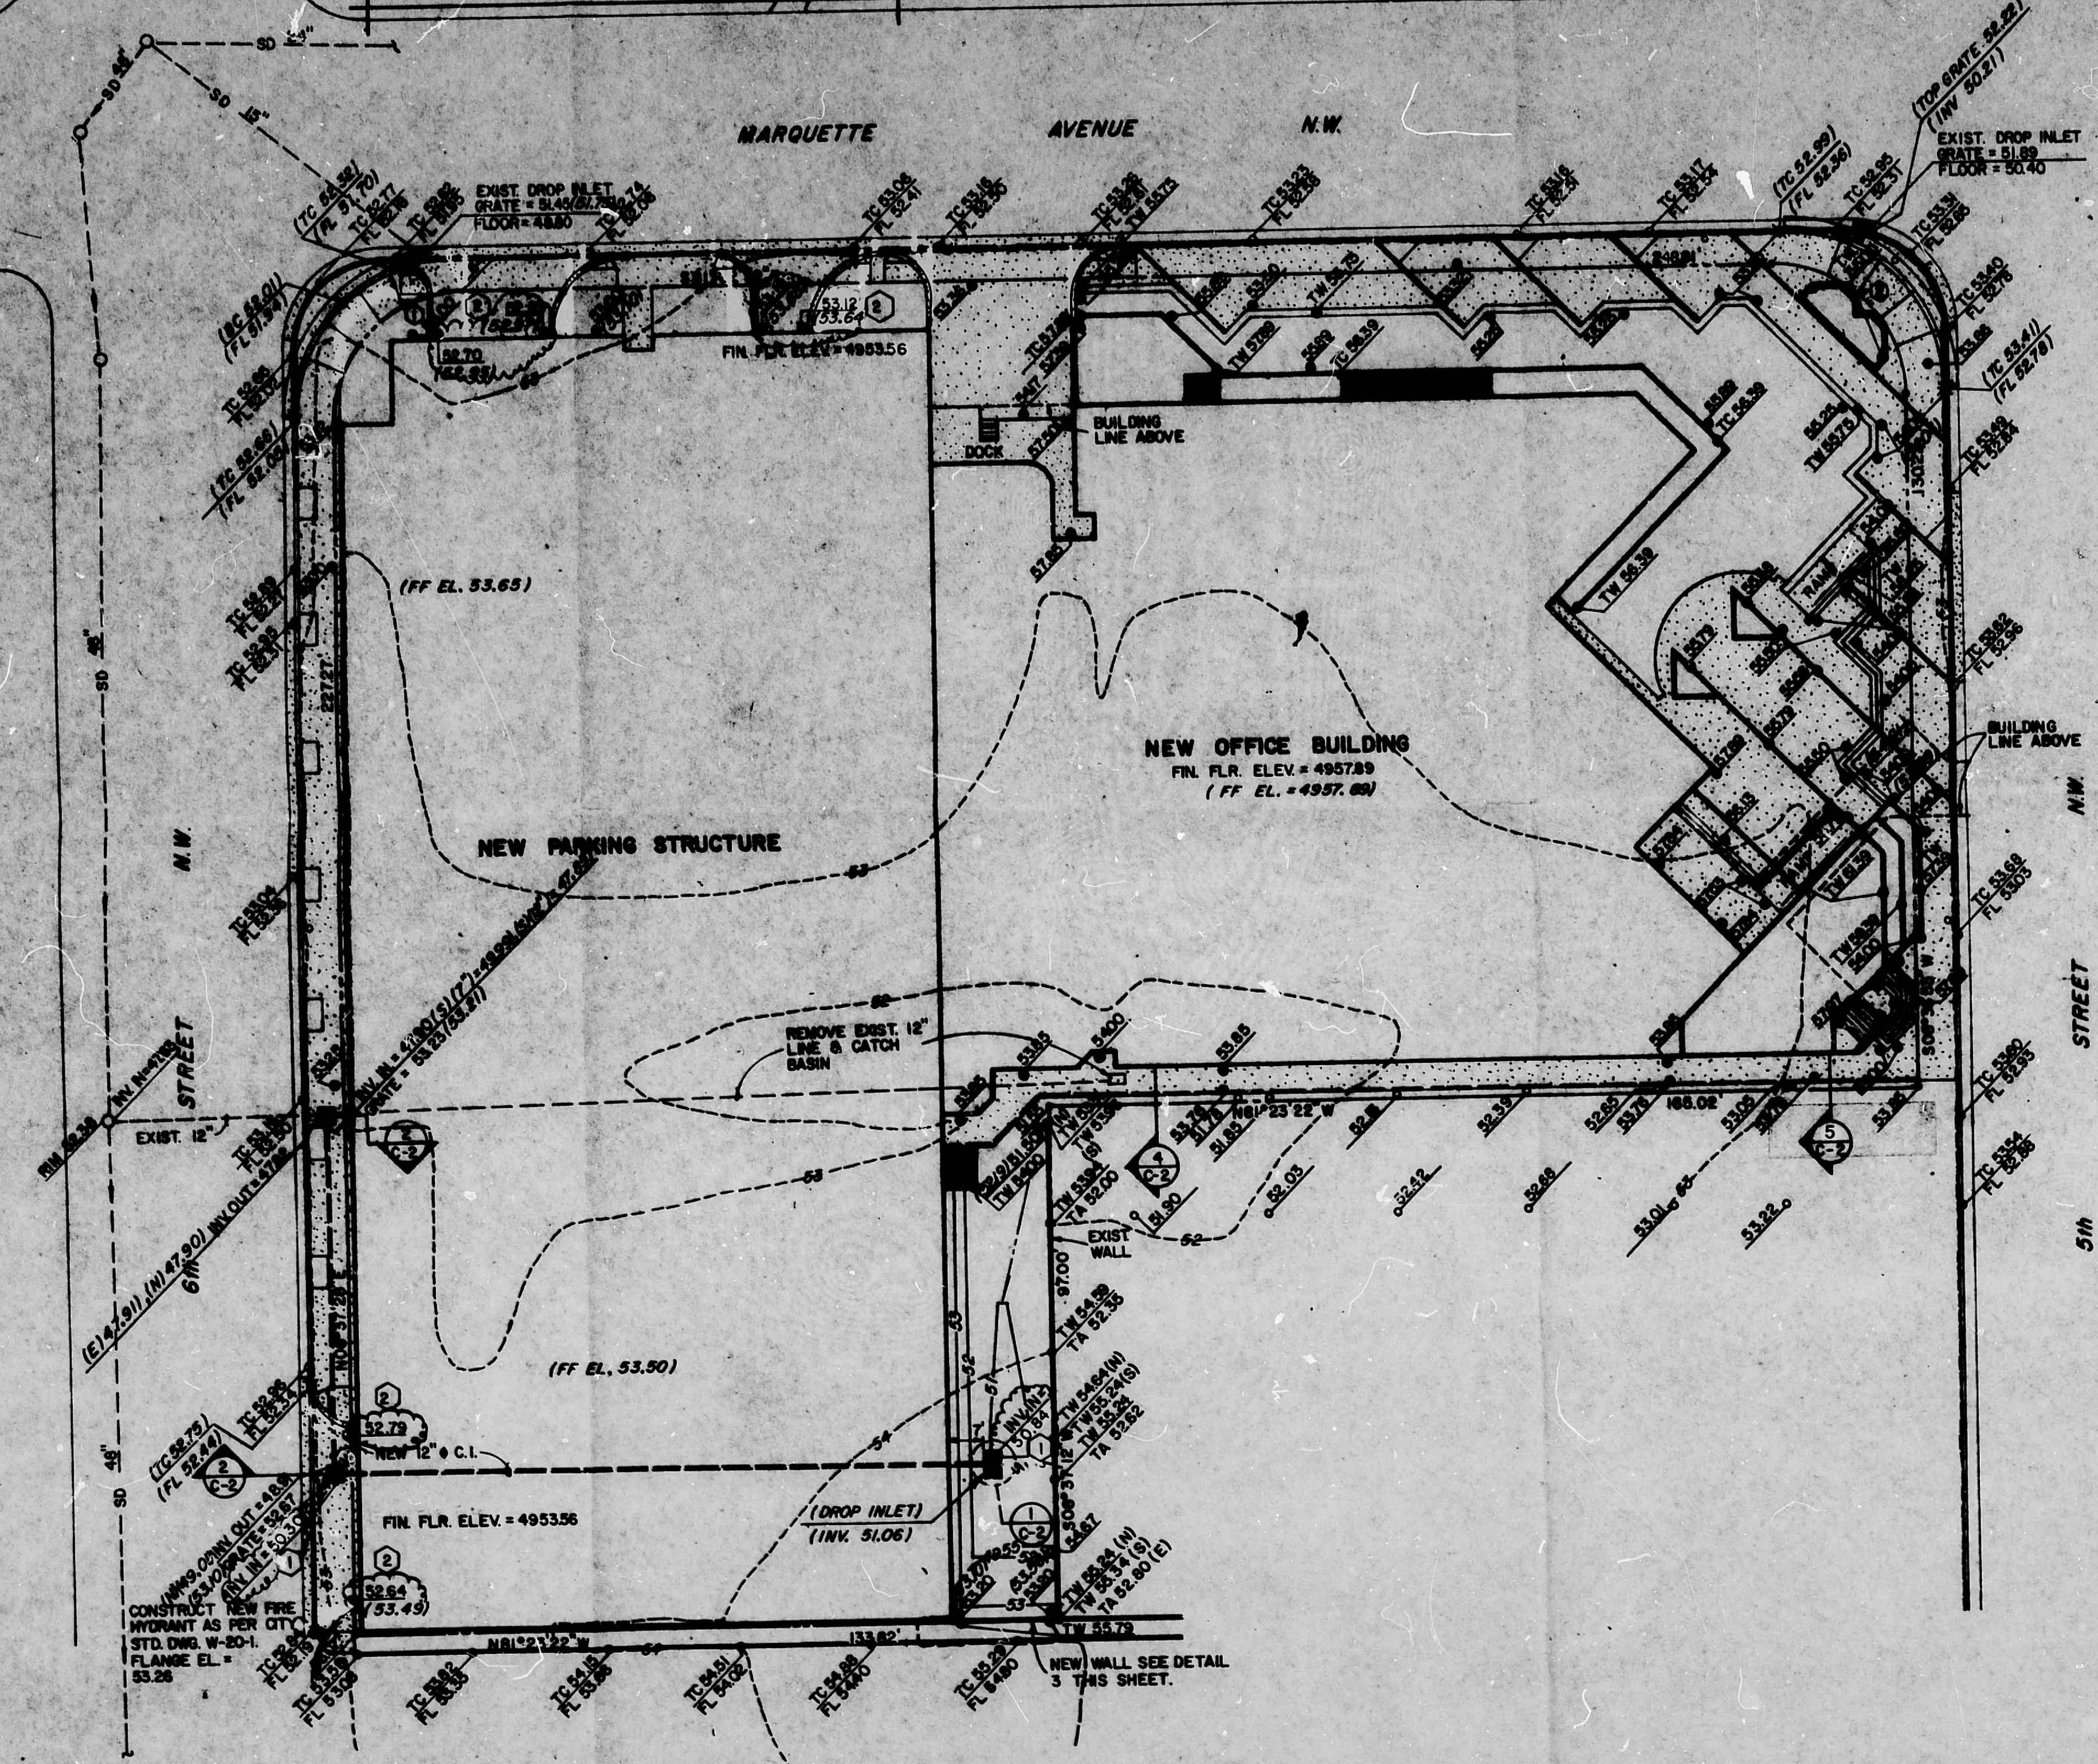

DRAINAGE PLAN

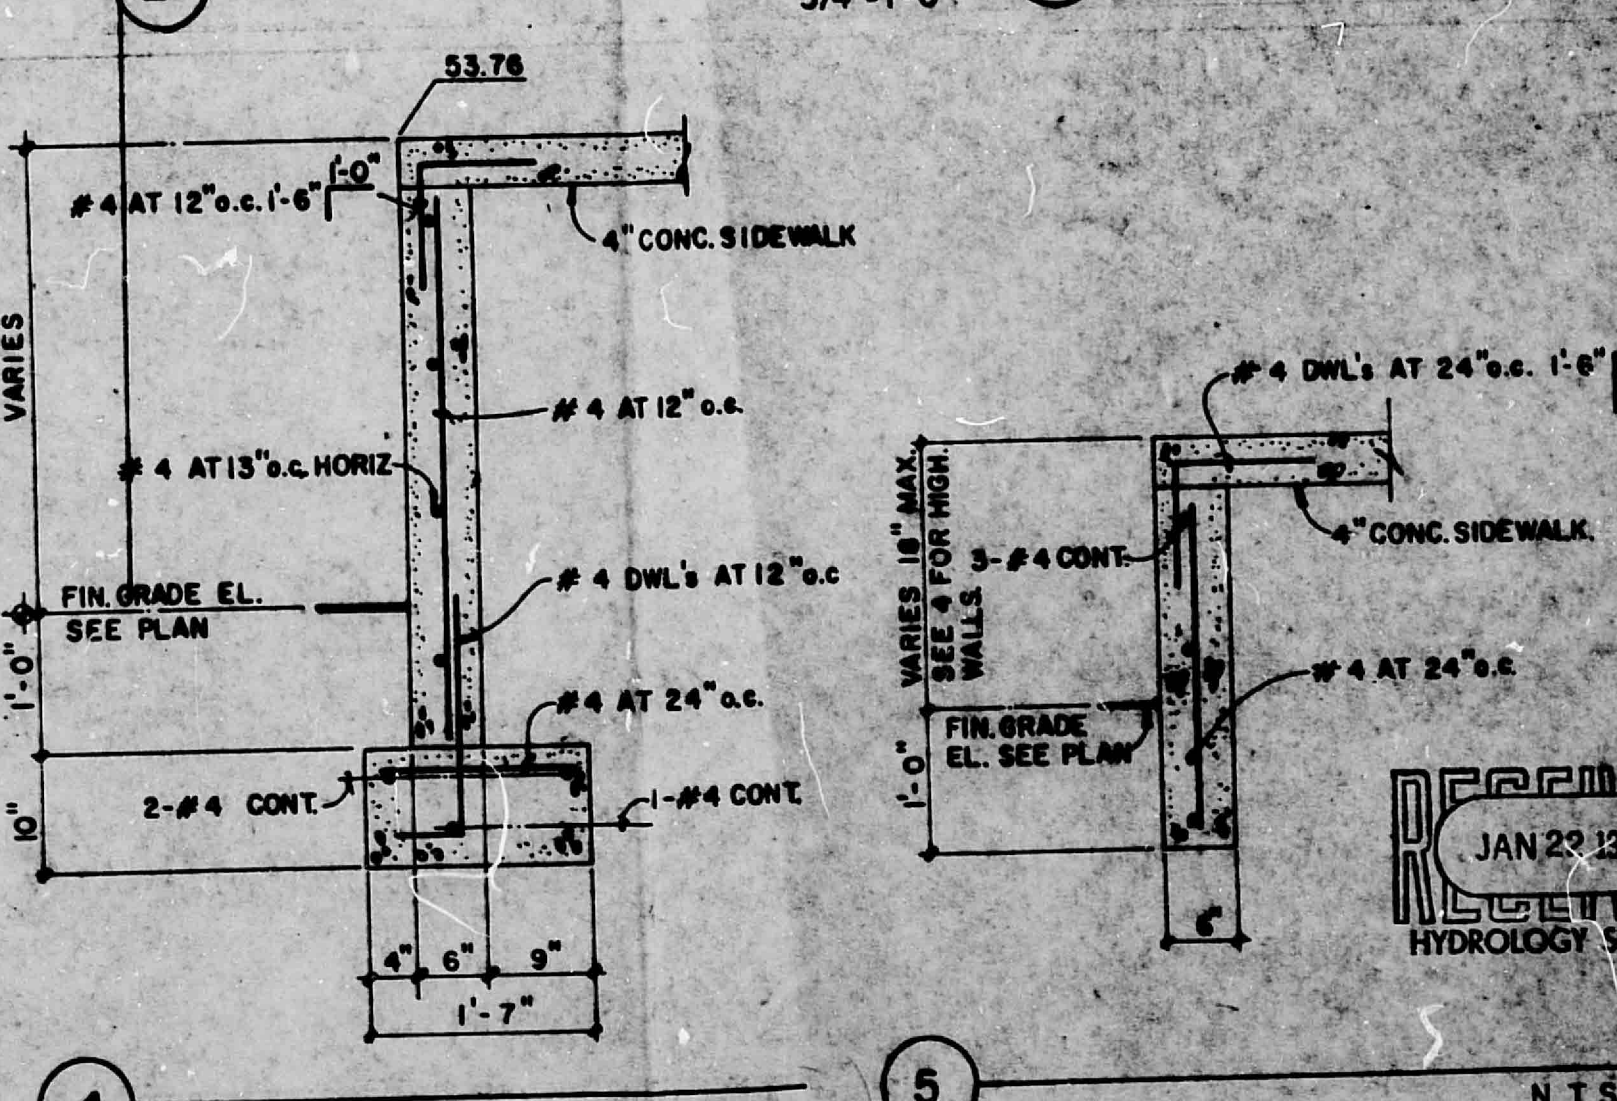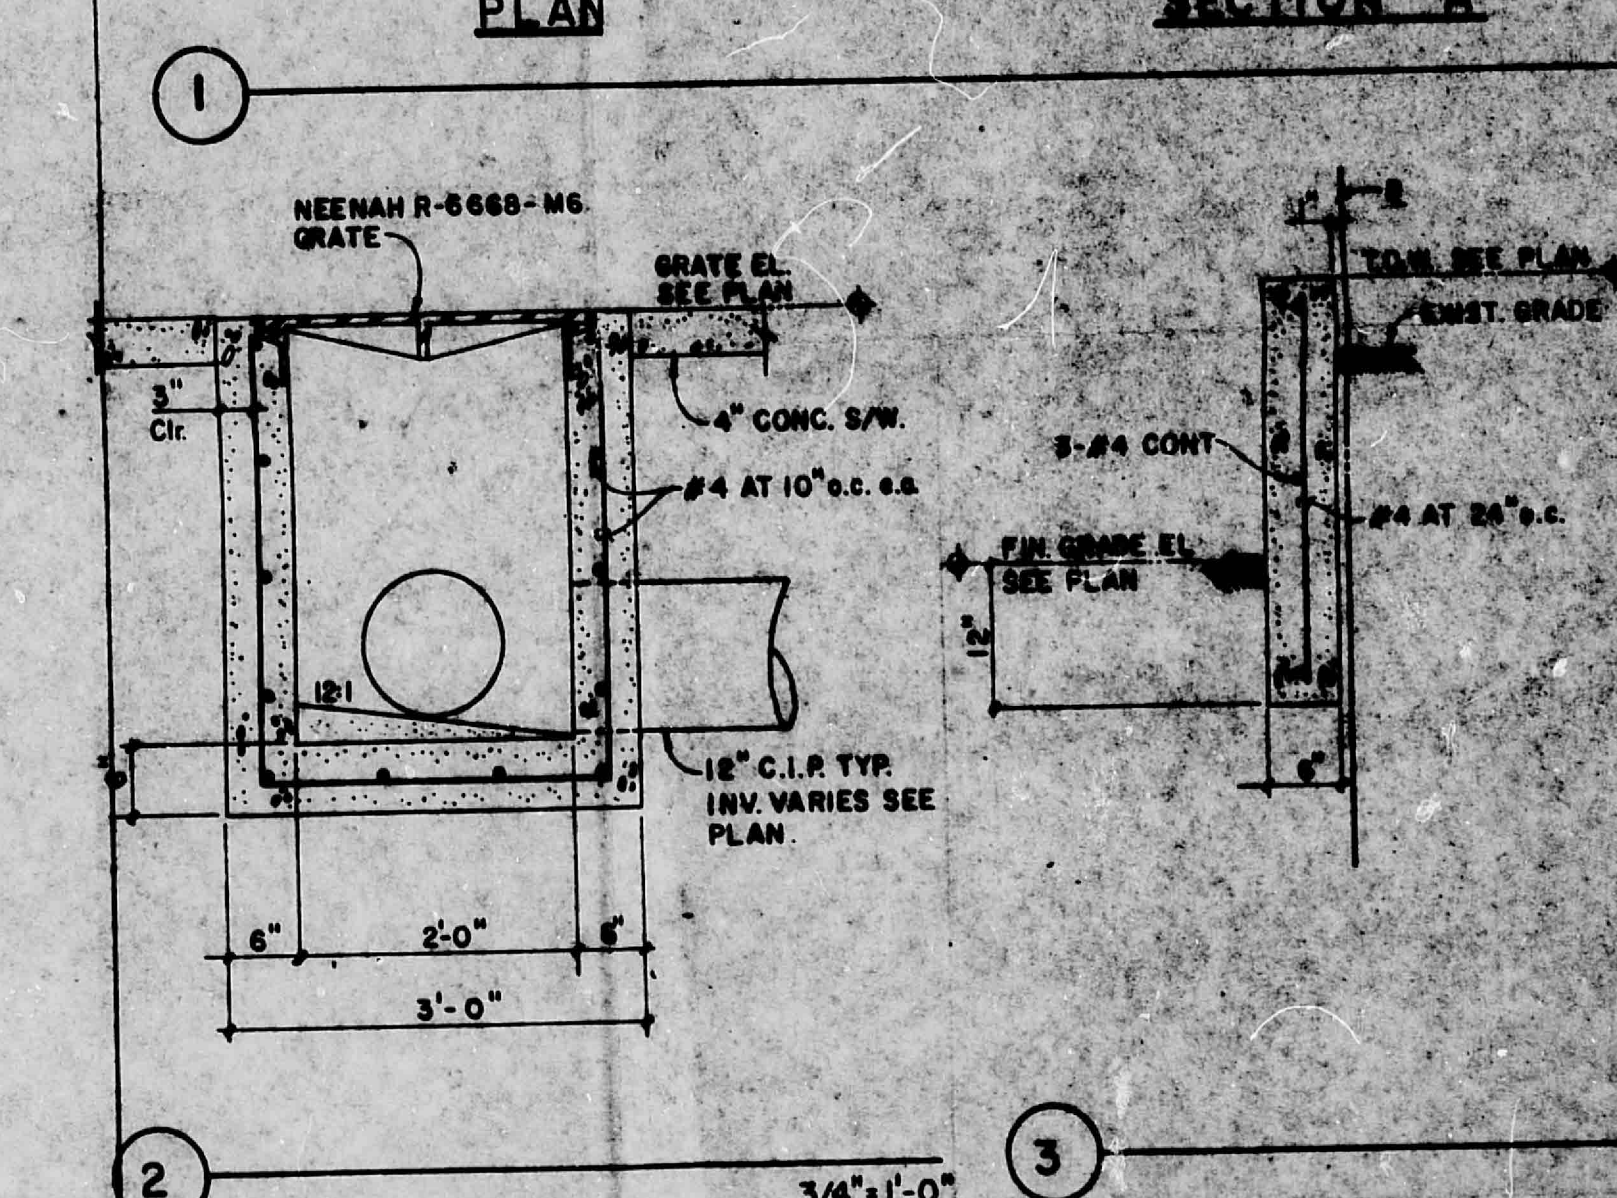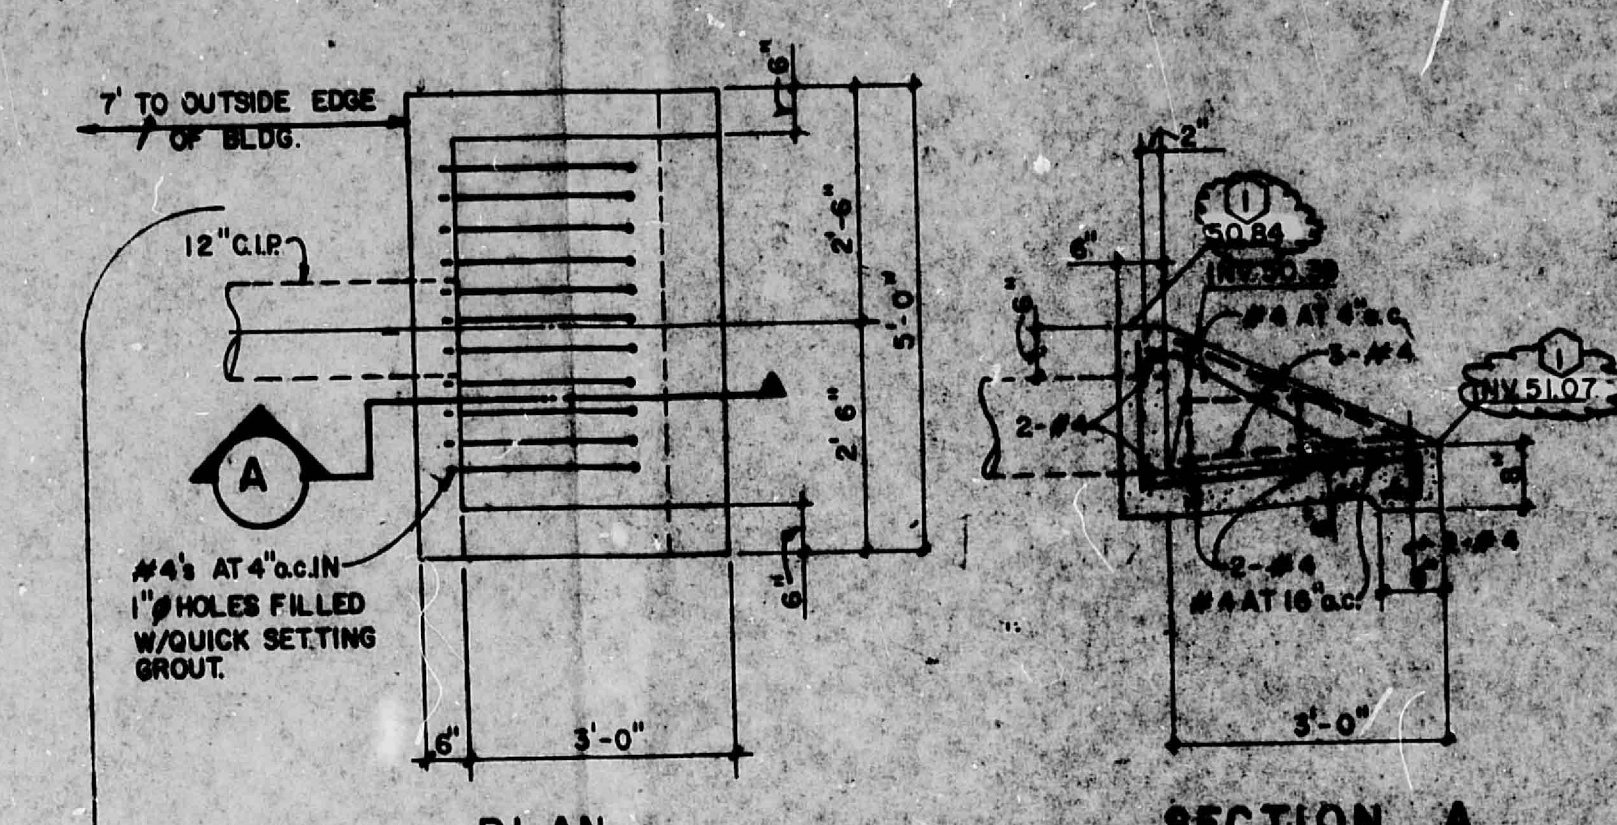

5TH & MARQUETTE
OFFICE BUILDING

JAN 23 1986
HYDROLOGY SECTION

J14/D44

C-2

2. 2000 FT. ELEV. IN INLET BLEV. AND
2000 FT. ELEV. IN BLEV. AND FIN.



Engineering Training

Design	
Drawn	LEA
Check	JRW
Scale	1" = 20'
	FLD. 05. 1604

GENERAL NOTES:

1. Utility easements, overhead of aves, private and community walls, driveways, steps and other improvements are not shown on this map.
2. BEARING BASIS: The recorded plat of THE NORTHWEST PORTION OF THE TIJERAS URBAN RENEWAL DISPOSITION BLOCK 9, filed Dec. 29, 1982 (220-132).
3. Bearings shown are New Mexico State Plane, distances shown are ground distances.
4. The purpose of this map is to show curb and gutter as-built elevations.

1. Jeryl Hart, Jr., New Mexico Registered Land Surveyor No. 7474, do hereby certify that this map has been compiled under my supervision from a survey actually made on the ground on December 19, 1985 and that the same is true and correct to the best of my knowledge and belief.

Jeryl Hart *VS/06*
Jeryl Hart, Jr. Date:
N.M.R.L.S. No. 7474

RECEIVED
JAN 21 1966
HYDROLOGY SECTION

Date 1-17-86
Job No. 204-0901

J14/D44

FIELD BOOK # 1684
PARTY CHIEF - P. TURNER

30357 CV 1 11 2011100