



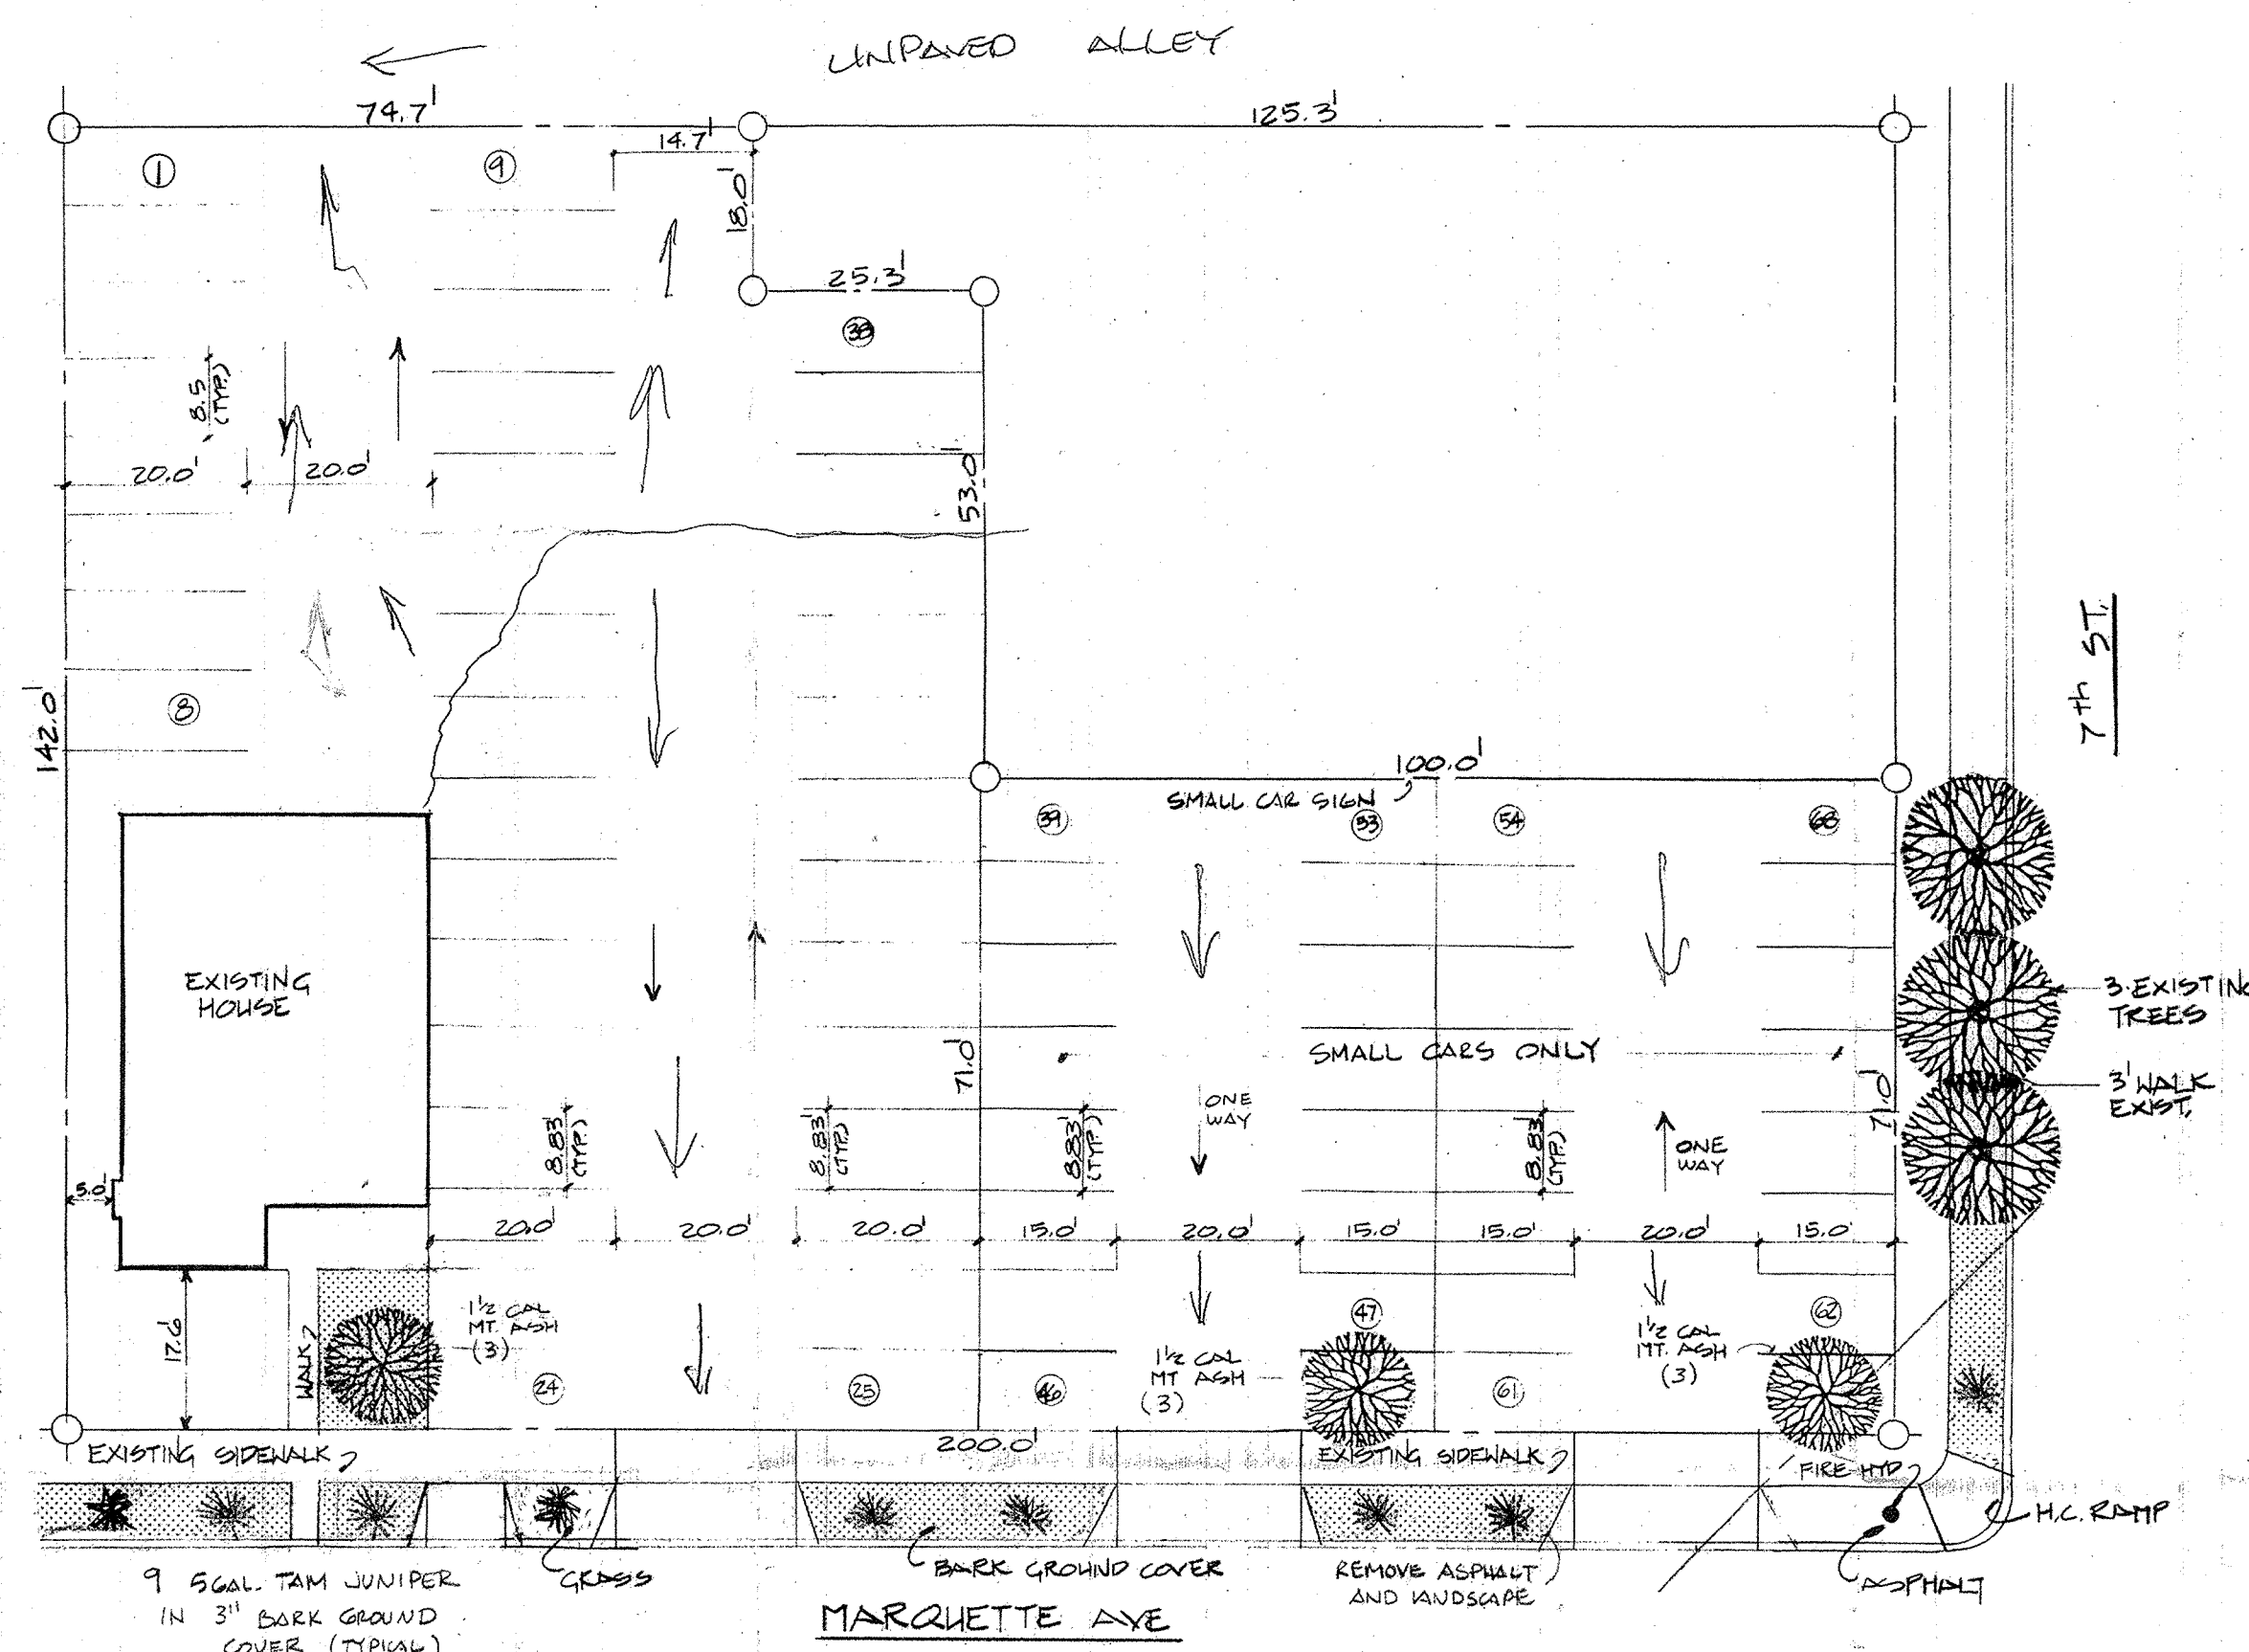

PROPERTY OF MR & MRS DAN CHAVEZ

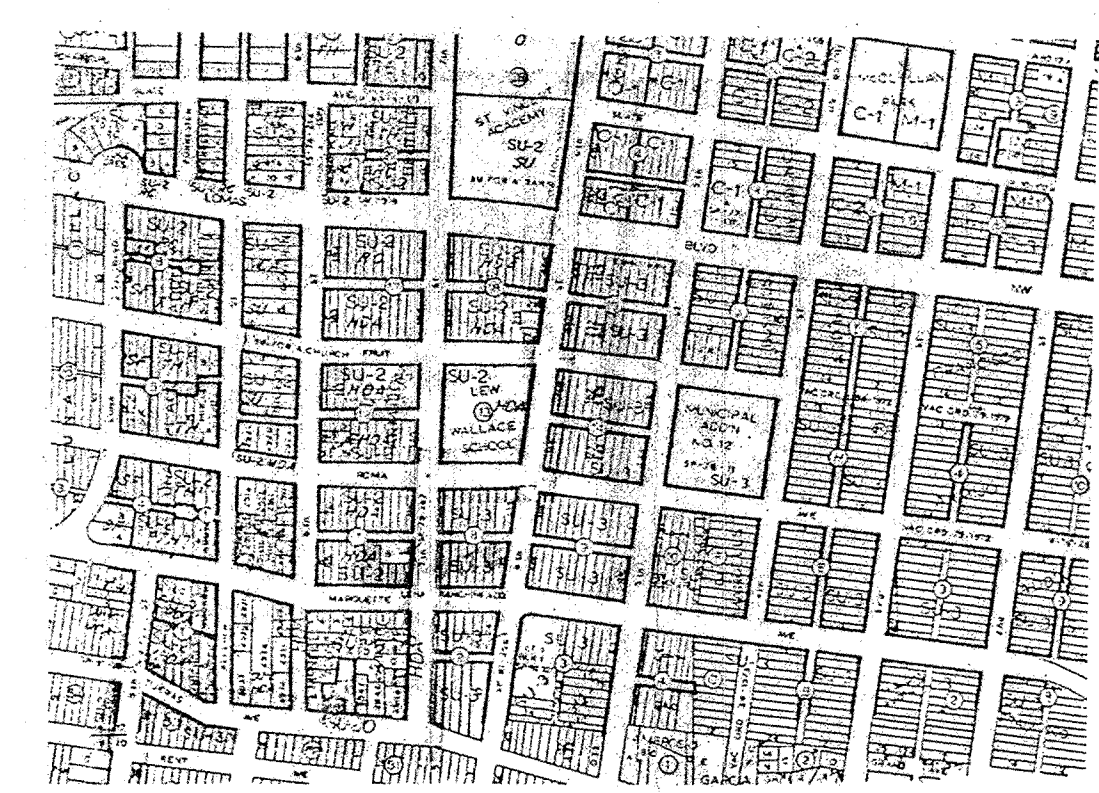

VICINITY MAP


J-14-Z

PAVED AREA	1718.1 #
PARKING	6
LANDSCAPING ON SITE	264 #
R.O.W.	1062 #
TOTAL	1326
7% REQUIRED	1202.8 #
ZONE	SH-2/HDA


LEGAL DESCRIPTION

LOTS 68 & 69, PARCEL A, OF THE REPLAT OF LOTS 70 & 71, THE SOUTH 1/2 OF LOTS 72 THRU 75 ALL IN BLOCK 7, ARMD ADDITION

RECEIVED
JUL 17 1987
HYDROLOGY SECTION

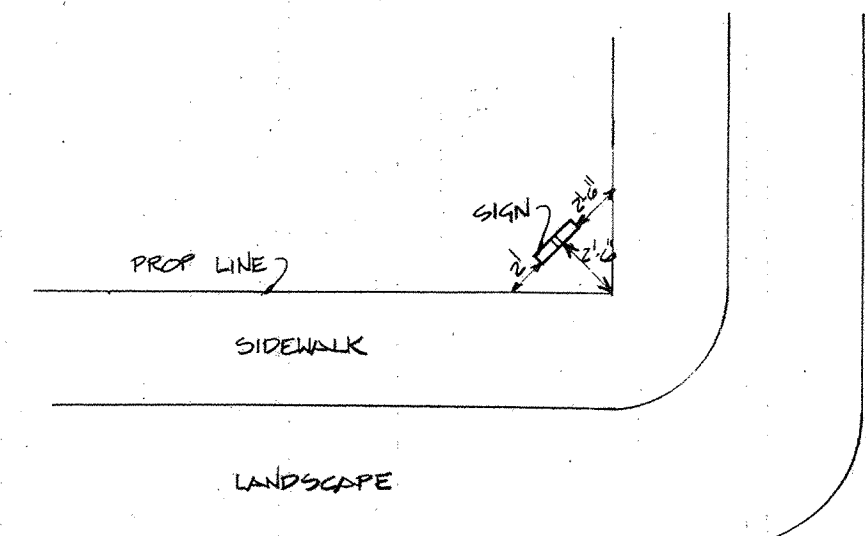

SIGN LOCATION 1"=10'-0"

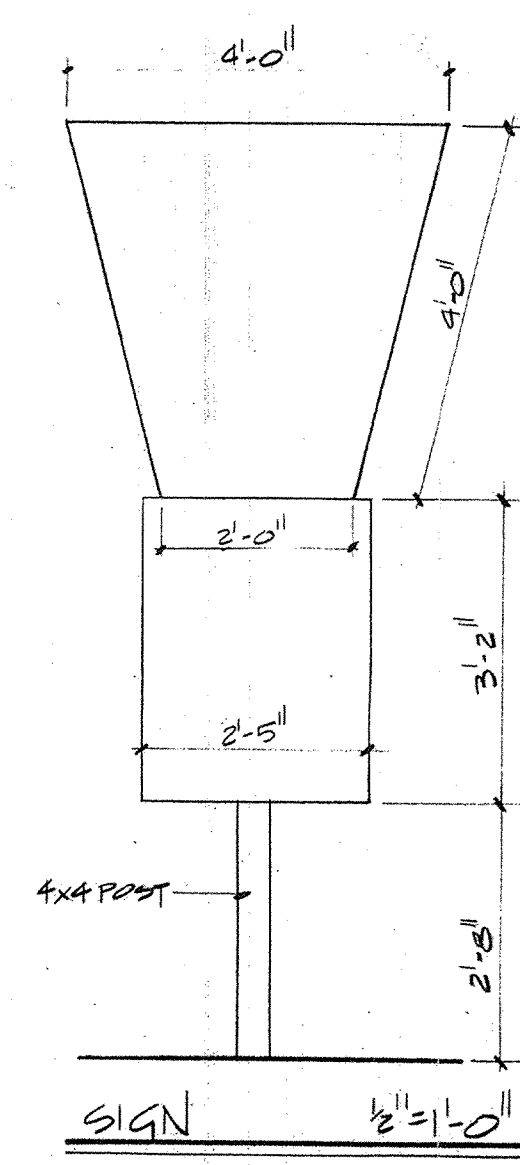

AS BUILT
7-1-87