

DRAINAGE PLAN

THE SUBJECT SITE IS LOCATED JUST NORTH AND WEST OF THE INTERSECTION OF BROADWAY BLVD. AND MOUNTAIN RD. AS SHOWN ON PANEL 28 OF THE FEDERAL EMERGENCY MANAGEMENT AGENCY FLOOD BOUNDARY AND FLOODWAY MAP, A PORTION OF THIS SITE IS WITHIN A DESIGNATED FLOOD HAZARD AREA. THE APPROXIMATE LIMITS OF THIS BOUNDARY ARE SHOWN ON THE SITE PLAN BELOW. THE IMPROVEMENTS TO THE SITE INCLUDE THE CONSTRUCTION OF OFFICE SPACE, WAREHOUSE SPACE, AND A VEHICLE MAINTENANCE BLDG. THE SITE CURRENTLY ACCEPTS STORM WATER FROM TWO LOCATIONS TO THE NORTH. FIRST, A PORTION OF THE PAVED AREA SHEET FLOWS TO THIS PROPERTY AND A ROOF DRAIN ALSO DISCHARGES TO THE SITE. THE PAVED AREA IS INCLUDED IN THE ONSITE CALCULATIONS. THE ROOF DRAIN IS SHOWN AS OFFSITE FLOWS. THE FLOW FROM THE ROOF DRAIN WAS ESTIMATED BY CALCULATING THE TOTAL BUILDING AREA AND THEN DIVIDING BY THE NUMBER OF ROOF DRAINS OBSERVED IN THE FIELD. (3 TOTAL DRAINS - 2 DRAIN TO THE NORTH AND 1 TO THE SUBJECT SITE).

THIS DRAINAGE PLAN INCLUDES THE DETENTION OF STORM WATERS WITH A INLET AND PUMP TO DISCHARGE RUNOFF TO THE EXISTING STORM SEWER SYSTEM IN ROSEMONT AND BROADWAY. THE VOLUME DETAINED IS WELL IN EXCESS OF THE 100-YR, 24-HR RUNOFF VOLUME. SEE SHEET 2 OF 2 FOR PUMP SYSTEM AND DISCHARGE DETAILS.

THE EXISTING TOPOGRAPHY WAS PREPARED FROM A SURVEY PERFORMED IN AUGUST 1995 BY RIO GRANDE SURVEYING. A SUBSEQUENT FIELD REVIEW BY THIS OFFICE REVEALED THAT ALL THE INFORMATION SHOWN HEREON IS CONSISTANT WITH THE ACTUAL FIELD CONDITIONS.

BENCH MARK

CITY OF ALBUQUERQUE CONTROL STATION 13-J14. A SQUARE CHISEL CUT ON TOP OF THE NNE CURB RETURN AT THE INTERSECTION OF ODELLA AND BROADWAY. ELEVATION = 4960.17

GENERAL LEGEND

EXISTING CONTOUR	61
PROPOSED CONTOUR	61
PROPOSED SPOT ELEVATION	56.4
FLOWLINE	→
FLOW DIRECTION ARROW	→
PROPOSED CONCRETE	—
TOP OF CURB ELEVATION	TC
TOP OF SIDEWALK ELEVATION	TSW
FLOWLINE ELEVATION	FL
TOP OF ASPHALT	TA
EXISTING SPOT ELEVATION	x 73.07
RECORD DRAWING ELEV.	x 57.60

THE FOLLOWING CALCULATIONS WERE DEVELOPED USING THE CITY OF ALBUQUERQUE DPM SECTION 22.2

THE SUBJECT PARCEL IS 4.53 AC. IN TOTAL THERE EXISTS A PAVED AREA OF 0.20 AC. TO THE NORTH THAT DRAINS TO THIS SITE. FOR SIMPLICITY THESE CALCULATIONS SHOW THIS AREA AS ONSITE WATERS. ADDITIONALLY, THERE EXISTS A ROOF DRAIN FROM THE BUILDING TO THE NORTH THAT DRAINS TO THIS PROPERTY. THIS ADDED FLOW IS SHOWN AS OFFSITE WATERS IN THE FOLLOWING CALCULATIONS. SEE DRAINAGE PLAN FOR FURTHER DISCUSSION OF THIS CONDITION.

SITE CHARACTERISTICS:
SITE LOCATION: ZONE 2
PRECIPITATION: P = 2.35 inches

LAND TREATMENT:
UNCOMPACTED SOIL - TREATMENT A
LANDSCAPE - TREATMENT B
COMPACTED SOIL - TREATMENT C
BUILDINGS & PAVING - TREATMENT D

EXCESS PRECIPITATION:
TREATMENT A E = 0.53 inches
TREATMENT B E = 0.78 inches
TREATMENT C E = 1.13 inches
TREATMENT D E = 2.12 inches

PEAK DISCHARGE:
TREATMENT A = 1.56 cfs/acre
TREATMENT B = 2.28 cfs/acre
TREATMENT C = 3.14 cfs/acre
TREATMENT D = 4.70 cfs/acre

GENERAL NOTES

- PRIOR TO ANY CONSTRUCTION, THE CONTRACTOR SHALL EXCAVATE AND VERIFY THE LOCATION OF ALL POTENTIAL OBSTRUCTIONS. SHOULD A CONFLICT EXIST, THE CONTRACTOR SHALL NOTIFY THE ENGINEER AS SOON AS POSSIBLE TO RESOLVE THE CONFLICT WITH A MINIMUM AMOUNT OF DELAY.
- ALL WORK ON THIS PLAN SHALL BE PERFORMED IN ACCORDANCE WITH APPLICABLE FEDERAL, STATE AND LOCAL LAWS, RULES AND REGULATIONS CONCERNING CONSTRUCTION SAFETY AND HEALTH.
- IF ANY UTILITY LINES, PIPELINES, OR UNDERGROUND UTILITY LINES ARE SHOWN ON THESE DRAWINGS, THEY ARE SHOWN IN AN APPROXIMATE LOCATION ONLY, AND LINES MAY EXIST WHERE NONE ARE SHOWN, THE LOCATION IS BASED UPON INFORMATION PROVIDED BY THE UTILITY OWNER OR FROM EXISTING PLANS, AND THIS INFORMATION MAY BE INCOMPLETE, OR OBSOLETE AT THE TIME OF CONSTRUCTION. THE ENGINEER HAS NOT UNDERTAKEN ANY FIELD VERIFICATION OF THESE LOCATIONS, LINE SIZES OR MATERIAL TYPE, MAKES NO REPRESENTATION THERETO, AND ASSUMES NO RESPONSIBILITY OR LIABILITY THEREFOR. THE CONTRACTOR SHALL INFORM ITSELF OF THE LOCATION OF ANY UTILITY LINE, PIPELINE OR UNDERGROUND INSTALLATION IN OR NEAR THE AREA IN ADVANCE OF AND DURING ANY EXCAVATION WORK. THE CONTRACTOR IS FULLY RESPONSIBLE FOR ANY AND ALL DAMAGES CAUSED BY ITS FAILURE TO LOCATE, IDENTIFY AND PRESERVE ANY AND ALL EXISTING UTILITIES, PIPELINES AND UNDERGROUND FACILITIES. IN PLANNING AND CONDUCTING EXCAVATIONS, THE CONTRACTOR SHALL COMPLY WITH ALL STATE STATUTES, MUNICIPAL AND LOCAL ORDINANCES, RULES AND REGULATIONS, IF ANY, PERTAINING TO THE LOCATION OF THESE LINES AND FACILITIES.
- THE CONTRACTOR SHALL INSURE THAT NO SOIL ERODES FROM THE SITE INTO PUBLIC RIGHTS-OF-WAY OR ONTO PRIVATE PROPERTY. THIS CAN BE ACHIEVED BY CONSTRUCTING TEMPORARY BERMS AND BY WETTING THE SOIL TO KEEP IT FROM BLOWING.
- THE CONTRACTOR SHALL OBTAIN ANY AND ALL PERMITS REQUIRED BY CITY OF ALBUQUERQUE FOR THE COMPLETION OF THE WORK PRIOR TO BEGINNING CONSTRUCTION.

	EXISTING	PROPOSED
TOTAL AREA	= 4.73 AC.	
TREATMENT A	= 0.00 AC. = 0.0%	0.00 AC. = 0.0%
TREATMENT B	= 0.00 AC. = 0.0%	0.14 AC. = 3.0%
TREATMENT C	= 3.96 AC. = 83.7%	2.88 AC. = 60.9%
TREATMENT D	= 0.77 AC. = 16.3%	1.71 AC. = 36.1%

ONSITE - EXCESS PRECIPITATION & VOLUMETRIC RUNOFF:

EXISTING RUNOFF:
WEIGHTED E = $[(0.53)(0.00) + (0.78)(0.00) + (1.13)(3.96) + (2.12)(0.77)] / 4.73$
= 1.29 inches

V100-6hr = $(1.29)(4.73) / 12 = 0.5085$ acre ft = 22,150 cf

DEVELOPED RUNOFF:

WEIGHTED E = $[(0.53)(0.00) + (0.78)(0.14) + (1.13)(2.88) + (2.12)(1.71)] / 4.73$
= 1.48 inches

V100-6hr = $(1.48)(4.73) / 12 = 0.5834$ acre ft = 25,420 cf

ONSITE - PEAK DISCHARGE:

EXISTING DISCHARGE:
Q100 = $(1.56)(0.00) + (2.28)(0.00) + (3.14)(3.96) + (4.70)(0.77) = 16.1$ cfs
DEVELOPED DISCHARGE:
Q100 = $(1.56)(0.00) + (2.28)(0.14) + (3.14)(2.88) + (4.70)(1.71) = 17.4$ cfs

RESULTS:

DEVELOPED VOLUMETRIC RUNOFF:
25,420 - 22,150 = 3,270 cf INCREASE IN RUNOFF VOLUME

DEVELOPED PEAK DISCHARGE:

17.4 - 16.1 = 1.3 cfs INCREASE IN PEAK DISCHARGE

OFFSITE - ROOF DRAIN FROM NORTH BLDG.

OFFSITE - PEAK DISCHARGE:
Q100 = $(4.70)(1.07) = 5.0$ cfs - 5.0/3 = 1.7 cfs

OFFSITE - EXCESS PRECIPITATION & VOLUMETRIC RUNOFF:

V100-6hr = $(2.12)(1.07) = 0.189$ - 0.189/3 = 0.063 acre-ft = 2,750 cf

DETENTION PONDING REQUIREMENTS:

ONSITE

V100-24hr = $0.5834 + (1.71)(2.75-2.35) / 12 = 0.6404$ acre-ft

OFFSITE

V100-24hr = $0.189 + (1.07)(2.75-2.35) / 12 = 0.2247 / 3 = 0.0749$ acre-ft

TOTAL POND REQUIRED = 0.6404 + 0.0749 = 0.7153 acre-ft = 31,160 cf

LEGAL DESCRIPTION


PARCEL A-1-A-1 LANDS OF SPRINGER CORPORATION LYING SITUATE WITHIN SECTION 17, T.10 N., R. 3 E., N.M.P.M. BERNALILLO COUNTY, NEW MEXICO. FILED OCTOBER 11, 1991 AT THE OFFICE OF THE COUNTY CLERK, BERNALILLO COUNTY, NEW MEXICO.

THE SITE IS IN SUBSTANTIAL COMPLIANCE WITH THE APPROVED GRADING AND DRAINAGE PLAN WITH ENGINEER'S SEAL DATED 9/29/95 (WITH THE MINOR REVISIONS AS REFLECTED IN THE RECORD DRAWING ELEVATIONS SHOWN HEREON). THE SITE DRAINAGE WILL FUNCTION AS ORIGINALLY PROPOSED.


RECORD DRAWING

DATE: 5-1-96

ADJUST VALVE BOXES AS REQ'D TO MATCH NEW ASPHALT ELEV.

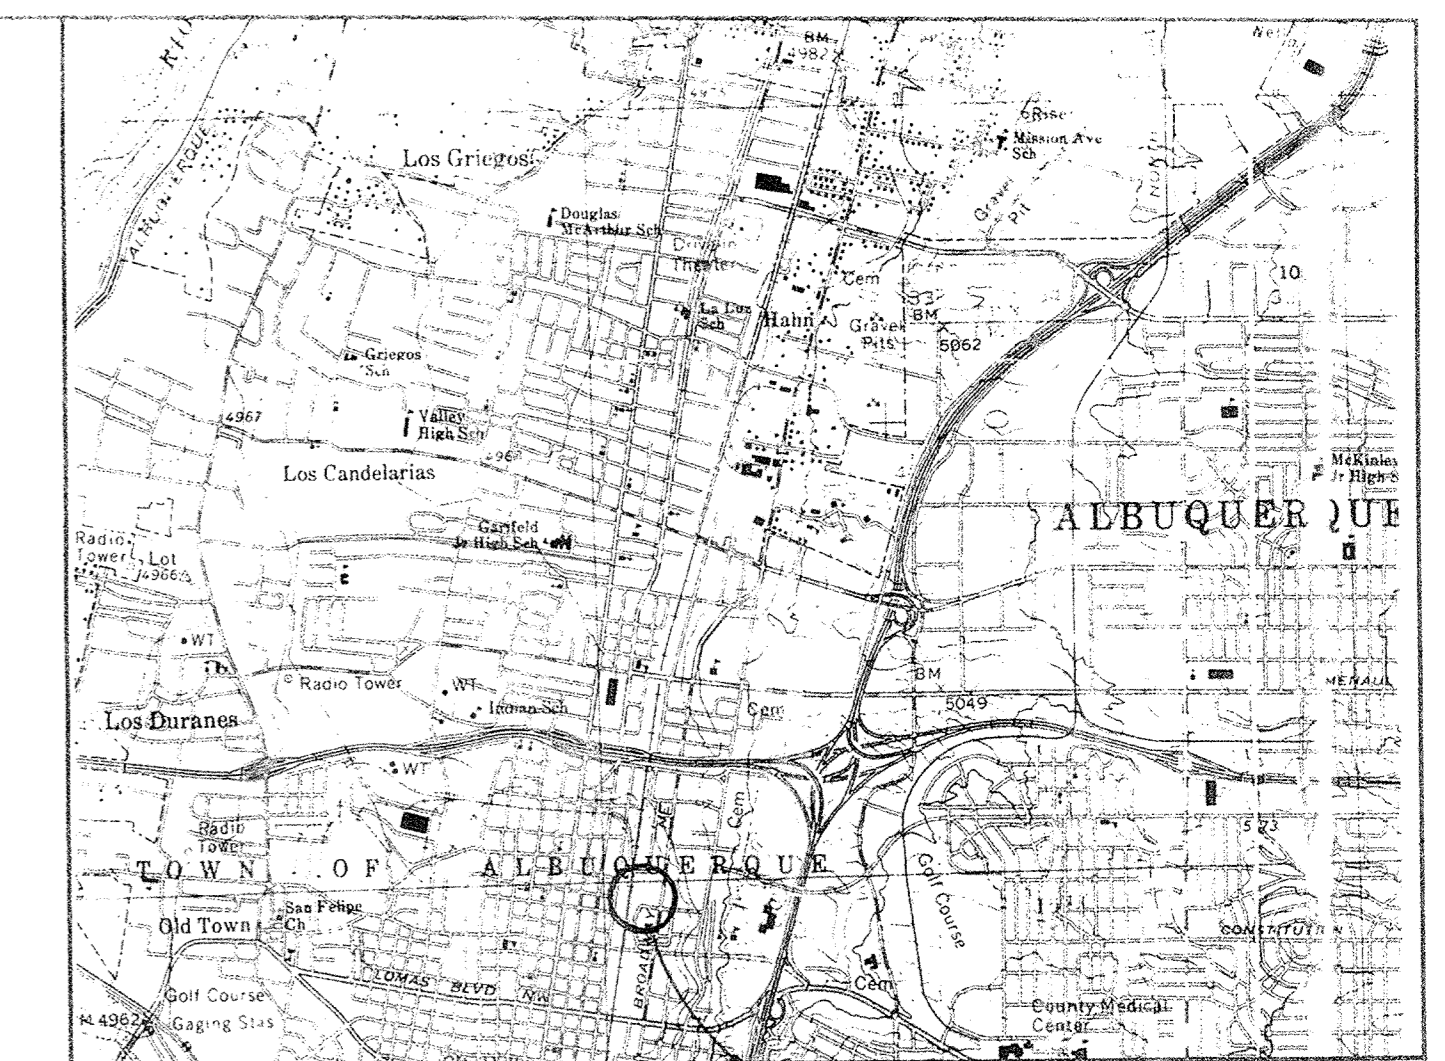

LOCATION MAP PROJECT LOCATION

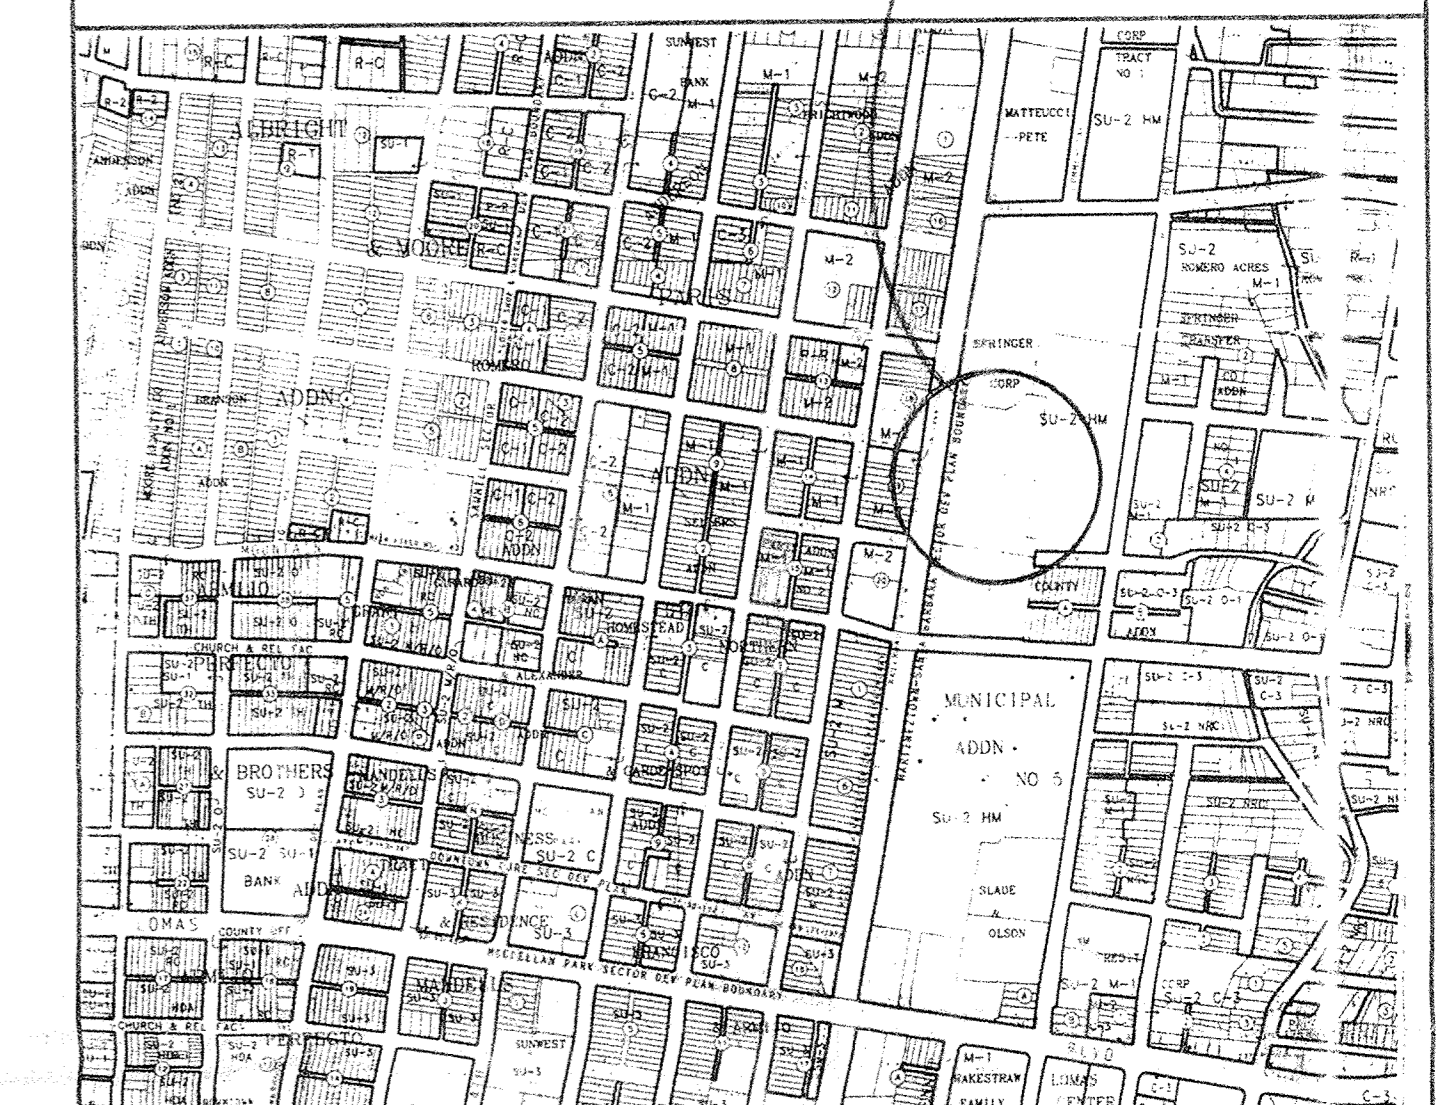

ZONE MAP J-14



FLOOD BOUNDARY MAP PROJECT LOCATION

ALBUQUERQUE MAIL SERVICE
GRADING AND DRAINAGE PLAN

KEMPER-VAUGHAN
CONSULTING ENGINEERS

3700 CUROS RD. N.W. • ALBUQUERQUE, NEW MEXICO 87120 • (505) 831-4520

Designed KRK Drawn SE Checked KRK Sheet 1 of 2

Date SEPTEMBER 1995