

N.T.S. LOCATION MAP J-14-Z

LEGEND

- 8" SS EXISTING 8" SANITARY SEWER
- 8" W EXISTING 8" WATERLINE
- 6" W EXISTING 6" WATERLINE
- 12" S EXISTING 12" STORM SEWER
- 10" S EXISTING 10" STORM SEWER
- 57.5 EXISTING CONTOUR LINE
- 57.5 PROPOSED CONTOUR LINE
- TC 57.48' FL 56.87' EXISTING ELEVATION TOP OF CURB & FLOW LINE
- EXISTING FIRE HYDRANT
- EXISTING SPOT ELEVATION
- TA 57.62 PROPOSED ELEVATION, TOP OF ASPHALT
- TS 57.62 PROPOSED ELEVATION, TOP OF SIDEWALK
- TD 57.83 PROPOSED ELEVATION, TOP OF DRIVEPAD
- TG 45.00 LANDSCAPED AREA
- PROPOSED ELEVATION, TOP OF GRATE
- EXISTING MANHOLE
- EXISTING DOWNSPOUT
- EXISTING POWER POLE
- 47.74 AS-BUILT ELEVATION

BENCHMARK: ACS MON. 23-J-14 ELEVATION 4957.94 (MSLD 1929)




T.B.M.: WEST END, NORTHWEST CURB RETURN
TOP OF CURB ELEVATION 57.94

NOTE:

- THIS IS NOT A BOUNDARY SURVEY. PROPERTY CORNERS, BEARINGS AND DISTANCES SHOWN HEREON ARE FOR ORIENTATION PURPOSES ONLY.
- UNDERGROUND UTILITIES SHOWN HEREON ARE BASED ON MAPS AND/OR EVIDENCES ON THE GROUND. THE CONTRACTOR SHALL BE RESPONSIBLE FOR VERIFYING LOCATIONS OF ALL UTILITIES, SHOWN OR NOT SHOWN ON THIS DRAWING, PRIOR TO ANY EXCAVATIONS.
- CONTRACTOR IS RESPONSIBLE FOR OBTAINING A TOPSOIL DISTURBANCE PERMIT PRIOR TO BEGINNING WORK.
- CONTRACTOR IS RESPONSIBLE FOR KEEPING RUN-OFF ON SITE DURING CONSTRUCTION AND CLEANING UP SEDIMENT THAT GETS INTO EXISTING RIGHT-OF-WAY AND ADJOINING PROPERTIES AFTER CONSTRUCTION.
- MEDIAN CURB AND GUTTER PER CITY STANDARD DRAWING #2415.

CONSTRUCTION NOTE:




- (A) BUILD STANDARD DRIVEPAD.
- (B) BUILD CATCH BASIN, PER DETAIL A, THIS SHEET.

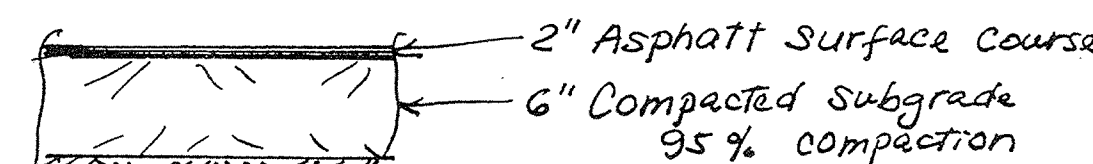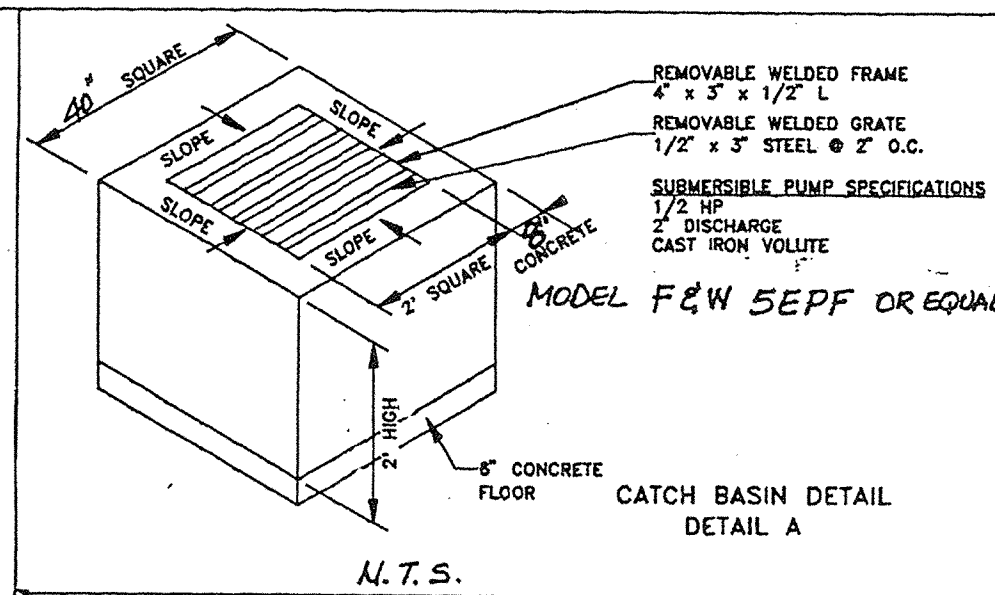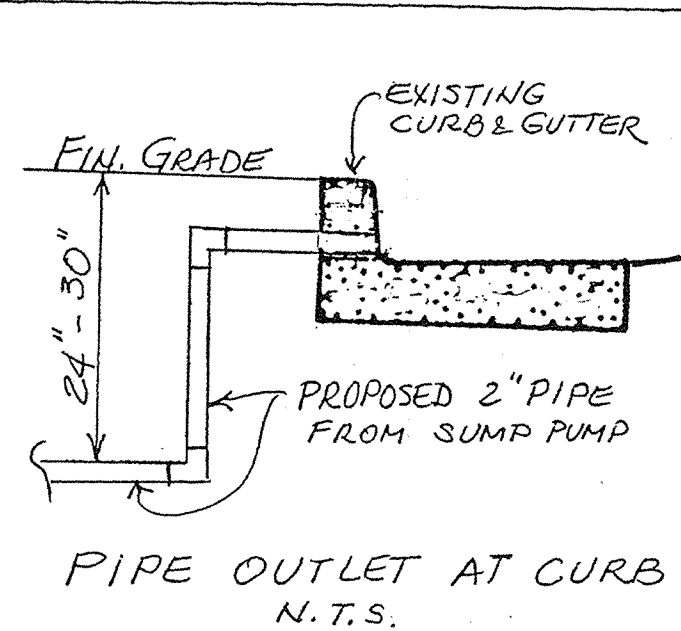

PROPOSED PAVING SECTION
N.T.S.

NOTICE TO CONTRACTOR:

- AN EXCAVATION/CONSTRUCTION PERMIT WILL BE REQUIRED BEFORE BEGINNING ANY WORK WITHIN CITY RIGHT-OF-WAY. AN APPROVED COPY OF THIS PLAN MUST BE SUBMITTED AT THE TIME OF APPLICATION FOR THIS PERMIT.
- ALL WORK DETAILED ON THIS PLAN TO BE PERFORMED, EXCEPT AS OTHERWISE STATED OR PROVIDED HEREON, SHALL BE CONSTRUCTED IN ACCORDANCE WITH CITY OF ALBUQUERQUE INTERIM STANDARD SPECIFICATIONS FOR PUBLIC WORKS CONSTRUCTION, 1985.
- TWO WORKING DAYS PRIOR TO ANY EXCAVATION, CONTRACTOR MUST CONTACT LINE LOCATING SERVICE, 765-1234, FOR LOCATION OF EXISTING UTILITIES.
- PRIOR TO CONSTRUCTION, THE CONTRACTOR SHALL EXCAVATE AND VERIFY THE HORIZONTAL AND VERTICAL LOCATIONS OF ALL CONSTRUCTIONS. SHOULD A CONFLICT EXIST, THE CONTRACTOR SHALL NOTIFY THE ENGINEER SO THAT THE CONFLICT CAN BE RESOLVED WITH A MINIMUM AMOUNT OF DELAY.
- BACKFILL COMPACTION SHALL BE ACCORDING TO COMMERCIAL STREET USE.
- MAINTENANCE OF THESE FACILITIES SHALL BE THE RESPONSIBILITY OF THE OWNER OF THE PROPERTY SERVED.

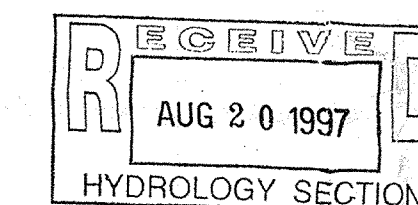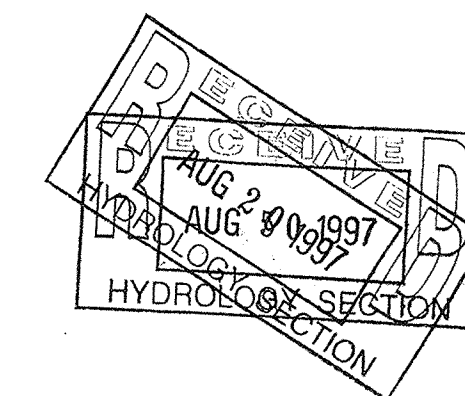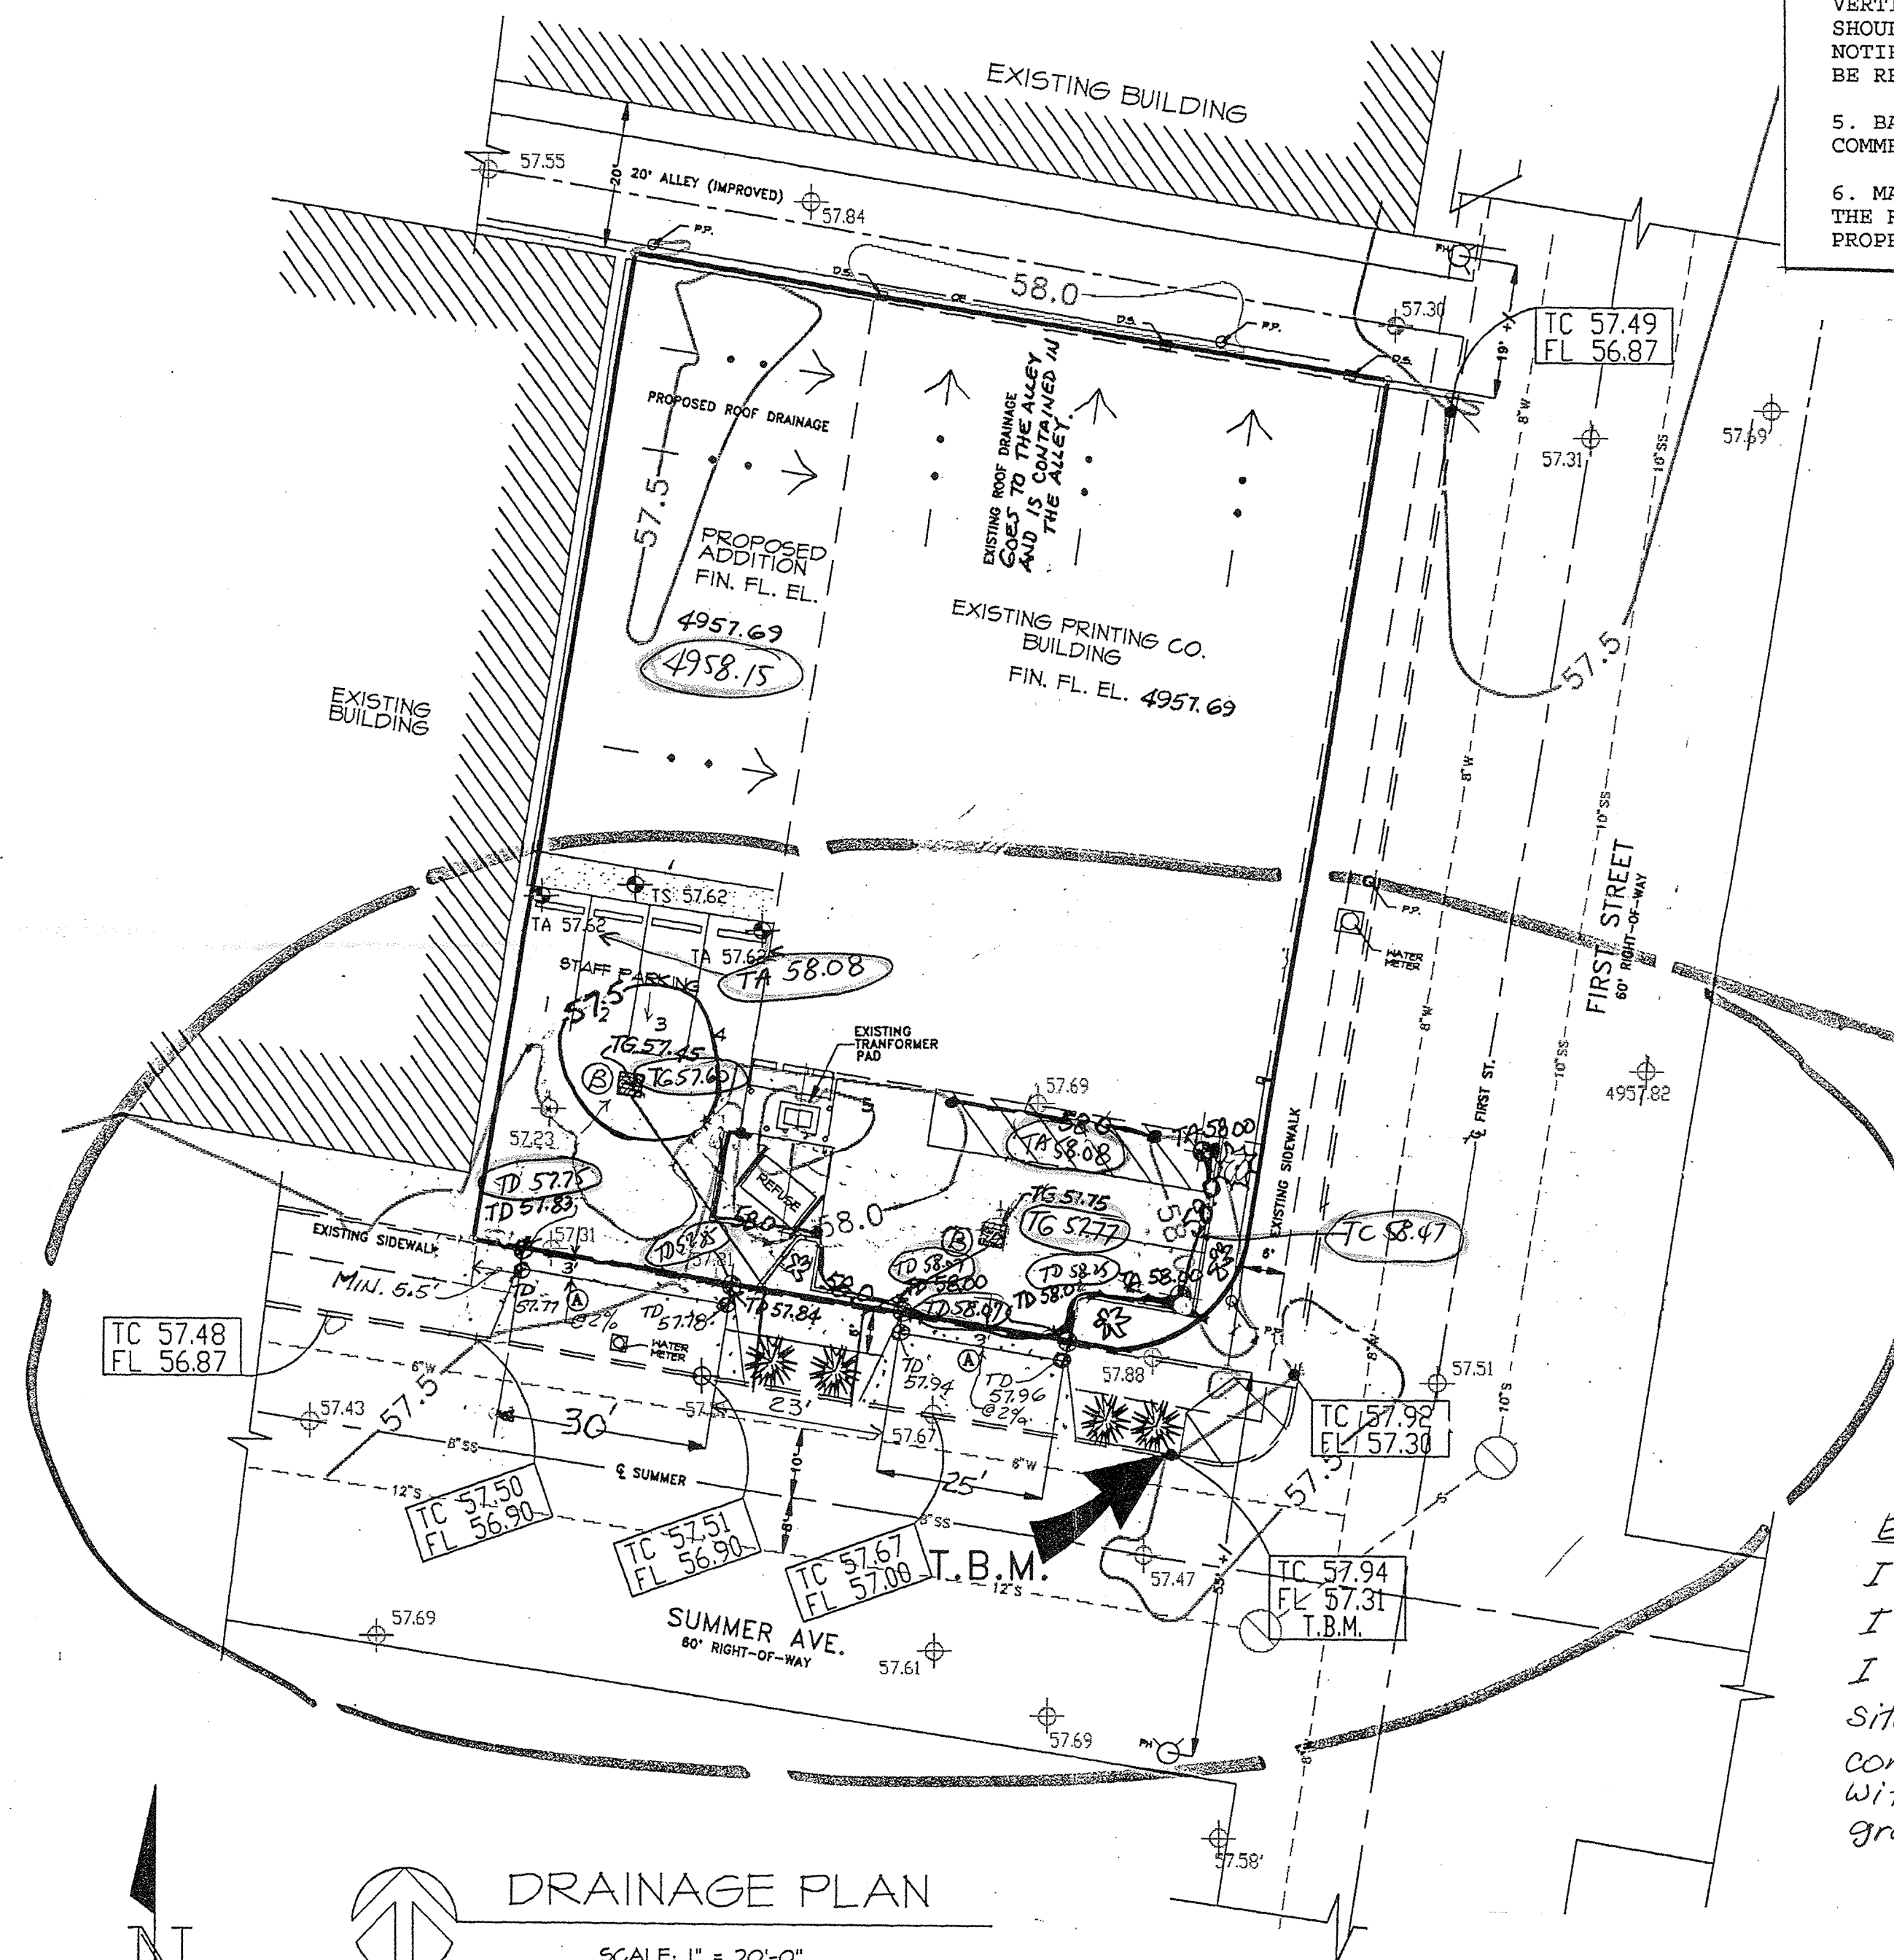

SEE
ENLARGEMENT,
SHEET 2.

TG 57.60 AS-BUILT ELEVATION

ENGINEER'S AS-BUILT CERTIFICATION:

I hereby certify that on August 16, 1997 I personally inspected the property. I further certify that the property site grading and drainage were constructed in substantial compliance with the approved drainage and grading plan.

Celia S. Tomlinson

APPROVALS	NAME	DATE	TITLE:
HYDROLOGY			101 SUMMER AVE. NW. PARIS ADDITION
			DRAINLINE THROUGH CURB
INSPECTOR			PERMIT NO.
A.C.E./FIELD			SHEET 1 OF 2 MAP J14

Van Guard Printing Co. DRAINAGE AND GRADING PLAN

PROPOSED IMPROVEMENTS AT VANGUARD PRINTING, 101 SUMMER AVE. NW

LEGAL DESCRIPTION: LOT 24-A, BLOCK 13 PARIS ADDITION

ADDRESS: 101 Summer Avenue NW, Albuquerque, NM

FLOODPLAIN INFORMATION: The property is located on Zone X, areas determined to be outside 500-year floodplain, according to the Floodway Boundary and Floodway Map of Bernalillo County, New Mexico, and Incorporated Areas, Map Number 35001C0332, effective September 20, 1996.

EXISTING CONDITIONS: The area proposed for development consists of existing buildings surrounded by concrete pavement and no landscaping. The lot is bounded on the north by a paved alley, on the east and south by improved Summer Avenue and First Street, and on the west by an improved lot. The roof of the existing building drains to the alley. The area in front of the existing building drains to Summer Avenue. The lot of the existing house which is lower than the lot of the existing building has no positive drainage to the street nor to the alley. The lot receives no offsite runoff.

PROPOSED IMPROVEMENTS: The existing 2500 square foot house will be demolished and a 2975 square foot addition to the existing building will be built at the same finished floor elevation as the building. The roof of the addition will be directed to the roof of the old building and eventually to downspouts that drain toward the paved alley. The net increase in roof area is 475 square feet which will add a negligible 0.05 cfs to the flow on the alley. The surface runoff on the parking lot will drain to two catch basins where the water will be directed to the existing flowline of the curb and gutter on Summer Avenue.

EROSION CONTROL: Water, if any, from activities during construction and/or from rain will be temporarily ponded on site to prevent the spread of silt.

CALCULATIONS:

Existing Conditions:

Land Treatment A = 0
Land Treatment B = 0
Land Treatment C = 3,292 SF = 0.07 Acre
Land Treatment D = 12,116 SF = 0.28 Acre
TOTAL = 0.35 Acre

Proposed Improvement:

Land Treatment A = 0
Land Treatment B = 0
Land Treatment C = 525 SF = 0.01 Acre
Land Treatment D = 14,100 SF = 0.34 Acre
TOTAL = 0.35 Acre

Zone 2 (From DPM 22.2, page A-1)

Existing Condition,

Peak Discharge, 100-year: C = 3.14, D = 4.70 (DPM 22.2, A-9)
 $Q_{100} = 0.07 \times 3.14 = 0.22 \text{ cfs}$
 $0.28 \times 4.70 = 1.32 \text{ cfs}$
composite = 1.54 cfs

Volume of Runoff, Excess Precipitation
100-year: C = 1.13, D = 2.12 (from DPM 22.2, A-7)

$V_{100} = 0.07 \times 1.13 \times 43560/12 = 287 \text{ cf}$
 $= 0.28 \times 2.12 \times 43560/12 = 2,155 \text{ cf}$
composite = 2,442 cf

Proposed Improvement:

Peak Discharge, 100-year
Land Treatment C, 100-year: 3.14 cfs
Land Treatment D, 100-year: 4.70 cfs

$Q(100\text{-year}) = 0.01 \times 3.14 = 0.03 \text{ cfs}$
 $0.34 \times 4.70 = 1.60 \text{ cfs}$
composite = 1.63 cfs

Volume of Runoff, 100-year:

Excess Precipitation, Land Treatment C
100-year: 1.13 Inch
Excess Precipitation, Land Treatment D
100-year: 2.12 inches

$V(100\text{-year}) = C = 0.01 \times 1.13 \times 43,560/12 = 41 \text{ cfs}$
 $D = 0.34 \times 2.12 \times 43,560/12 = 2,616 \text{ cfs}$
TOTAL = 2,657 cfs


Change in Discharge, $Q_{100} = 1.63 - 1.54 = 0.09 \text{ cfs (increase)}$
 $0.05 \text{ cfs goes to the alley.}$
Change in Runoff Volume, $V_{100} = 2,657 - 2,442 = 215 \text{ cf (increase)}$

Since the proposed addition is replacing an existing structure in a developed basin, the proposed grading has been designed to allow for free discharge to the improved city system such as Summer Avenue or the paved alley behind the existing building.

CONCLUSION: The proposed improvements will not have any adverse impact on nor will be adversely affected by the existing drainage around the Vanguard Printing property.



Celia S. Tomlinson 5/23/97
Celia S. Tomlinson 5/20/97
Celia S. Tomlinson 5/13/97

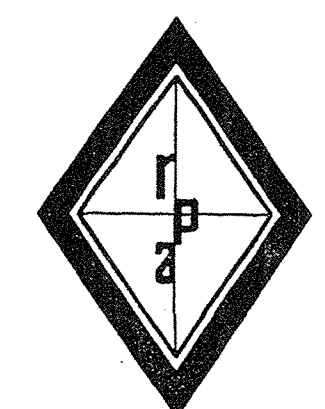

RHOMBUS P.A., INC.

FACILITIES ENGINEERS & ENVIRONMENTAL CONSULTANTS
2620 San Mateo NE SUITE B
Albuquerque, NM 87110

TEL. (505) 881-6690 FAX (505) 881-6896

SHEET 1 of 2