DRAINAGE PLAN

SCOPE:

Pursuant to the latest City of Albuquerque Ordinance, the Drainage Plan shown hereon outlines the drainage management criteria for controlling developed runoff on and exiting the project site. One building is proposed for the subject property, with associated access, parking and landscaping.

EXISTING CONDITIONS:

Presently the 0.78 acre site is developed. The site is bounded on the north by Constitution Ave, on the east by Second Street, on the south by Kinley Ave. and on the west by private property. The site is level. As shown by the FEMA Map Panel No. 332, dated 1996, the site is not located in a 100-year floodplain. Second Street is shown as being in a 100-year floodplain, but the City has installed storm drainage improvements (AMDS Systems 128-02B and 128-04B) which have eliminated the floodplain. No offsite runoff enters the property.

PROPOSED CONDITIONS:

As shown by the plan, the building site is located along the west side of the property. On site flows will drain around the structure and flow to the east. All roof drainage will discharge from the roof to the east parking lot and continue to flow to Second Street via concrete curb openings/channels and sidewalk culverts. Runoff will continue to be allowed to free discharge to the adjacent streets, since the increase in runoff due to development is less than 10%.

Supplemental calculations have been provided to the City of Albuquerque Hydrology Department.

CALCULATIONS:

The calculations shown hereon define the 100 year/6 hour design storm falling within the project area under existing and developed conditions. The Hydrology is per "Section 22.2, Hydrology of the Development Process Manual, Volume 2, Design Criteria, for the City of Albuquerque, New Mexico in cooperation with Bernalillo County, New Mexico and the Albuquerque Metropolitan Arroyo Flood Control Authority, latest edition.

Existing Treatment Types:

Treatment A = 0 acres Treatment B = 0 acres Treatment C = 0.33 acres

Treatment D = 0.45 acres Proposed Treatment Types:

Treatment A = 0.00 acres Treatment B = 0.11 acres Treatment C = 0.00 acres Treatment D = 0.67 acres

Using the values above produces the following storm water flows and volumes:

Existing 100—year Flow = 3.15 cfs Proposed 100-year Flow = 3.40 cfs

Existing 100-year Volume = 4817 cu. ft. Proposed 100-year Volume = 5468 cu. ft.

PROPERTY ADDRESS:

Second Street NW

TOPOGRAPHY:


Topographic information provided by Marquez Surveying Company, dated September 1998.

GENERAL GRADING NOTES:

- 1. THE CONTRACTOR SHALL OBTAIN A TOP SOIL DISTURBANCE PERMIT FROM THE CITY OF ALBUQUERQUE, ENVIRONMENTAL HEALTH DIVISION PRIOR TO CONSTRUCTION.
- THE CONTRACTOR IS TO REFER TO THE EARTHWORK SPECIFICATIONS NOTED IN THE GEOTECHNICAL INVESTIGATION REPORT PREPARED FOR THIS LOT AND CAN BE OBTAINED BE THE OWNER.
- THE CONTRACTOR SHALL CONFORM TO ALL CITY, COUNTY, STATE AND FEDERAL DUST CONTROL MEASURES AIND REQUIREMENTS AND WILL BE RESPONSIBLE FOR PREPARING AND OBTAINING ALL NECESSARY APPLICATIONS, PERMITS AND
- PVC DRAINAGE PIPES MAY REQUIRE FIELD ADJUSTMENT DUE TO SUBSURFACE ROCK. CONTRACTOR SHALL PROVIDE POSITIVE DRAINAGE TO INLET/STREET.
- CONTRACTOR SHALL FIELD VERIFY ALL EXISTING UTILITY CONDITIONS AND NOTIFY THE ENGINEER IMMEDIATELY OF ANY DISCREPANCIES.
- TWO WORKING DAYS PRIOR TO EXCAVATION THE CONTRACTOR SHALL CONTACT NEW MEXICO ONE CALL SYSTEM (260-1990) FOR LOCATION OF EXISTING UTILITIES.
- CONTRACTOR SHALL PROVIDE DOUBLE CLEAN-OUTS AT ALL BENDS IN DRAINAGE
- THE TOPSOIL COULD BE SAVED ASIDE FOR RE-USE IN FILLING DISTURBED AREAS AROUND THE STRUCTURE.
- ALL DISTURBED AREAS ON THE LOT SHALL BE RESEEDED WITH NATIVE SEEDING
- THE MAXIMUM GRADED SIDE SLOPE SAHLL NOT EXCEED 3 FEET (HORIZONTALLY) TO 1 FOOT (VERTICALLY)
- 11. AREAS DISTURBED DUE TO GRADING SHALL BE RESEEDED IN ACCORDANCE WITH CITY OF ALBUQUERQUE STD. SPECIFICATION 1012 - NATIVE GRASS SEEDING, O.A.E.



ZONE ATLAS: J-14

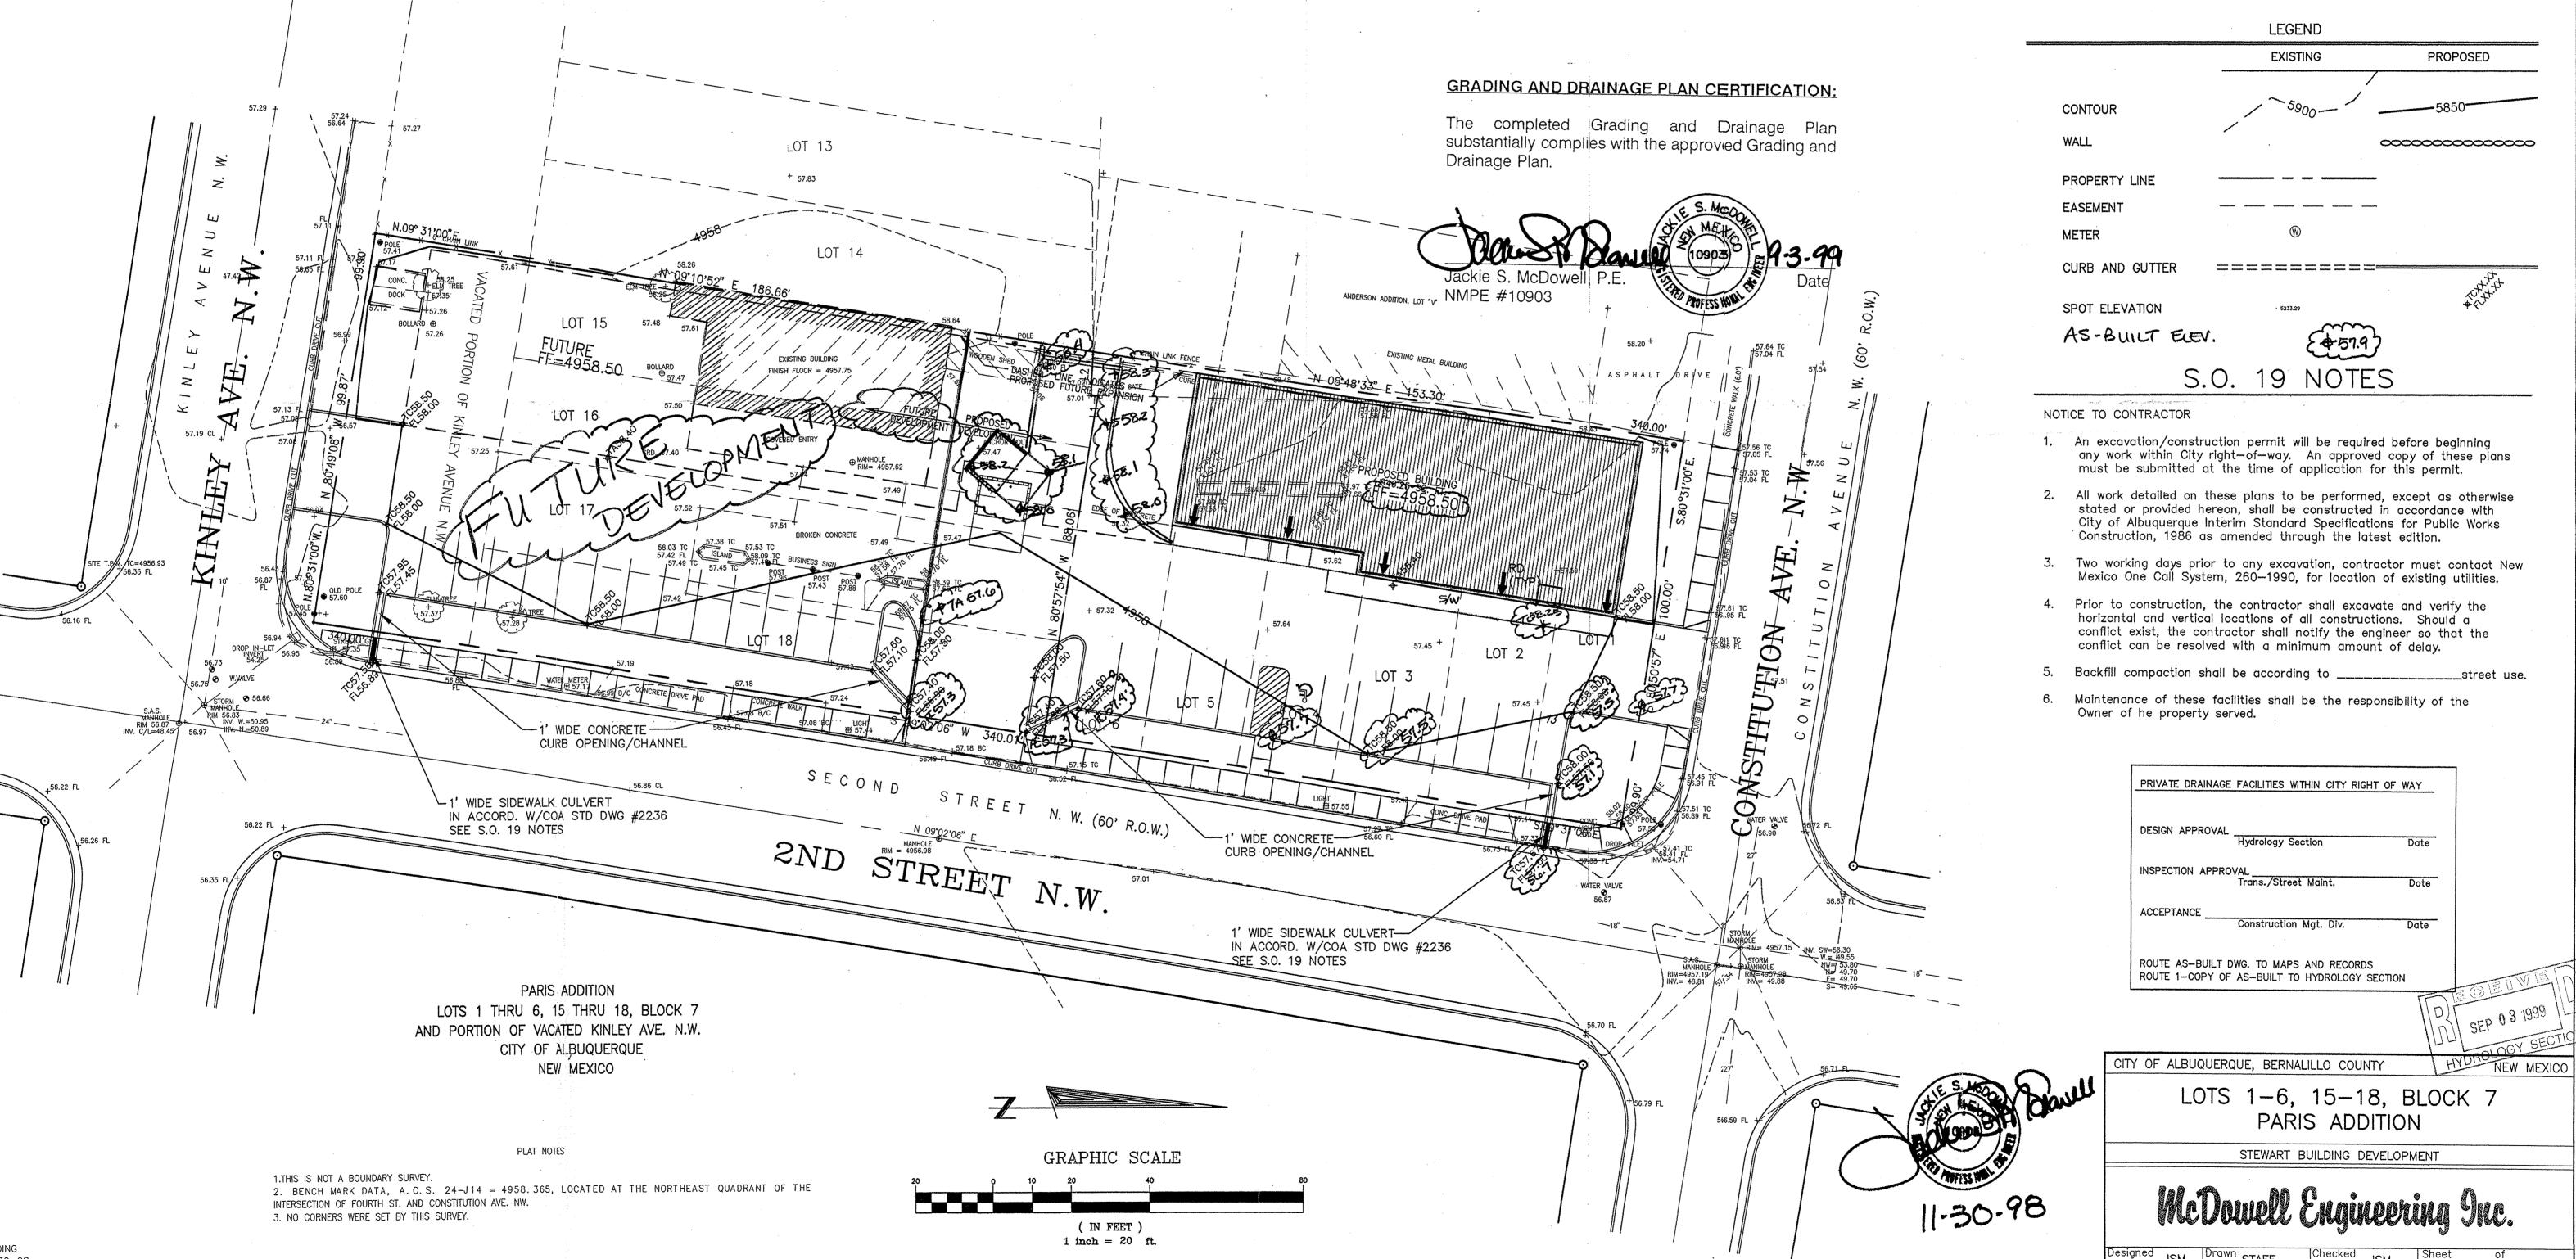

Designed JSM Drawn STAFF Date NOVEMBER,1998 STE0198L

GRADING 11-30-98 1=20 STE0198L