

- a. Runoff factors from Section 22.2, DPM, December, 1999
- b. Land use descriptions: A. Uncompacted soil B. Landscaped

  - C. Compacted soil, to include most vacant lots

Peak Total

0.6 837.9

0.4 671.3

1.1 1509.2

Runoff

CF

0.0

0.0

1"=10'

TC 54.08 T

7

EXISTING

SIDEWALK

HC RAMPI

m

TC 54.11 ~ "X

1 cli

CURB

FL 53,43

Runoff

CFS

0.0

0.0

PROPOSED USE

0.00

0.2915 acre

115.00

5827.00

6756.00

Area Percent

0.0

0.9

45.9

12698.00 100.000 1.2 1749.7

53.2

Peak

CFS

0.0

0.0

0.4

0.7

Runoff

0.0

7.5

548.7

1193.6

EXISTING OFFICE BUILDING

FFE 4955,20

Runoff

- c. Peak runoff = Area (acres) x factor (CFS/acre) = CFS
- D. Impervious areas
- d. Total runoff = Area (SF) x factor (inches) / 12 (inches /foot) = CF
- e. Peak and total runoff is based on 6 hour, 100 year frequency storm

The purpose of this grading and drainage plan is to obtain approval for a construction of an addition to an existing office building on a tract of .2915 acres located at 904 Broadway Boulevard, NE, Albuquerque, New Mexico.

### **DISCUSSION:**

A. The facilities are to be located in the Rio Grande Valley, in the level historic floodplain of the Rio Grande, north of the intersection of Lomas Boulevard and Broadway Boulevard, near downtown Albuquerque.

B. The tract is presently developed with a small office building, a metal shed workshop, and a portland cement concrete pad. The rest of the lot consists of compacted natural soil. The site is presently used for manufacture of wrought iron products. The owner plans to add about 670 square feet of building to the existing building, and to pave the parking area in front of the office building.

Soils within the area are identified by reference C as Glendale clay loam (Gm). The soils are suited for residential building and associated infrastructure. The soils have a moderate shrink swell potential, and high risk of corrosion to uncoated steel, so imported material may be required for structures, streets and driveways. Soils may be susceptible to consolidation, particularly when wetted, so care must be taken to direct runoff and landscape watering away from building foundations.

### DRAINAGE CONSIDERATIONS:

PROPOSED BUILDING

55.00

GATE

SILL

X 54.80

CONCRETE

MARBLE AVE NE

NEW ASPHALT SURFACE

PORTLAND CEMENT CONCRETE

45-BUILT

100 YEAR FLOOD

ELEVATION 4954

TBM = TC 4954.19

ADDITION FFE 4955.20

A. The site is located adjacent to the limits of the 100-year flood hazard area, Zone AH, with flood depths of 1 to 3 feet, usually ponding, with base flood elevation determined. The flood for the pond adjacent to the Reyes site has a base elevation of 4954 (see Flood Insurance Rate Map, panel 334 of 825, effective date, September 20, 1996). The topographic map on which the flood hazard elevation is determined is based on an aerial photograph from October 8, 1980. The flood map shows the pond as extending partially onto the Reyes site. A detailed spirit level topography shows that the limits of the flood pond are in fact defined by the curb on Broadway Boulevard and Marble Avenue, as the top of curb is above the elevation of 4954.

B. The site is presently bordered by finished structures, on the west and south by the sidewalk, curb and gutter and pavement of Broadway Boulevard and Marble Avenue NE, on the east by a 16 feet wide alley right-of-way, and on the north by an office and shop building.

EXISTING OPEN SHED

As Built

NEW SIDEWALK

PORTLAND COMMOT CONCRETE

C. Presently all runoff from the site which leaves the site flows out along the south and west boundaries of the site, flowing along gutter to an existing drain inlet located in the northeast quadrant of the intersection of Broadway Boulevard and Marble Avenue. The drain inlet is connected to a 42" and 54" storm drain in Broadway Boulevard, then to the net work of storm drains through downtown Albuquerque. The existing peak flow from the undeveloped site for the 100 year-6 hour storm is estimated as 1.1 CFS (see Table A).

D. The grading scheme proposed is to direct all runoff from the newly developed impervious parking and driveway, and office roof surfaces, through the entry drivepad onto the Marble Avenue right-of-way, and then to the storm drain inlet.

E. The finished floor of the existing building and the proposed addition are 1.4 feet above the 100-year base flood elevation, so no additional floodproofing is required.

F. No off-site flow enters the tract. G. The site is protected from major flooding from off-site flows by the railroad berm 500 feet west of Broadway Boulevard, the I-40 berm 3000 to the north, and the edge of the mesa 1000 feet to the east. Major flooding would probably come from the north, crossing under the I-40 berm at the railroad and Broadway Boulevard openings, then spreading out over the surfaces between the railroad berm and the mesa edge.

## CONCLUSIONS:

A. The proposed construction is adjacent to but not within a designated 100 year floodplain.

B. Construction as proposed will not increase the hazard from flooding to downstream facilities. C. The proposed grading and construction will protect the

# REFERENCES:

A. Standard Specifications for Public Works Construction, City of Albuquerque.

B. Section 22.2, Hydrology, of the Development Process Manual, Volume 2, Design Criteria, for the City of Albuquerque...Bernalillo County...AMAFCA, December 1999.

property from any off-site or on-site runoff.

EXISTING

ELEVATION (TYPICAL) 55.15 X1

EXISTING

PROPOSED

ELEVATION

(TYPICAL)

COMPACTED EARTH SURFACE

(TC 53,81

FL 53,19

C. Soil Survey of Bernalillo County and Parts of Sandoval and Valencia Counties, New Mexico, USDA-SCS. D. Flood Insurance Rate Map, City of Albuquerque, Bernalillo

County, Federal Emergency Management Agency, Panel 334 of 825, effective date: September 20, 1996.

E. Floodway Flood Boundary Map, City of Albuquerque, Bernalillo County, Federal Emergency Management Agency, Panel 28 of 50, date of aerial photography: October 8, 1980. E. City of Albuquerque topographic maps, sections J-14. Date of

aerial photography, March 21, 1976. Scale: 1"=200' F. City of Albuquerque Drainage Facilities maps, section J-14, compiled March 5, 1999.



LEGAL DESCRIPTION LOTS NUMBERED 5, 6, AND 7 IN BLOCK NUMBERED 2 OF THE MAYO AND ROSS ADDITION TO THE CITY OF ALBUQUERQUE, BERNALILLO COUNTY, NEW MEXICO, FILED JULY 11, 1923.

Topography by Marvin R Kortum, December 11, 2000.

BENCHMARK: ACS 25-J15.

## NOTES (


- A. Existing standard curb and gutter.
- B. Existing double C storm drain inlet. C. Existing asphalt surface.
- D. Existing portland cement sidewalk.
- E. Existing portland cement drivepad. F. Existing block wall.
- G. Finished Floor elevations (FFE) shown on the drawing are the top
- surface of the slab. H. Landscaped area.

Quantities shown on the estimate tables are to the significant figures as shown for the purpose of tracking numbers from one calculation to the next. Actual accuracy of the numbers is about equal to the first significant figure, ie. 5693.5 CF would be some quantity between 5200 CF and 6200 CF.

I certify that I have inspected the Reyes Wrought Iron site and that the construction on-site is in substantial compliance with the grading and drainage plan (J14/D138) as approved by City of Albuquerque letter dated February 15, 2001. Finished floor elevations for all buildigs constructed are above the minimum specified elevation, and concrete yard surfaces slope as required, and specified curbing is in place.

February 6, 2002 NMPE 6519

CERTICICATION

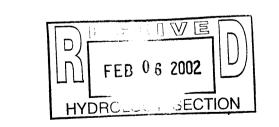


FB6 2002

PRELIMINARY MRK DEC 19 2000 APPROVALS, REVISIONS ΒY DATE MARVIN R. KORTUM, P.E. Civil Engineering NM PE 6519 1605 Speakman Drive, S.E. Albuquerque, New Mexico 87123 (505) 299-0774 GRADING AND DRAINAGE PLAN REYES WROUGHT IRON 904 BROADWAY NE PROJECT NO MAP NO SHEET OF

J-14/D138

MRK

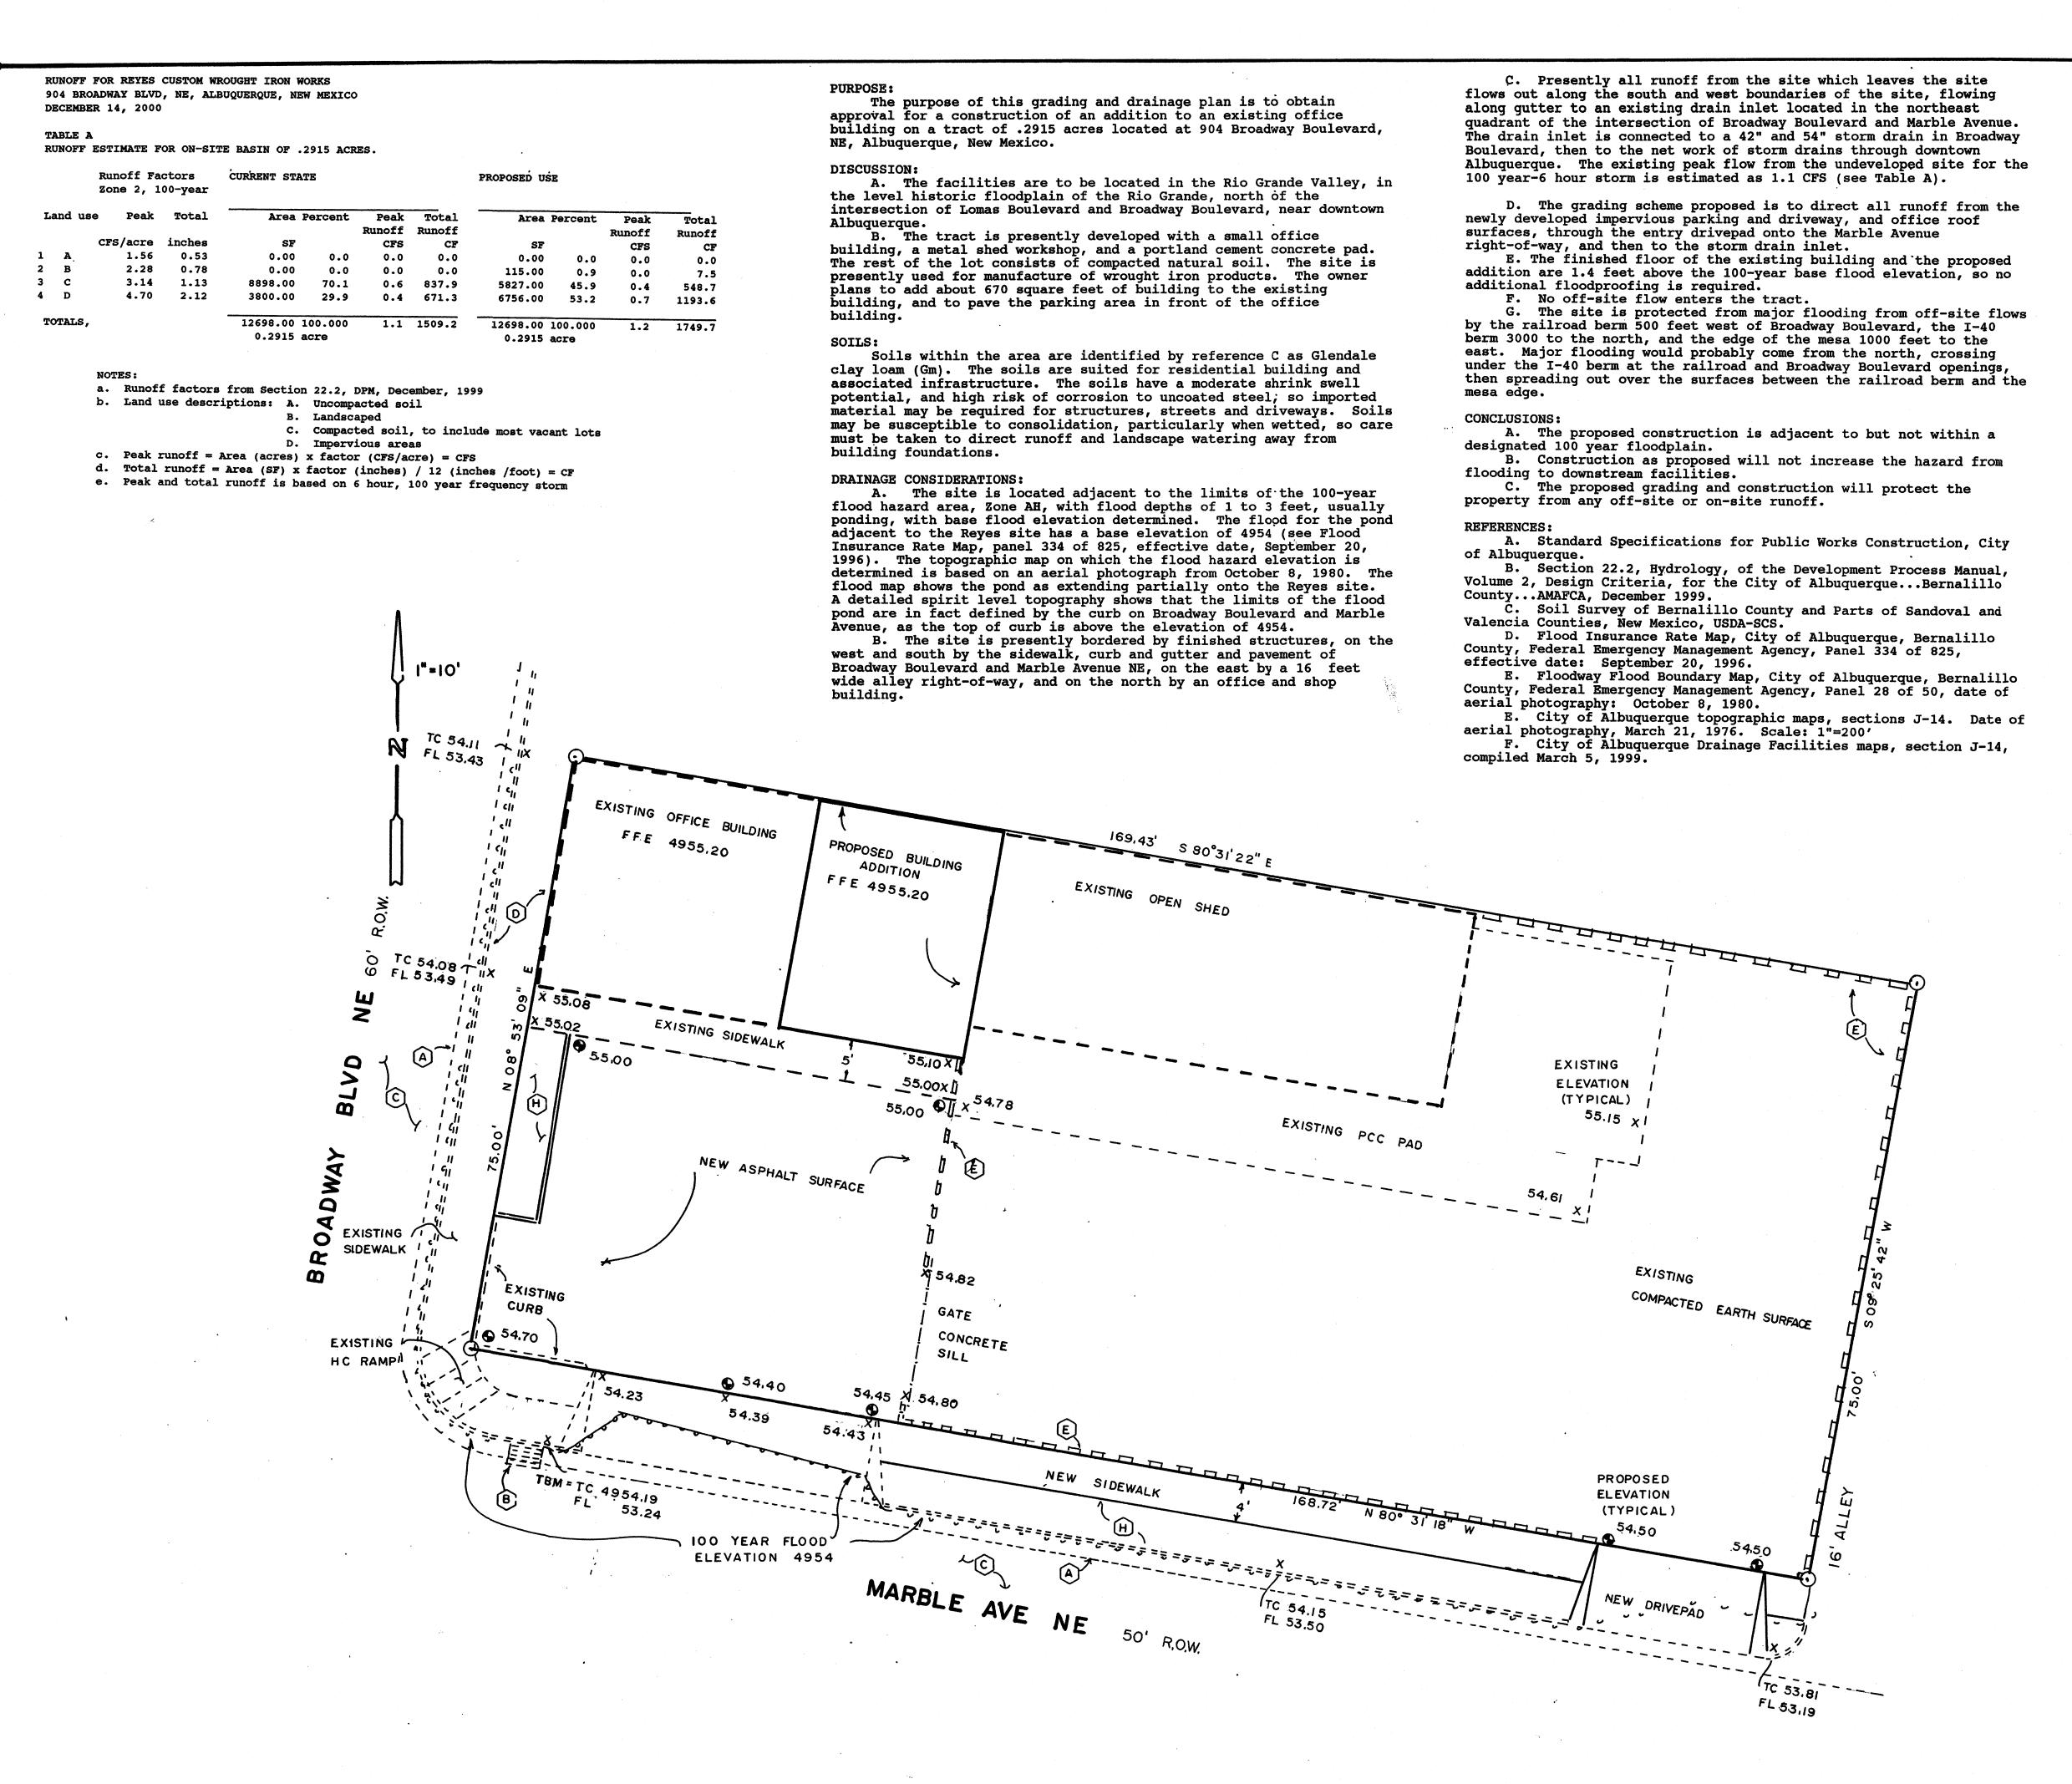

ADD'N MUNICIPAL M'DDA SLADE M-2

LEGAL DESCRIPTION

LOTS NUMBERED 5, 6, AND 7 IN BLOCK NUMBERED 2 OF THE MAYO AND RO\$S ADDITION TO THE CITY OF ALBUQUERQUE, BERNALILLO COUNTY, NEW MEXICO, FILED JULY 11, 1923.

Topography by Marvin R Kortum, December 11, 2000.

BENCHMARK: ACS 25-J15.

## NOTES (

- A. Existing standard curb and gutter.
- B. Existing double C storm drain inlet.
- C. Existing asphalt surface. D. Existing portland cement sidewalk.
- E. Existing portland cement drivepad.
- F. Existing block wall.
- G. Finished Floor elevations (FFE) shown on the drawing are the top

H. Landscaped area.


Quantities shown on the estimate tables are to the significant figures as shown for the purpose of tracking numbers from one calculation to the next. Actual accuracy of the numbers is about equal to the first significant figure, ie. 5693.5 CF would be some quantity between 5200 CF and 6200 CF.


> PRELIMINARY MRK DEC 19 2000 APPROVALS, REVISIONS DATE MARVIN R. KORTUM, P.E Civil Engineering NM PE 6519 1605 Speakman Drive, S.E. Albuquerque, New Mexico 87123 (505) 299-0774 GRADING AND DRAINAGE PLAN REYES WROUGHT IRON 904 BROADWAY NE

> > SHEET OF

PROJECT NO MAP NO J-14/D J-14



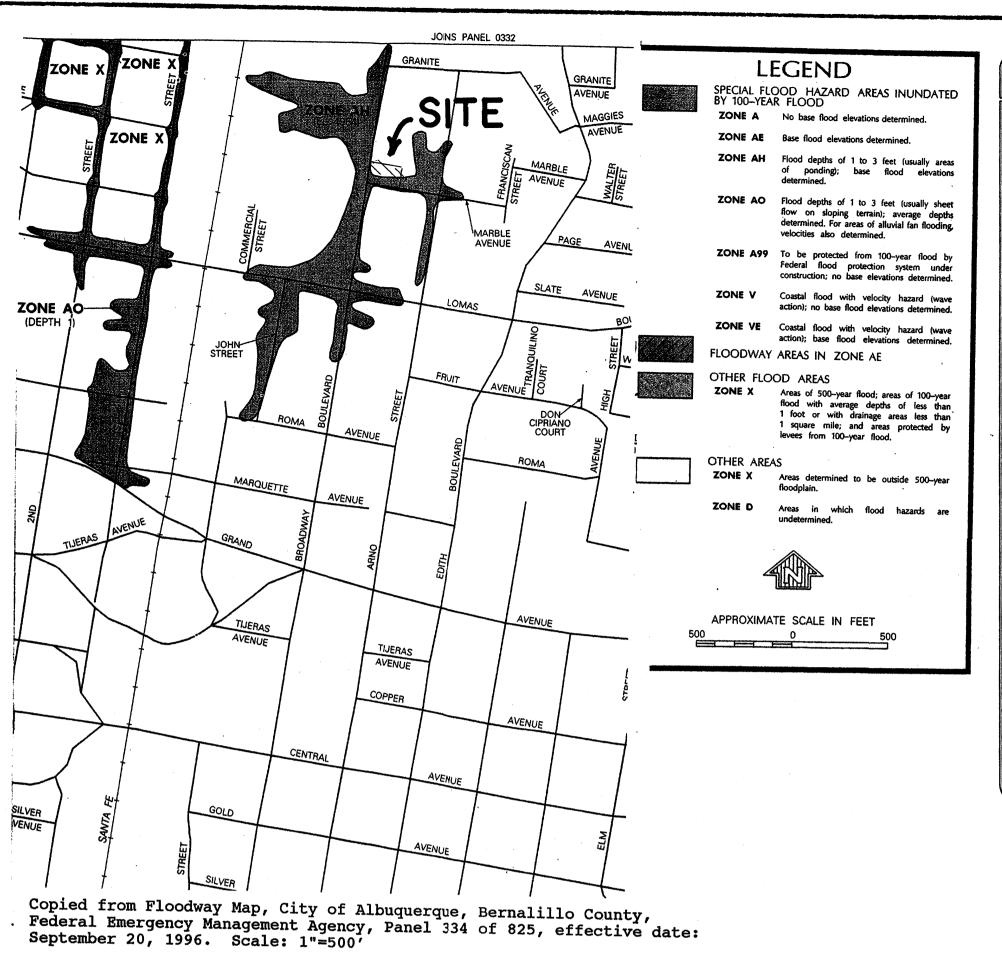

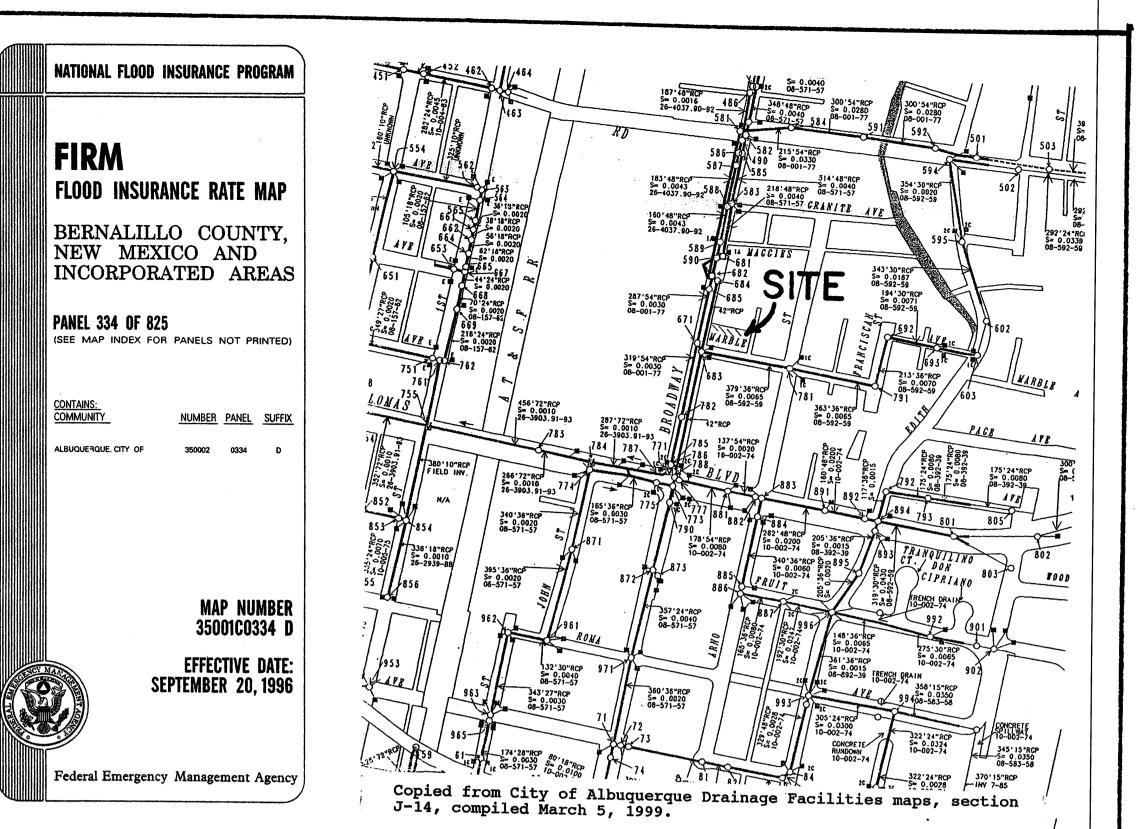

DEC 19 2000 PRELIMINARY MRK BY APPROVALS, REVISIONS DATE MARVIN R. KORTUM, P.E. Civil Engineering NM PE 6519 1605 Speakman Drive, S.E. Albuquerque, New Mexico 87 23 (505) 299-0774 GRADING AND DRAINAGE PLAN REYES WROUGHT IRON 904 BROADWAY NE MAPS PROJECT NO MAP NO SHEET J-14/D