


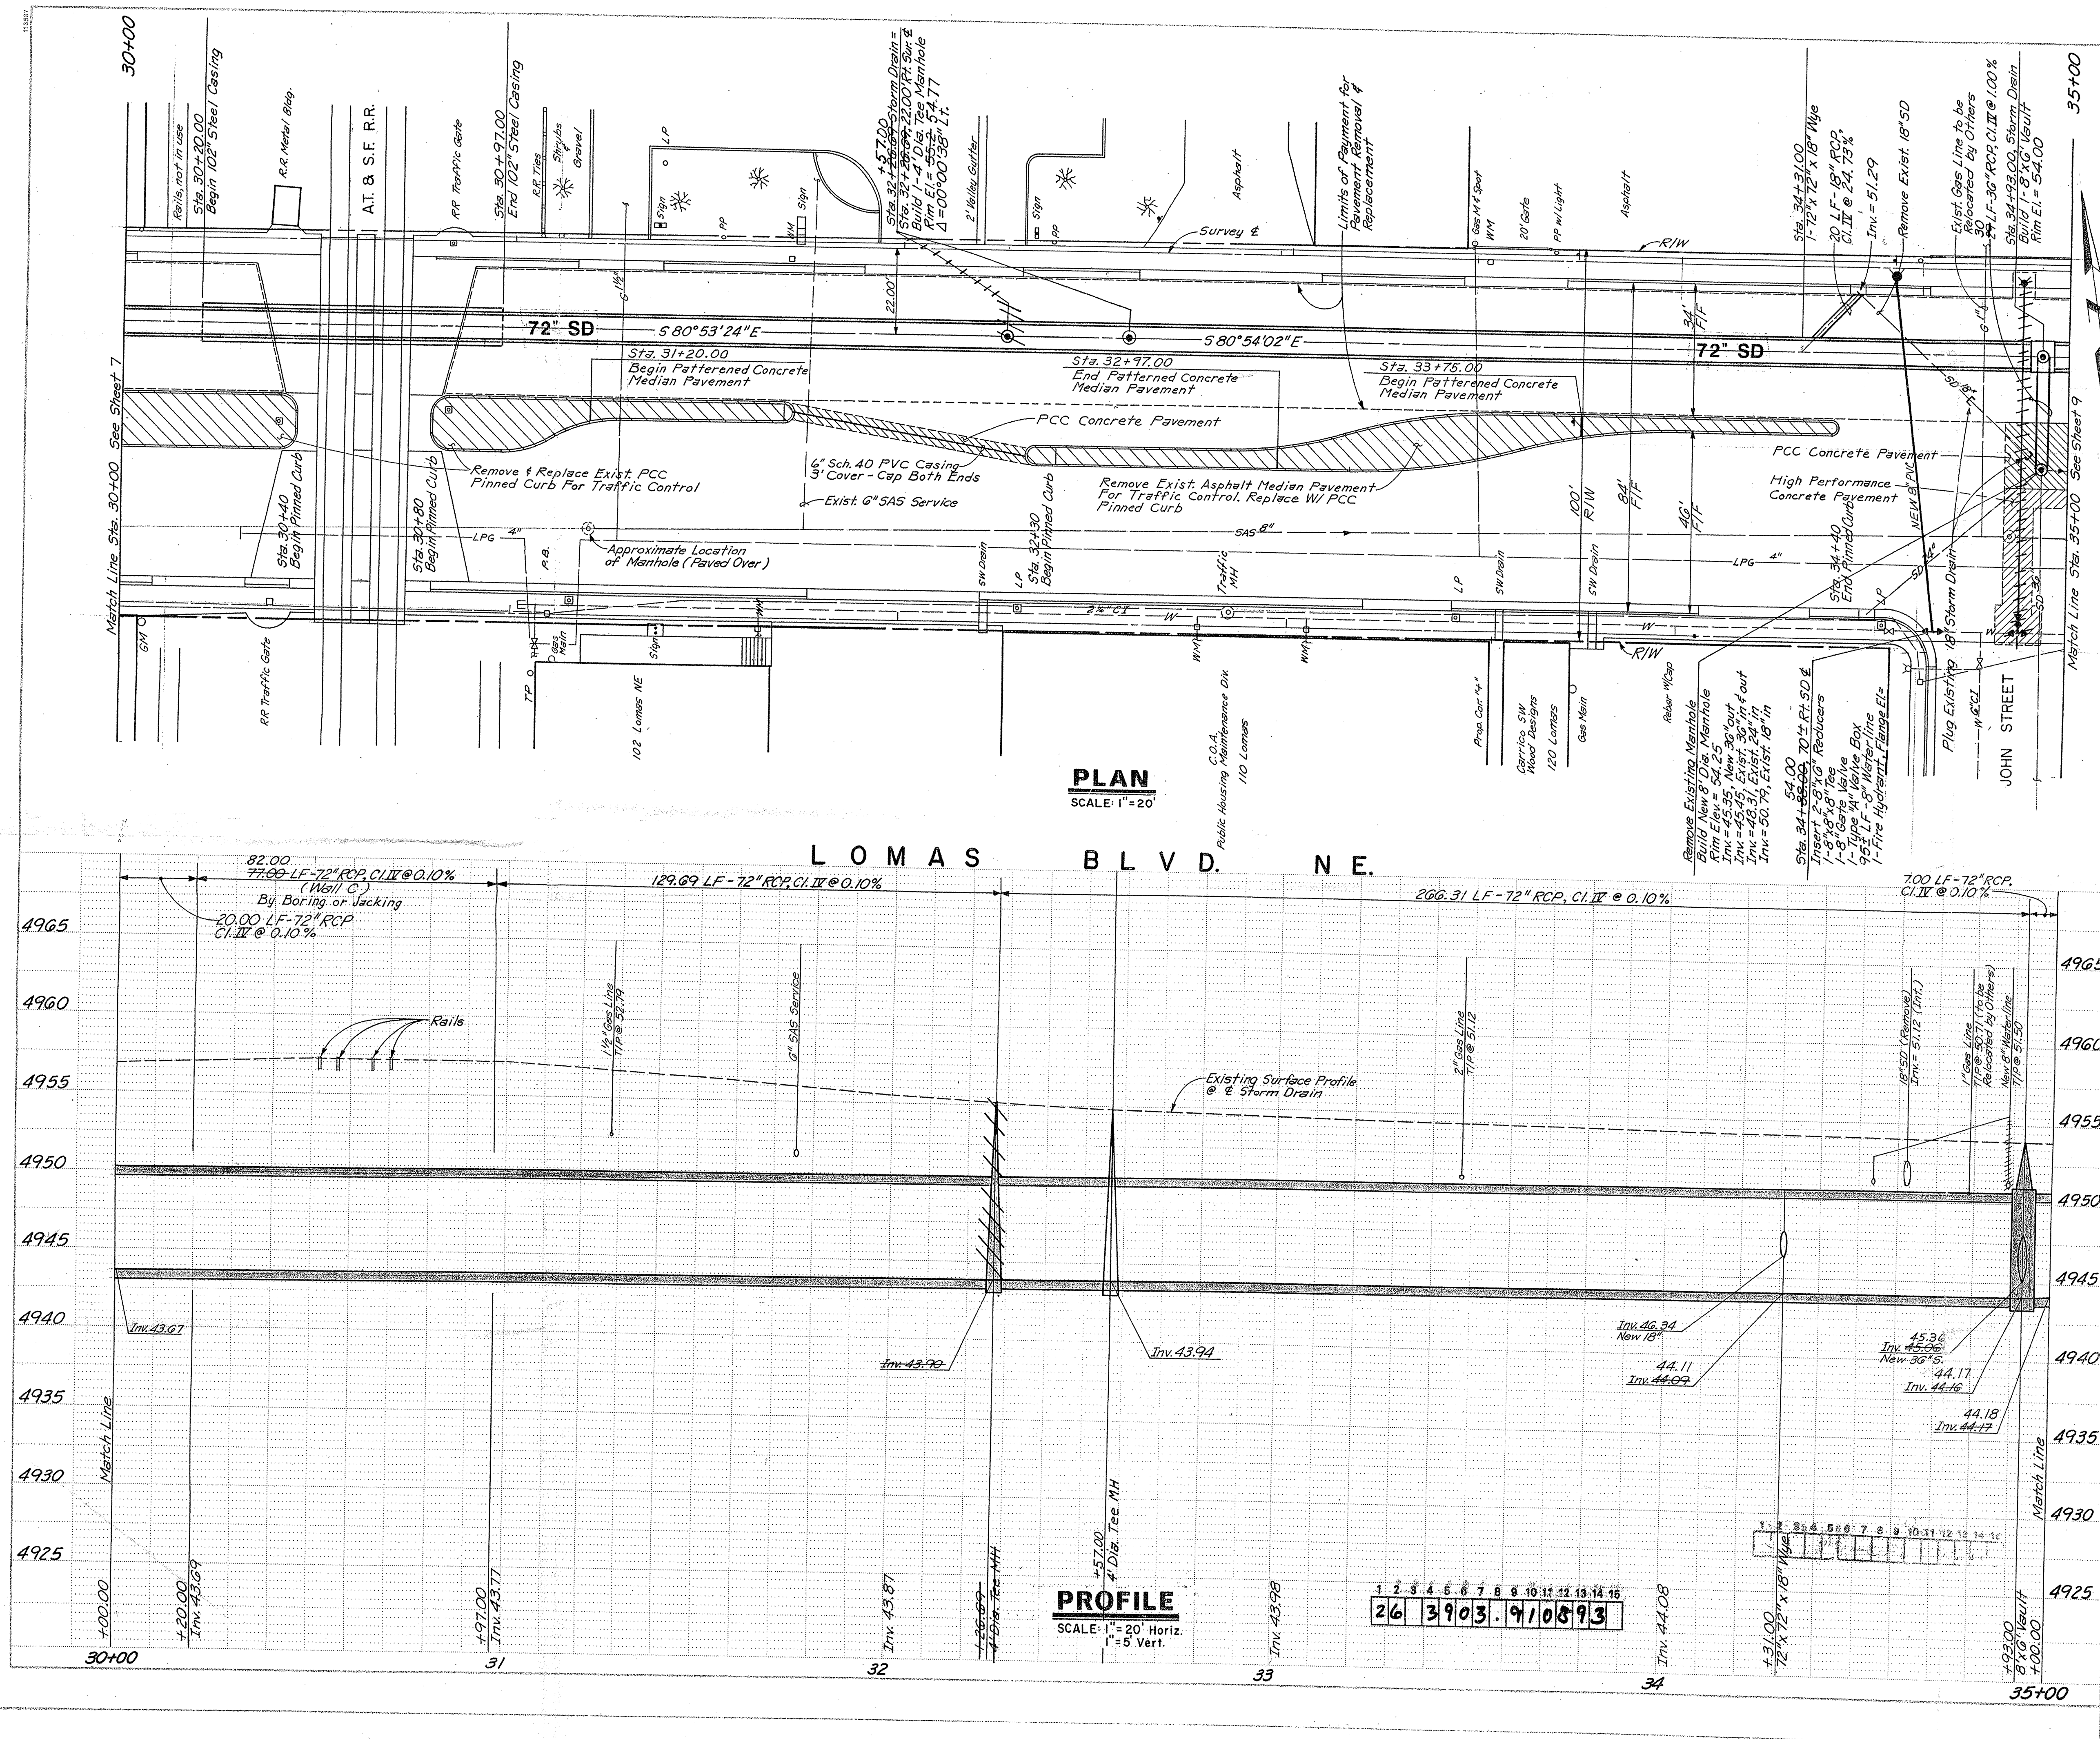

John A. Andrews
RECORD DRAWING
RECORD DRAWINGS WERE PREPARED
FROM THE CITY OF ALBUQUERQUE.

APR 1 8 2002
HYDROLOGY SECTION

CITY OF ALBUQUERQUE PUBLIC WORKS DEPARTMENT ENGINEERING GROUP					
LOMAS BOULEVARD STORM DRAIN - PHASE II PLAN & PROFILE - STA. 30+00 TO STA. 35+00					
APPROVALS	ENGINEER	DATE	APPROVALS	ENGINEER	DATE
DRC CHAIRMAN	<i>Royce J. Brown</i>	7-3-91	WATER	<i>W. J. J. J.</i>	8-30-91
TRANSPORTATION	<i>R. J. J.</i>	9-03-91	WASTE WATER	<i>W. J. J.</i>	..
HYDROLOGY	<i>Shirley J. J.</i>	9-3-91	CONSTRUCTION COORDINATOR		
DRAWING NO. 3903.91		MAP NO. J-14, J-15		SHEET 8 OF 45	

ENGINEER'S SEAL		SURVEY INFORMATION		BENCH MARKS		AS BUILT INFORMATION	
		FIELD NOTES		CONTRACTOR		NEW CONCEPTS	
NO.		BY		ACS STA. 2-J14R		STATIONED BY NEW CONCEPTS	
DATE		DATE		ELEVATION 4954.40		INSPECTED BY J. FRANCO	
REVISIONS		REMARKS		STANDARD CITY OF ALBUQUERQUE DISK SET IN SIDE- WALK LOCATED AT THE NORTHWEST CORNER OF LOMAS BOULEVARD, N.W. AND 4TH STREET, N.W.		DATE 7-92	
DESIGNED BY J.M.		DATE May 1991		CORRECTED BY J.A.R.		DATE 9-92	
DRAWN BY JCS, TL		DATE 1990-91		MICRO-FILM INFORMATION		RECORDED BY	
CHECKED BY J.M., JA		DATE June 1991		NO.		DATE	