

APPENDIX 2.8 –

Pump Station As-Builts / Plans

FOR:

Urban Pump Station

TABLE UPS
Urban Pump Station Computations of Elevations
and Rating Curve

Item Description	Elevation 29 vert datum	88 vert datum add 2.65 ft	Elevation on 88 vert datum
(a)	(a)	(a)	(a)
Urban Pump Station			
pump station floor elevation	4927.84	2.65	4930.49
depth from pump station top rim elevation to floor elevation top rim 4956.50 floor 4927.84 depth of pump station 28.66			
pump station rim elevation	---		4959.15

(a) Data Source: Record Drawings Feb. 20, 1990 - Urban Roadway Pump Station Sections Sheet P5 of 47 - Included in Appendix

Pump Rating Curve Information and Assumptions

High weir water elevation = 4937.00 (a)
 floor invert elevation = 4927.84 (a)
 pump operating depth = 9.2

Very limited documentation was found by the COA regarding this pump station and its capacity, therefore, the COA suggested that the assumed maximum capacity is 12 cfs

SEC assigned an assumed rating curve for this pump operating depth range and maximum Q as follows:

Depth ft	Q cfs
0.0	0
0.2	1
1.5	2
3.1	4
6.1	8
9.2	12

CURVE	Δ	T	L	R	DESCRIPTION
(A)	60°00'00"	27.14'	49.22'	47.00'	FACE OF WALL
(B)	90°01'06"	52.02'	81.70'	52.00'	CENTERLINE
(C)	90°01'06"	60.02'	94.27'	60.00'	FACE OF WALL
(D)	30°01'06"	33.46'	65.39'	124.81'	FACE OF WALL
(E)	90°01'29"	45.02'	70.71'	45.00'	FLOWLINE
(F)	44°15'40"	20.33'	38.63'	50.00'	FLOWLINE
(G)	44°57'32"	18.62'	35.31'	45.00'	FLOWLINE

NOTES

- ON 2" W.L.: INSTALL 34 LF OF 2" WATERLINE BEGINNING AT 6" X 6" X 2" TEE, 2" X 90° BEND W/BLOCKING, ADDITIONAL 19 LF OF 2" WATERLINE, INSTALL 2" FROST-PROOF POST HYDRANT AT END OF LINE. MAINTAIN MINIMUM 3' COVER OVER LINE.
- EXERCISE EXTREME CAUTION WHEN EXCAVATING IN THIS AREA. 60-WAY TELEPHONE CONDUIT CONTAINS FIBER OPTIC CABLE. CONTACT WARREN REYNOLDS AT MOUNTAIN HILL 888-8783 THREE WORKING DAYS PRIOR TO CONSTRUCTION IN THIS AREA.
- EXCAVATION OF THIS SITE MUST BE COMPLETED TO WITHIN ONE FOOT OF GRADE SHOWN FOUR MONTHS AFTER NOTICE TO PROCEED. WORK SHALL BE COORDINATED WITH PARKING STRUCTURE CONTRACTOR. PUMP STATION AND CONTROL BUILDING CONSTRUCTION SHALL BE SUBSTANTIALLY COMPLETE FOUR MONTHS AFTER NOTICE TO PROCEED SO THAT HELIX CONSTRUCTION MAY PROCEED.

CURB RETURN ELEVATIONS


	T.C.	F.L.		T.C.	F.L.		T.C.	F.L.
P.C.	54.43	53.76	P.C.	53.50	52.83	P.C.	55.22	54.55
1	54.14	53.47	1	53.58	52.91	1	55.25	54.58
2	53.84	53.17	2	53.66	52.99	2	55.28	54.61
3	53.55	52.88	3	53.73	53.06	3	55.31	54.64
P.T.	53.25	52.58	P.T.	53.81	53.14	P.T.	55.34	54.67

NOTES

- REFER TO SHEETS P1 THROUGH P12 FOR PUMP STATION PLANS AND DETAILS.
- REFER TO SHEETS P13 THROUGH P15 FOR CONTROL BUILDING PLANS AND DETAILS.
- REFER TO PLAN AND PROFILE SHEET U-4 FOR 14" AND 3" D.I. STORM DRAIN LINES PROFILE.
- PUMP STATION STORM DRAIN DISCHARGE LINES ARE TO BE CLASS 50 DUCTILE IRON W/45°, 22-1/2° AND 90° FITTINGS AS SHOWN.
- REFER TO MISCELLANEOUS SHOP DRAWINGS FOR ADDITIONS TO PUMP STATION.

URBAN PUMP STATION
INVERT


UPS
4-4

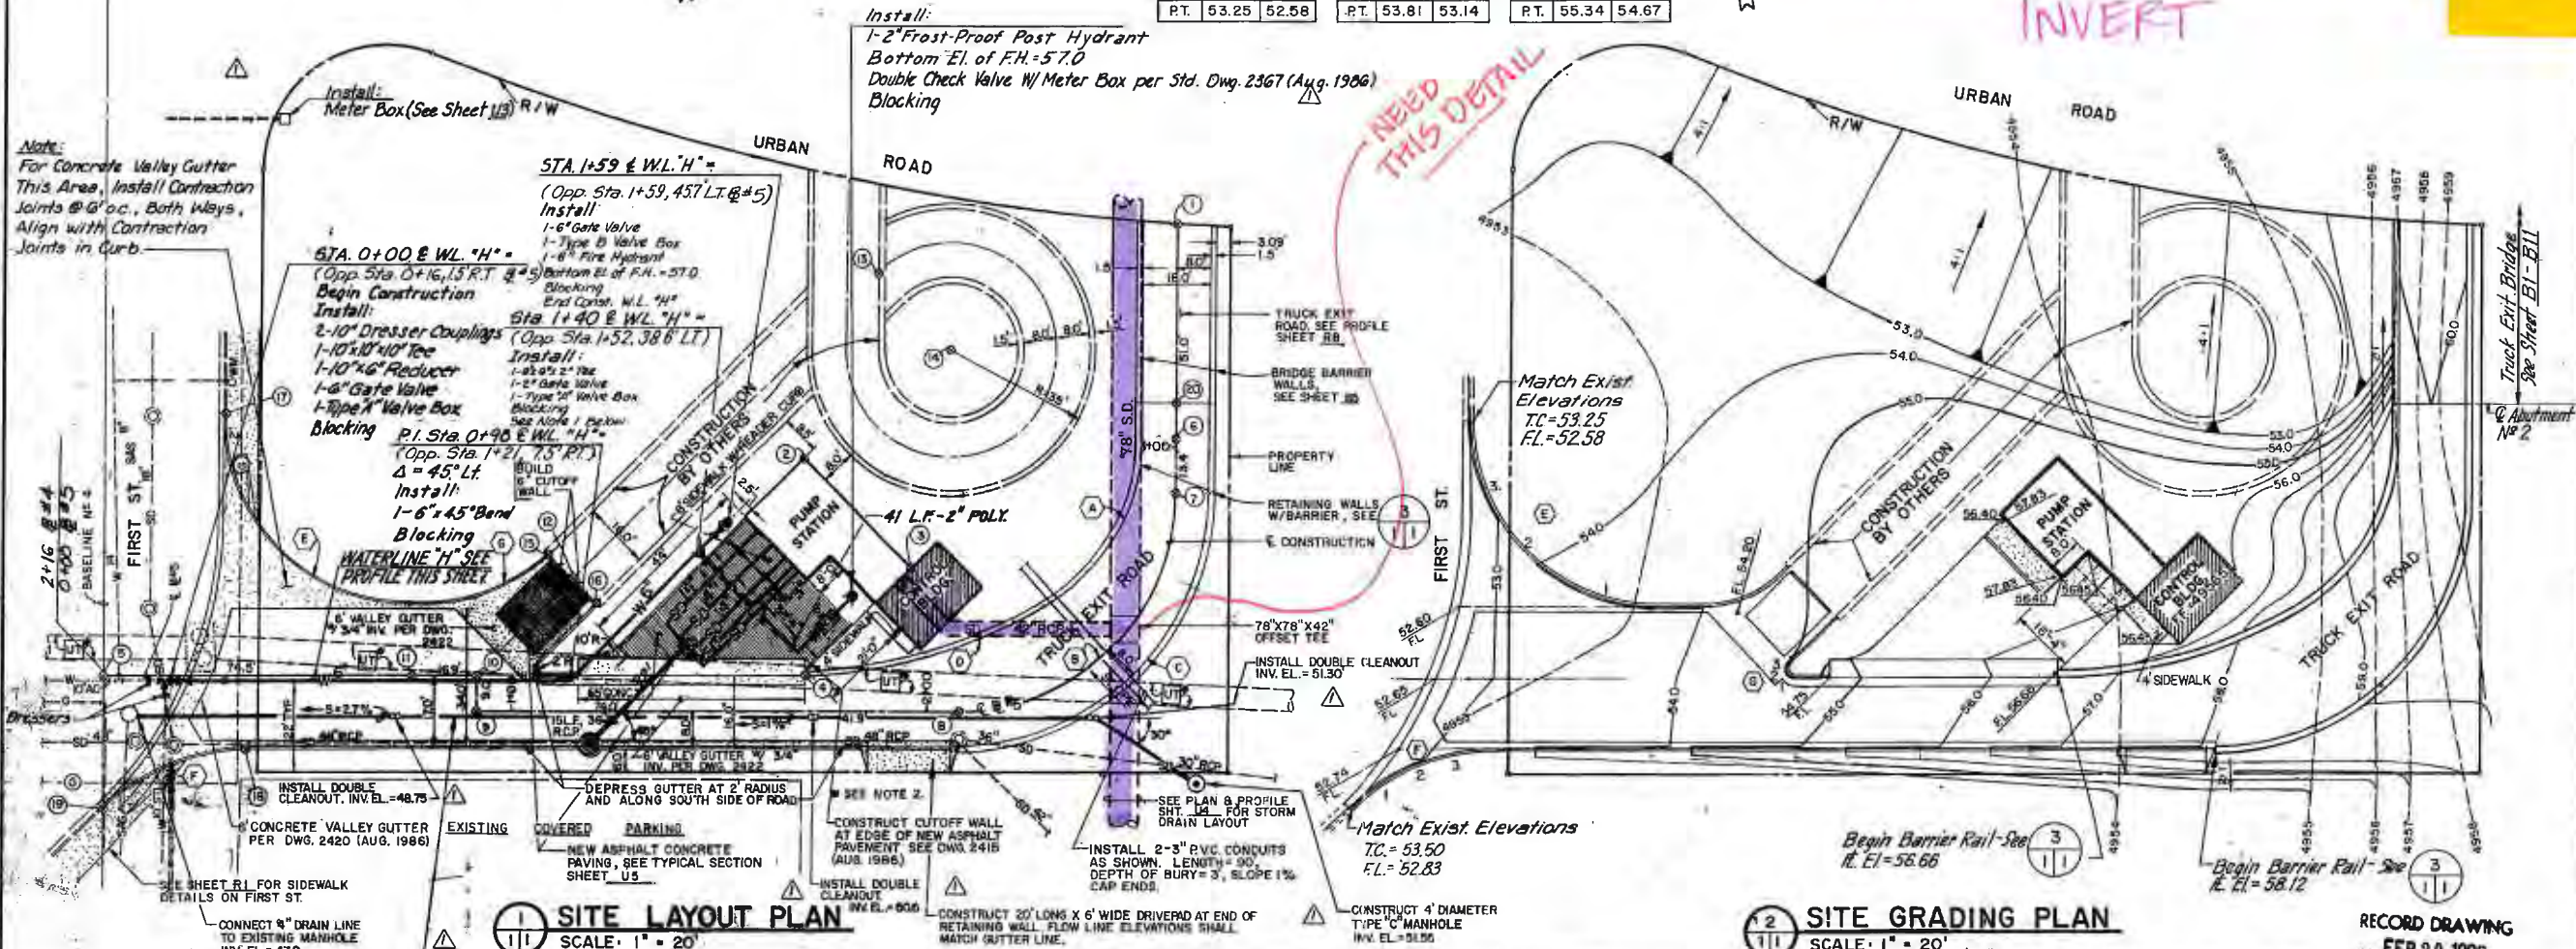


11 SITE LAYOUT PLAN
SCALE: 1" = 20'

12 SITE GRADING PLAN
SCALE: 1" = 20'

POINT	COORDINATES	DESCRIPTION	STATION ALONG Q #5	OFFSET DISTANCE
1	N 1,486,993.91 E 381,540.71	INT. BETWEEN CENTERLINE OF ROAD AND PROPERTY LINE	3+53.24	
2	N 1,486,953.28 E 381,443.84	INT. COR. PUMP STATION	1+69.08	60.97'
3	N 1,486,923.28 E 381,465.50	NE COR. PUMP STATION	1+96.03	34.79'
4	N 1,486,901.09 E 381,434.76	INT. BETWEEN PROJECTION OF BLDG./ASPHALT LINE AND FLOWLINE	1+69.20	8.00'
5	N 1,486,928.91 E 381,267.86	INT. BETWEEN CENTERLINE OF ROAD AND BASILINE NO. 4	0+00	
6	N 1,486,943.55 E 381,532.64	OPP. P.C. (A)	3+02.24	
7	N 1,486,930.29 E 381,530.51	P.C. (A)	2+88.01	
8	N 1,486,887.18 E 381,470.92	P.T. (A)	2+07.11	
9	N 1,486,905.60 E 381,356.23	Q & L PT.	0+50.95	
10	N 1,486,914.48 E 381,357.66	Q & L PT.	0+50.95	
11	N 1,486,917.10 E 381,341.37	OPP. P.C. (C)	0+74.45	
12	N 1,486,934.78 E 381,395.76	Q EXIT RAMP @ CURB LINE	1+10.48	53.50'
13	N 1,486,993.57 E 381,467.17	Q P.C. HELIX (FUTURE)	3+41.25	72.56'
14	N 1,486,972.89 E 381,482.10	RADIUS PT. HELIX (FUTURE)	2+04.55	86.41'
15	N 1,486,941.22 E 381,381.08	P.T. (C)	1+09.83	39.16'
16	N 1,486,928.29 E 381,390.45	BEGIN LT. CURB @ EXIT RAMP	1+21.13	27.65'
17	N 1,486,985.47 E 381,306.78	P.T. (E)	0+29.45	62.62'
18	N 1,486,906.84 E 381,299.28	P.T. (F)	0+34.55	17.00'
19	N 1,486,898.17 E 381,262.57	P.C. (F)	-0+00.35	31.19'
20	N 1,486,952.14 E 381,534.02	Q ROAD @ S. ABUTMENT #2	3+10.96	

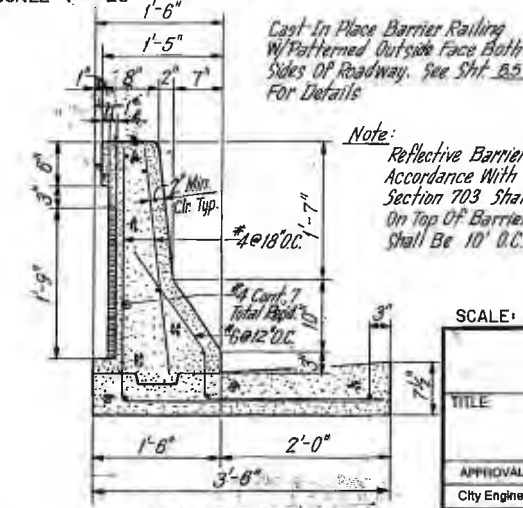

3 DETAIL
SCALE: 1" = 1'-0"

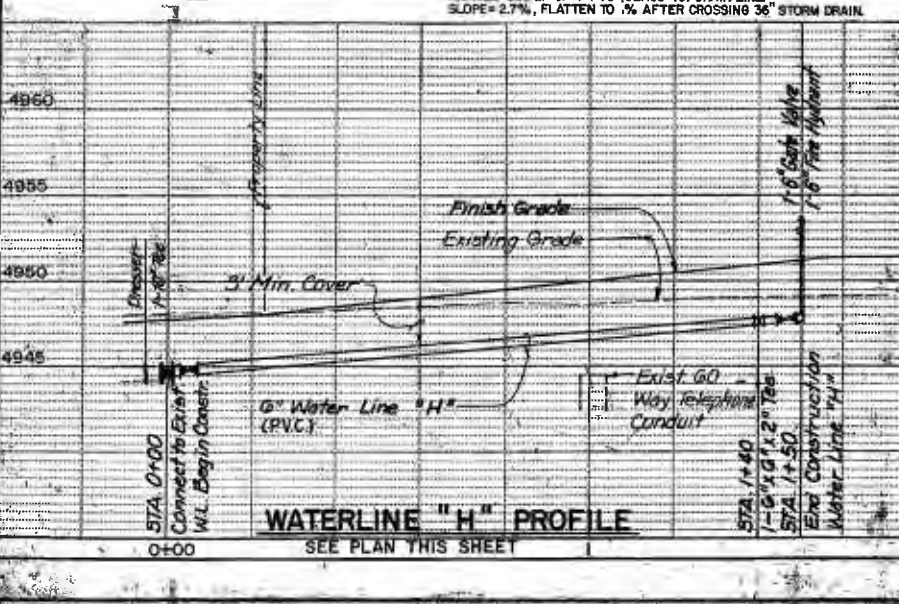

WATERLINE "H" PROFILE
SEE PLAN THIS SHEET

RECORD DRAWING

DATE: FEB 20 1990

These drawings have been revised based on the construction records of the owner. While the information is believed to be correct, the Engineer will not be responsible for any errors or omissions which may appear in the record drawings as a result thereof.

Note: Reflective Barrier Delineators In Accordance With N.M.S.H.D. Specification Section 703 Shall Be Installed On Top Of Barrier Railing. Spacing Shall Be 10' O.C.

CITY OF ALBUQUERQUE
MUNICIPAL DEVELOPMENT DEPARTMENT
ENGINEERING DIVISION

SCALE: 1" = 20'

TITLE: URBAN ROADWAY PUMP STATION SITE LAYOUT AND GRADING PLAN

APPROVALS: City Engineer, A.C.E. Design, A.C.E. Hydrology

DATE: 11/19/87, 12/1/87, 11/19/87


ENGINEER: Liquid Waste, Traffic, Water

DRAWING NO.: 3244

MAP NO.: K-14

SHEET: P1


QF: 43

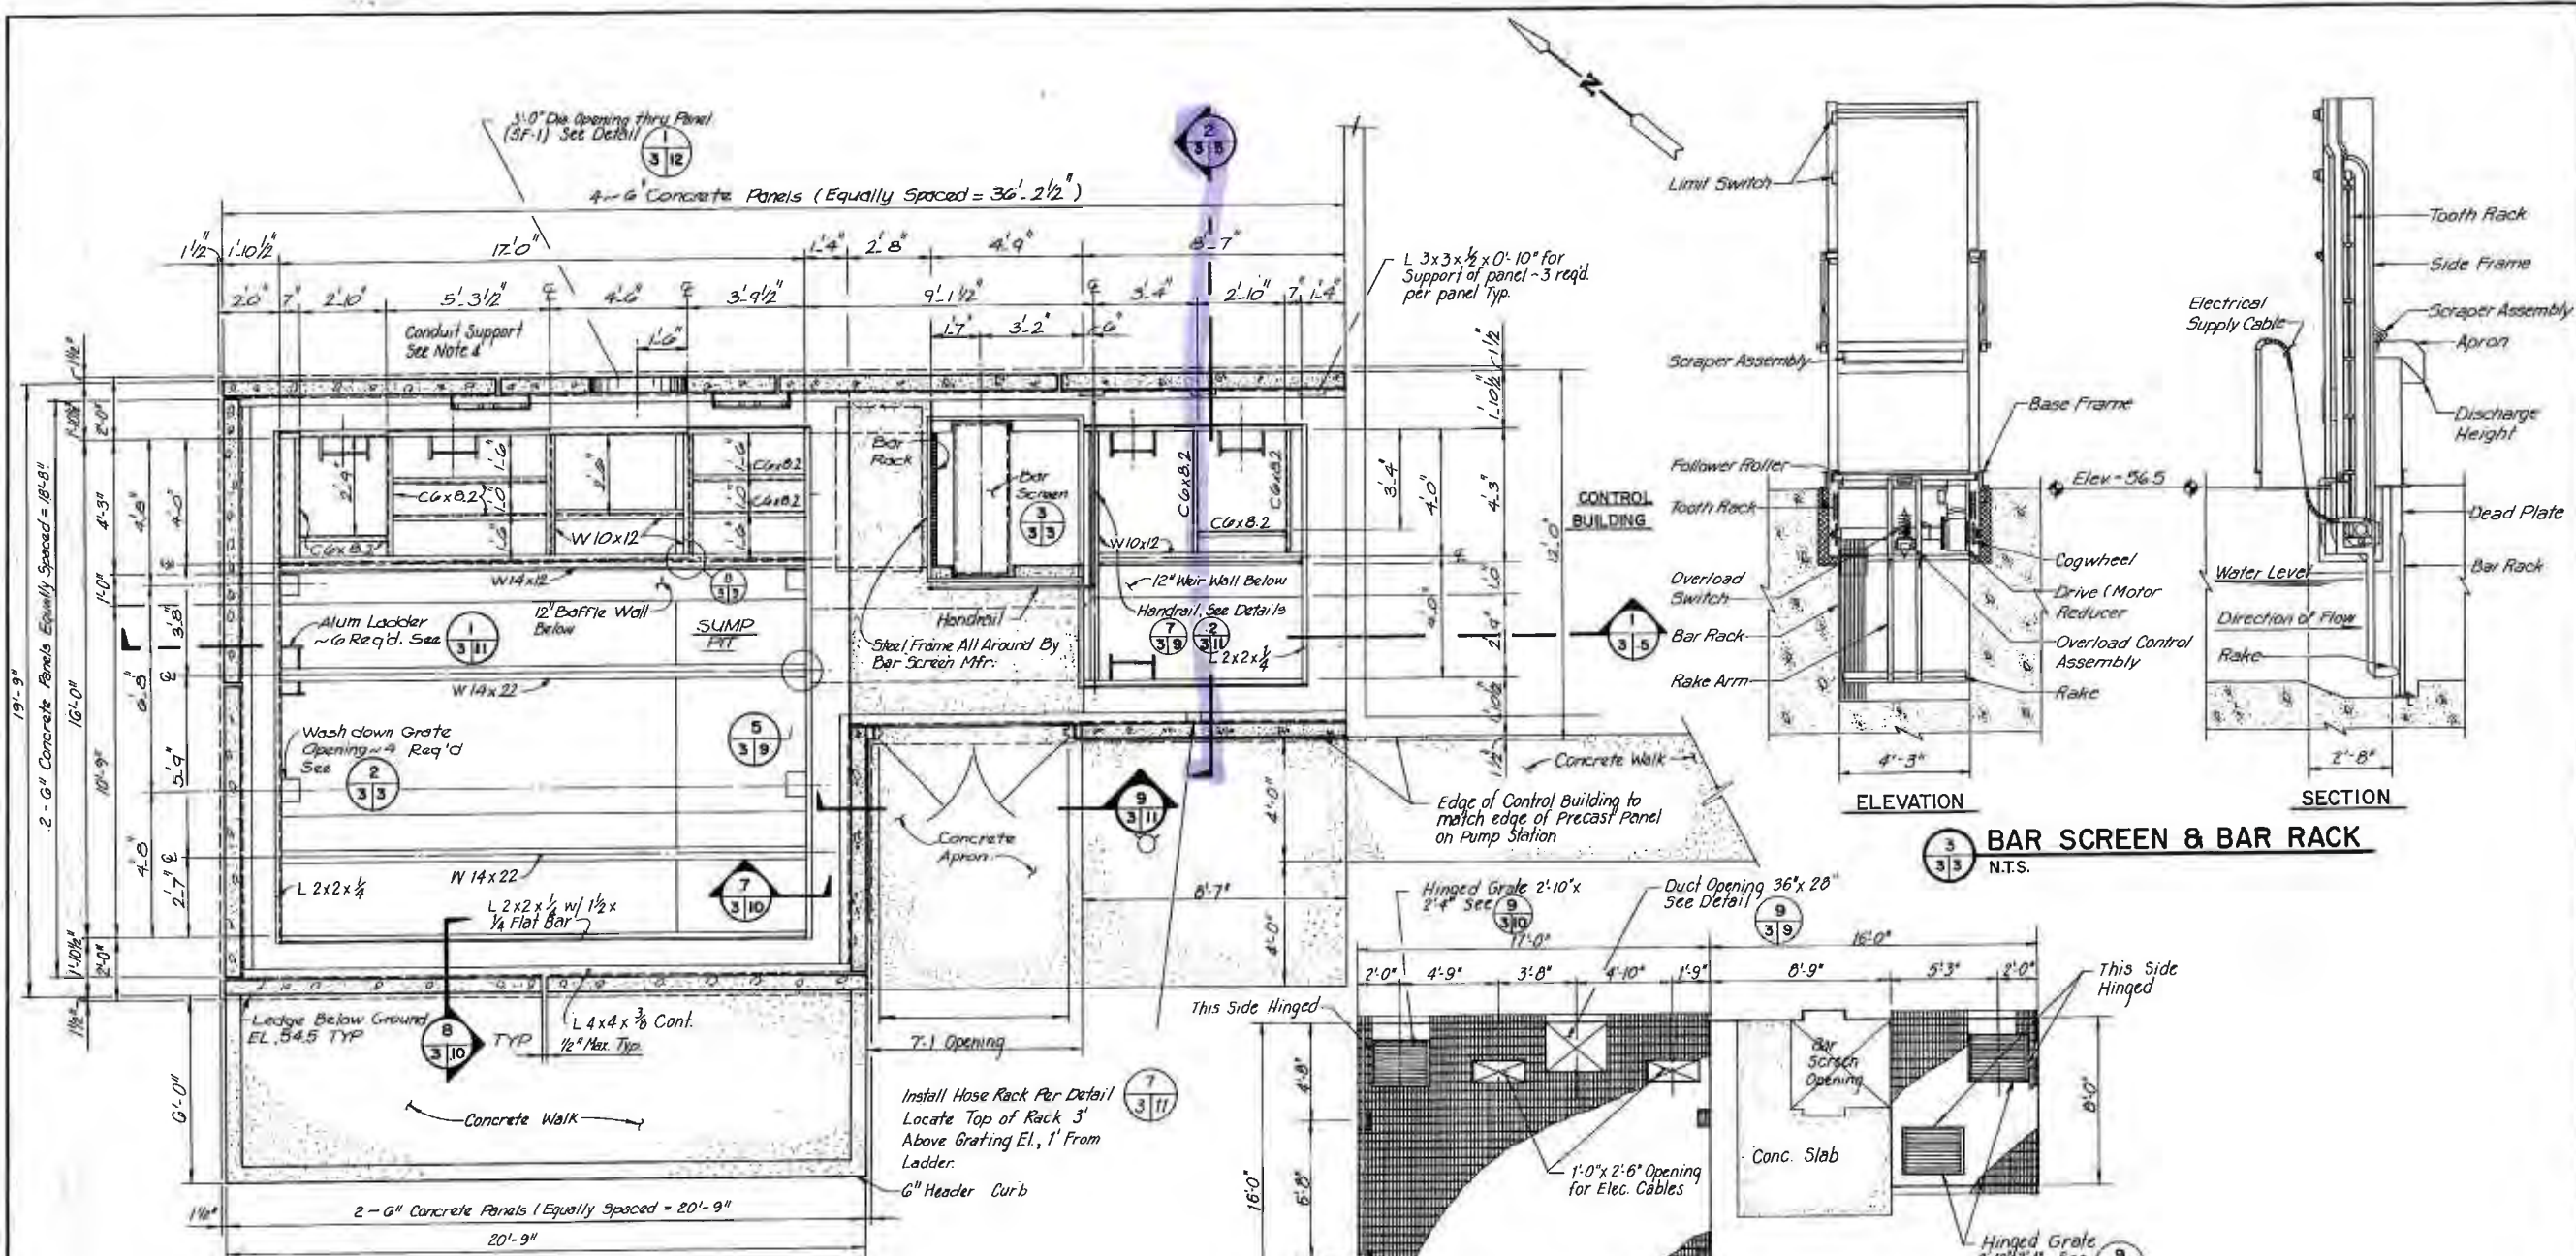

 **FLOOR PLAN**
SCALE: 3/8" = 1'-0"

- NOTES:**
1. For Aluminum Ladder Locations
See Piping Plan Sht 4.
 2. For Platforms see Sht. 4. for
locations. See Sht 10 for Details.
 3. For Precast Panels, See

10
39
 4. Support Members Not Shown For Clarity.

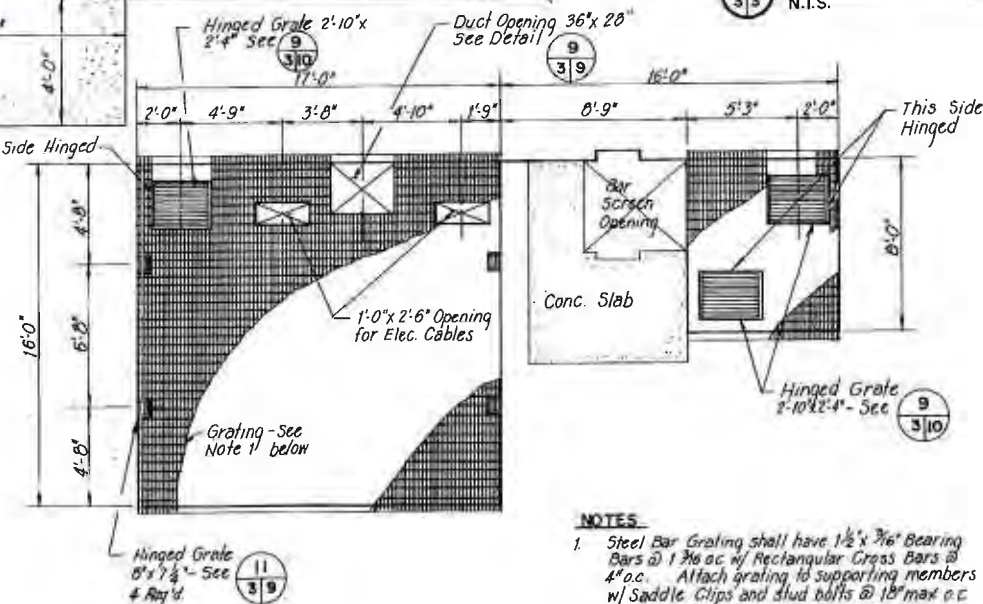

2
3 3

PLAN- GRATING LAYOUT @ EL. 56.50
SCALE: 1/4" = 1'-0"

- NOTES
1. Steel Bar Grating shall have $1\frac{1}{2} \times \frac{3}{8}$ " Bearing Bars @ 1" o.c. w/ Rectangular Cross Bars @ 4" o.c. Attach grating to supporting members w/ Saddle Clips and stud bolts @ 18" max o.c.

RECORD DRAWING
Date FEB 20 1990

These drawings have been revised based on the construction records of the owner. While the information submitted by the Owner will be assumed to be reliable, the Engineer will not be responsible for the accuracy of this information nor for errors or omissions which may appear in the record document as a result thereof.

CITY OF ALBUQUERQUE MUNICIPAL DEVELOPMENT DEPARTMENT ENGINEERING DIVISION					
TITLE * URBAN ROADWAY- PUMP STATION FLOOR AND GRATING PLANS					
APPROVALS	ENGINEER	DATE	APPROVALS	ENGINEER	DATE
City Engineer	<i>[Signature]</i>		Liquid Waste	<i>[Signature]</i>	11/19/87
A.C.E. Design	<i>[Signature]</i>	11-14-87	Traffic	<i>[Signature]</i>	12/14/87
A.C.E. Hydrology	CAM	11-15-87	Water	<i>[Signature]</i>	12/14/87
DRAWING NO.	3244		MAP NO.	K-14	
			SHEET	P3 OF 45	



TITLE:		URBAN ROADWAY PUMP STATION SECTIONS			
APPROVALS	ENGINEER	DATE	APPROVALS	ENGINEER	DATE
City Engineer	<i>[Signature]</i>		Liquid Waste	<i>[Signature]</i>	11/19/18
A.C.E. Design	<i>[Signature]</i>	11/19/18	Traffic	<i>[Signature]</i>	11/19/18
A.C. E-Hydrology	<i>[Signature]</i>	11-19-18	Water	<i>[Signature]</i>	11/19/18
DRAWING NO.		MAP NO.		SHEET OF	
3244		K-14		P5 OF 47	

