

APPENDIX 2.8 –

MANHOLE STORM DRAIN AS-BUILTS

FOR:


14TH Street and Mountain Rd.

Manhole # 22 Location Maintran + 14th Date 3-23-10


Notes S.E. Intersection

COA MH # 25656


COA 25656
RIM 4959.18
MH INV 4948.86

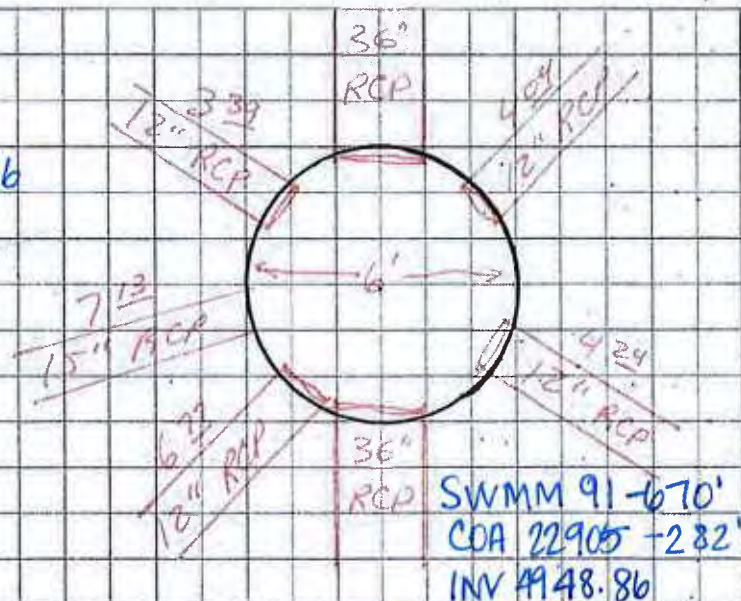

1 of 2

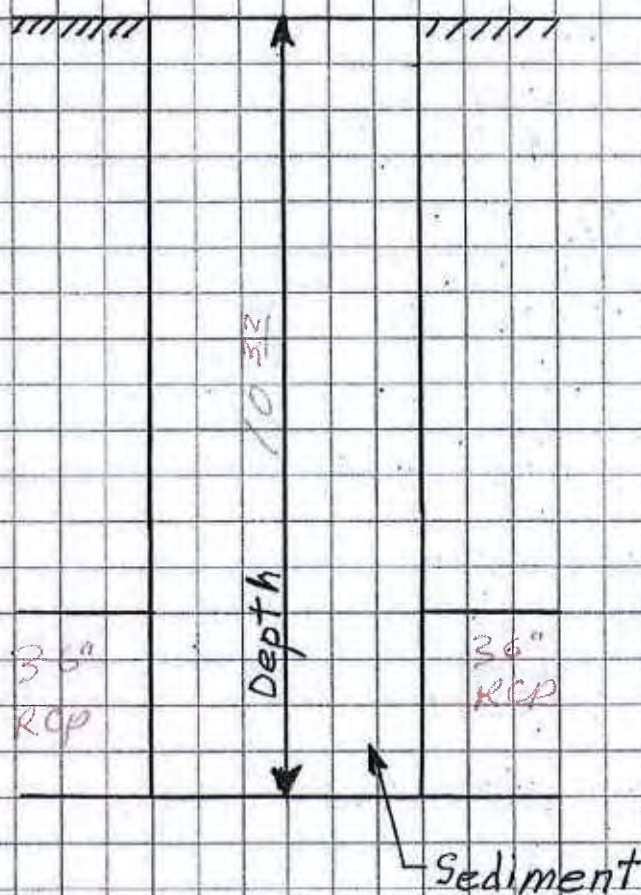


25656

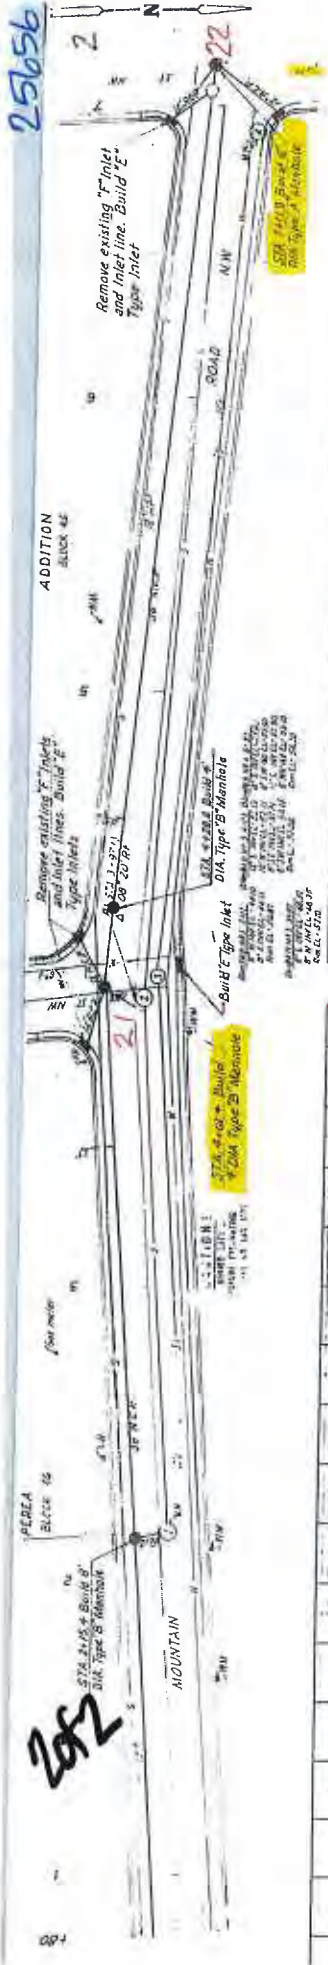


22



22

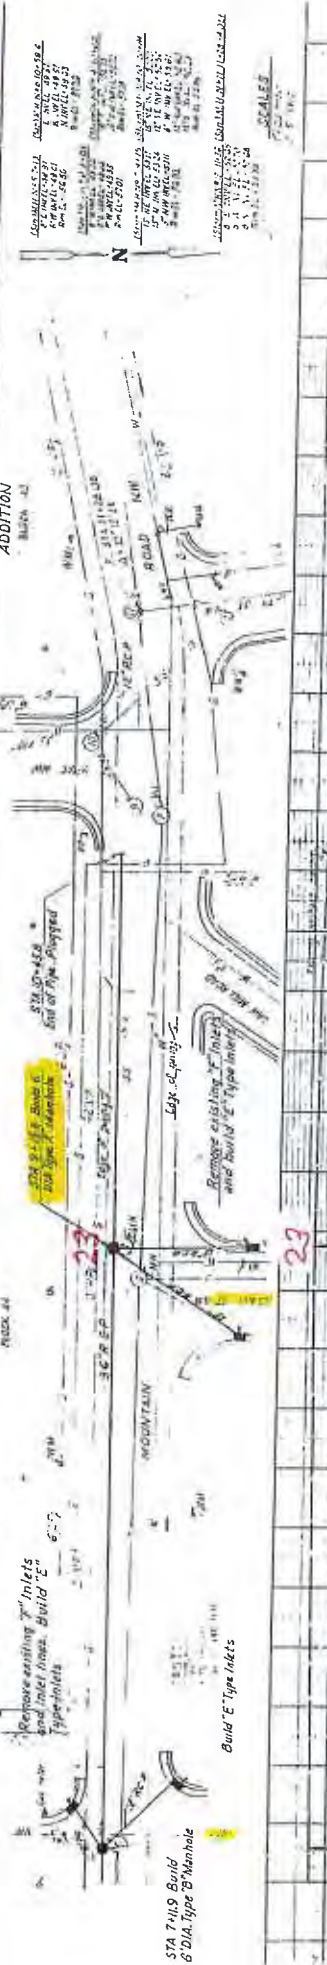

23

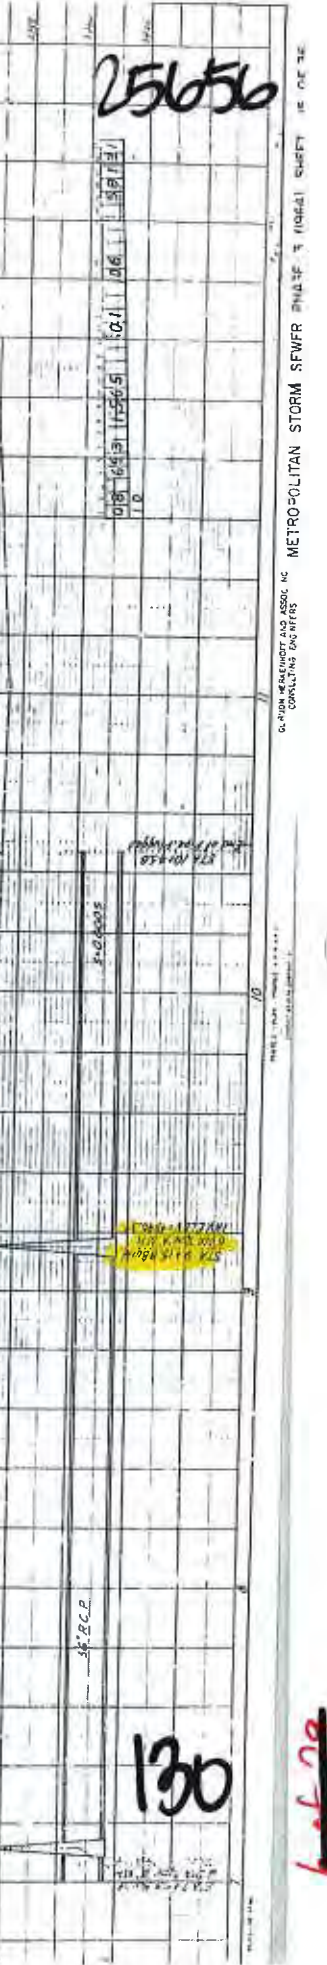

24

25656

130

66 109



Manhole # 3400

Location 12th & Mountain

Date 5-17-11





Notes E. Bound Center Intersection

COA MH # 25677

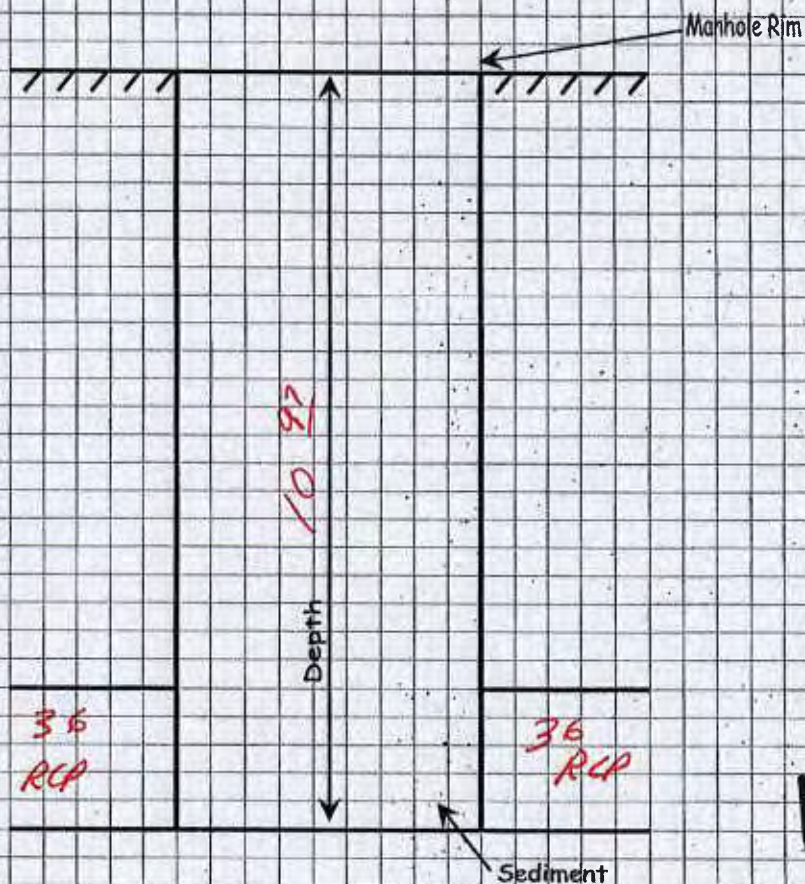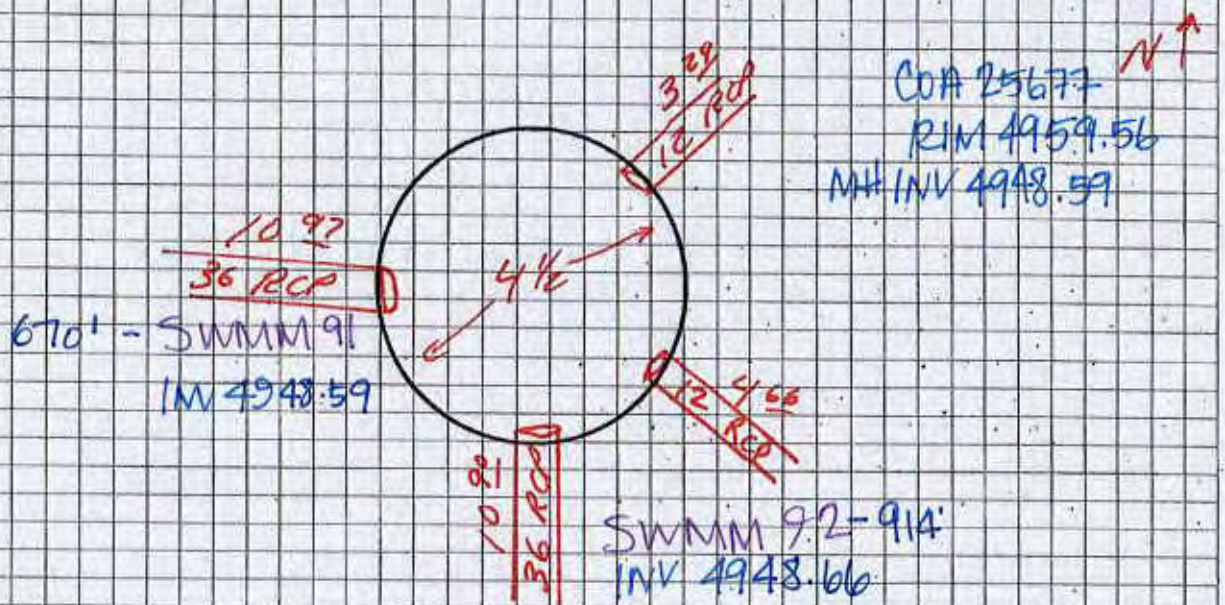

1 of 2

131

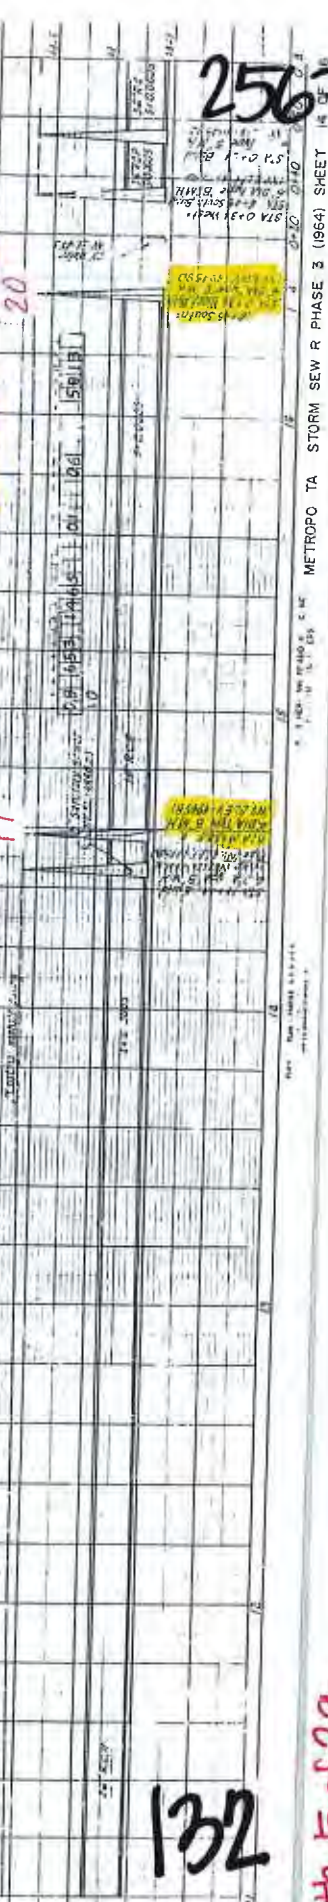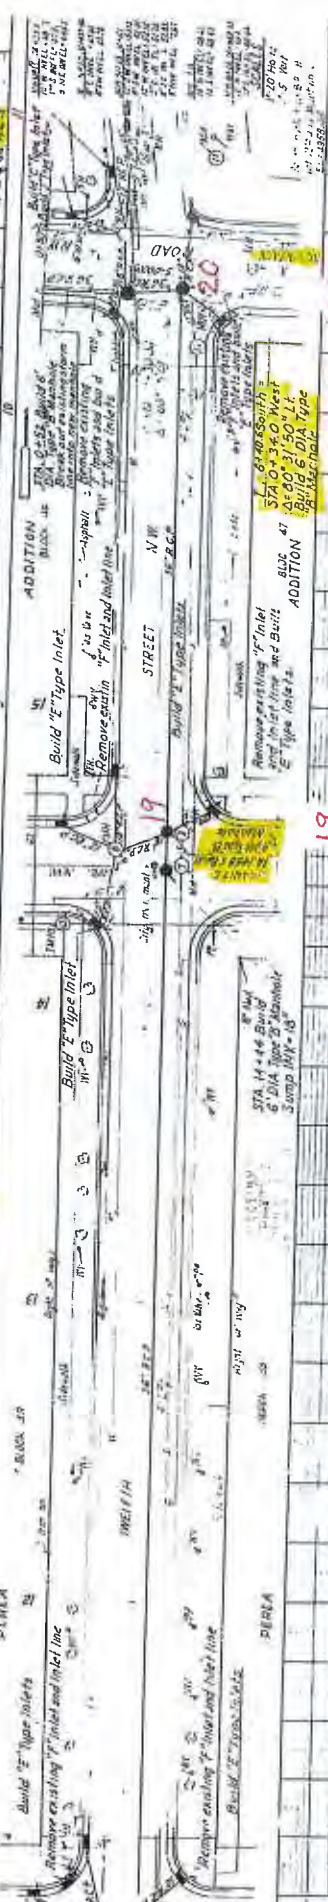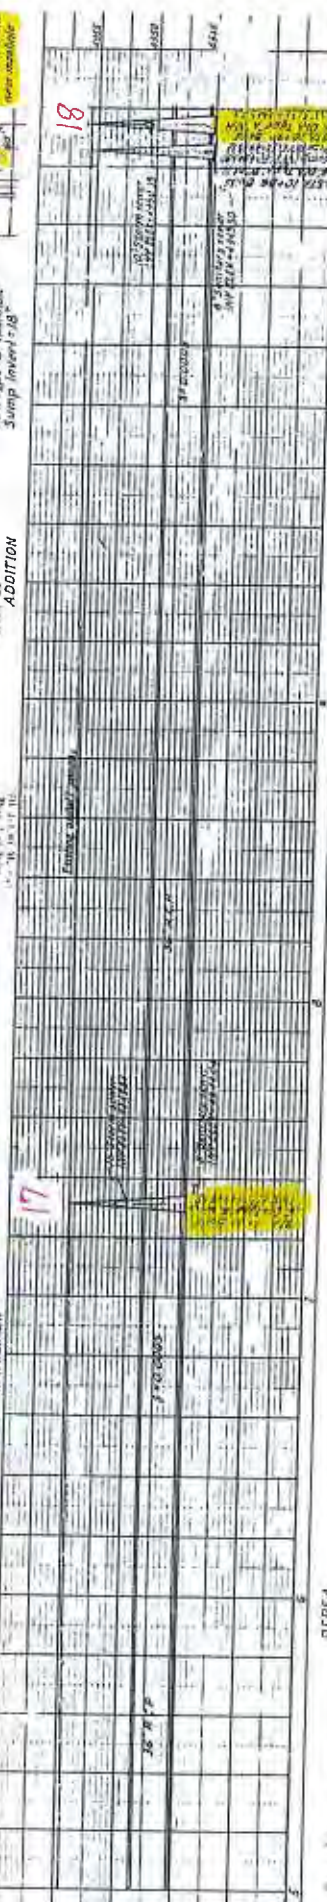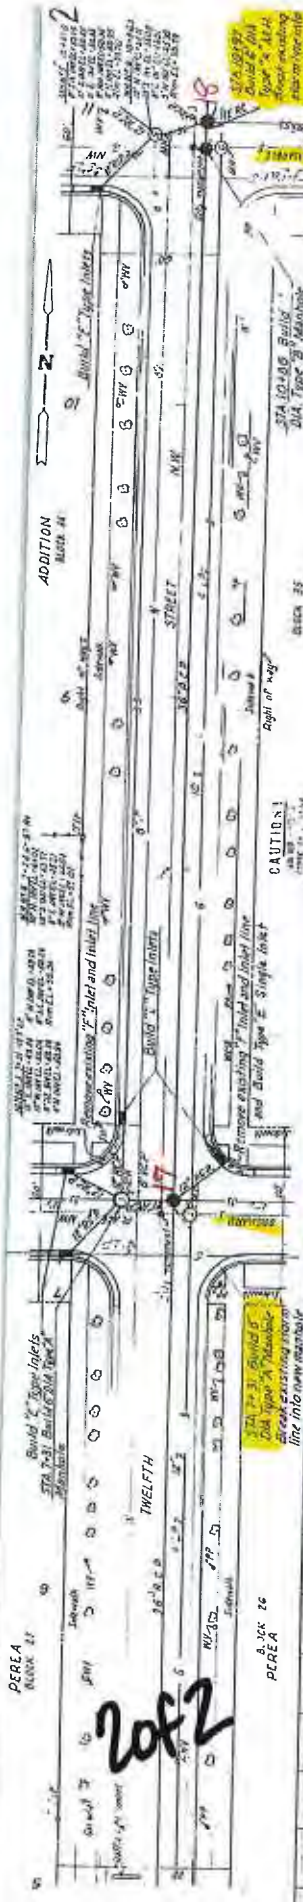

25677

132

17254

Manhole # 17 Location 12th + Orchard Place Date 3-23-10

Notes East Center Intersections

COA MH # 25622

SWMM 92-914'

COA 22861-341'
INV 4948.38

36"
RCP

COA 25622
RM 4957.82
MH INV 4948.24

858
22" RCP



SWMM 93-752'
COA 22863-296'
INV 4948.24

36"
RCP

1 of 2

36"
RCP

Depth

36"
RCP

133


Sediment

2 of 2



STA. 10+85 Build'
DIA. Type "B" Manhole
Summ. Invert = 19"

ADDITION

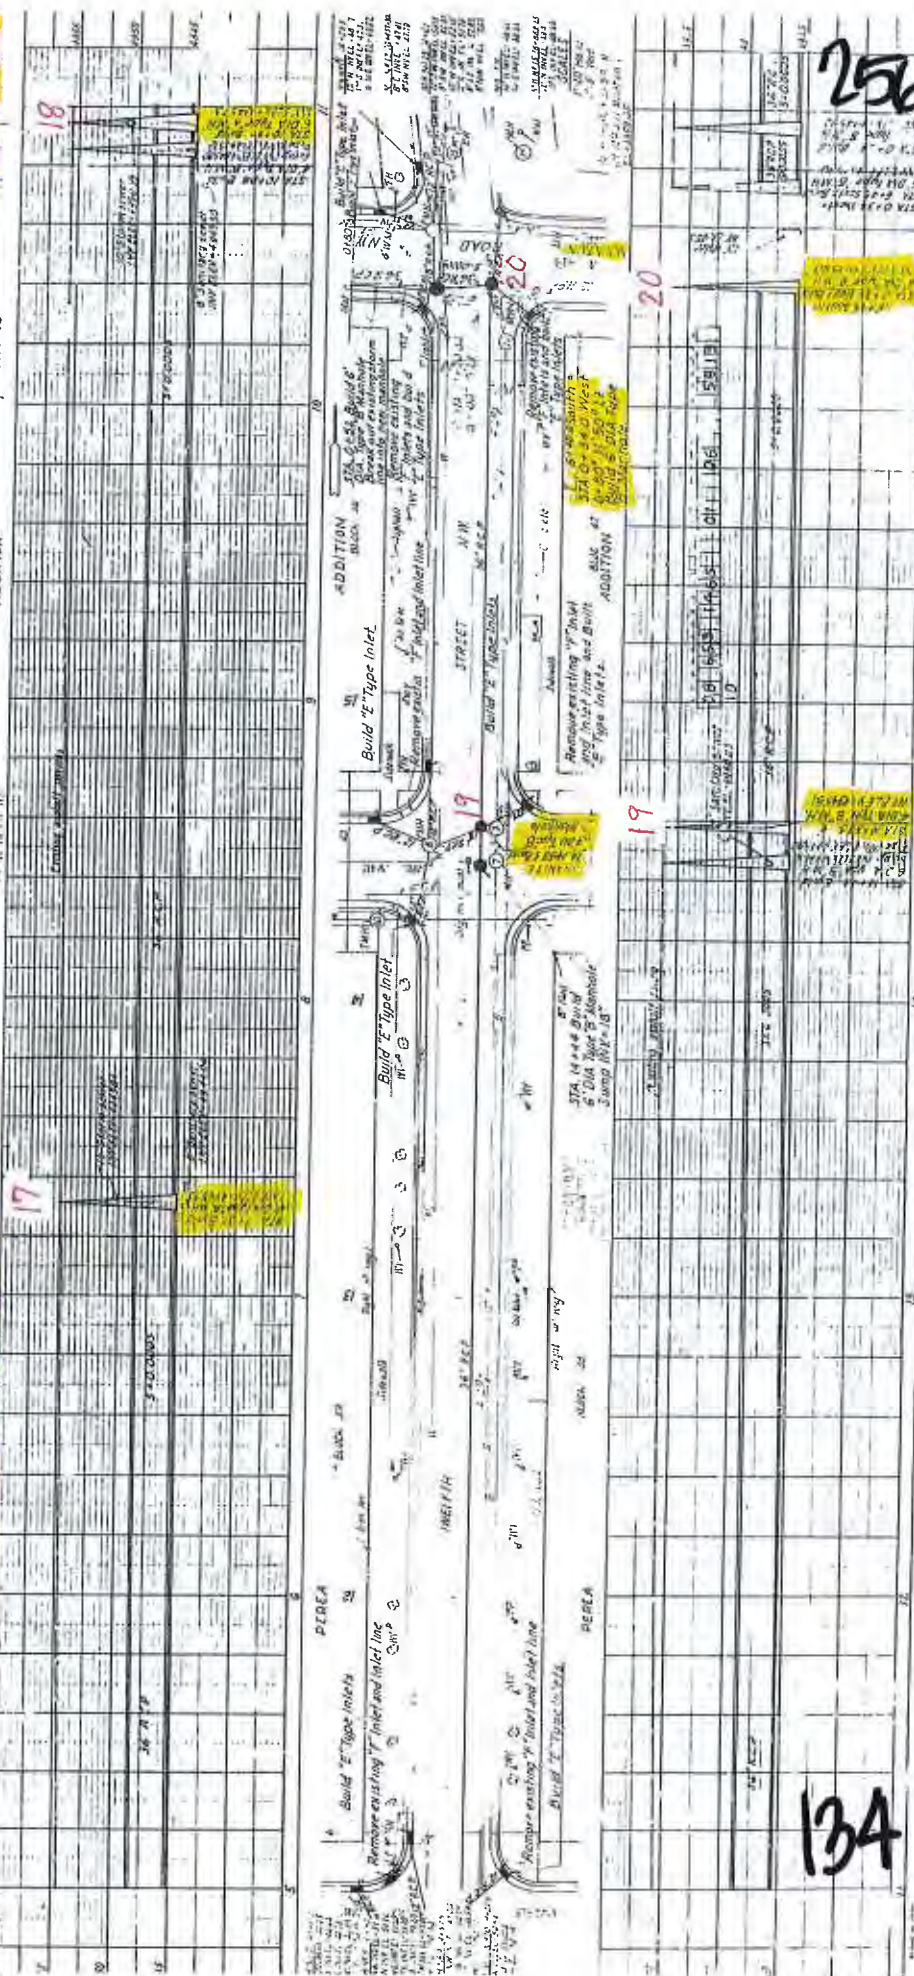

134

14th 5 of 29

METROPO TA STORM SEW R PHASE 3 (1964) SHEET

1998-1999

62

Manhole # 14 Location Fruit + 12th


Date 3-23-10

Notes S.E. Intersection

COA MH # 25105
~~22301~~

SWMM 94-280'
COA 22305-22
INV-4946.31

10 3/4"
48"
RCP

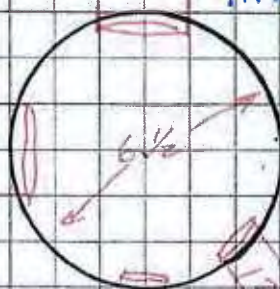

SWMM 93-752'
COA 22301-17'
INV 4946.47

COA 25105
RIM 4956.51
MH INV 4946.31

1 of 2

48"
RCP

Depth
10 20

48"
RCP

135

Sediment

Manhole # 11001

Location 1220 Fruit

Date 5-16-11

Notes

COA MH # 25109


COA 25109

RIM 4956.54

MH INV 4945.87

N ↑

48 RCP
SWMM 95-389'
INV 4945.87

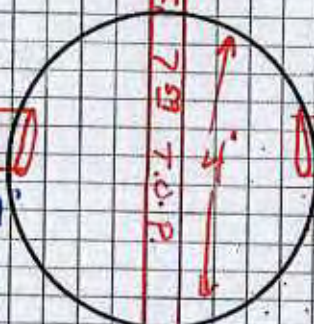

48" RCP
SWMM 94-280'
INV 4945.87

Sewer

Manhole Rim

10' 87"

Depth




1 of 2

48"
RCP

48"
RCP

Sediment

137

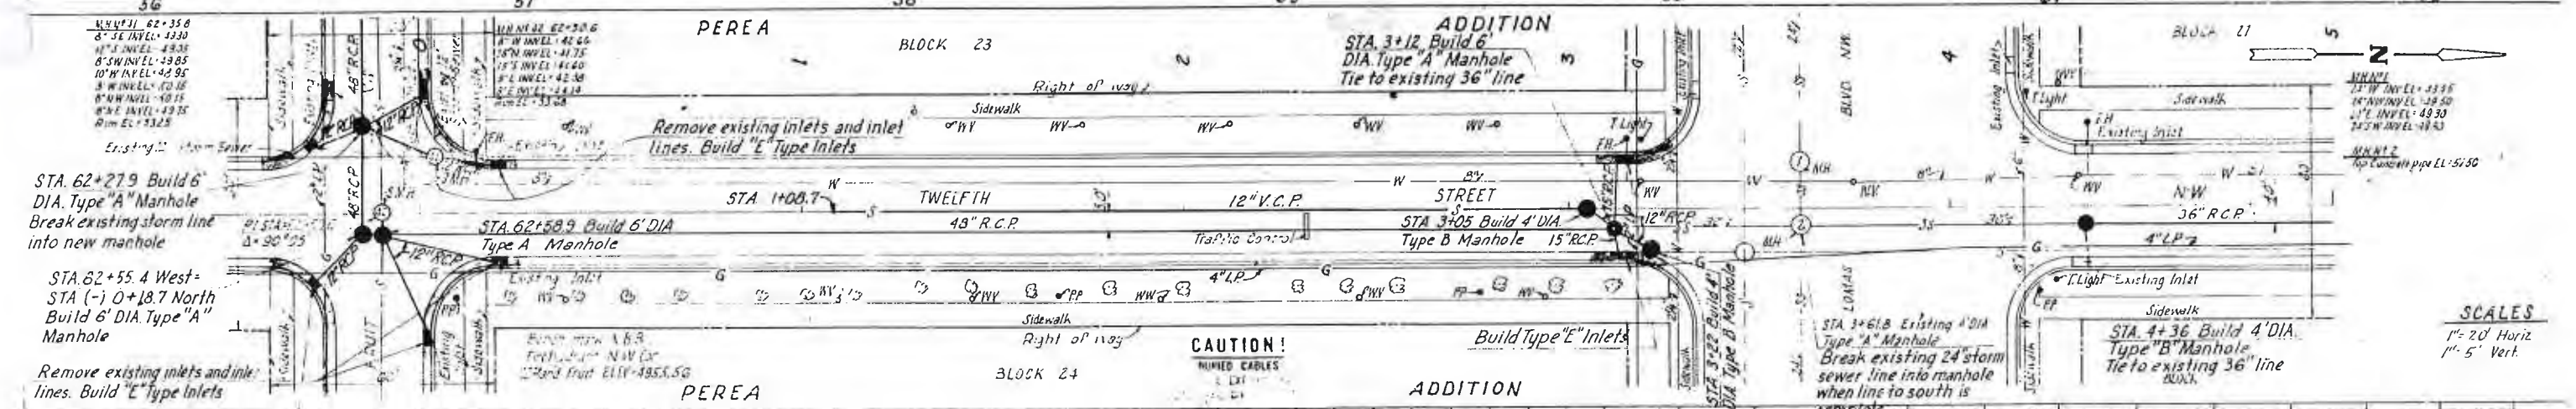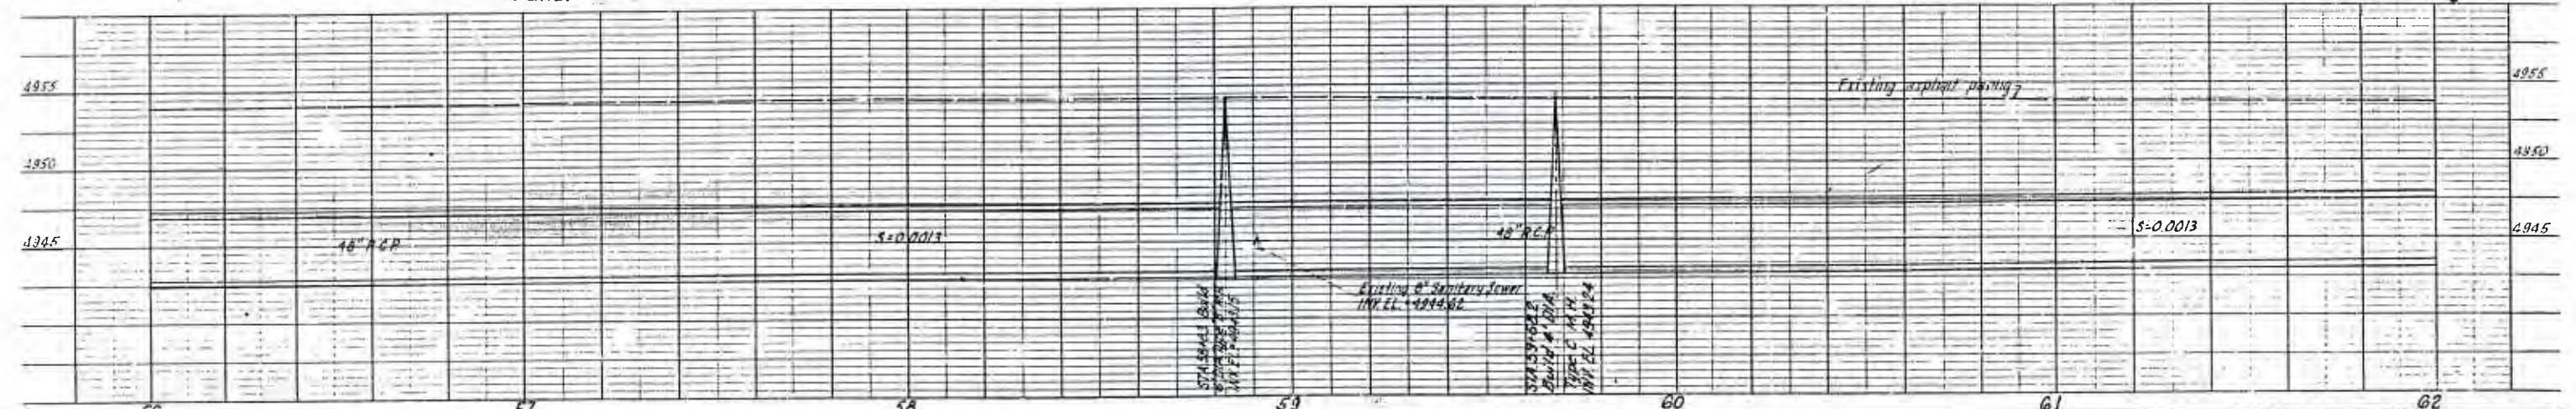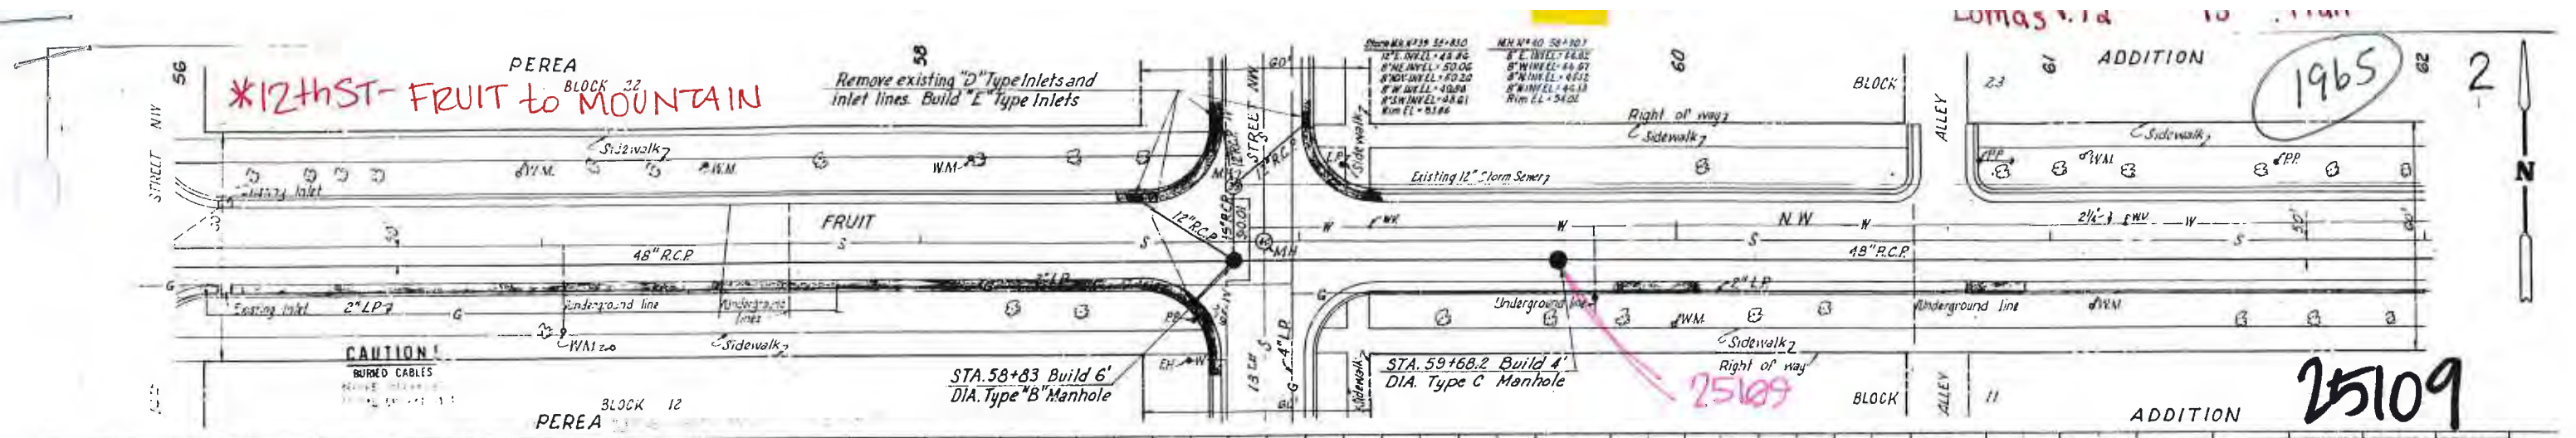

26f2

138


Manhole # 12 Location Fruit + 14th

Date 3-23-10

Notes S.E. InterSection

COA MH #25117


COA 25117
RIM 4956.55
MH INV 4945.26

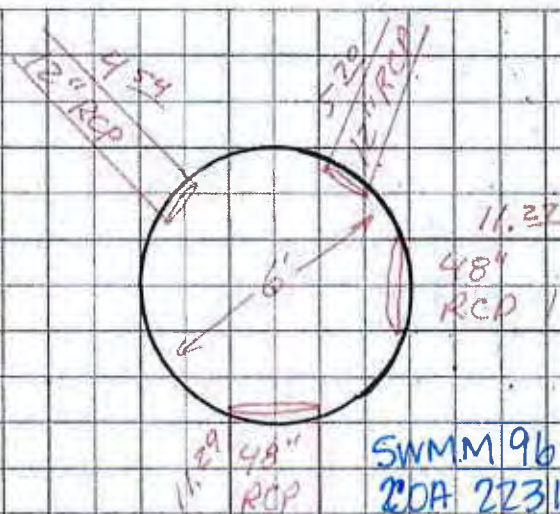

SWMM 95-389'
COA 22315-12'
INV 4945.28


SWMM 96-342
COA 22316-180'
INV 4945.26

1 of 2

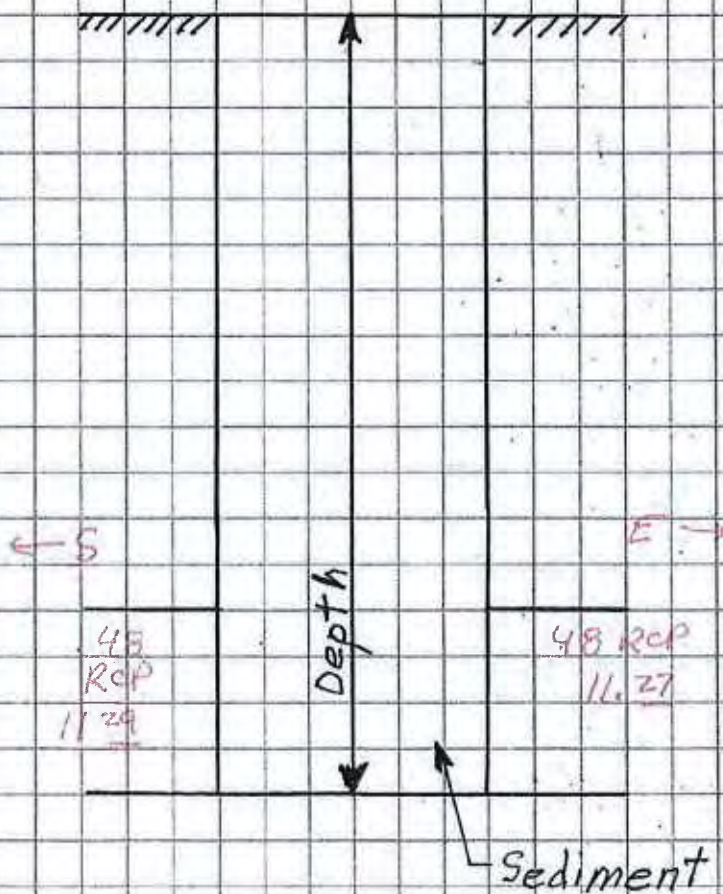

139

2 of 2

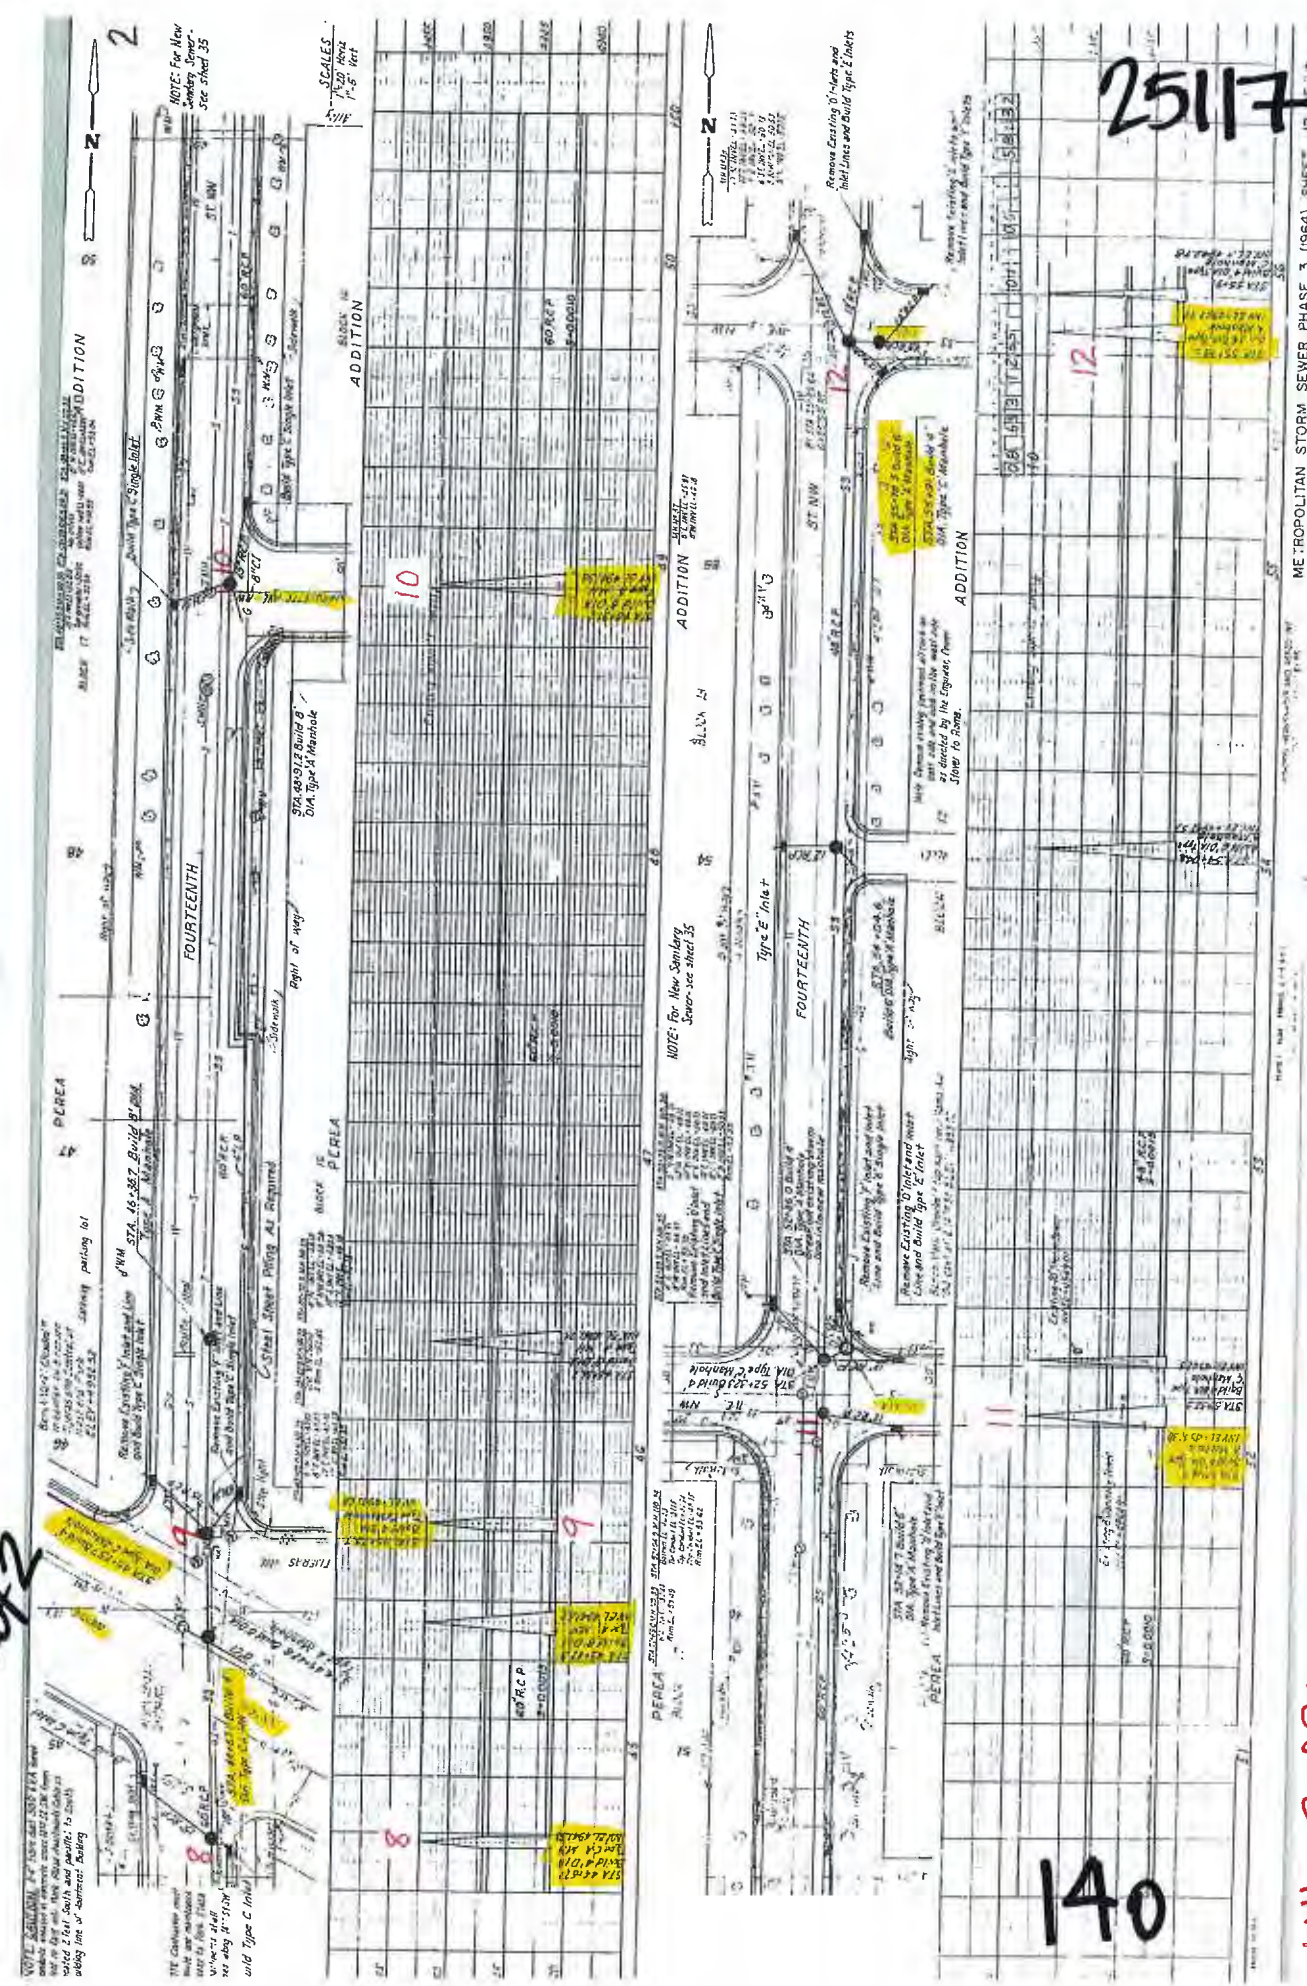

25117



140

14th 3 of 29

Manhole # 11 Location 14th + Roma Date 3-23-10

Notes S.E. Intersection

COA MH # 25048

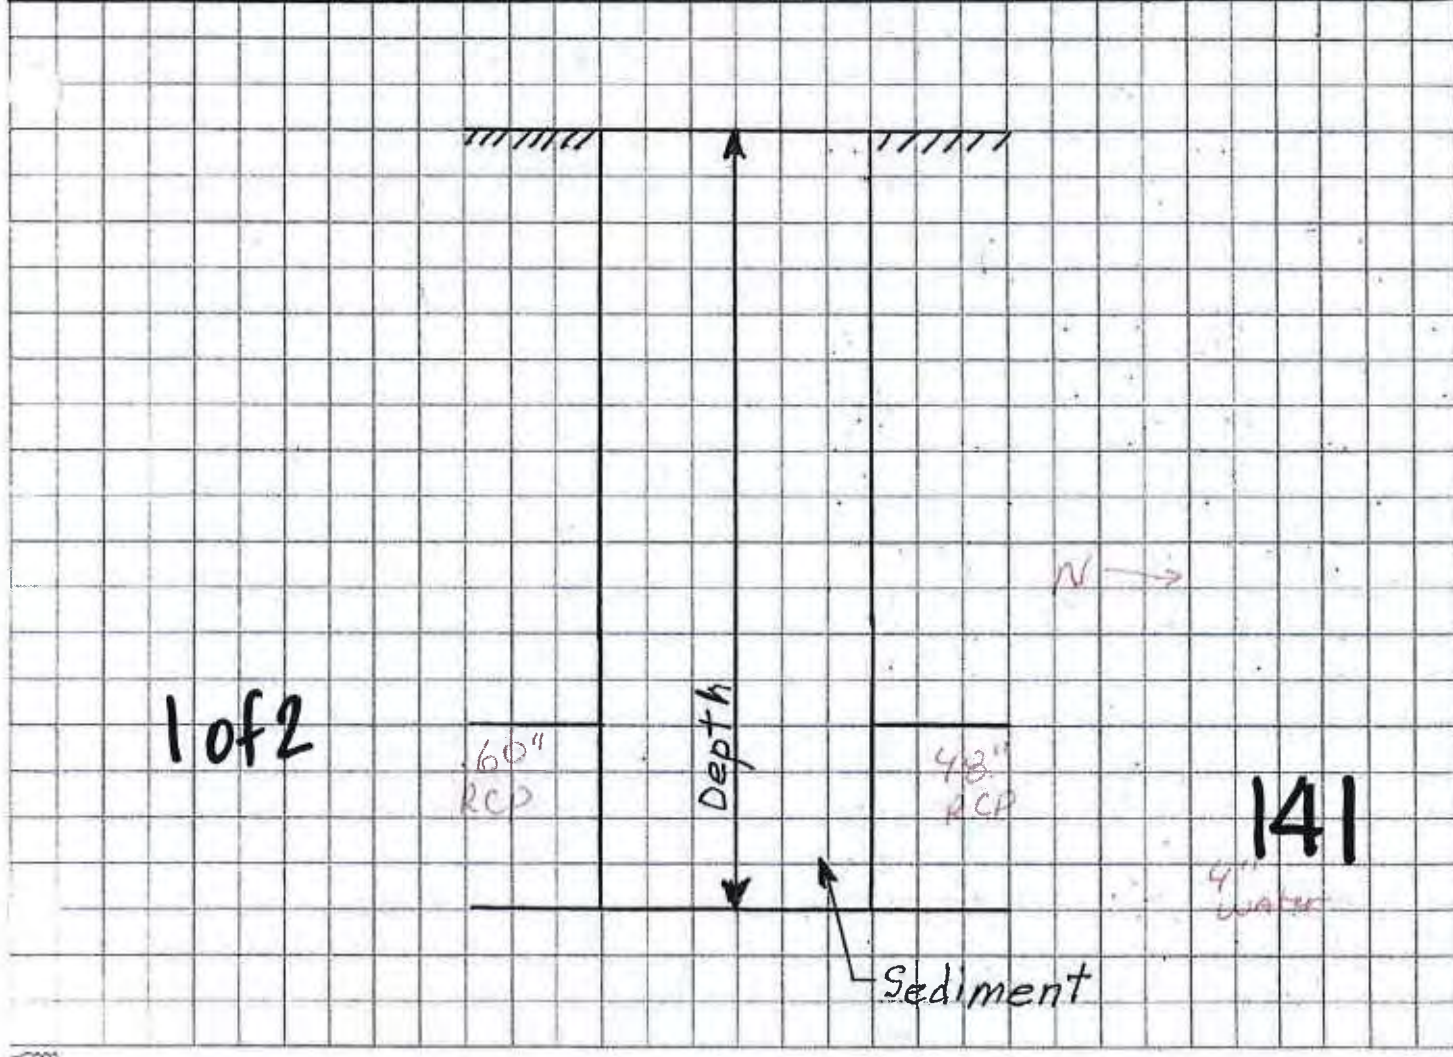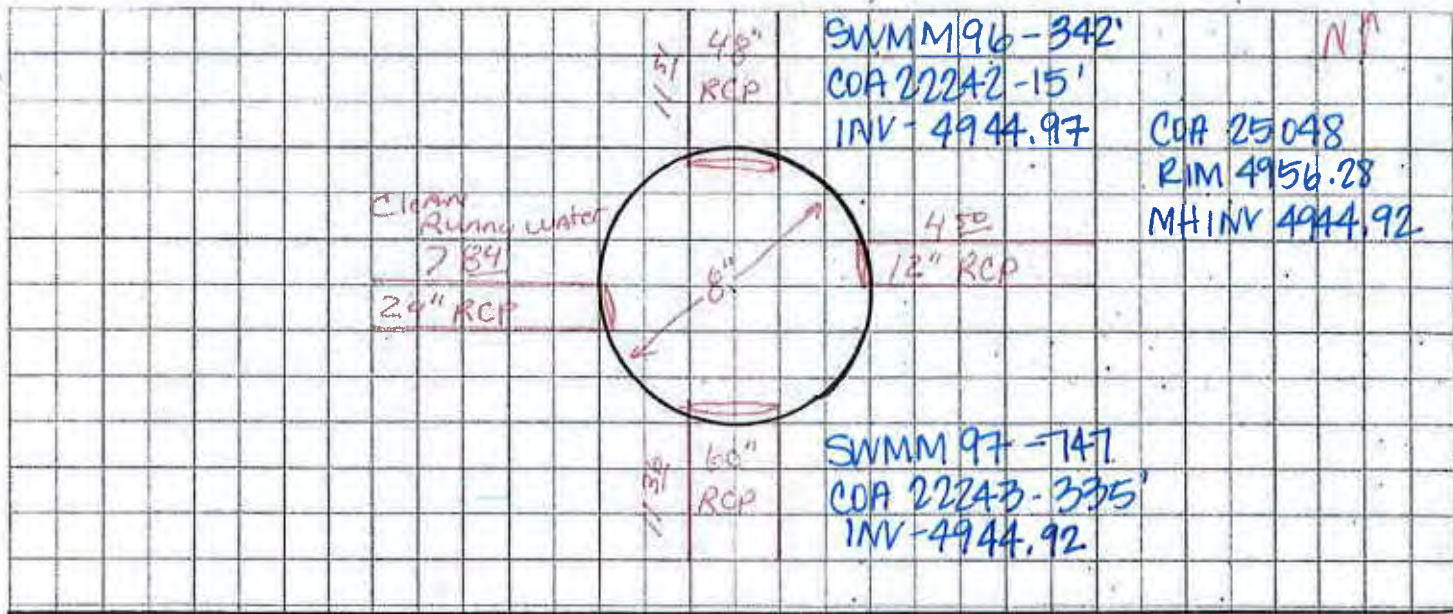

2082



with 3 of 29


Manhole # 9 Location 14th + Central Date 3-23-10

Notes N.E. Inter section

COA MH # 25034


COA 25034
RM 4954.52
MH INV 4943.82

SWMM 97-747
COA 22288-67'
INV 4943.82

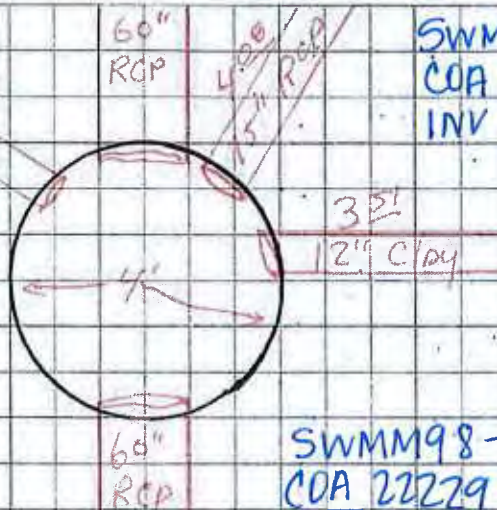

SWMM 98-1976
COA 22279-33'
INV 4943.82



1 of 2

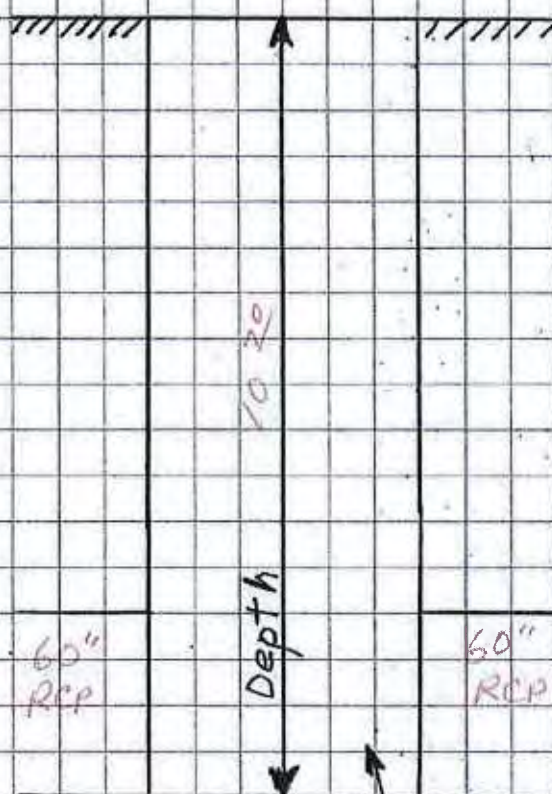

Sediment

143

25034

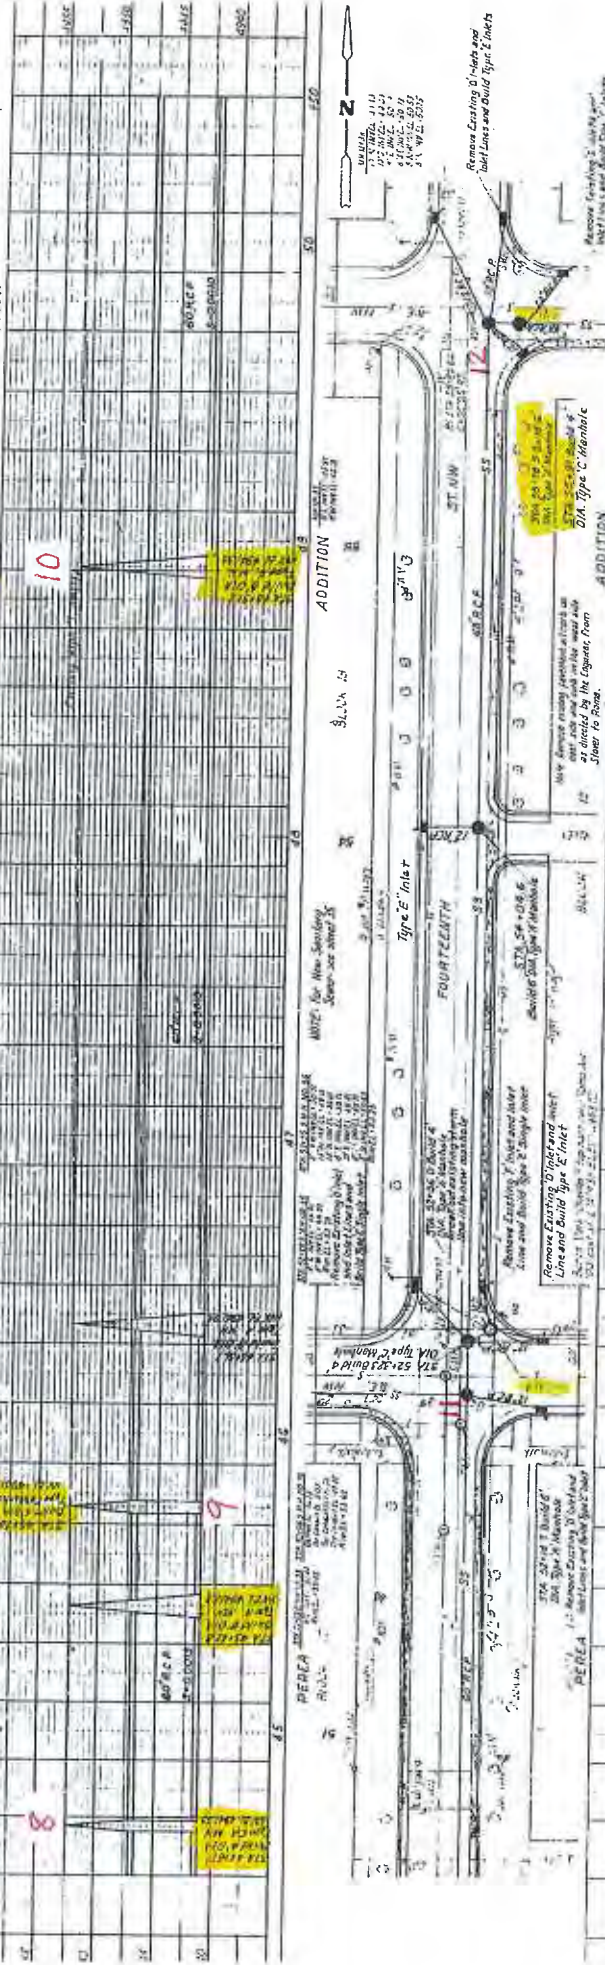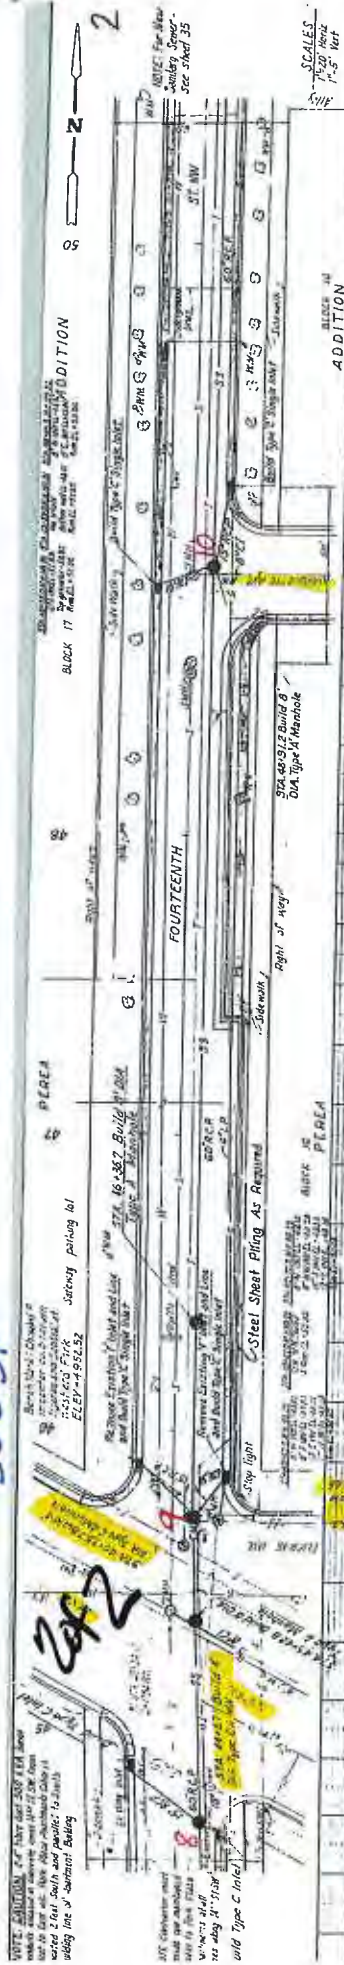

11th 3 of 29

Manhole # 7800


Location 14th ST & LEAD

Date 5-17-11

Notes N.E. Intersection

COA MH # 9045

SWMM 98-1976
INV 4941.67

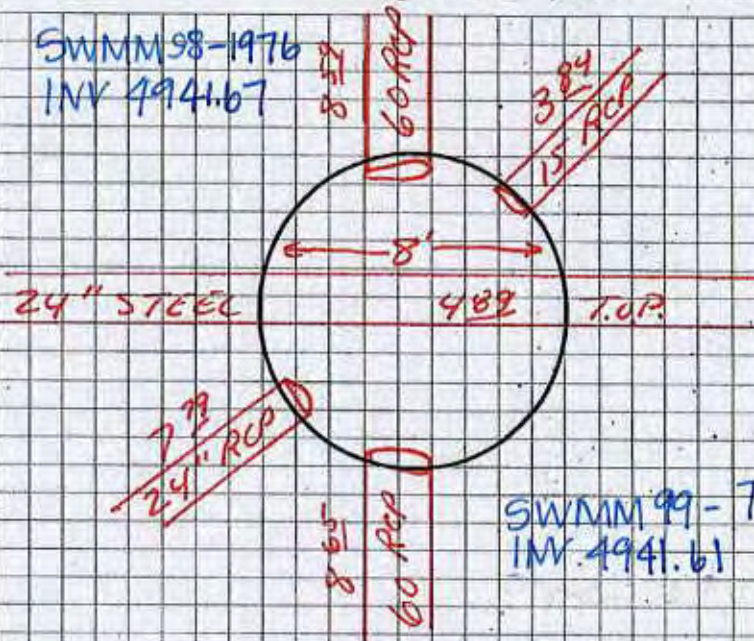

COA 9045
RIM 4950.26
MH INV
4941.61

SWMM 99-740
INV 4941.61

Manhole Rim

8' 6.5"

Depth

60"
RCP

60"
RCP

Sediment

1 of 2

145


Date 5-17-11

Notes S.E. InterSection

COA MH# 24902

740

SWMM 99
INV 4940.39

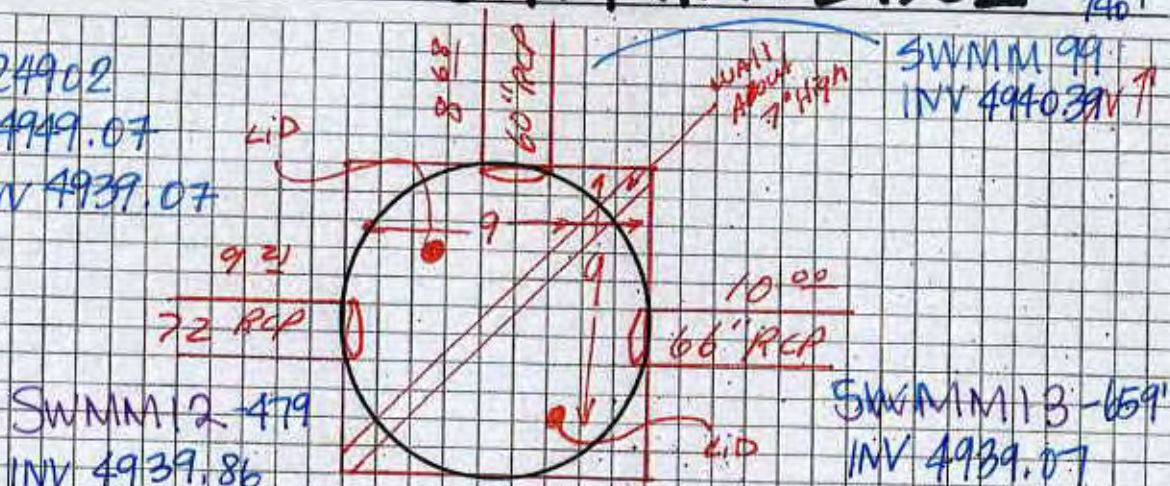


1 of 2




147

19+00

20+00

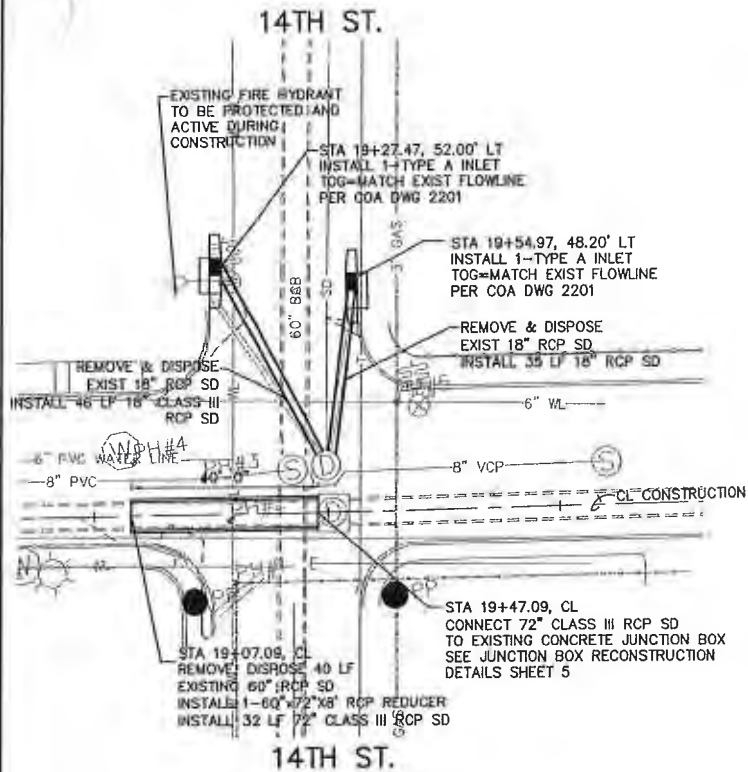

SCALE:
HORIZ: 1" = 20'
VERT: 1" = 5'

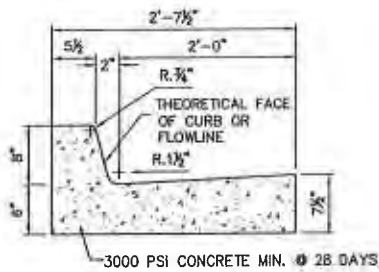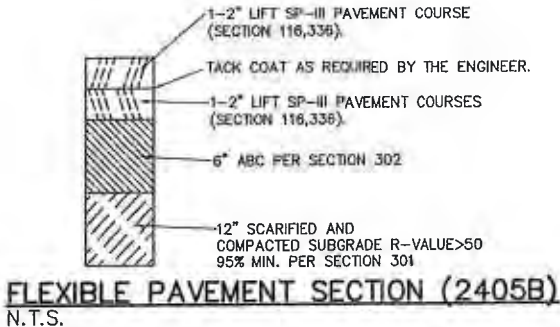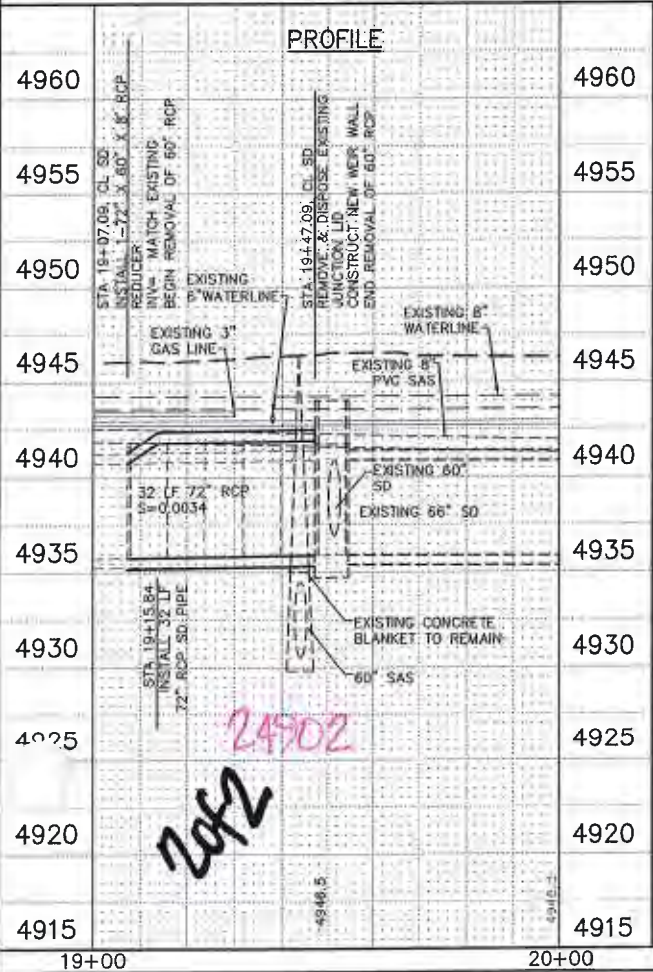

STANDARD CURB & GUTTER
SCALE 1" = 1'

2-08-08

24902

CITY OF ALBUQUERQUE DEPARTMENT OF MUNICIPAL DEVELOPMENT	
IRON AVE/14TH ST JUNCTION BOX & STORM DRAIN RECONSTRUCT IRON AVE STORM DRAIN PLAN & PROFILE	
Design Review Committee	City Engineer Approval
145	
WCEA #06600123 APR 2007	City Project No. 7963.04 Zone Map No. K-13
Sheet 4	Of 4

AS-BUILT	INFORMA	
CONTRACTOR	NMLT	
DATE	2-08-08	
BY	WEL	
REVISIONS		
NO.	DATE	REMARKS
1		
2		
3		
