

APPENDIX 2.8 –

MANHOLE STORM DRAIN AS-BUILTS

FOR:

Rio Grande Blvd. and I-40

Manhole # 12 Location Rio Grande + Carson RD. Date 4-27-10


Notes S.W. Intersection

COA MH # 7444

COA 7444
RIM 4960.59
MH INV 4952.87

N ↑

758
30" x 17"
OVAL

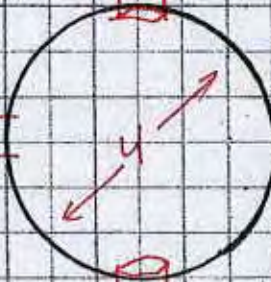

764
24" RCP

SWMM1-1361
COA 12067-211
INV 4952.95

1 of 2

24"
RCP

722


Depth

24"
RCP

Sediment

149

20x2

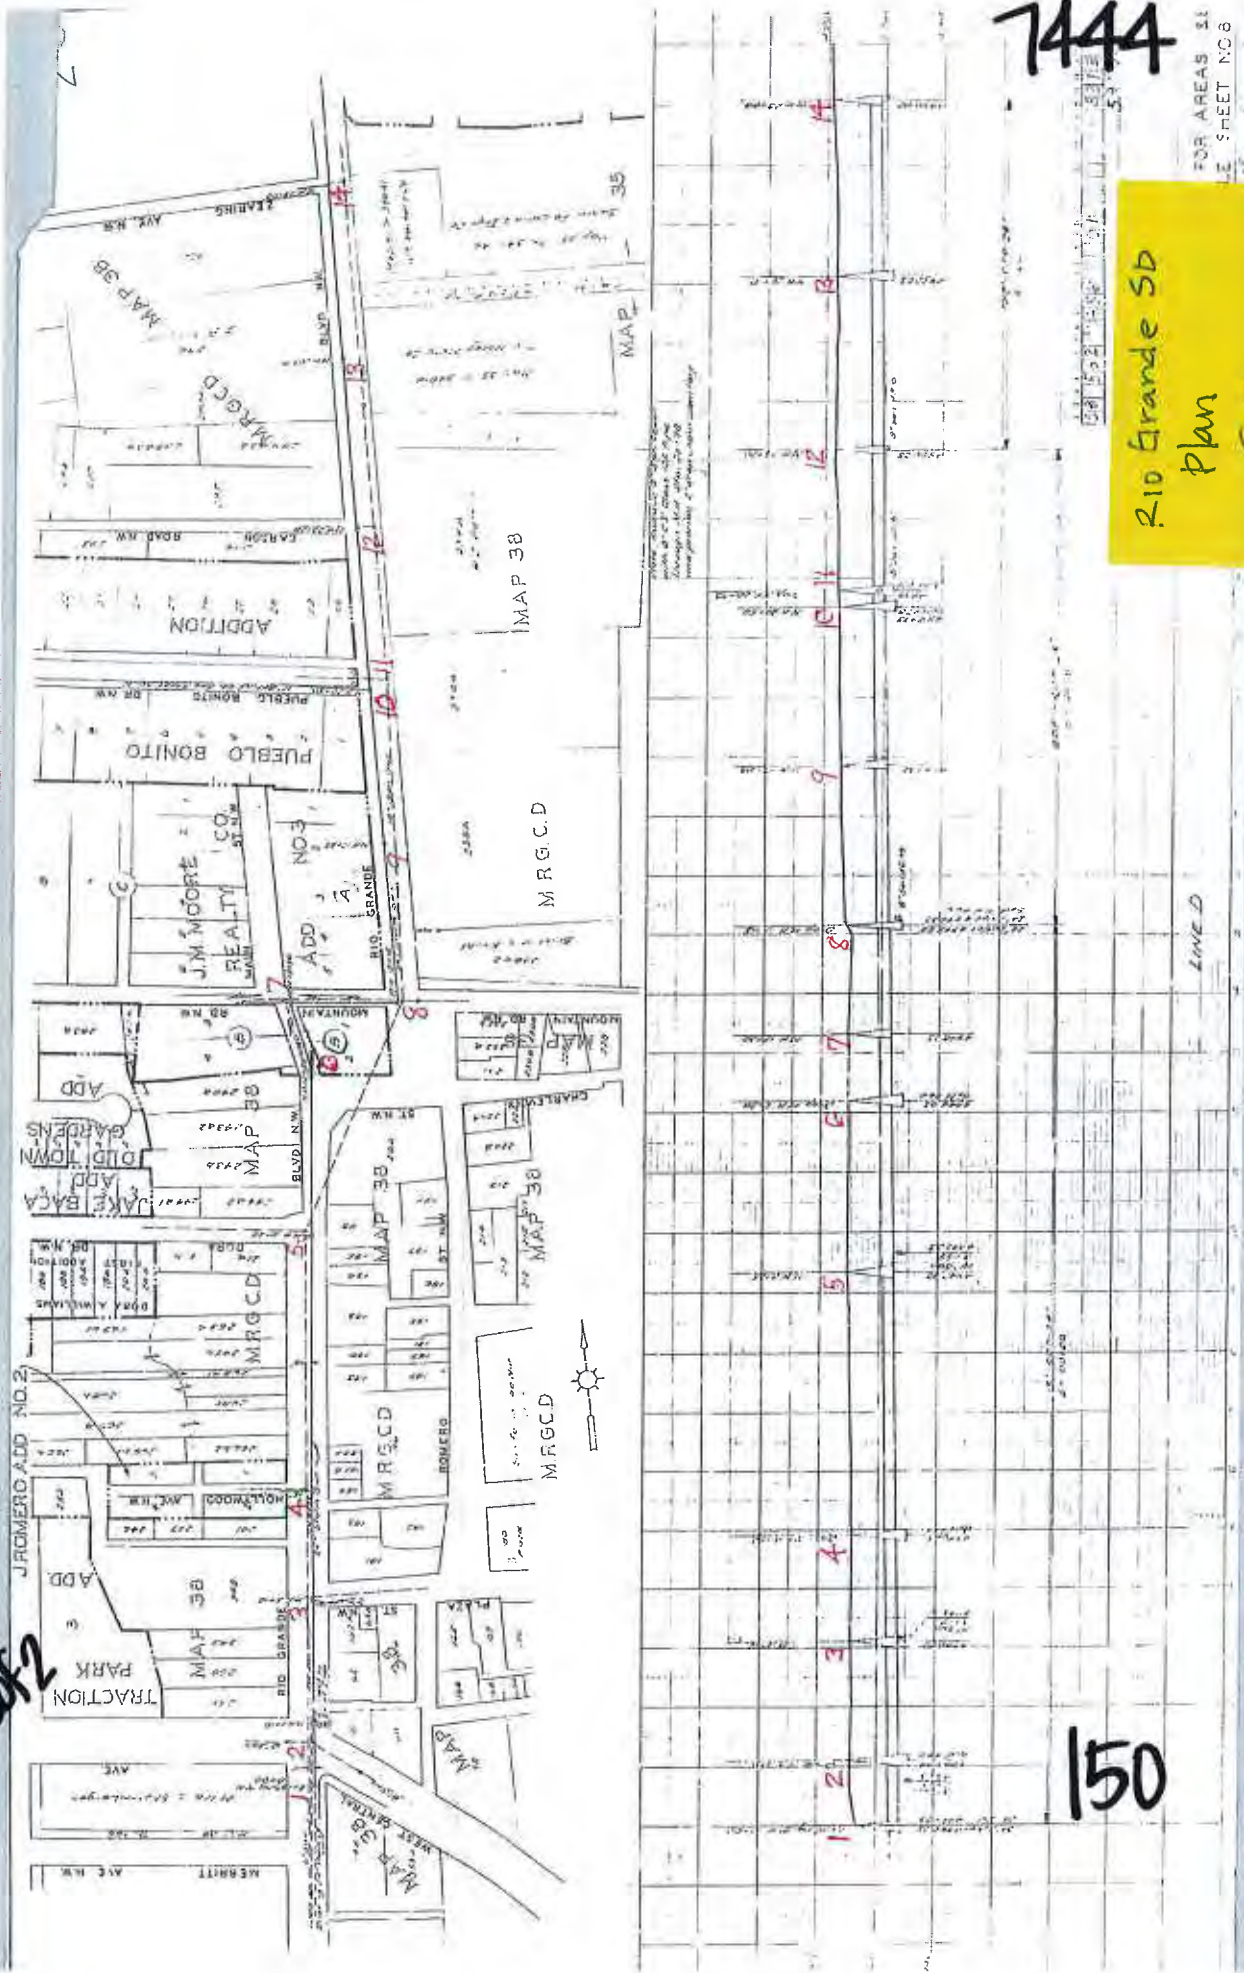

7444


210 Grande SB
plan
(5)

~~12 is Gravel 1 of 44~~

Manhole # 5 Location Rio Grande + DORA Date 4-27-10

Notes Center Intersection

COA MH # 7476

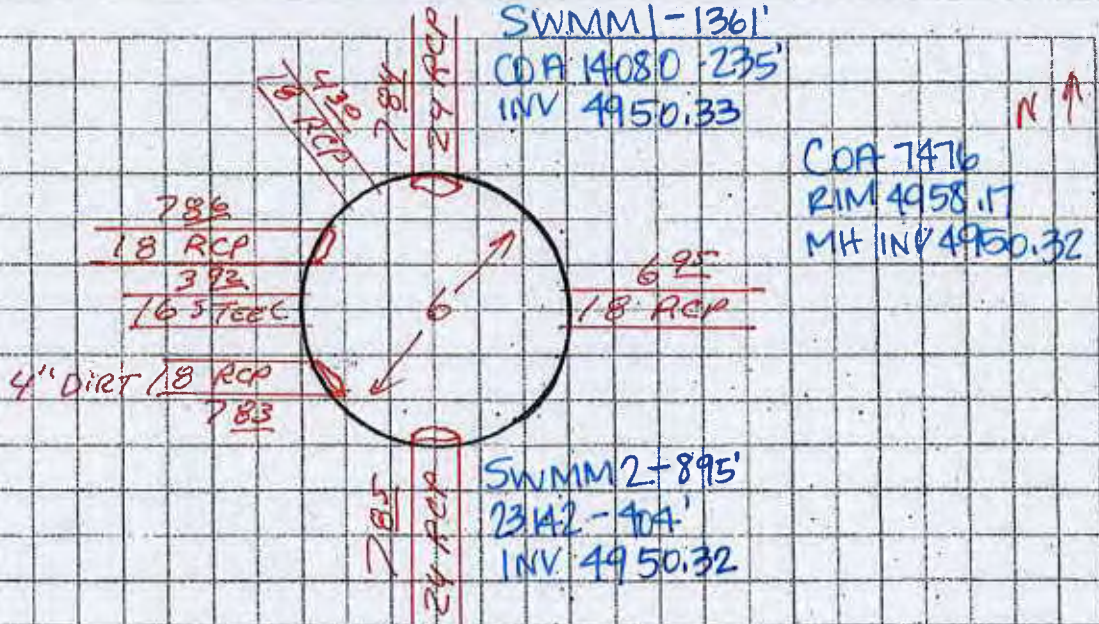

10f2

24 RCP

Depth

24 RCP

151

Sediment

"RIO GRANDE SD PLAN"



7476

RIO GRANDE SD
PLAN
(5)

LINE D

152

~~RIO GRANDE 1 of 44~~

Manhole # 2 Location Rio Grande + Centex

Date 4-27-10

Notes N.E. Intersection

COA MH # 7518


COA 7518
RIM 4956.83
MH INV 4947.94

SWMM2-895'
COA 1074-1A'
INV 4948.04 **N ↑**




SWMM3-1804
COA NEW-21'
INV 4947.94

1 of 2

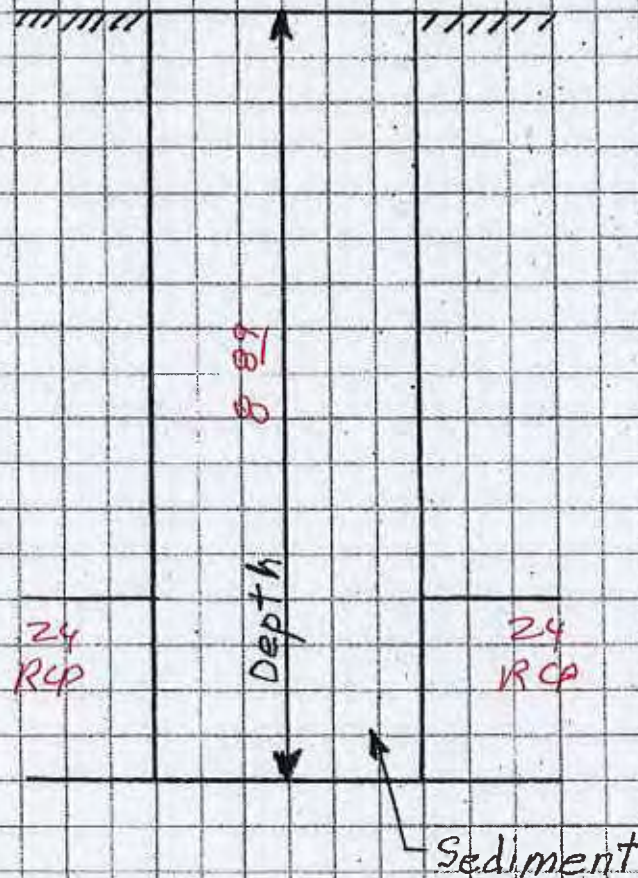

153

"RIO GRANDE SD PLAN"

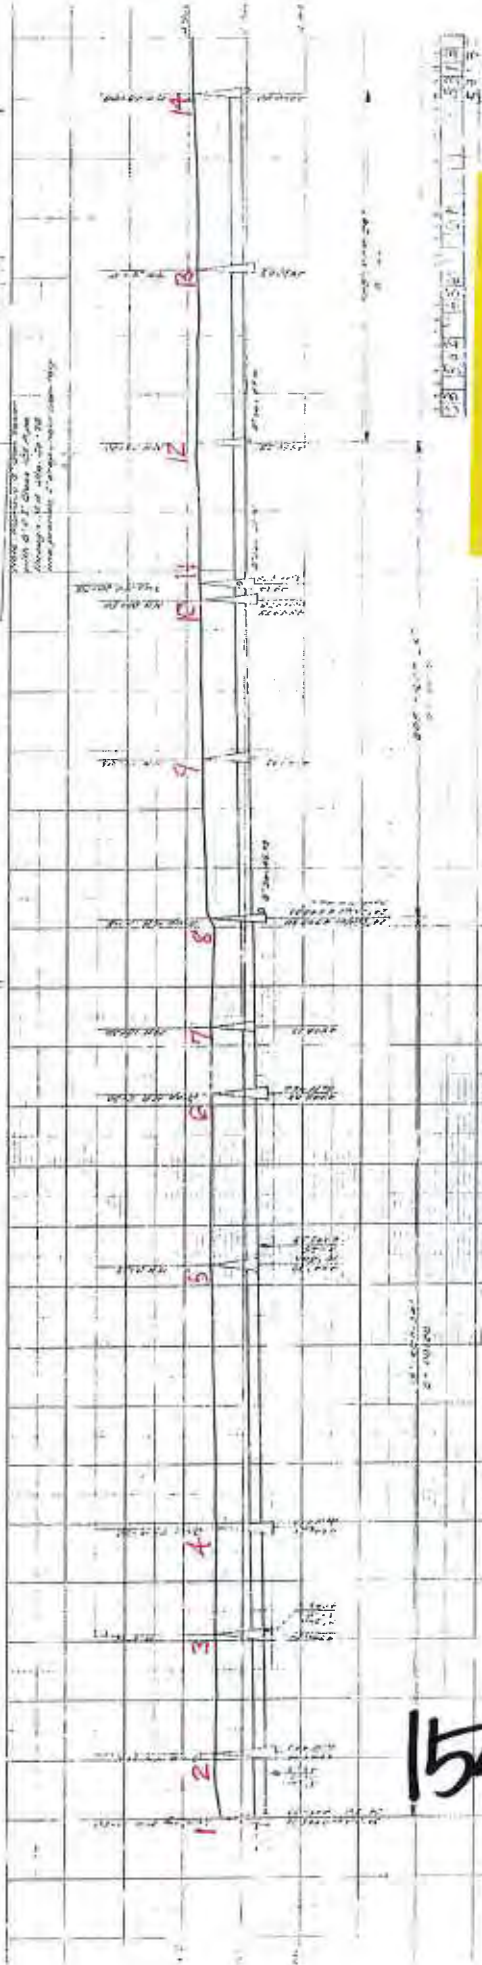

Rio Grande SD
Plan
(5)
7518

LINED


~~Rio Grande lot 14~~

154


Manhole # 17 Location San Pasquale + Chacona Pl. Date 3-24-10

Notes M.H. Located in Sidewalk on S.W. Intersection

COA MH # 24834

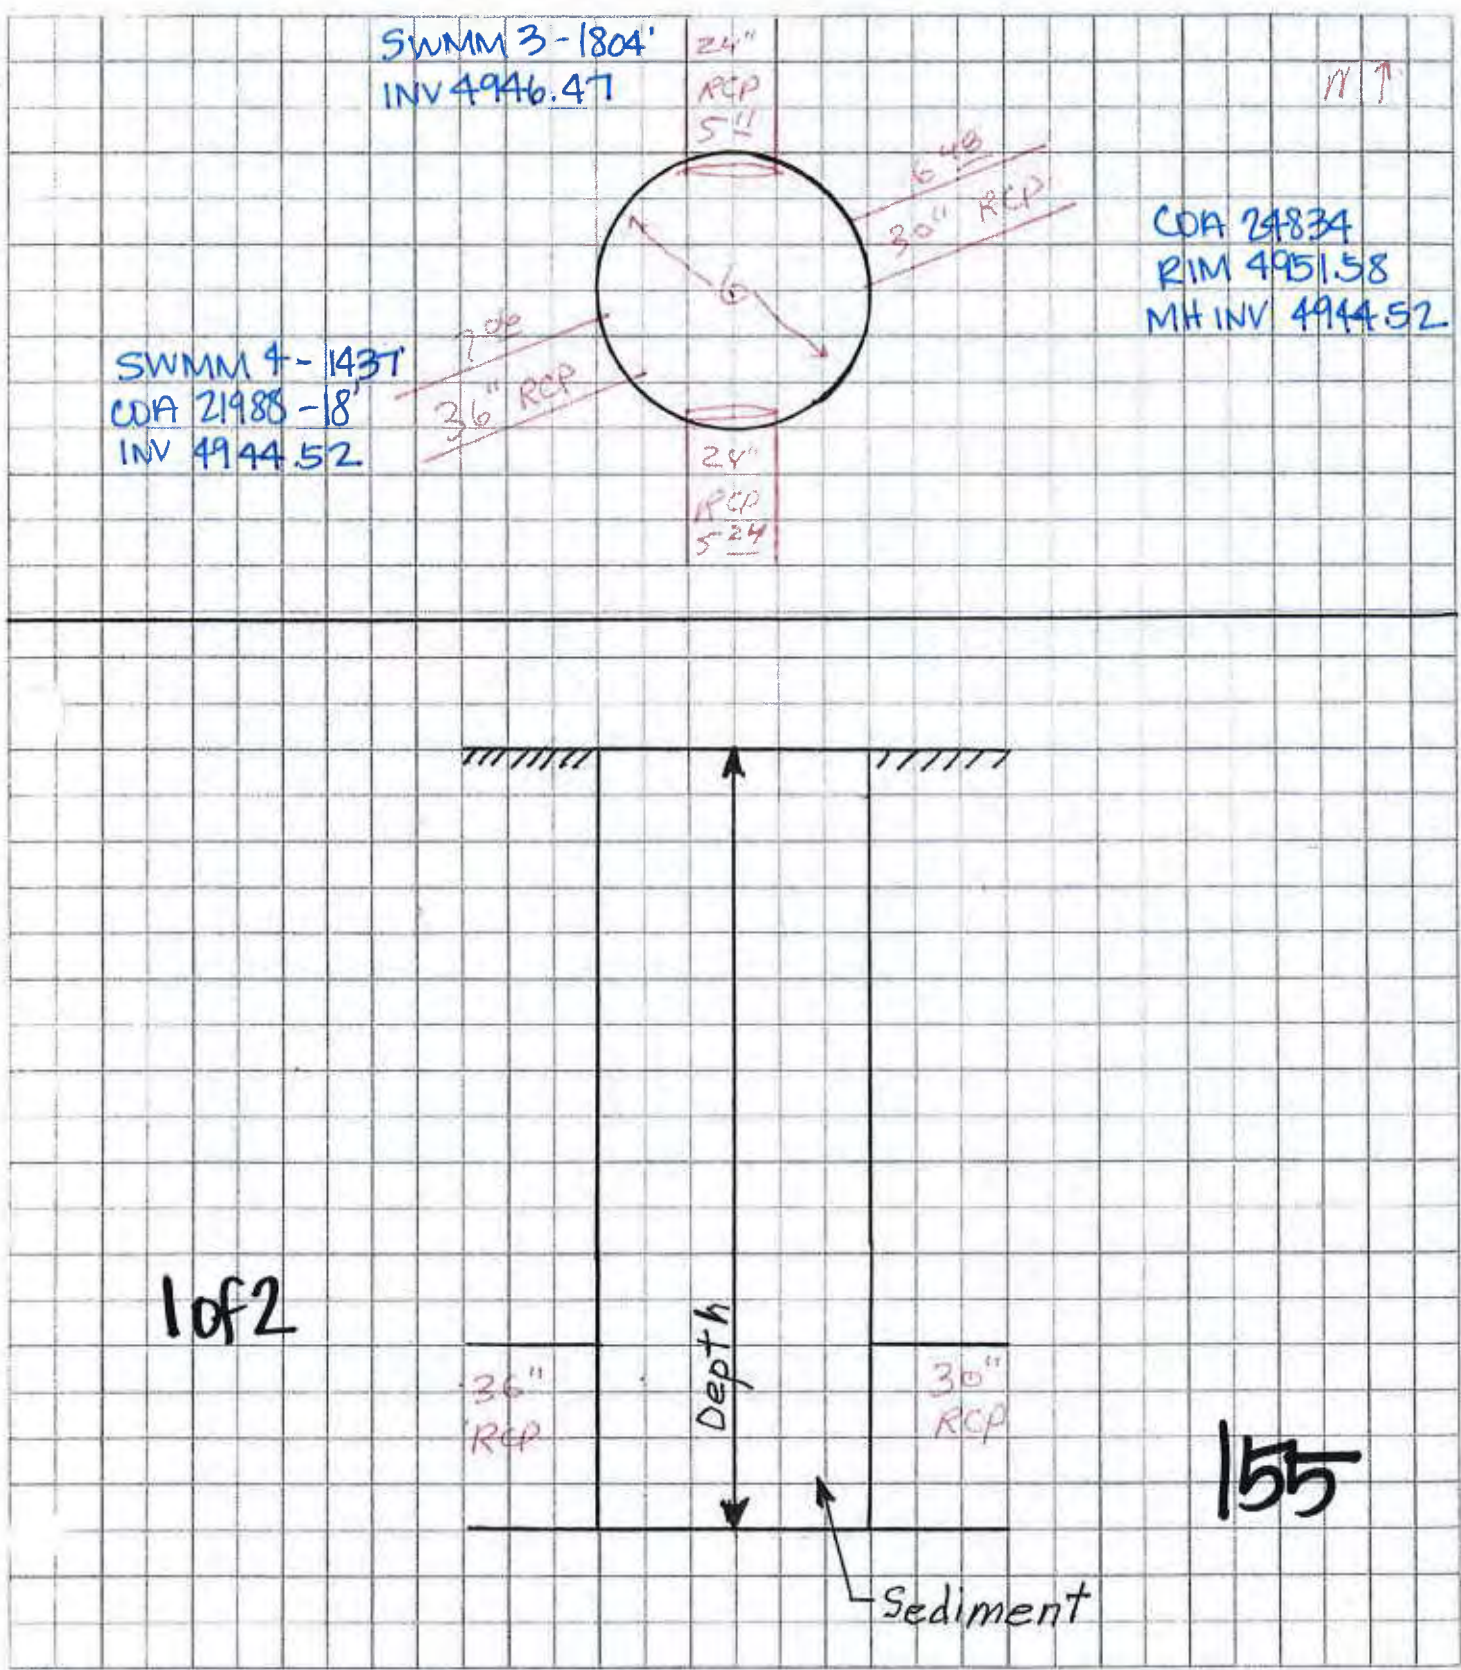

24834

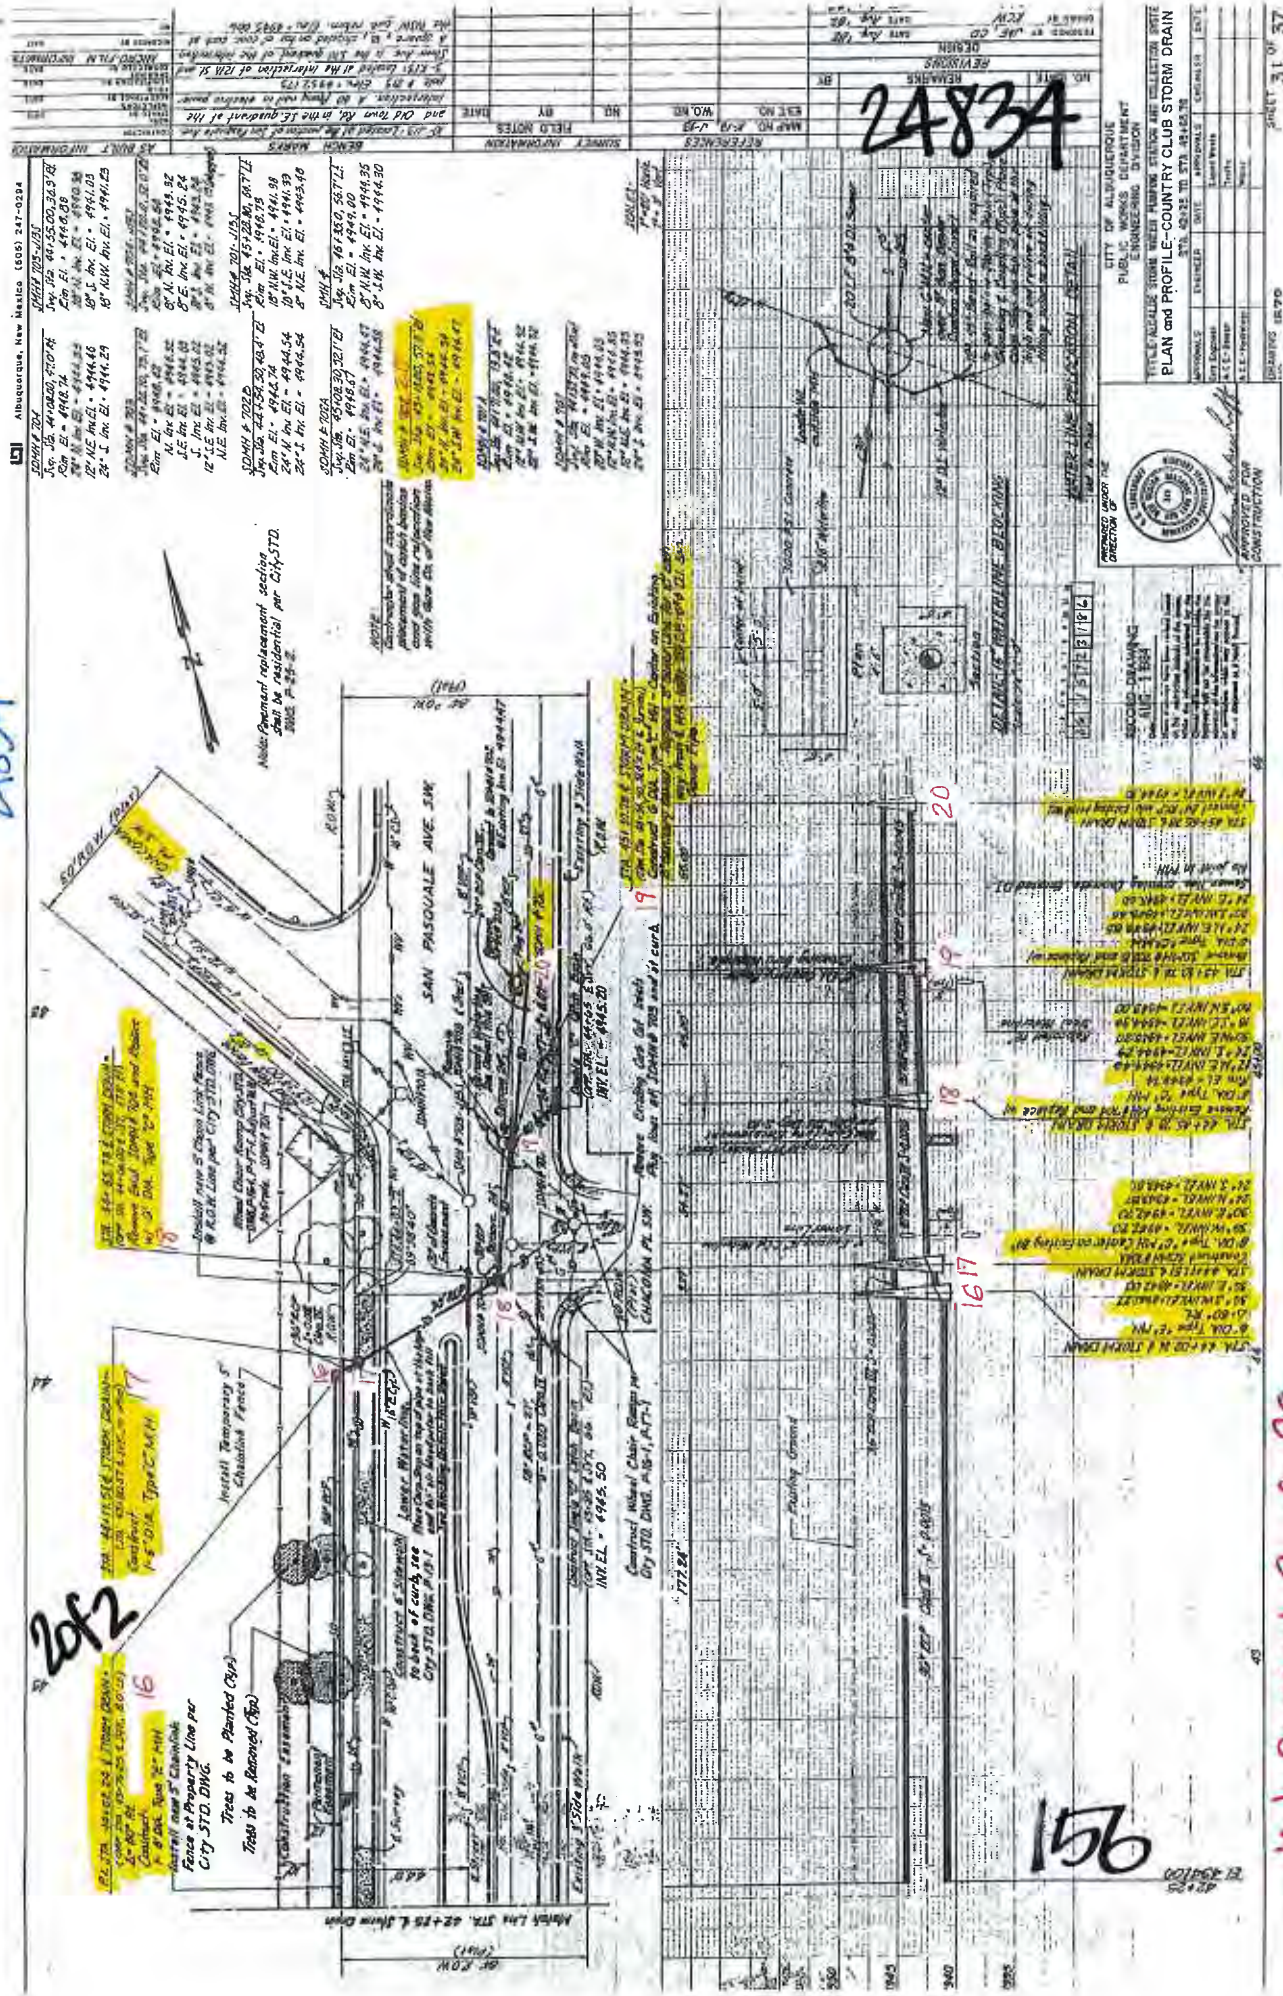

NO.	DATE	REVISIONS
1	10/1/83	1. 12" DIA. STORM DRAIN
2	10/1/83	2. 12" DIA. SEWER
3	10/1/83	3. 12" DIA. WATER MAIN
4	10/1/83	4. 12" DIA. STORM DRAIN
5	10/1/83	5. 12" DIA. SEWER
6	10/1/83	6. 12" DIA. WATER MAIN
7	10/1/83	7. 12" DIA. STORM DRAIN
8	10/1/83	8. 12" DIA. SEWER
9	10/1/83	9. 12" DIA. WATER MAIN
10	10/1/83	10. 12" DIA. STORM DRAIN
11	10/1/83	11. 12" DIA. SEWER
12	10/1/83	12. 12" DIA. WATER MAIN
13	10/1/83	13. 12" DIA. STORM DRAIN
14	10/1/83	14. 12" DIA. SEWER
15	10/1/83	15. 12" DIA. WATER MAIN
16	10/1/83	16. 12" DIA. STORM DRAIN
17	10/1/83	17. 12" DIA. SEWER
18	10/1/83	18. 12" DIA. WATER MAIN
19	10/1/83	19. 12" DIA. STORM DRAIN
20	10/1/83	20. 12" DIA. SEWER
21	10/1/83	21. 12" DIA. WATER MAIN
22	10/1/83	22. 12" DIA. STORM DRAIN
23	10/1/83	23. 12" DIA. SEWER
24	10/1/83	24. 12" DIA. WATER MAIN
25	10/1/83	25. 12" DIA. STORM DRAIN
26	10/1/83	26. 12" DIA. SEWER
27	10/1/83	27. 12" DIA. WATER MAIN
28	10/1/83	28. 12" DIA. STORM DRAIN
29	10/1/83	29. 12" DIA. SEWER
30	10/1/83	30. 12" DIA. WATER MAIN
31	10/1/83	31. 12" DIA. STORM DRAIN
32	10/1/83	32. 12" DIA. SEWER
33	10/1/83	33. 12" DIA. WATER MAIN
34	10/1/83	34. 12" DIA. STORM DRAIN
35	10/1/83	35. 12" DIA. SEWER
36	10/1/83	36. 12" DIA. WATER MAIN
37	10/1/83	37. 12" DIA. STORM DRAIN
38	10/1/83	38. 12" DIA. SEWER
39	10/1/83	39. 12" DIA. WATER MAIN
40	10/1/83	40. 12" DIA. STORM DRAIN
41	10/1/83	41. 12" DIA. SEWER
42	10/1/83	42. 12" DIA. WATER MAIN
43	10/1/83	43. 12" DIA. STORM DRAIN
44	10/1/83	44. 12" DIA. SEWER
45	10/1/83	45. 12" DIA. WATER MAIN
46	10/1/83	46. 12" DIA. STORM DRAIN
47	10/1/83	47. 12" DIA. SEWER
48	10/1/83	48. 12" DIA. WATER MAIN
97	10/1/83	97. 12" DIA. STORM DRAIN
98	10/1/83	98. 12" DIA. SEWER
99	10/1/83	99. 12" DIA. WATER MAIN
100	10/1/83	100. 12" DIA. STORM DRAIN



Kit Carson 9 of 29

156

Manhole # 8 Location LAGUNA + PARK AVE Date 3-29-10

Notes S.W. Inter Service

COA MH# 8985

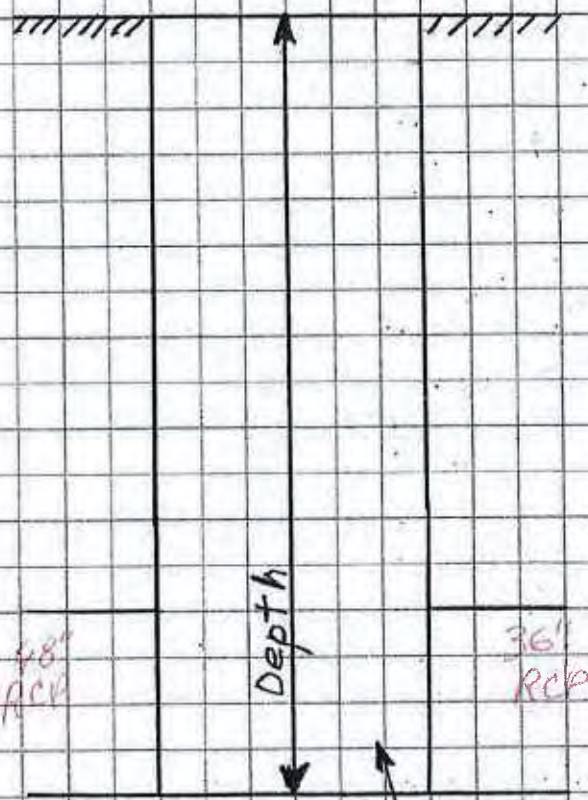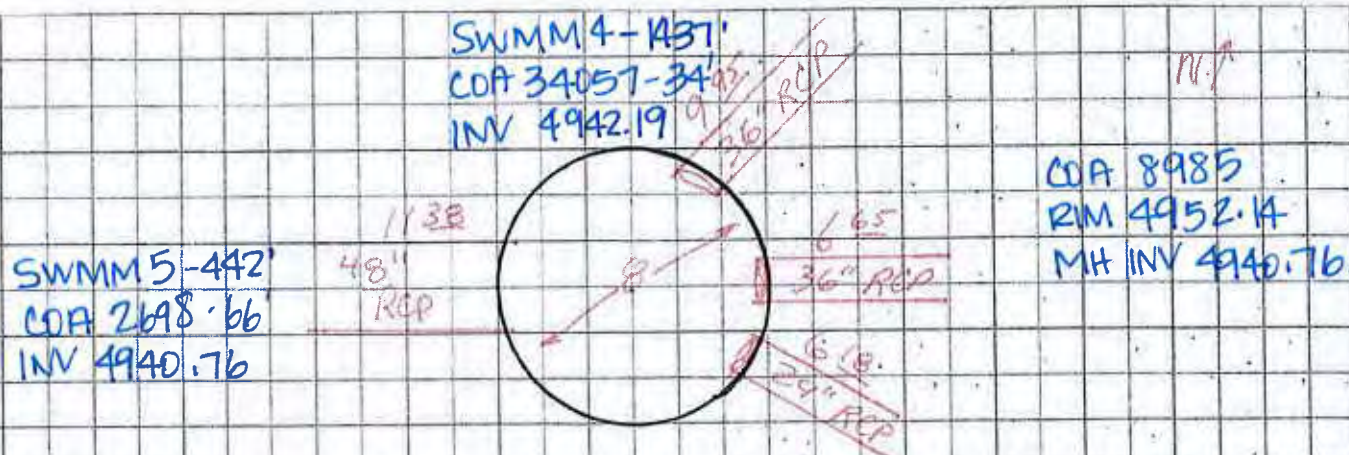

1 of 2


157

8985

STA 27+10
ELEV. 4936.58

1.199

5868

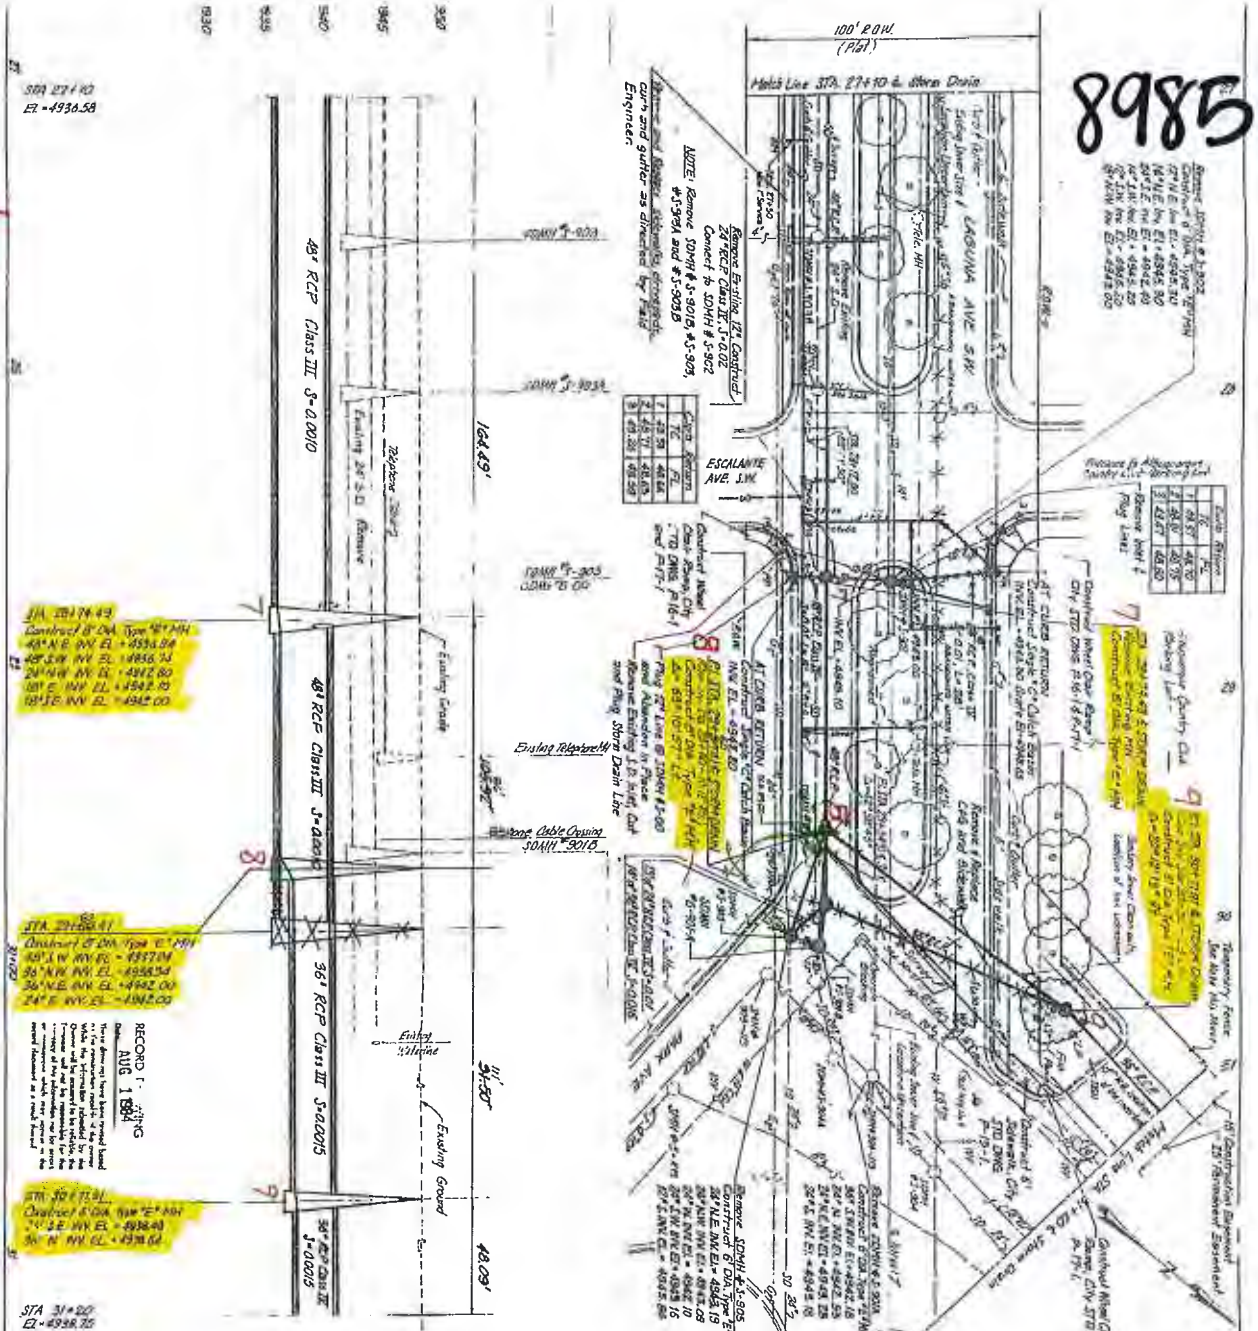

NOTE: Regarding boundaries, the County Engineer's Office is not responsible for the accuracy of the boundaries shown on this plan. The boundaries shown are for informational purposes only. The County Engineer's Office is not responsible for the accuracy of the boundaries shown on this plan. The boundaries shown are for informational purposes only.

TEST HOLE NO. 6 - OPP. STA. 30+53 ± 8' (Reference on sheet 2.)

TEST HOLE DATA

DEPTH (FEET)	SOIL DESCRIPTION	WATER LEVEL (FEET)
0.0	Surface	4936.58
1.0	Dark gray silty clay	4936.58
2.0	Dark gray silty clay	4936.58
REFERENCES:

MAP NO.	DATE	BY
2-13	11-11-82	W.D. NO.

REVISIONS:

NO.	DATE	BY
1	Aug. 82	W.D. NO.
2	Aug. 82	W.D. NO.

APPROVED FOR:

ENGINEER: [Signature]

CITY OF ALBUQUERQUE:

PUBLIC WORKS DEPARTMENT:

ENGINEERING DIVISION:

STATIONING: 1672

SHEET: 28 OF 37

158

Manhole # 6 445 Location Kit Carson + Laguna Date 3-24-10



Notes S.E. Intersections

M.H. Lid under Asphalt

COA MH # 24859

24859
RIM 4950.64
LID

COA 24859
RIM 4950.64
MH INV 4939.09

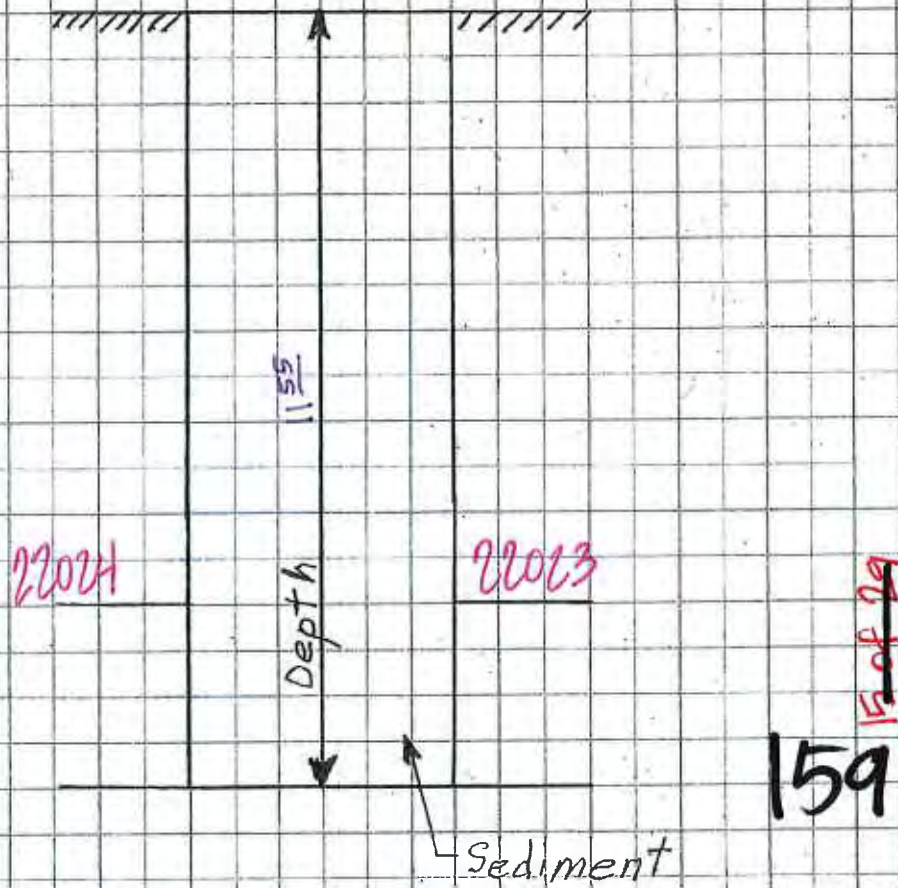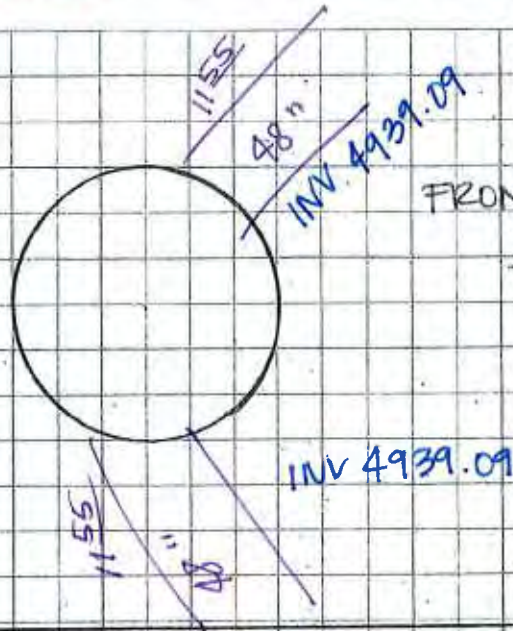





Manhole # 4 Location FRANZ Hunting + Kit Carson Date 3-24-10

Notes N.W. Inter-Section

COA MH # 9015

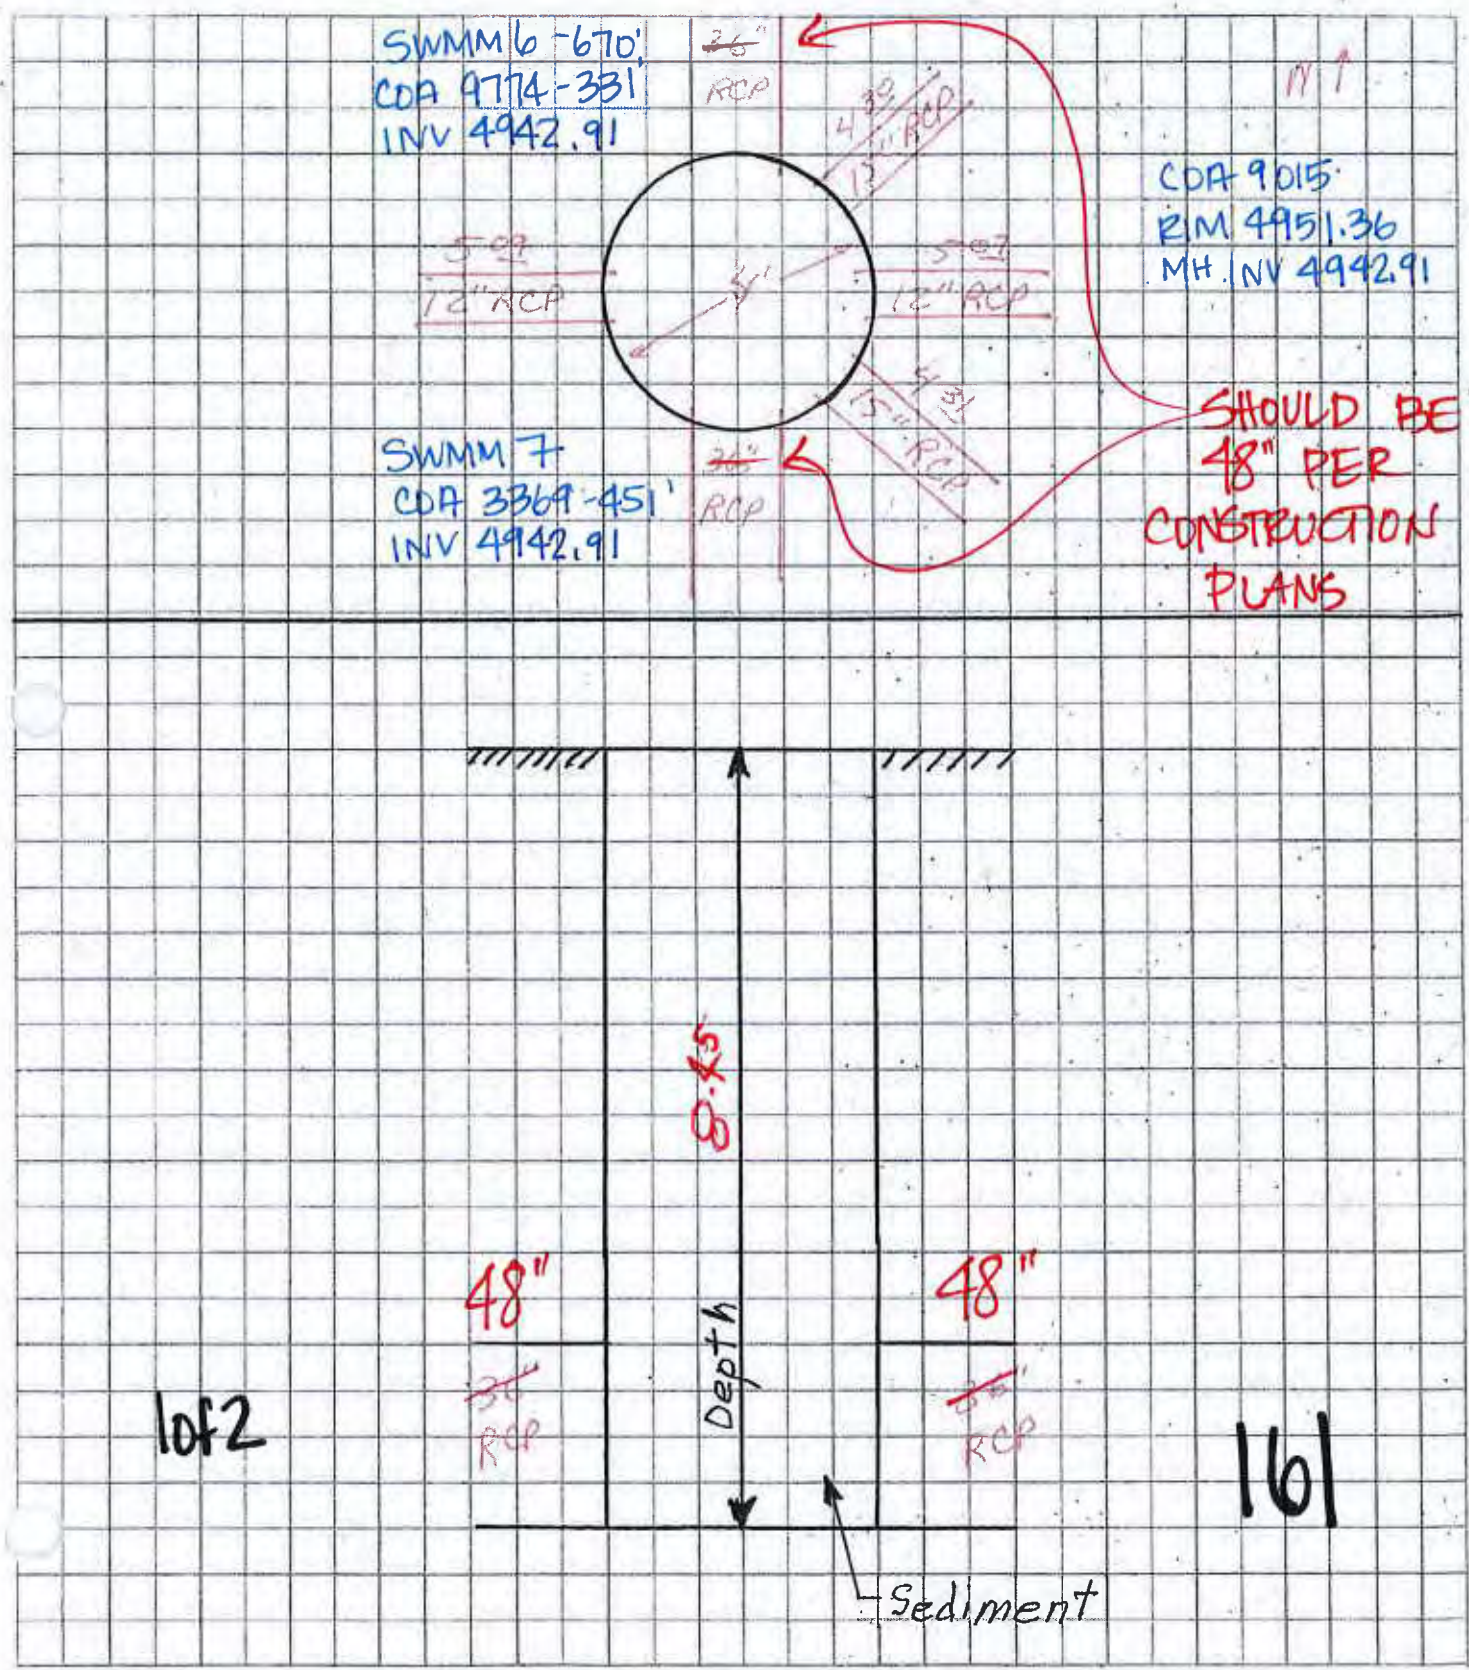


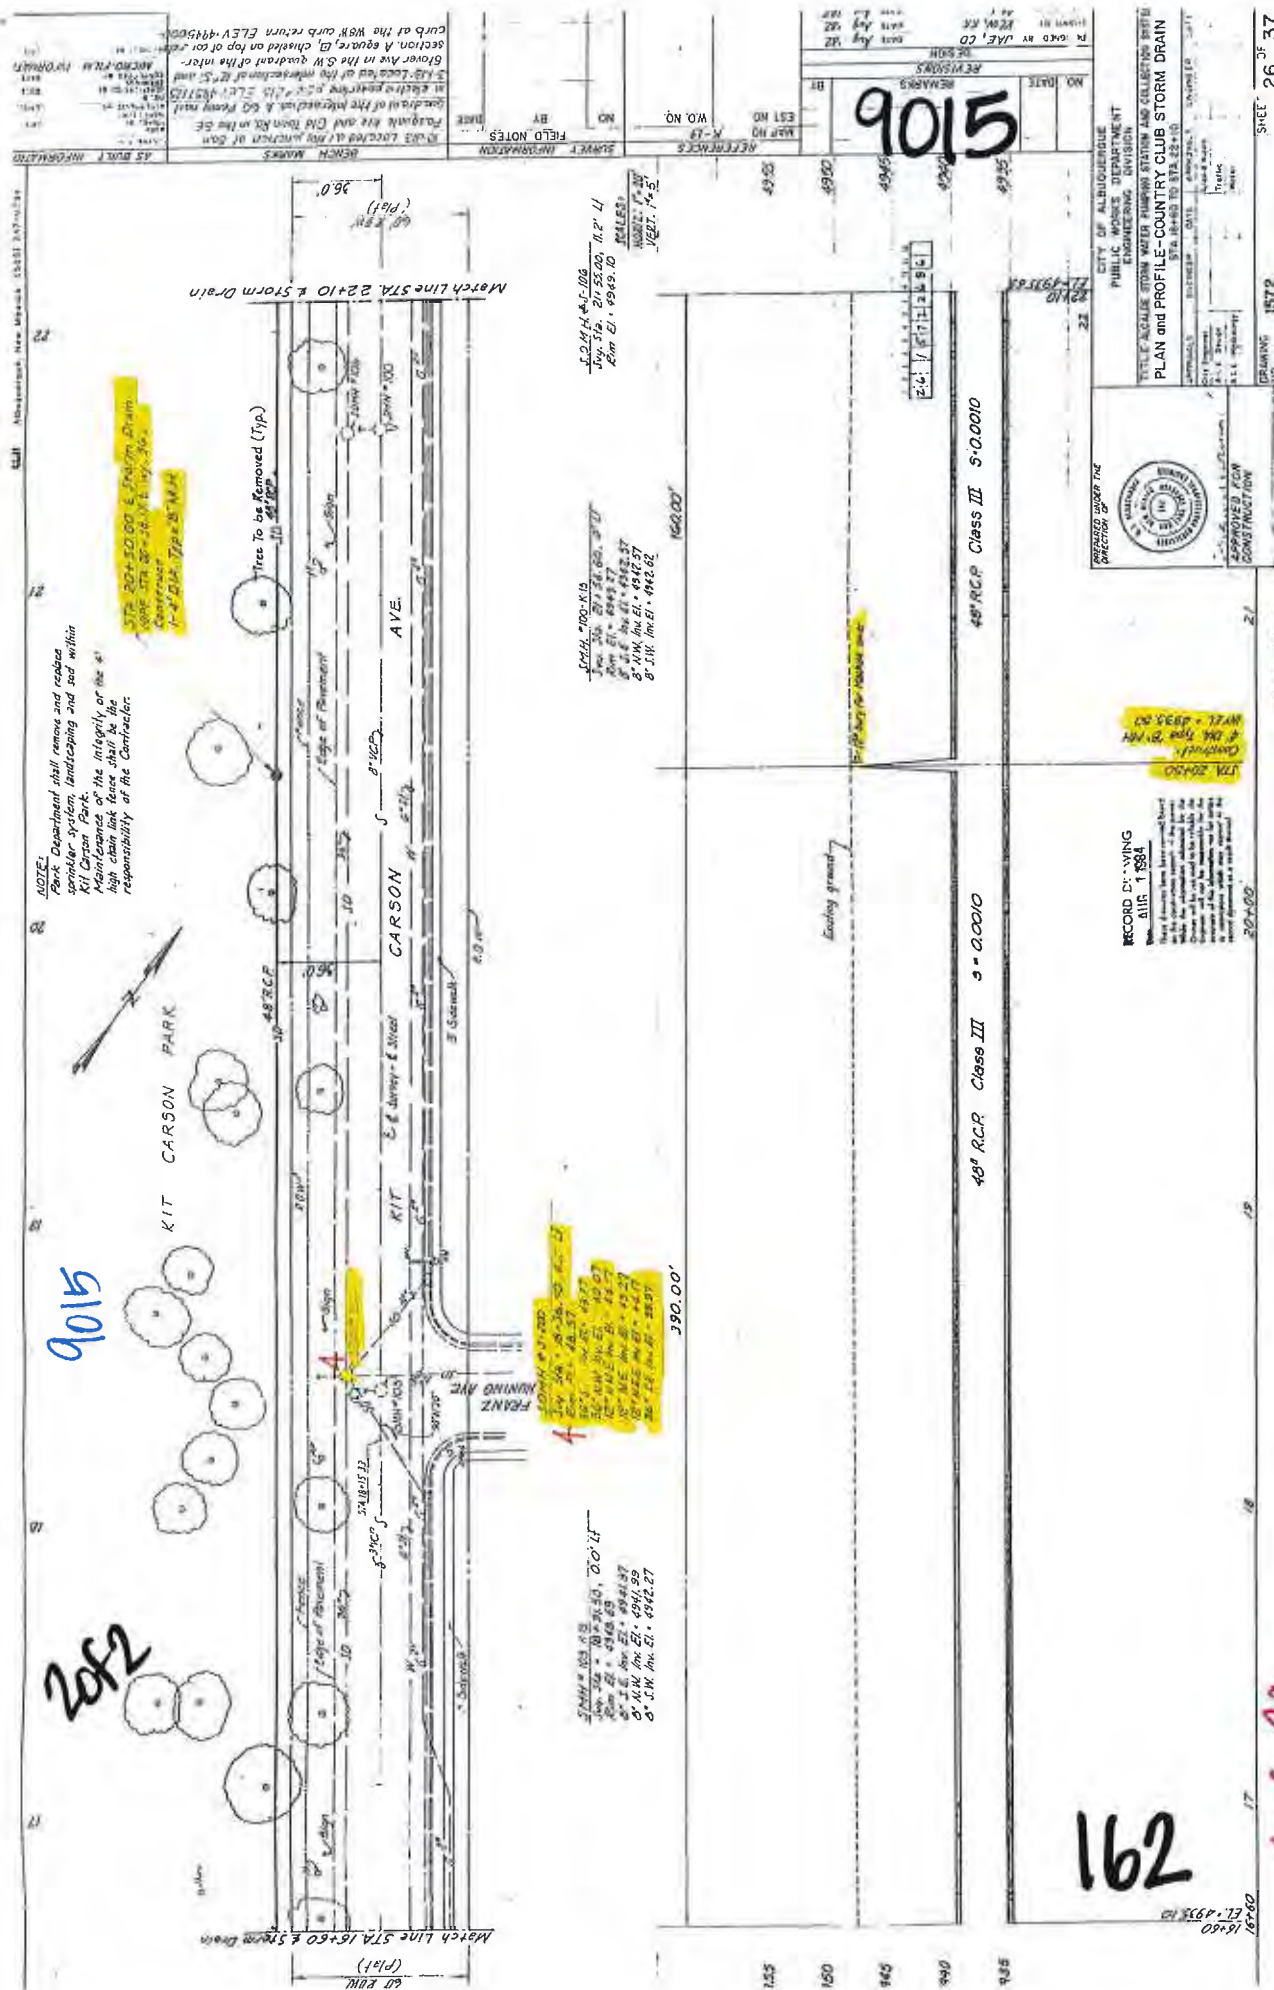


Manhole # 2 Location Alcalde + Kit Carson Date 3-24-10

Notes South Center InterSection

COA MH #9069

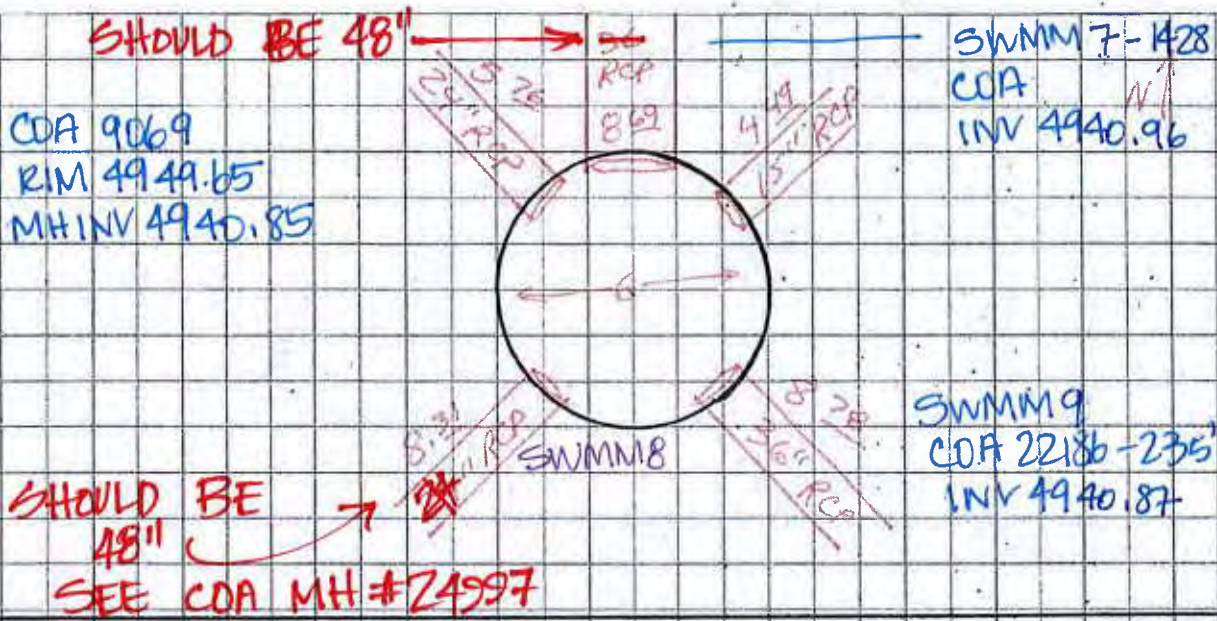

1 of 1

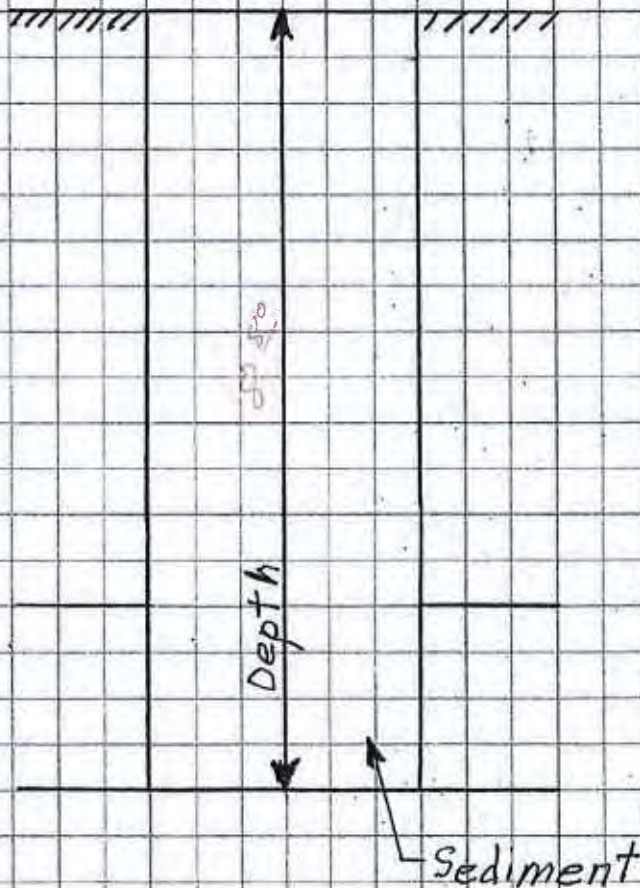

163