

APPENDIX 2.8 –

Weir As-Builts / Plans in Manholes

FOR:

Broadway- Lomas Weir in Manhole

Manhole #

2301

Location


LOMAS

&


BROADWAY

Notes


Northwest Intersection SB Lane.

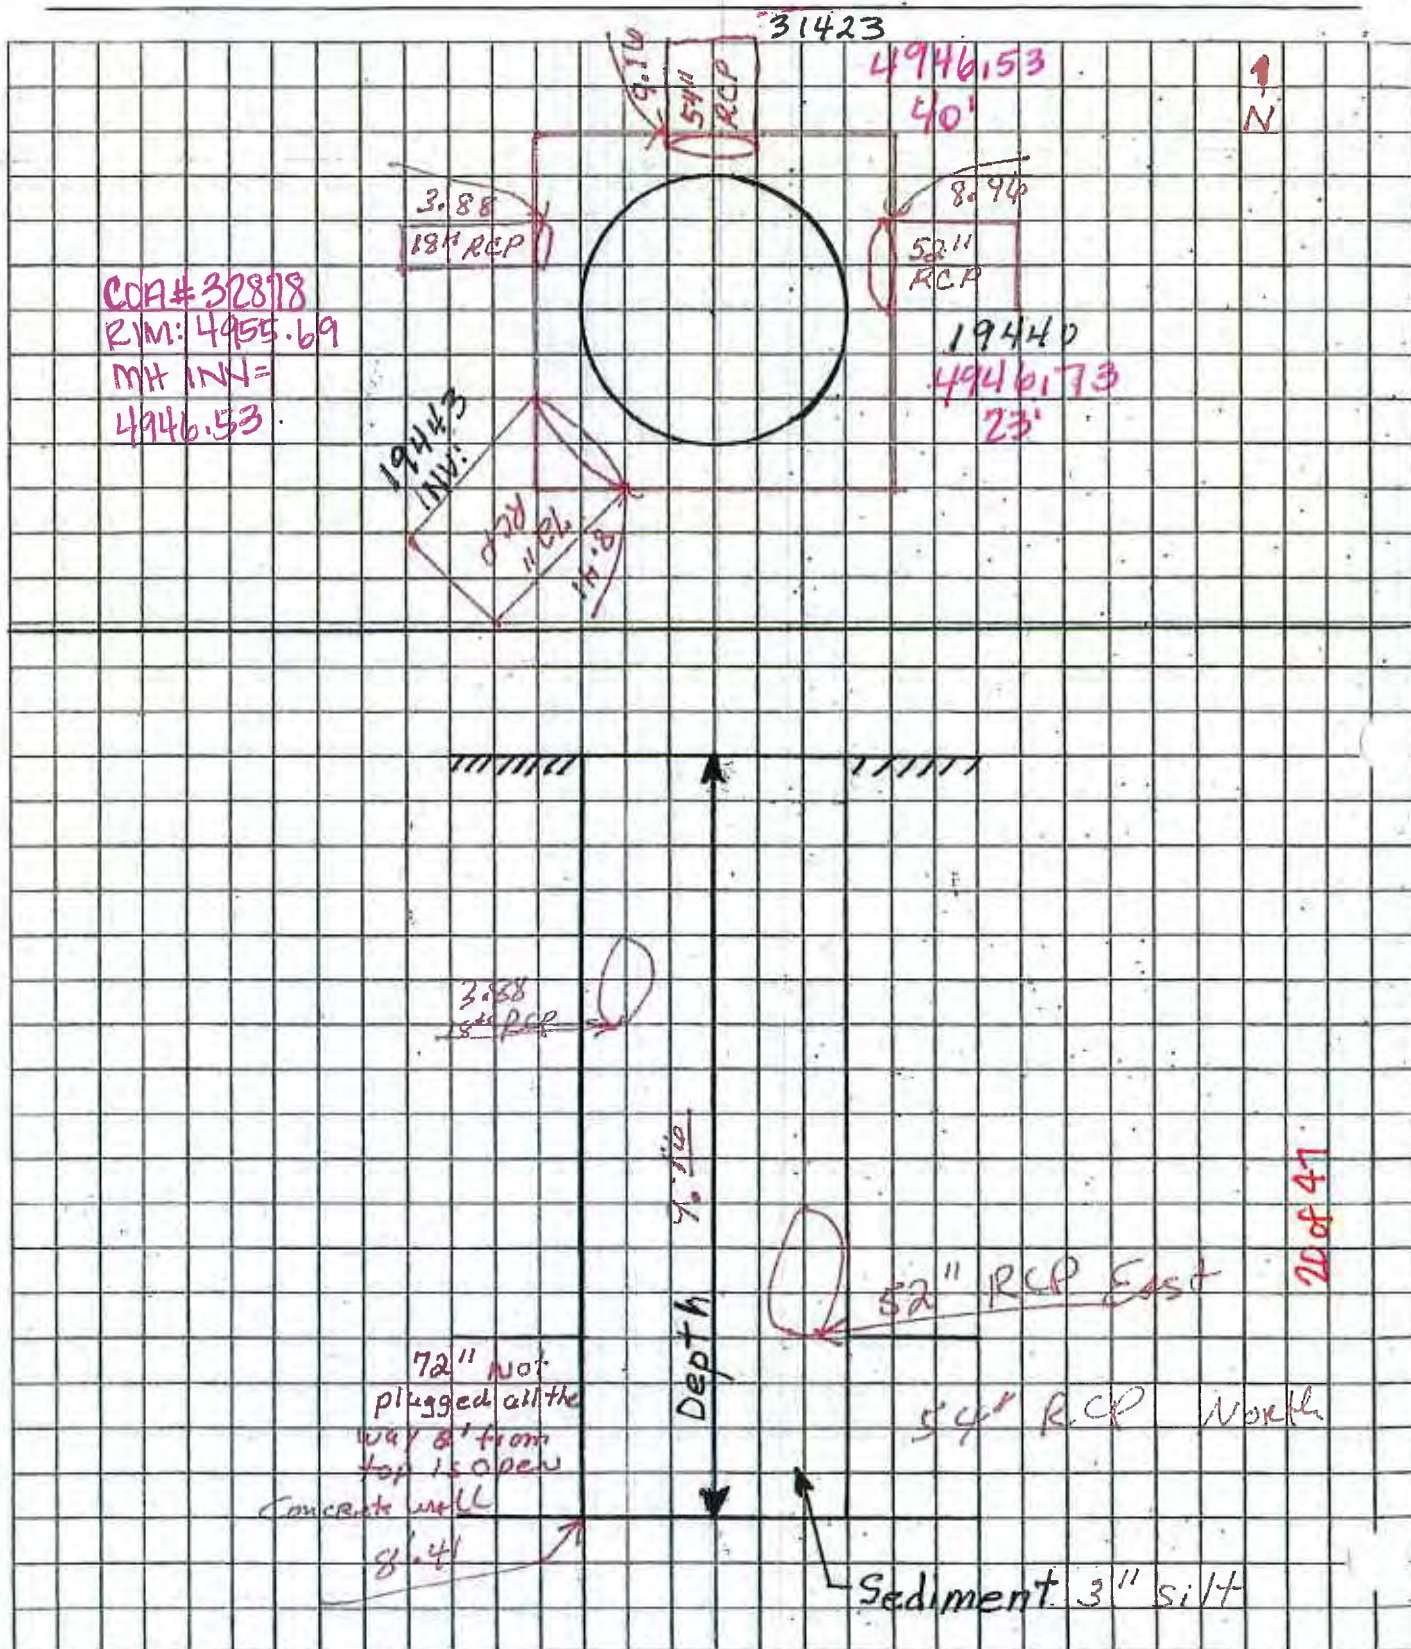


BROADWAY / LOMAS

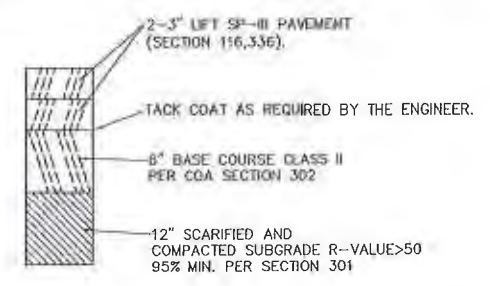


PAVEMENT SECTION
N.T.S.

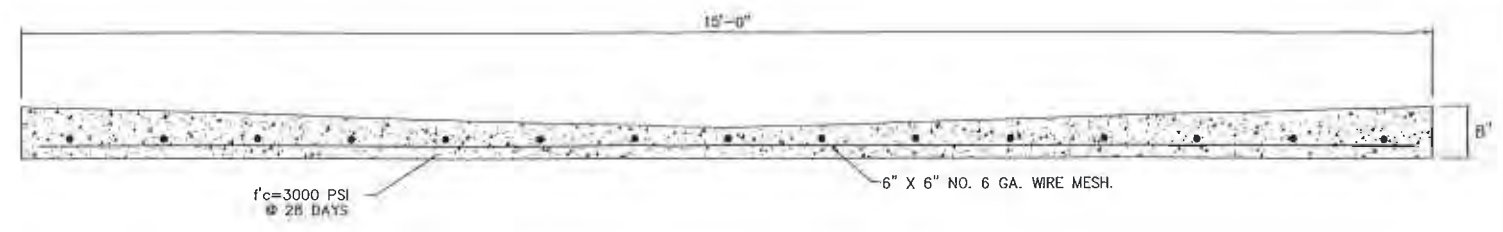


15'-0" LOW FLOW CHANNEL DETAIL
SCALE: 1"=1'

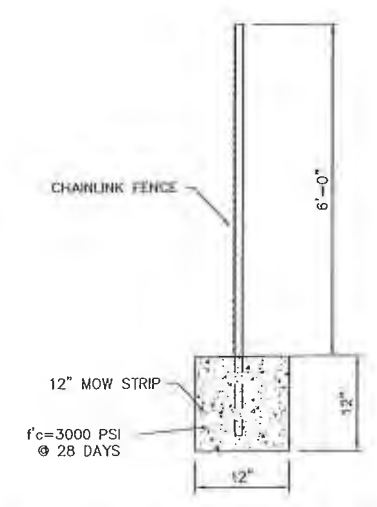


6'-0" HIGH CHAINLINK FENCE W/ MOW STRIP
SCALE: NTS

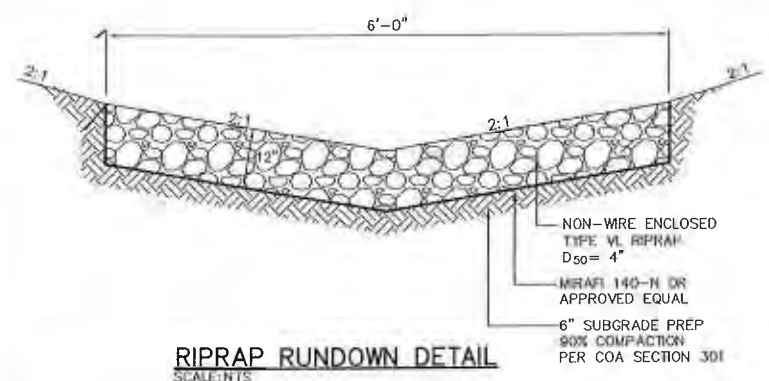

NOTE:
CONCRETE ACCESS MAINTENANCE RAMP
SHALL BE CONSTRUCTED WITH A 2.00%
INVERT CROWN.

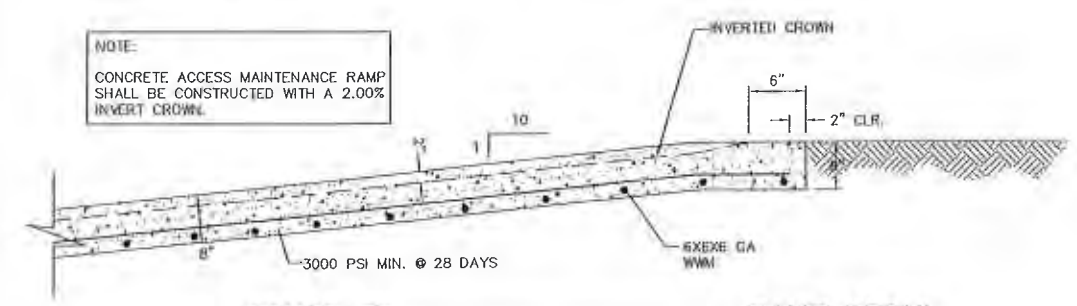

CONCRETE ACCESS MAINTENANCE RAMP DETAIL
SCALE: 1" = 1'

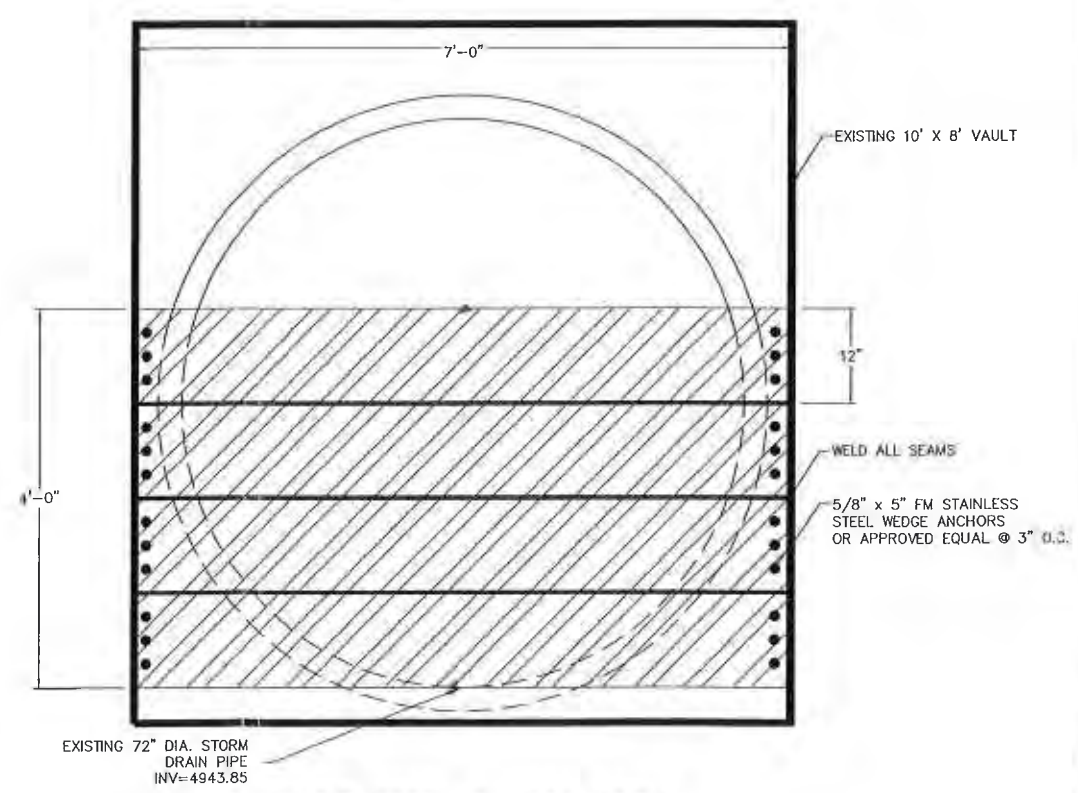

12" X 7' X 1/2" STEEL PLATES DETAIL
SCALE: NTS

ALBUQUERQUE CITY DEPARTMENT ENGINEERING DIVISION DETENTION POND		ENGINEER'S SEAL		SURVEY INFORMATION		BENCH MARKS		AS BUILT INFORMATION			
NO. DATE		REMARKS		BY		FIELD NOTES		APPROX. 225' SOUTH OF STOVER AVE. OF THE WEST CURB ON EIGHTH STREET, AND IS BELOW TURF. THE STATION IS THEN 0.7 FT WEST SET IN TOP OF A CONCRETE POST, APPROX. 0.2 FT STD. ACS BRASS TABLET STAMPED "1-K13". ELEVATION = 4944.03 FT. DATUM= 1929 NGVD			
						NO.		CONTRACTOR			
						BY		DATE			
						DATE		DATE			
DESIGNED BY: TJA		DATE: 3 SEPT. 2008		DRAWN BY: JLL		DATE: 3 SEPT. 2008		CHECKED BY: TJA		DATE: 3 SEPT. 2008	
MICRO-FILM INFORMATION		NO.		DATE		REMARKS		NO.		DATE	
MICRO-FILM INFORMATION		NO.		DATE		REMARKS		NO.		DATE	