



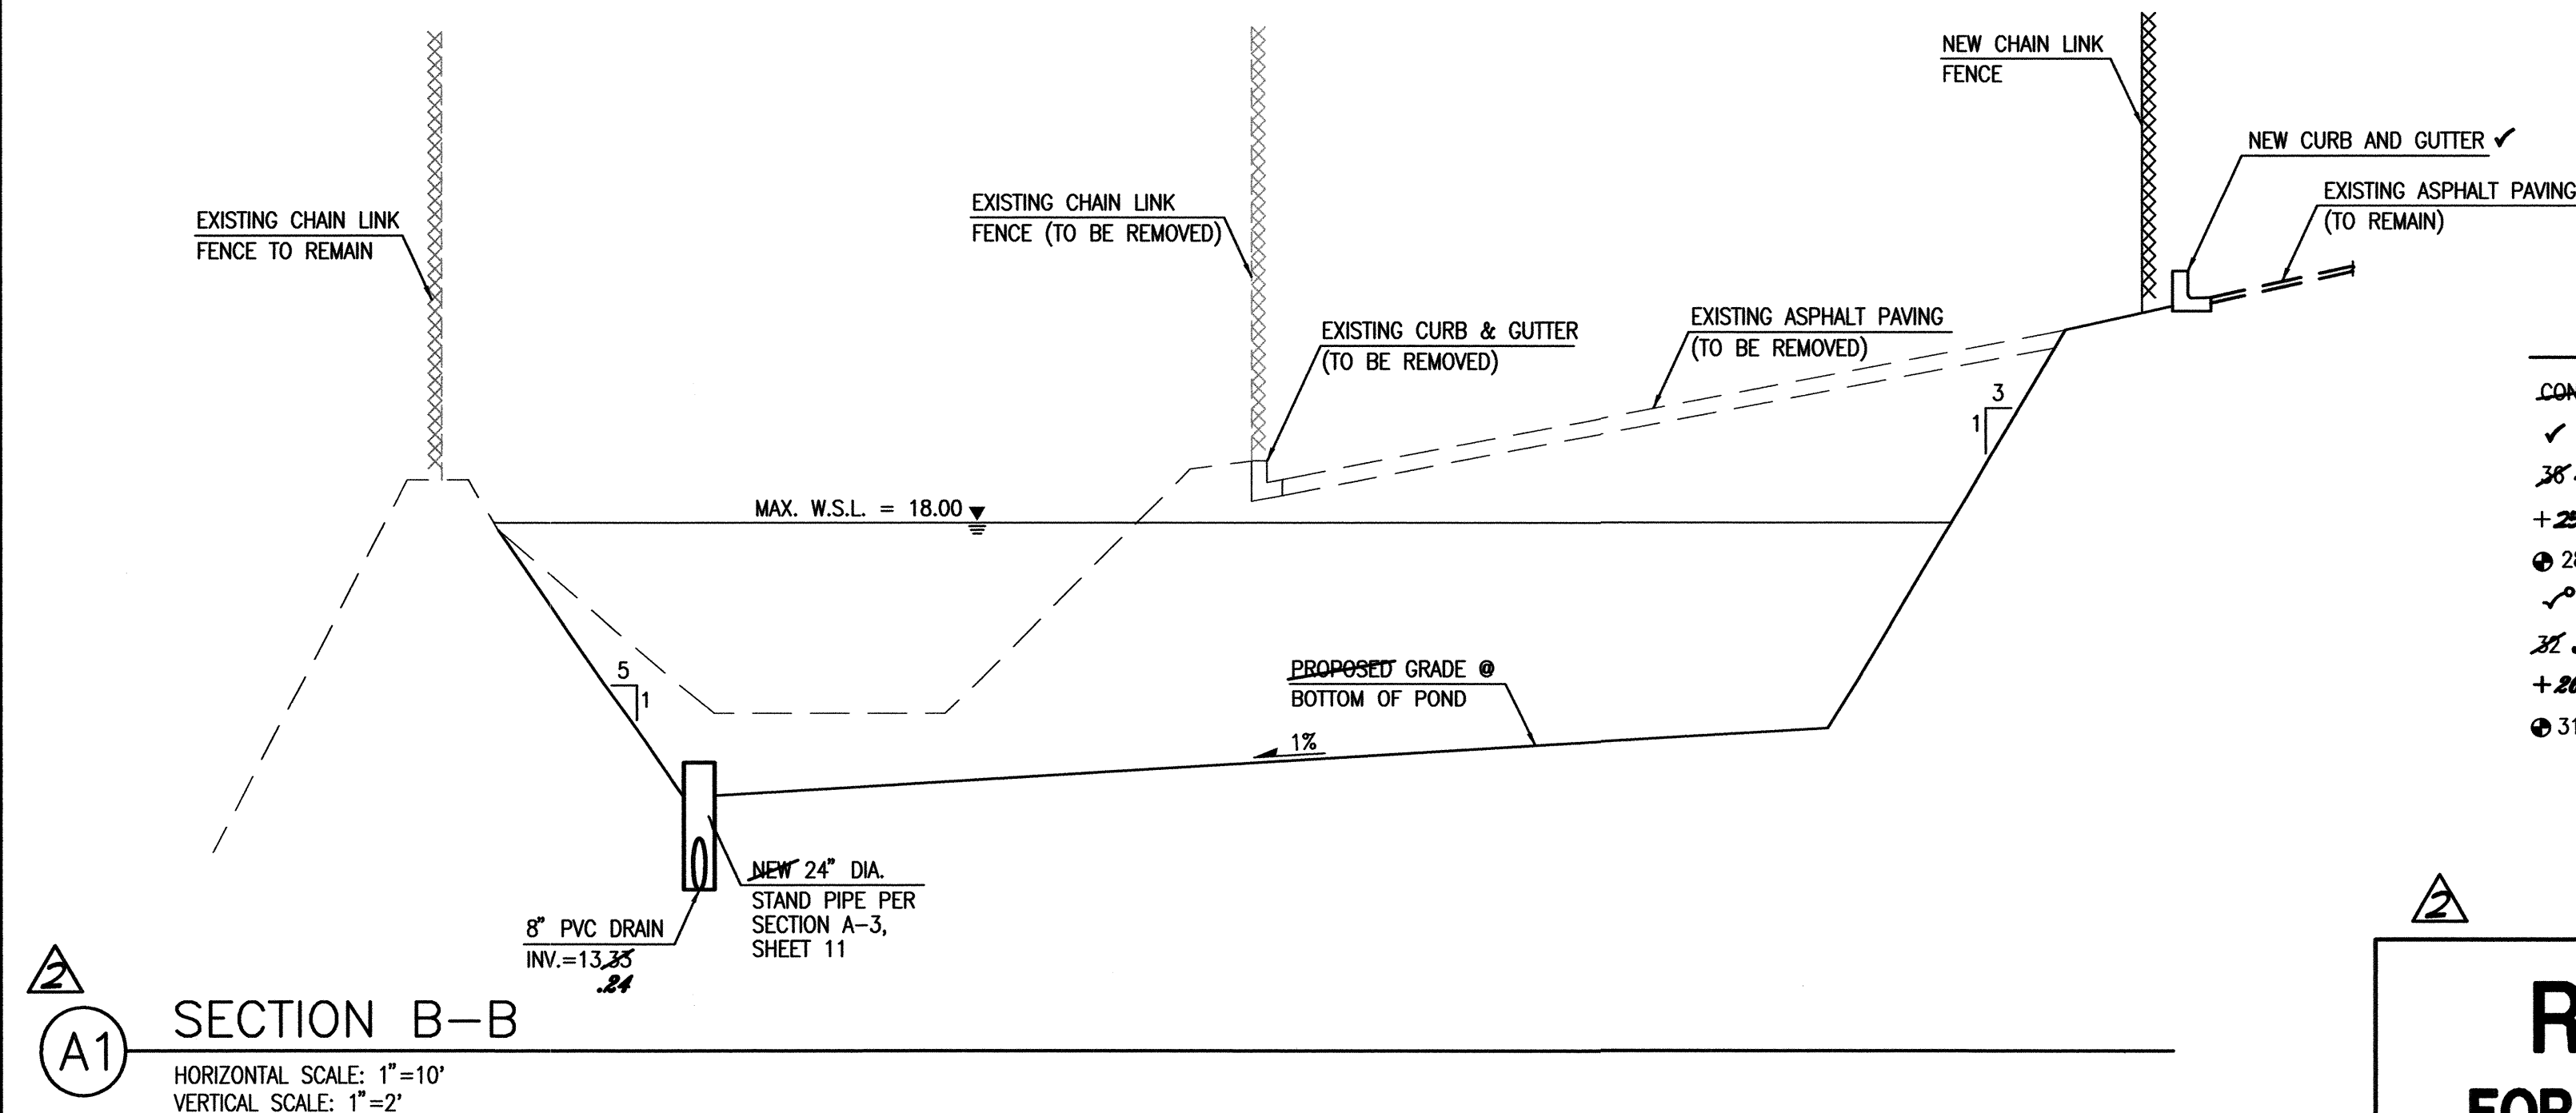

RECORD DRAWING LEGEND

CONSTRUCT	RECORD INFORMATION (VERIFIED BY ENGINEER)
✓	AS-CONSTRUCTED = AS-DESIGNED (VERIFIED BY ENGINEER)
38° 42'	RECORD INFORMATION (VERIFIED BY ENGINEER)
+ 25.2	RECORD INFORMATION (VERIFIED BY ENGINEER)
⊕ 28.95' 42	RECORD INFORMATION (VERIFIED BY ENGINEER)
✓	AS-CONSTRUCTED = AS-DESIGNED (VERIFIED BY AS-BUILT SURVEY)
32° 31.8	RECORD INFORMATION FROM AS-BUILT SURVEY
+ 26.9	RECORD INFORMATION FROM AS-BUILT SURVEY
⊕ 31.25' 22	RECORD INFORMATION FROM AS-BUILT SURVEY

RECORD DRAWING
FOR CERTIFICATION, SEE SHEET 1

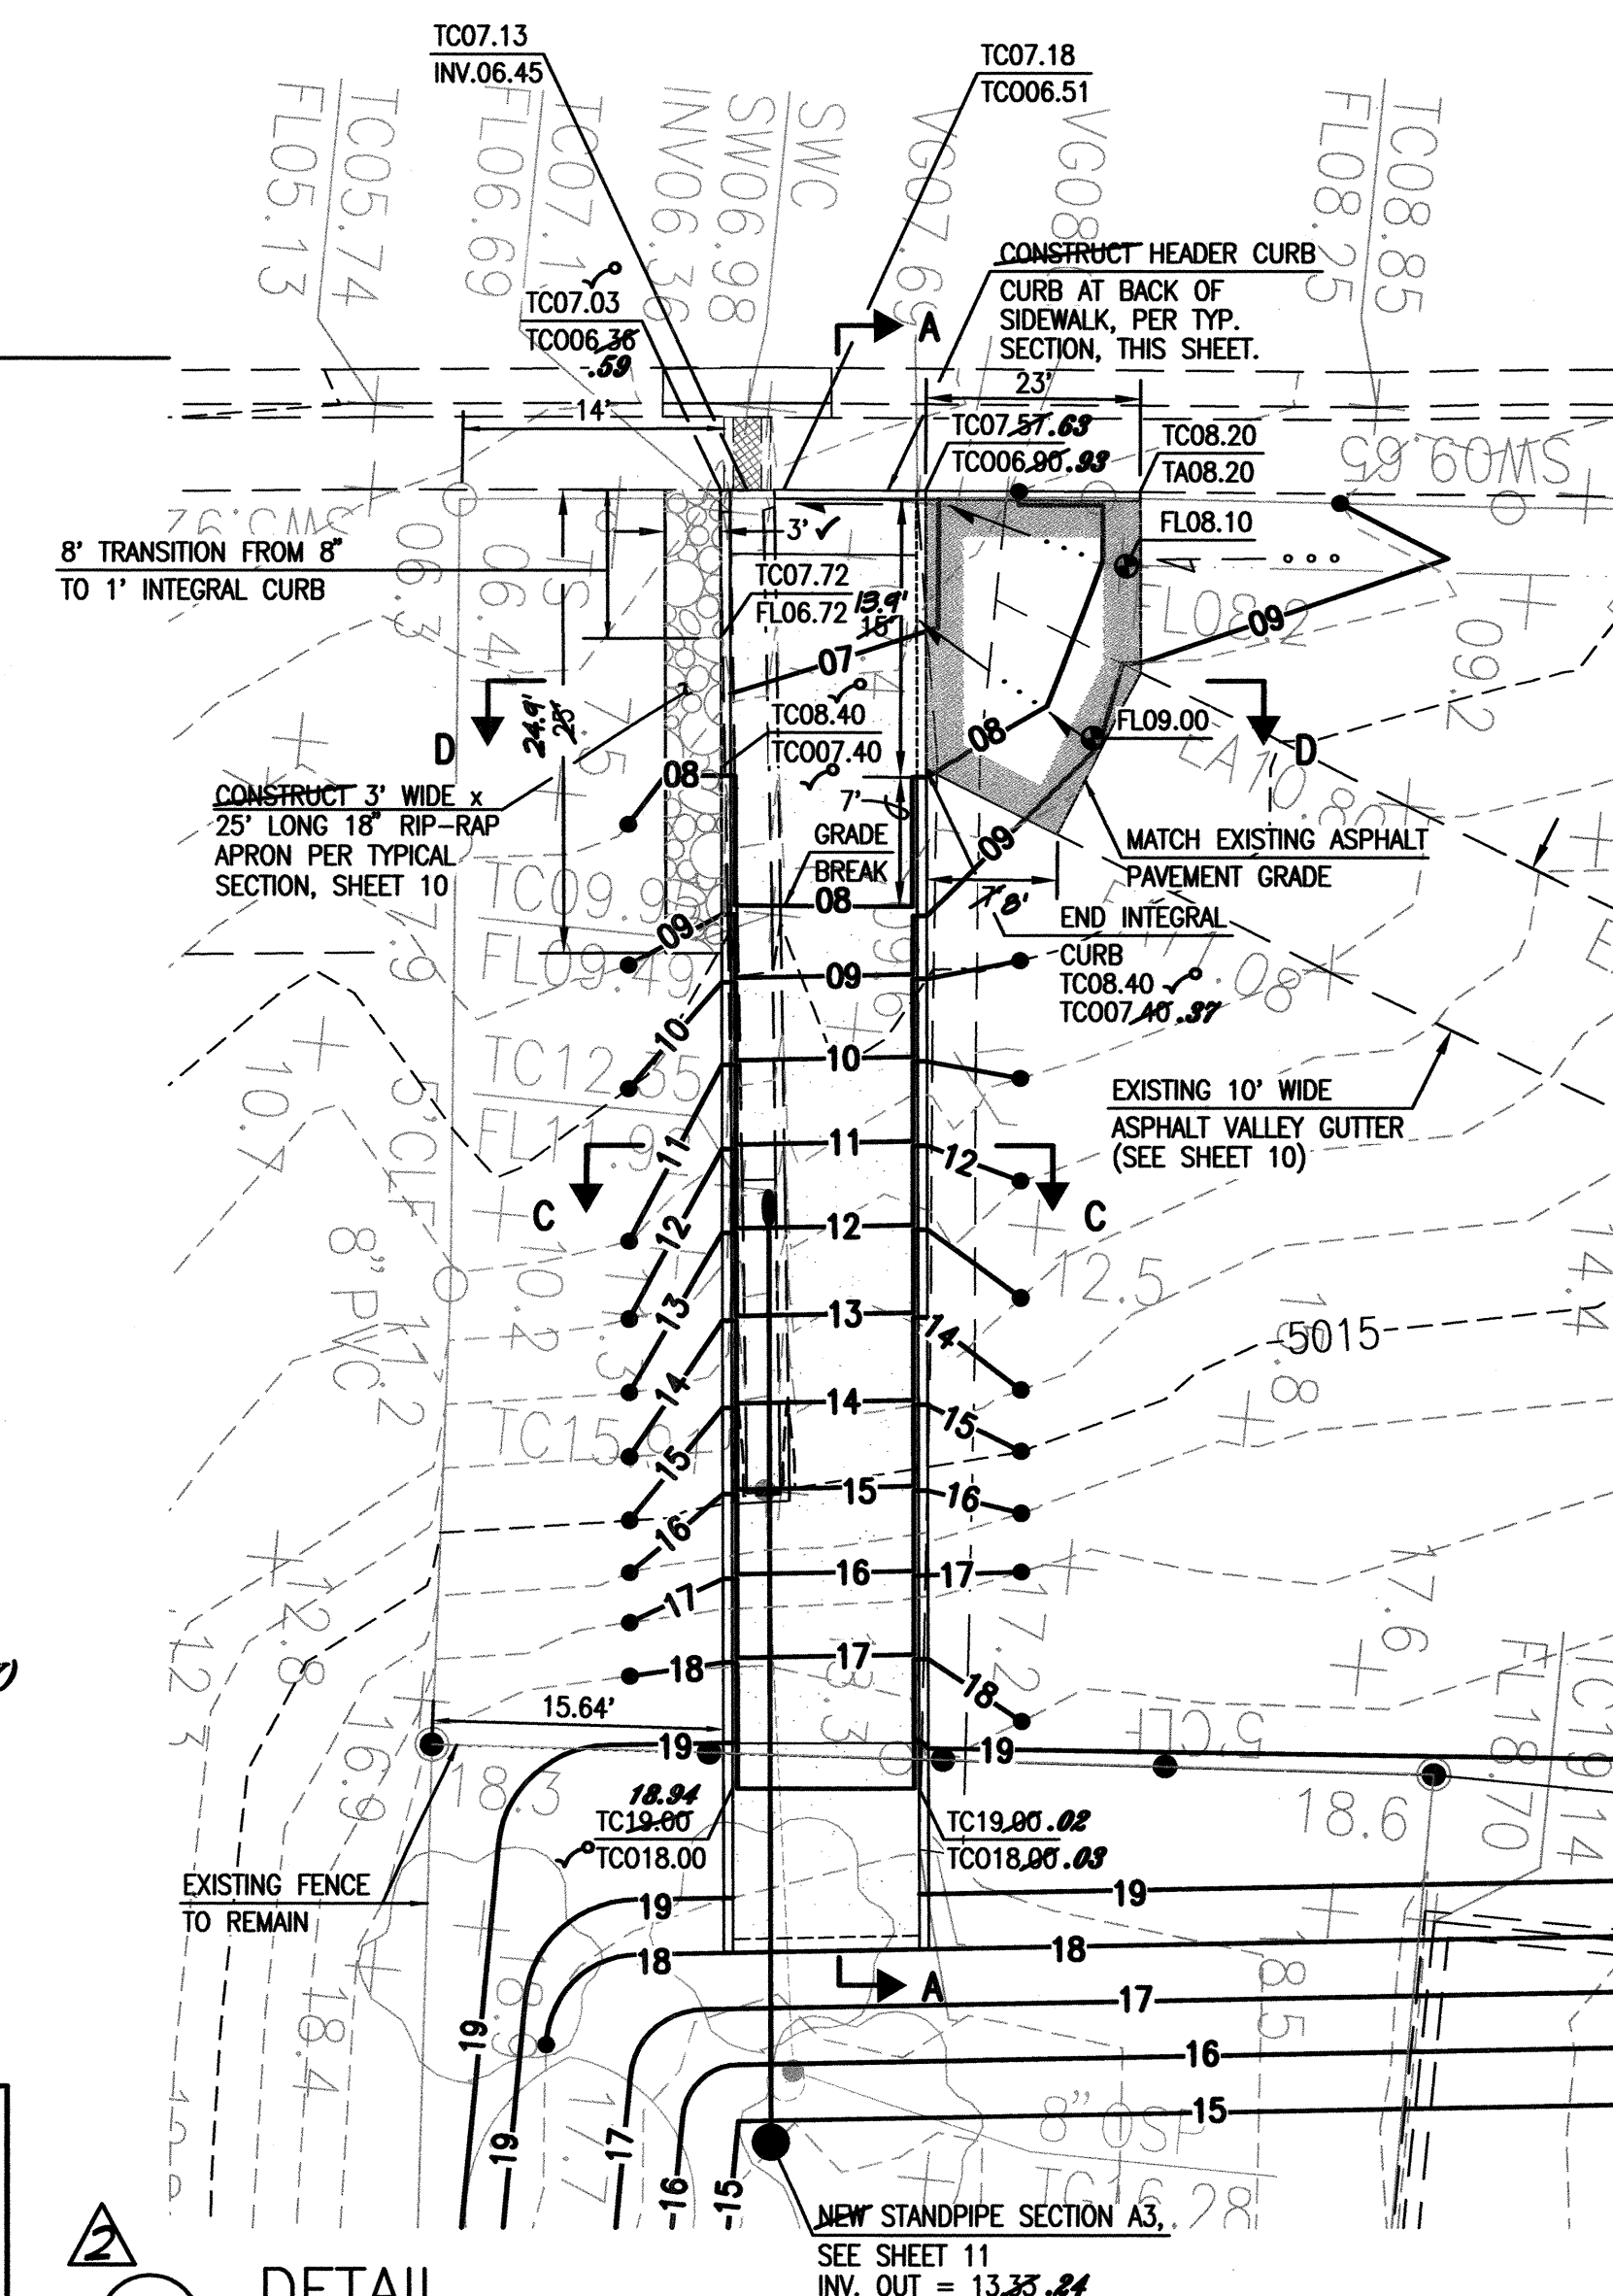

HIGH MESA
Consulting Group

6010-B MIDWAY PARK BLVD. NE
ALBUQUERQUE, NEW MEXICO 87109
PHONE: 505.345.4250 FAX: 505.345.4254
www.highmesacg.com

01-11-2010

06-05-2009

PROFESSIONAL ENGINEER NASSAU
JEFREY G. WORTEN
MEXICO
8647
N.E.M.
REGISTERED

MASTER DRAINAGE PLAN IMPROVEMENTS PHASE 2—B ALBUQUERQUE HIGH SCHOOL

[illegible]

POND AND SPILLWAY SECTIONS AND DETAILS

C-309

SHEET 9 OF 14

File Path:	E:\DATA\ACQU14\2007\183.1\PHASE-28\121	Plot Date:	01-06-2010
File Name:	71837P2B_DPSTAR2.DWG	Plot Time:	09:55 am