




File Path: E:\WORK\2007\183\183-183.dwg Plot Date: 01-06-2010
File Name: 7183728_183-183.dwg Plot Time: 09:56 am

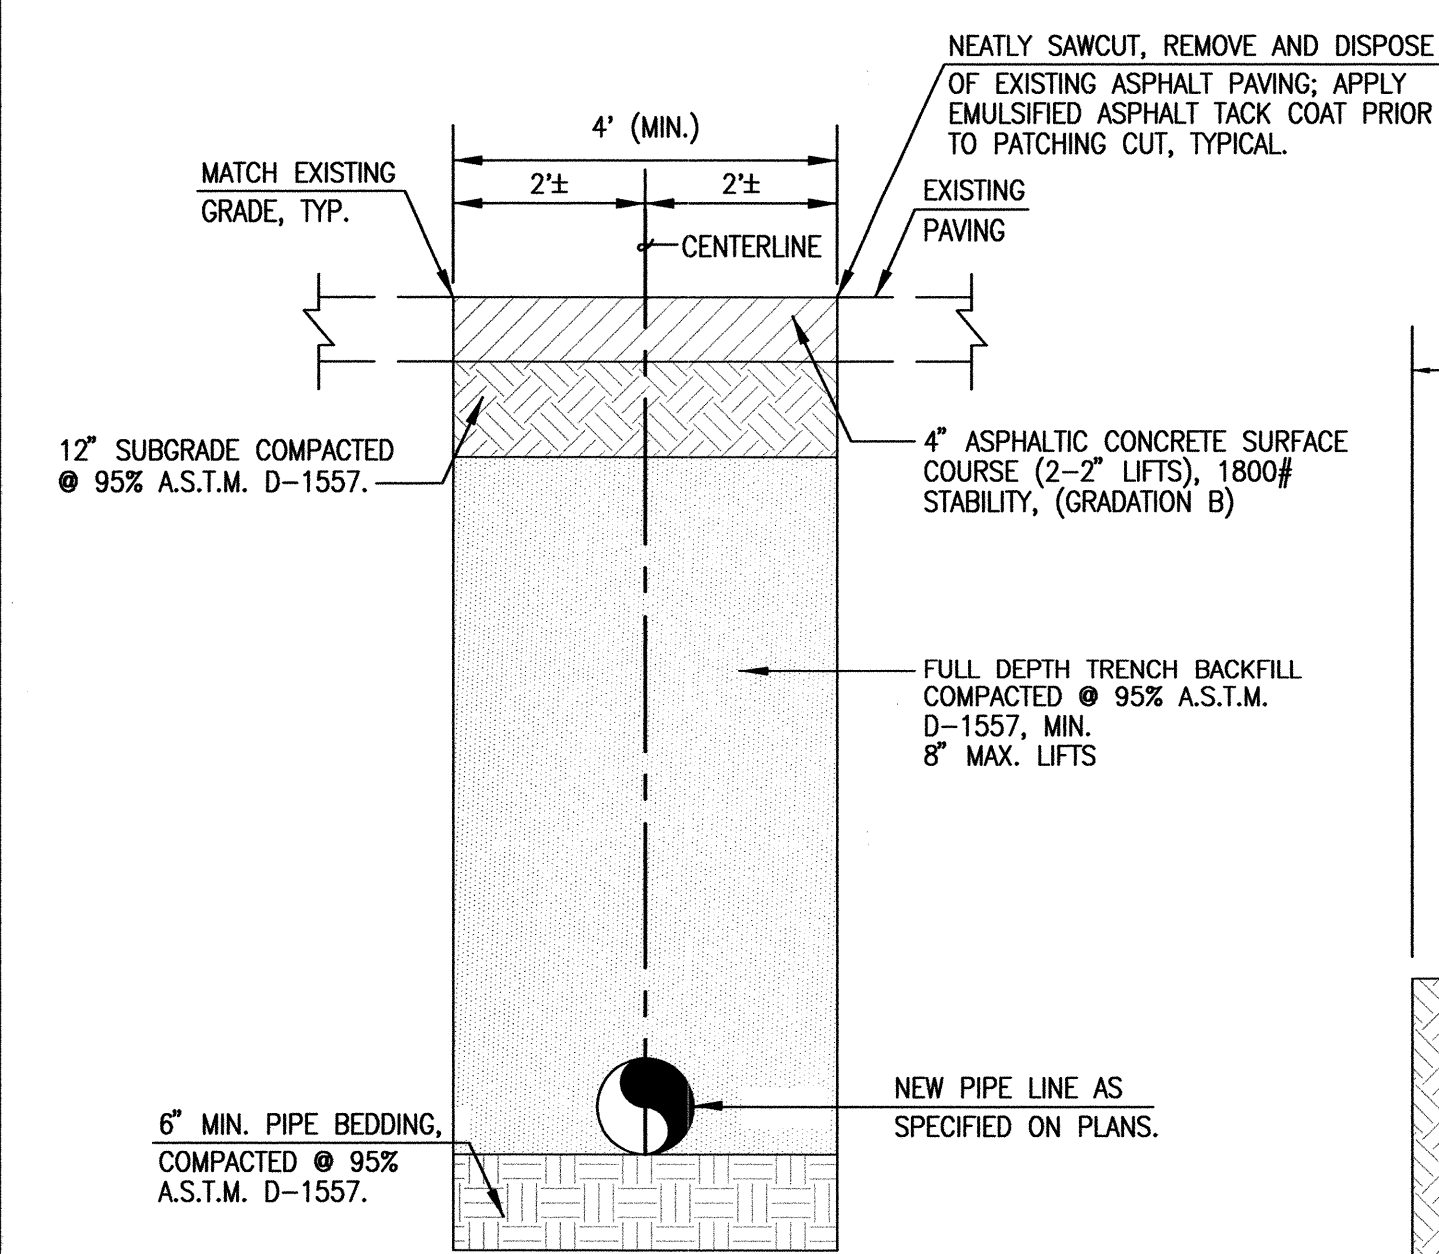


D1
NTS
TYPICAL PRIVATE PAVING UTILITY CUT AND PAVEMENT REPLACEMENT SECTION

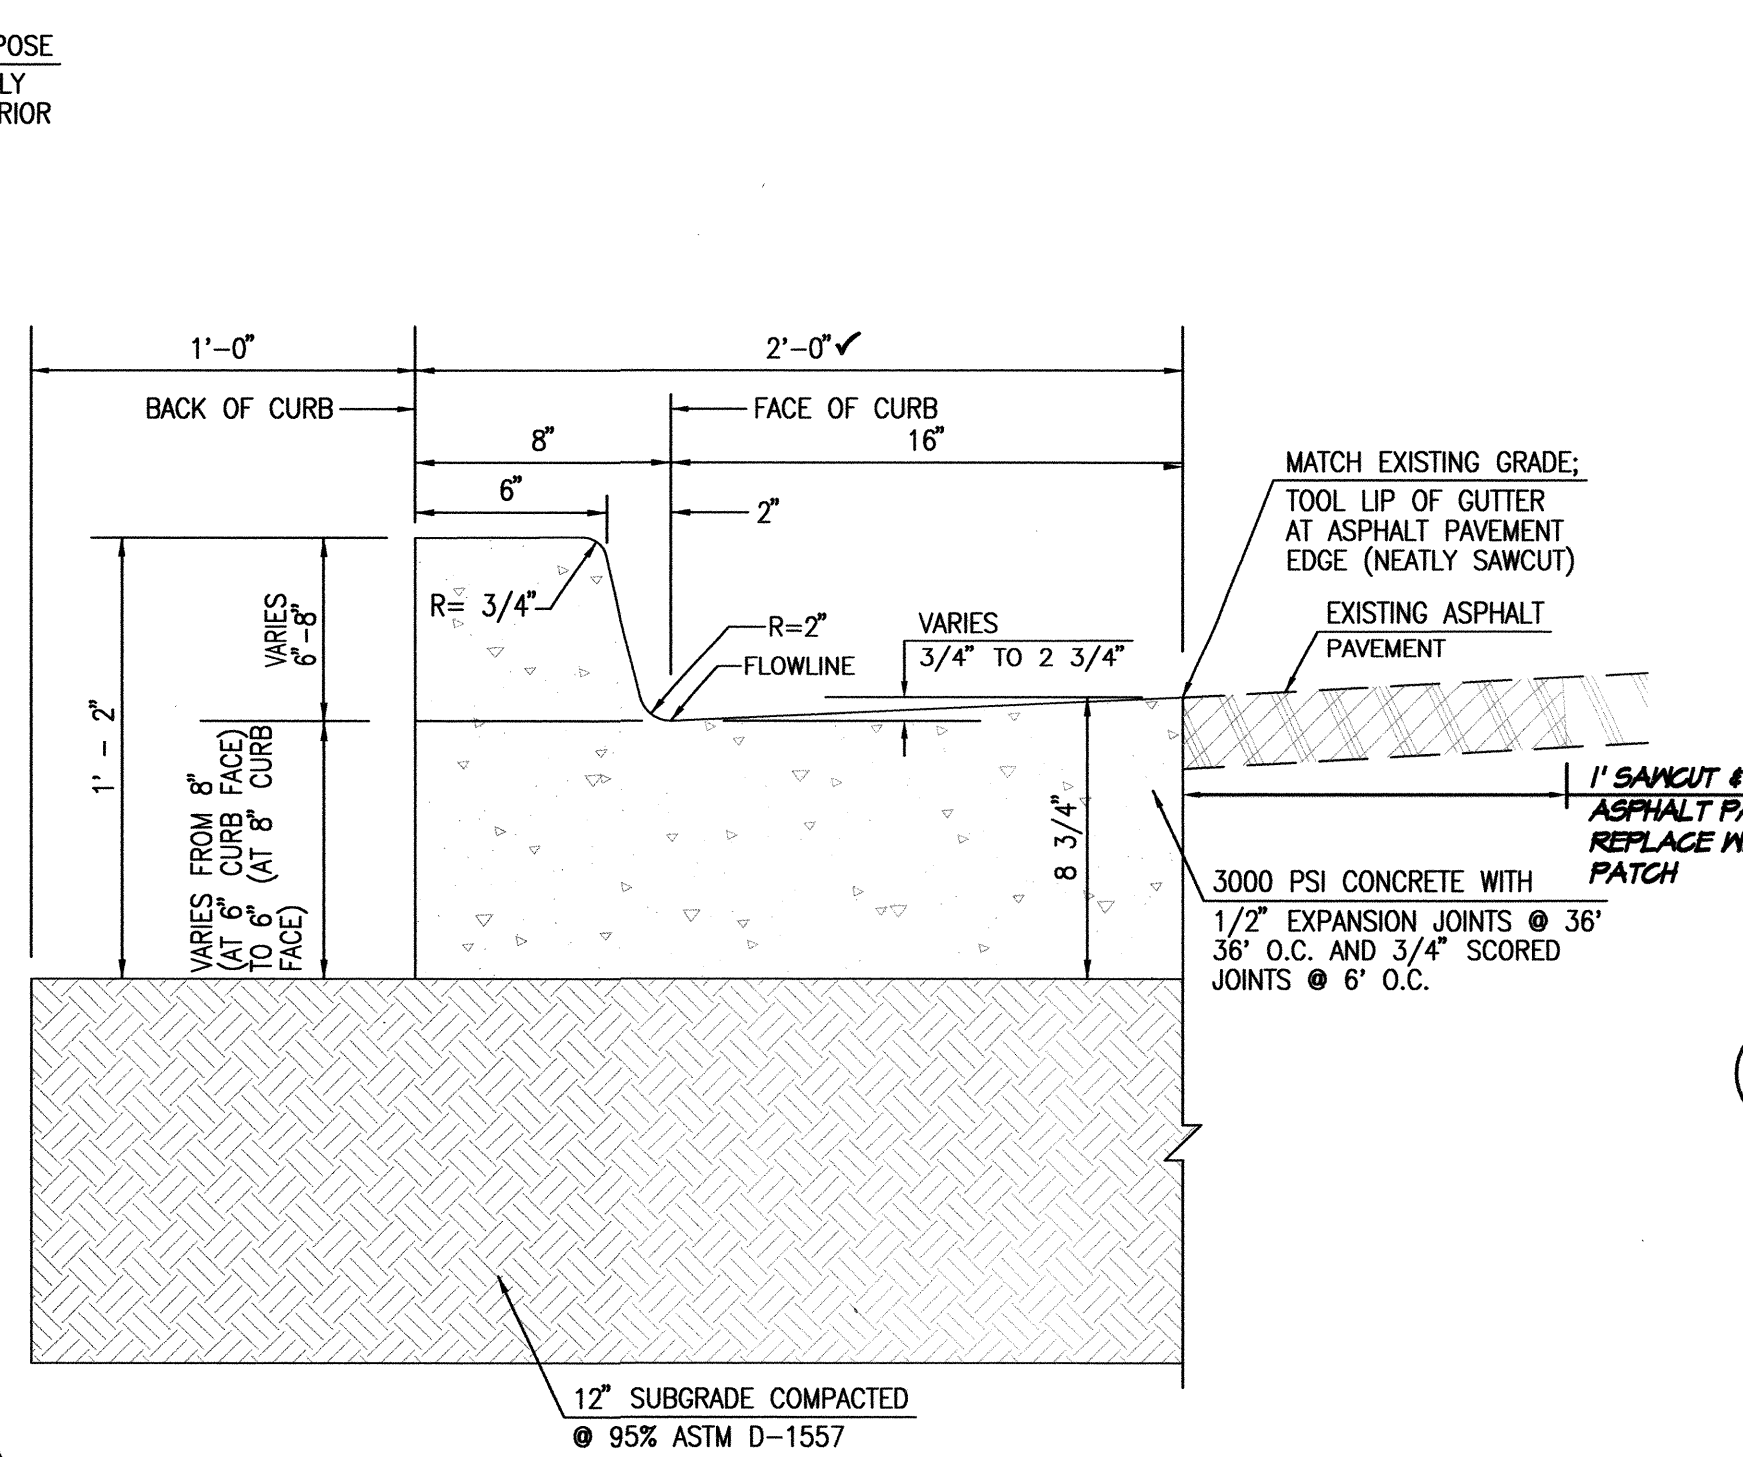

D2
SCALE: 1" = 0'-6"
TYPICAL CURB & GUTTER (VARIABLE CURB HEIGHT)

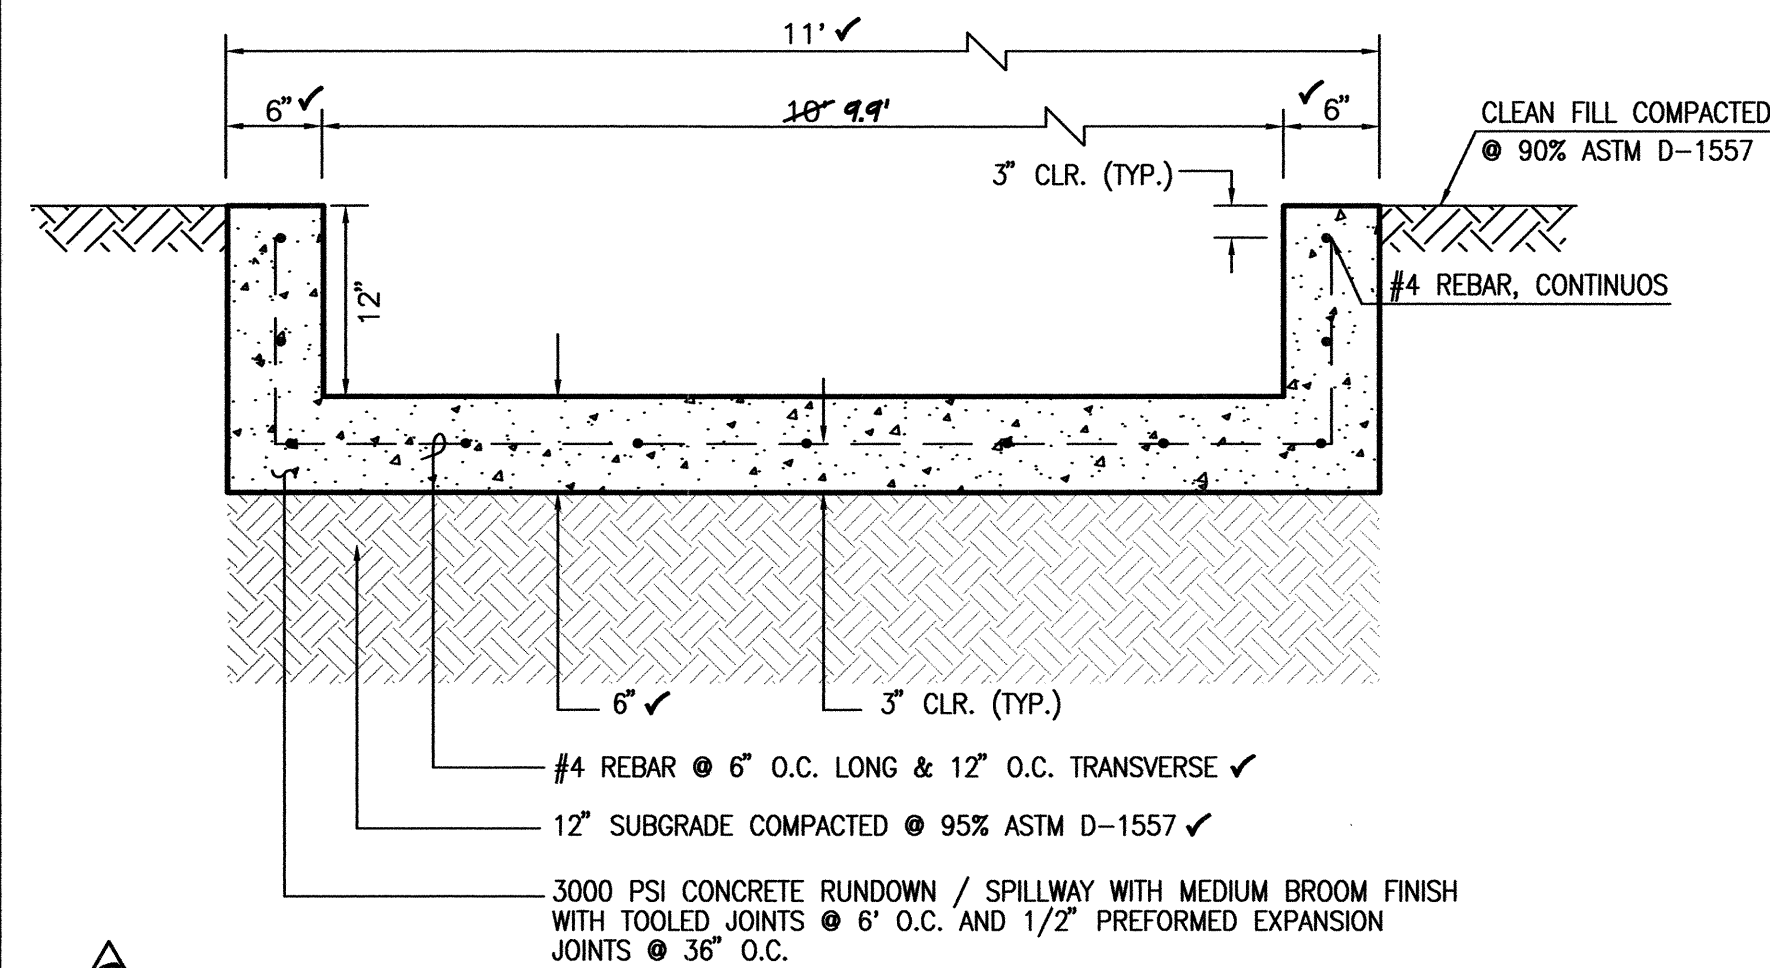


B1
SCALE: 1" = 1' - 0"
SECTION C-C

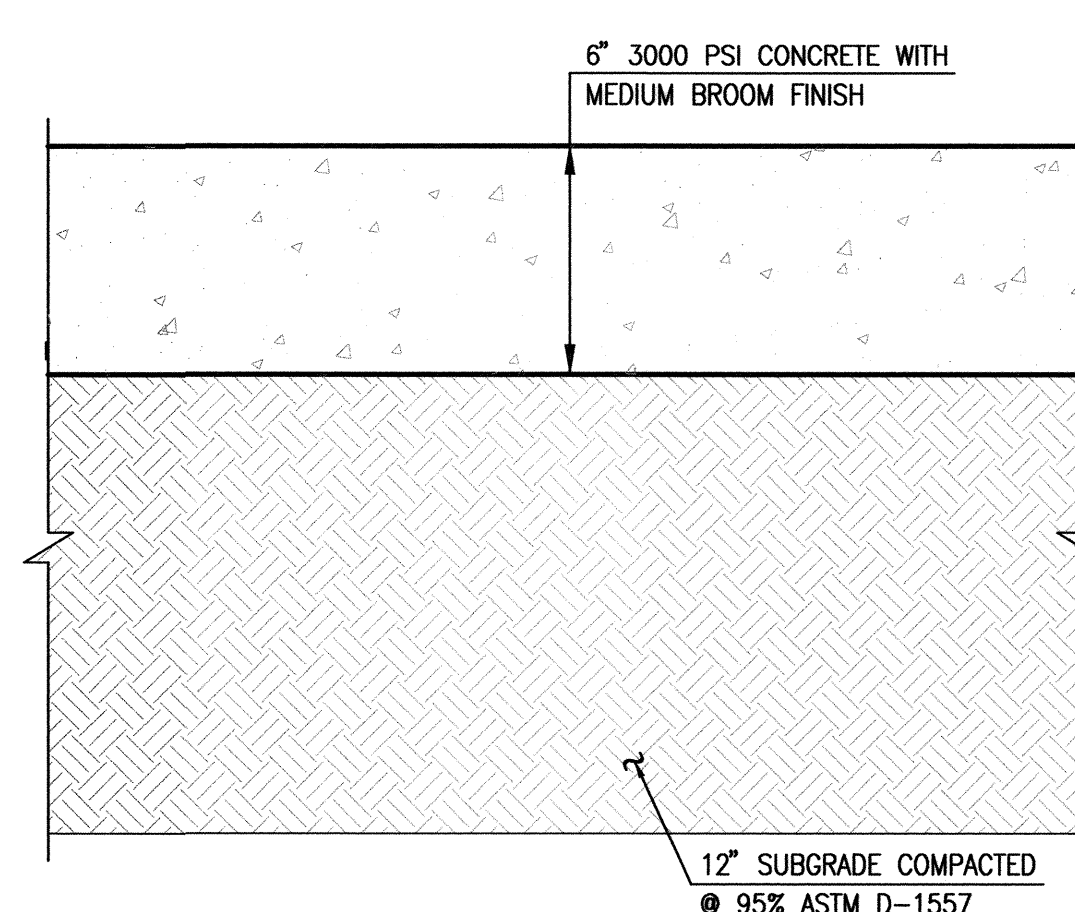


B2
SCALE: 1" = 0' - 5"
TYPICAL 6" CONCRETE PAVING SECTION

RECORD DRAWING LEGEND


CONSTRUCT	RECORD INFORMATION (VERIFIED BY ENGINEER)
✓	AS-CONSTRUCTED = AS-DESIGNED (VERIFIED BY ENGINEER)
36' 42"	RECORD INFORMATION (VERIFIED BY ENGINEER)
+25.2	RECORD INFORMATION (VERIFIED BY ENGINEER)
28.98' 42"	RECORD INFORMATION (VERIFIED BY ENGINEER)
✓	AS-CONSTRUCTED = AS-DESIGNED (VERIFIED BY AS-BUILT SURVEY)
31.31.8	RECORD INFORMATION FROM AS-BUILT SURVEY
+26.9	RECORD INFORMATION FROM AS-BUILT SURVEY
31.25.22	RECORD INFORMATION FROM AS-BUILT SURVEY

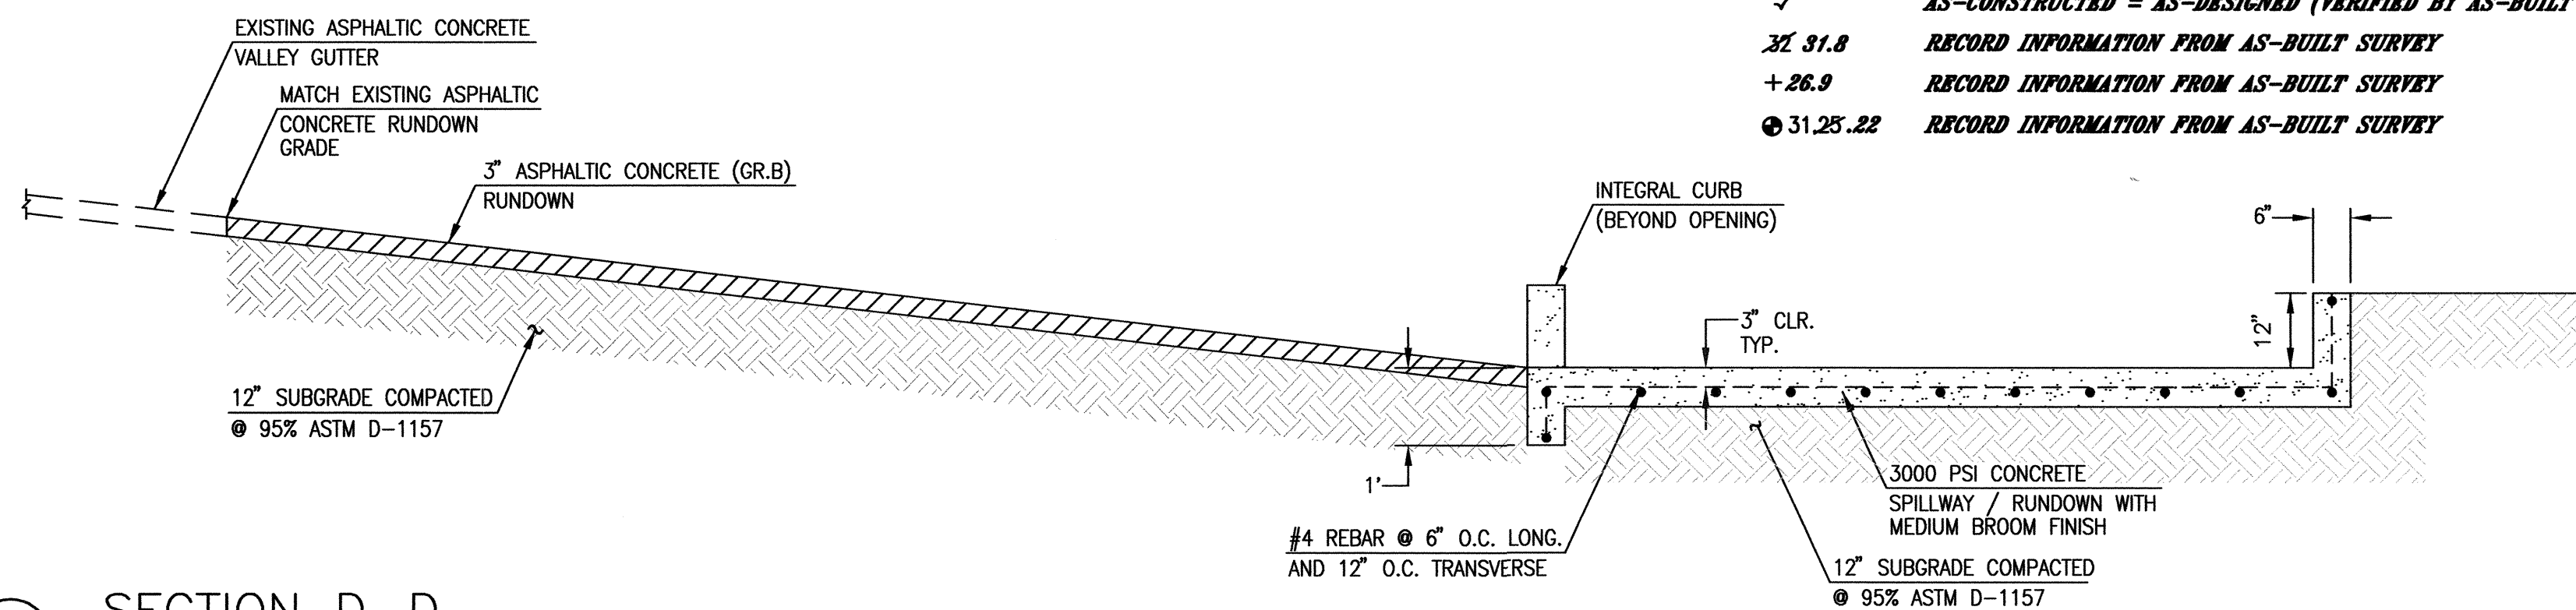


A1
SCALE: 1" = 2"
SECTION D-D

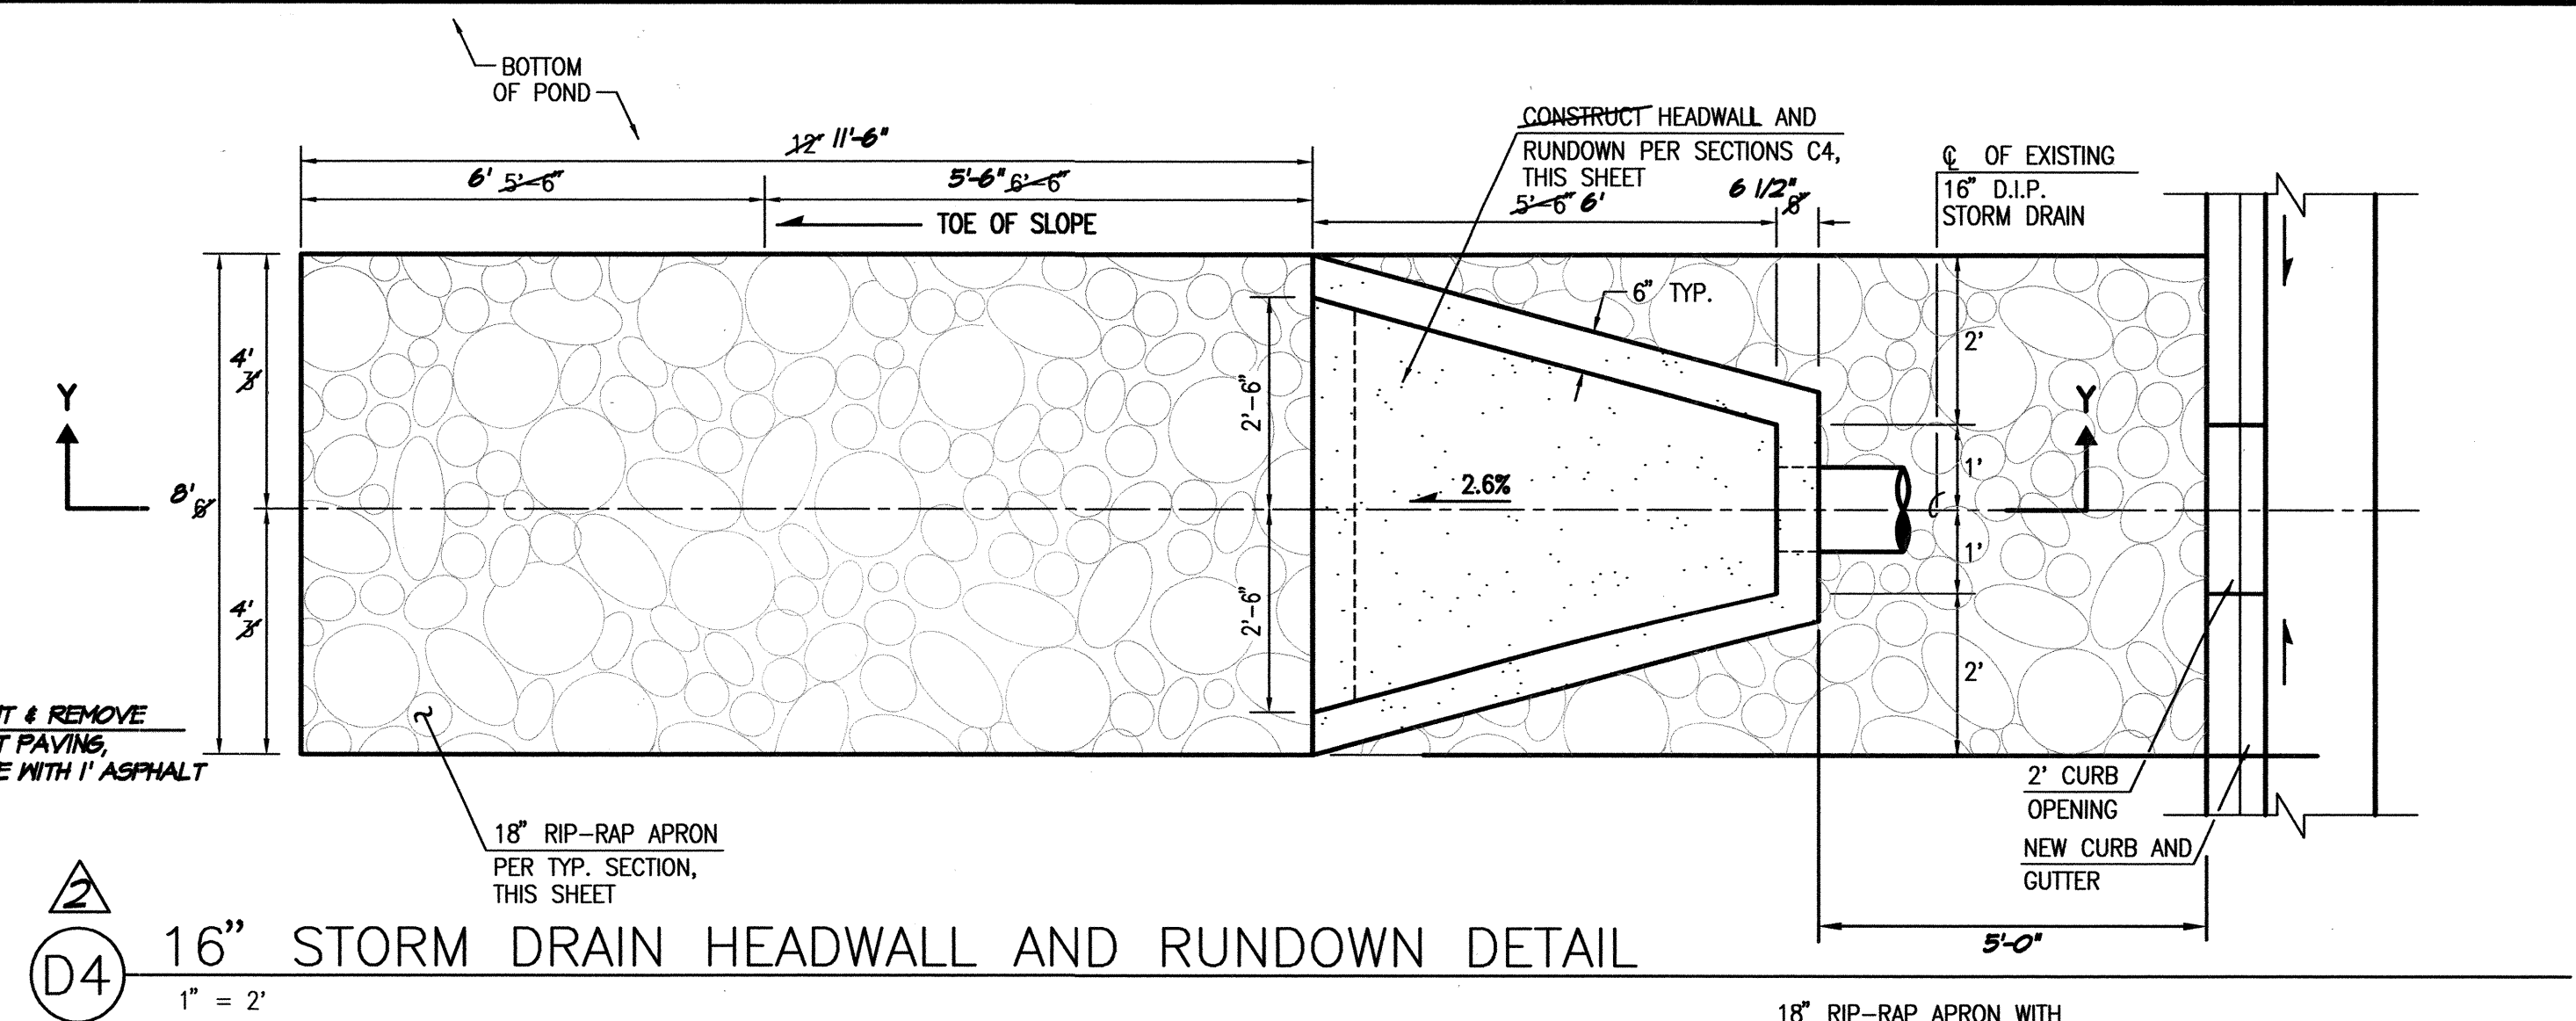


D4
1" = 2"
16" STORM DRAIN HEADWALL AND RUNDOWN DETAIL

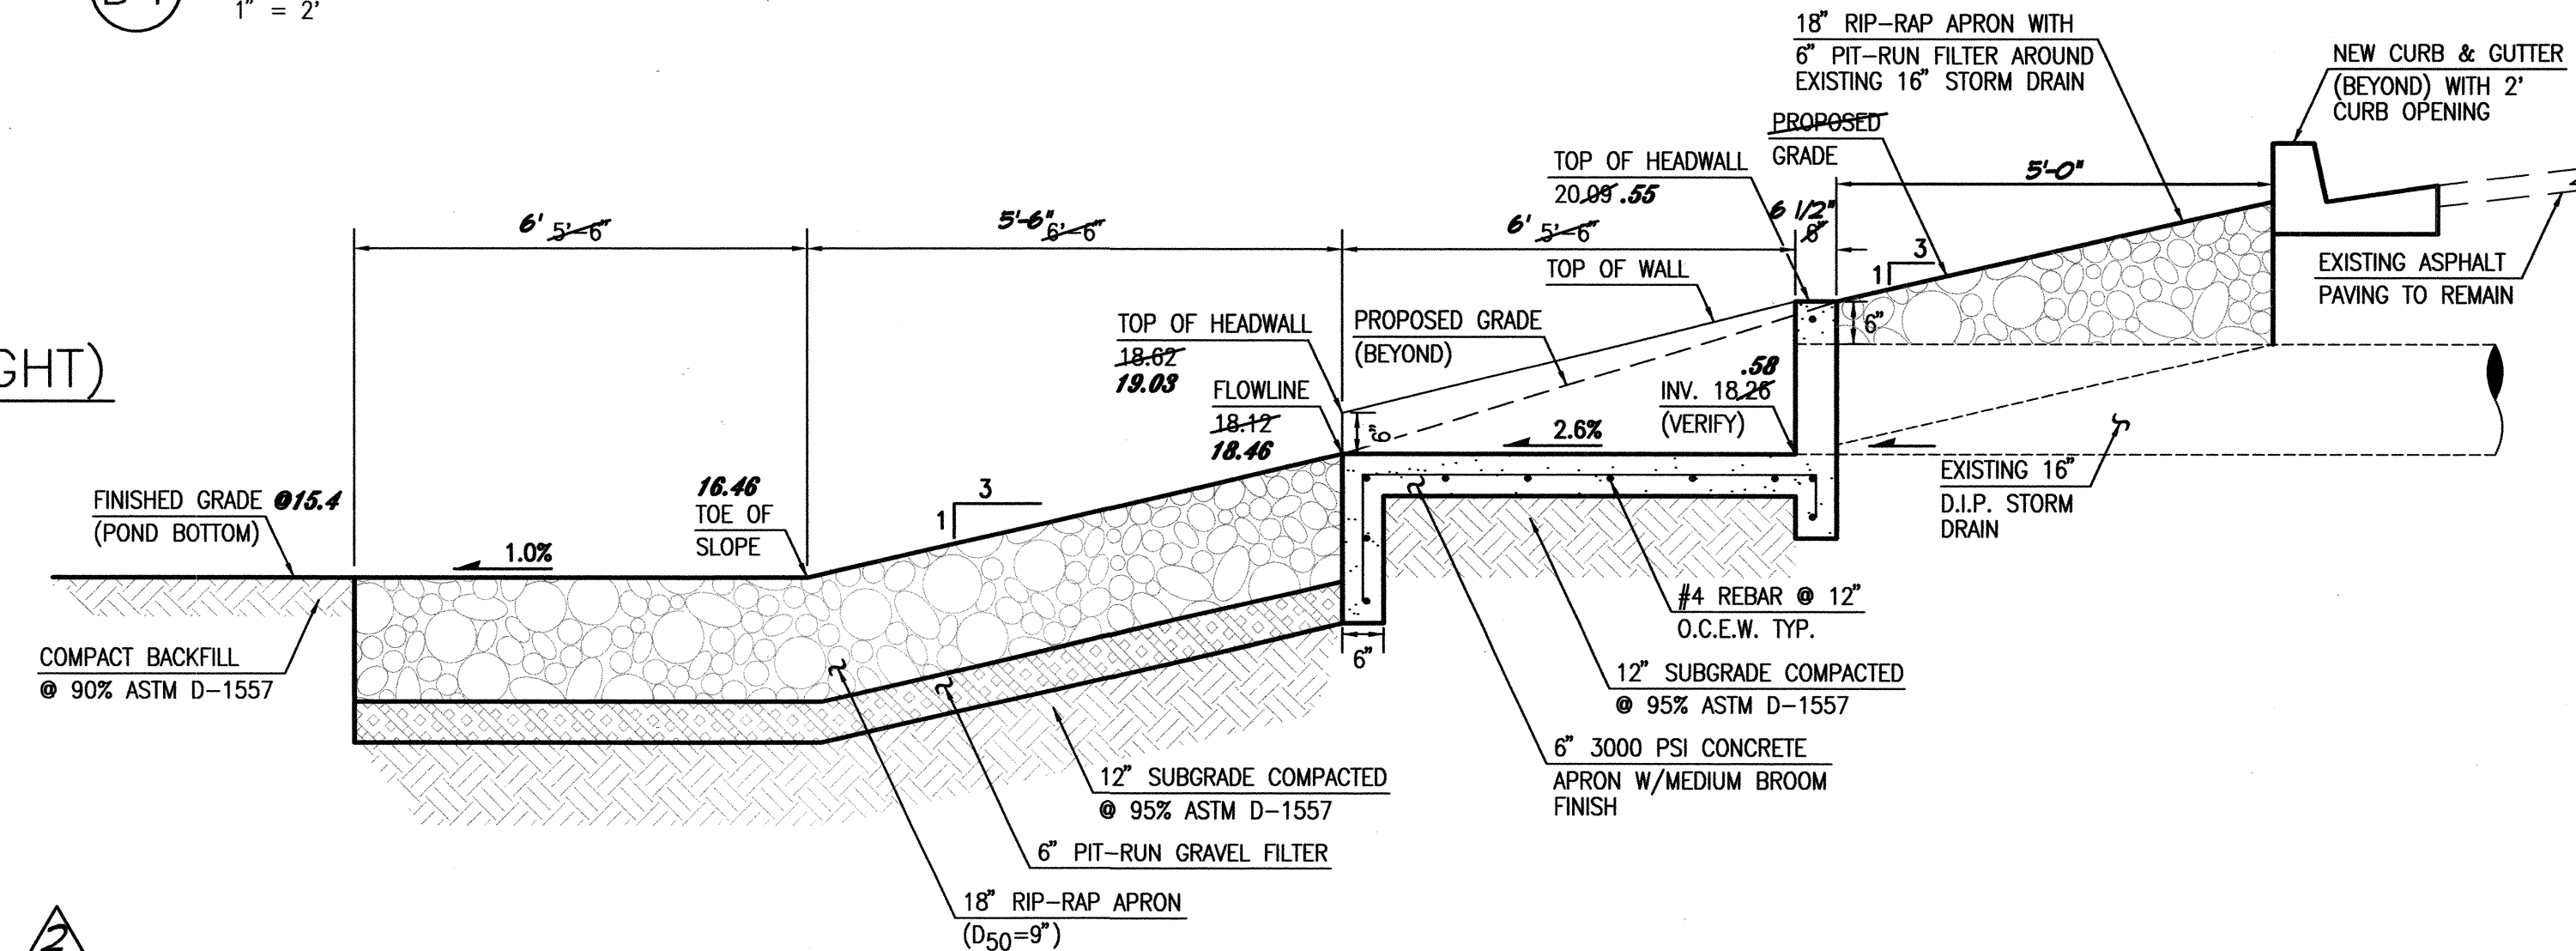


C4
1" = 2"
16" HEADWALL AND RUNDOWN SECTION Y-Y

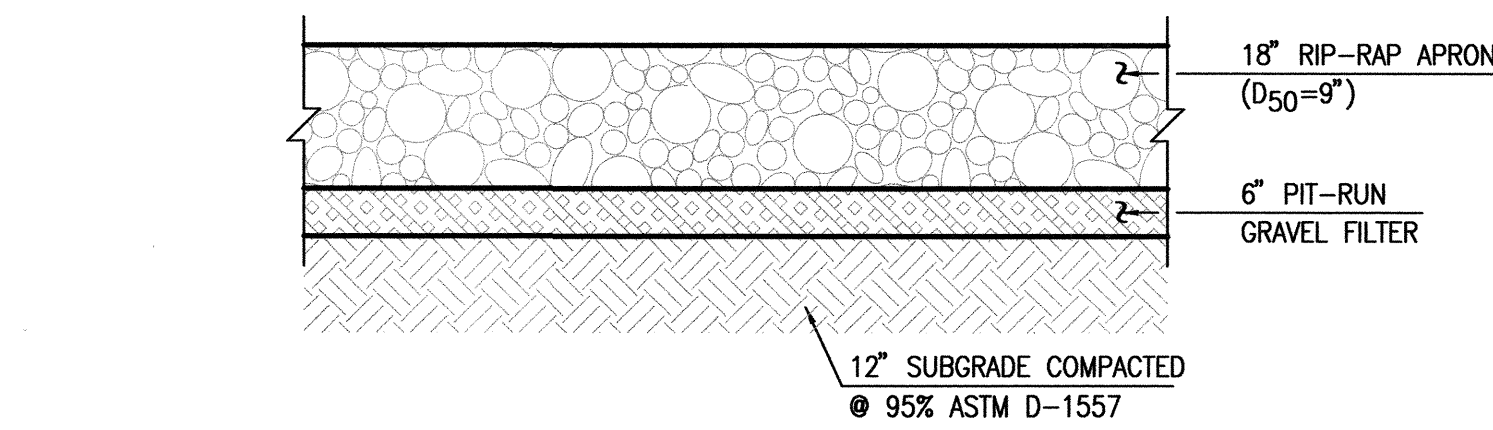

B4
1" = 2"
TYPICAL RIP-RAP APRON SECTION

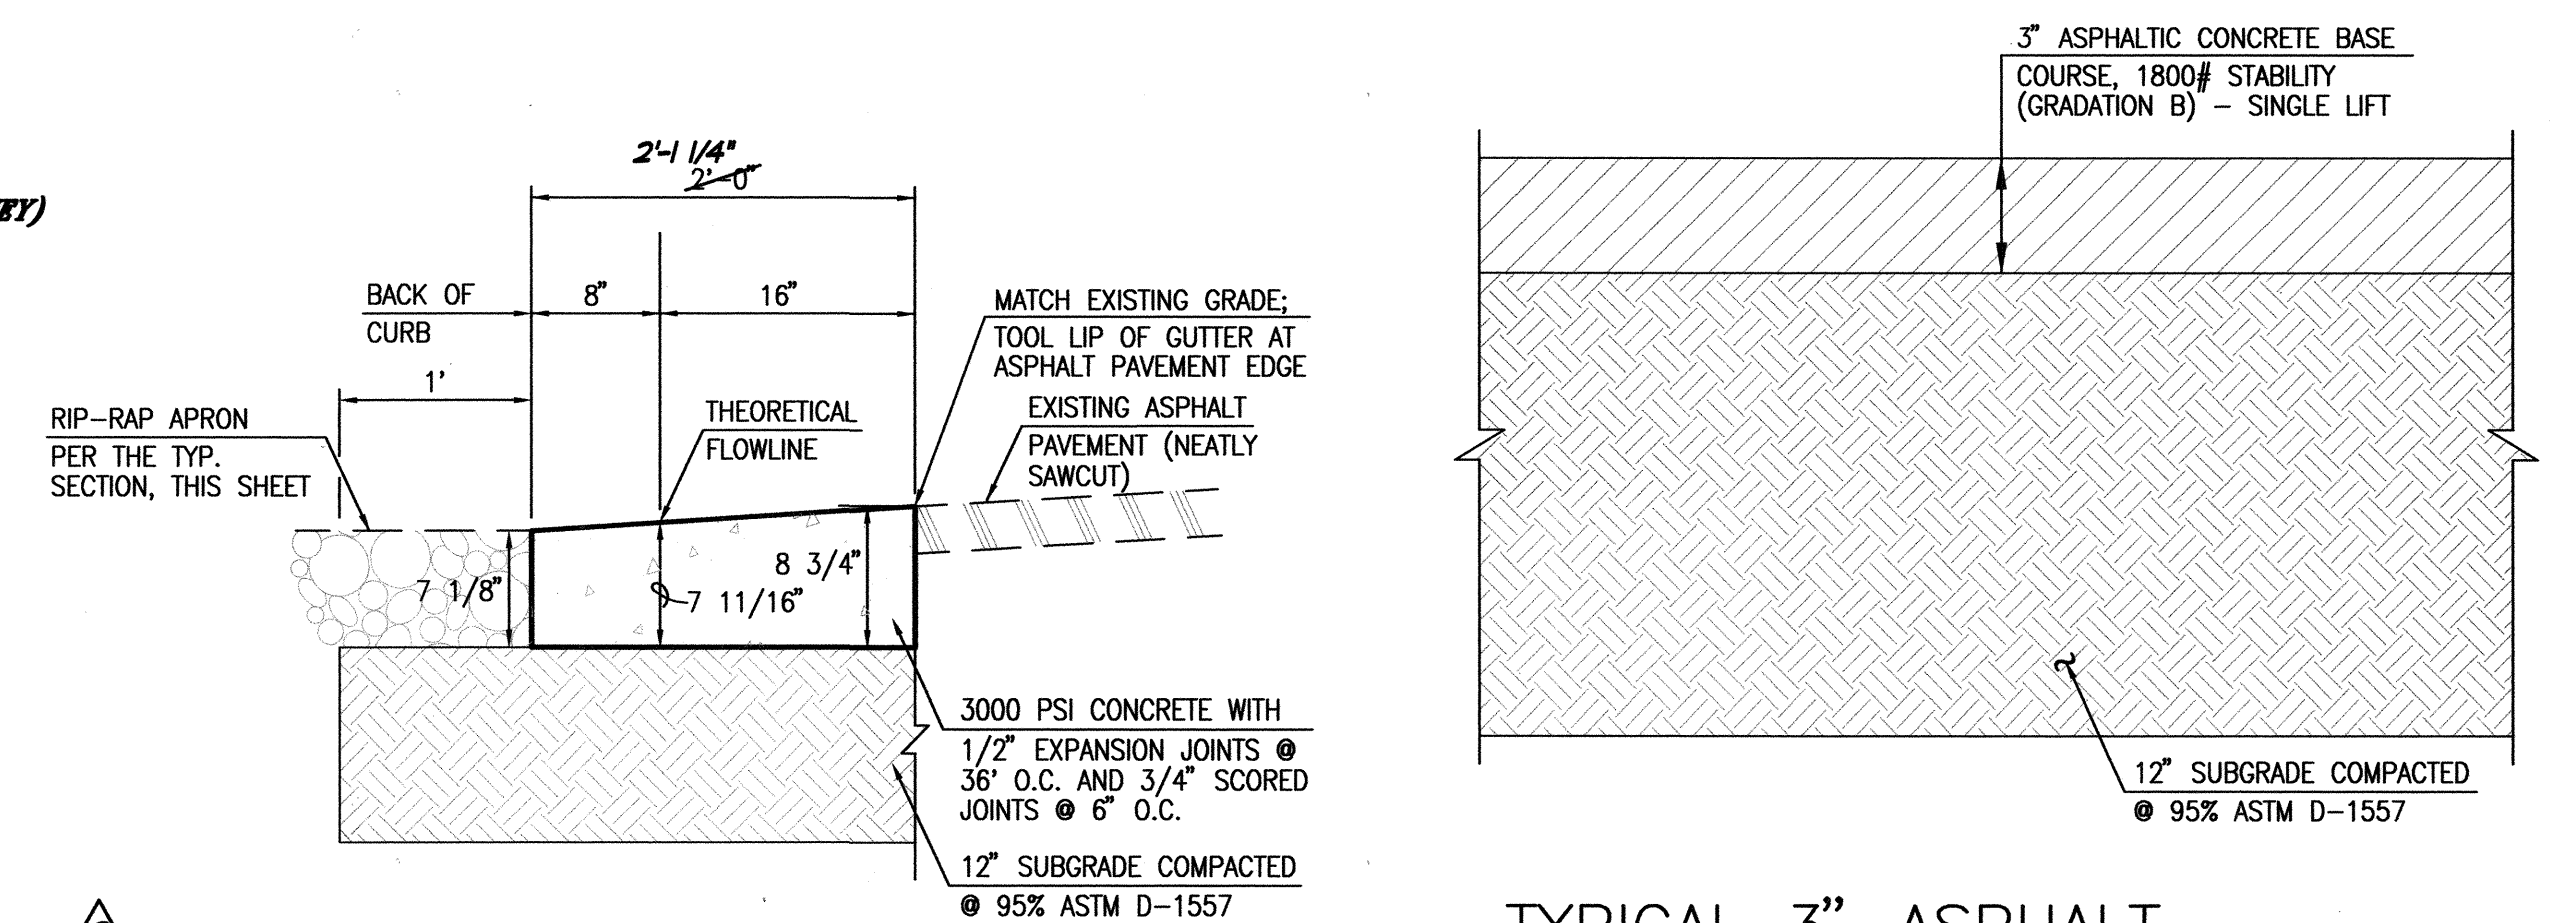

A4
SCALE: 1" = 1' - 0"
TYPICAL RUN-DOWN CURB SECTION

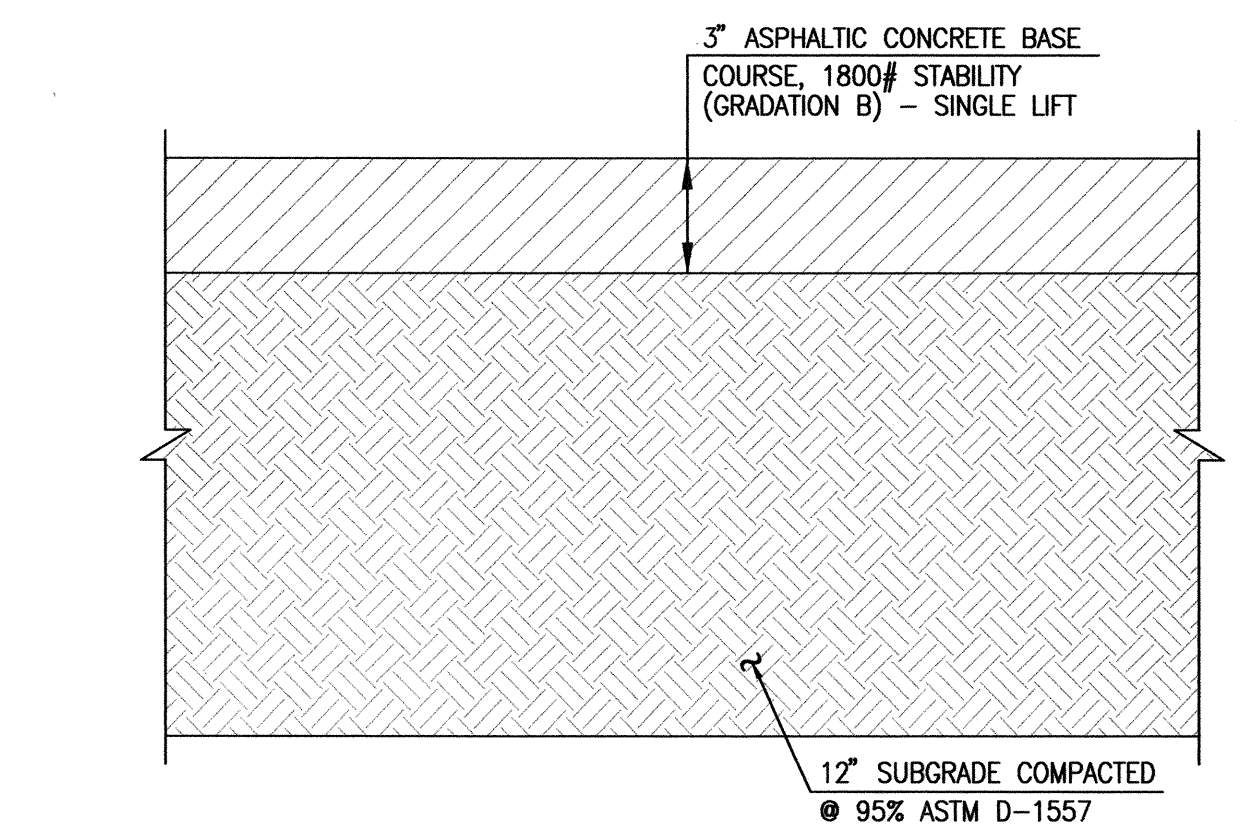

A5
SCALE: 1" = 0' - 5"
TYPICAL 3" ASPHALT PAVING SECTION

RECORD DRAWING
FOR CERTIFICATION, SEE SHEET 1

MASTER DRAINAGE PLAN IMPROVEMENTS
PHASE 2-B
ALBUQUERQUE HIGH SCHOOL

NO.	DATE	BY	REVISIONS
1	12/04	AM	REC. DMS & CERT.
2			
3			
4			
5			
6			
7			
8			
9			
10			

PROJECT No. 2007.183.7
DESIGNED BY G.R.B.
DRAWN BY J.Y.R.
APPROVED BY J.G.M.
SHEET TITLE

PAVING AND DRAINAGE
SECTIONS AND
DETAILS

C-310
SHEET 10 OF 14

01-11-2006
06-05-2007
HIGH MESA Consulting Group
6010-B MIDWAY PARK BLVD. NE
ALBUQUERQUE, NEW MEXICO 87109
PHONE: 505.345.4250 FAX: 505.345.4254
www.highmesacg.com