


RECORD INFORMATION (VERIFIED BY ENGINEER) AS-CONSTRUCTED = AS-DESIGNED (VERIFIED BY ENGINEER) RECORD INFORMATION (VERIFIED BY ENGINEER) RECORD INFORMATION (VERIFIED BY ENGINEER) ♠ 28.98.42 RECORD INFORMATION (VERIFIED BY ENGINEER) AS-CONSTRUCTED = AS-DESIGNED (VERIFIED BY AS-BUILT SURVEY) RECORD INFORMATION FROM AS-BUILT SURVEY 32 31.8 RECORD INFORMATION FROM AS-BUILT SURVEY ◆ 31.25.22 RECORD INFORMATION FROM AS-BUILT SURVEY

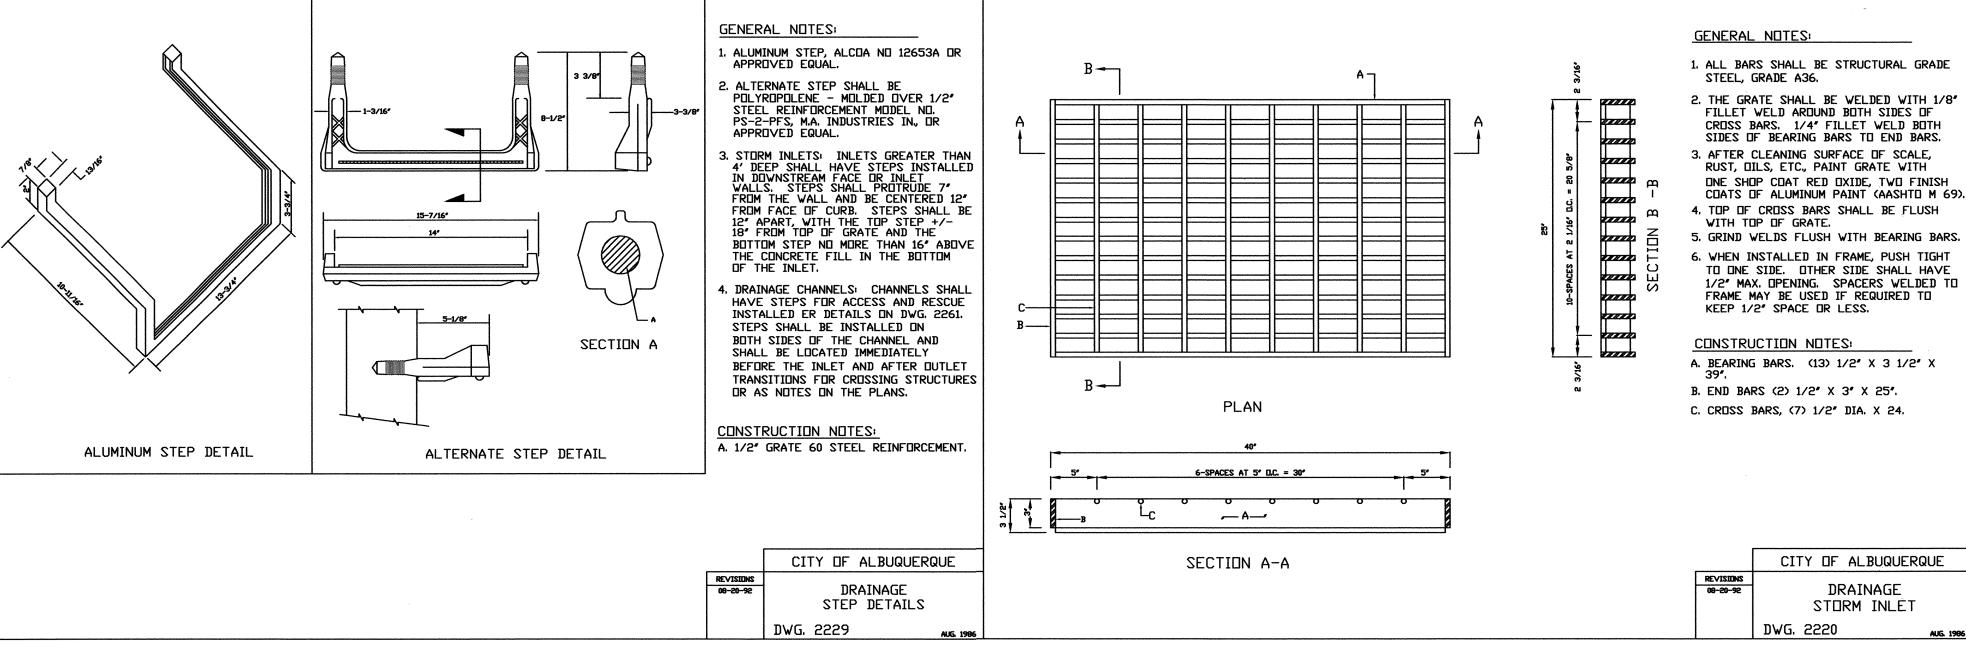



DRAINAGE STEP DETAILS

N.T.S.

DRAINAGE STORM INLET



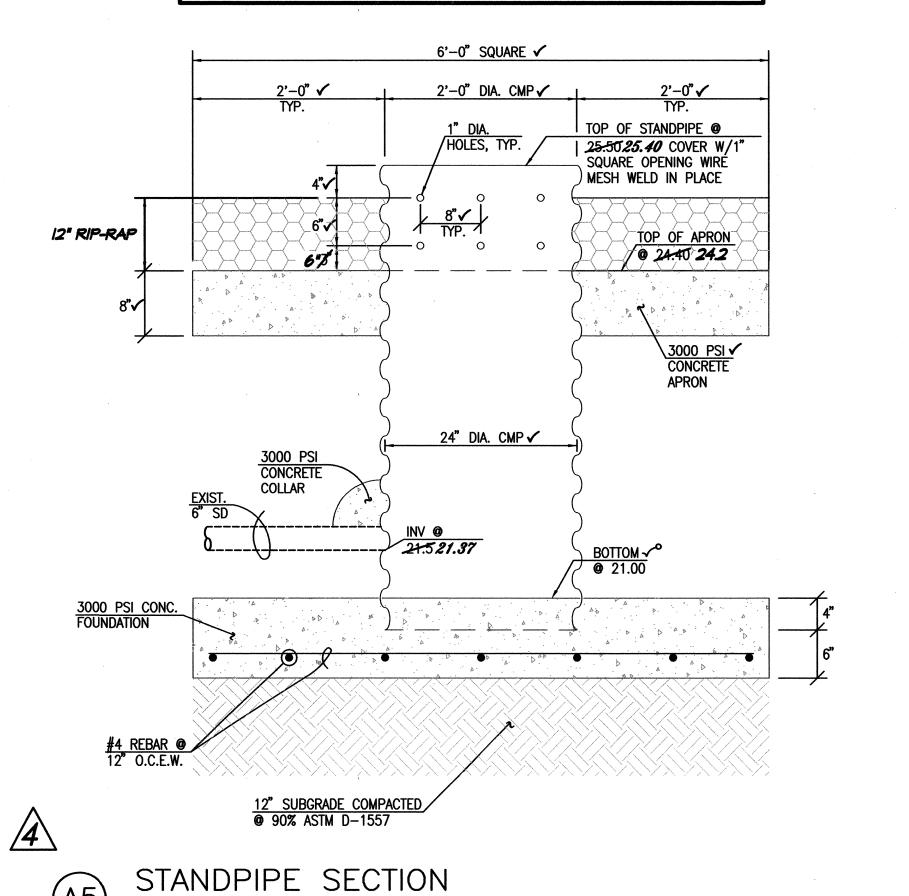

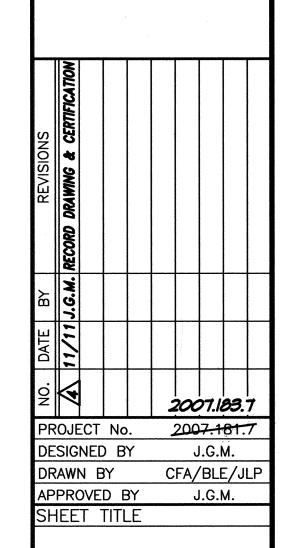

ATION

8

R

O

9

E S

STORM DRAIN **SECTIONS** & DETAILS

C - 316

SHEET 16 OF 25