


File Path: E:\WORK\2007\1837\B-1\B1.dwg Plot Date: 11-30-2011
File Name: 71837-SH17-R4.DWG Plot Time: 07:19 am

B1 STORAGE AREA IMPROVEMENTS AND GRADING PLAN
SCALE: 1" = 10'

4 **RECORD DRAWING**
FOR CERTIFICATION, SEE SHEET 1

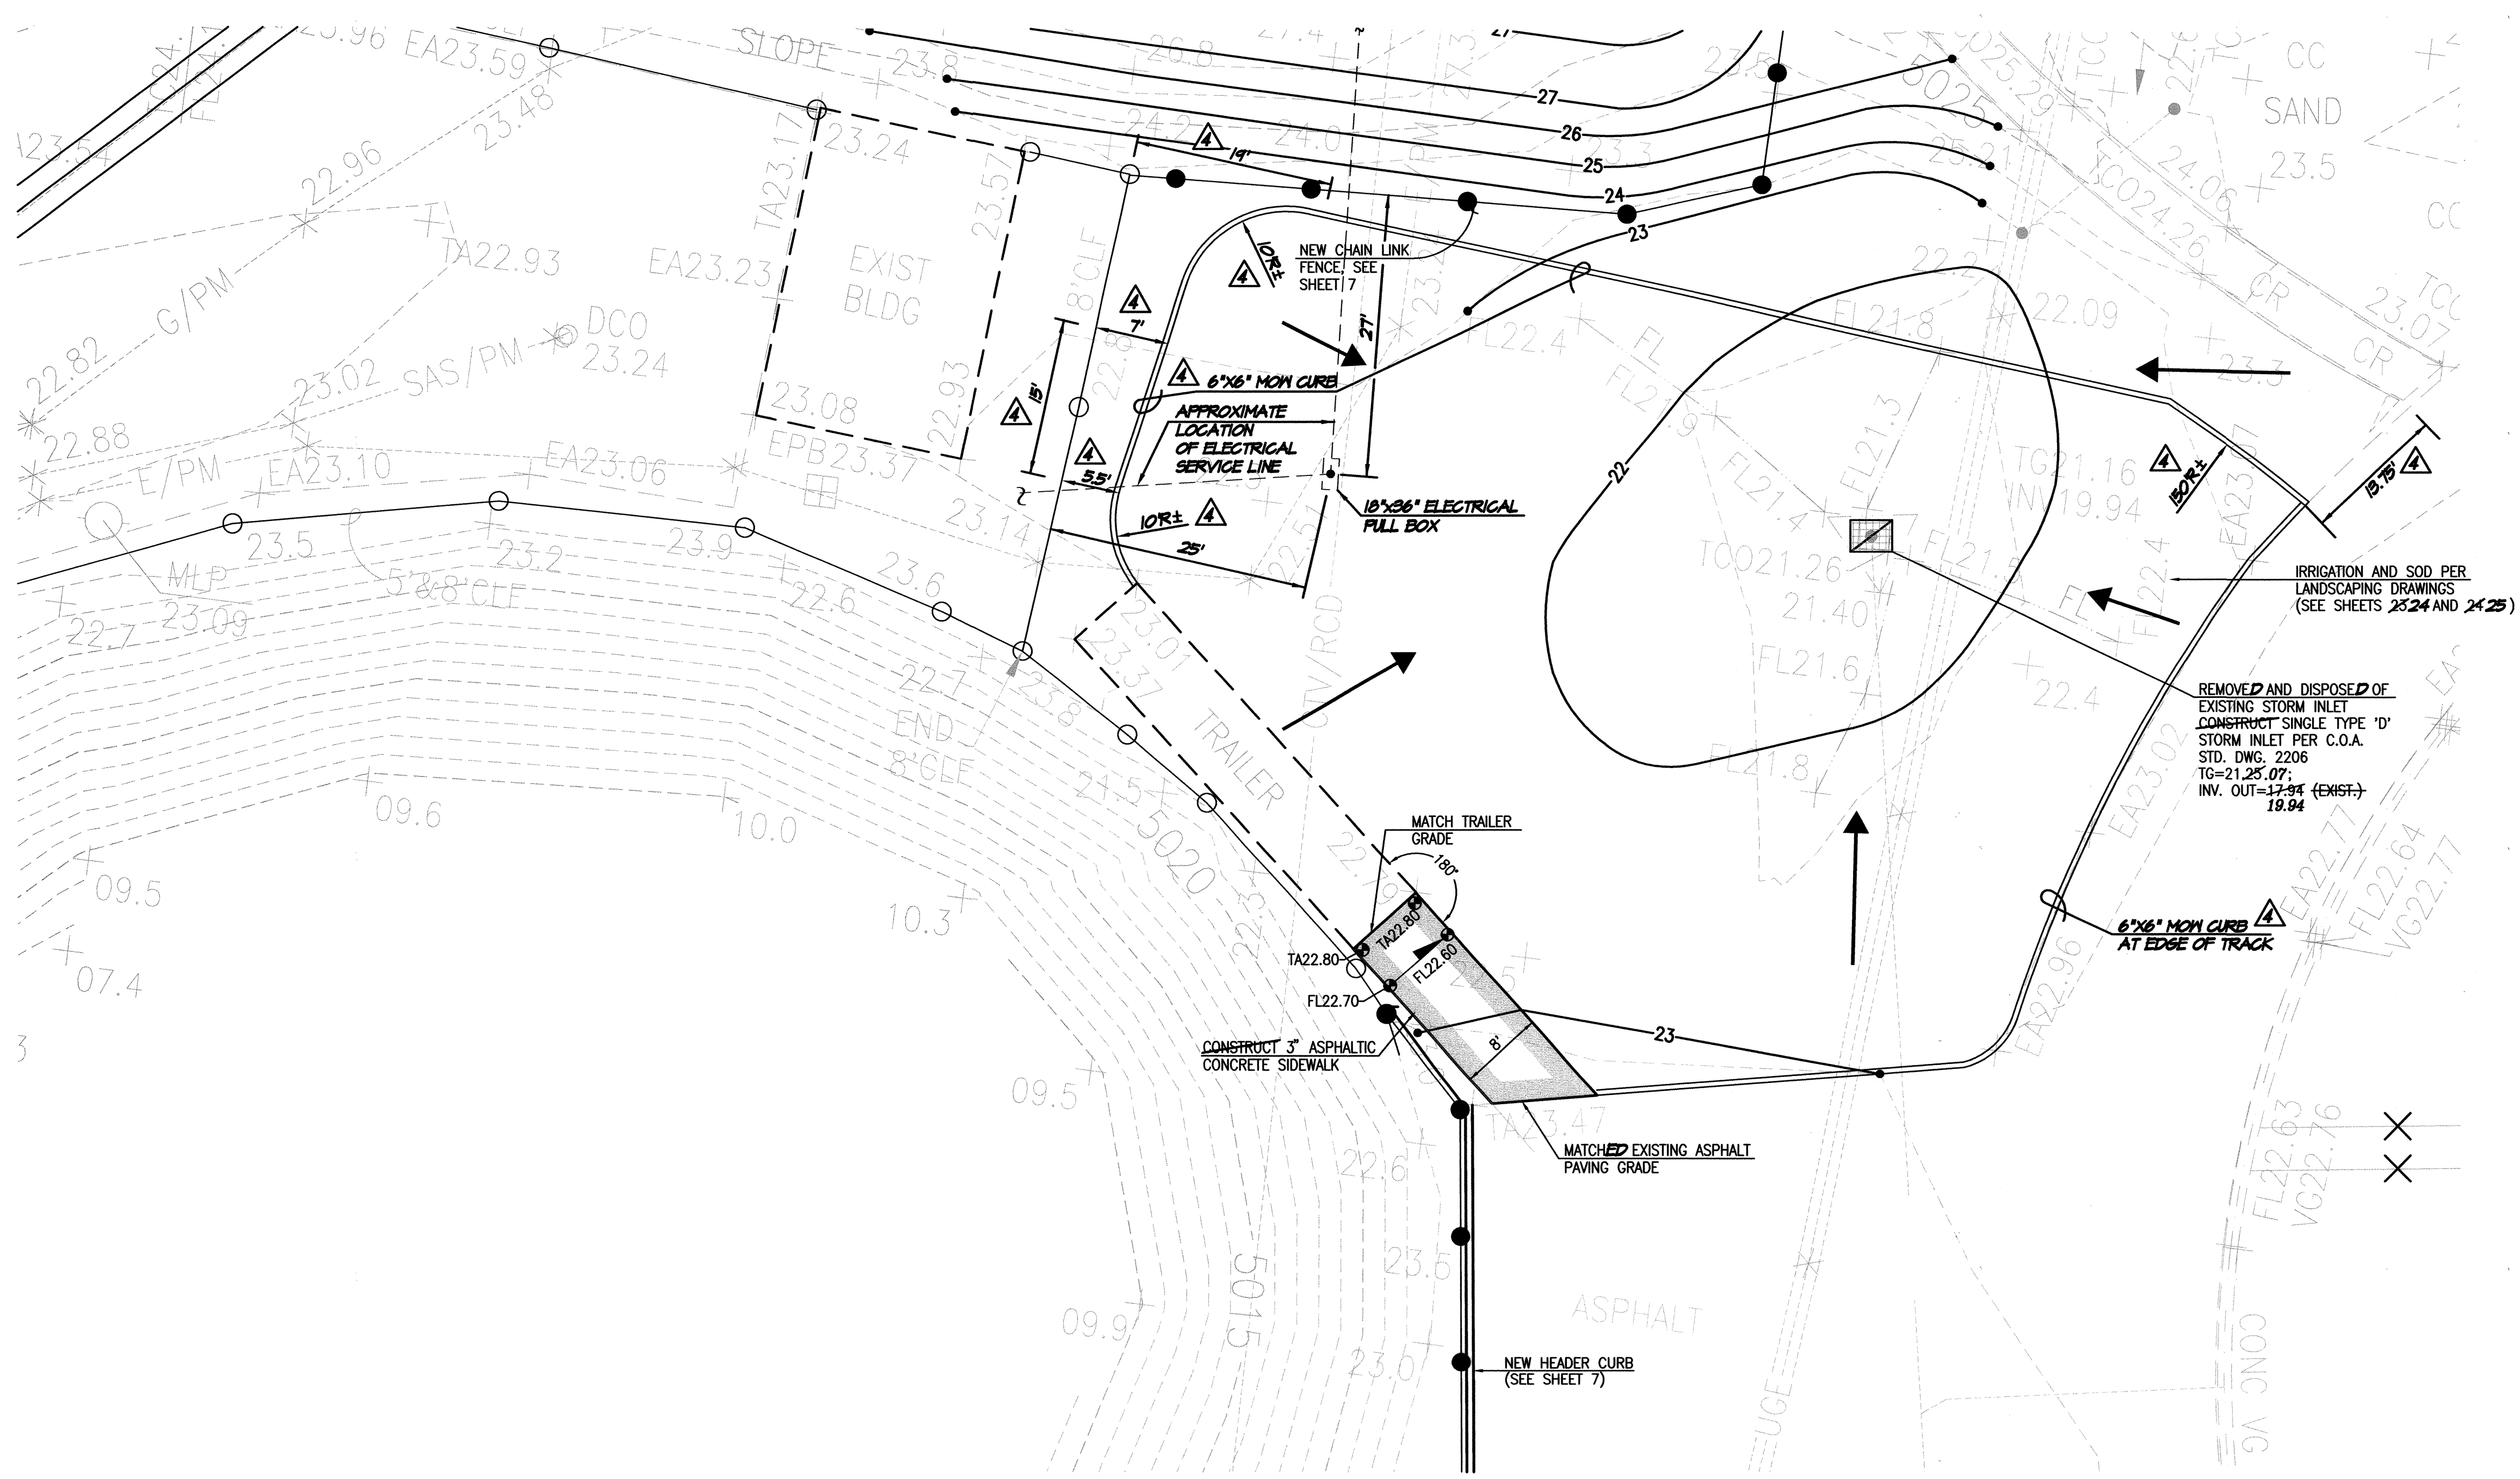

SURVEY NOTE

THIS IS NOT A BOUNDARY SURVEY; DATA IS SHOWN FOR ORIENTATION ONLY. THE BOUNDARY INFORMATION DEPICTED BY THIS PLAN IS BASED UPON THE BOUNDARY SURVEY PREPARED BY HIGH MESA CONSULTING GROUP, NMPS NO. 11184, DATED 11/15/2007. TOPOGRAPHIC INFORMATION IS BASED UPON A TOPOGRAPHIC SURVEY PREPARED BY HIGH MESA CONSULTING GROUP, NMPS NO. 11184, DATED 11/15/2007.


LEGEND

- 25.41 PROPOSED SPOT ELEVATION
- +24.86 EXISTING FLOWLINE ELEVATION
- 08 PROPOSED CONTOUR
- 5008 EXISTING CONTOUR
- PROPOSED FLOWLINE
- ROOF DRAINAGE
- EXISTING ROOF DRAINAGE
- PROPOSED DIRECTION OF FLOW
- EXISTING DIRECTION OF FLOW
- NEW BUILDING ENVELOPE
- RIGHT OF WAY LINE
- PUBLIC EASEMENT LINE
- PROPOSED CONCRETE
- PROPOSED ASPHALT
- RIVER ROCK DRY STREAM BED
- PROPOSED ORNAMENTAL WALL
- PROPOSED RETAINING WALL
- HIGH POINT
- INV INVERT
- TG TOP OF GRATE
- TC TOP OF CURB
- TA TOP OF ASPHALT PAVEMENT

4 RECORD DRAWING LEGEND

CONSTRUCT RECORD INFORMATION (VERIFIED BY ENGINEER)

- ✓ AS-CONSTRUCTED = AS-DESIGNED (VERIFIED BY ENGINEER)
- 38' 42" RECORD INFORMATION (VERIFIED BY ENGINEER)
- +25.2 RECORD INFORMATION (VERIFIED BY ENGINEER)
- 28.98' 42" RECORD INFORMATION (VERIFIED BY ENGINEER)
- ✓ AS-CONSTRUCTED = AS-DESIGNED (VERIFIED BY AS-BUILT SURVEY)
- 31' 31.8" RECORD INFORMATION FROM AS-BUILT SURVEY
- +26.9 RECORD INFORMATION FROM AS-BUILT SURVEY
- 31.25' 22" RECORD INFORMATION FROM AS-BUILT SURVEY

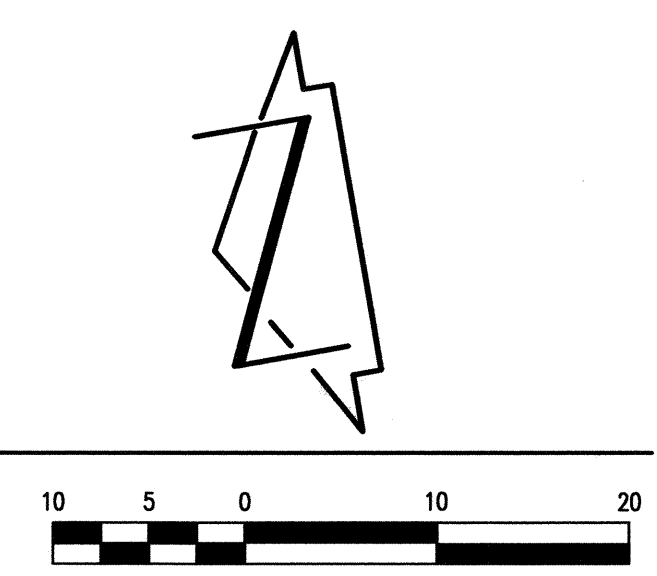

6010-B MIDWAY PARK BLVD. NE
ALBUQUERQUE, NEW MEXICO 87109
PHONE: 505.345.4250 FAX: 505.345.4254
www.hghmesacg.com

12-01-2011

TRACK AND FIELD RENOVATIONS

ALBUQUERQUE HIGH SCHOOL

NO.	DATE	BY	REVISIONS
1	11/11/11	J.G.M.	RECORD DRAWING & CERTIFICATION

PROJECT No. 2007-1837-7
DESIGNED BY J.G.M.
DRAWN BY CFA/BLE/JLP
APPROVED BY J.G.M.
SHEET TITLE

STORAGE AREA IMPROVEMENTS & GRADING PLAN

C-117

SHEET 17 OF 25